

INDEX TO DRAWINGS	
SHEET	DESCRIPTION
1	TITLE SHEET
2	CROSS SECTIONS

STATE OF HAWAII

DEPARTMENT OF TRANSPORTATION

HIGHWAYS DIVISION

HONOLULU, HAWAII

"AS BUILT" PLANS FOR

CONSTRUCTION OF ROCK REVETMENT

ALONG ROUTE 30

UKUMEHAME AREA

PROJECT NO. 30B-01-68


DISTRICT OF LAHAINA

ISLAND OF MAUI

SCALE


CROSS SECTION.....HOR. 1 INCH=10'

VER. 1 INCH=10'

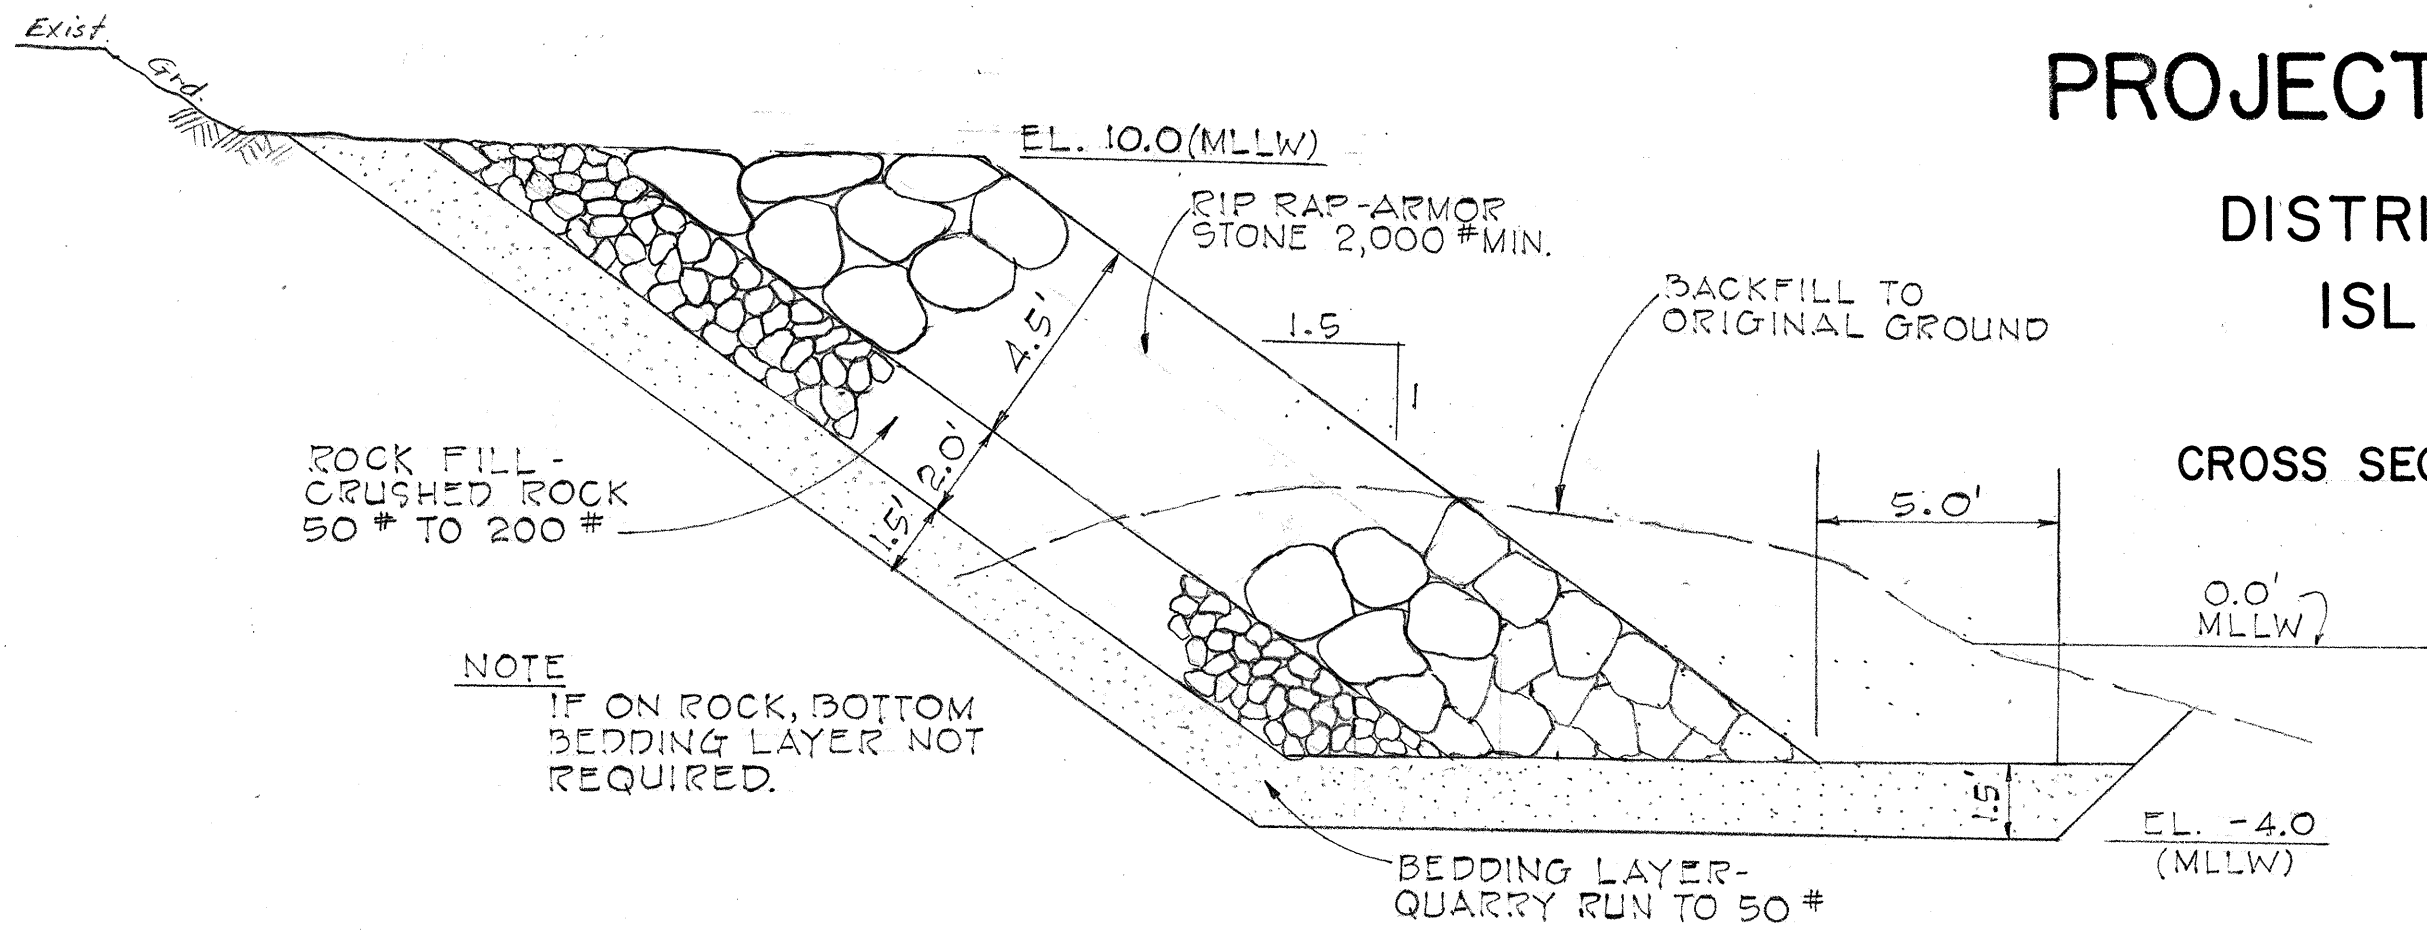

TYPICAL REVETMENT SECTION

Scale: 1" = 4'-0"

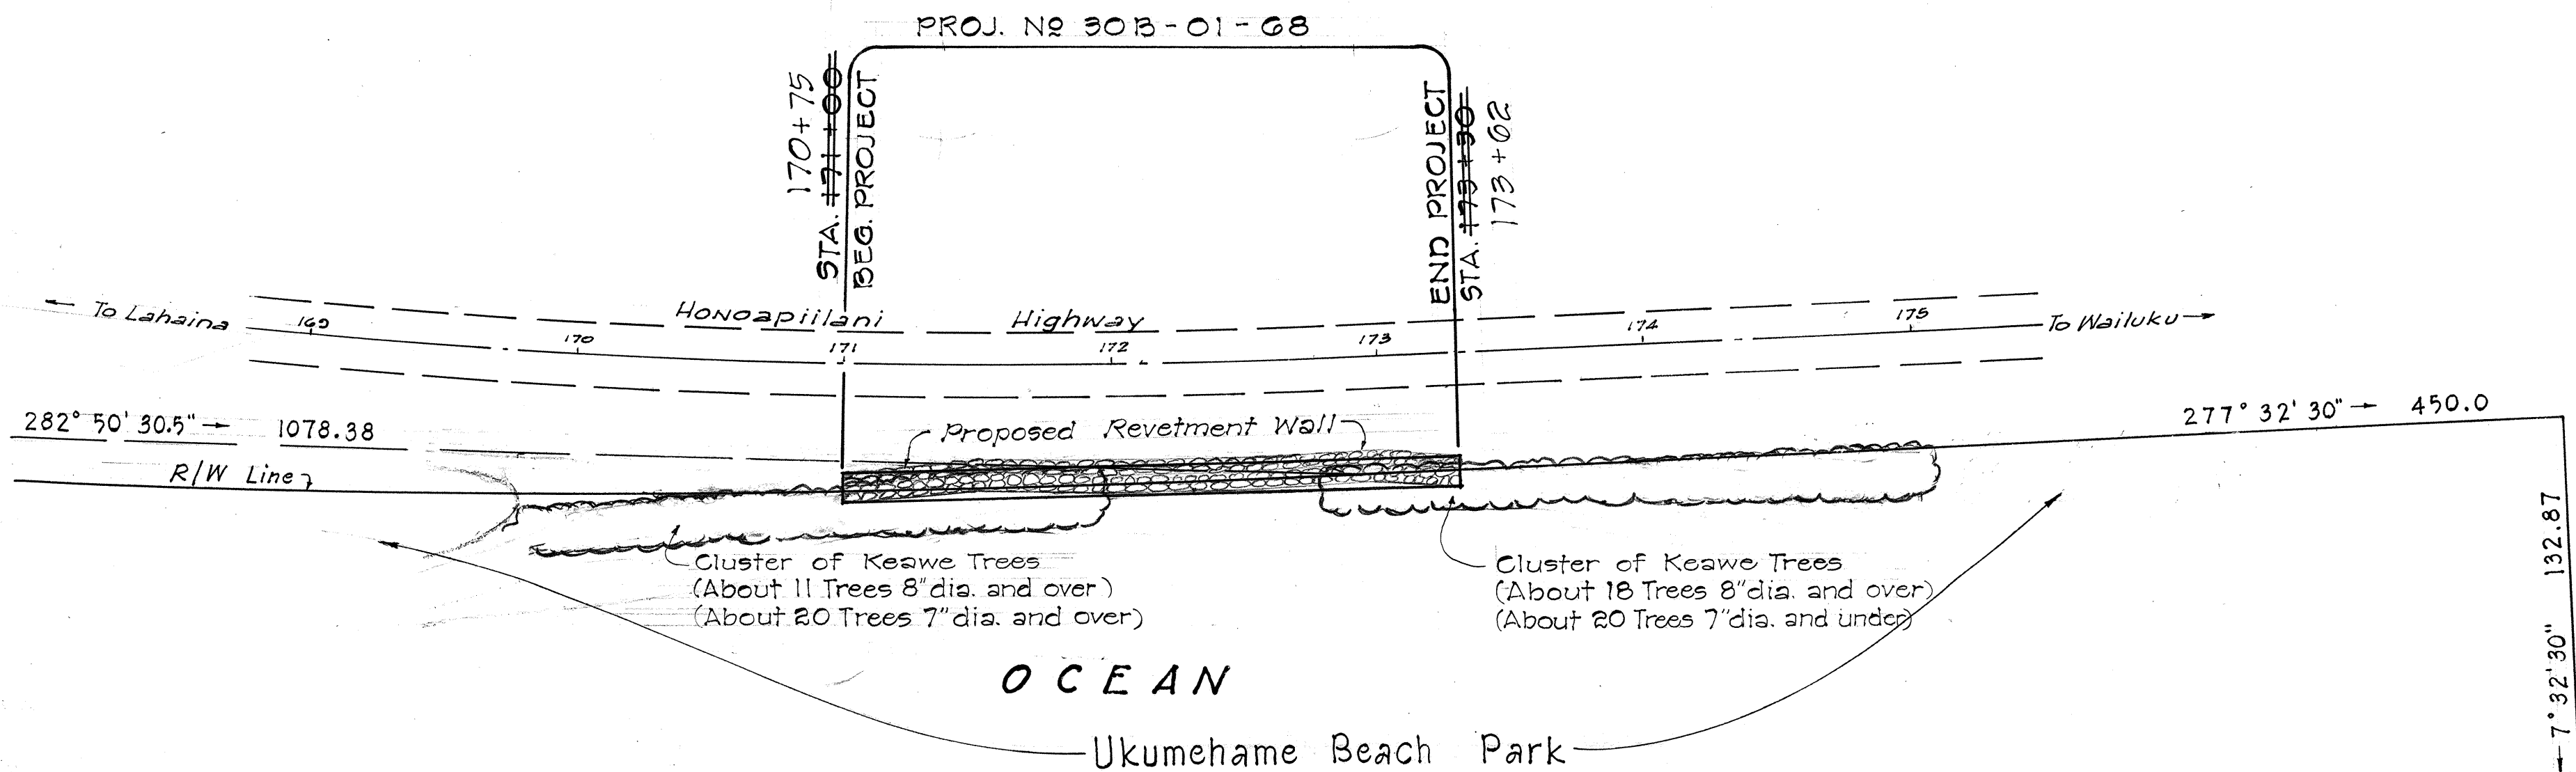


GENERAL PLAN


Scale: 1" = 50'

LENGTH OF PROJECT0.044 MILE

FED. ROAD DIST. NO.	STATE	PROJ. NO.	FISCAL YEAR	SHEET NO.	TOTAL SHEETS
HAWAII	HAW.	30B-01-68	1967	1	2

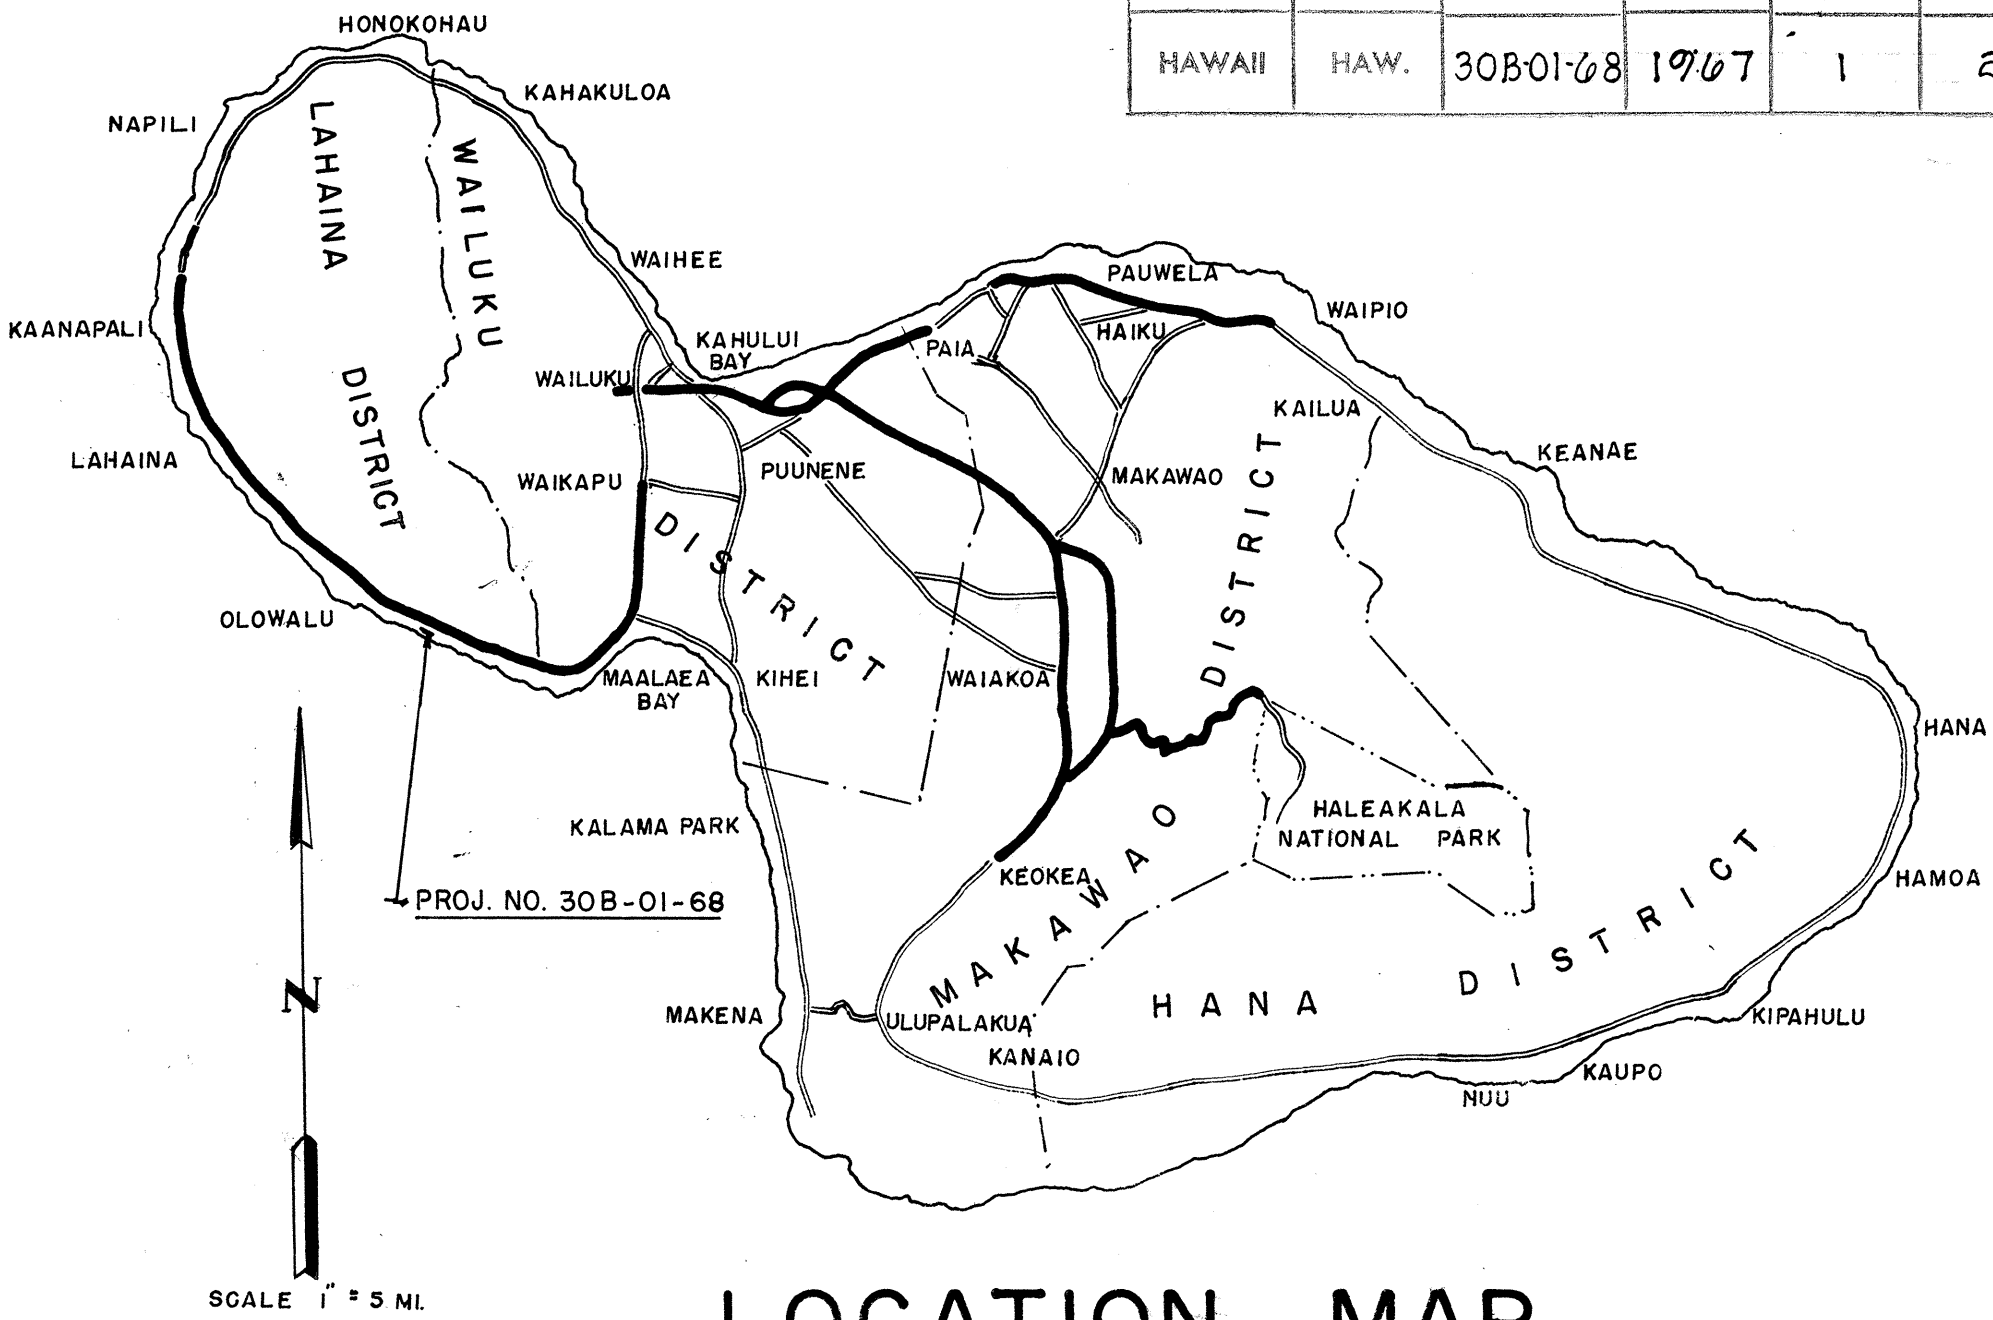

LOCATION MAP

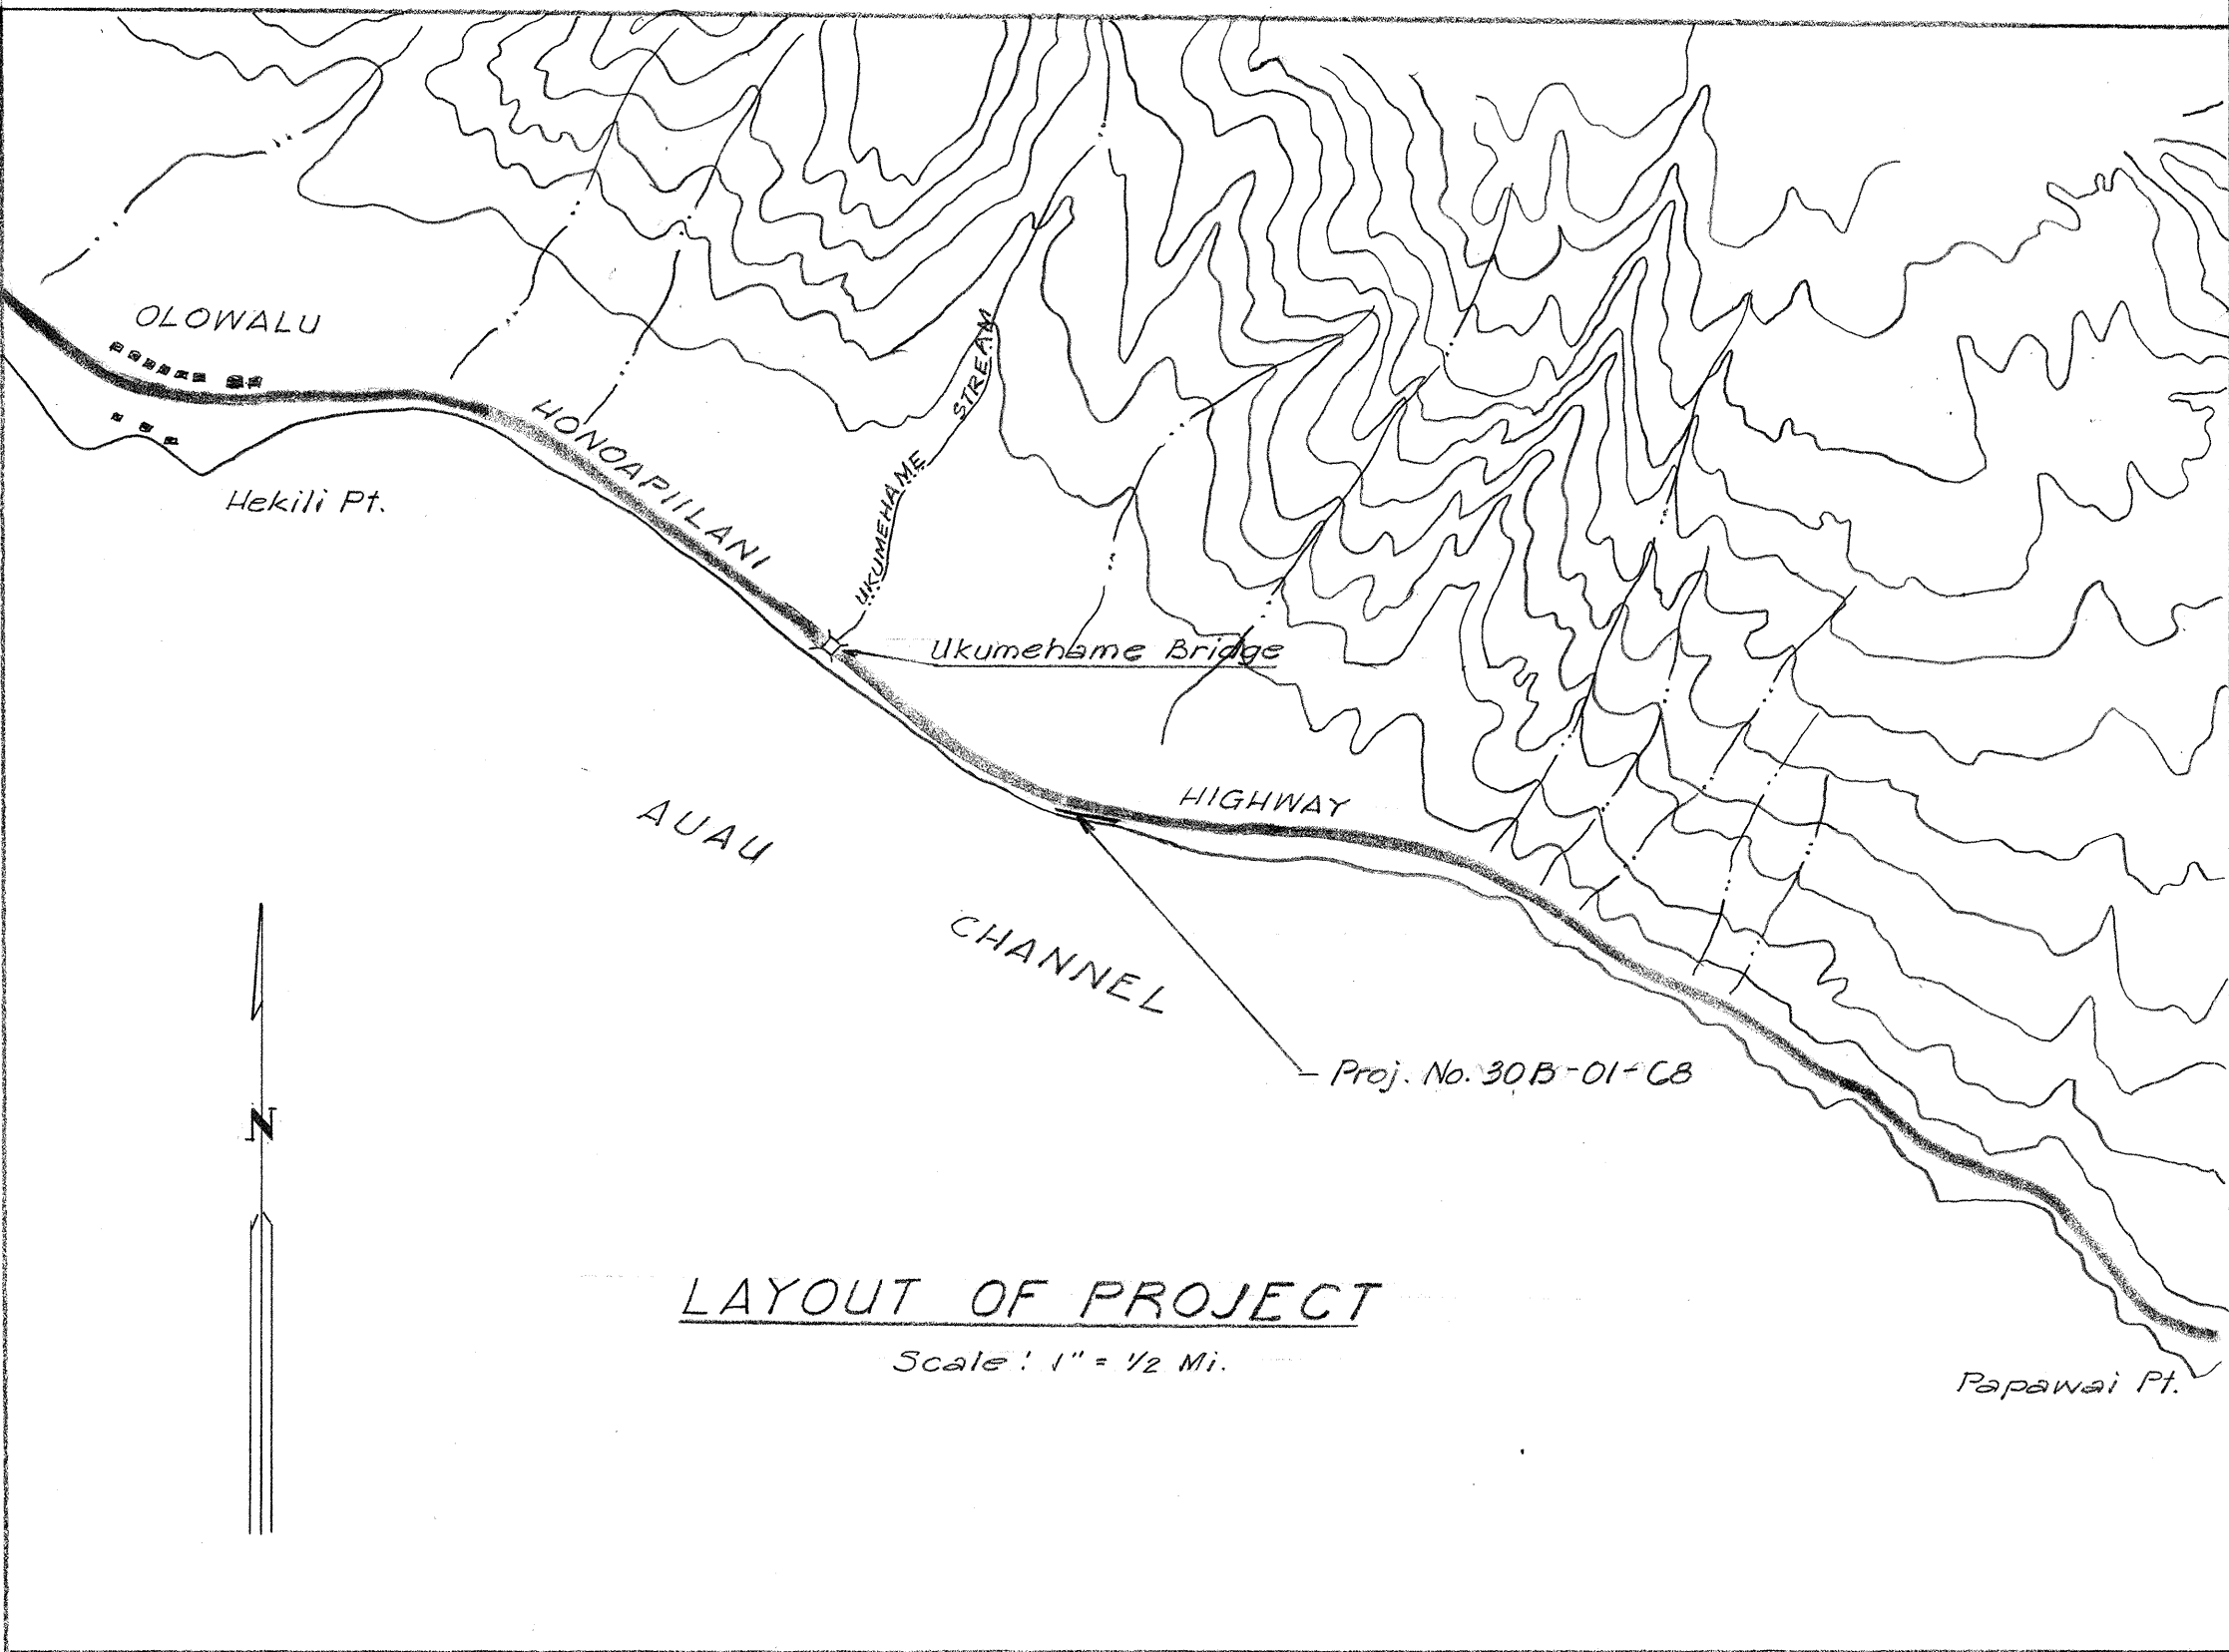

LAYOUT OF PROJECT

Scale: 1" = 1/2 Mi.

NOTE:

ALL CHANGES MADE DURING

CONSTRUCTION HAVE BEEN NOTED

IN RED ON THESE TRACINGS AND

CHECKED BY:

Ingis Phachi

PROJECT ENGINEER

July 10, 1968

DATE

APPROVED: *John H. ...*

DATE 10/25/67

DIRECTOR OF TRANSPORTATION