

INDEX TO DRAWINGS	
SHEET NO	DESCRIPTION
1	TITLE SHEET
2	DETAIL PLAN
3-4	CONSTRUCTION I.D. SIGN

STATE OF HAWAII

DEPARTMENT OF TRANSPORTATION

HIGHWAYS DIVISION

HONOLULU, HAWAII

PLANS OF

EXTENSION OF CULVERT




HONOAPIILANI HIGHWAY

(LOWALU SECTION)

PROJECT NO. 30B-02-69, UNIT I

DISTRICT OF LAHAINA

ISLAND OF MAUI

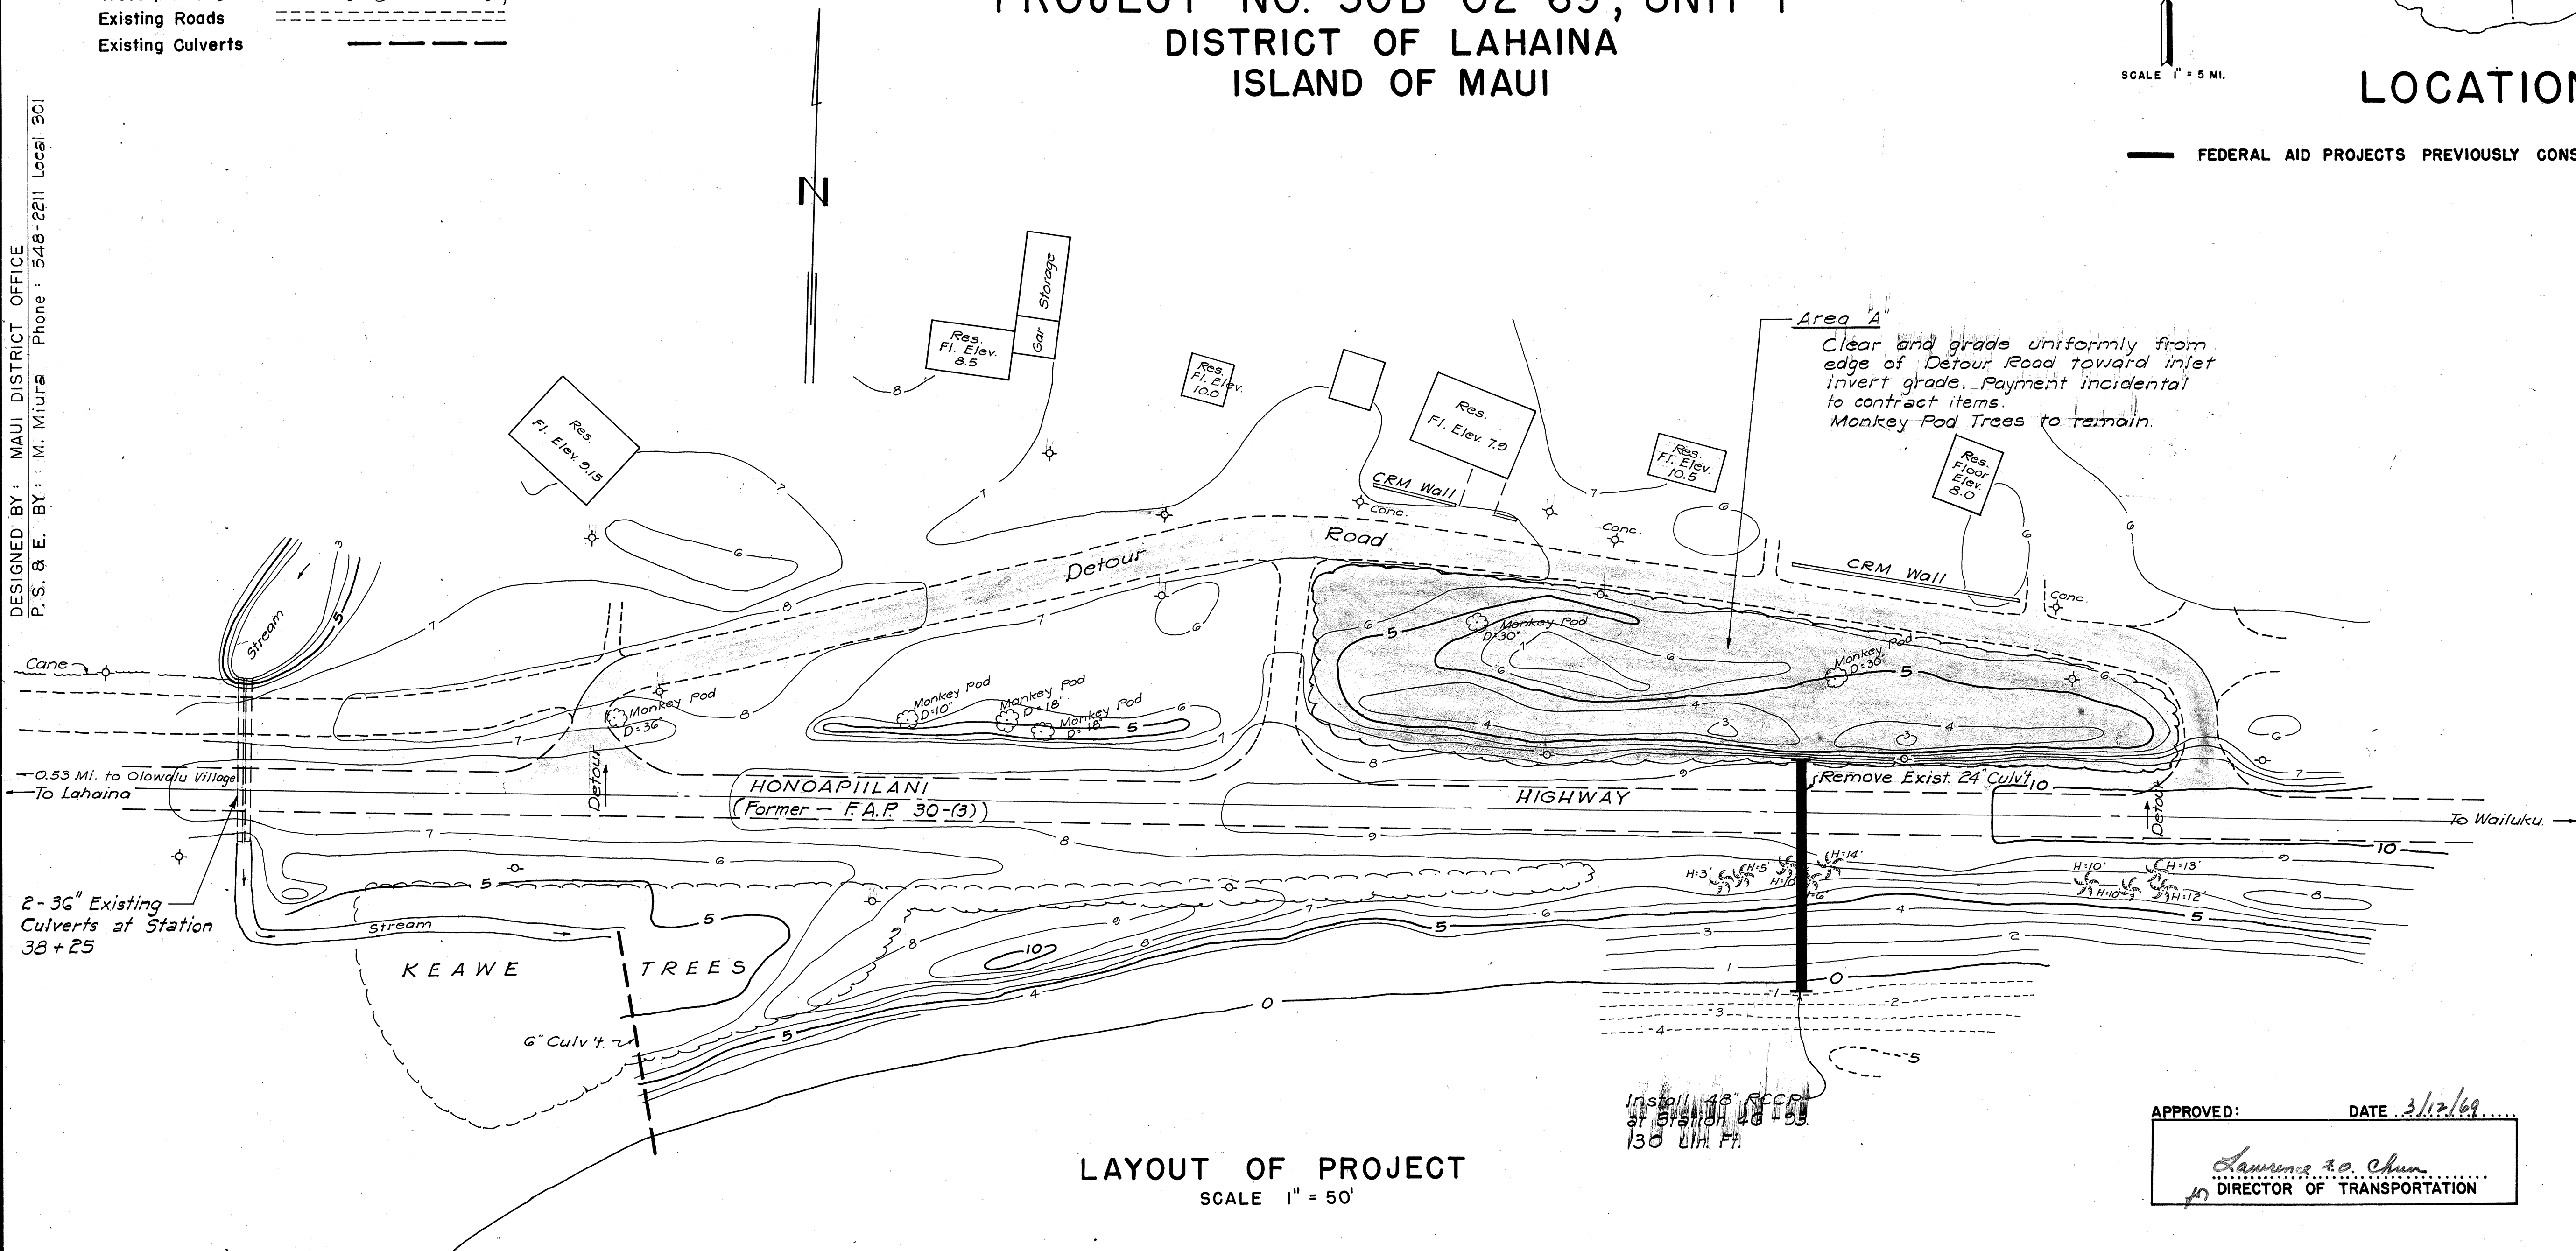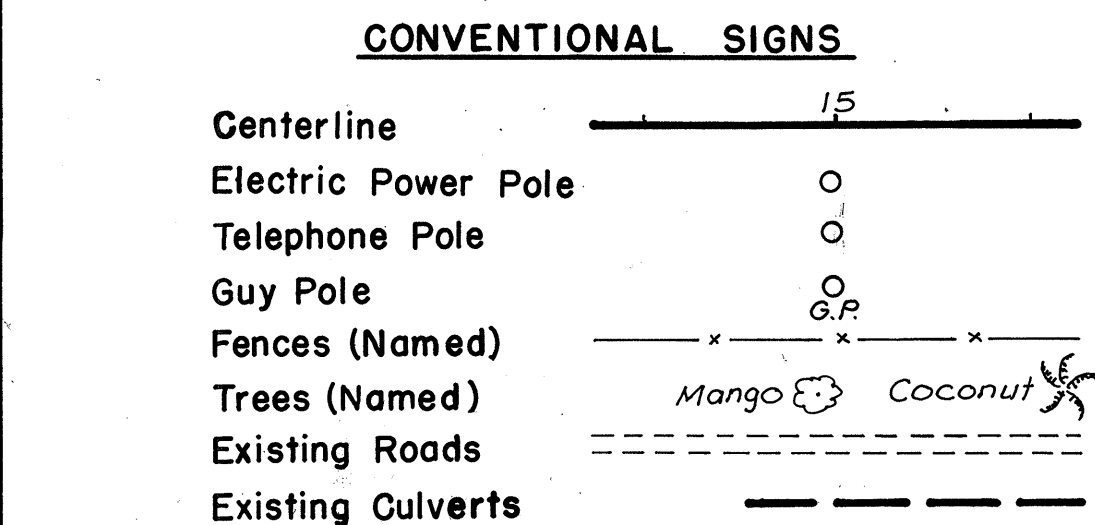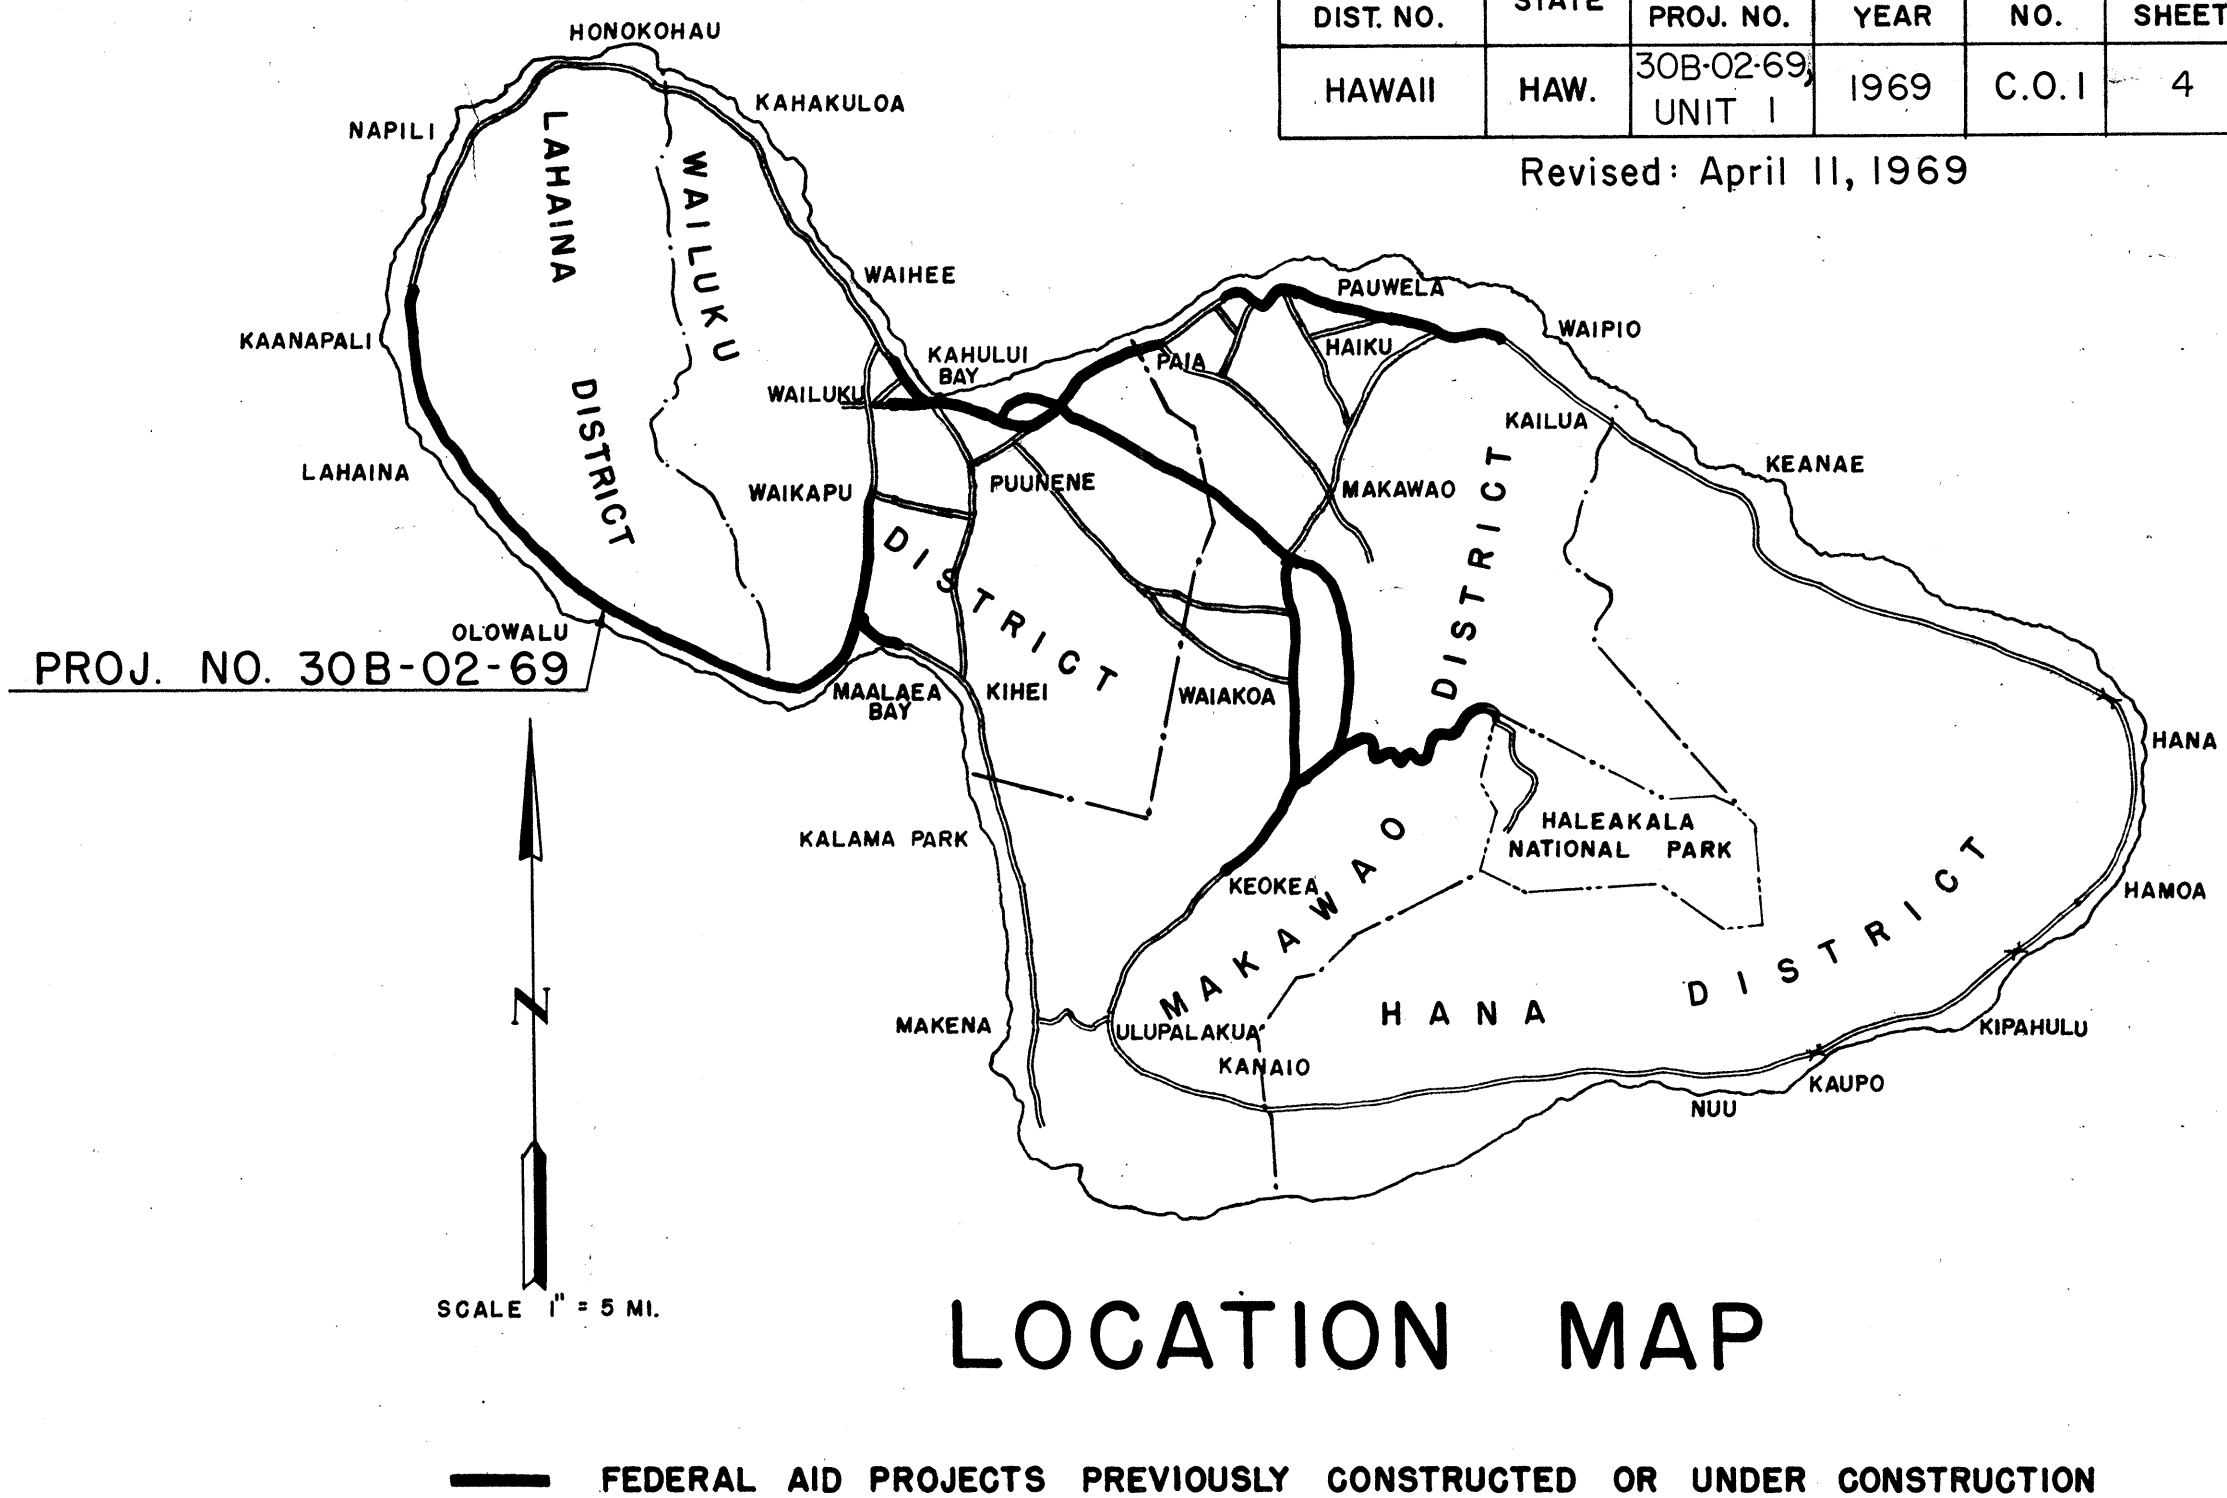

THIS SHEET SUPERSEDES SHEET NUMBER 1