
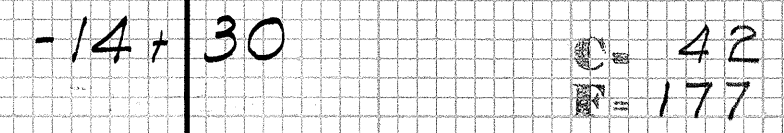
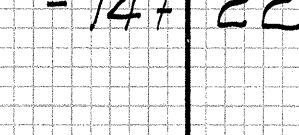
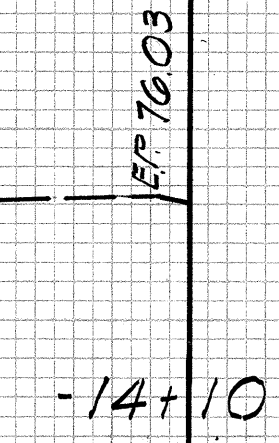
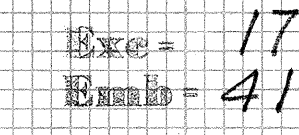
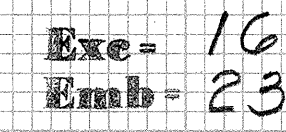
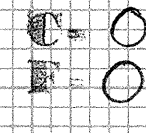
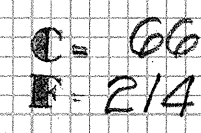
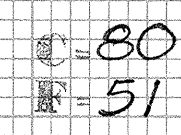
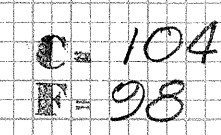
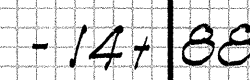
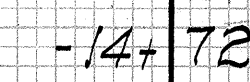
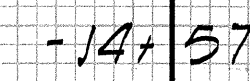
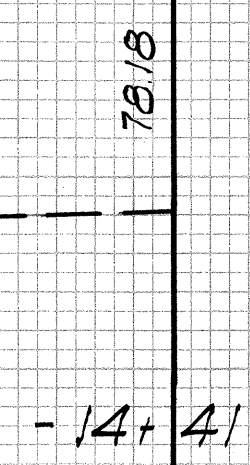
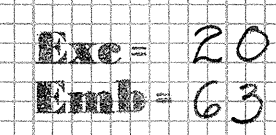
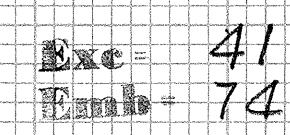


FED. ROAD DIST. NO.	STATE	PROJ. NO.	FISCAL YEAR	SHEET NO.	TOTAL SHEETS
HAWAII	HAW.	330C-03-70	1970	24	30

FINAL SURVEY	SURVEYED	BY	DATE
	PLOTTED		
NOTE BOOK	TEMPLATE		
	AREAS		
NO.	AREAS CHECKED		

ORIGINAL SURVEY		BY	DATE
SURVEYED			
PLOTTED			
TEMPLATE			
AREAS			
AREAS CHECKED			
NO.			

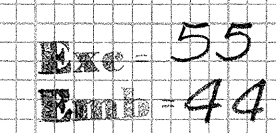


SLIDE AREA STA. -14+88 TO STA -14+10

FED. ROAD DIST. NO.	STATE	PROJ. NO.	FISCAL YEAR	SHEET NO.	TOTAL SHEETS
HAWAII	HAW.	330C-03-70	1970	25	30

FINAL SURVEY	DATE
SURVEYED	
NOTED	
PLANNED	
AREAS CHECKED	


ORIGINAL SURVEY	DATE
SURVEYED	1-29-70
NOTED	2-10-70
PLANNED	
AREAS CHECKED	

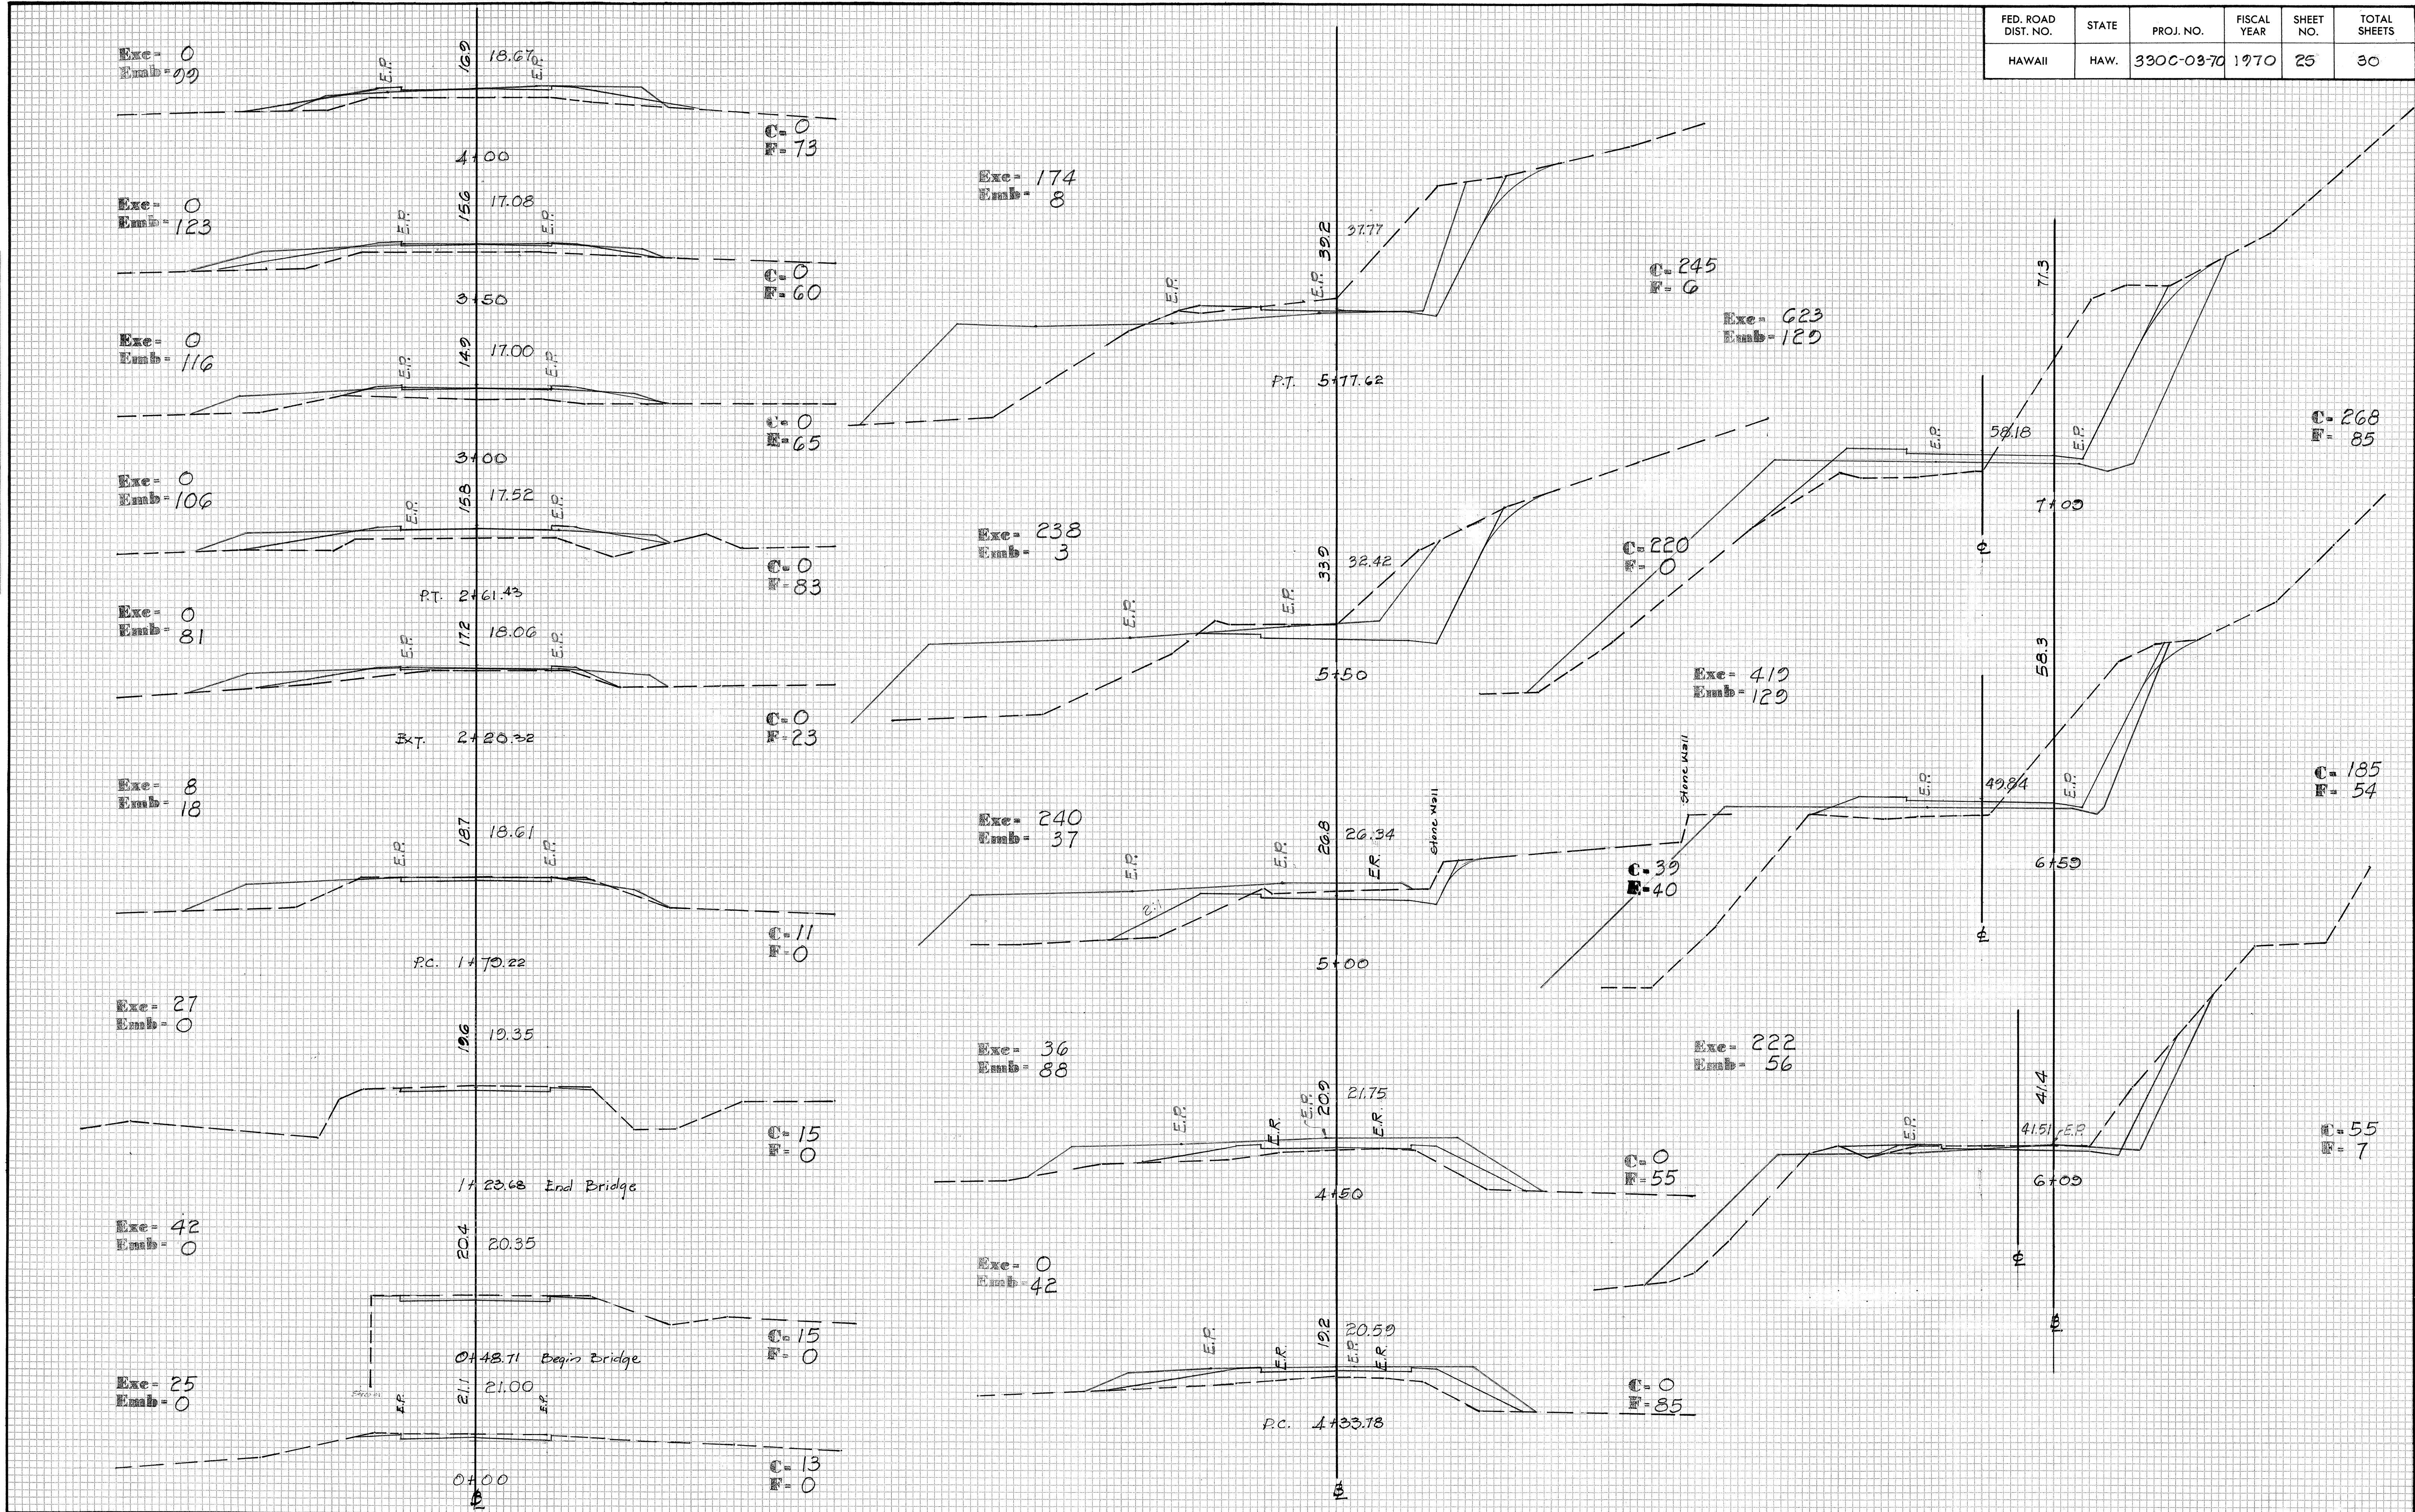

FED. ROAD DIST. NO.	STATE	PROJ. NO.	FISCAL YEAR	SHEET NO.	TOTAL SHEETS
HAWAII	HAW.	330C-03-70	1970	26	30

FINAL SURVEY	DATE
SURVEYED	
PLOTTED	
NOTE BOOK	
AREAS	
CHECKED	
NO.	


ORIGINAL SURVEY	DATE
SURVEYED	1-28-70
PLOTTED	2-25-70
NOTE BOOK	
AREAS	
CHECKED	
NO.	

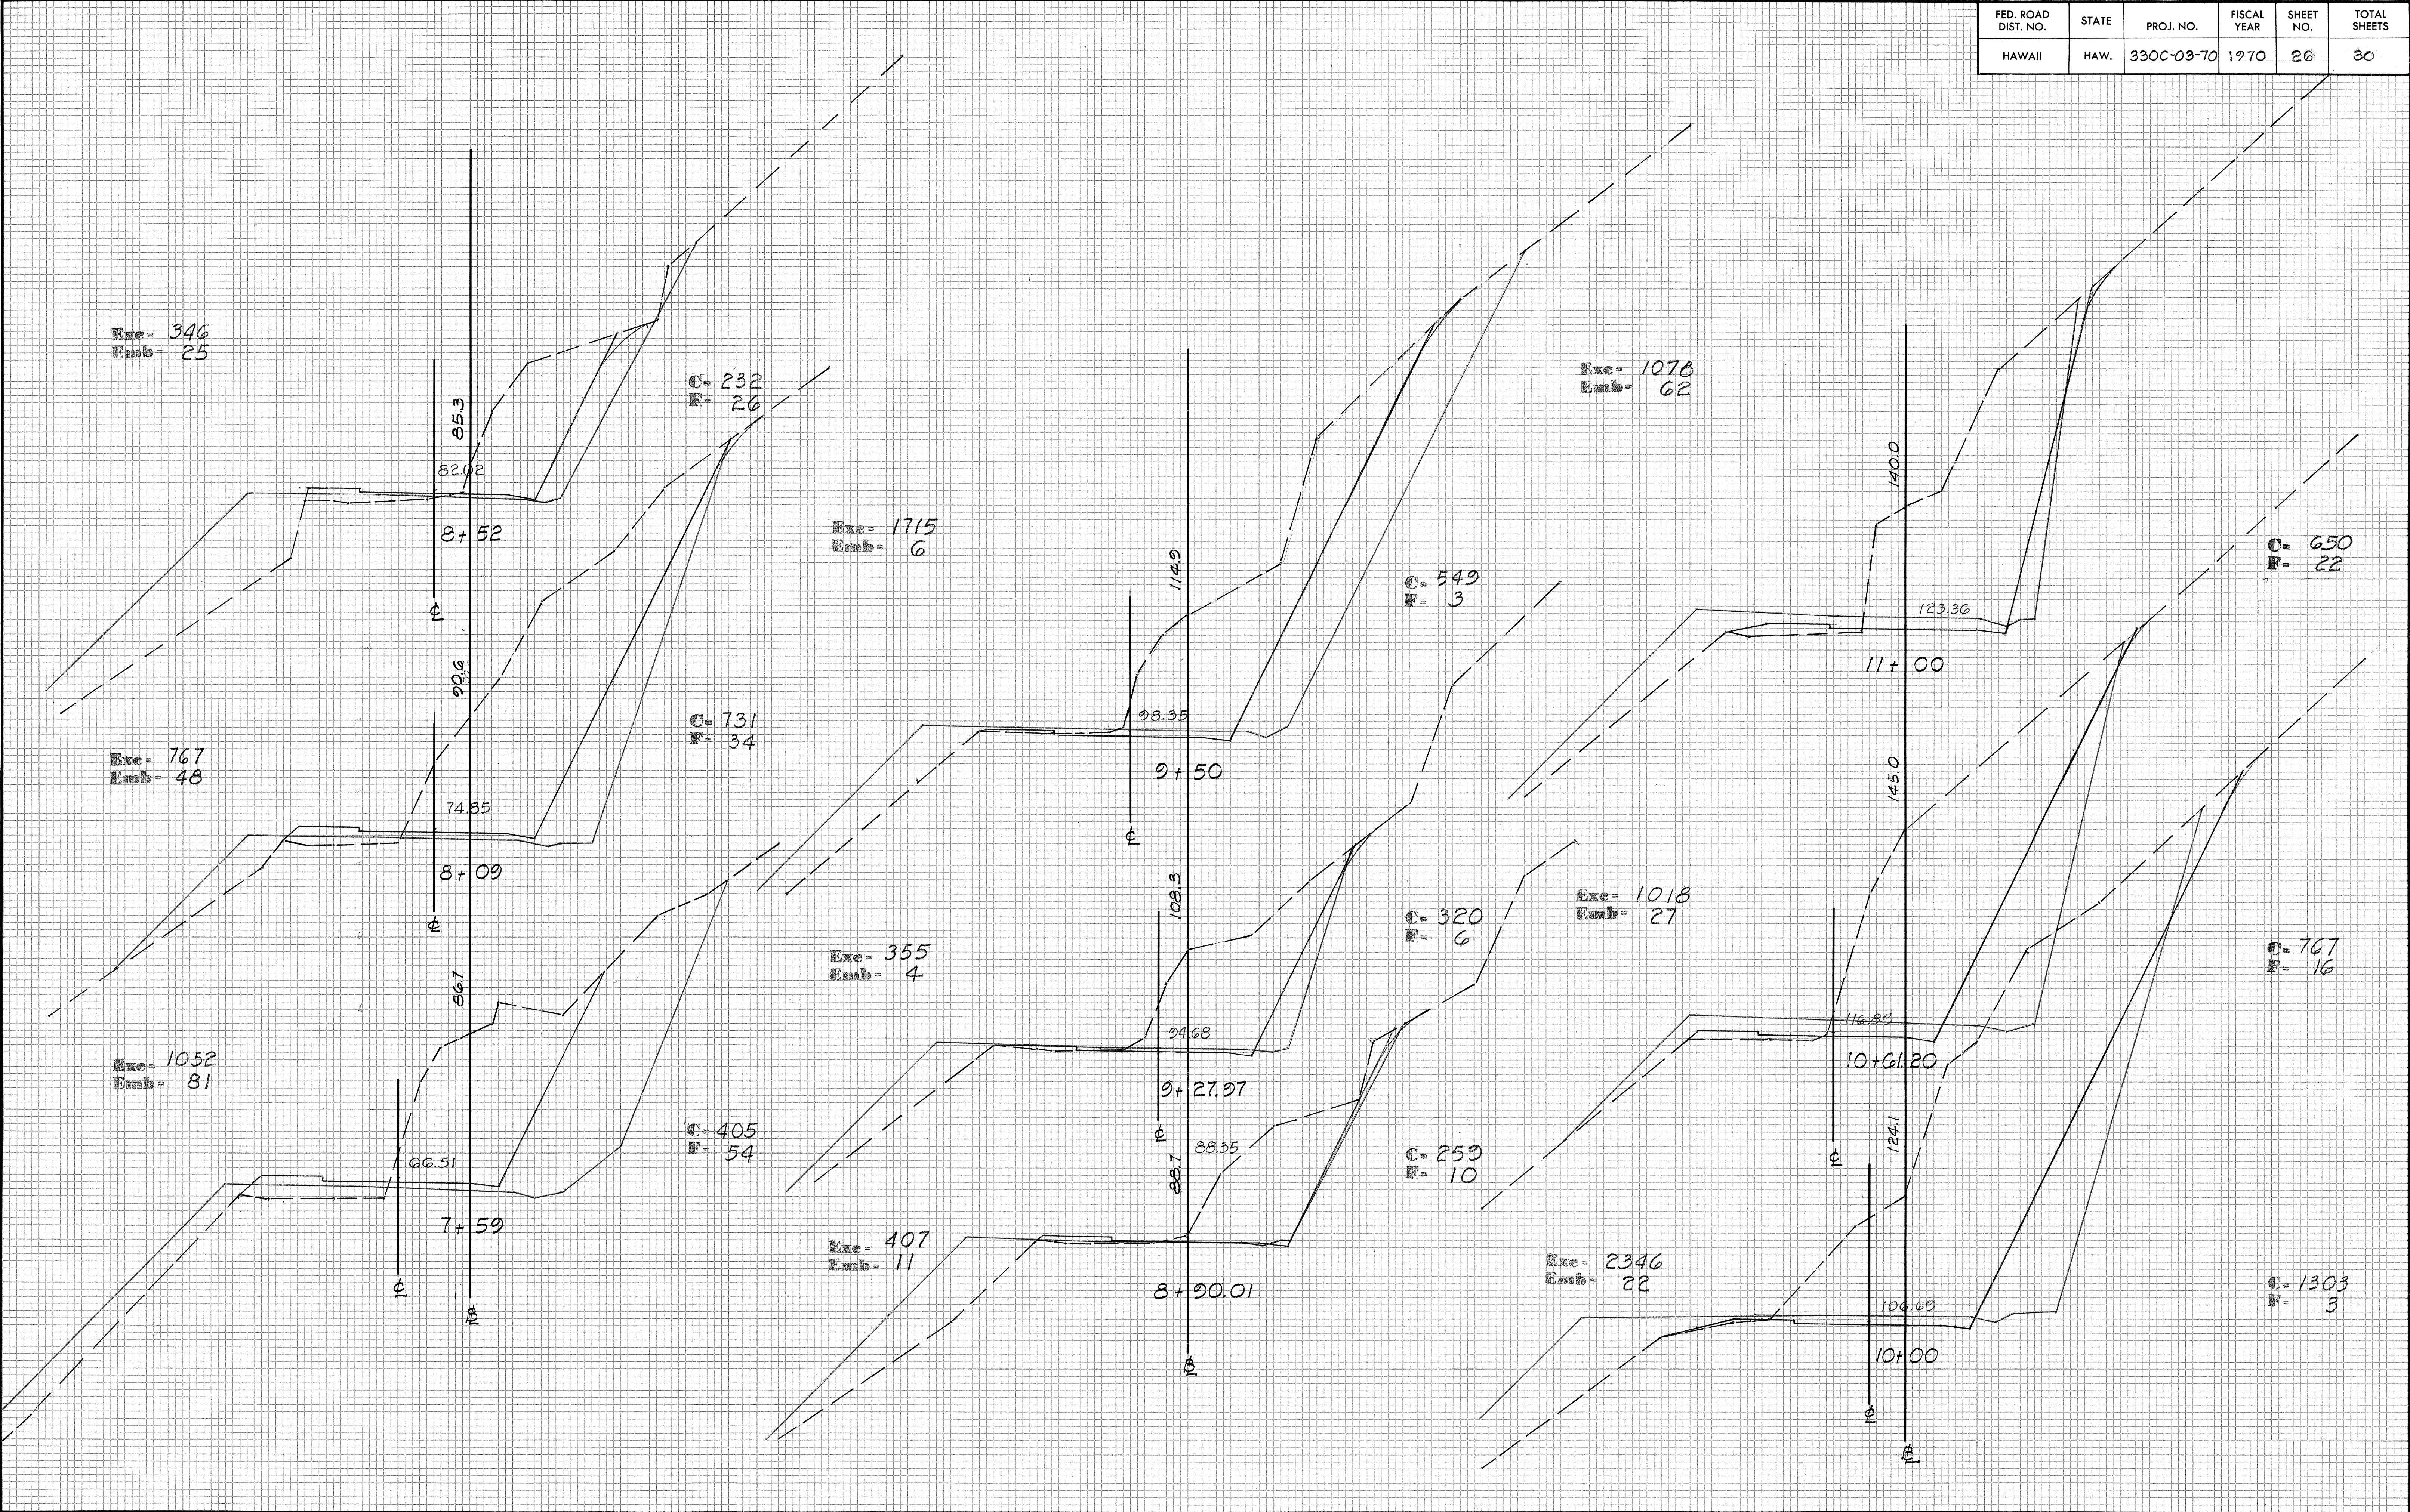

FED. ROAD DIST. NO.	STATE	PROJ. NO.	FISCAL YEAR	SHEET NO.	TOTAL SHEETS
HAWAII	HAW.	330C-03-70	1970	28	30

FINAL SURVEY	DATE
SURVEYED	
PLOTTED	
NOTE BOOK	
AREAS CHECKED	


ORIGINAL SURVEY	DATE
SURVEYED	1-22-76
PLOTTED	2-22-76
NOTE BOOK	
AREAS CHECKED	

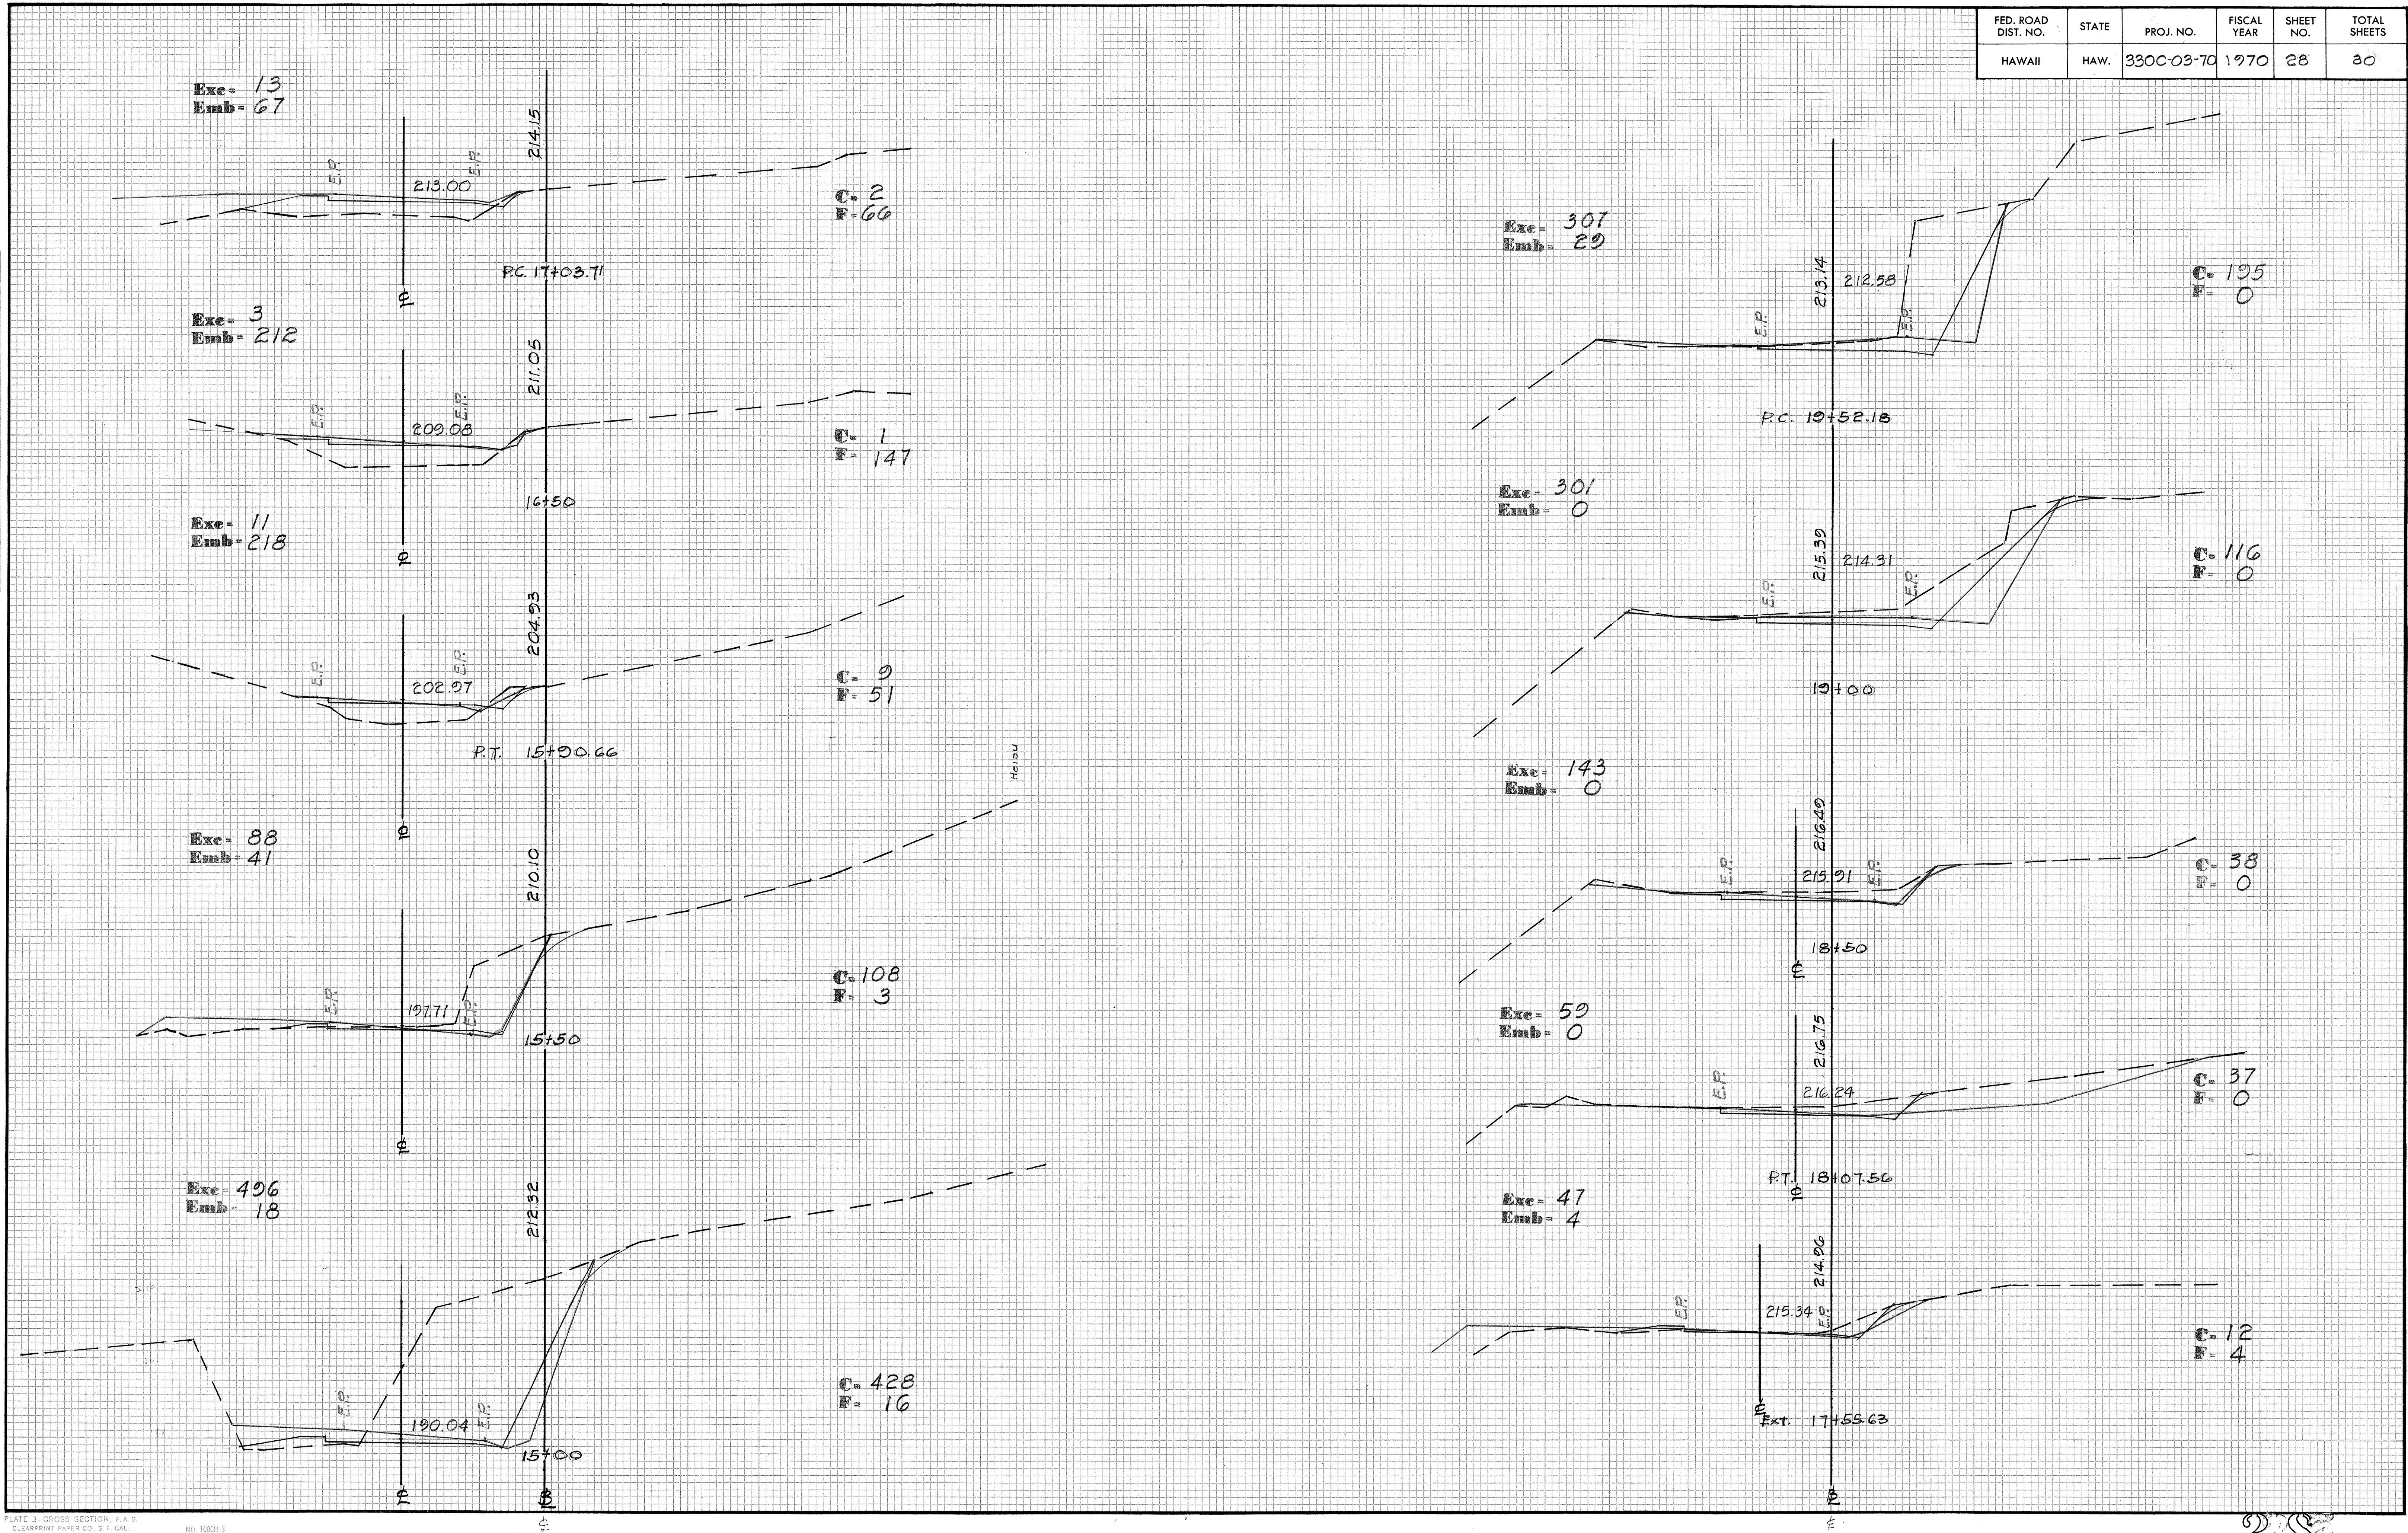

FED. ROAD DIST. NO.	STATE	PROJ. NO.	FISCAL YEAR	SHEET NO.	TOTAL SHEETS
HAWAII	HAW.	330C-03-70	1970	29	30

FINAL SURVEY	DATE
NO.	BY
SURVEYED	
PLOTTED	
TEMP. DATE	
NOTE BOOK	
AREAS CHECKED	

ORIGINAL SURVEY	DATE
NO.	BY
SURVEYED	
PLOTTED	
TEMP. DATE	
NOTE BOOK	
AREAS CHECKED	

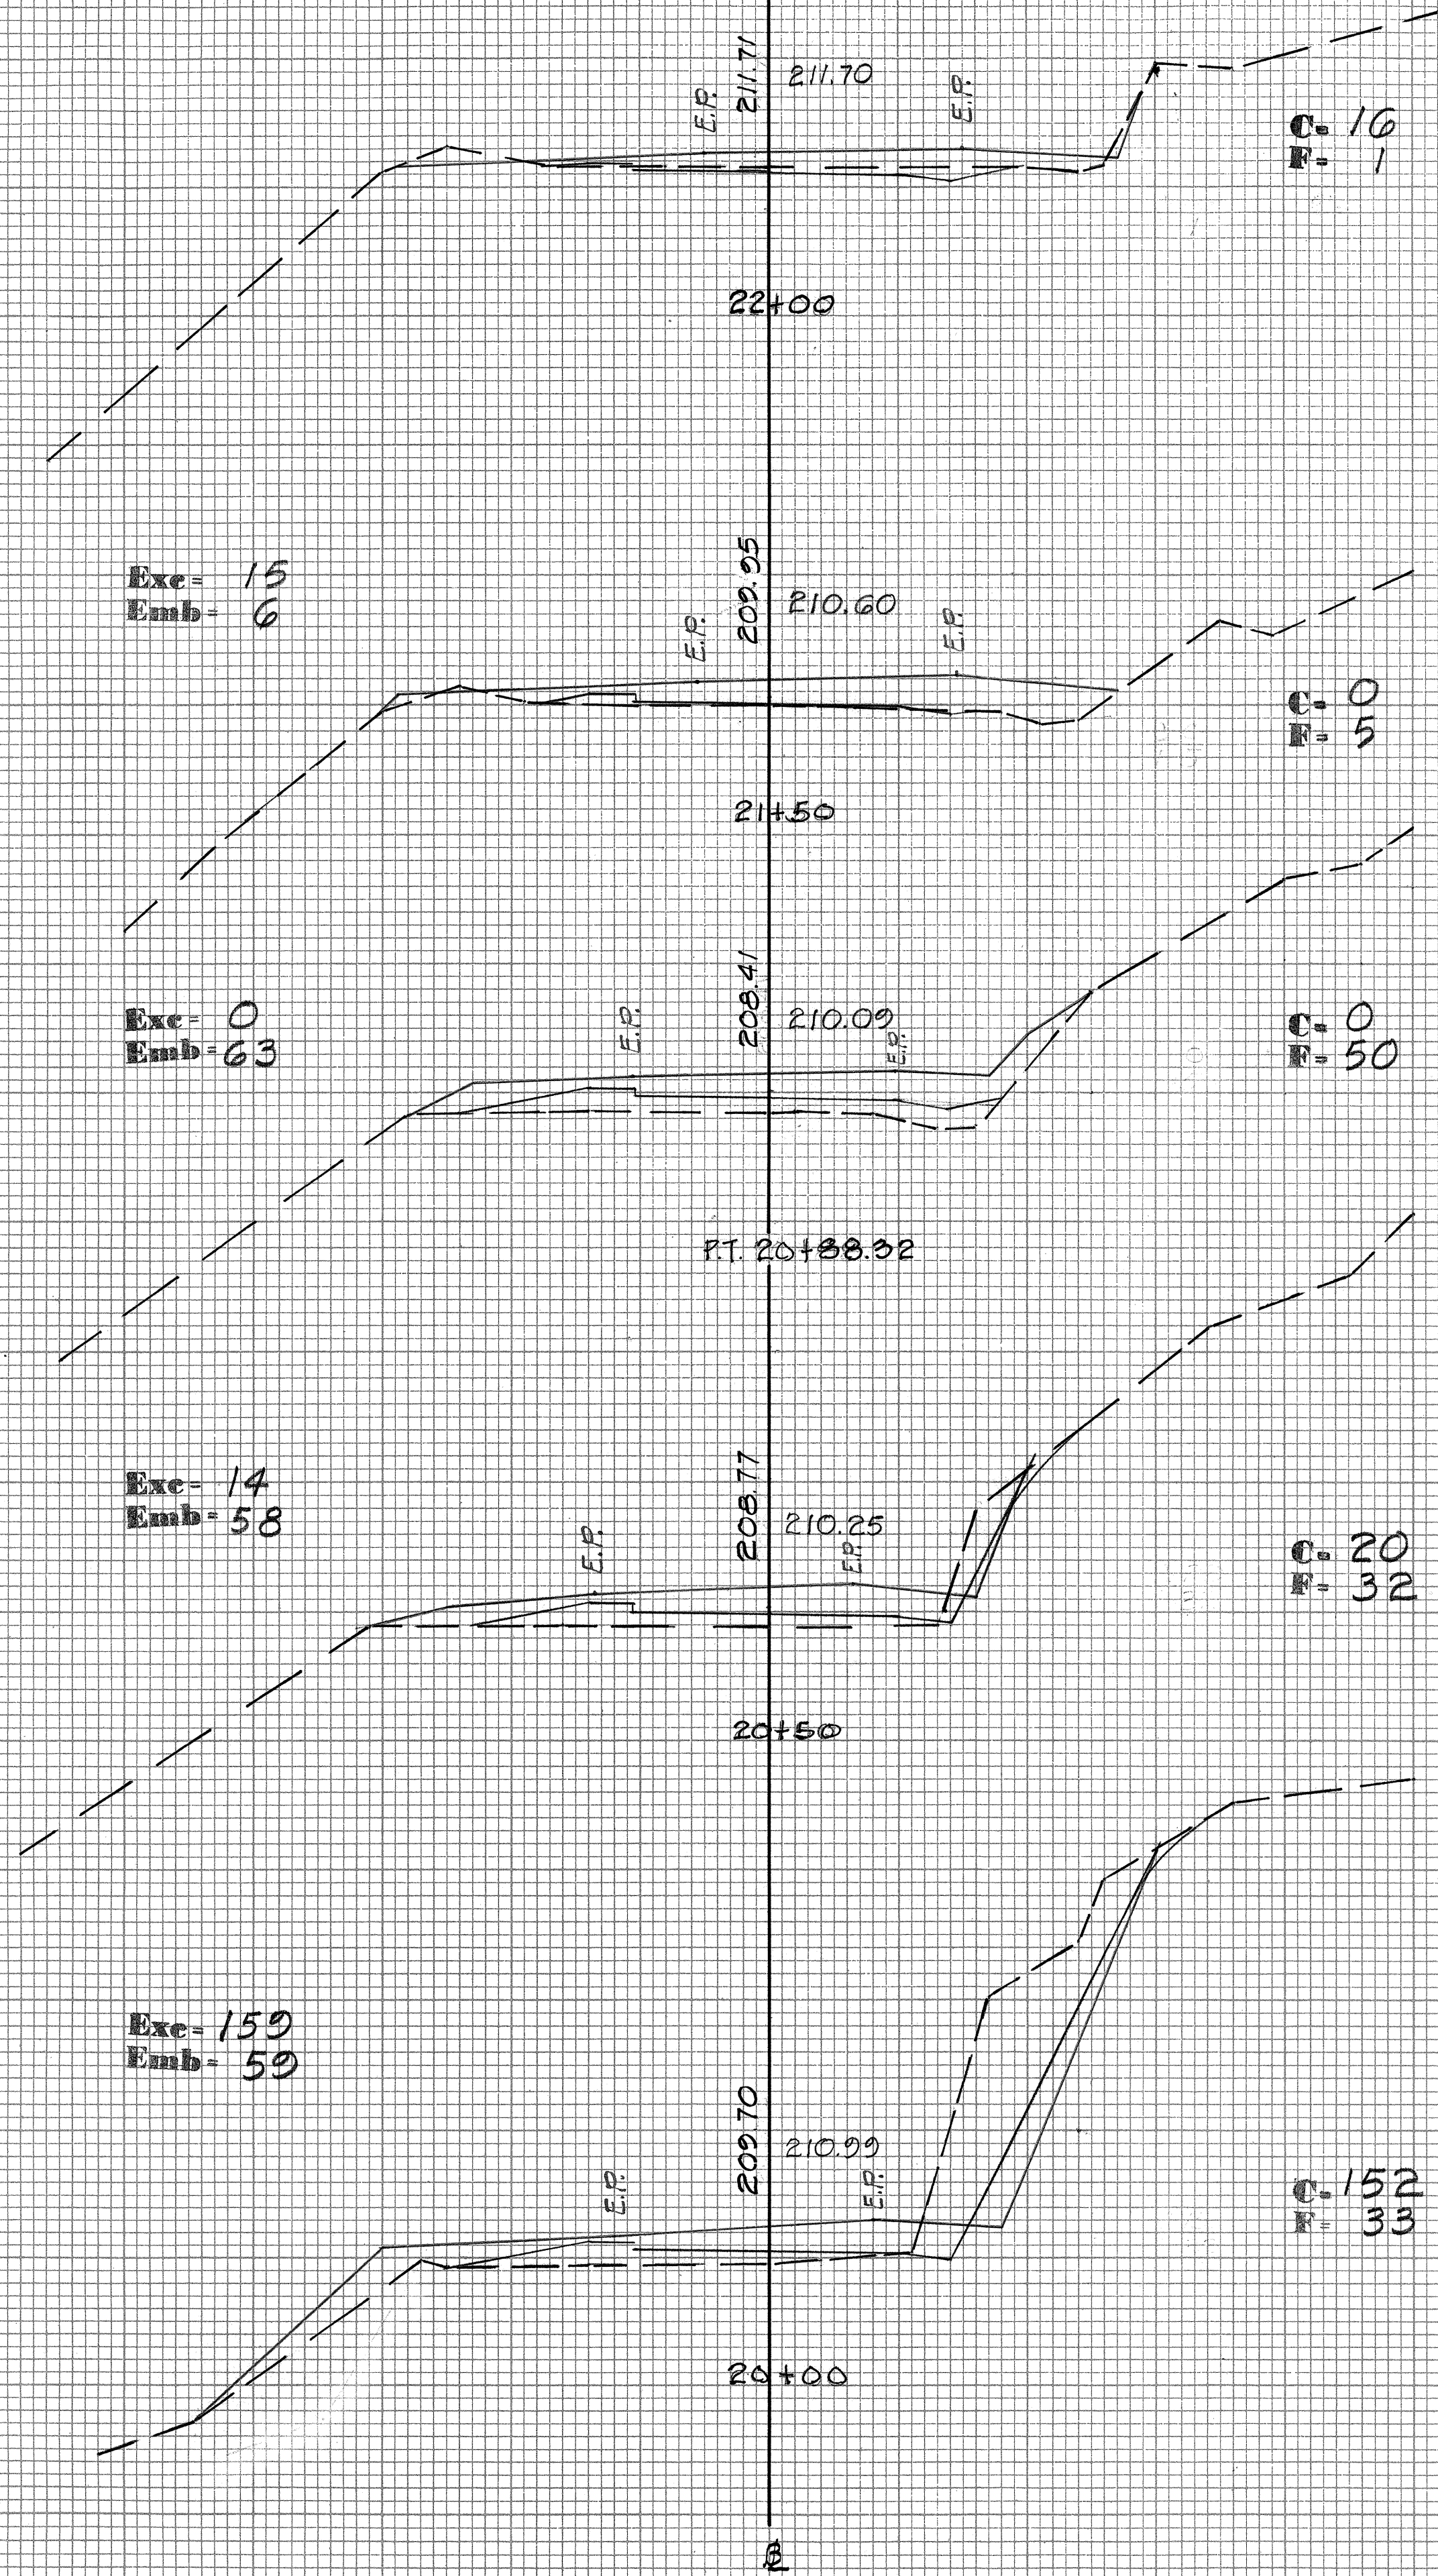

FED. ROAD DIST. NO.	STATE	PROJ. NO.	FISCAL YEAR	SHEET NO.	TOTAL SHEETS
HAWAII	HAW.	330C-03-70	1970	30	30

FINAL SURVEY NO.	SURVEYED BY	DATE
NOTE BOOK		
AREAS CHECKED		

ORIGINAL SURVEY NO.	SURVEYED BY	DATE
NOTE BOOK	P. S. Kug...	2-25-70
AREAS CHECKED		

