

INDEX TO DRAWINGS	
SHEET NO	DESCRIPTION
1	TITLE SHEET
2	TYPICAL SECTION
3 - 7	PLANS & PROFILE
8 - 18	MISC. & STANDARD DETAILS
19 - 23	DRAINAGE DETAILS
24 - 30	CROSS SECTIONS

STATE OF HAWAII

DEPARTMENT OF TRANSPORTATION

HIGHWAYS DIVISION

HONOLULU, HAWAII

" AS BUILT " PLANS OF



KAHEKILI HIGHWAY

HONOKOHAU STREAM TO POELUA GULCH

PROJECT NO. 330C-03-70

DISTRICT OF LAHAINA & WAILUKU

ISLAND OF MAUI

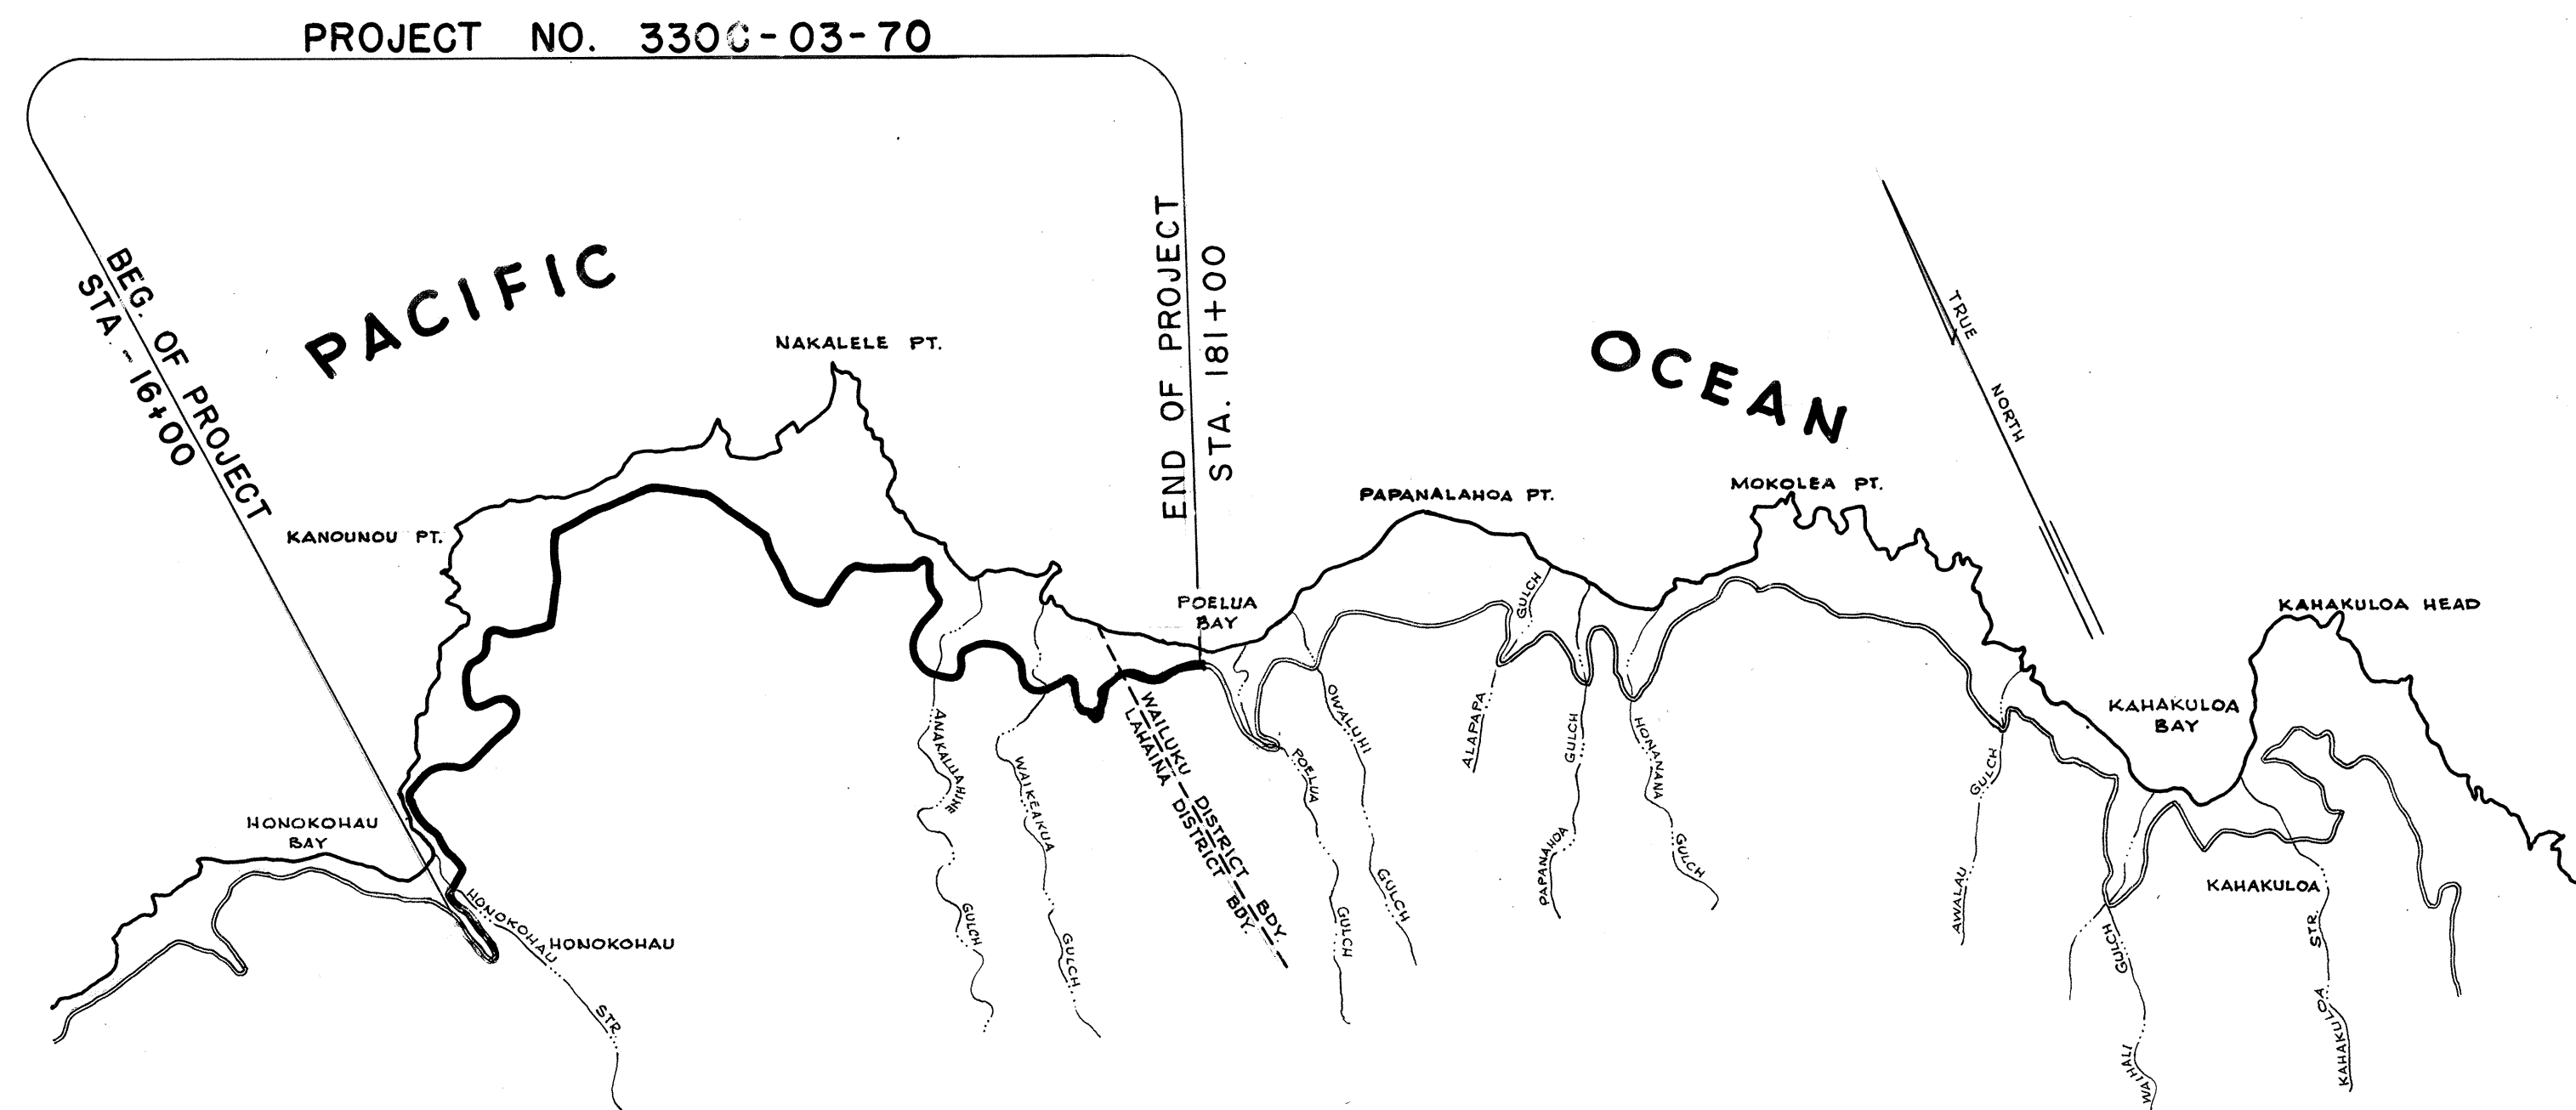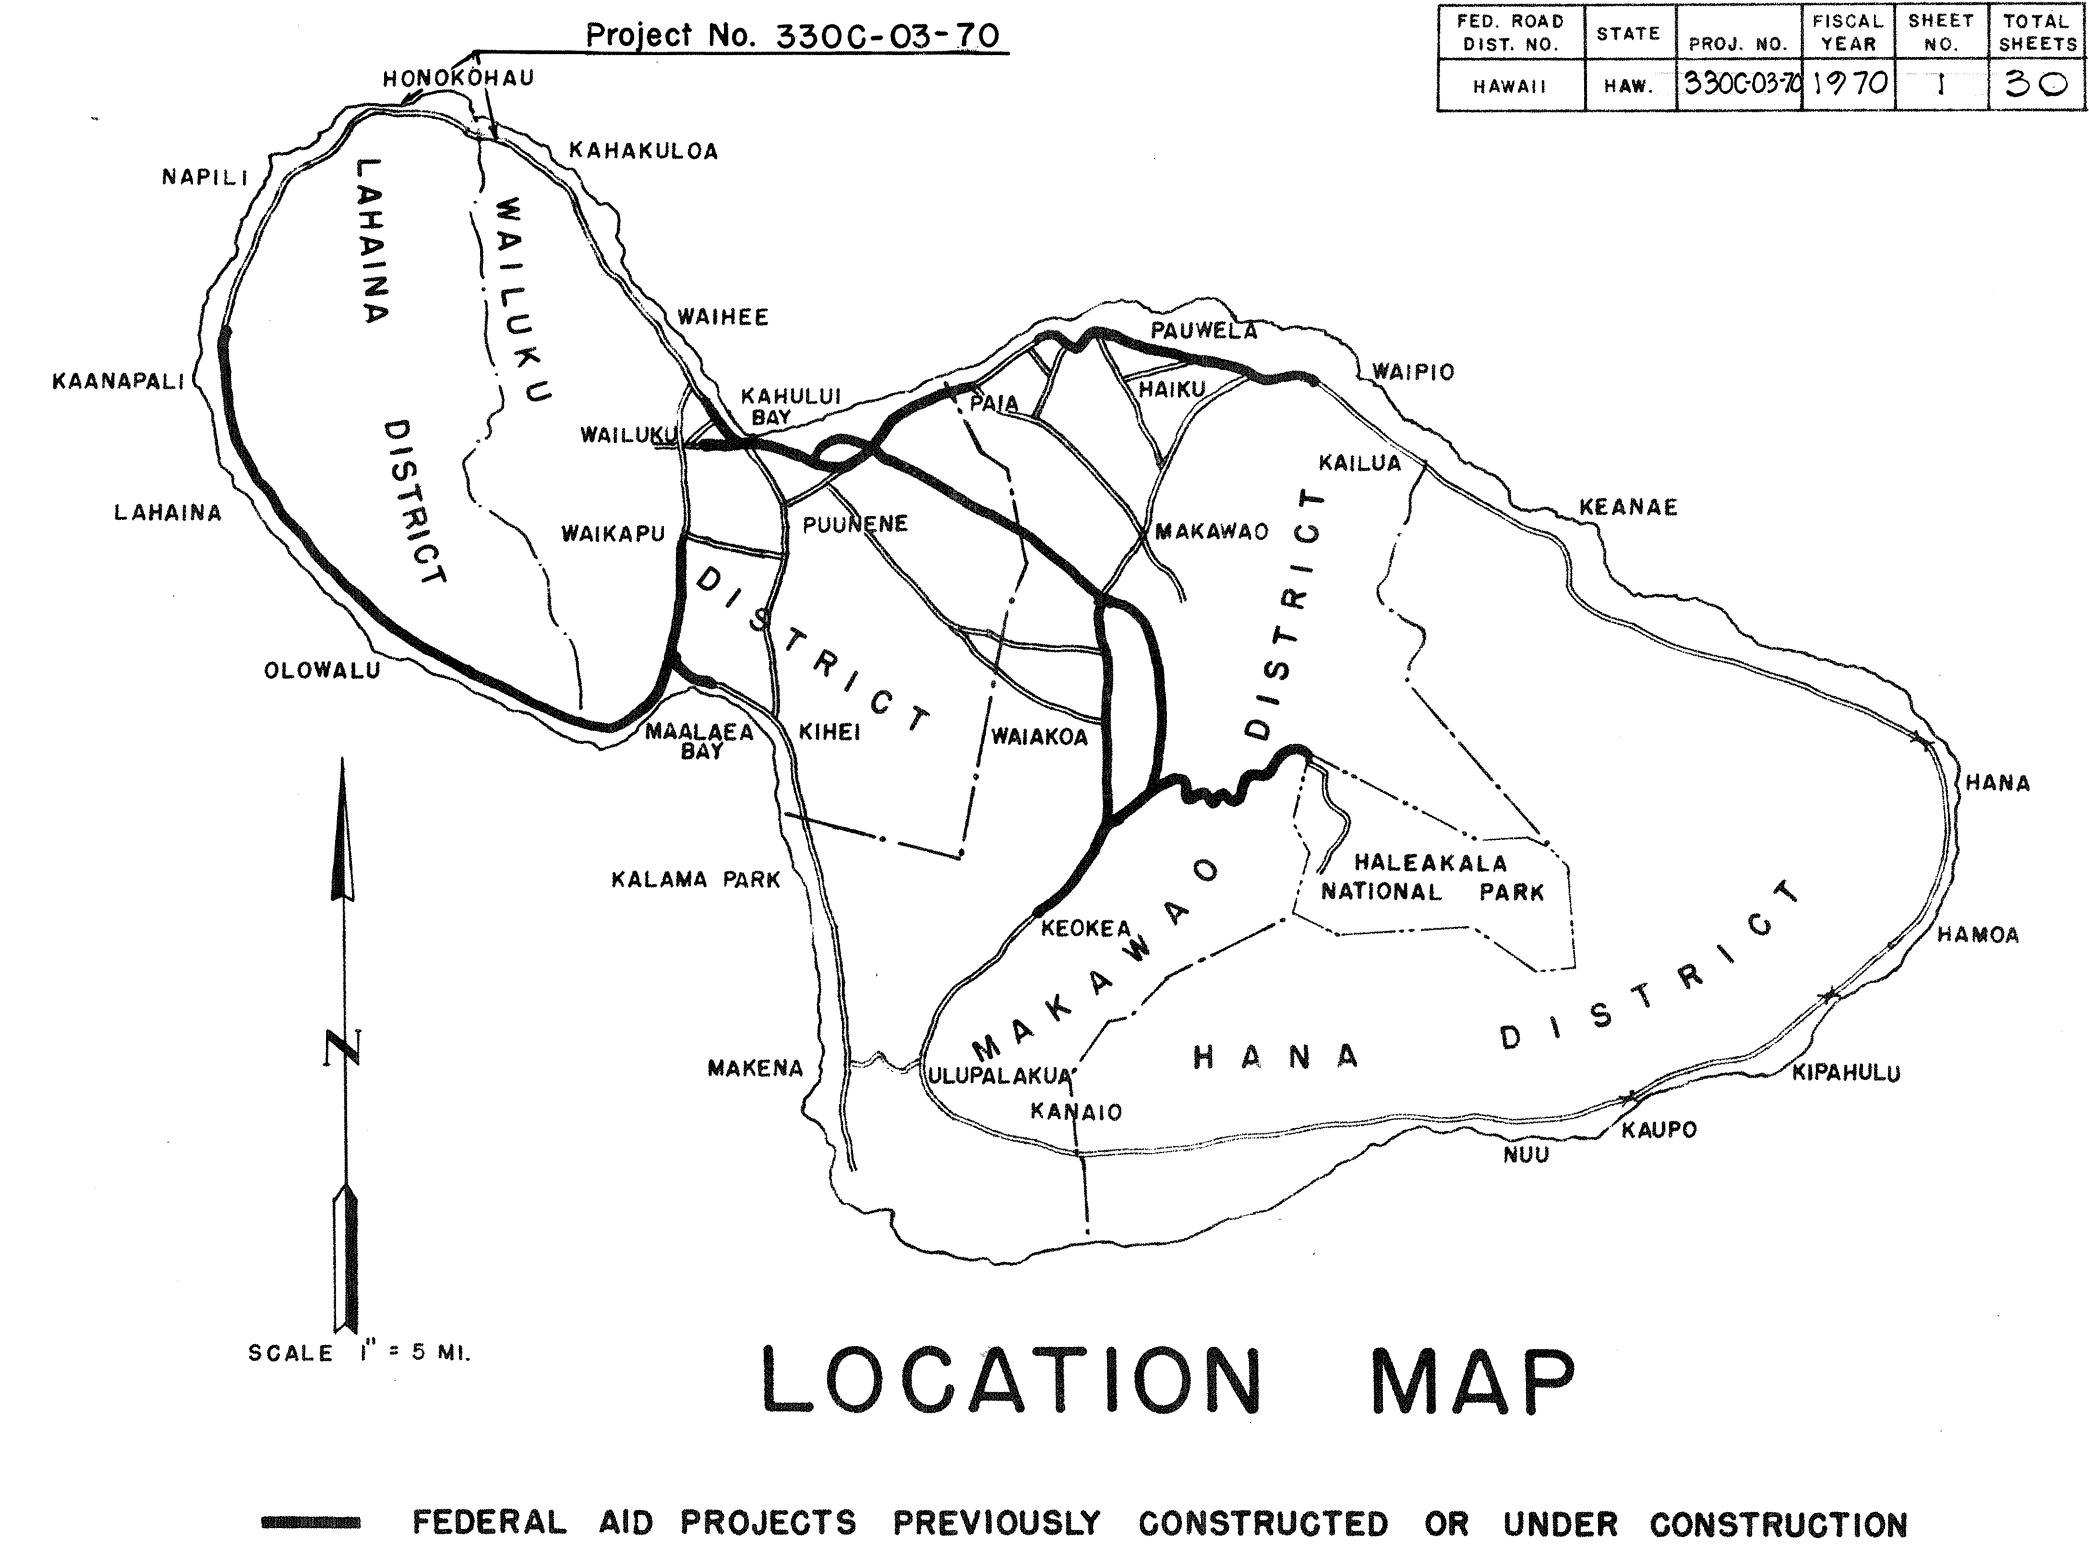

NOTE :

ALL CHANGES MADE DURING CONSTRUCTION HAVE BEEN NOTED IN RED ON THESE TRACINGS AND CHECKED BY

S. J. Murakami

PROJECT ENGINEER

8/30/72

DATE

All the quantities shown on these plans are original theoretical quantities. For actual quantities, refer to project ledger and /or computation book.

DEPARTMENT OF TRANSPORTATION STATE OF HAWAII	
APPROVED:	
<i>E. J. J. J. J.</i>	7/29/70
DIRECTOR OF TRANSPORTATION	DATE

JUNE 1970

MAUI DISTRICT

HWY. DESIGN UNIT

D. BEVIER

DESIGN ENGR