

INDEX TO DRAWINGS	
SHEET NO	DESCRIPTION
1	TITLE SHEET
2	RAISED PAVEMENT MARKERS
3	PROJECT INFORMATION SIGN

STATE OF HAWAII

DEPARTMENT OF TRANSPORTATION

HIGHWAYS DIVISION

HONOLULU, HAWAII

"AS BUILT" PLANS OF

RESURFACING A PORTION OF HONOAPIILANI HIGHWAY

2.0 MILES SOUTHWEST OF WAIKAPU TOWARDS Mc GREGOR POINT

PROJECT NO. 30 BC-01-71

GENERAL NOTES:


- The existing paved roadway shall be cleaned according to Section 310 of the Standard Specifications.
- Dressing at the shoulder area shall be done with material approved by the Engineer. The shoulders shall be cut or filled, graded, watered and rolled as directed by the Engineer. Payment incidental to A.C. Pavement.
- All chuck holes and large depressions, if any, shall be filled and compacted with A.C. Pavement prior to resurfacing.

DISTRICT OF WAILUKU

ISLAND OF MAUI


SCALES

PLAN	1 IN. =	FT.
PROFILE	HOR. 1 IN. =	FT.
	VER. 1 IN. =	FT.
X-SECTIONS	HOR. 1 IN. =	FT.
	VER. 1 IN. =	FT.

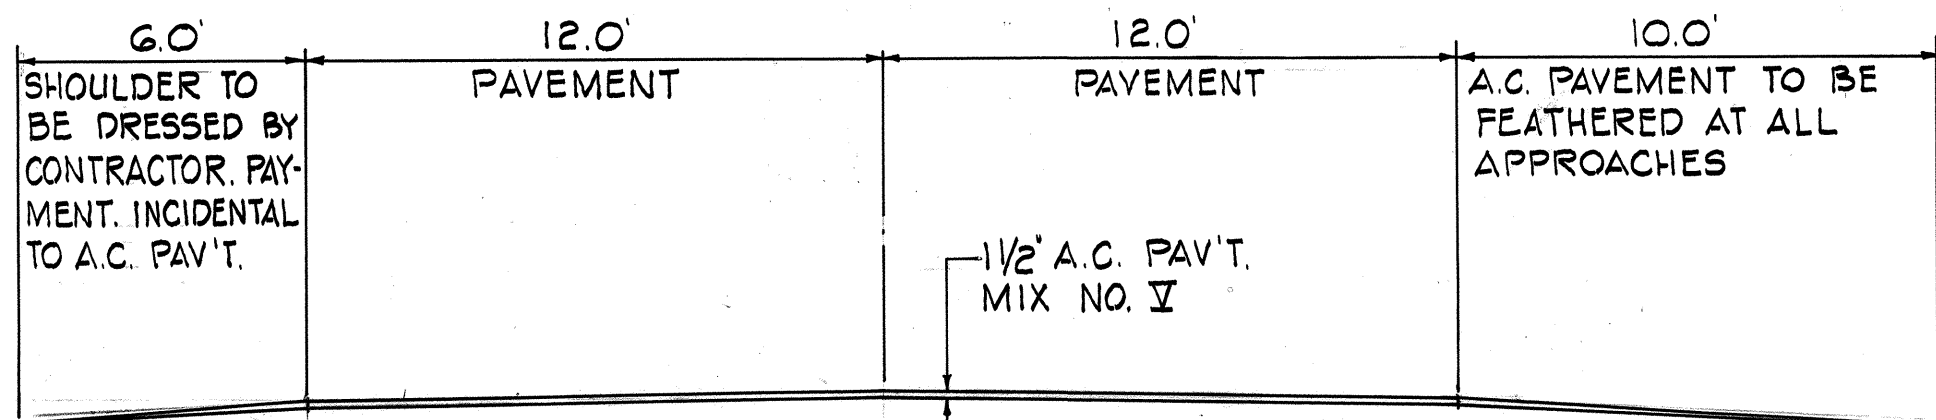

TYPICAL SECTION


SCALE: 1/4" = 1'-0"

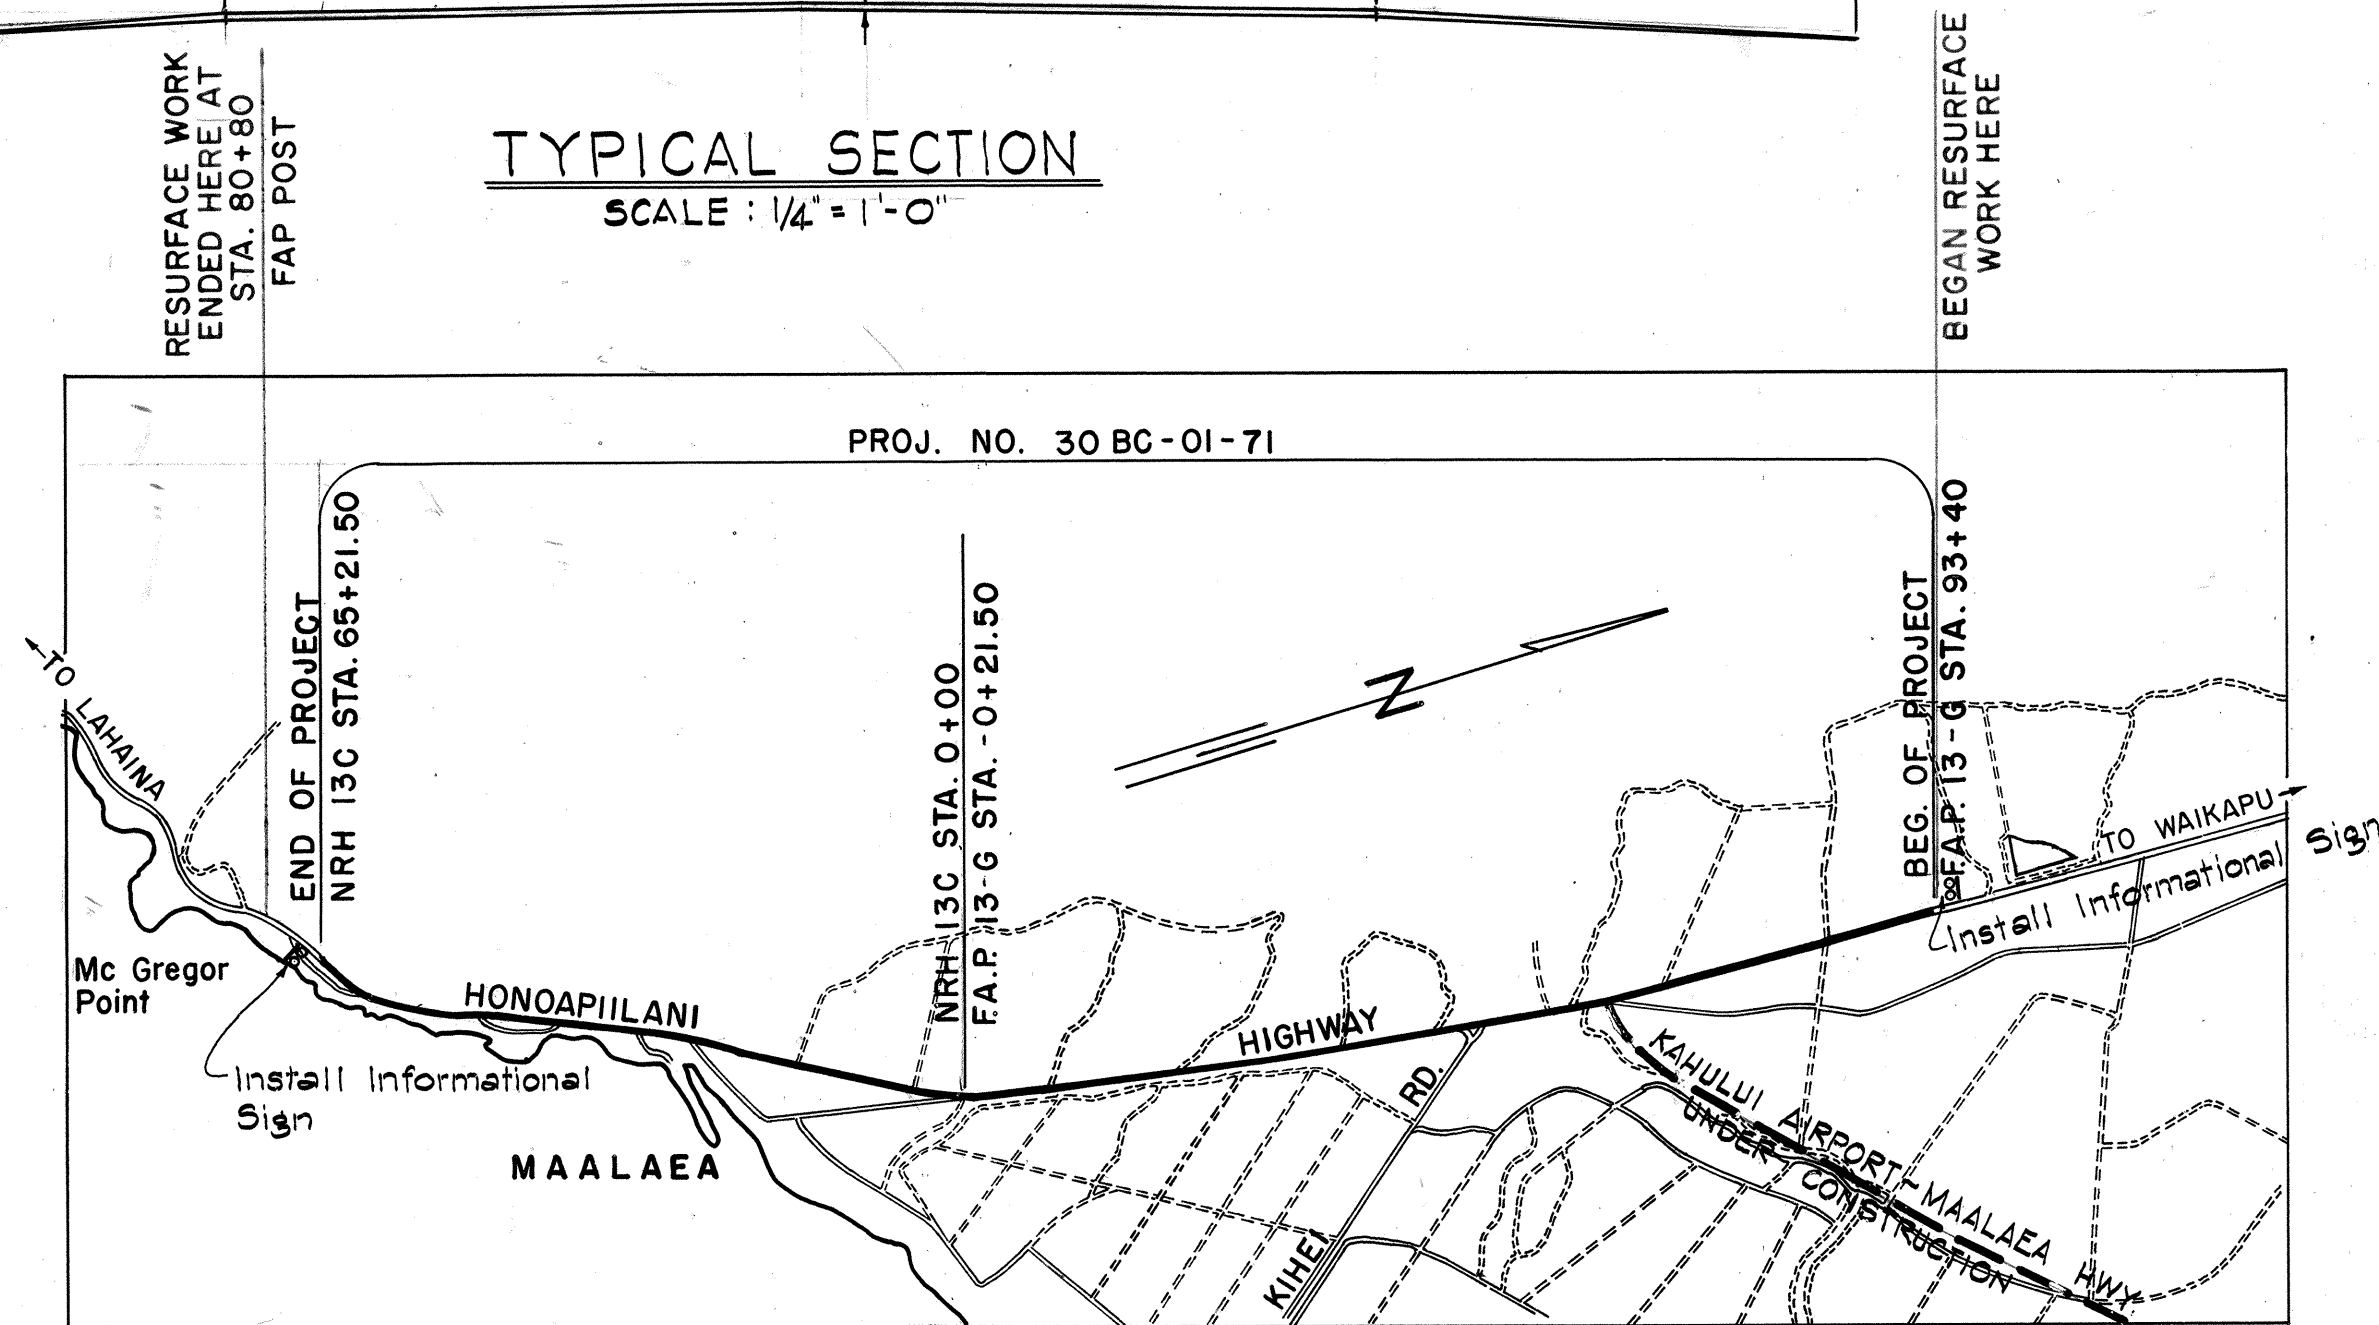

LAYOUT OF PROJECT

SCALE: 1" = 2000'

LENGTH OF PROJECT 3.00 MI.

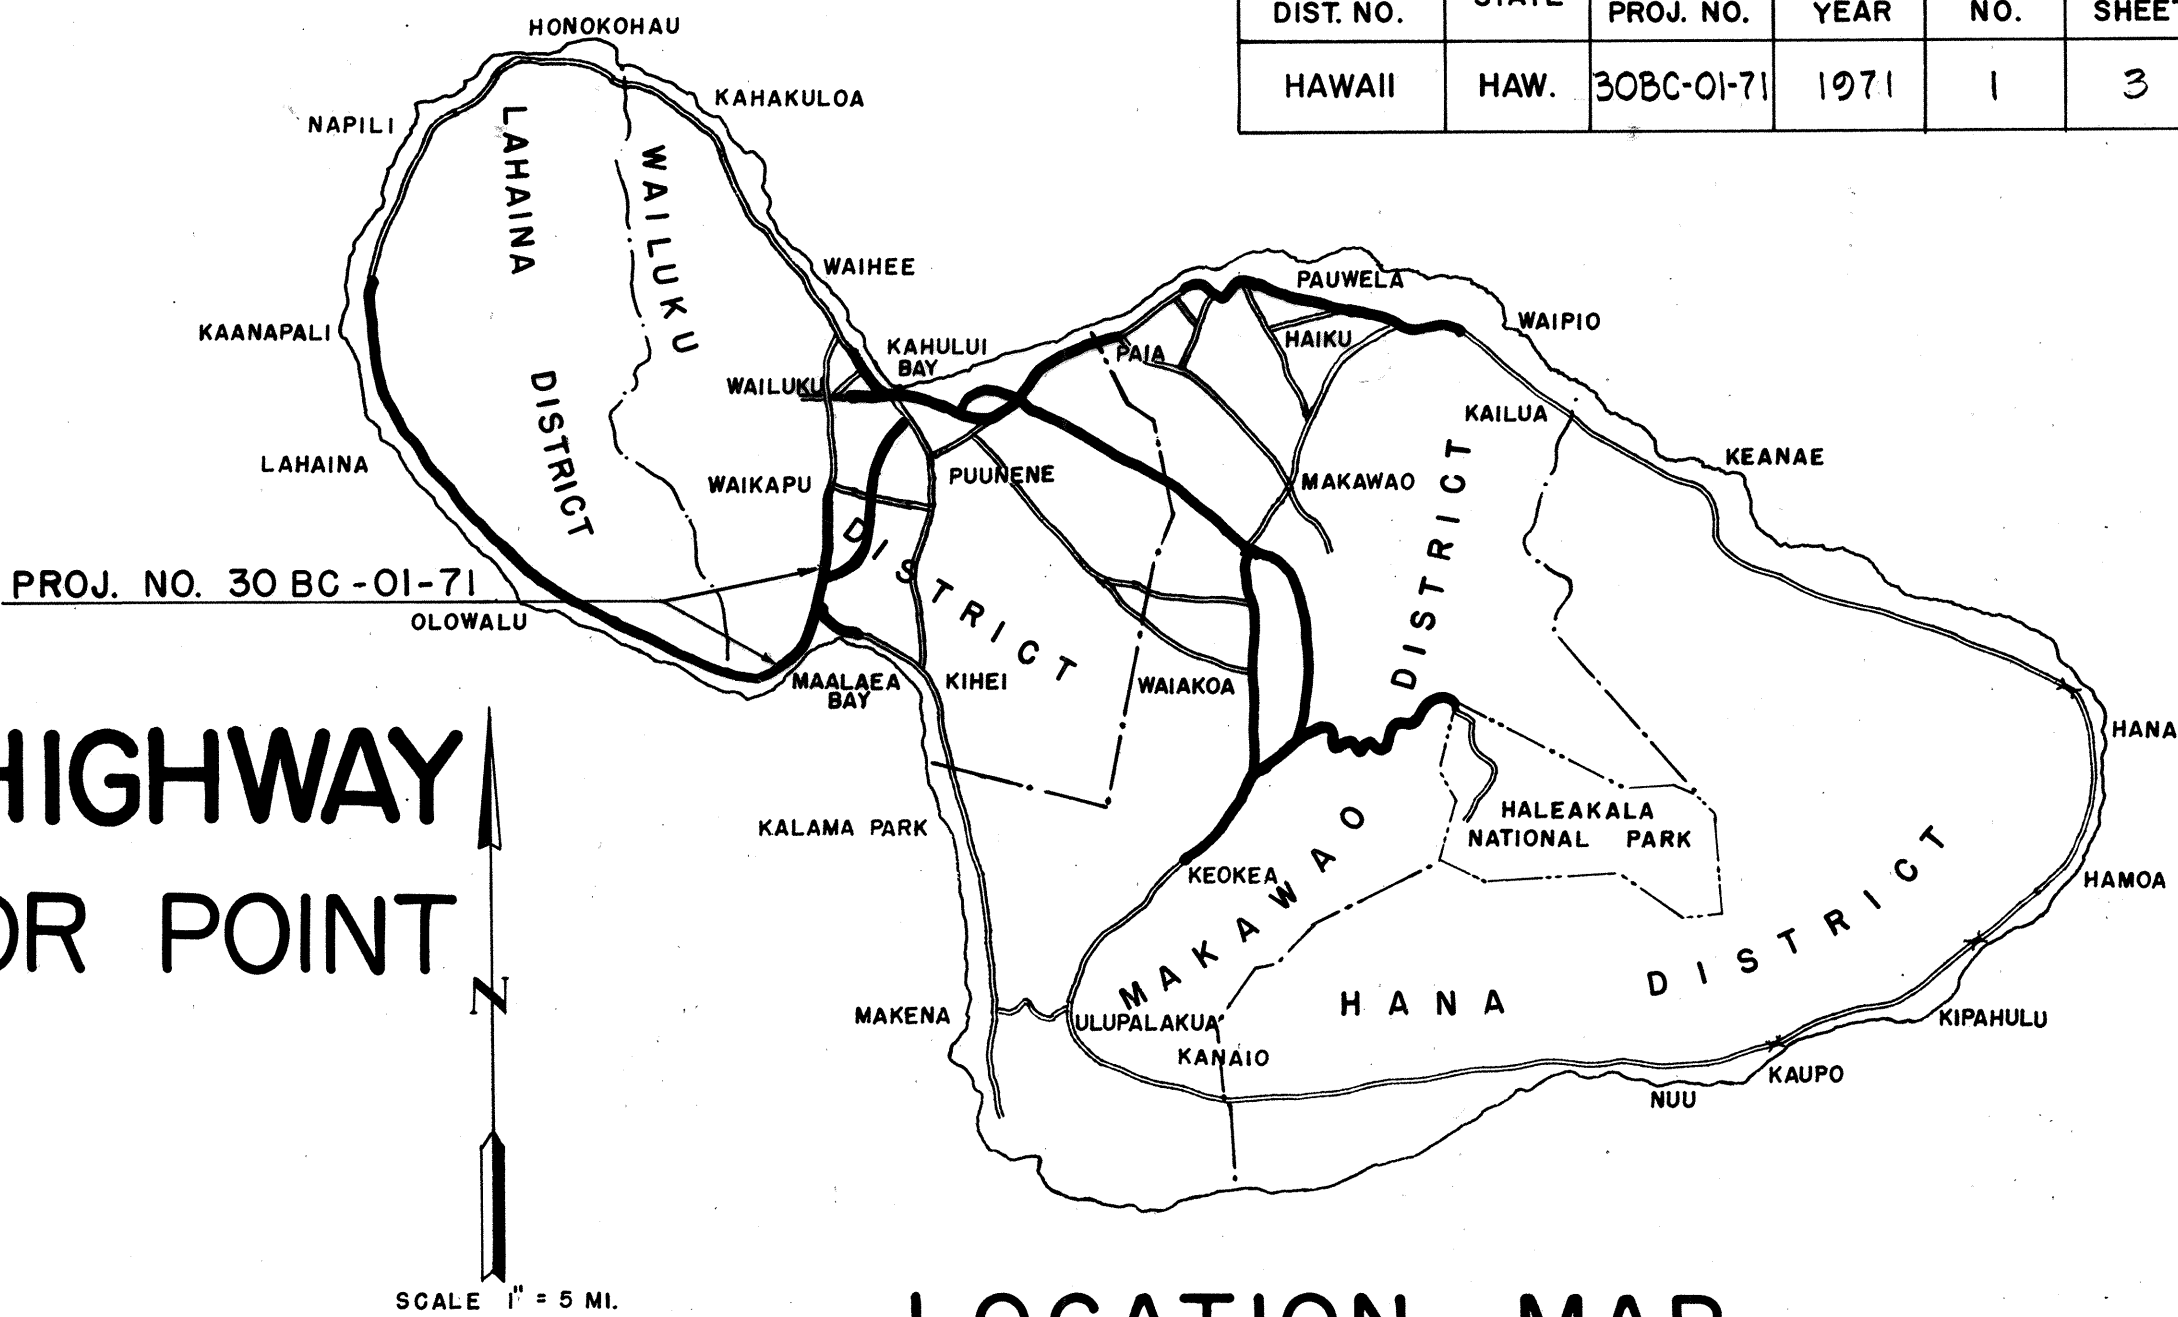

LOCATION MAP

FEDERAL AID PROJECTS PREVIOUSLY CONSTRUCTED OR UNDER CONSTRUCTION

ESTIMATED QUANTITIES

ASPHALT CONCRETE PAVEMENT, MIX NO. V	3,800	TONS
EMULSIFIED ASPHALT FOR BITUMINOUS TACK COAT	8,500	GALS.
TYPE B PAVEMENT MARKERS	150	EACH
TYPE D PAVEMENT MARKERS	54	EACH
TYPE E PAVEMENT MARKERS	52	EACH

PAVEMENT MARKERS SUMMARY

LAHAINA - WAILUKU ROAD, MAALAEA - WAILUKU SECTION F.A.P. PROJECT NO. 13-G			
STA. 93+40	TO	STA. 50+21	TYPE B
STA. 50+21	TO	STA. 46+76	TYPE E
STA. 46+33	TO	STA. 42+28	TYPE D
STA. 41+63	TO	STA. 37+86	TYPE E
STA. 37+86	TO	STA. 0+21.50	TYPE B

LAHAINA - WAILUKU ROAD, U.S. PUBLIC WORKS PROJECT NO. NRH 13C			
STA. 0+00	TO	STA. 2+00	TYPE B
STA. 2+00	TO	STA. 5+45	TYPE E
STA. 5+95	TO	STA. 9+44	TYPE E
STA. 9+44	TO	STA. 33+95	TYPE B
STA. 33+95	TO	STA. 47+85	TYPE E
STA. 48+26	TO	STA. 65+21.50	TYPE D

DELETED BY C.O. #1

NOTE:

ALL CHANGES MADE DURING CONSTRUCTION

HAVE BEEN NOTED IN RED ON THESE TRACINGS

AND CHECKED BY:

PROJECT ENGINEER

DATE

DEPARTMENT OF TRANSPORTATION

STATE OF HAWAII

APPROVED:

G. Alvey Wright 11/30/70

DIRECTOR OF TRANSPORTATION DATE

DESIGNED BY: MAUI DISTRICT OFFICE

STATE HIGHWAYS DIVISION

DATE: OCT. 1970

D. Bevier