


FED. ROAD DIST. NO.	STATE	PROJ. NO.	FISCAL YEAR	SHEET NO.	TOTAL SHEETS
HAWAII	HAW.	303-02-69 UNIT II	1971	2	7

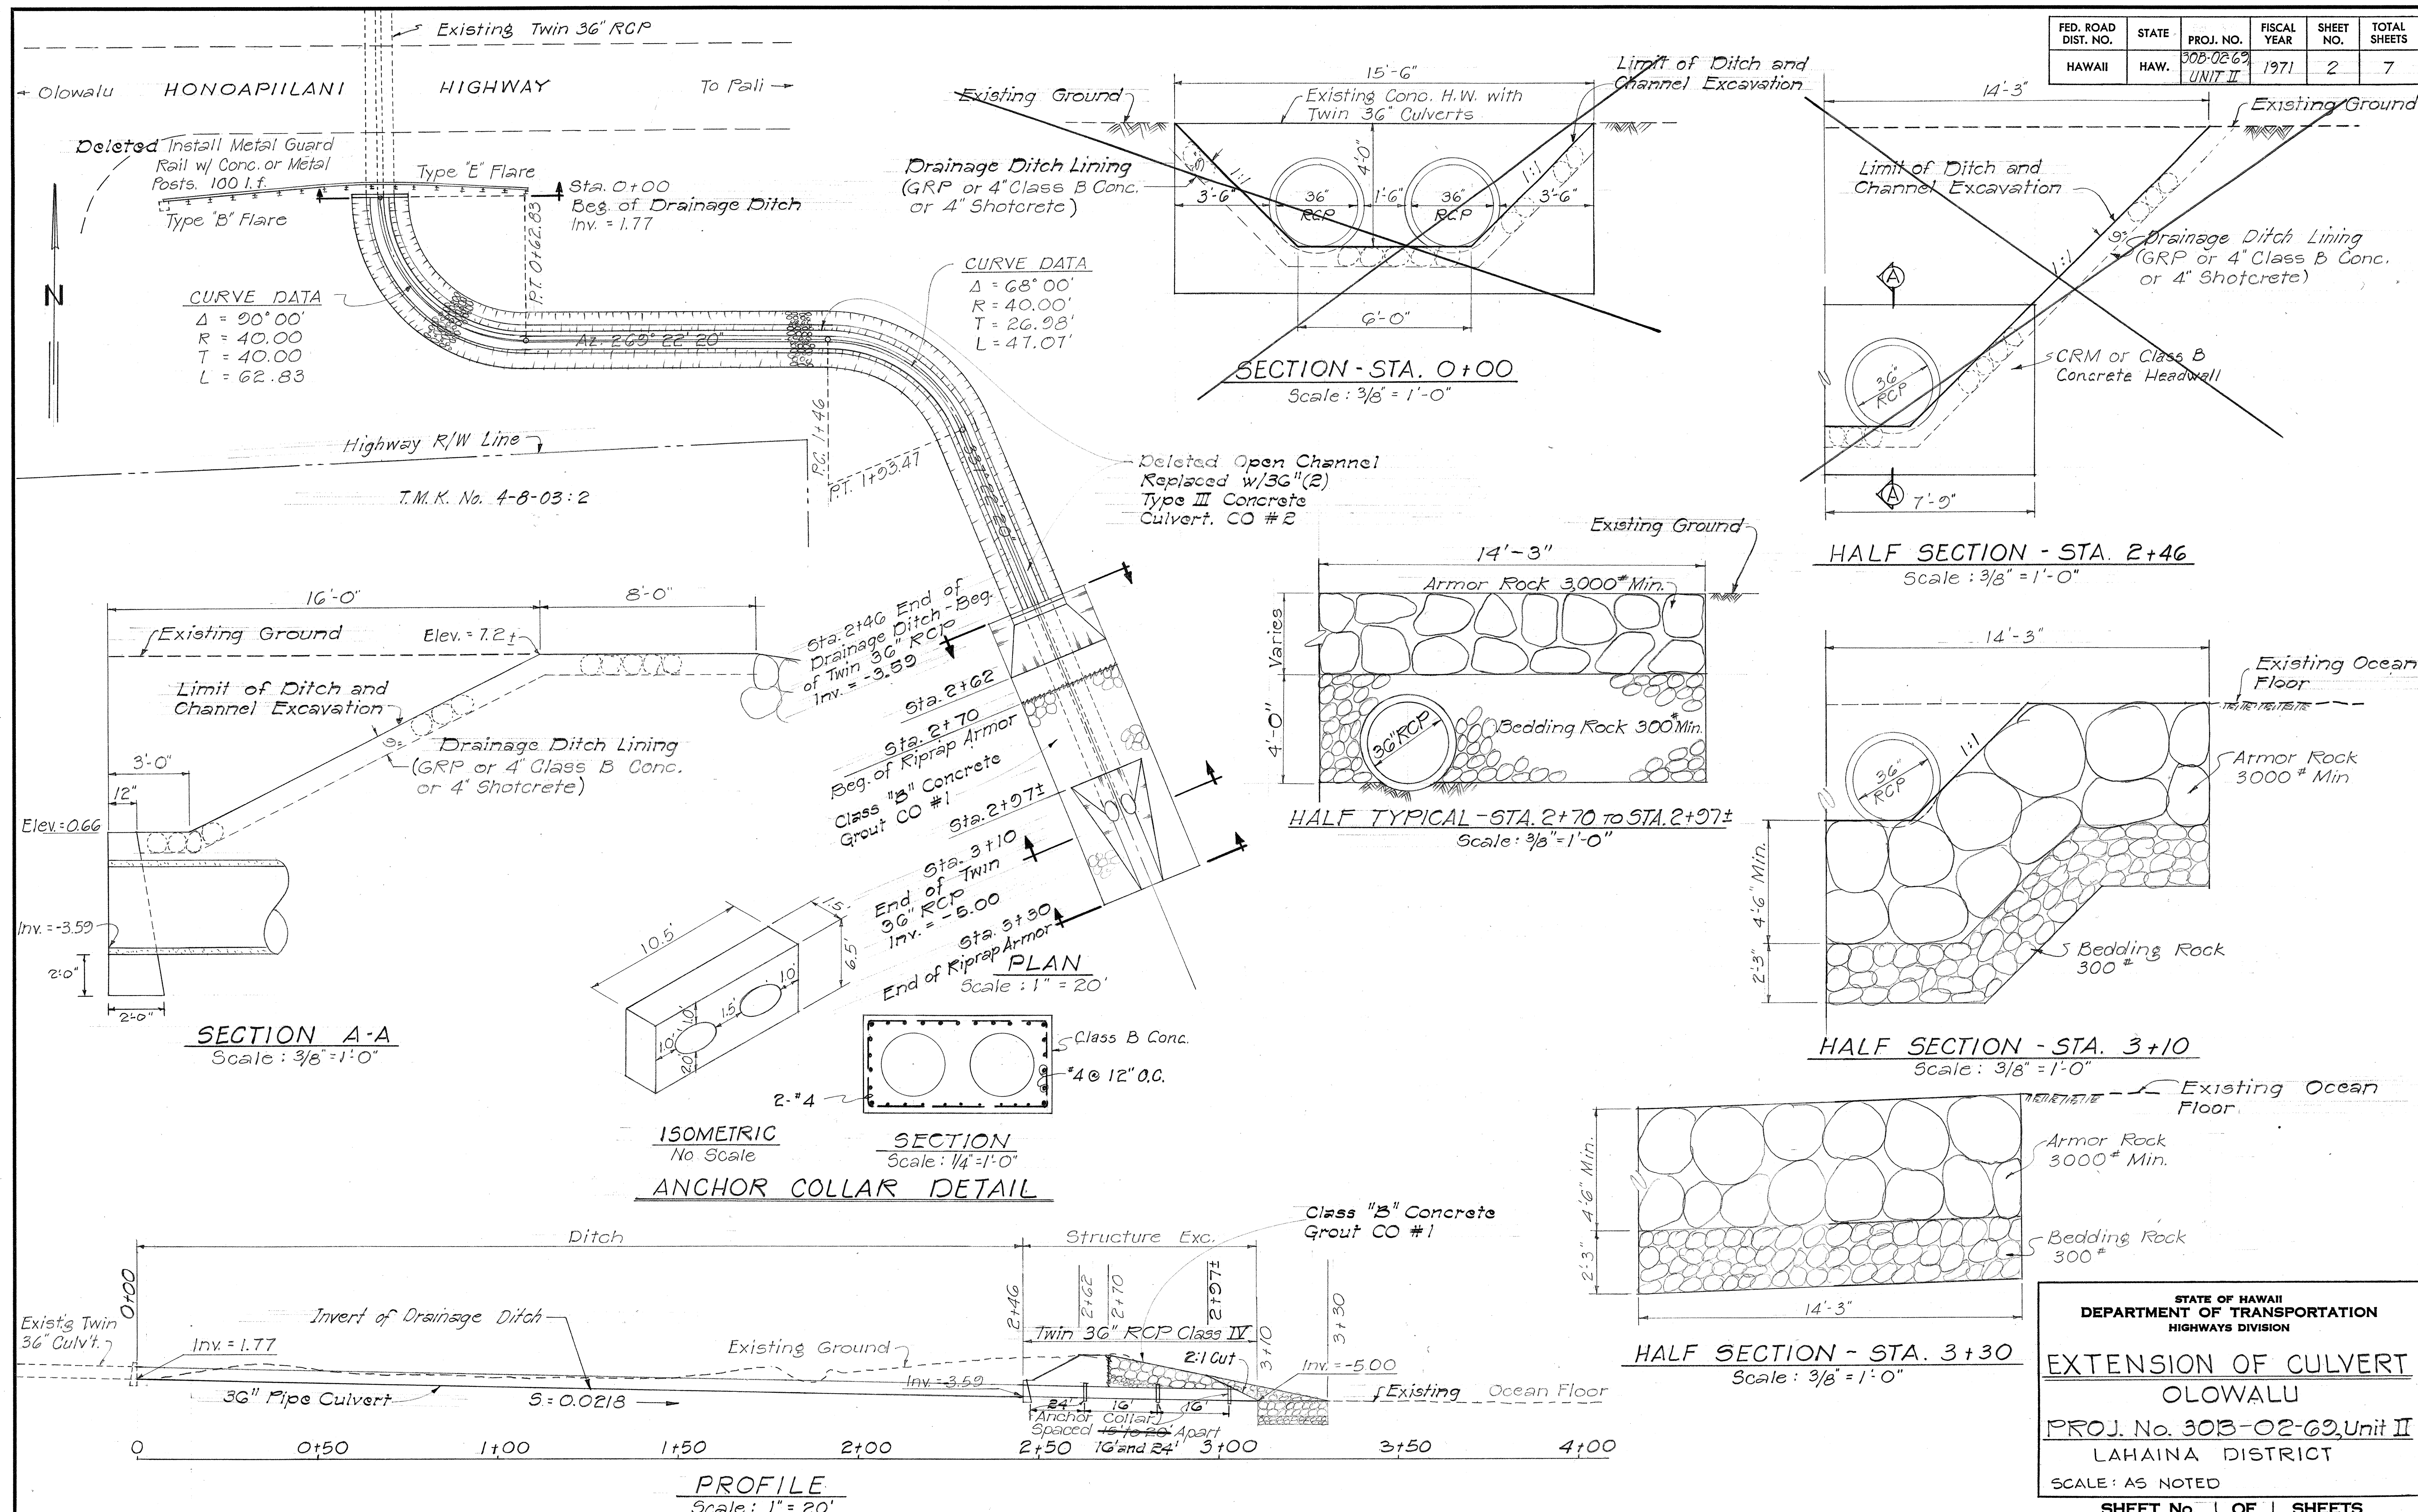

STATE OF HAWAII
DEPARTMENT OF TRANSPORTATION
HIGHWAYS DIVISION

EXTENSION OF CULVERT
LOWALU
PROJ. No. 303-02-69, Unit II
LAHAINA DISTRICT
SCALE: AS NOTED
SHEET No. 1 OF 1 SHEETS