




FED. ROAD DIST. NO.	STATE	PROJ. NO.	FISCAL YEAR	SHEET NO.	TOTAL SHEETS
HAWAII	HAW.	HWY.M-01-73	1973	2	6

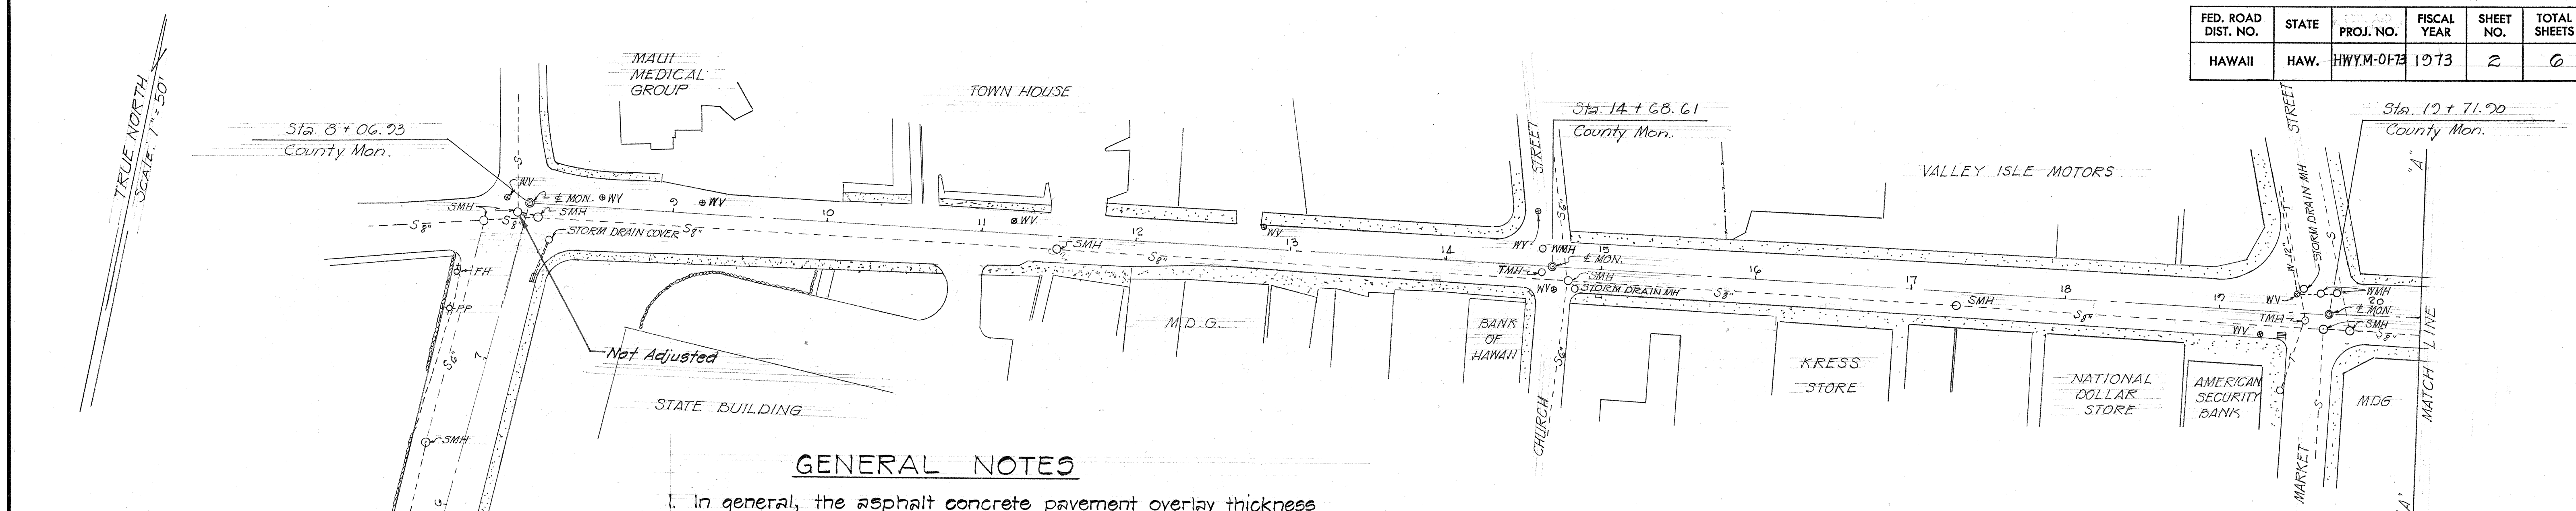

### GENERAL NOTES

- In general, the asphalt concrete pavement overlay thickness shall be 2 inches unless otherwise directed by the Engineer.
- The existing pavement shall be cleaned according to Section 310 of the Standard Specifications. Payment incidental to A.C. Pavement.
- All holes, cracks and large depressions encountered in the existing pavement shall be filled & compacted with A.C. Mix No. V prior to resurfacing. Payment incidental to A.C. Pavement.
- Frames & covers for manholes, electric handholes, survey monuments, catch basins, and water valves, whether exposed or previously covered by resurfacing or patching, shall be adjusted to new finish grade, as required by the Engineer.
- Remove existing pavement at drain inlets and irregular areas, as designated in the field by the Engineer.
- Smooth riding transitions shall be provided at the beginning and end of the project and at all connecting driveways and streets, as required by the Engineer.
- Cross walks, centerlines, lane lines, and all other painted markings shall be done by others.
- Location of pavement markers shall be staked out by the Engineer.
- The Contractor's attention is directed to Subsection 107.13 of the Special Provisions concerning traffic flow during peak and off-peak traffic hours.

Elect. Handhole,  
Type 57 (5'-0" x 7'-0")  
Remove & Replace  
Riser Neck to required  
elevation. See Details  
on Sht. No. 4

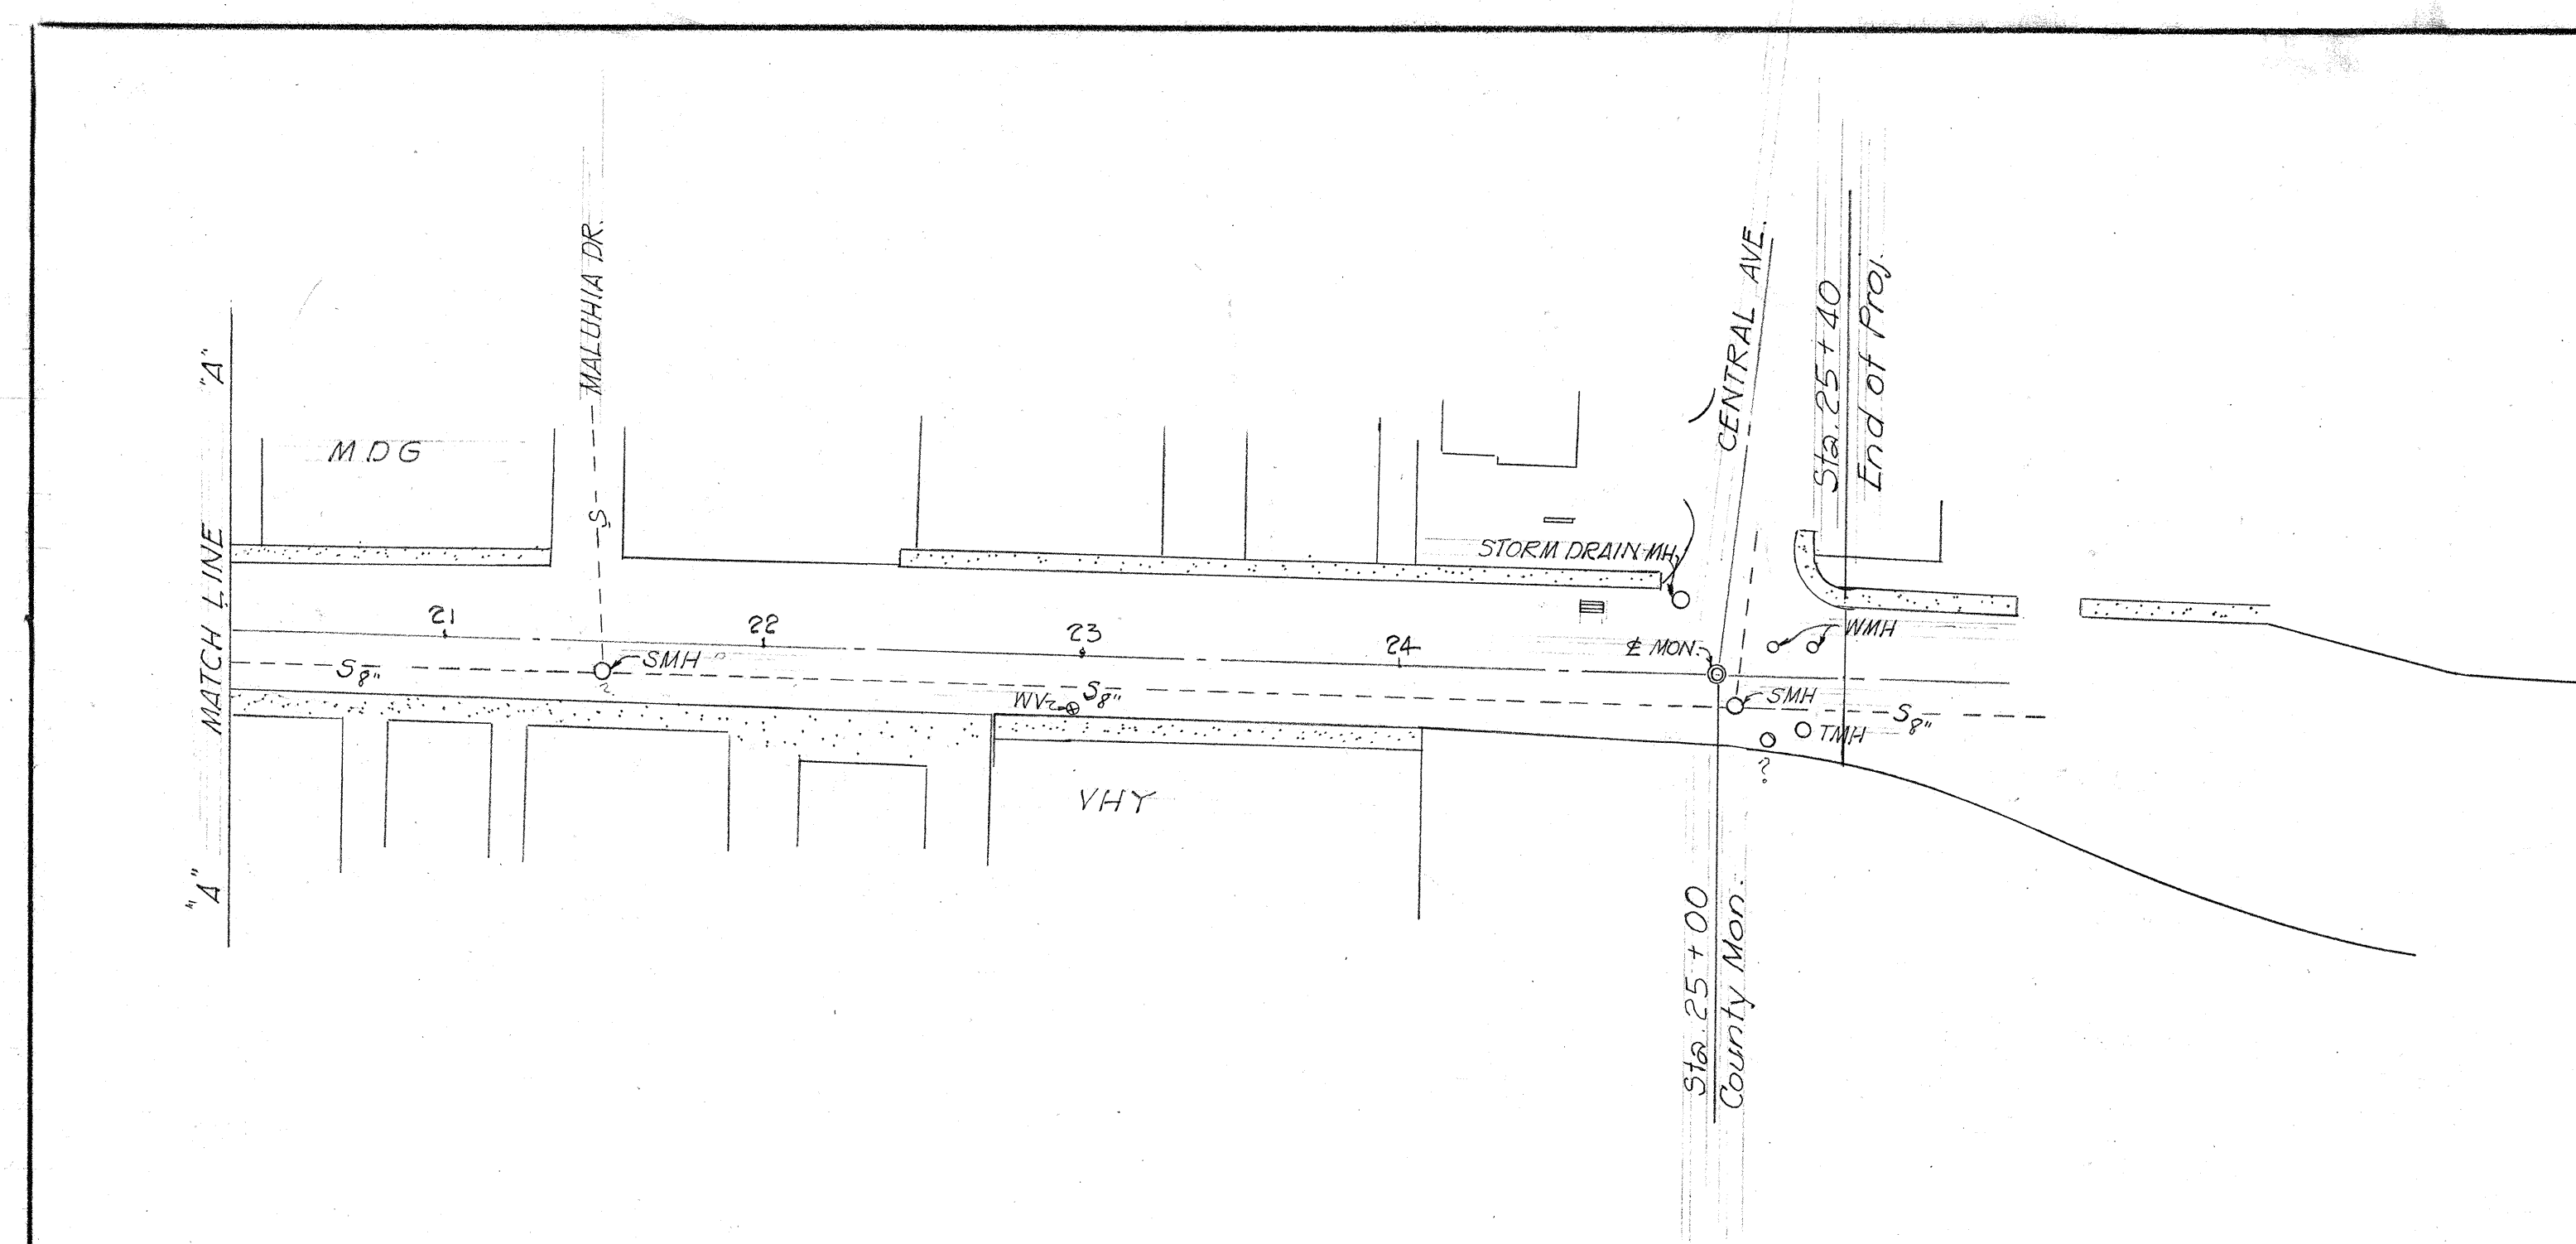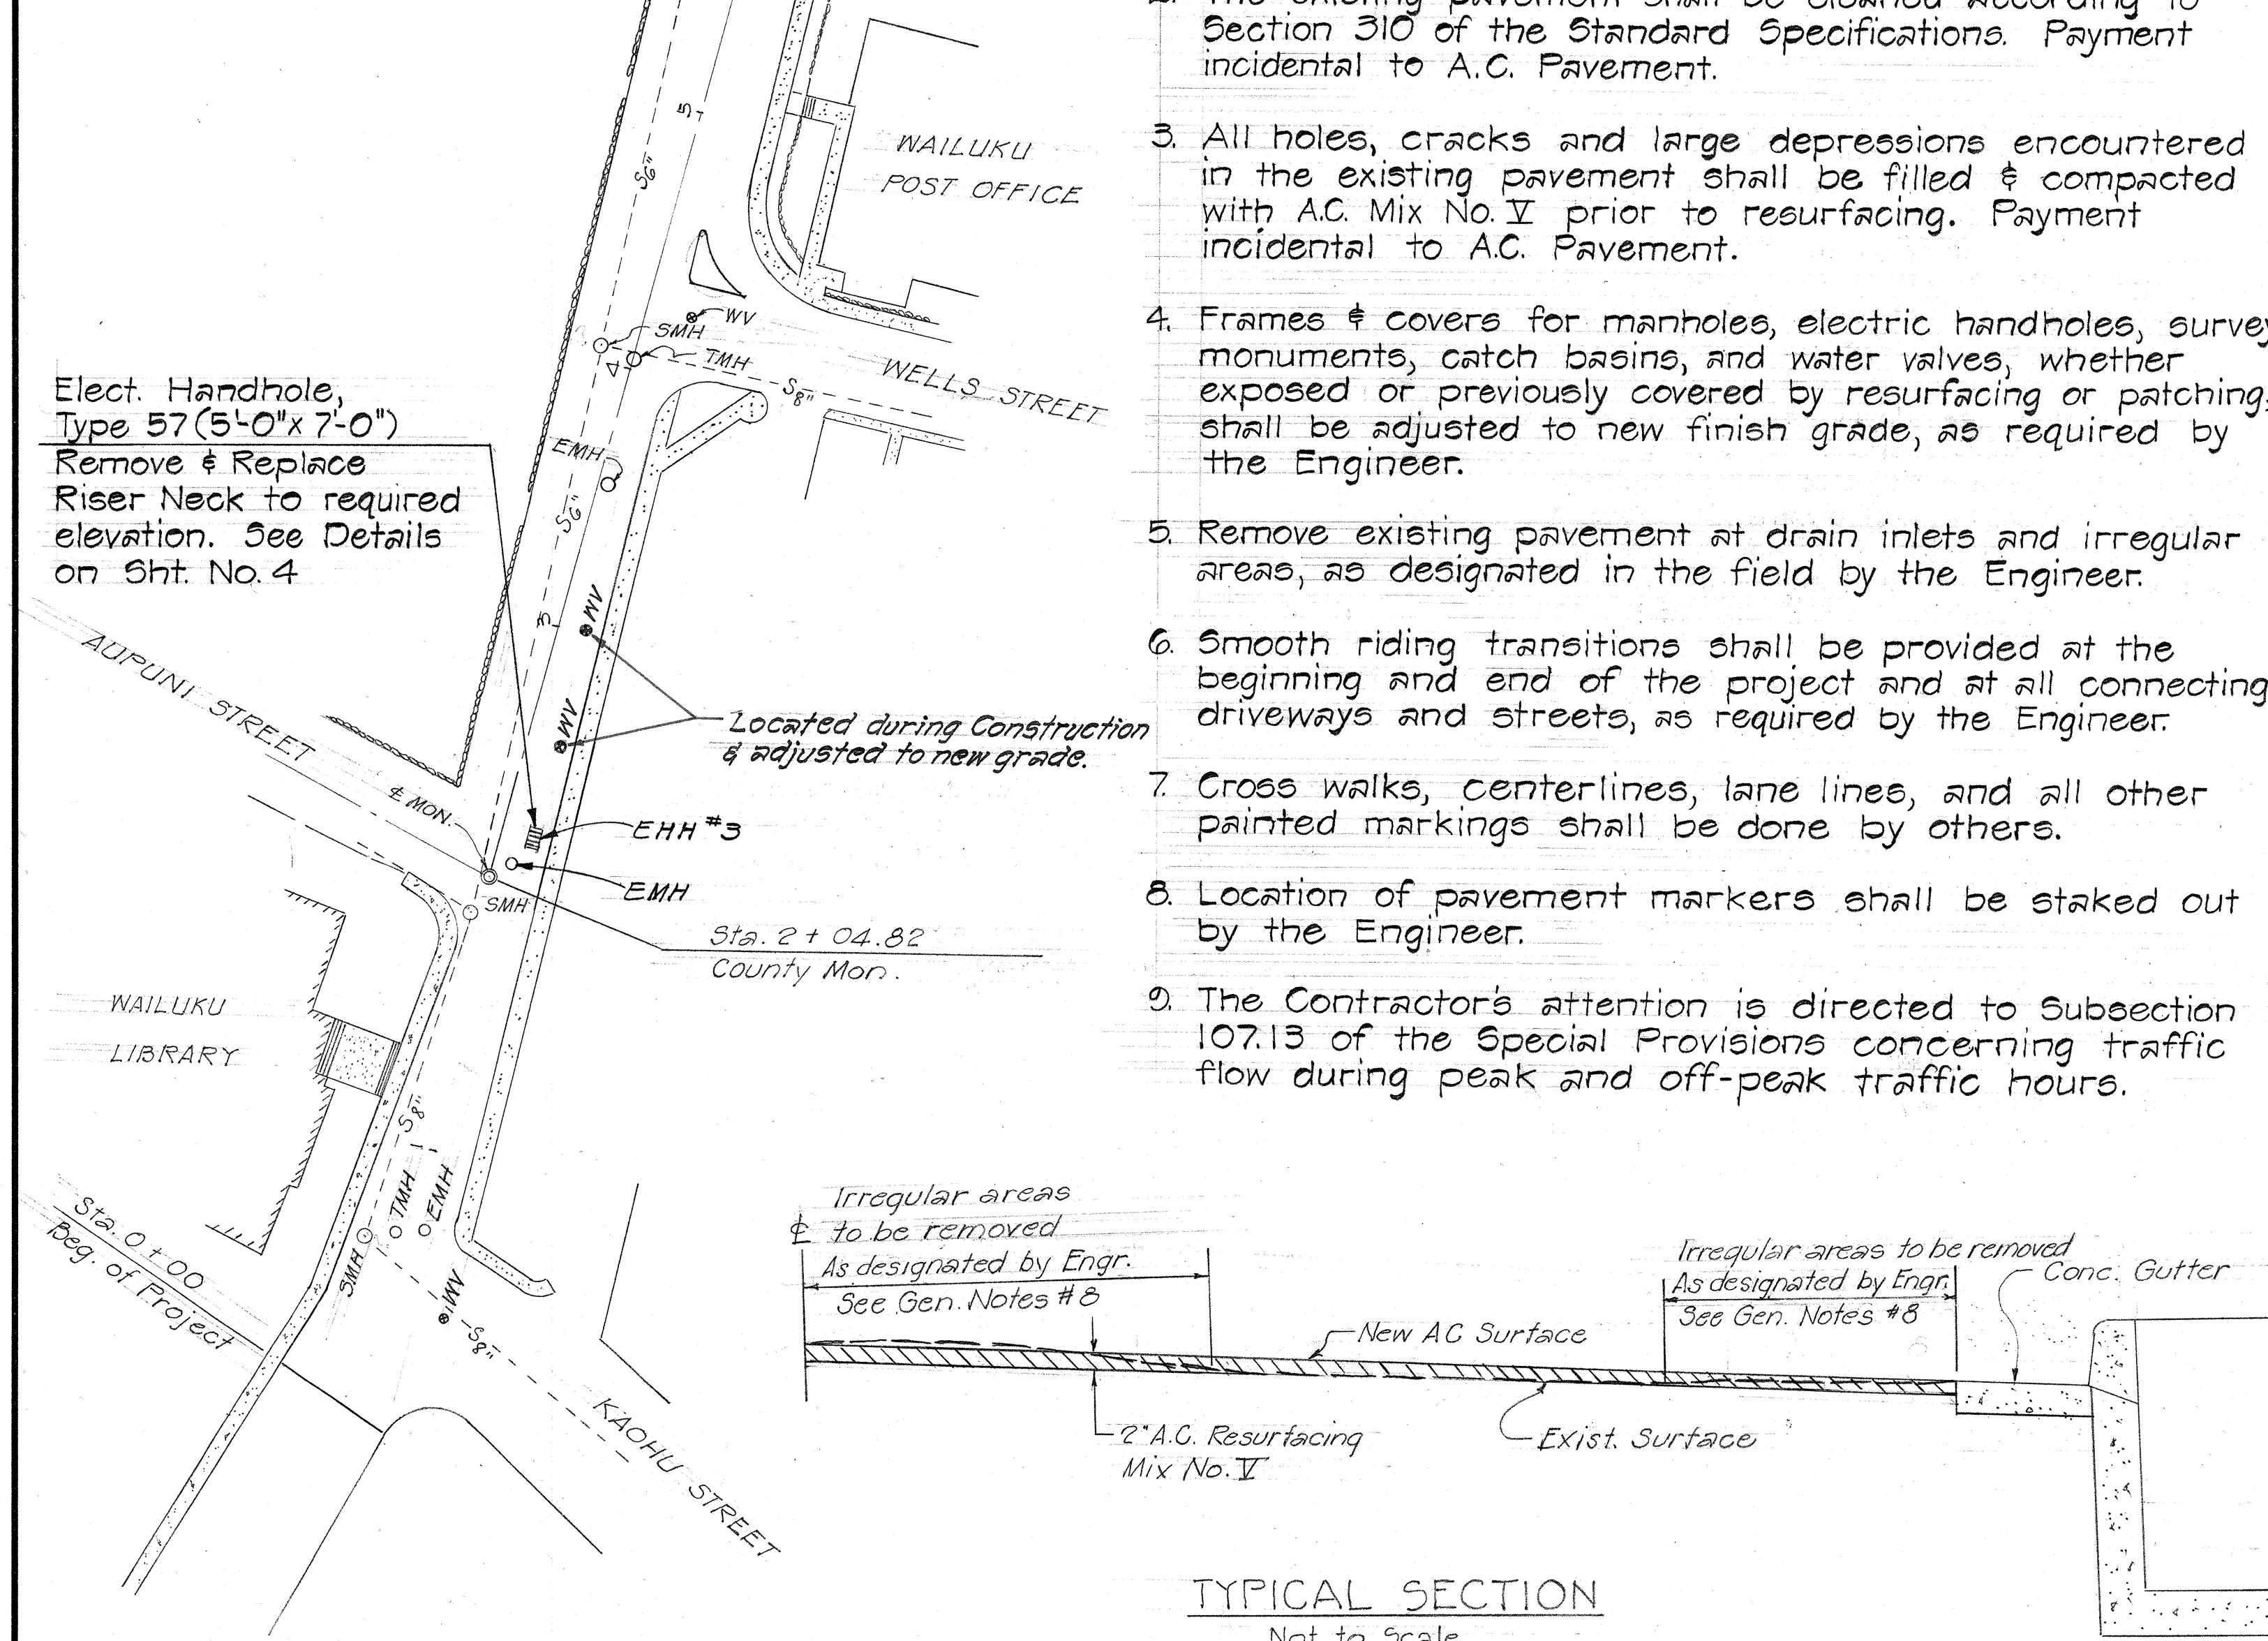

STATE OF HAWAII  
DEPARTMENT OF TRANSPORTATION  
HIGHWAYS DIVISION

**PLAN & TYPICAL SECTION**

RESURFACING OF MAIN AND  
HIGH STREET - WAILUKU, MAUI  
Proj. No. HWY. M-01-73

SCALE: 1" = 50' Aug. '72

SHEET No. 1 OF 1 SHEETS