

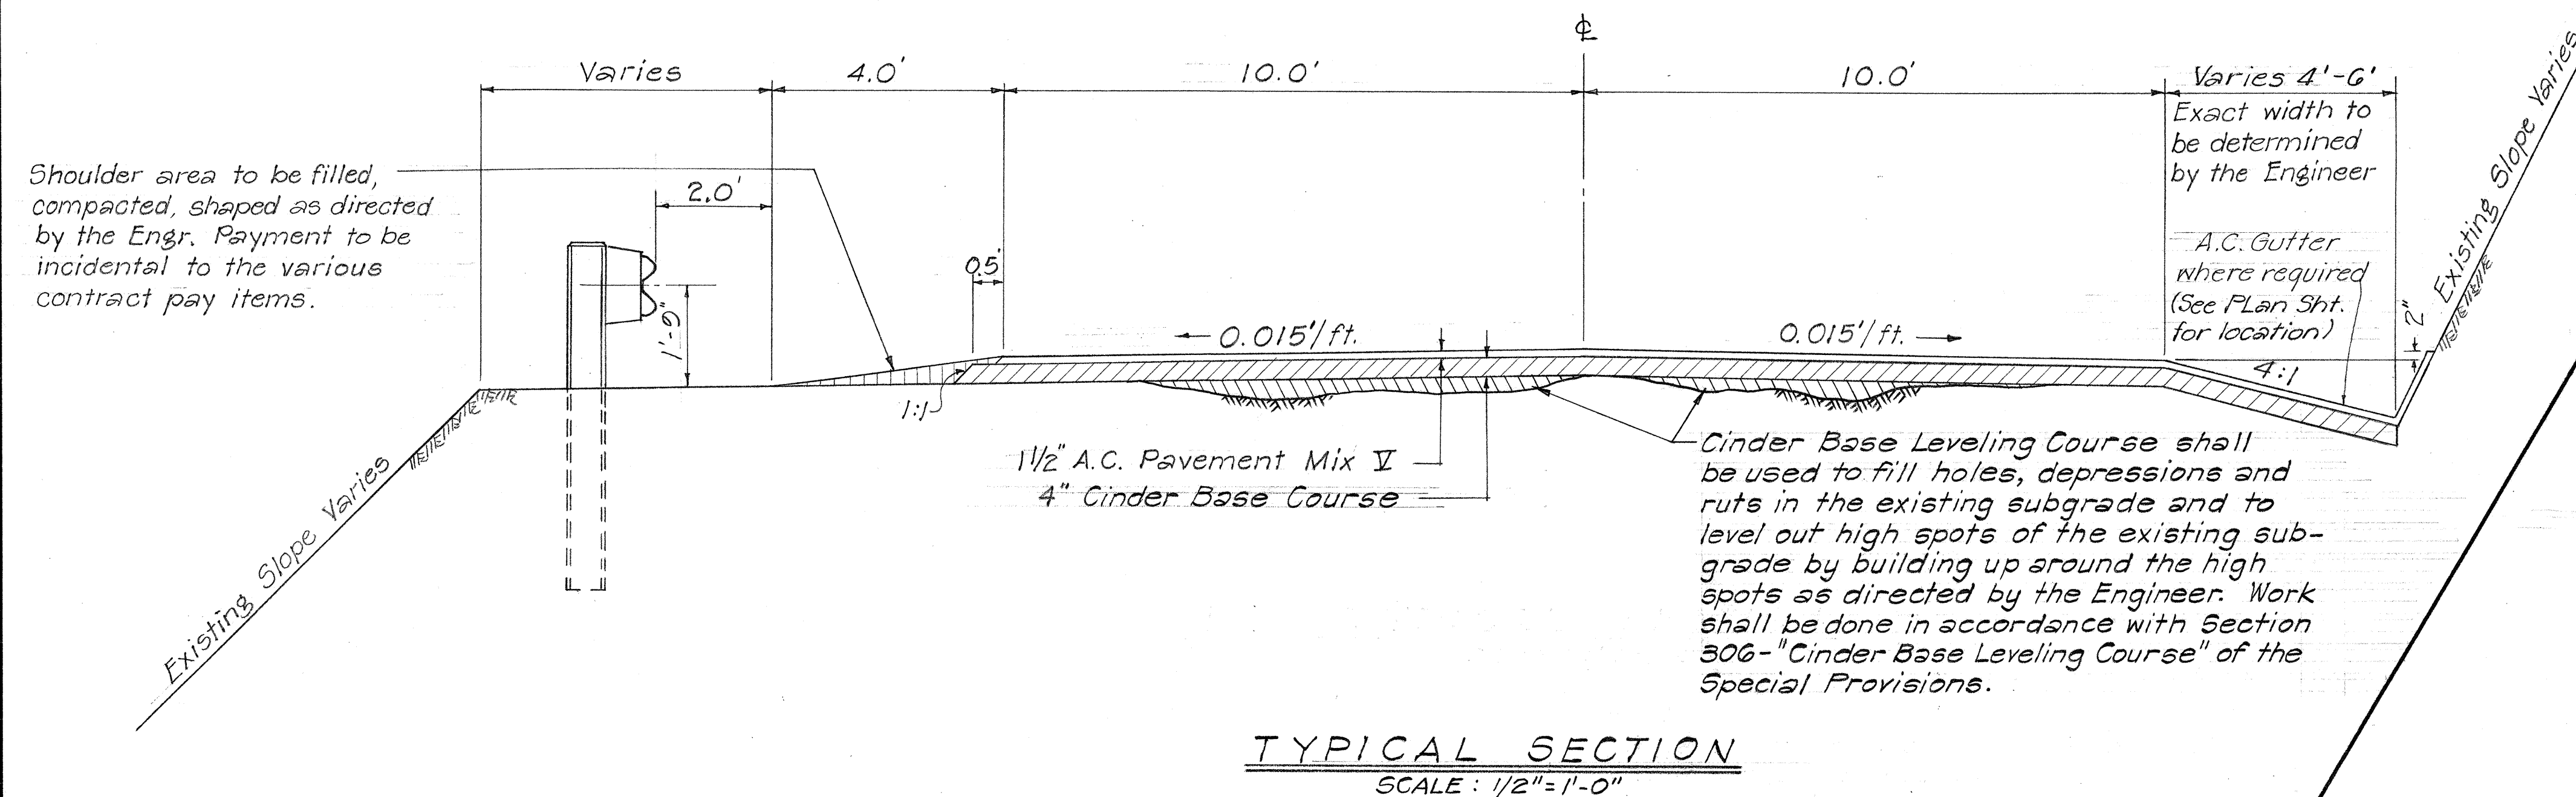




FED. ROAD DIST. NO.	STATE	PROJ. NO.	FISCAL YEAR	SHEET NO.	TOTAL SHEETS
HAWAII	HAW.	340A-02-72	1975	2	13

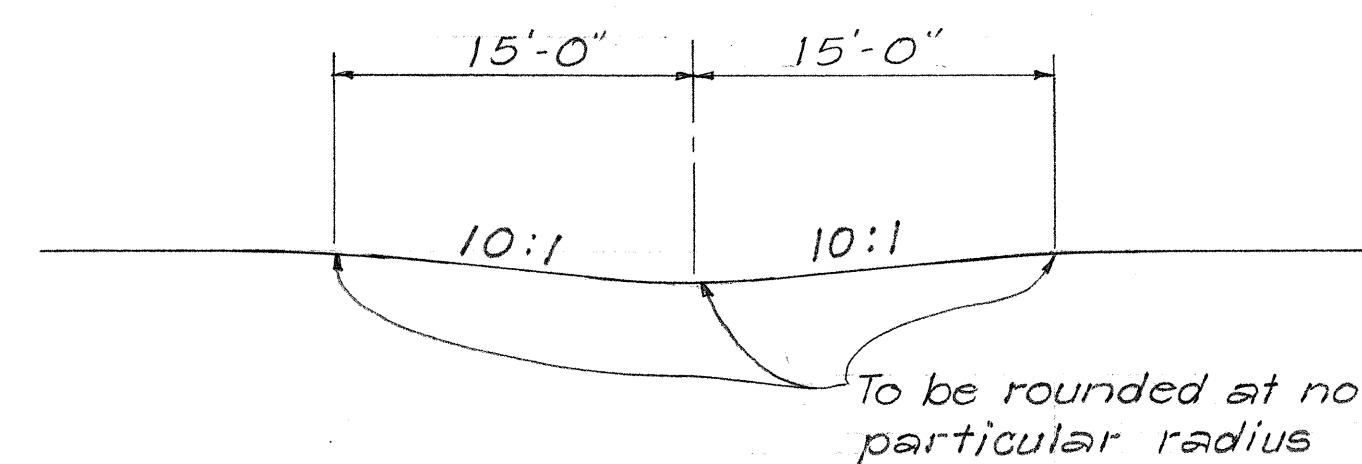




Note:
Construction of Paved Inverts shall considered incidental to A.C. Pavement.

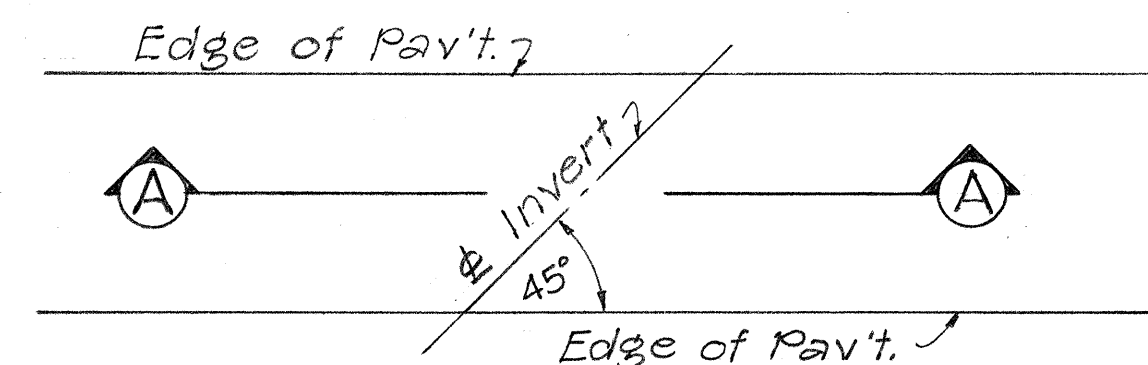

DETAIL OF PAVED INVERTS
NOT TO SCALE

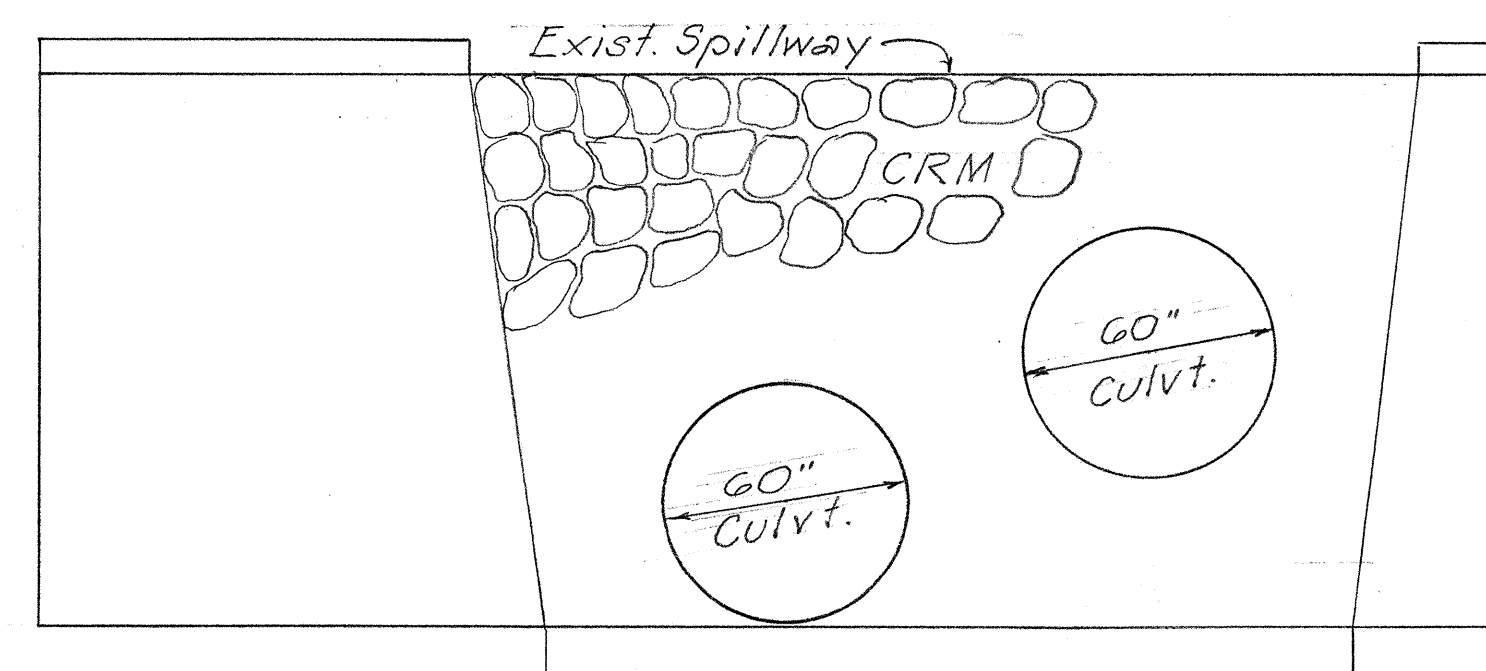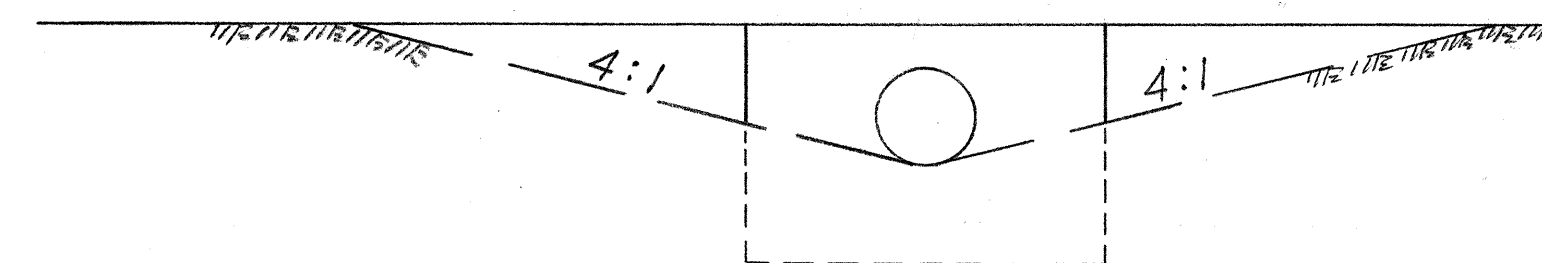

EXISTING TWIN 60" CMP CULVERT AT STA. 205+00 ±

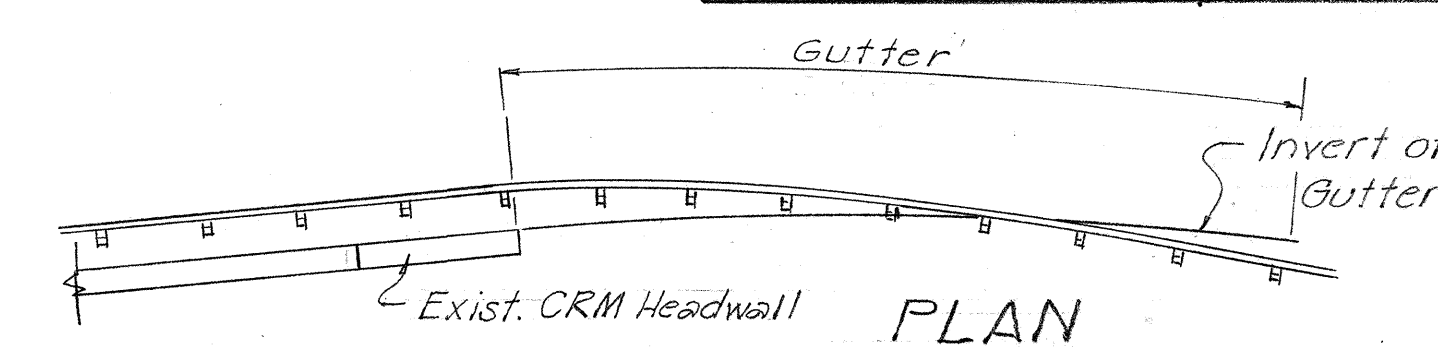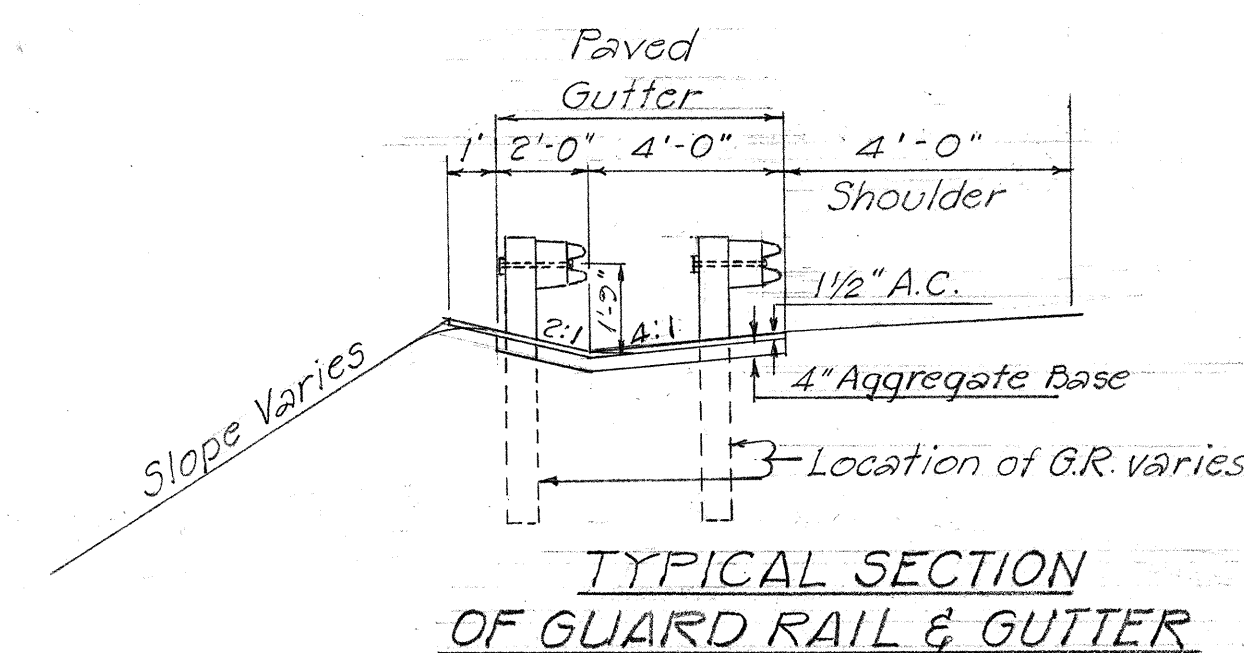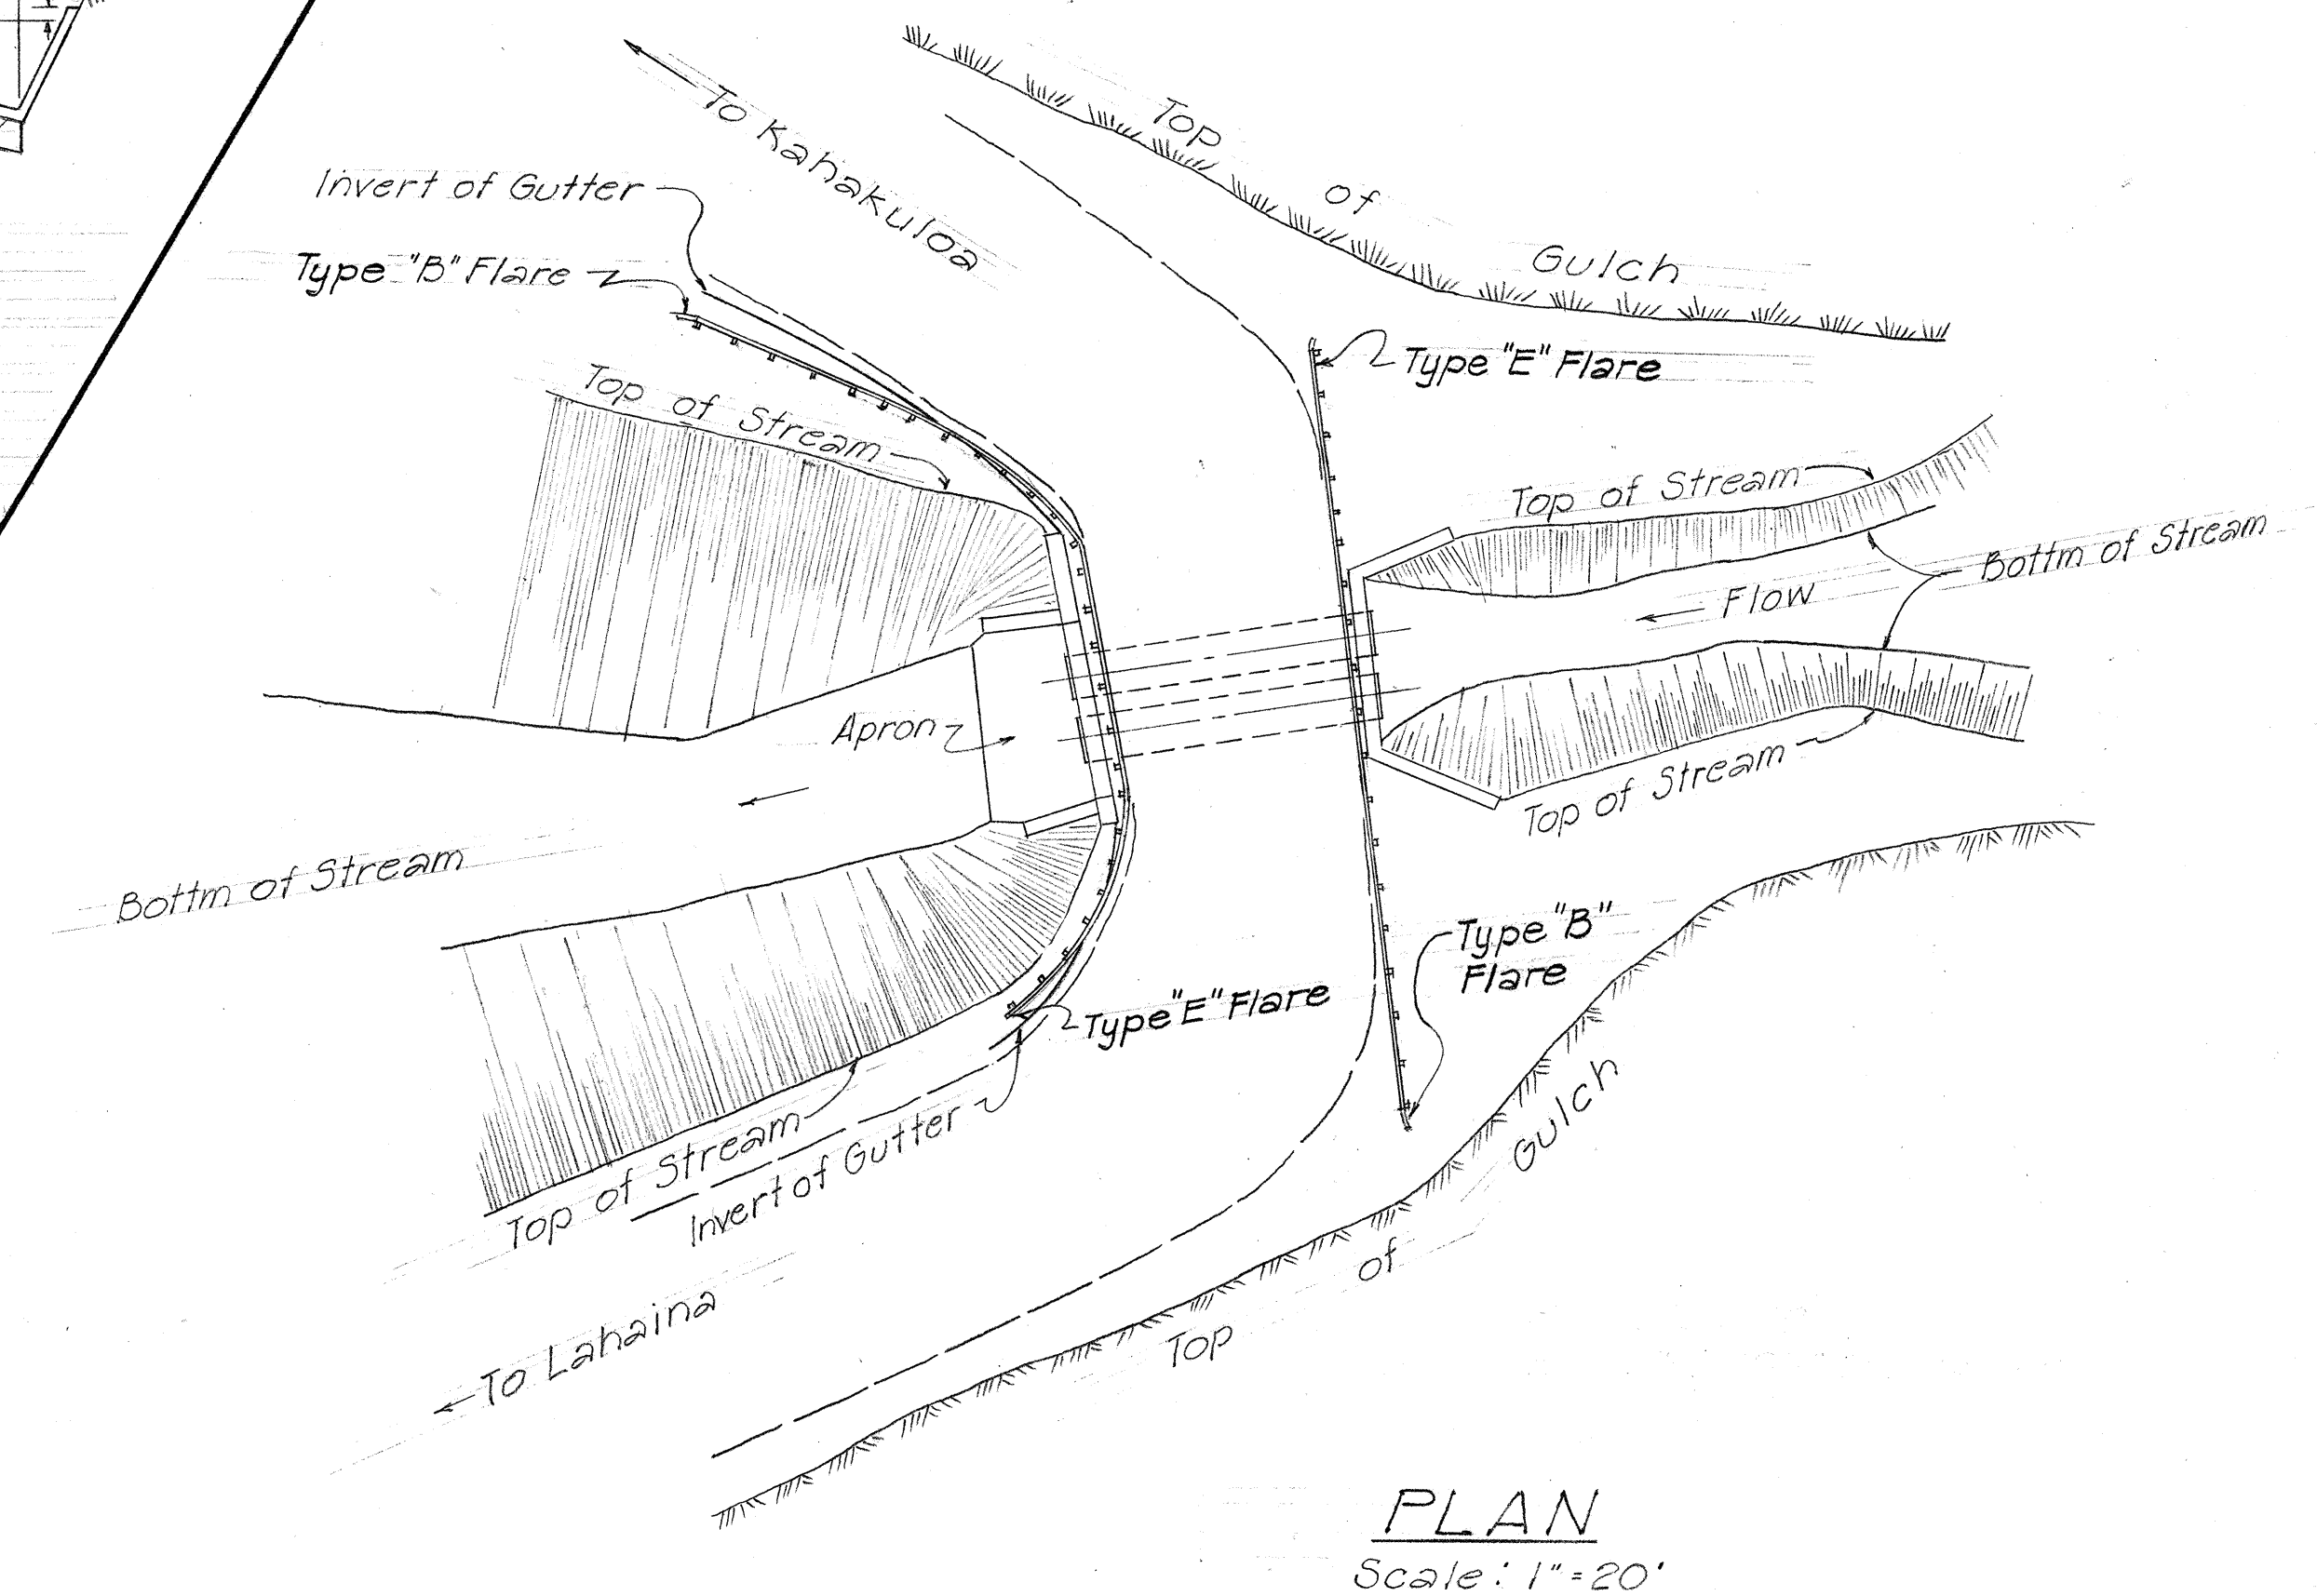

INSTALL METAL GUARD RAIL W/ METAL POSTS
112.5' Lt.
87.5' Rt.
CONSTRUCT PAVED GUTTER
100.0'

STATE OF HAWAII
DEPARTMENT OF TRANSPORTATION
HIGHWAYS DIVISION

KAHEKILI HIGHWAY
PAVING FROM
POELUA TO HONANANA
PROJ. No. 340A-02-72

SCALE: AS SHOWN DATE: FEB. 1975

SHEET No. 1 OF 1 SHEETS