



INDEX TO DRAWINGS	
SHEET NO	DESCRIPTION
1	TITLE SHEET
2	PLAN AND DETAILS
3-4	STANDARD DETAILS

STATE OF HAWAII
DEPARTMENT OF TRANSPORTATION
HIGHWAYS DIVISION
HONOLULU, HAWAII

AS BUILT PLAN FOR
DRAINAGE IMPROVEMENT
ON HONOAPIILANI HIGHWAY
(VICINITY OF KAHANA SUNSET BEACH LOT)

PROJ NO 30A-02-76

DISTRICT OF LAHAINA
ISLAND OF MAUI

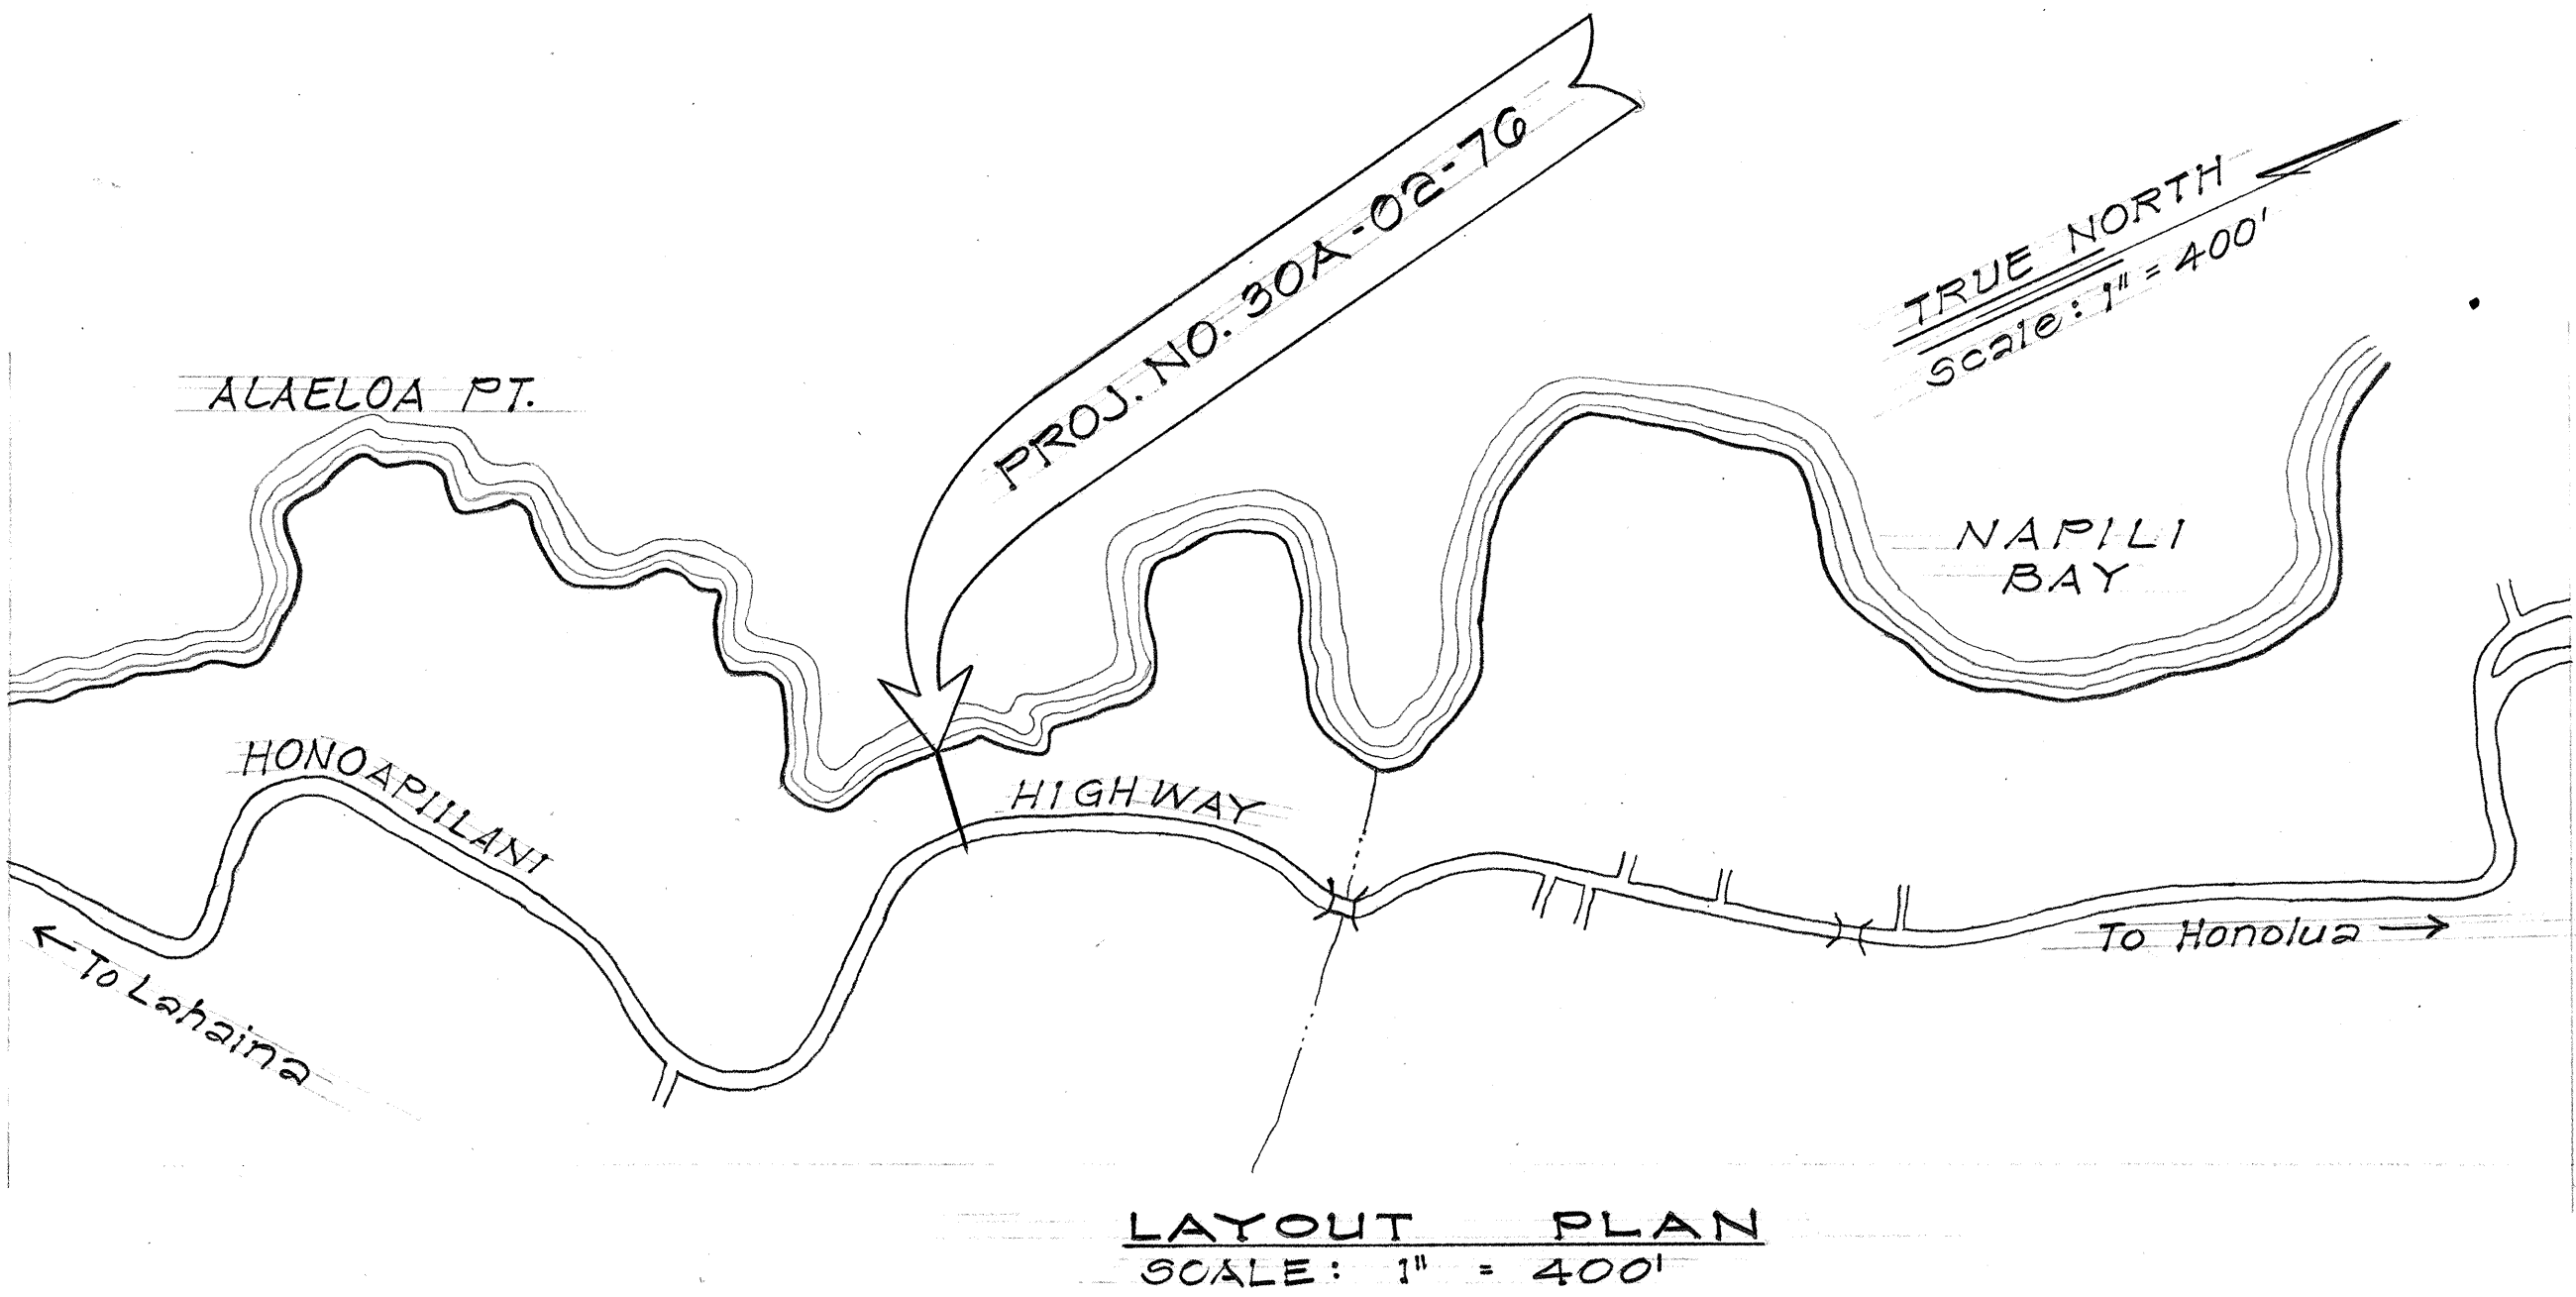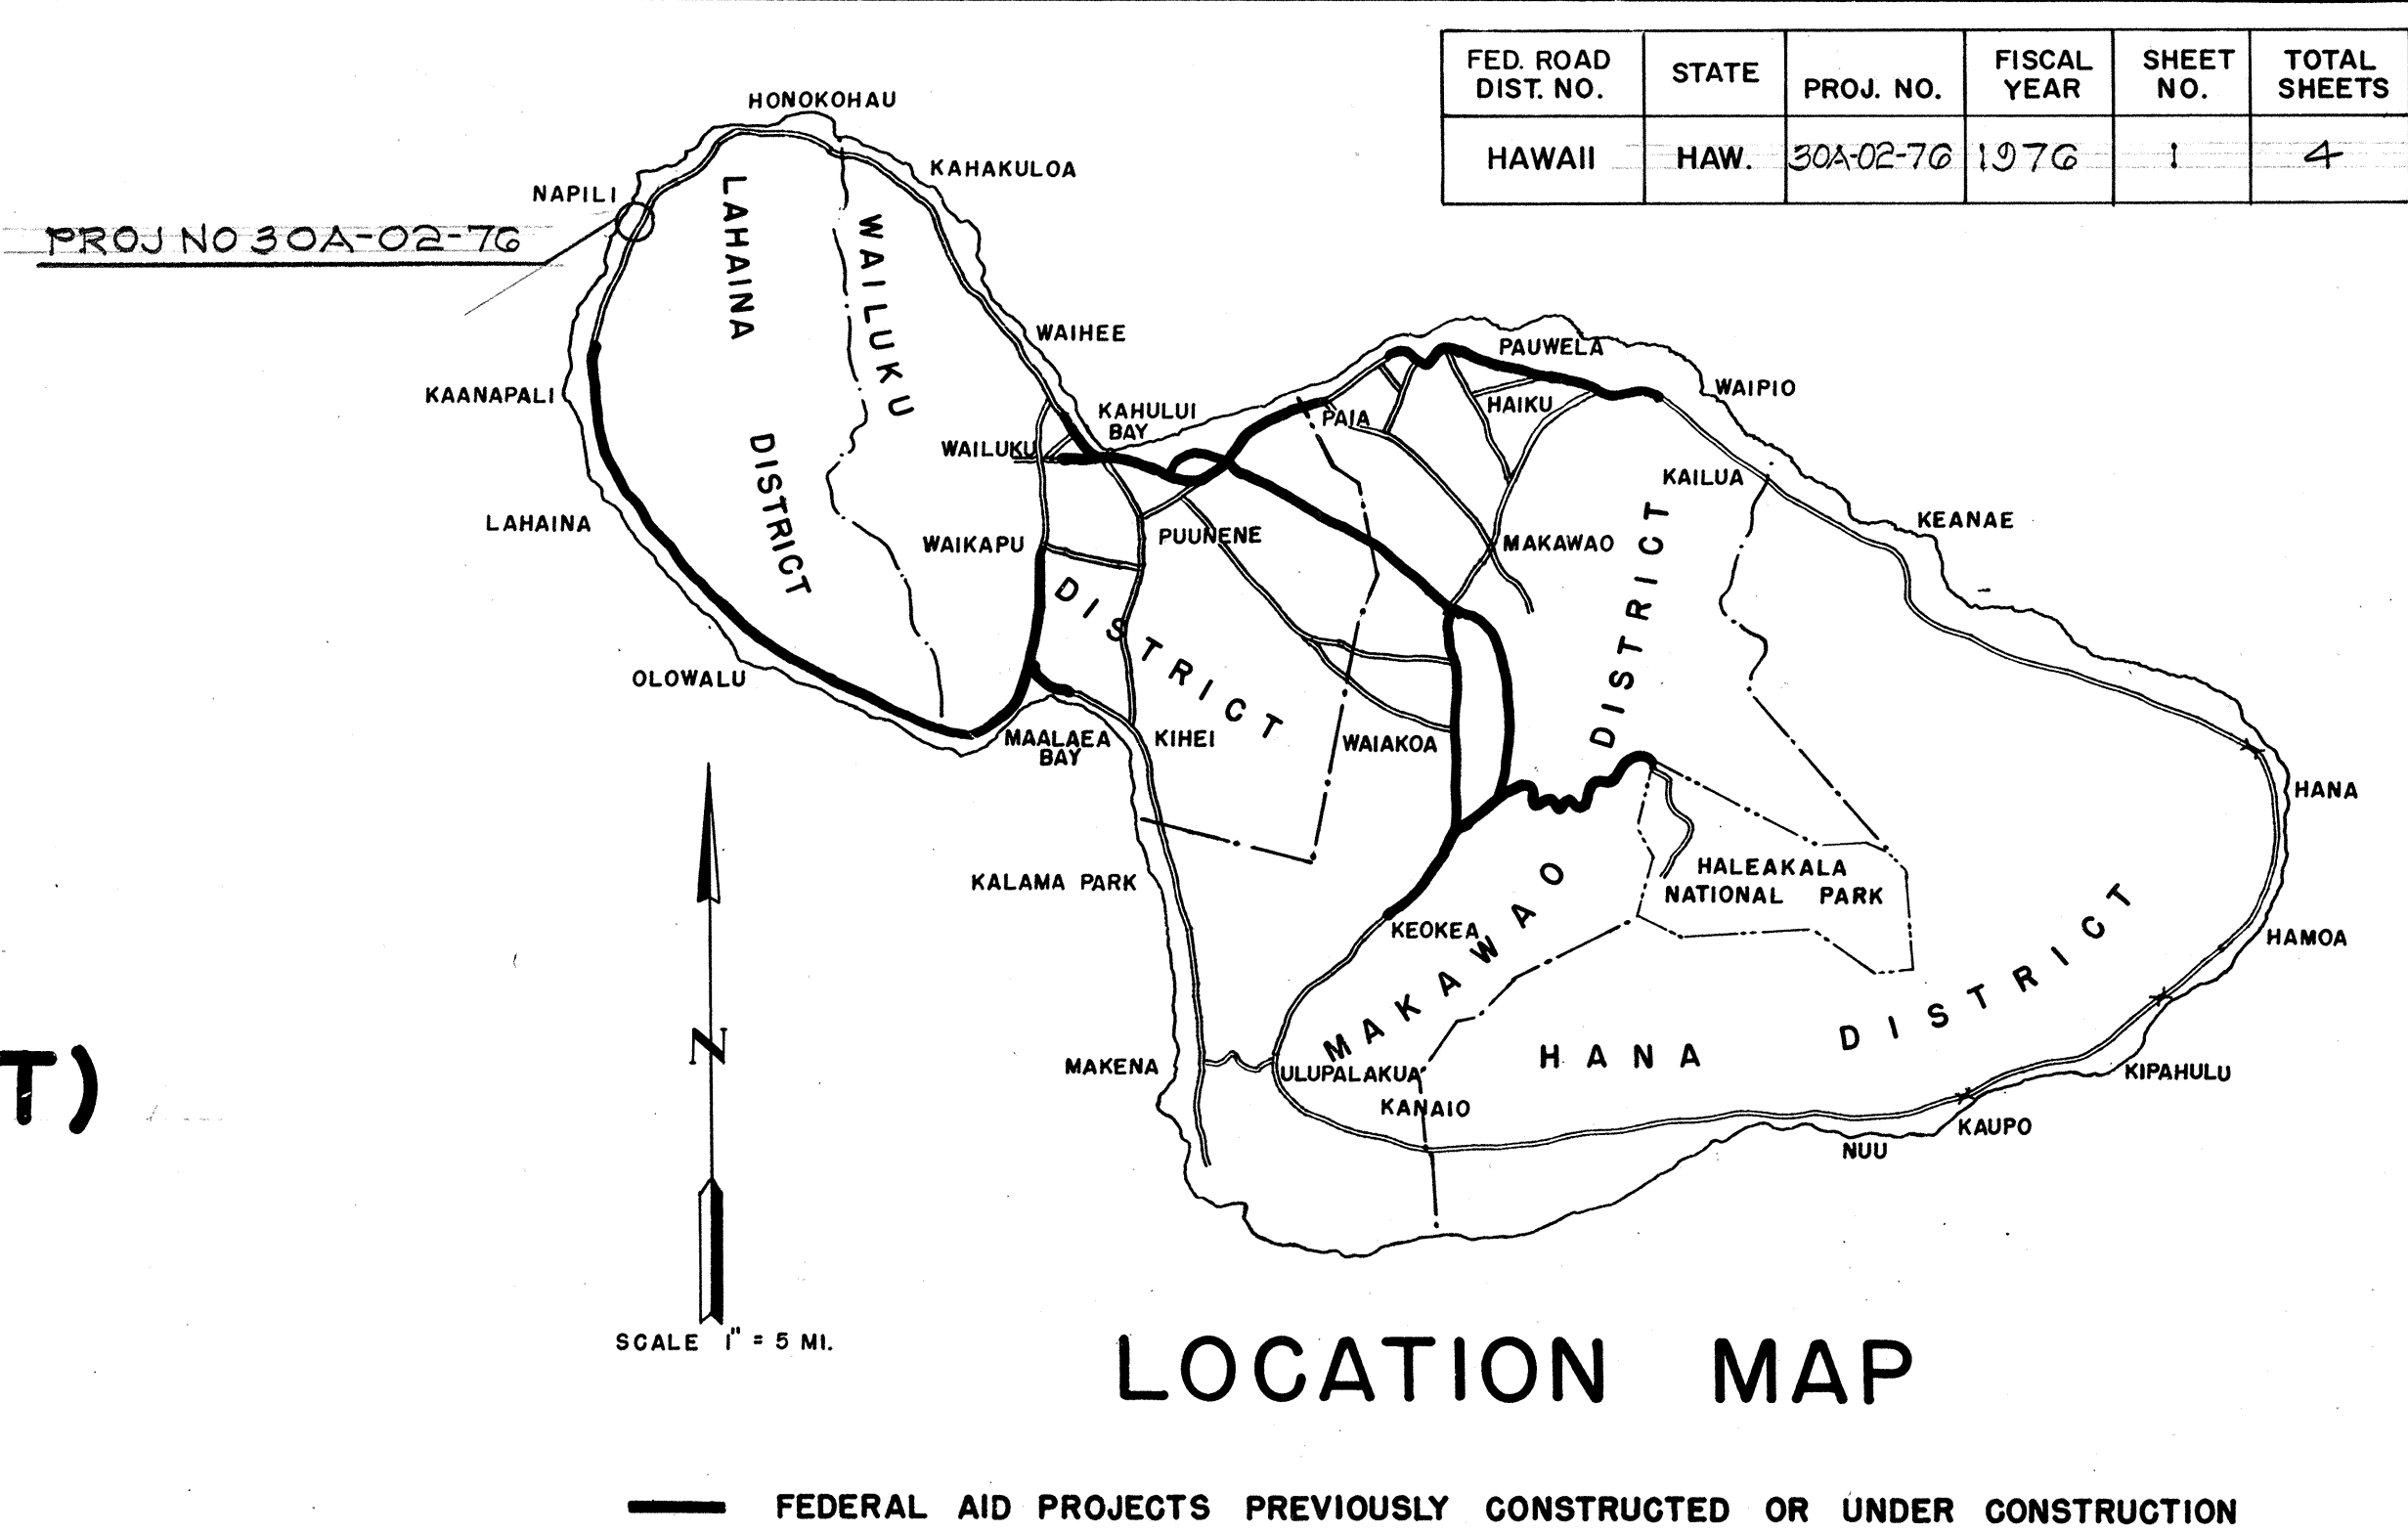

NOTE :
ALL CHANGES MADE DURING CONSTRUCTION
HAVE BEEN NOTED IN RED ON THESE TRACINGS
AND CHECKED BY.

K. Nakamoto
Resident Engineer

5/18/76
Date

DEPARTMENT OF TRANSPORTATION
STATE OF HAWAII
APPROVED:
R. Higashimura
for DIR. OF TRANSPORTATION

9-22-76
DATE