

INDEX TO DRAWINGS	
SHEET NO	DESCRIPTION
1	TITLE SHEET
2 - 4	PLANS
(2)	PLAN & MISC. DETAILS
(4)	PLAN & GENERAL NOTES
5	TYPICAL SECT. & SUMMARY
6 - 7	DRAINAGE DETAILS
8 - 17	STANDARD DETAILS

STATE OF HAWAII

DEPARTMENT OF TRANSPORTATION

HIGHWAYS DIVISION

HONOLULU, HAWAII

"AS BUILT" PLANS OF

HONOAPIILANI HIGHWAY SAFETY IMPROVEMENTS


WEST OF PALI TUNNEL TOWARD Mc GREGOR POINT

FED. AID PROJECT NO. ROS-030-1(12)

DISTRICTS OF

LAHAINA - WAILUKU

ISLAND OF MAUI

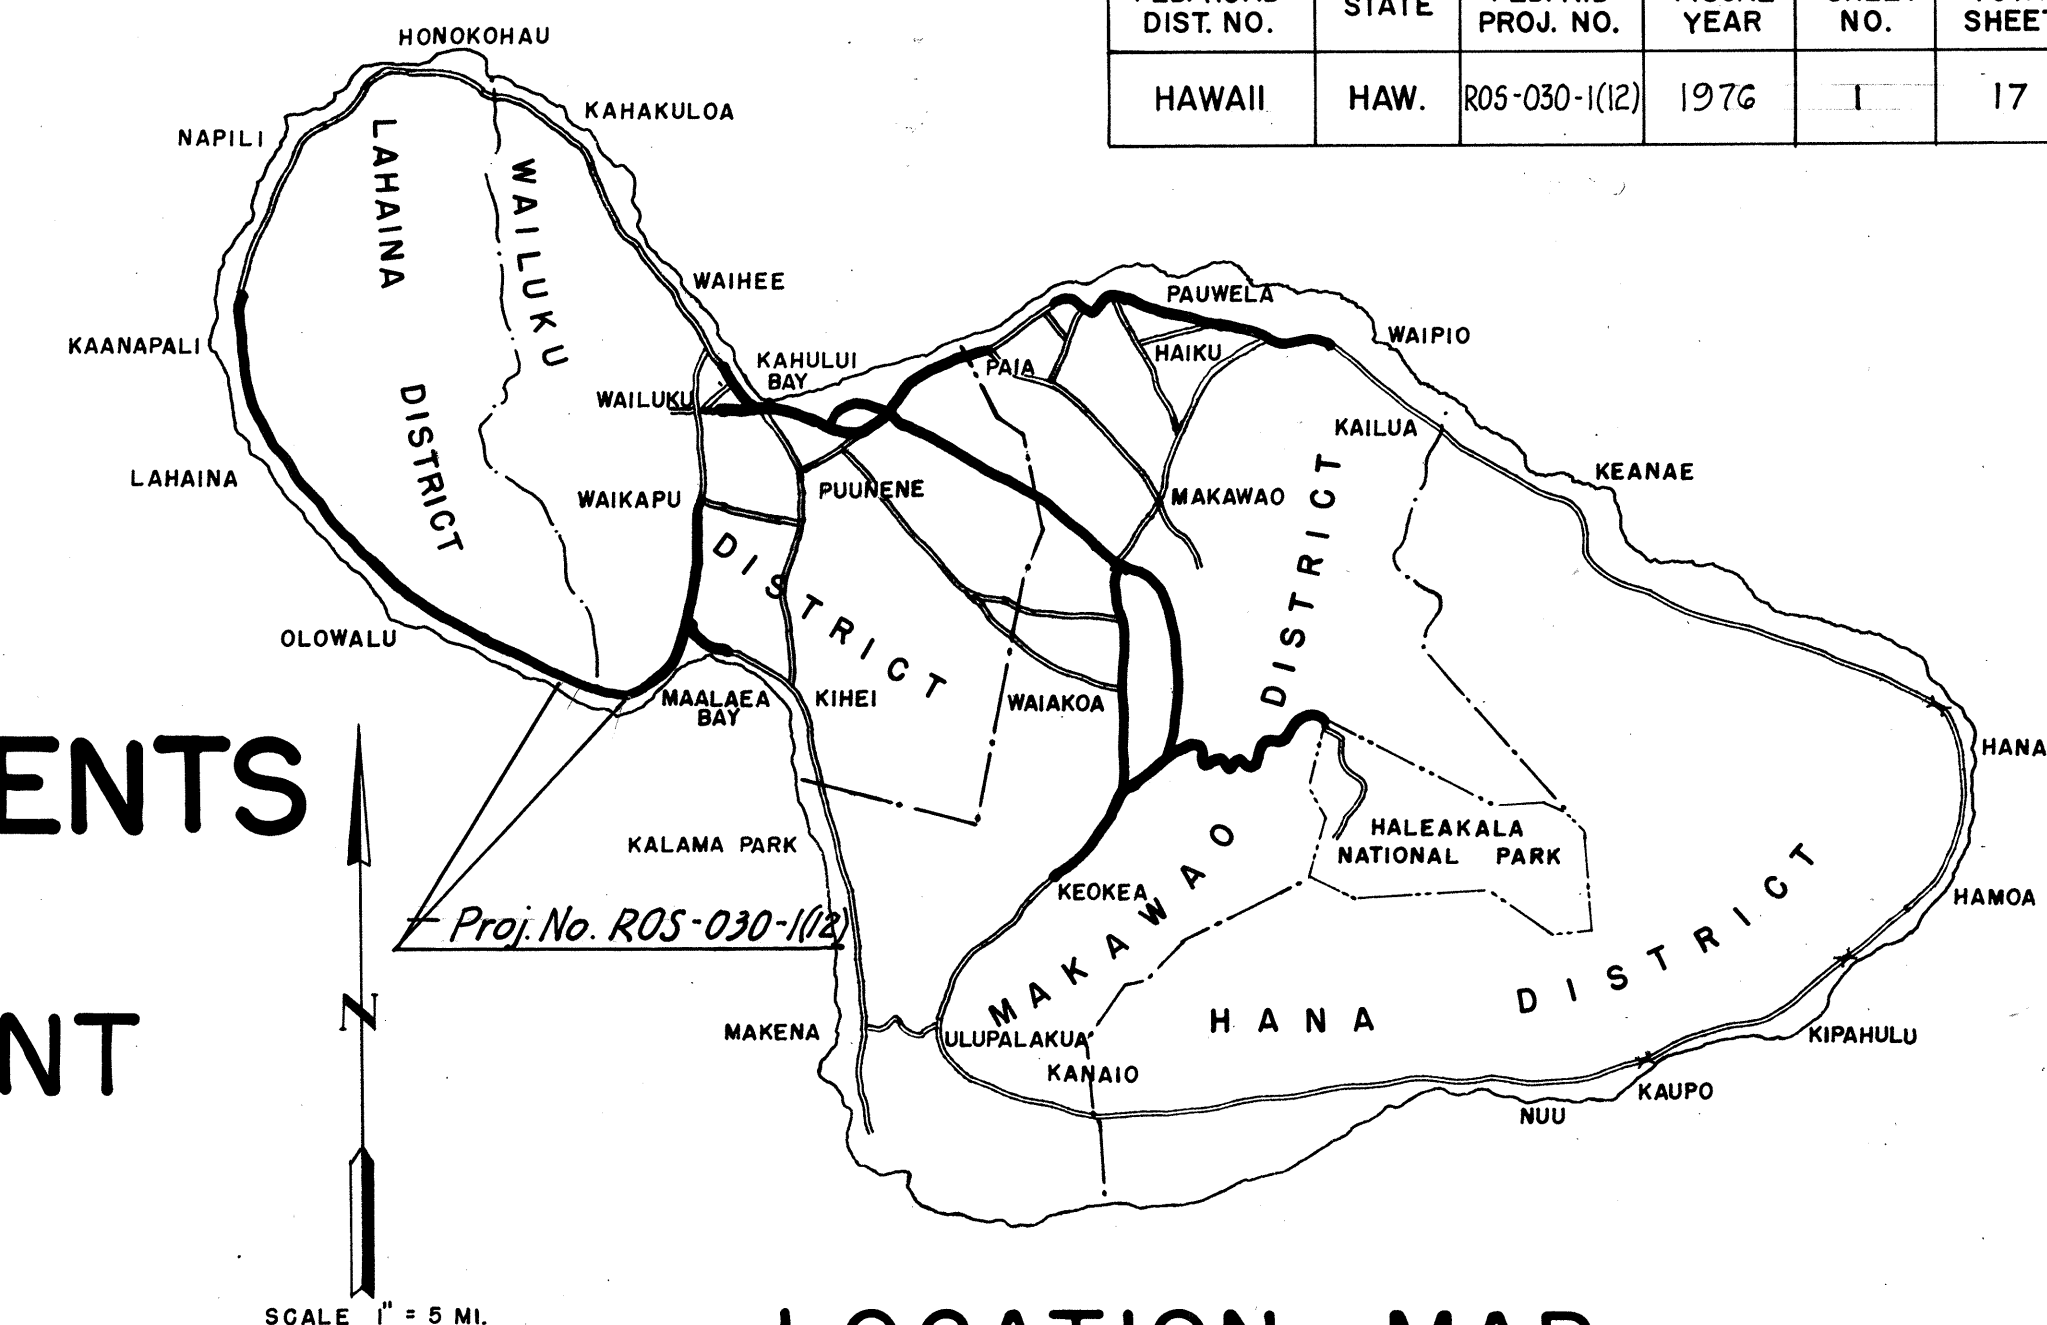

LOCATION MAP

— FEDERAL AID PROJECTS PREVIOUSLY CONSTRUCTED OR UNDER CONSTRUCTION

March, 1976

DATE

548-7490

PHONE

C


HWY. DESIGN UNIT

Mike Miura

P.S. & E. BY

MAUI DISTRICT

DESIGNED BY

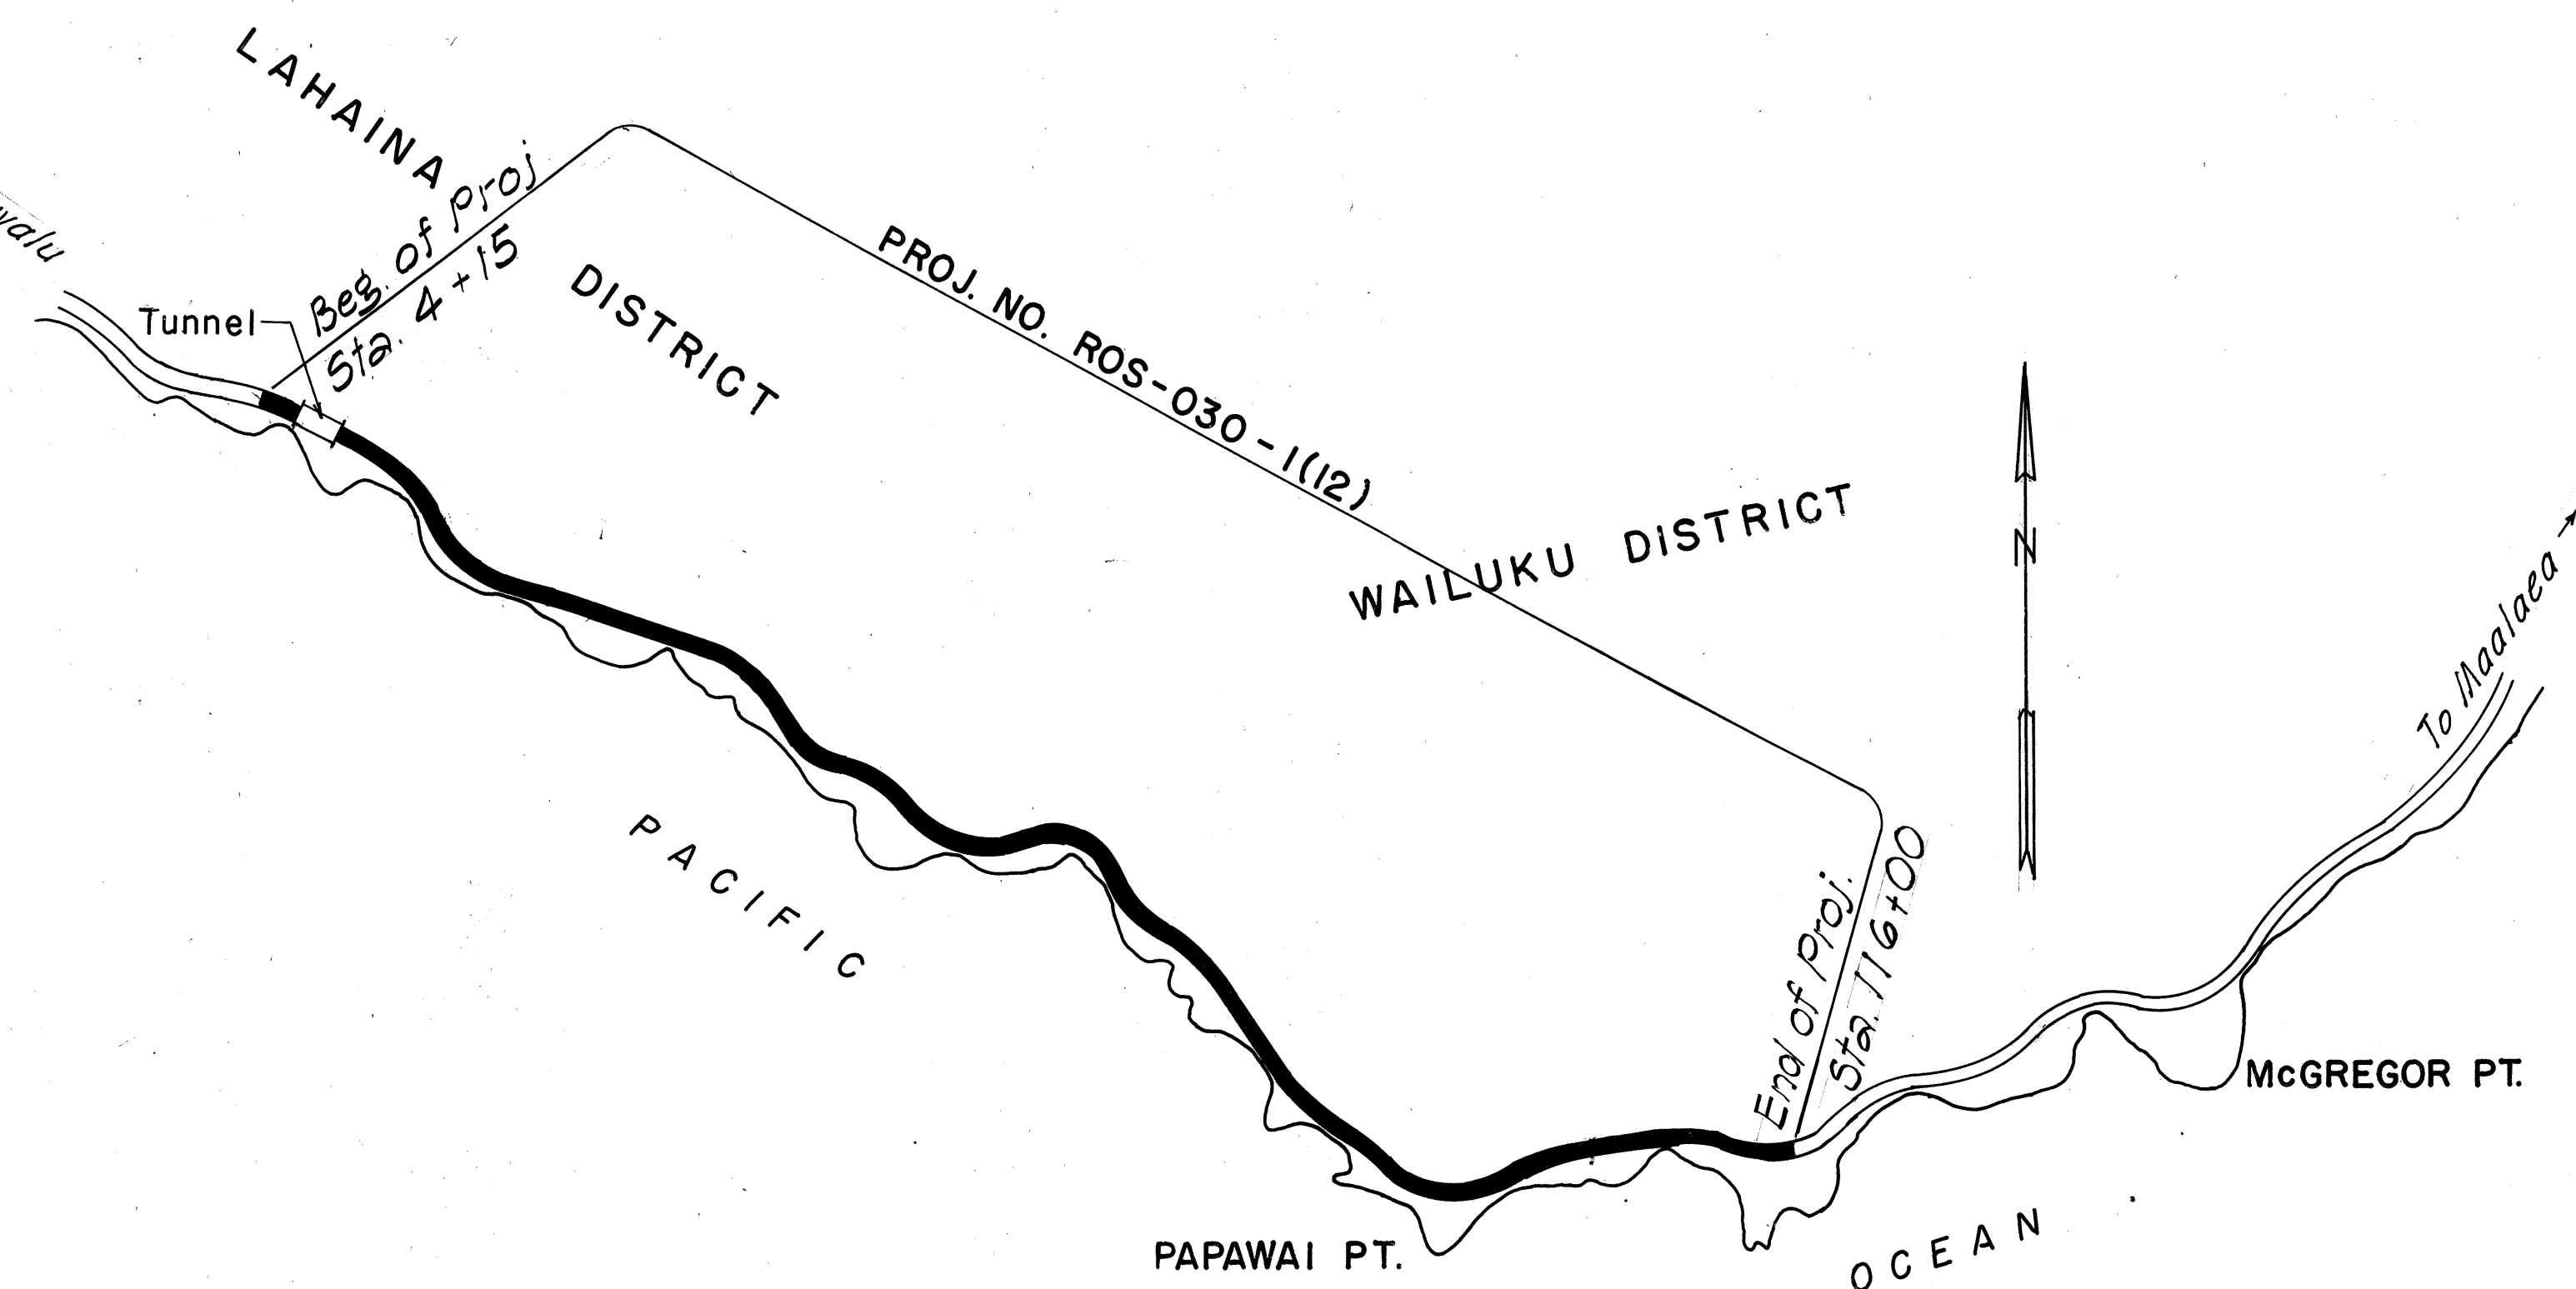

LAYOUT OF PROJECT

SCALE: 1" = 1000'

LENGTH OF PROJECT

2.118 MI.

3.408 KM.

DESIGN DESIGNATION

ADT (1976)..... 6,900

DHV..... 730

V..... 35 m.p.h.

D..... 60/40

T..... 8%

NOTE:

ALL CHANGES MADE DURING CONSTRUCTION HAVE BEEN NOTED IN RED ON THESE TRACINGS AND CHECKED BY

John P. Jett

PROJECT ENGINEER

12/29/77

DATE

DEPARTMENT OF TRANSPORTATION

FEDERAL HIGHWAY ADMINISTRATION

APPROVED:

John P. Jett

DIVISION ADMINISTRATOR

5-4-76

DATE

DEPARTMENT OF TRANSPORTATION

STATE OF HAWAII

APPROVED:

R. Higashimura

for DIR. OF TRANSPORTATION

4-27-76

DATE