

FED. ROAD DIST. NO.	STATE	FED. AID PROJ. NO.	FISCAL YEAR	SHEET NO.	TOTAL SHEETS
HAWAII	HAW.	ROS-030-1(14)	1978	5	33


② CURVE DATA
 $\Delta = 27^\circ 42' 30''$
 $D_c = 10^\circ 00'$
 $L_s = 200.00'$
 $T_s = 241.93'$
 $X_c = 199.39'$
 $Y_c = 11.61'$
 $LT = 133.55'$
 $ST = 66.86'$
 $Q_s = 10^\circ 00'$
 $SE = 0.10' / ft$
 $R = 573.68'$

① CURVE DATA
 $\Delta = 28^\circ 56'$
 $D = 1^\circ 45' 00''$
 $R = 3274.05'$
 $T = 844.70'$
 $L = 1653.33'$
 $C = 1635.82'$
 $SE = 0.04' / ft$

LEGEND:

+ Denotes RM-1 unless otherwise noted.

RM-3

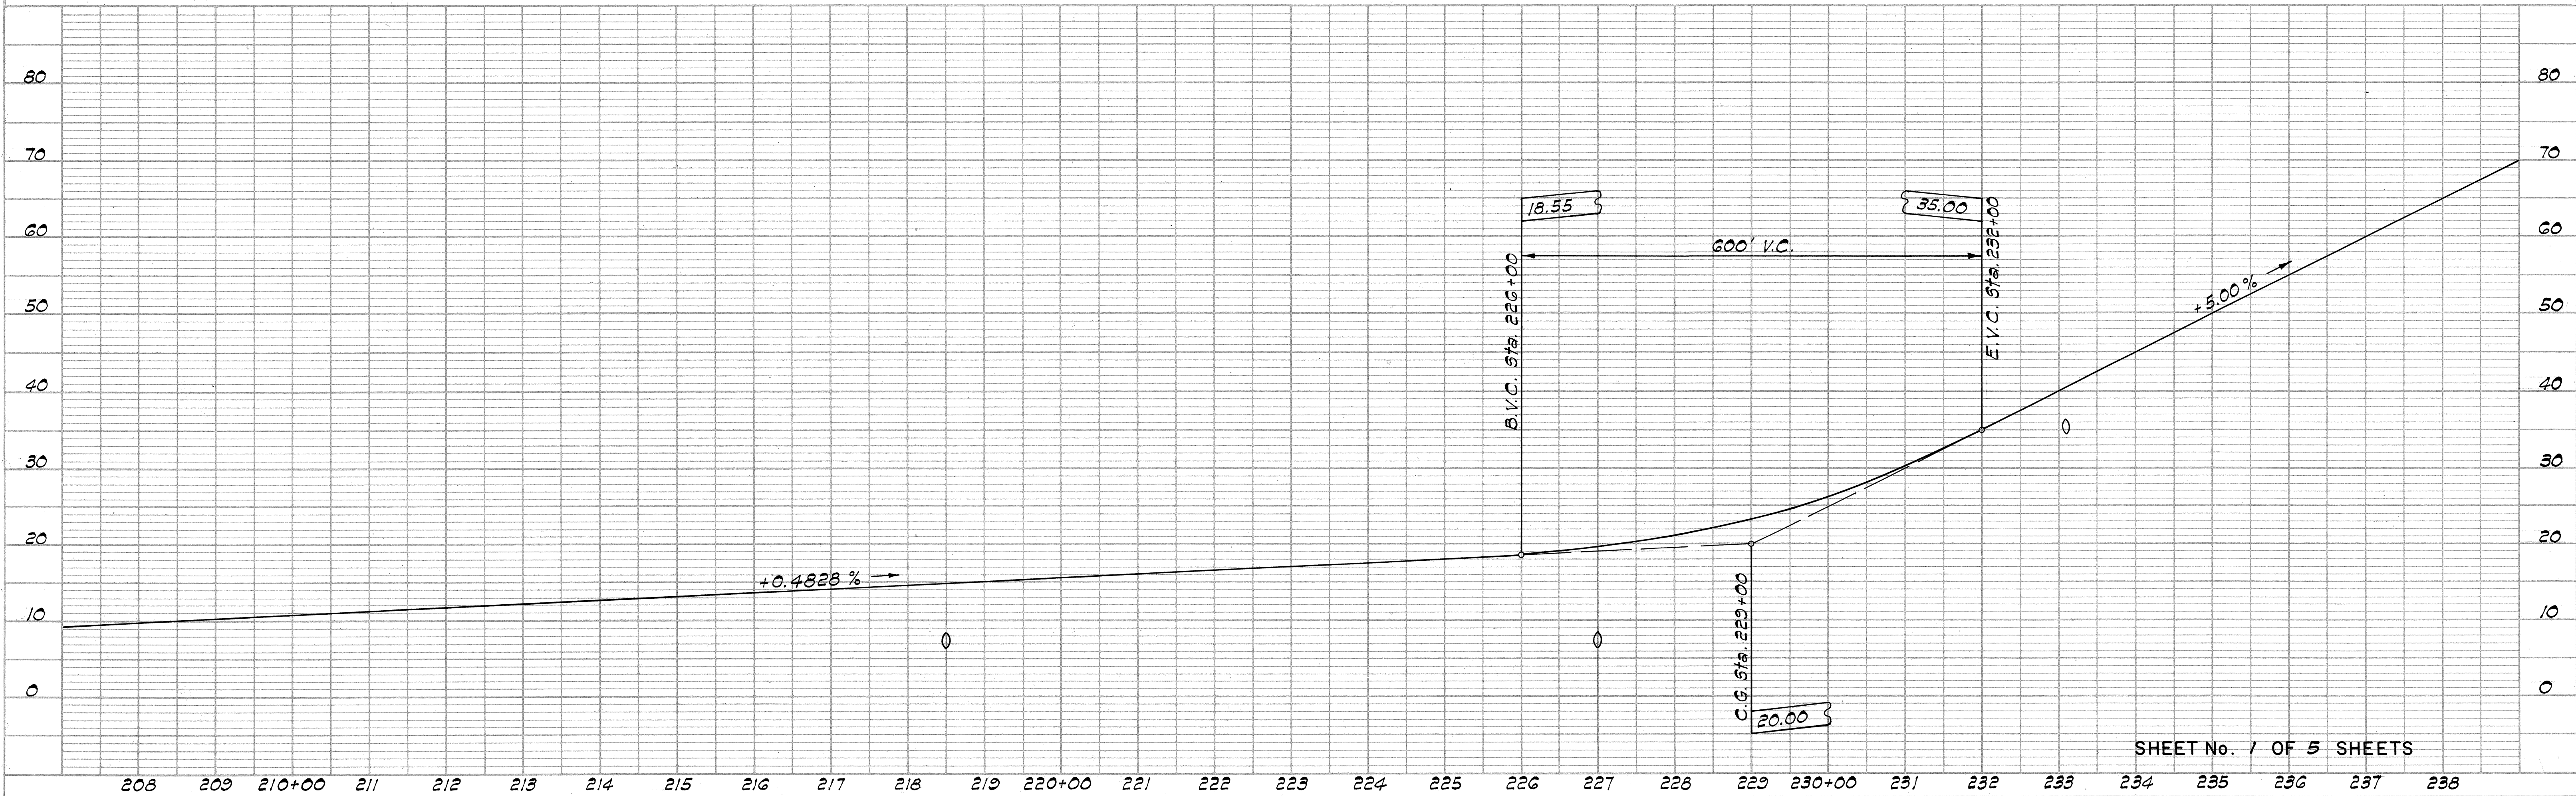


SHEET No. 1 OF 5 SHEETS

FED. ROAD DIST. NO.	STATE	FED. AID PROJ. NO.	FISCAL YEAR	SHEET NO.	TOTAL SHEETS
HAWAII	HAW.	ROS-0304(14)	1978	6	33


PLAN	DATE	BY
SURVEYED		
PLOTTED		
NOTE BOOK		
NO.		

PROFILE	DATE	BY
SURVEYED		
PLOTTED		
NOTE BOOK		
NO.		

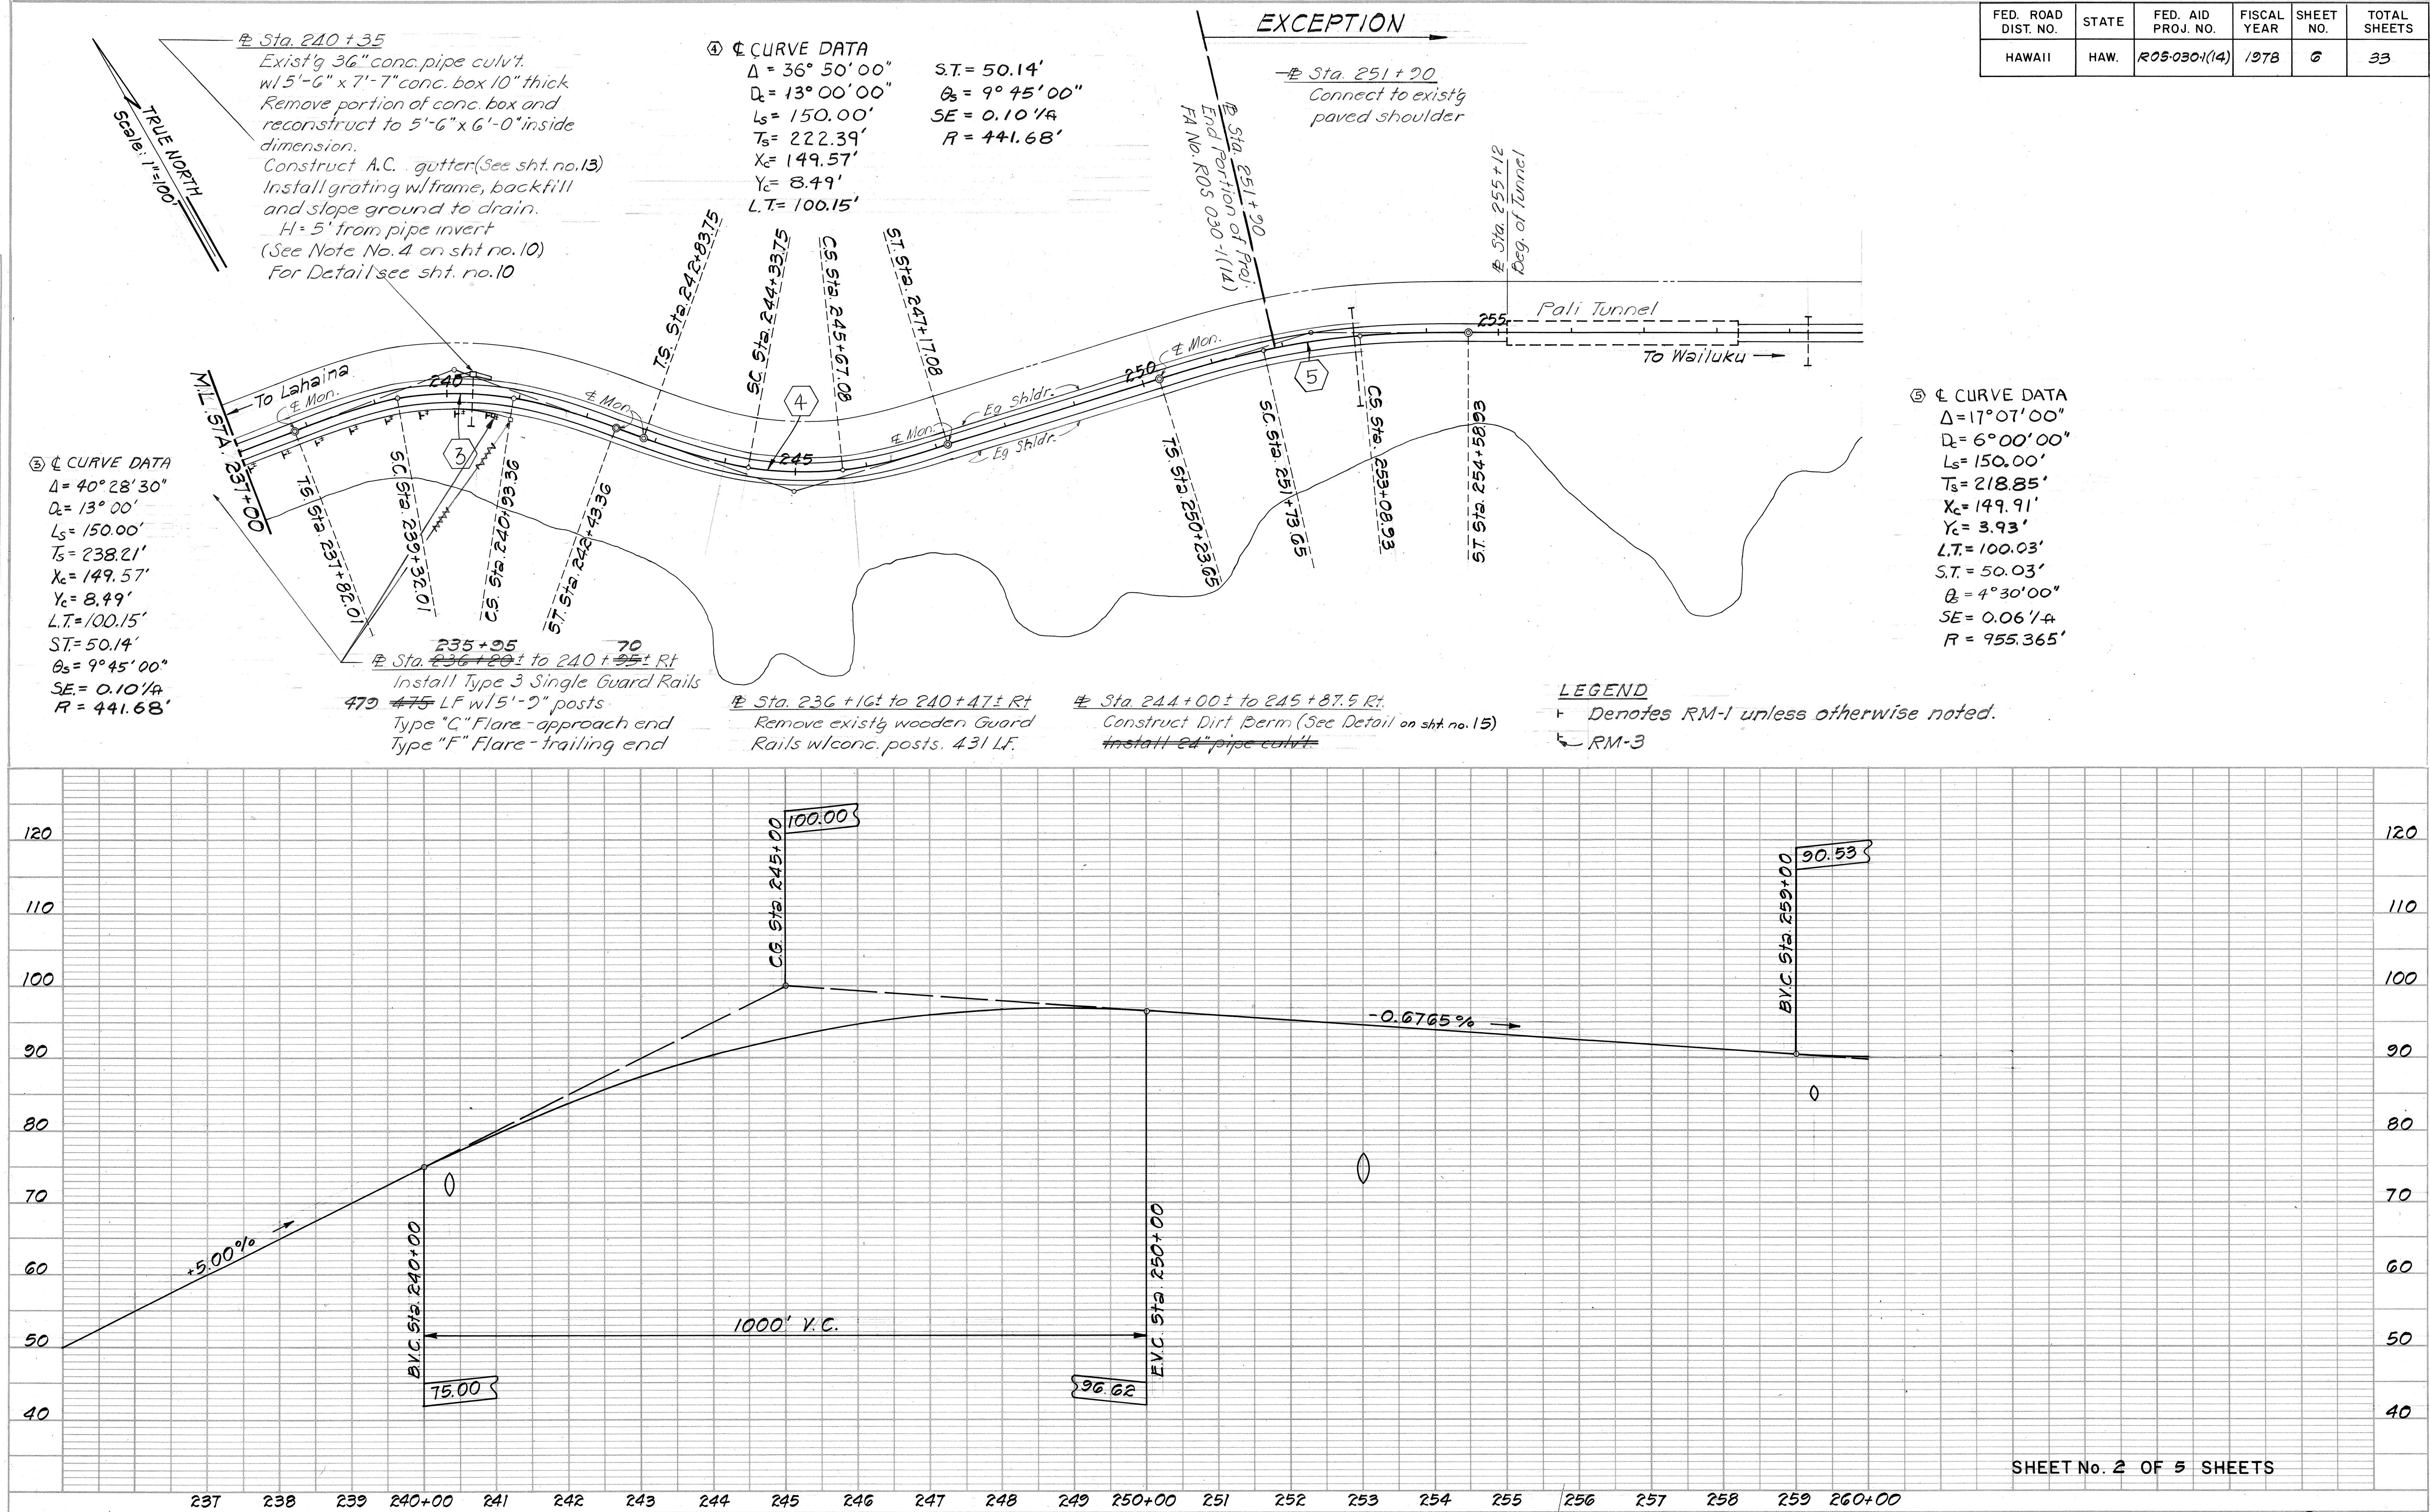

PLAN	SURVEYED	DATE
NO.	BY	
	PLOTTED	
	GRADES CHECKED	
	ALIGNMENT CHECKED	
	RT. OF WAY CHECKED	

PROFILE	SURVEYED	DATE
NO.	BY	
	PLOTTED	
	GRADES CHECKED	
	ALIGNMENT CHECKED	
	STRUCTURE NOTATION CHKD.	

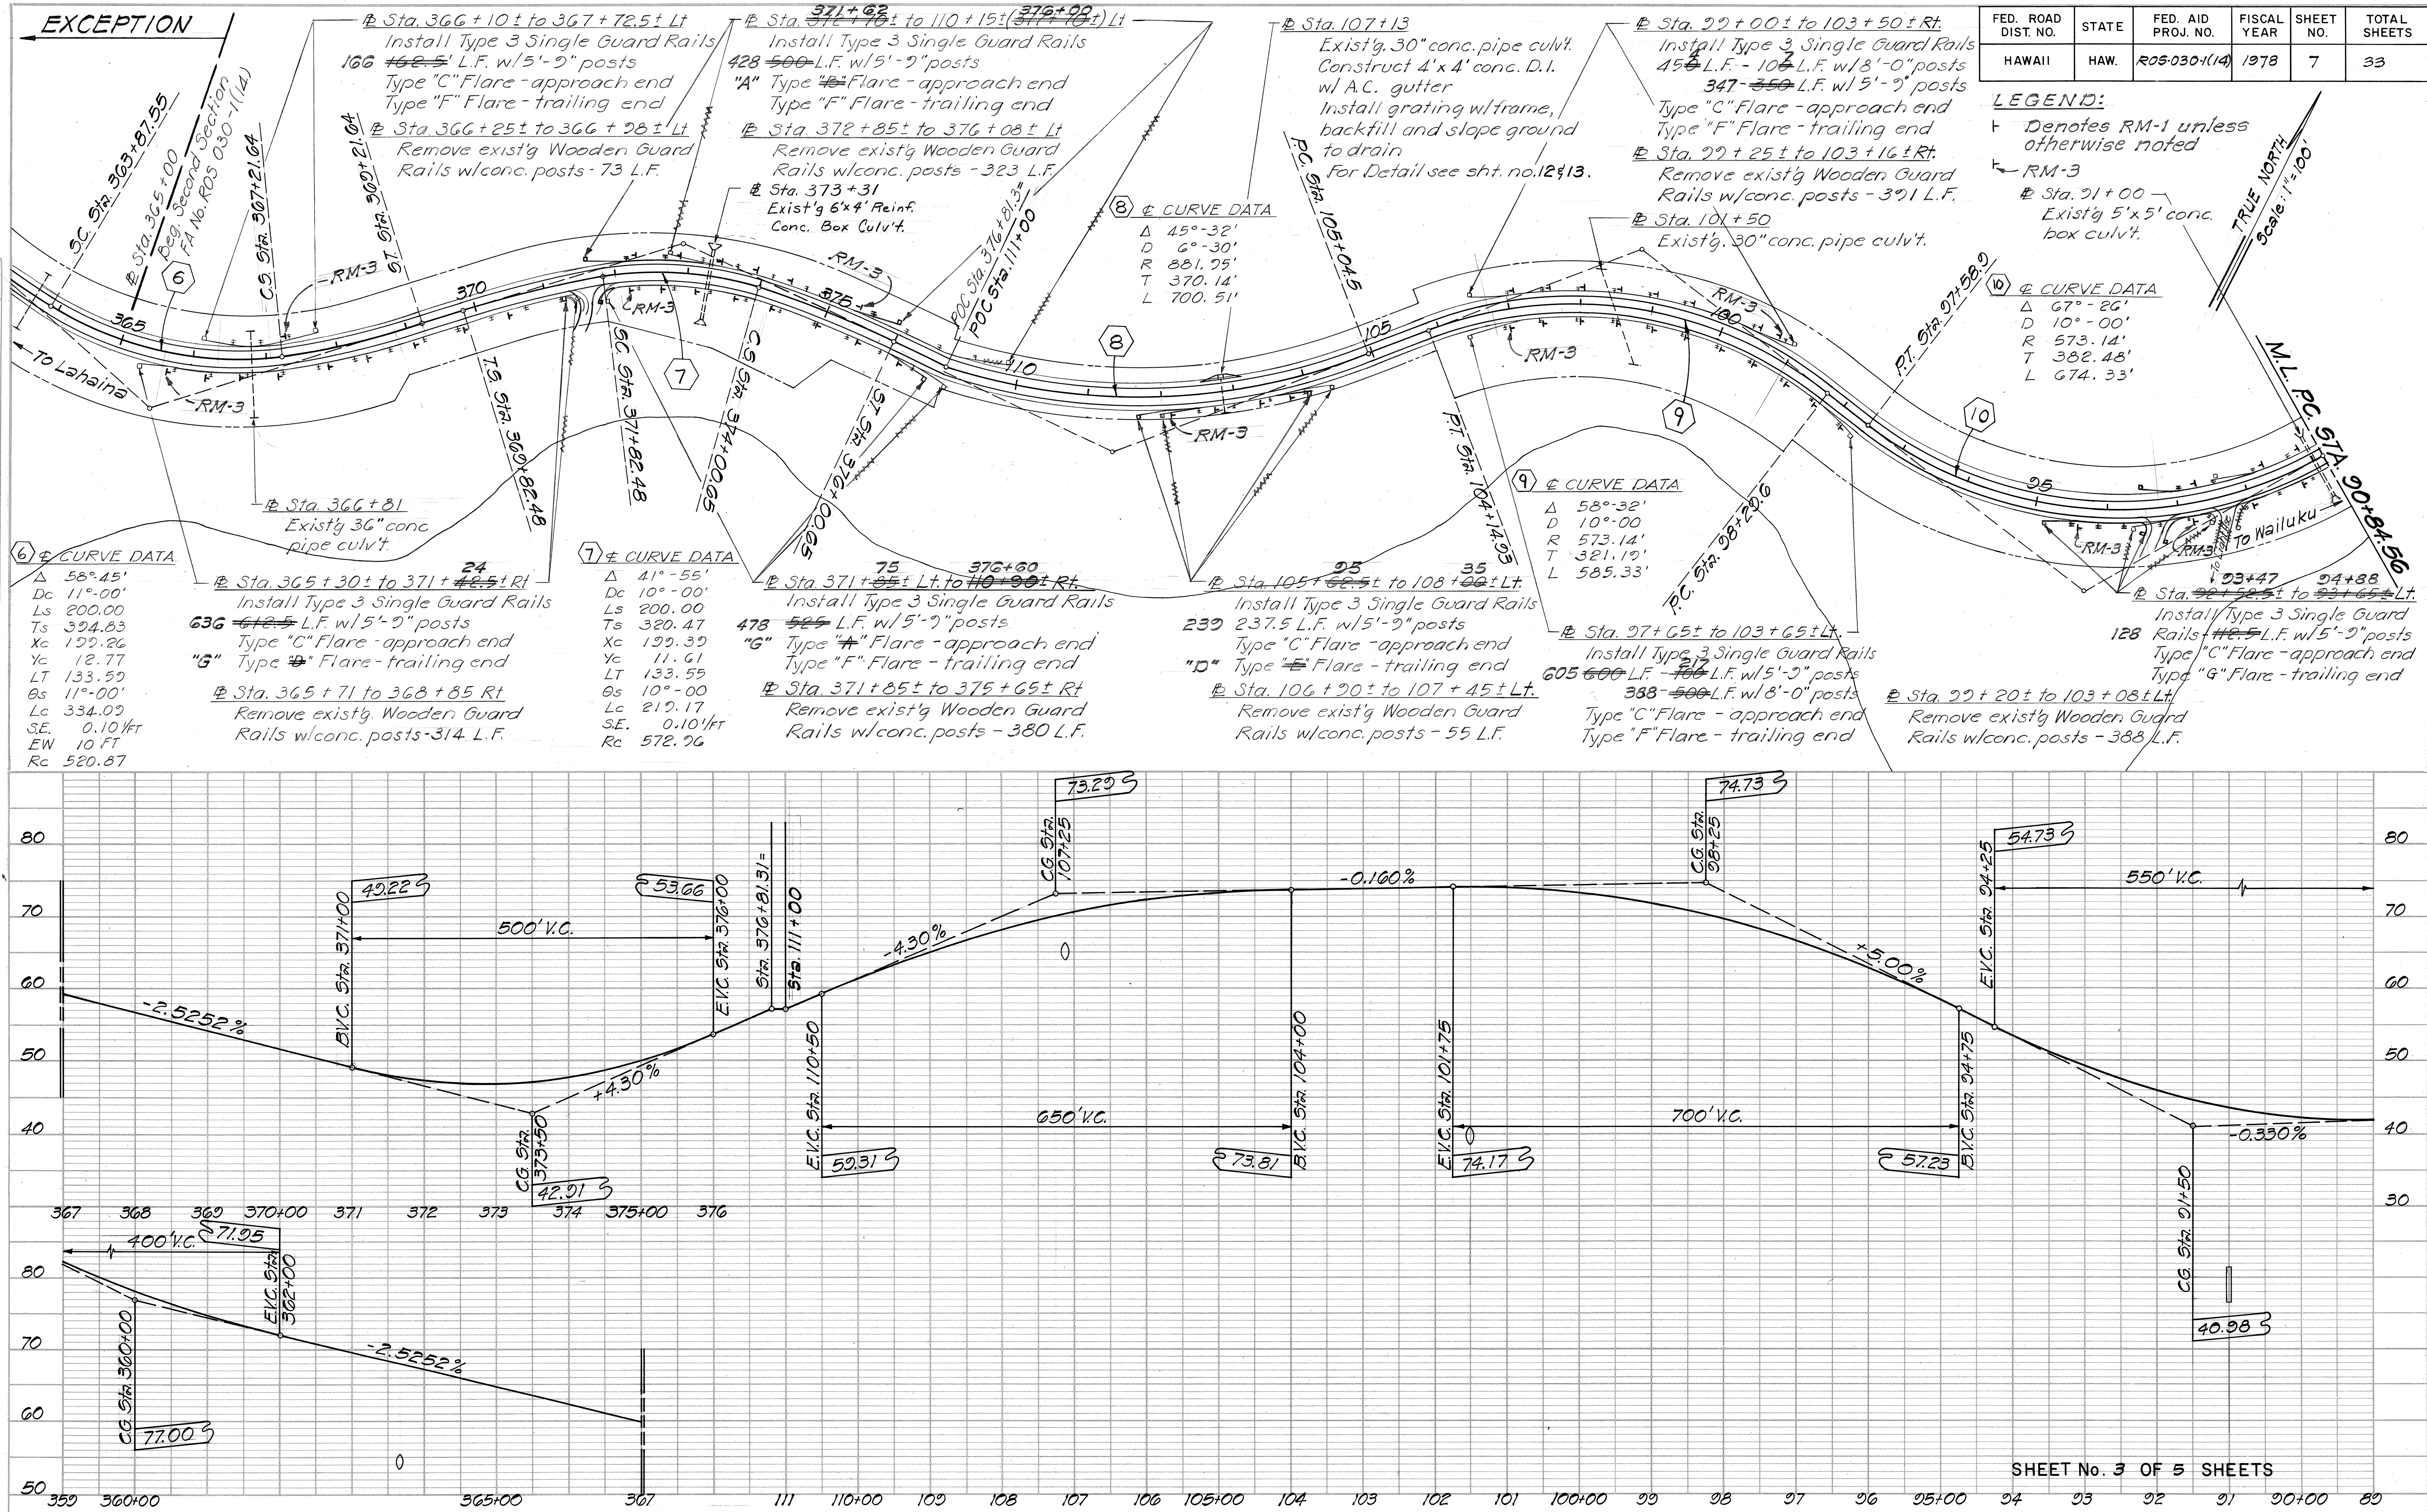

FED. ROAD DIST. NO.	STATE	FED. AID PROJ. NO.	FISCAL YEAR	SHEET NO.	TOTAL SHEETS
HAWAII	HAW.	ROS-0301(14)	1978	9	33

PLAN	DATE	BY
SURVEYED		
PLOTTED		
NOTE BOOK		
NO.		

PROFILE	DATE	BY
SURVEYED		
PLOTTED		
NOTE BOOK		
NO.		

