

INDEX TO DRAWINGS	
SHEET NO	DESCRIPTION
1	TITLE SHEET
2	TYPICAL SECTIONS
3	GUARD RAIL SUMMARY AND GENERAL NOTES
4	SUMMARY OF REFLECTORS, SIGNS & SHOULDER WIDTHS
5-9	PLANS
10-15	DRAINAGE DETAILS
16-17	MISCELLANEOUS DETAILS
18-33	STANDARD DETAILS

STATE OF HAWAII

DEPARTMENT OF TRANSPORTATION

LAND TRANSPORTATION FACILITIES DIVISION

HONOLULU, HAWAII

"AS-BUILT" PLANS OF


HONOAPIILANI HIGHWAY SAFETY IMPROVEMENTS

PHASE II

VICINITY OF PAPALAUA TO PALI TUNNEL

AND EAST OF PAPAWAI POINT TO MAALAEA

FED. AID PROJECT NO. ROS-030-1(14)

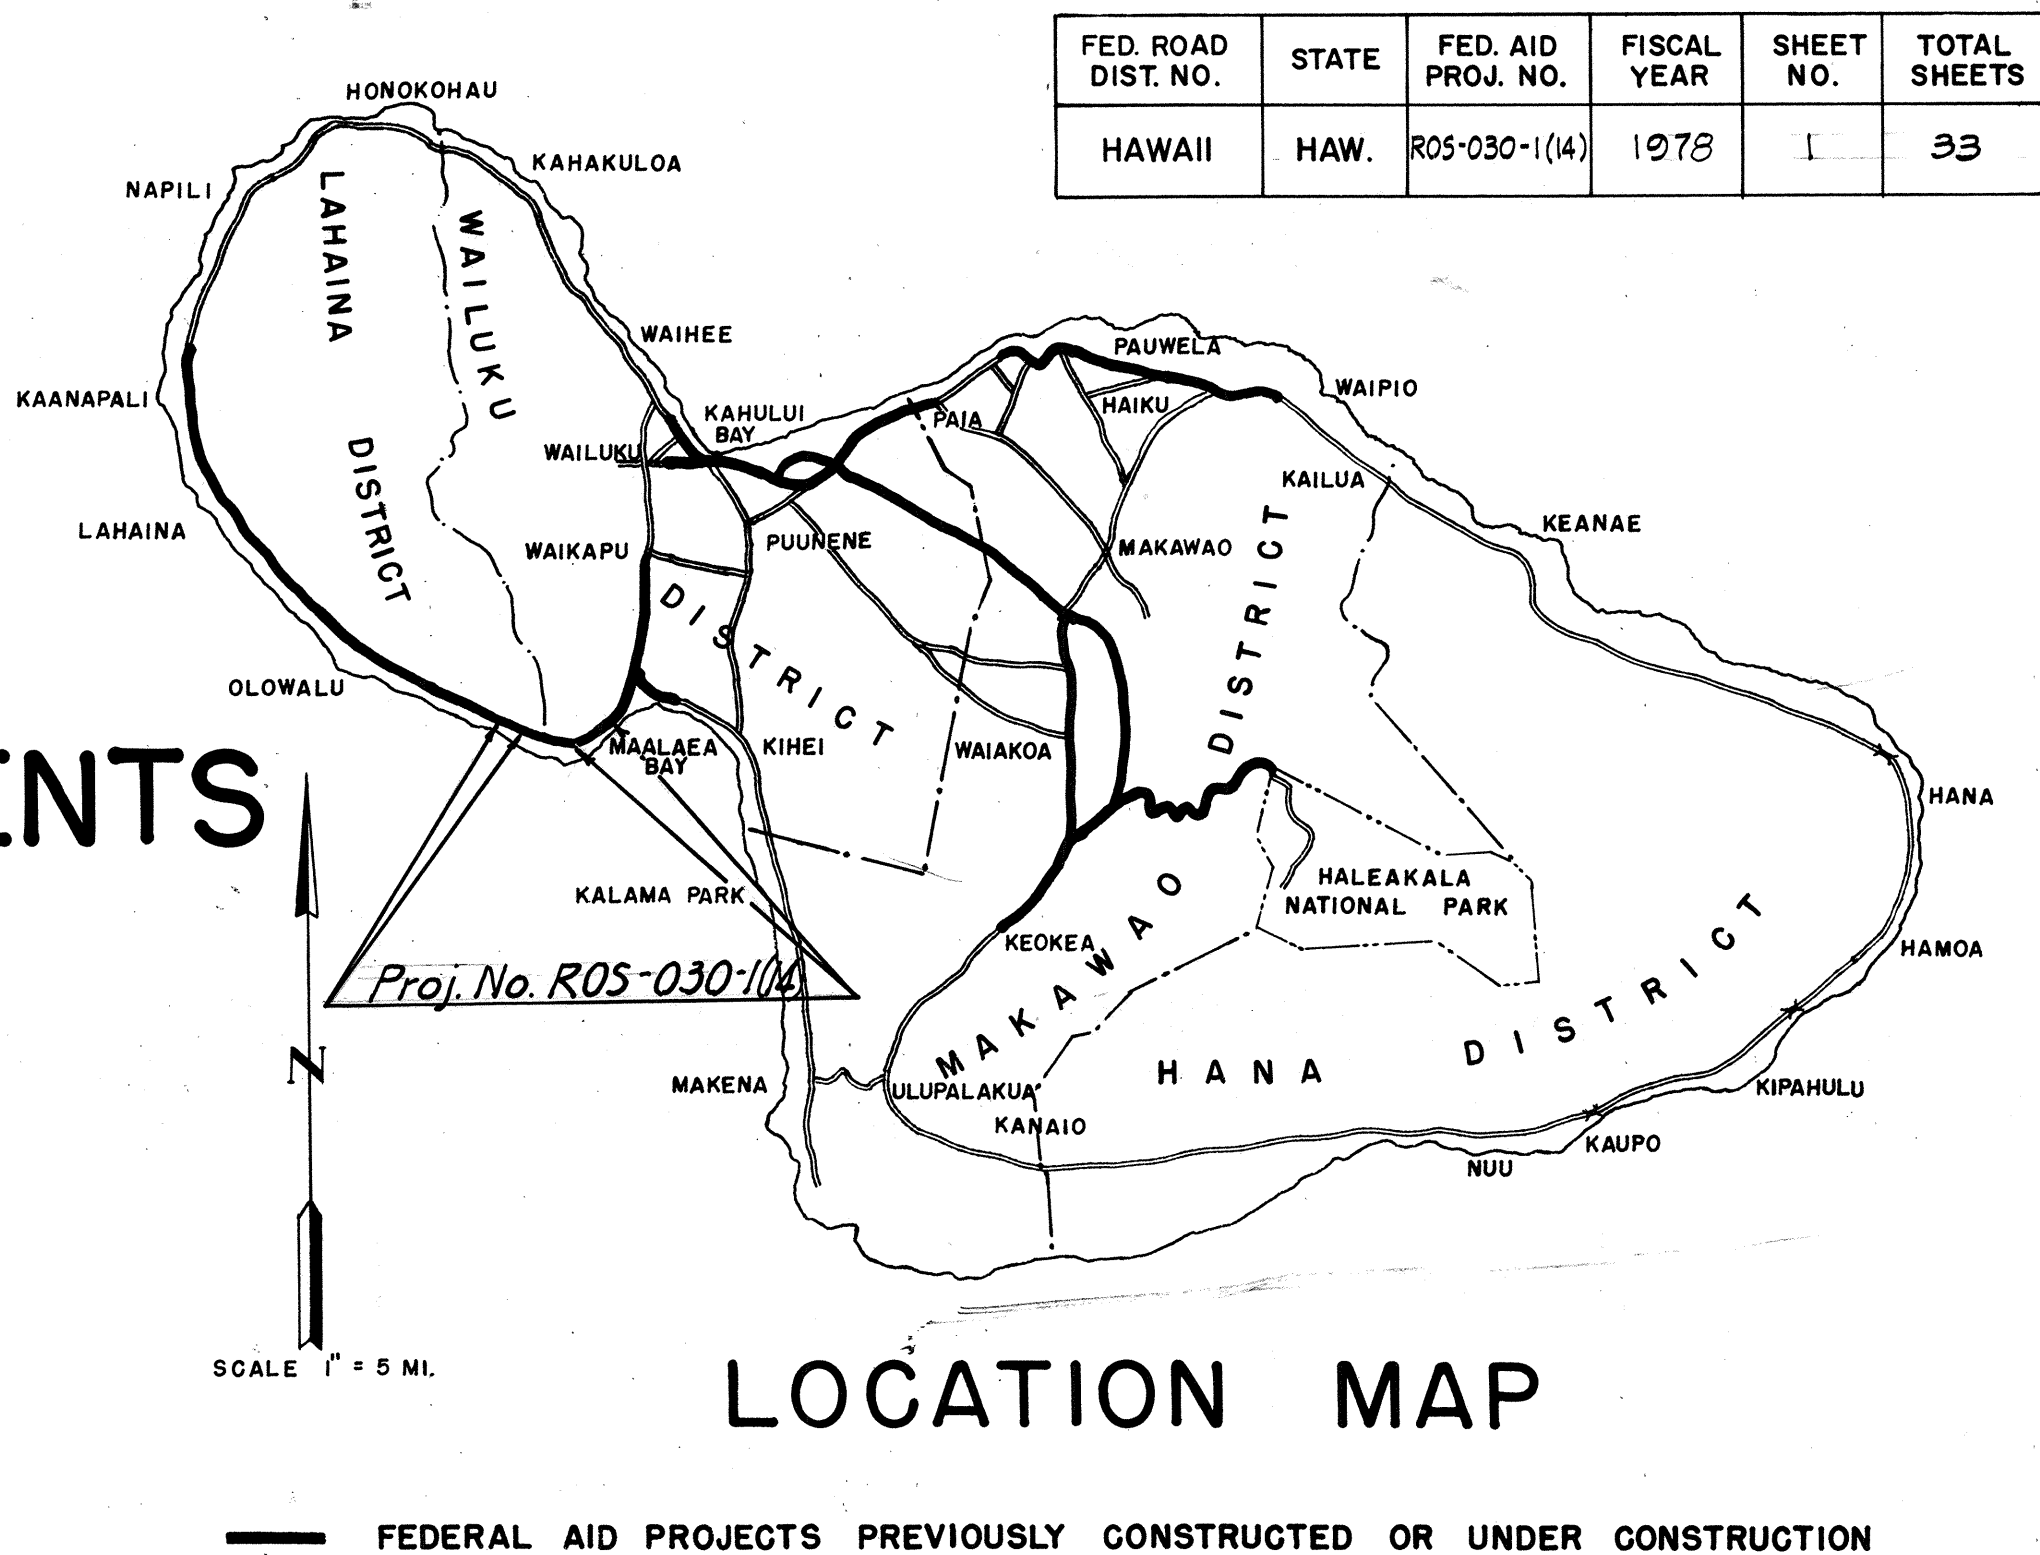

ALL CHANGES MADE DURING CONSTRUCTION HAVE BEEN INCORPORATED ON THESE PLANS IN RED EXCEPT CHANGES IN THE ORIGINAL THEORETICAL QUANTITIES. FOR ACTUAL QUANTITIES, REFER TO PROJECT LEDGER AND/OR COMPUTATION BOOK.

Stanley F. Jato
 RESIDENT ENGINEER

3/17/82
 DATE

DESIGN DESIGNATION

ADT (1976)	6,900
DHV	730
V	35 m.p.h.
D	60/40
T	8%

DEPARTMENT OF TRANSPORTATION
 STATE OF HAWAII

APPROVED:
Ryokichi Higashimura
 DIR. OF TRANSPORTATION

3/21/78
 DATE

DEPARTMENT OF TRANSPORTATION
 FEDERAL HIGHWAY ADMINISTRATION

APPROVED:
[Signature]
 DIVISION ADMINISTRATOR

3-21-78
 DATE

