



FED. ROAD DIST. NO.	STATE	FED. AID PROJ. NO.	FISCAL YEAR	SHEET NO.	TOTAL SHEETS
HAWAII	HAW.	R05-030-1(14)	1978	2	33

NOTE:


All costs to construct smooth connection to sideroads shall be incidental to item N° 304.1110, aggregate base and item N° 203.0100, roadway excavation.

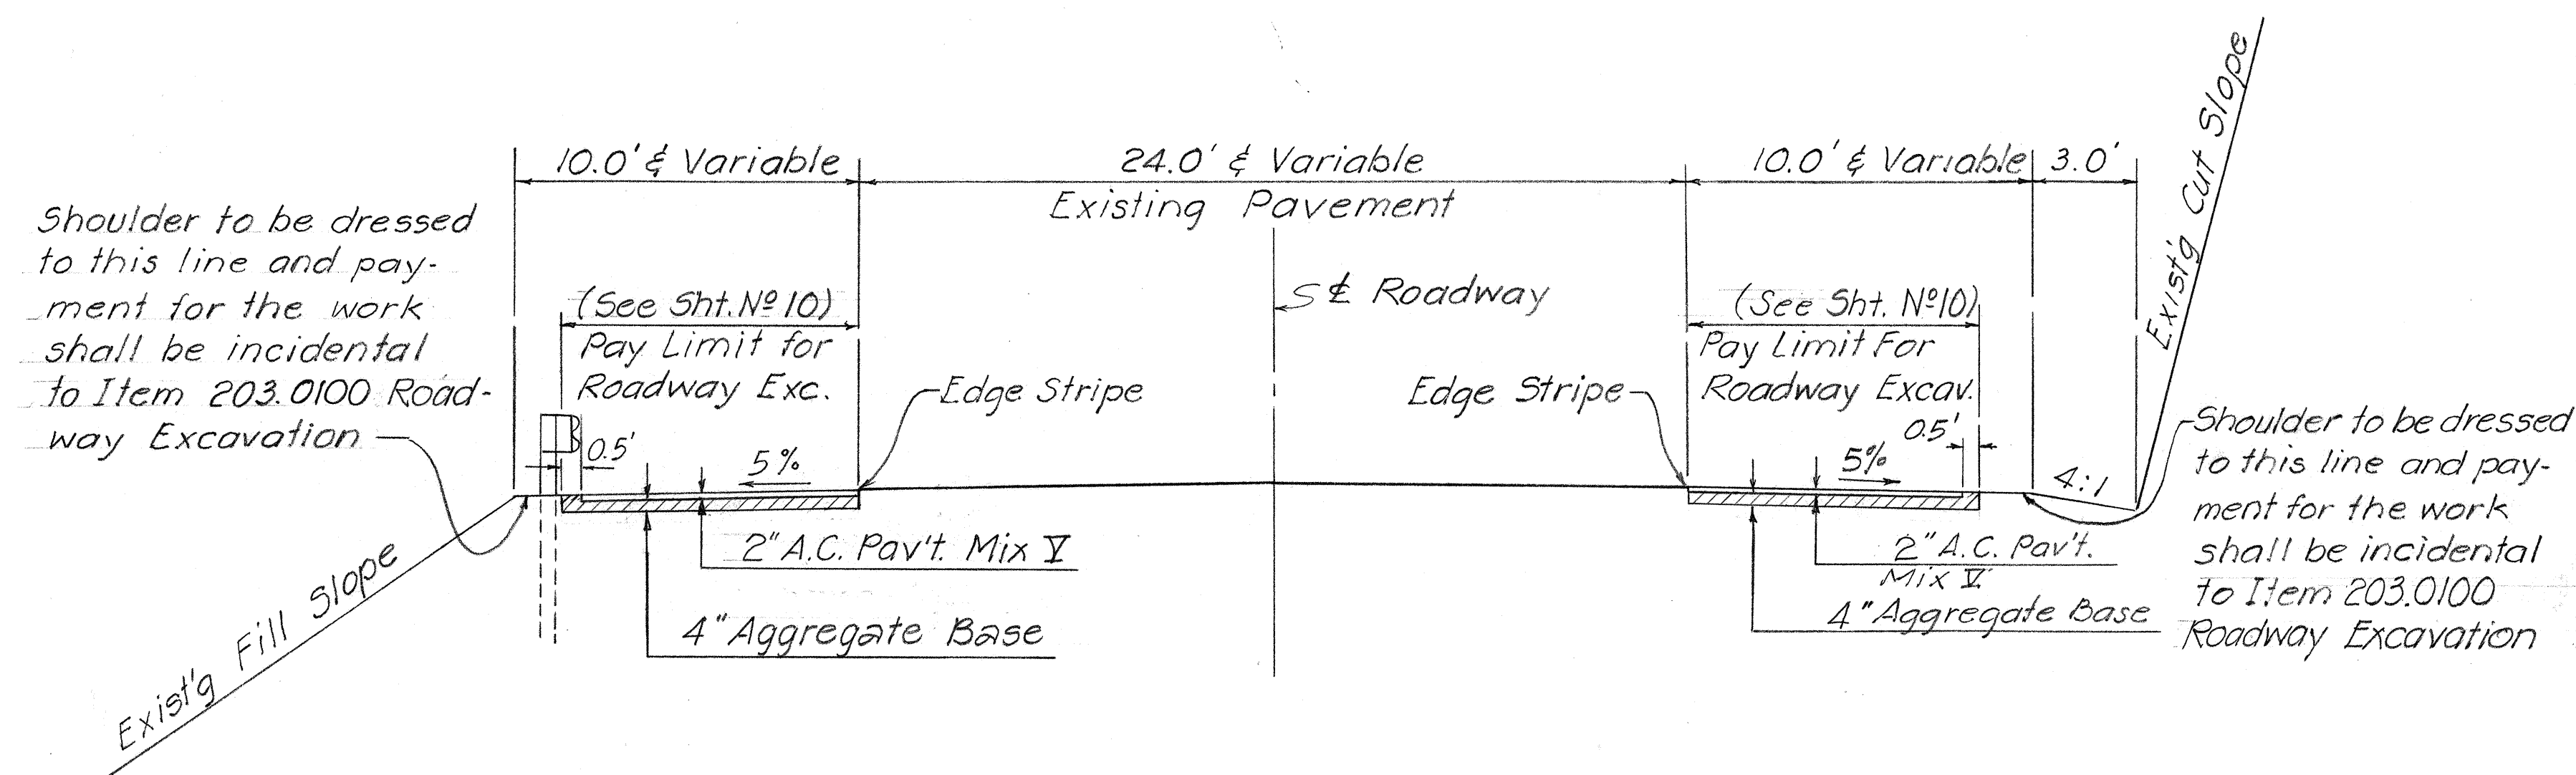

TYPICAL SECTION
ON TANGENT
Scale: 1/4" = 1'-0"

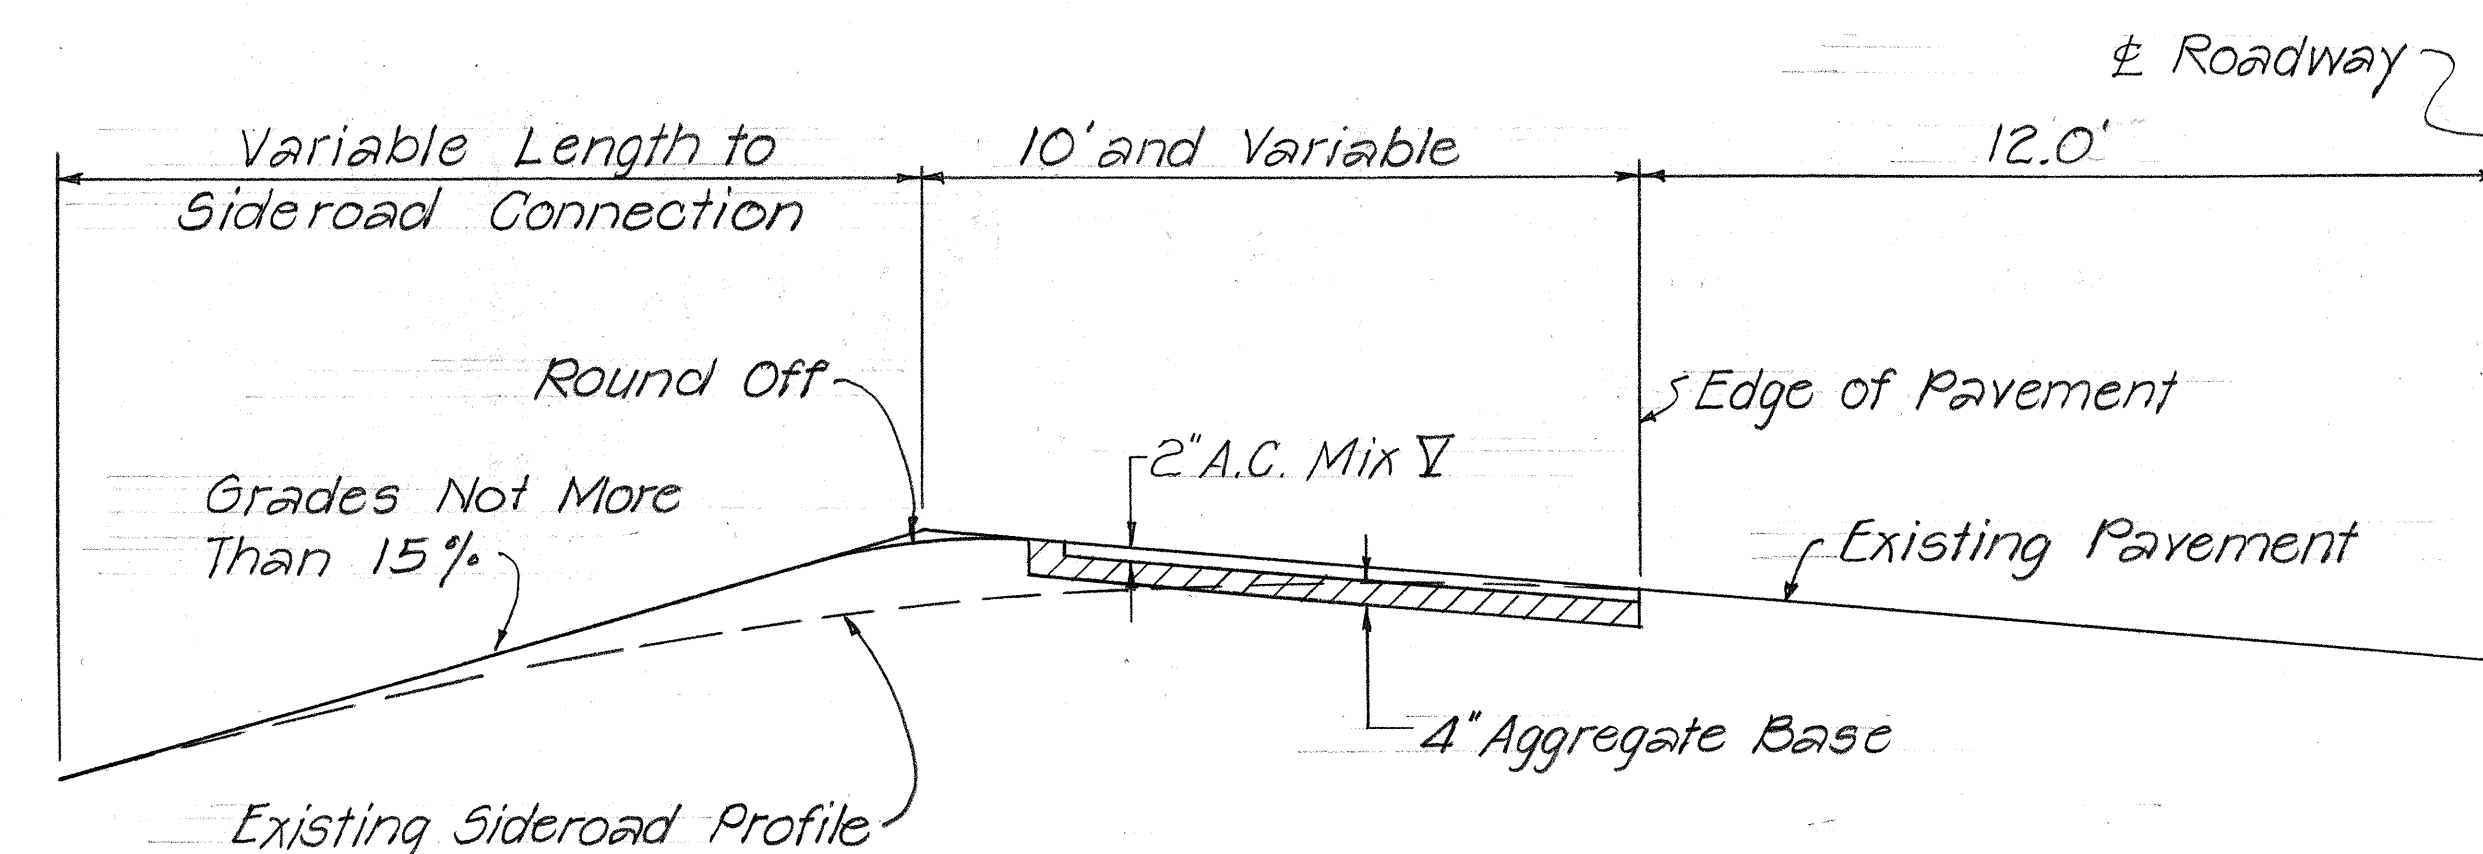


TYPICAL SECTION AT SIDEROADS
Scale: 3/8" = 1'-0"

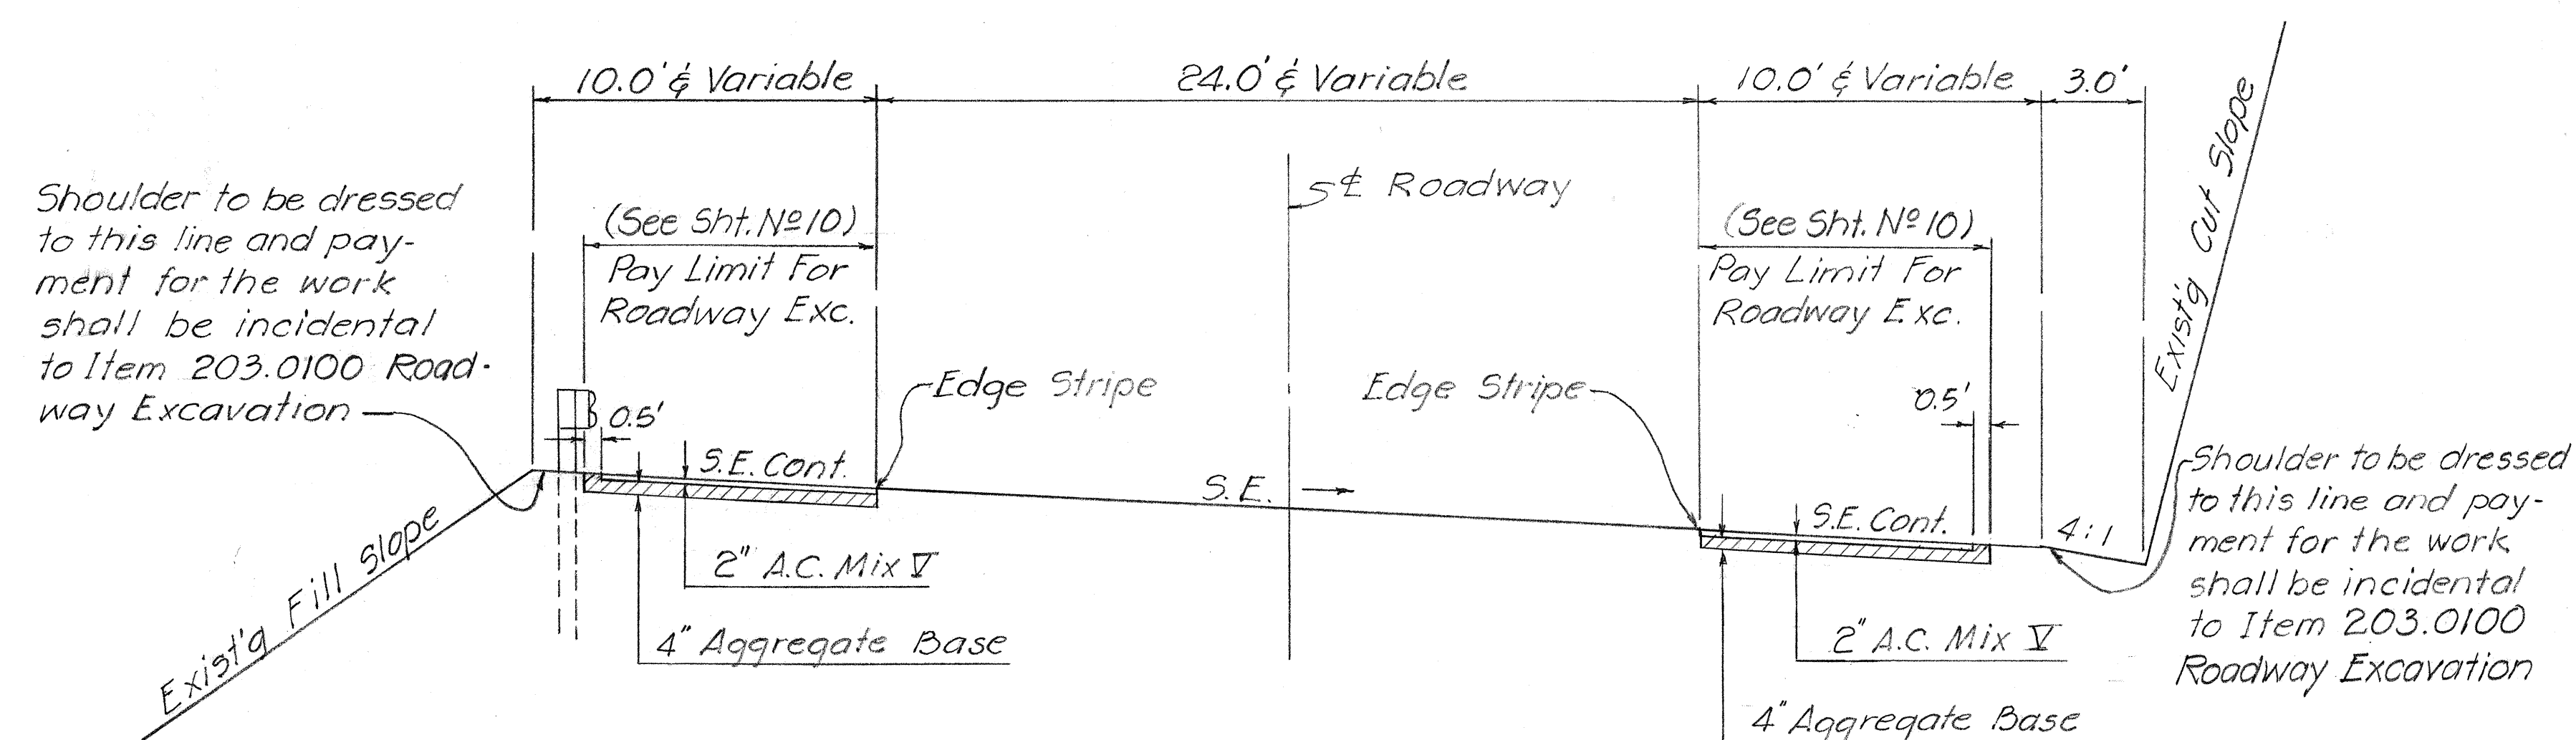

TYPICAL SECTION
ON SUPERELEVATION
Scale: 1/4" = 1'-0"

NOTE:

On high side of superelevated sections, shoulder slope shall be continuous with the pavement slope, when the slope equals or exceeds 0%. Shoulder slope on the low side shall be 5%.

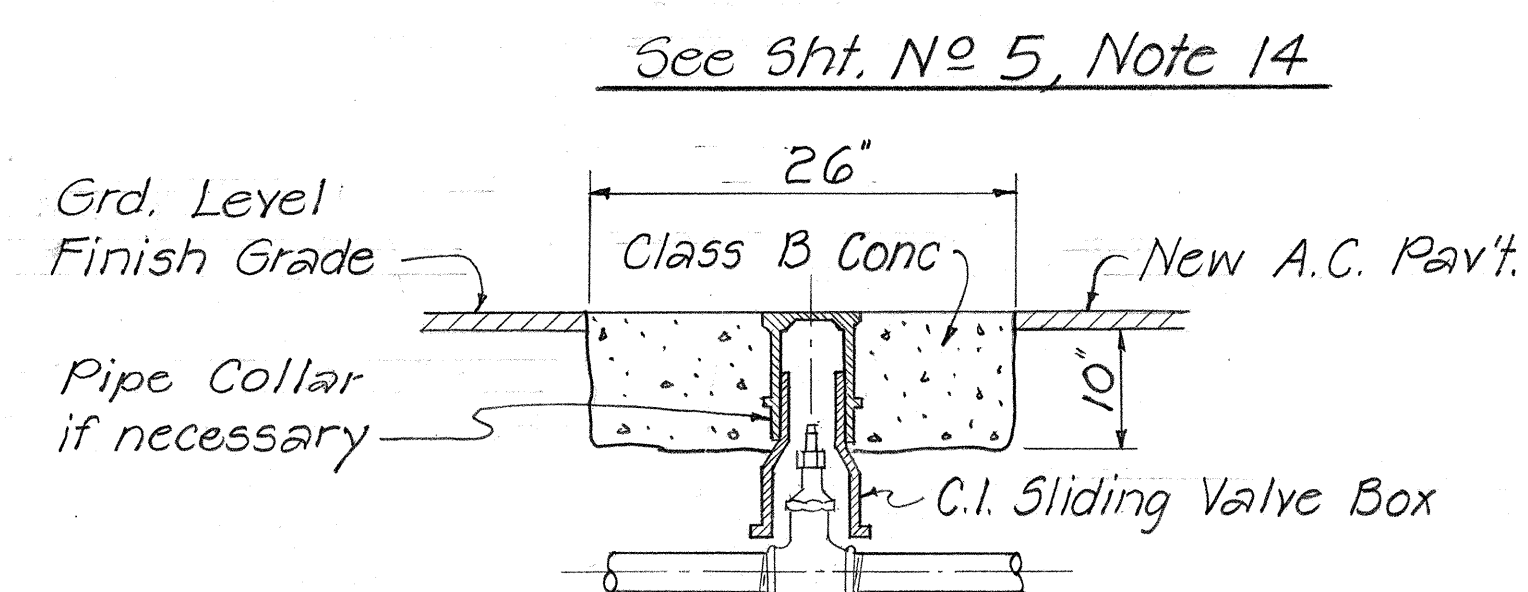

DETAIL "A"
ADJUSTED WATER VALVE BOX
No Scale

STATE OF HAWAII DEPARTMENT OF TRANSPORTATION HIGHWAYS DIVISION				
TYPICAL SECTION				
HONOAPIILANI HIGHWAY F.A. Proj. No. R05-030-1(14)				
Scale: As Shown Date: Aug. 1976				
SHEET No. 1 OF 1 SHEETS				