

INDEX TO DRAWINGS	
SHEET NO	DESCRIPTION
1	TITLE SHEET
2	TYP SEC., DET., GEN. NOTES
3-11	PLANS
12-13	TYP PAV'T MARKING DET.
14-15	STANDARD DETAILS

STATE OF HAWAII

DEPARTMENT OF TRANSPORTATION

LAND TRANSPORTATION FACILITIES DIVISION

HONOLULU, HAWAII

"AS BUILT" PLANS OF

HONOAPIILANI HIGHWAY RESURFACING

HONOKOWAI TO DICKENSON STREET

PROJECT NO. 30AB-01-78M


DISTRICT OF LAHAINA

COUNTY OF MAUI

ISLAND OF MAUI

SCALES

PLAN		1 IN. = 100 FT.
PROFILE	HOR.	1 IN. = FT.
	VER.	1 IN. = FT.
X-SECTIONS	HOR.	1 IN. = FT.
	VER.	1 IN. = FT.

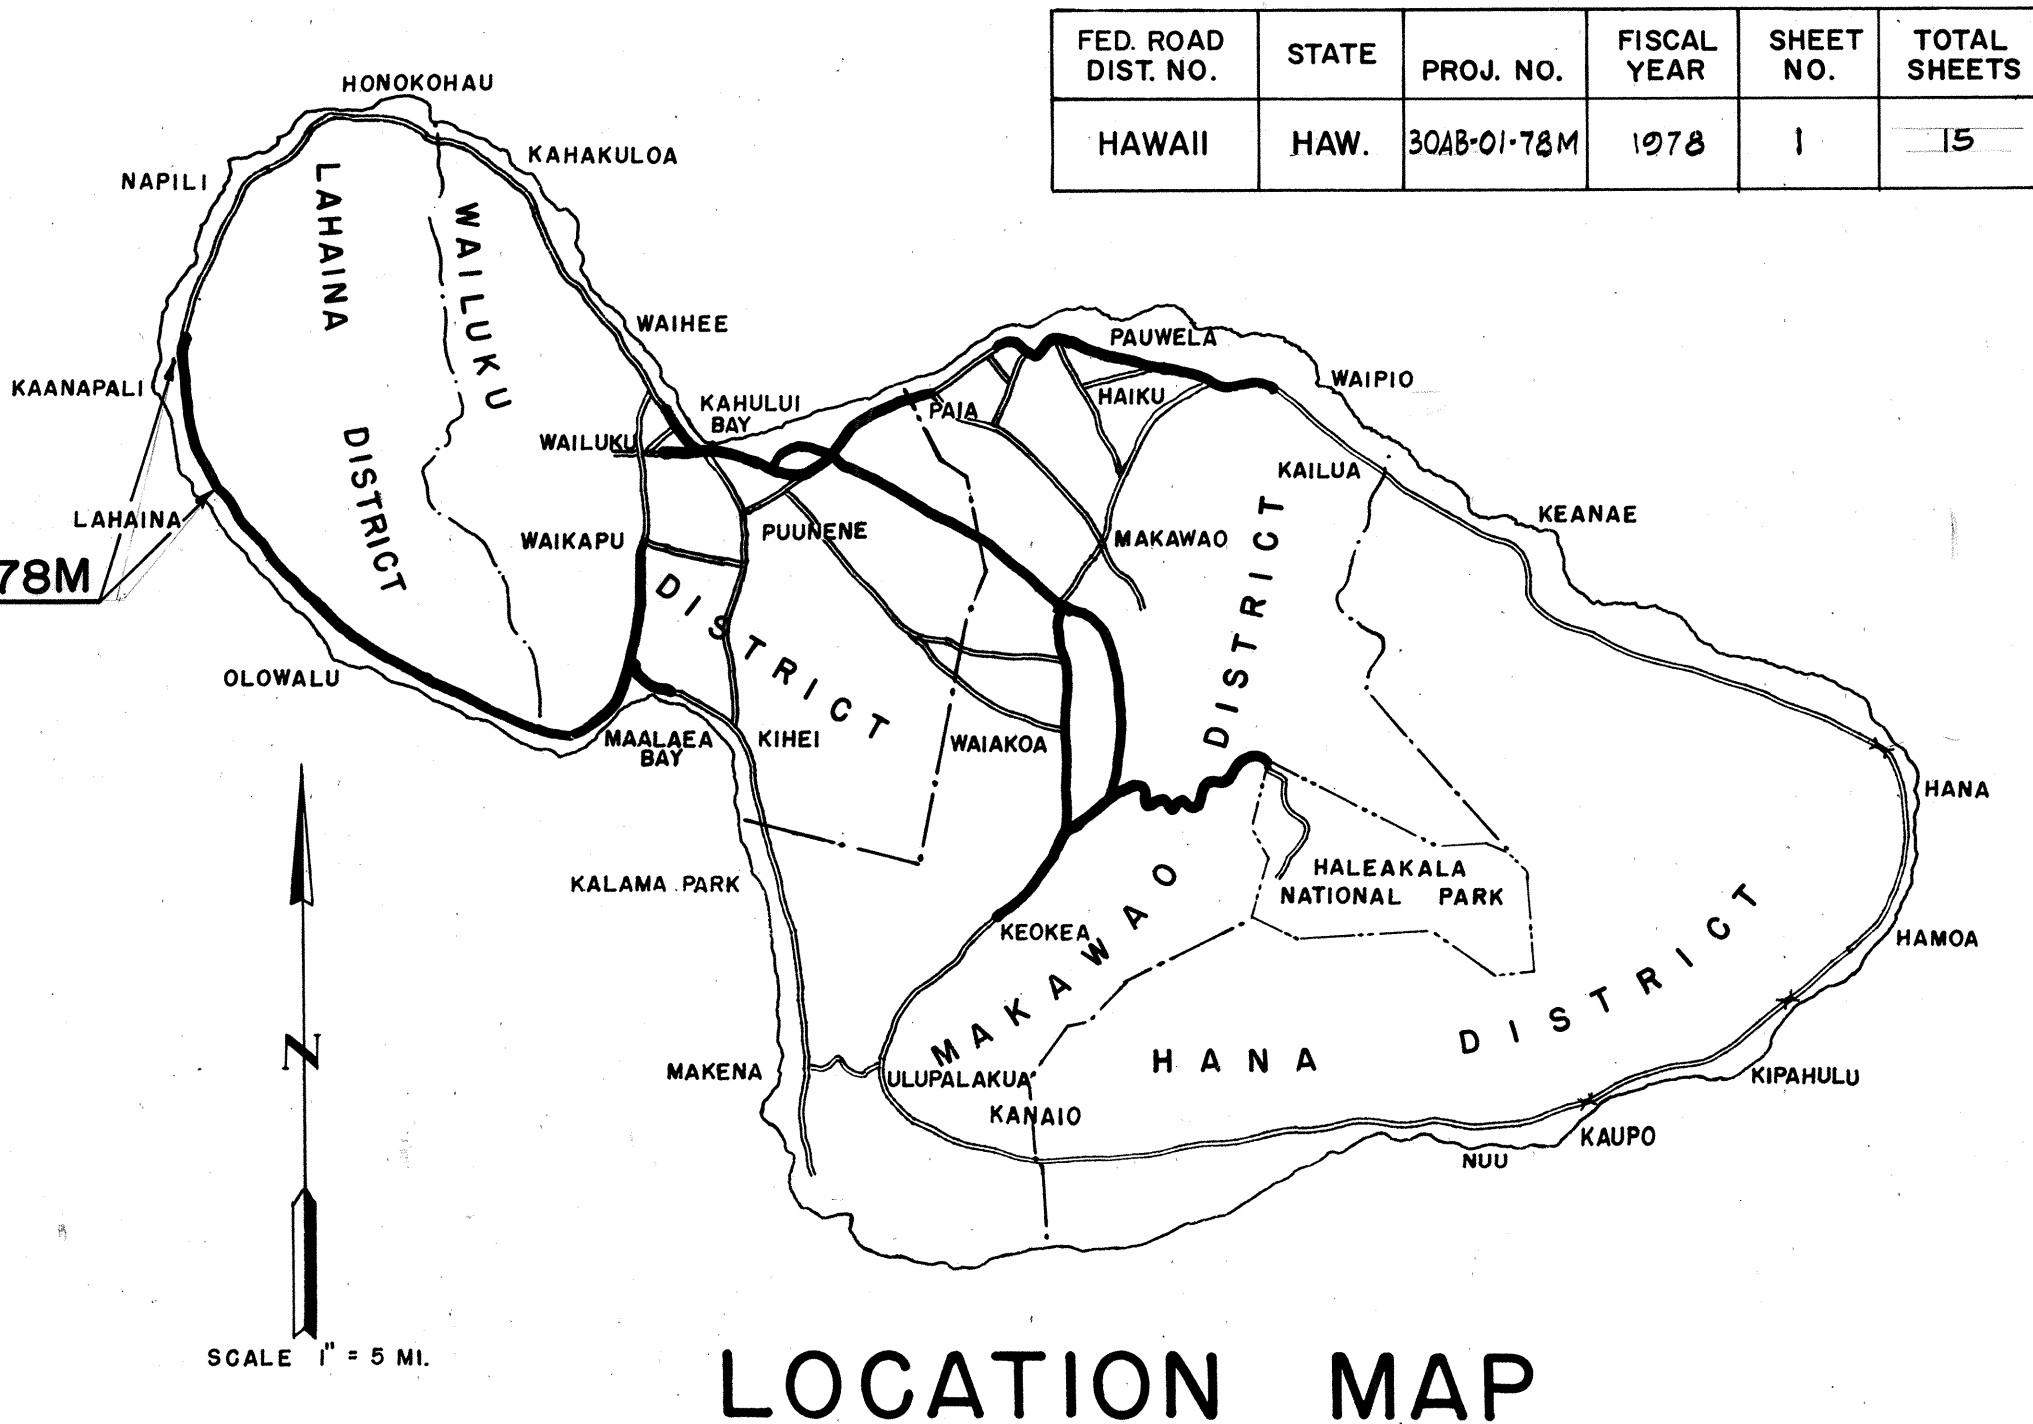

— FEDERAL AID PROJECTS PREVIOUSLY CONSTRUCTED OR UNDER CONSTRUCTION

DESIGNED BY: MAUI DISTRICT OFFICE

DATE: FEB. 1978

A. NISHIMURA

P. S. & E. BY

548-7537


PHONE

"F"

HWY. DESIGN UNIT

FEB. 1978

DATE

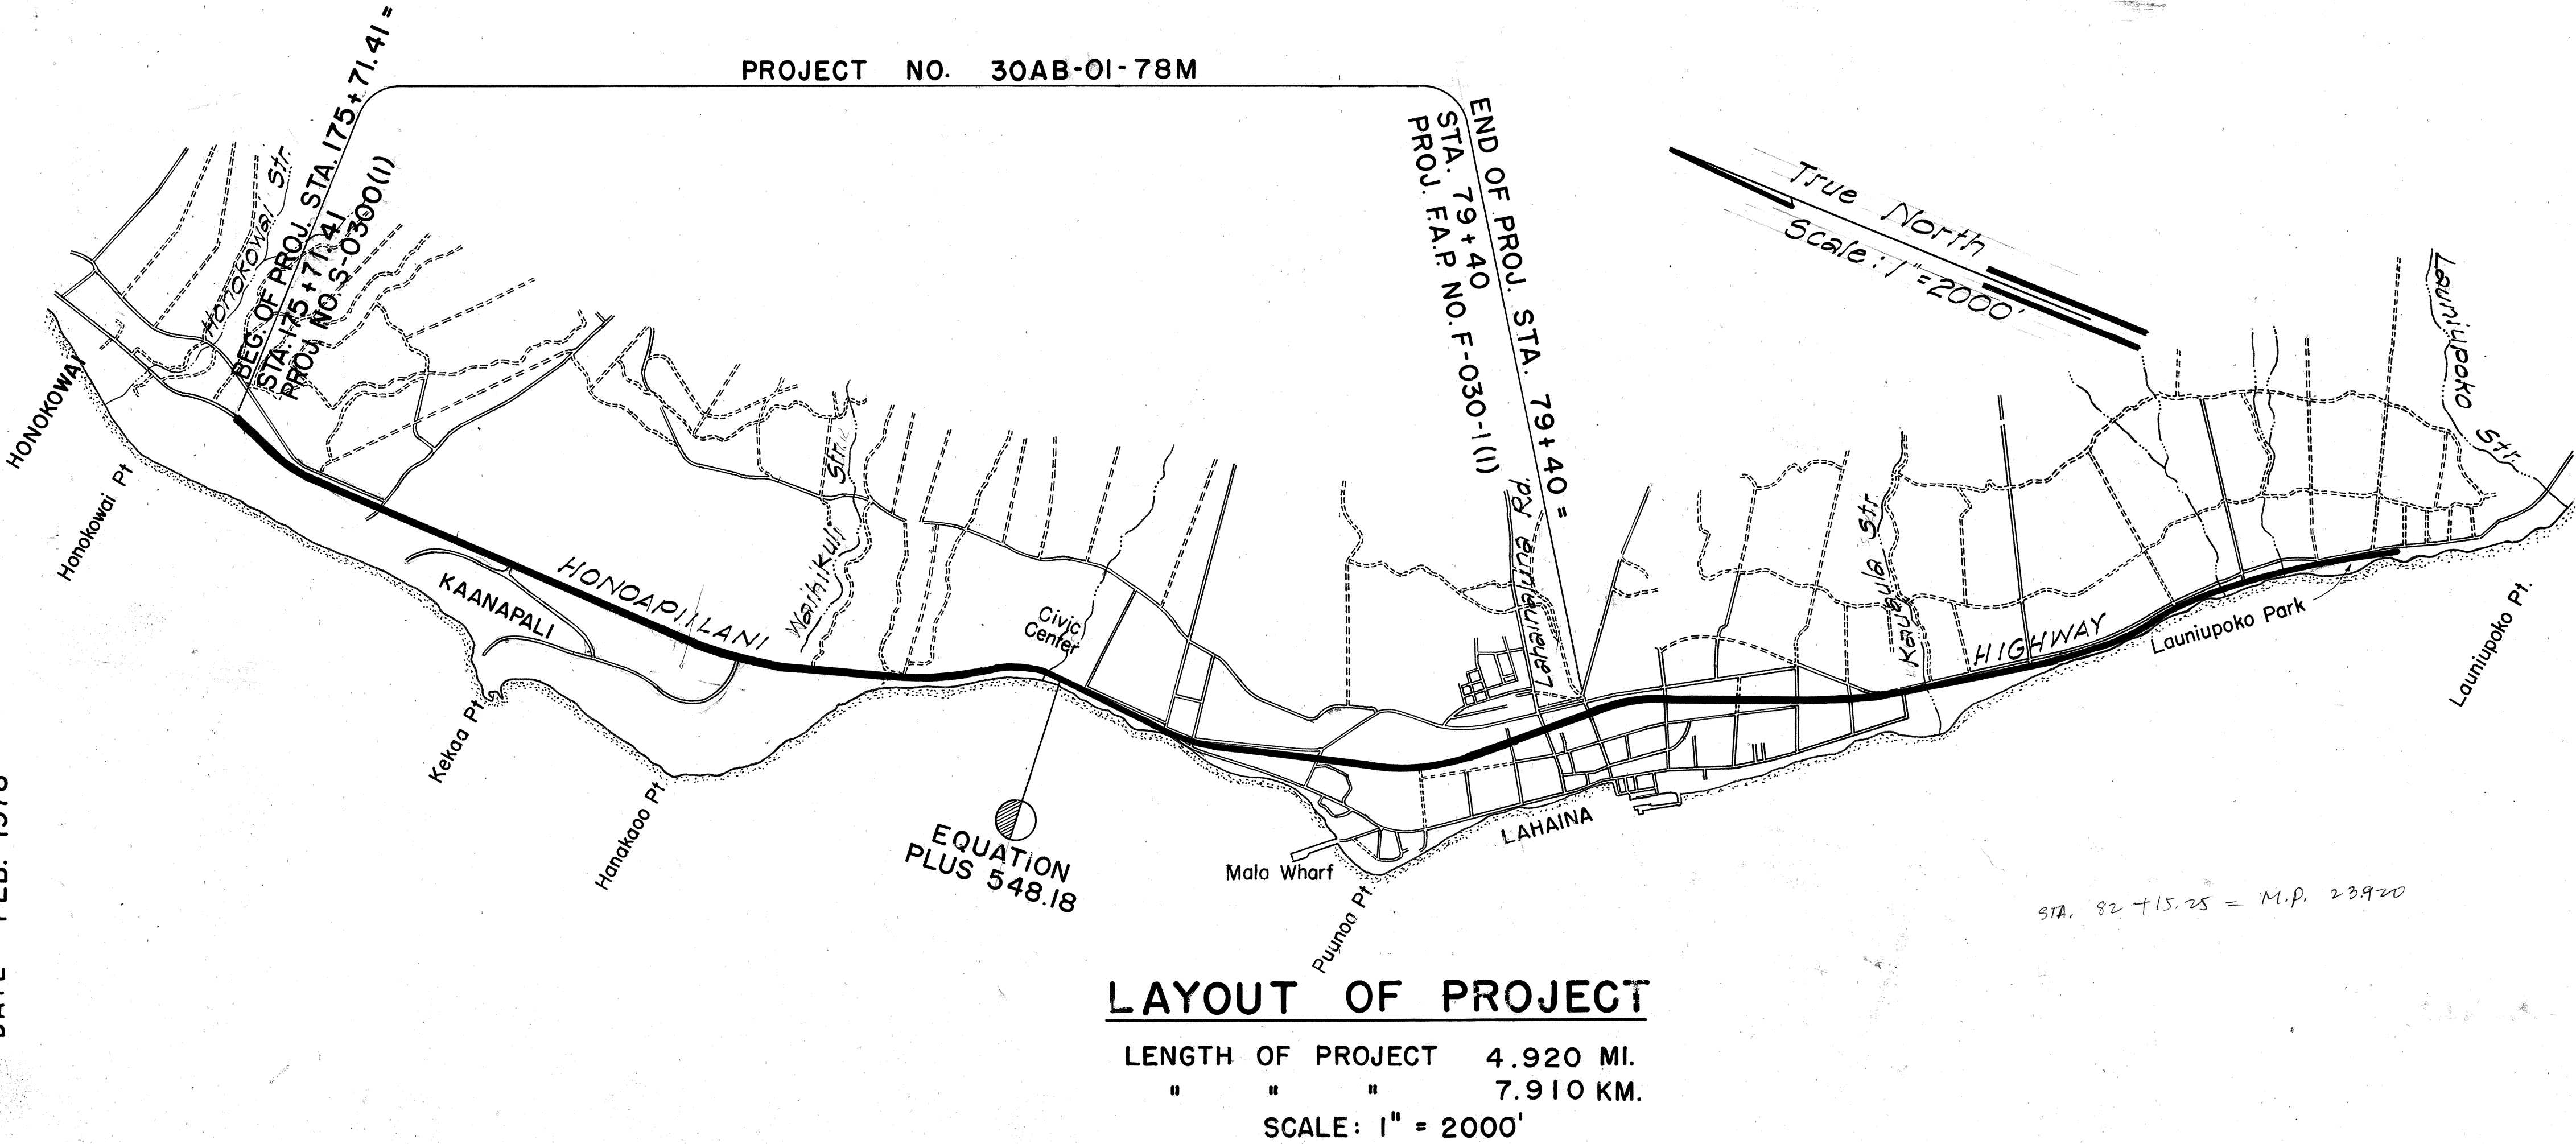

NOTE:

ALL CHANGES MADE DURING CONSTRUCTION

HAVE BEEN NOTED IN RED ON THESE TRACINGS

AND CHECKED BY

Manuel J. Silva

RESIDENT ENGINEER

9/27/78

DATE

DEPARTMENT OF TRANSPORTATION

STATE OF HAWAII

APPROVED:

R. Higashionna

5/4/78

DIR. OF TRANSPORTATION

DATE