


FED. ROAD DIST. NO.	STATE	FED. AID PROJ. NO.	FISCAL YEAR	SHEET NO.	TOTAL SHEETS
HAWAII	HAW.	F-030-1(13)	1979	60135-1	174

CURVE DATA		
	H-4	H-19
Δ	17°57'00"	4°56'6.67"
R	5,000.00'	7,500.00'
L	1,569.34'	646.01'
T	791.18'	323.21'

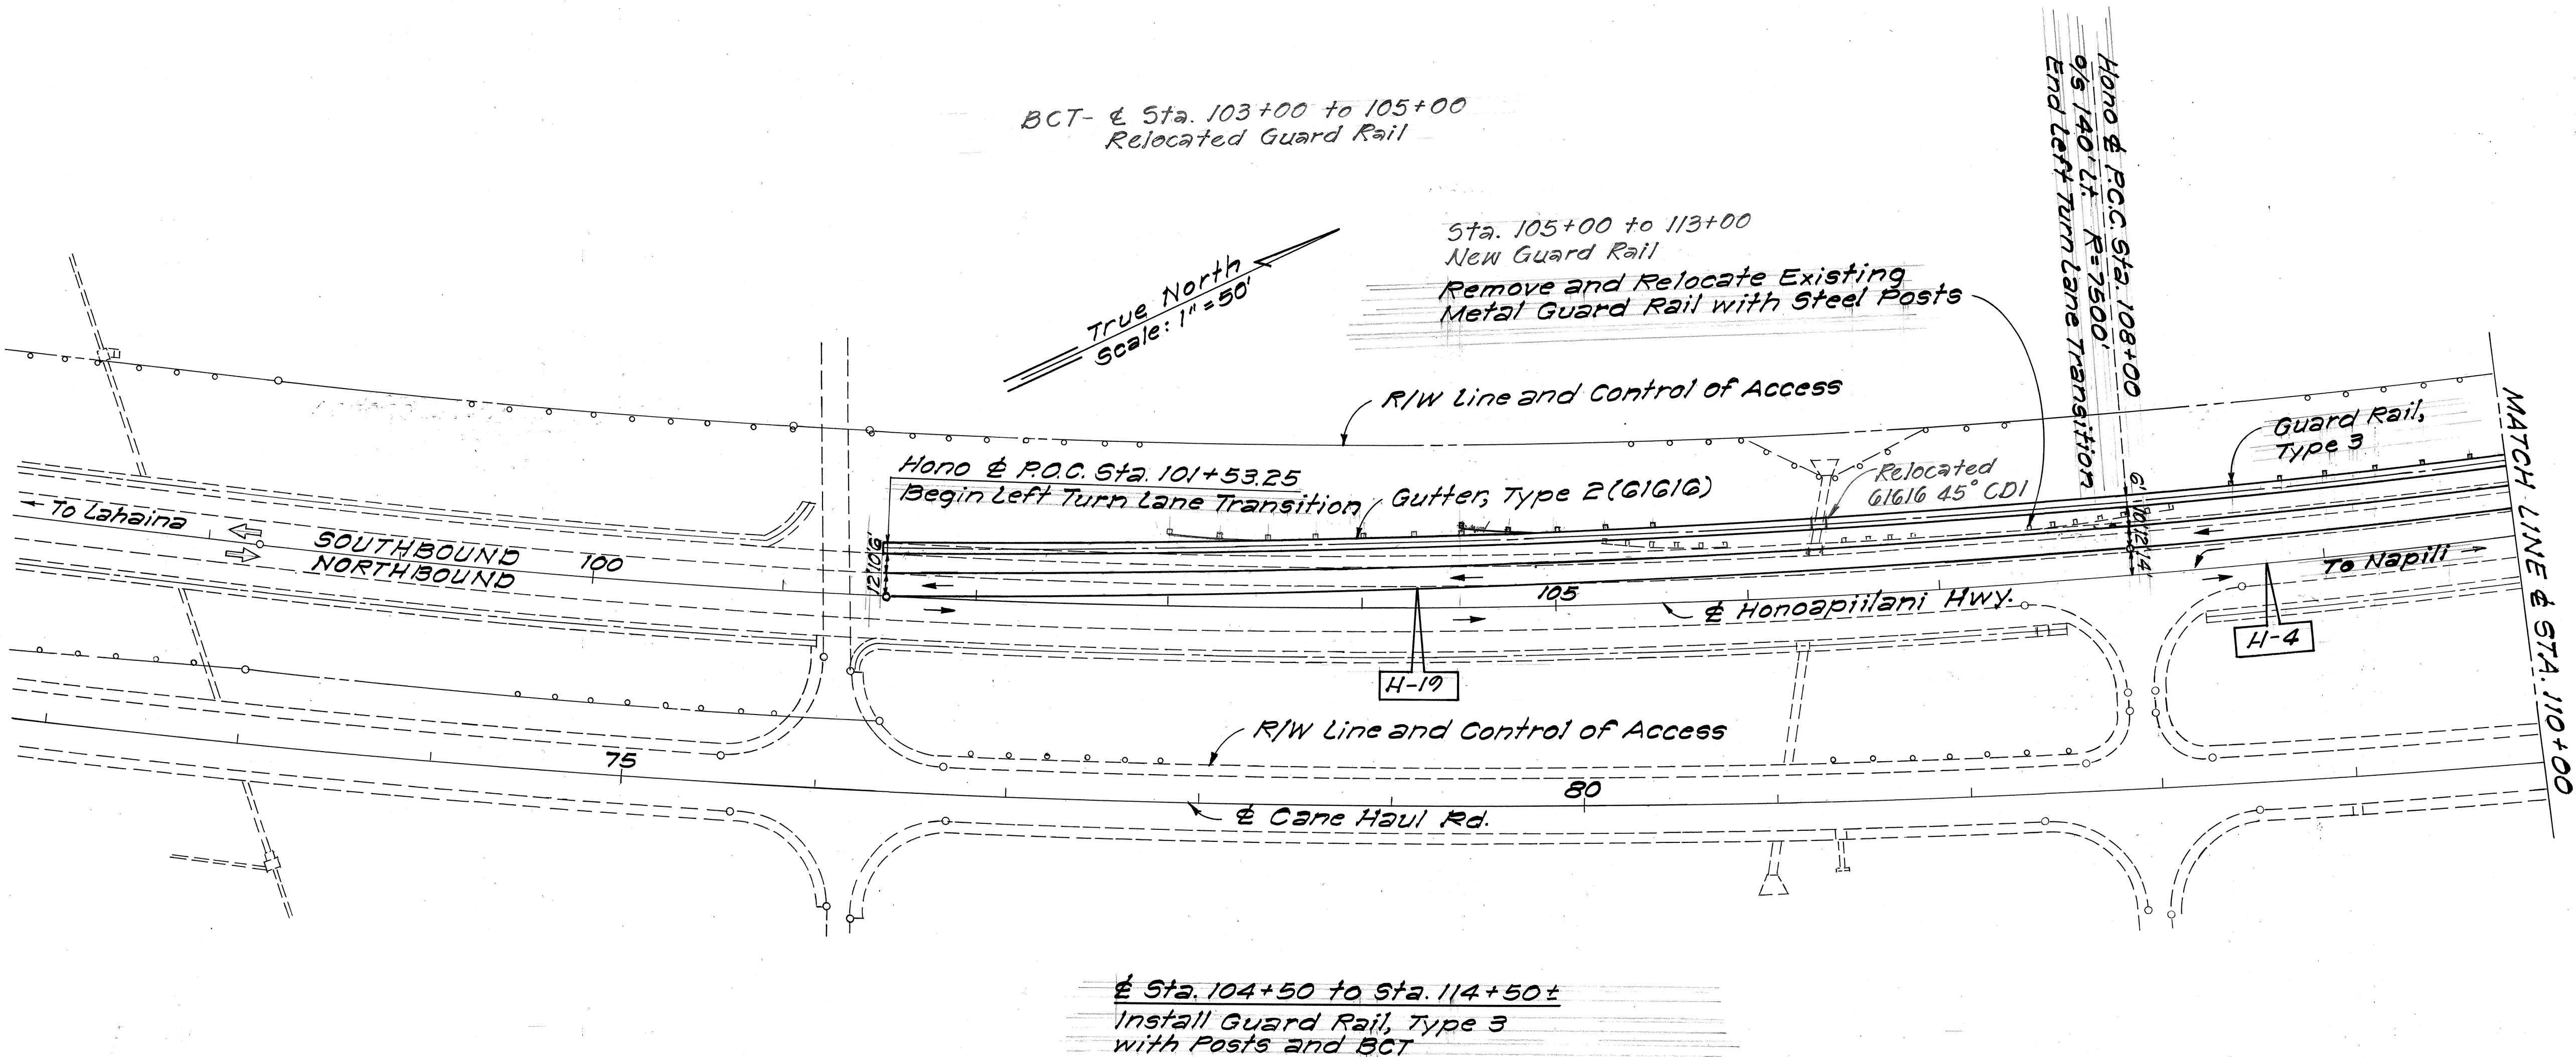

ORIGINAL PLAN	SURVEY PLOTTED BY	DATE
NOTE BOOK	DRAWN BY	" "
	DESIGNED BY	" "
	QUANTITIES BY	" "
	CHECKED BY	" "
No.		


9/19/79	Finalize roadway work for Left Turn Lane for Inter-section at Sta. 115+80
8/29/79	Add left-turn lane for proposed connector at Sta. 115+80.
DATE	REVISION

STATE OF HAWAII
DEPARTMENT OF TRANSPORTATION
LAND TRANSPORTATION FACILITIES DIVISION

CONNECTOR TO LOWER
HONOAPIILANI ROAD
HONOAPIILANI HIGHWAY
Kahana to Alae'oa
F.A. Project No. F-030-1(13)
Scale: 1"=50' Date: July, 1979
SHEET NO. 1 OF 2 SHEETS

FED. ROAD DIST. NO.	STATE	FED. AID PROJ. NO.	FISCAL YEAR	SHEET NO.	TOTAL SHEETS
HAWAII	HAW.	F-030-1(13)	1979	6013 S-2	174

CURVE DATA				
	H-4	CON-1	CON-2	CON-3
Δ	17°57'00"	85°51'8.6"	90°00'00"	23°30'00"
R	5,000.00	50.00	50.00	500.00
L	1,569.34	74.92	78.54	205.08
T	791.18	46.51	50.00	104.00

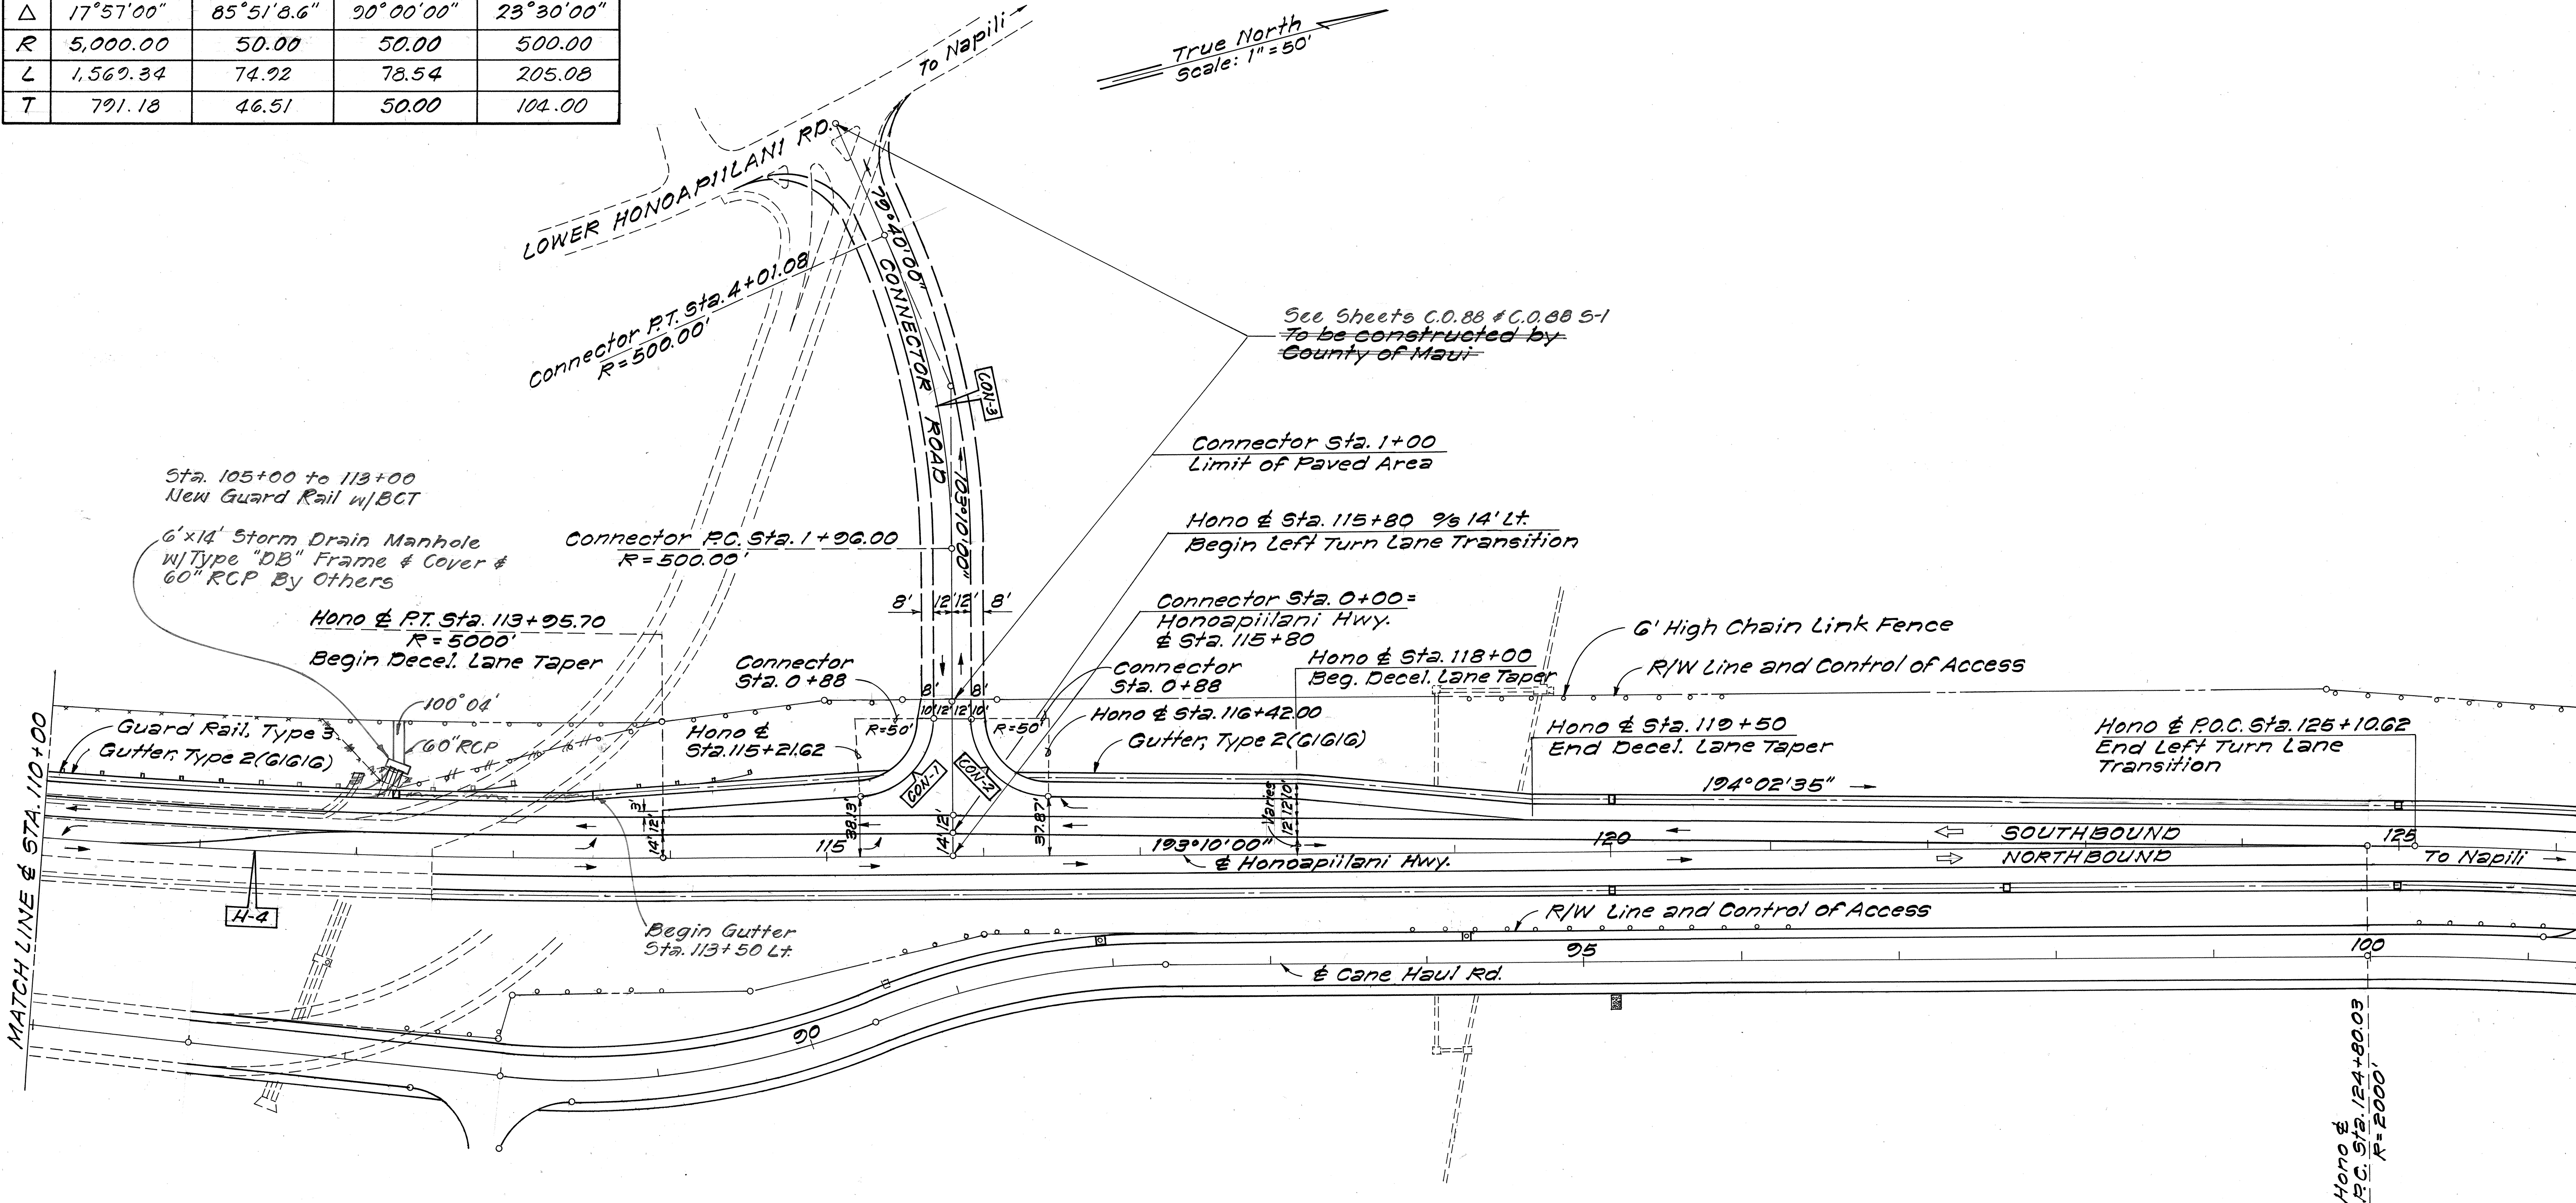

DATE	_____
SURVEY PLOTTED BY	_____
DRAWN BY	_____
TRACED BY	_____
DESIGNED BY	_____
QUANTITIES BY	_____
CHECKED BY	_____
ORIGINAL PLAN	_____
NOTE BOOK	_____
No.	_____

9/19/79	Finalize roadway work for Left Turn Lane for Intersection at Sta. 115+80
8/29/79	Add left-turn lane for proposed connector at Sta. 115+80.
DATE	REVISION

STATE OF HAWAII
DEPARTMENT OF TRANSPORTATION
LAND TRANSPORTATION FACILITIES DIVISION

CONNECTOR TO LOWER HONOAPIILANI ROAD

HONOAPIILANI HIGHWAY
Kahala to Aiea/oa
F.A. Project No. F-030-1(13)

Scale: 1"=50' Date: July, 1979

SHEET NO. 2 OF 2 SHEETS

C.O. 13 S-2