


FED. ROAD DIST. NO.	STATE	FED. AID PROJ. NO.	FISCAL YEAR	SHEET NO.	TOTAL SHEETS
HAWAII	HAW.	F030-1(13)	1978	81	174

GENERAL NOTES

1. All fill and cut slopes shall be hydro-mulched (with Bermuda seed) except where condition does not permit hydro-mulching such as on rock slopes. The rock limits (hatched areas) as shown on the plans are approximate only. The Engineer shall determine where hydro-mulching is not required.
2. All eroded slopes shall be filled and dressed before hydro-mulching.
3. For additional requirements see Section G41 - HYDRO-MULCH SEEDING of the Hawaii Standard Specifications for Road and Bridge Construction, 1976.
4. The Contractor shall take precautionary measures when hydro-mulching areas adjacent to the sugar cane fields to avoid damage to the sugar cane.

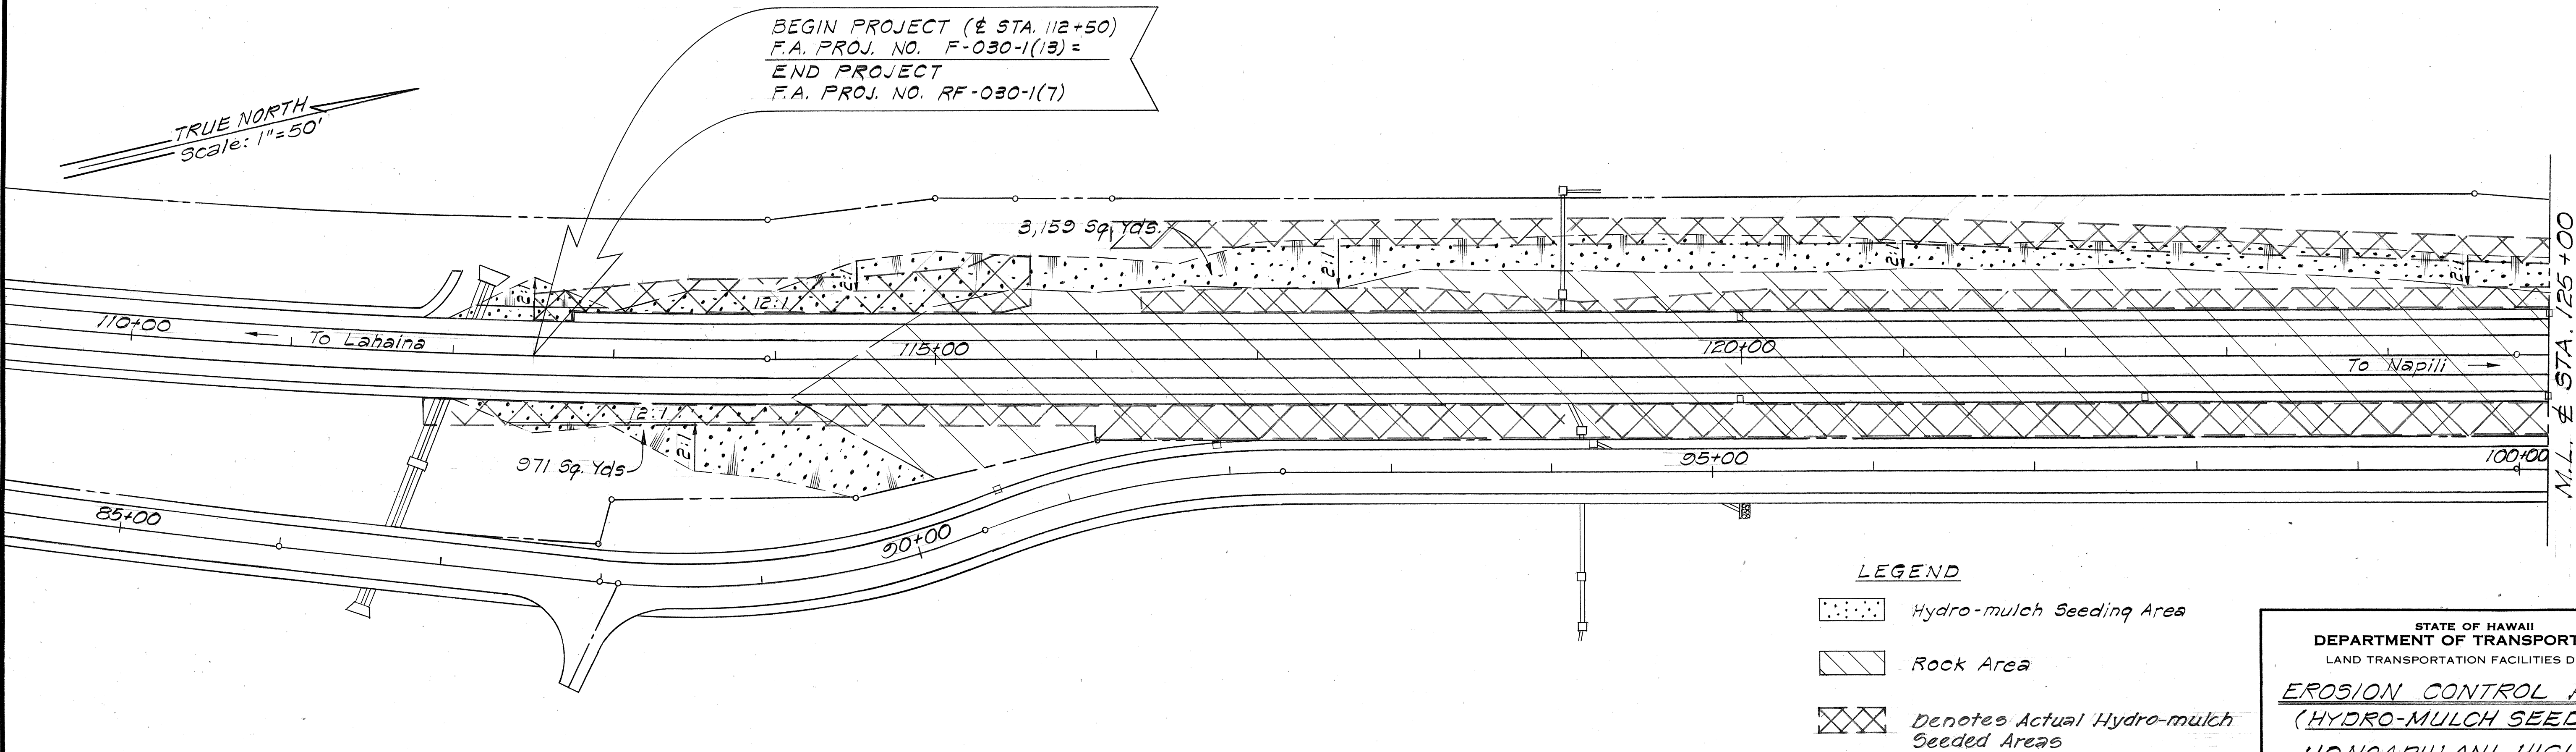


LEGEND

- Hydro-mulch Seeding Area
- Rock Area
- Denotes Actual Hydro-mulch Seeded Areas

STATE OF HAWAII
DEPARTMENT OF TRANSPORTATION
LAND TRANSPORTATION FACILITIES DIVISION
EROSION CONTROL PLAN
(HYDRO-MULCH SEEDING)
HONOAPIILANI HIGHWAY
Kahana to Alae'oa
F.A. Proj. No. F-030-1(13)
Scale: 1"=50' Date: Nov., 1977
SHEET NO. 1 OF 3 SHEETS

FED. ROAD DIST. NO.	STATE	FED. AID PROJ. NO.	FISCAL YEAR	SHEET NO.	TOTAL SHEETS
HAWAII	HAW.	F030-1(13)	1978	82	174

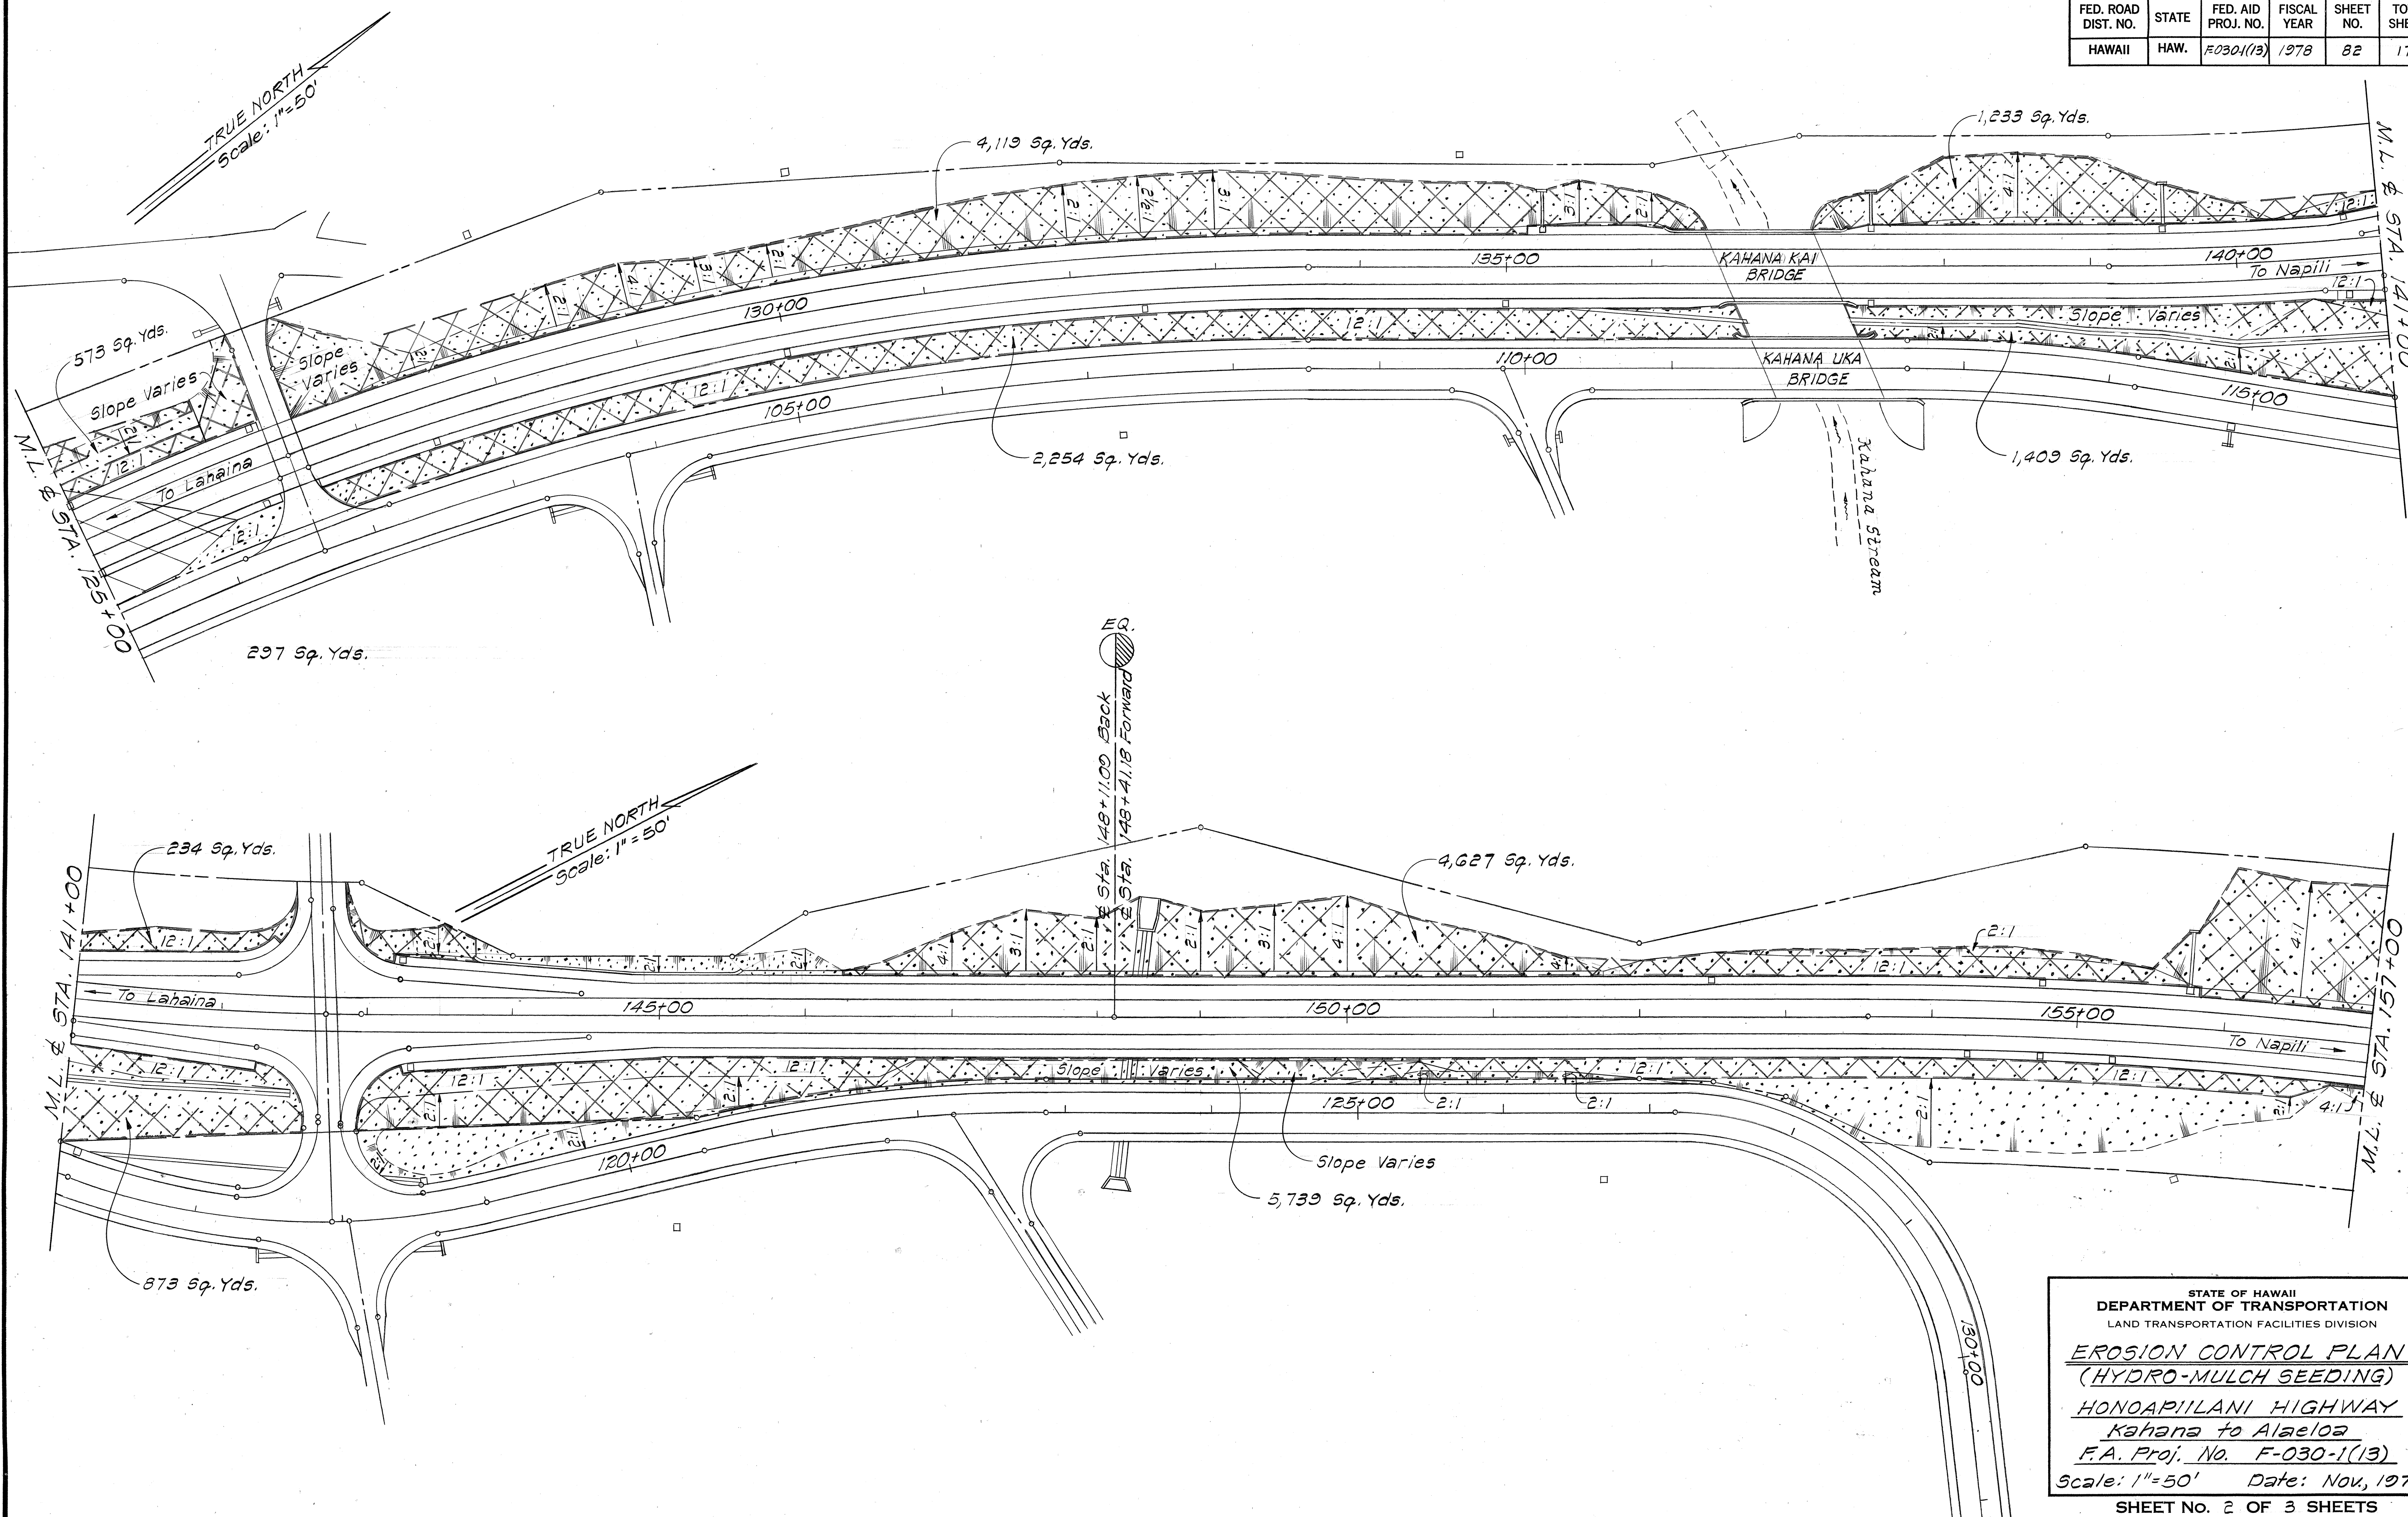



STATE OF HAWAII
DEPARTMENT OF TRANSPORTATION
LAND TRANSPORTATION FACILITIES DIVISION

EROSION CONTROL PLAN
(HYDRO-MULCH SEEDING)

HONOAPIILANI HIGHWAY
Kahana to Alaeloa
F.A. Proj. No. F-030-1(13)
Scale: 1"=50' Date: Nov, 1977

SHEET No. 2 OF 3 SHEETS

FED. ROAD DIST. NO.	STATE	FED. AID PROJ. NO.	FISCAL YEAR	SHEET NO.	TOTAL SHEETS
HAWAII	HAW.	F-030-1(13)	1978	83	174

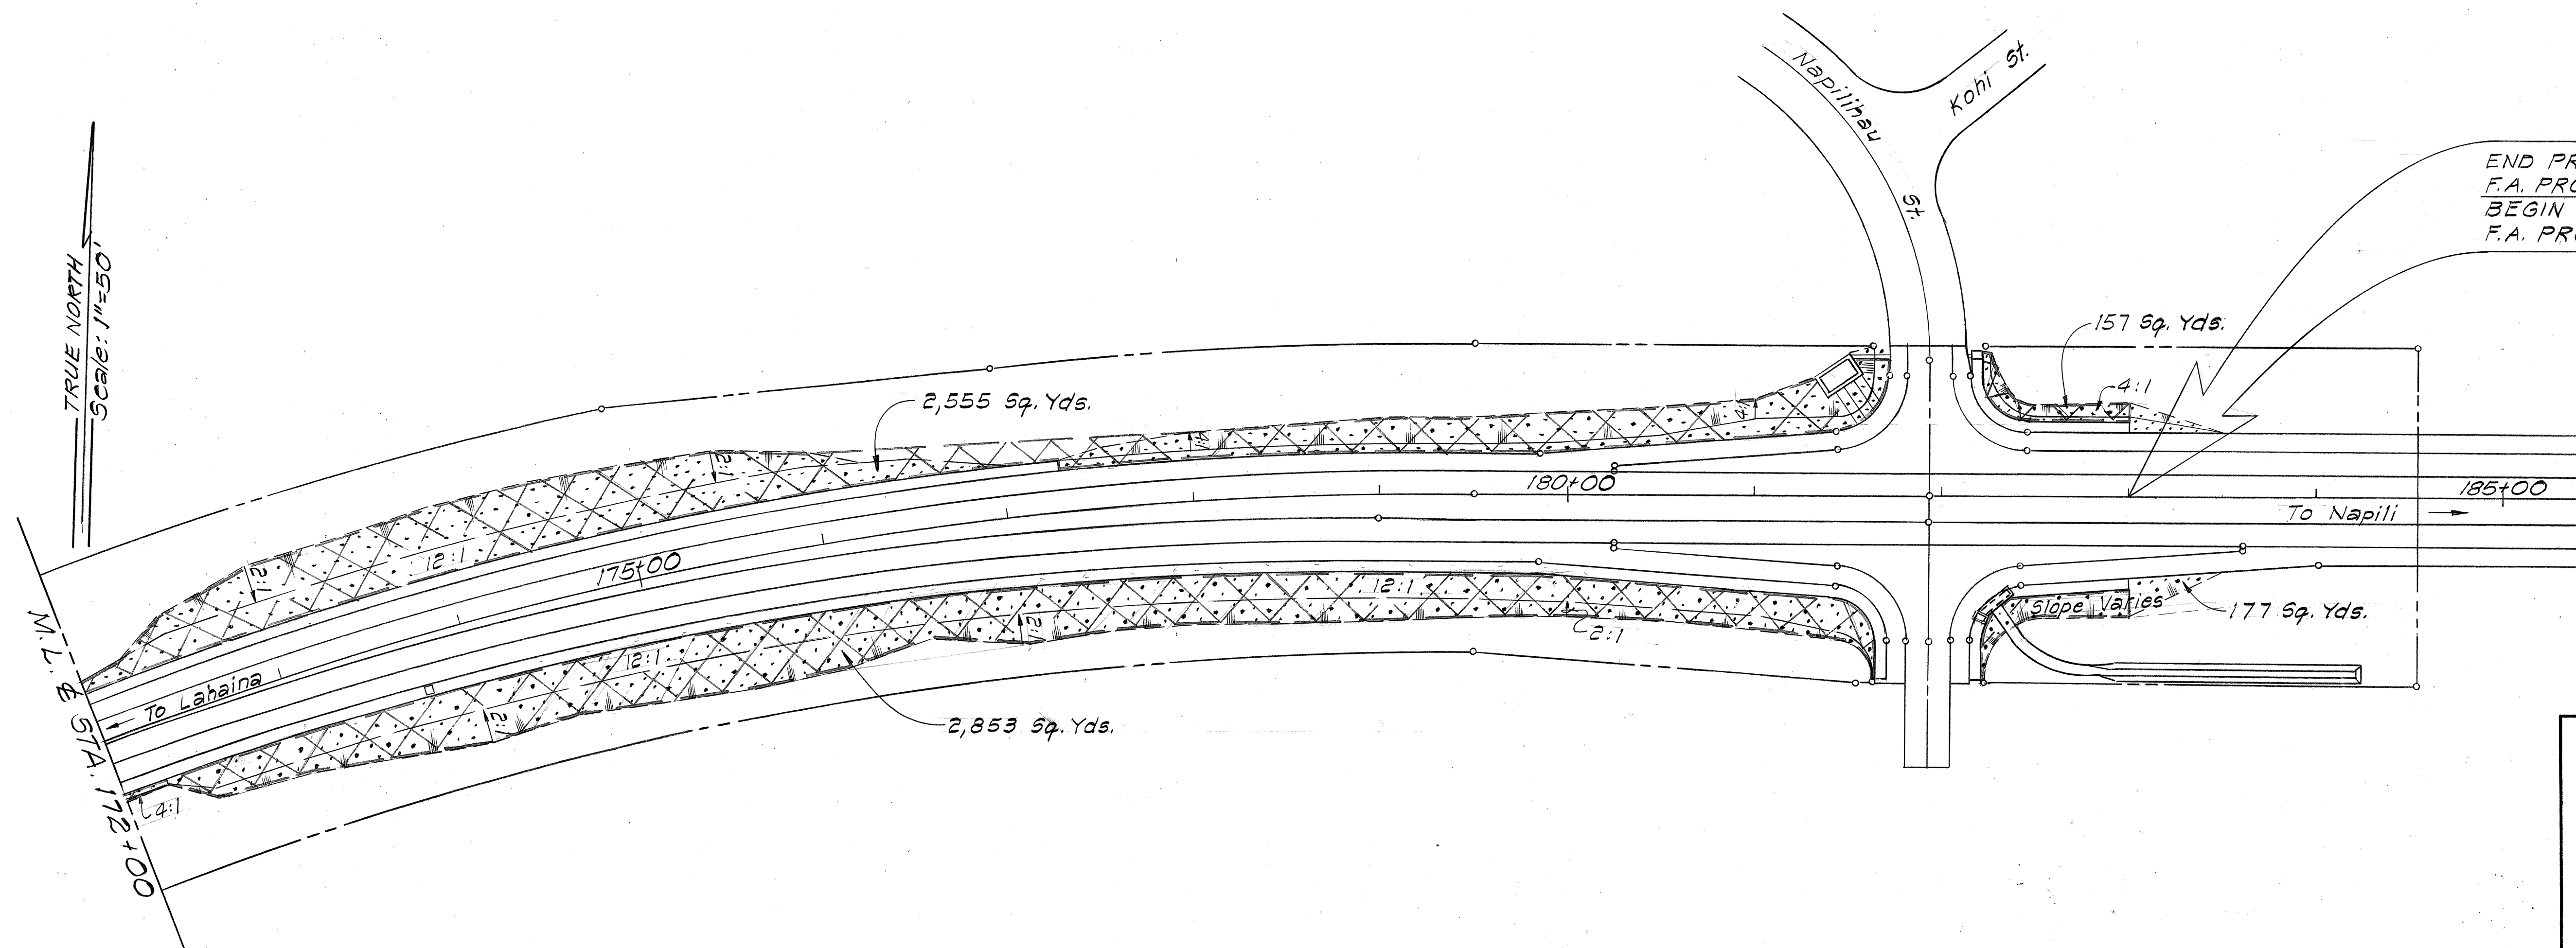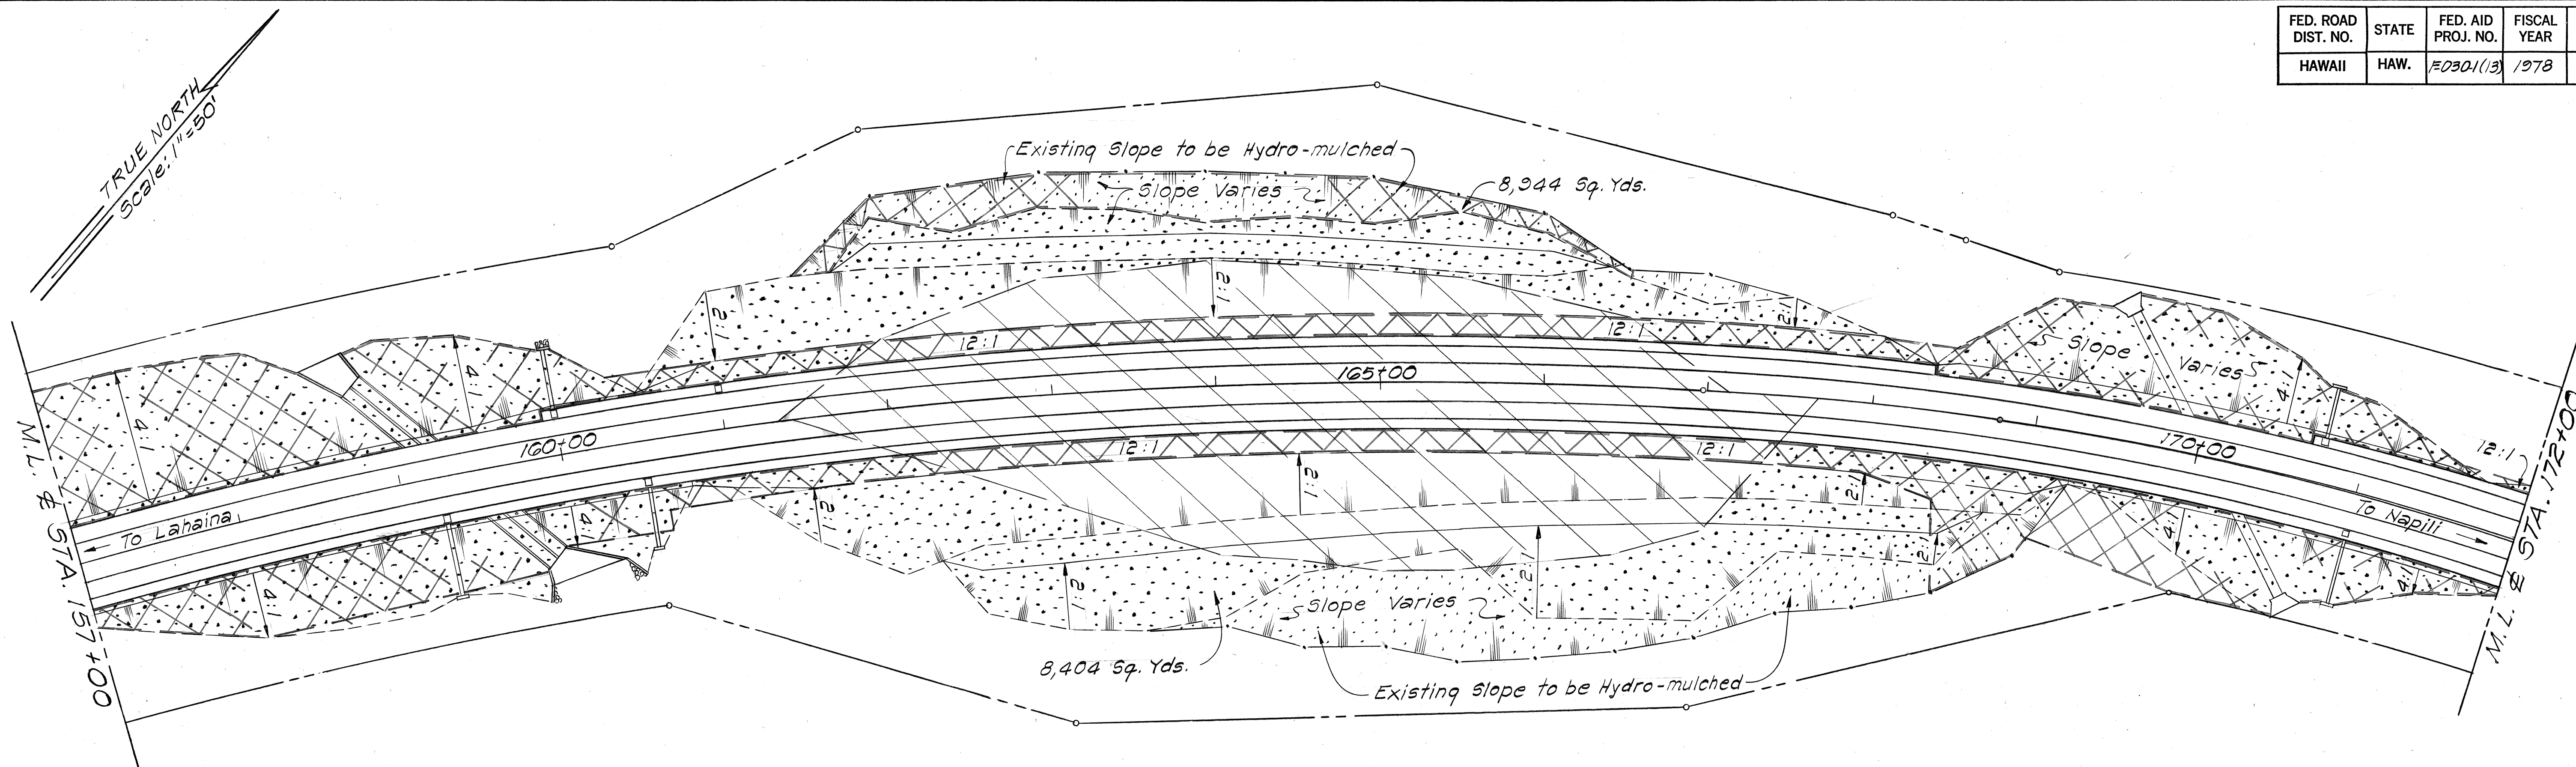

END PROJECT (± STA. 183+00)
F.A. PROJ. NO. F-030-1(13) =
BEGIN FUTURE PROJECT
F.A. PROJ. NO. F-030-1(8)

STATE OF HAWAII
DEPARTMENT OF TRANSPORTATION
LAND TRANSPORTATION FACILITIES DIVISION
EROSION CONTROL PLAN
(HYDRO-MULCH SEEDING)
HONOAPIʻILANI HIGHWAY
Kahana to Alaeloa
F.A. Proj. No. F-030-1(13)
Scale: 1"=50' Date: Nov., 1977
SHEET No. 3 OF 3 SHEETS

ORIGINAL PLAN	DATE
DRAWN BY	"
DESIGNED BY	"
NOTED BY	"
CHECKED BY	"
NO.	"