


DATE	BY	SURVEYED	PLOTTED	REVIEWED	NO.
ORIGINAL		SURVEY		NOTE BOOK	
NO.		NO.		NO.	


DATE	BY	SURVEYED	PLOTTED	REVIEWED	NO.
4-25-86	GN				
ORIGINAL		SURVEY		NOTE BOOK	
NO.		NO.		NO.	

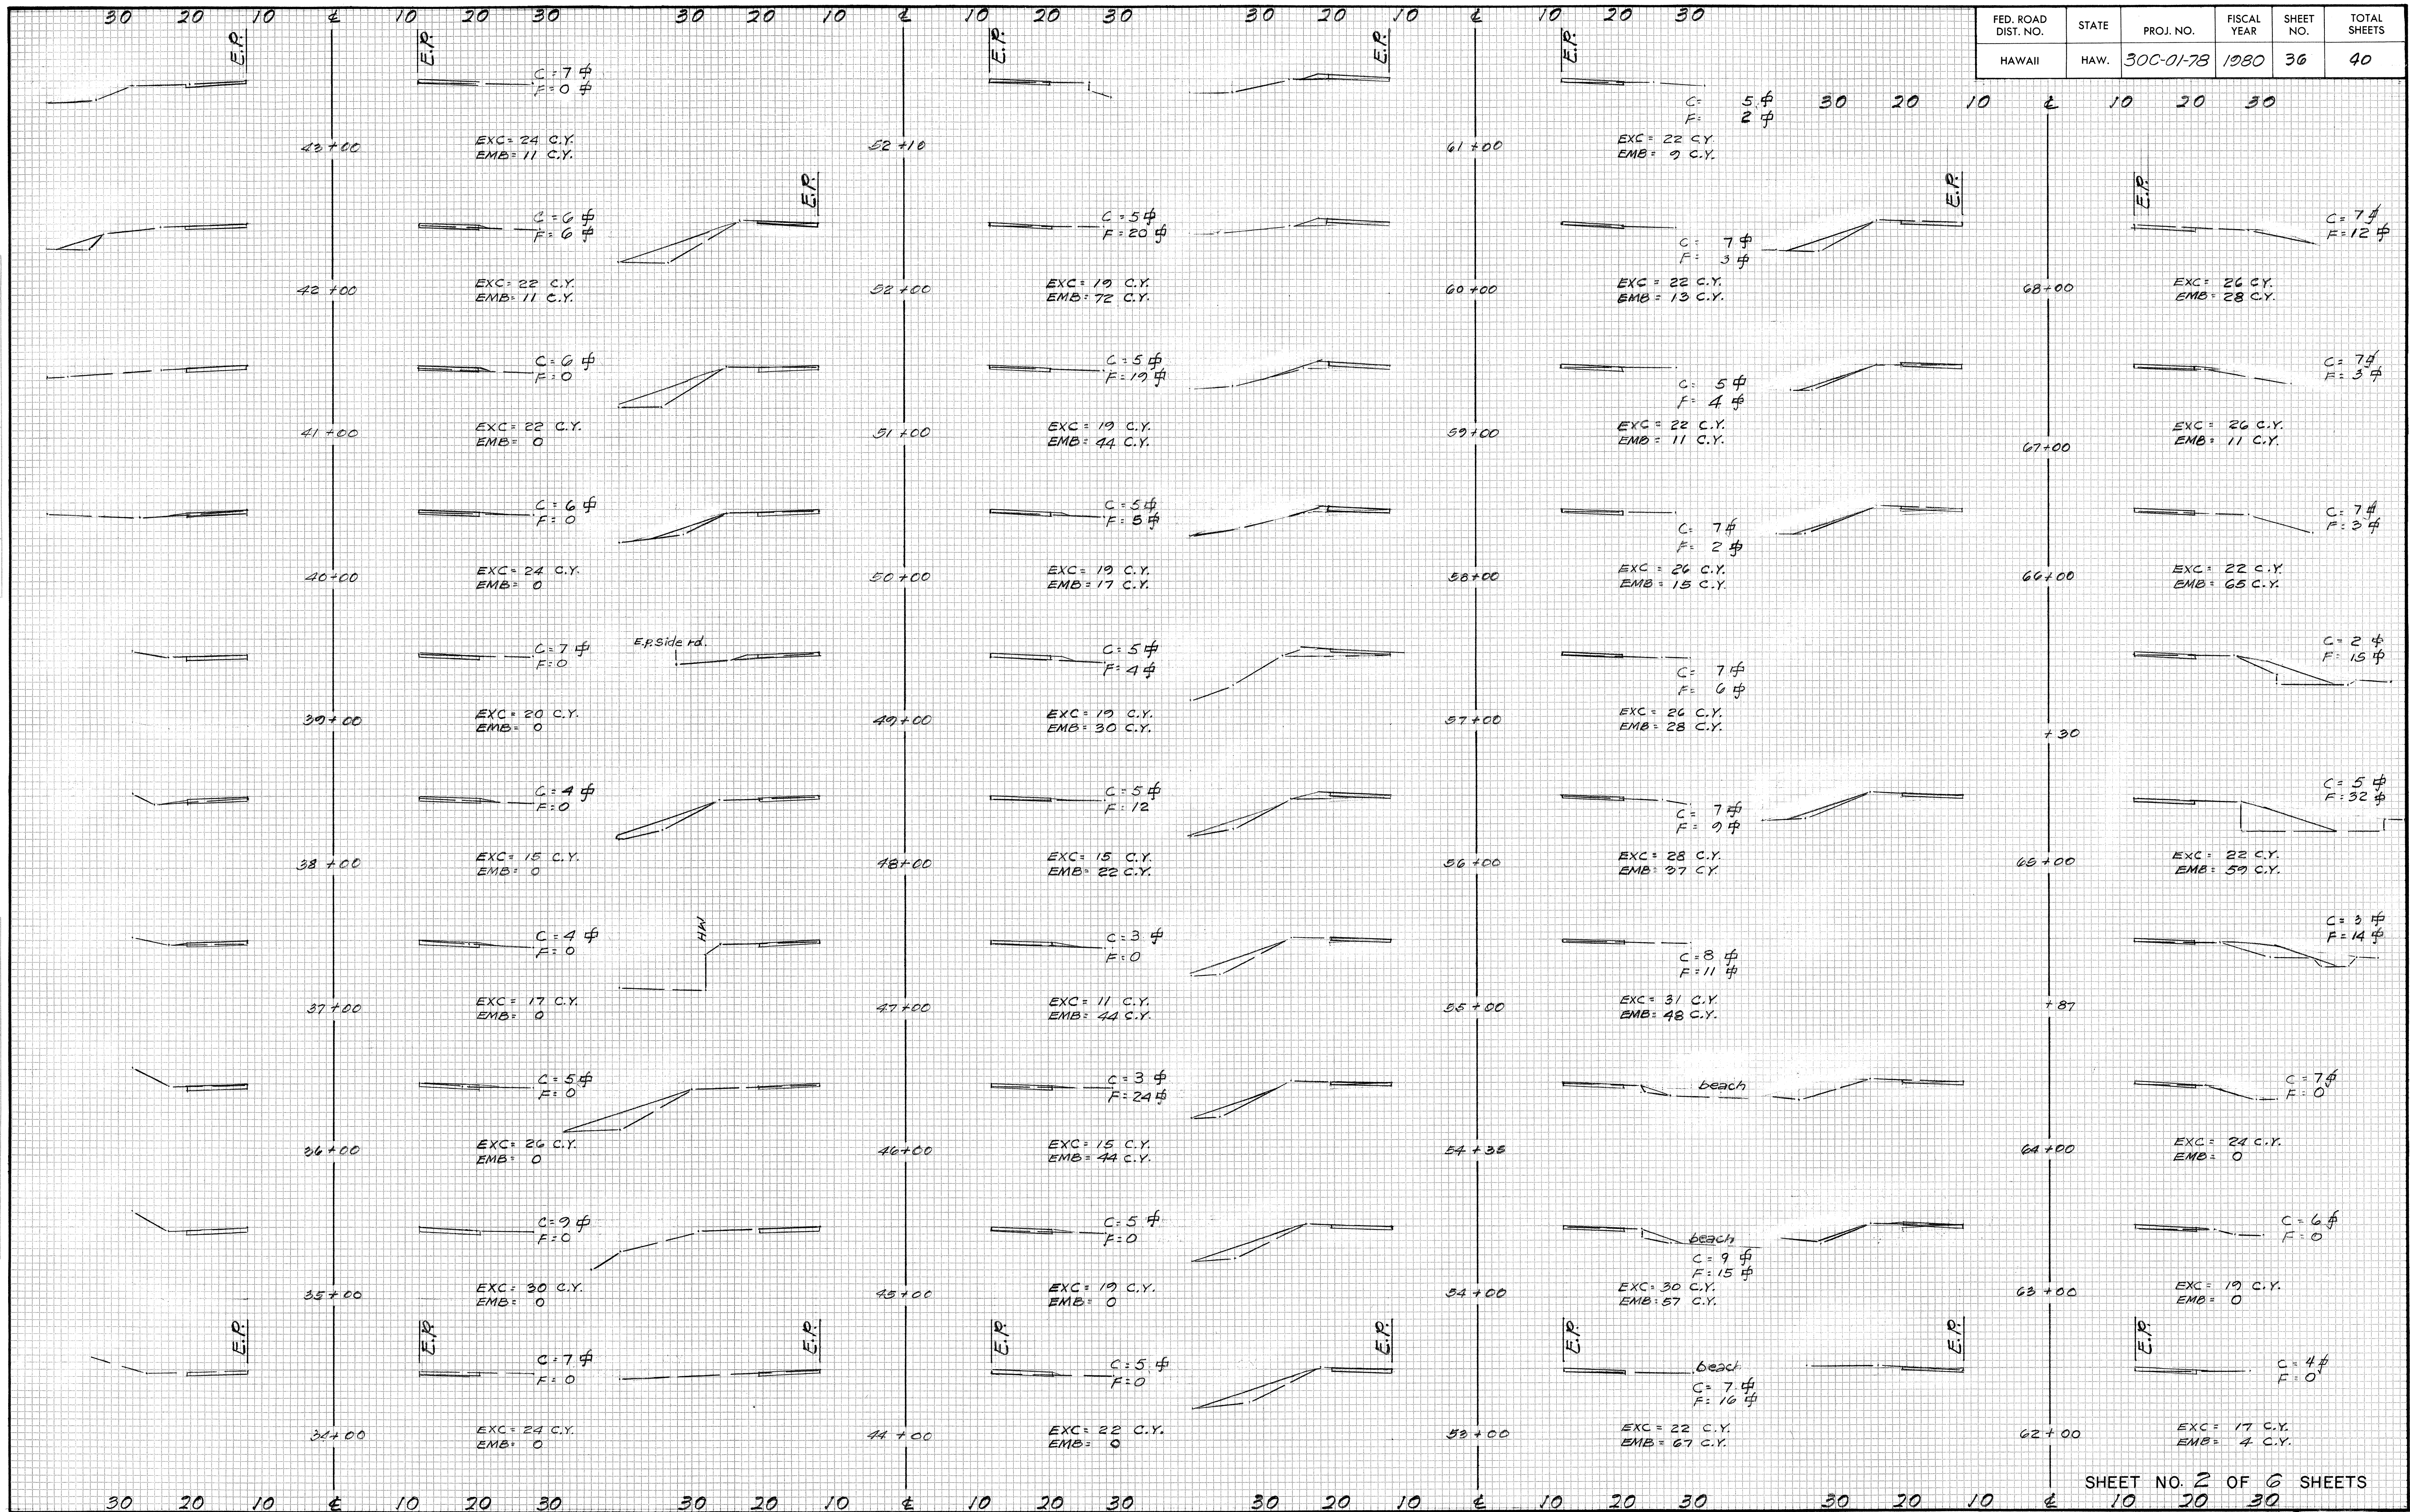

FED. ROAD DIST. NO.	STATE	PROJ. NO.	FISCAL YEAR	SHEET NO.	TOTAL SHEETS
HAWAII	HAW.	30C-01-78	1980	36	40


FINAL	SURVEYED	DATE
SURVEY	PLOTTED	BY
NOTE BOOK	TEMPLATE	
NO.	AREAS CHECKED	

ORIGINAL	SURVEYED	DATE
SURVEY	PLOTTED	BY
NOTE BOOK	TEMPLATE	
NO.	AREAS CHECKED	

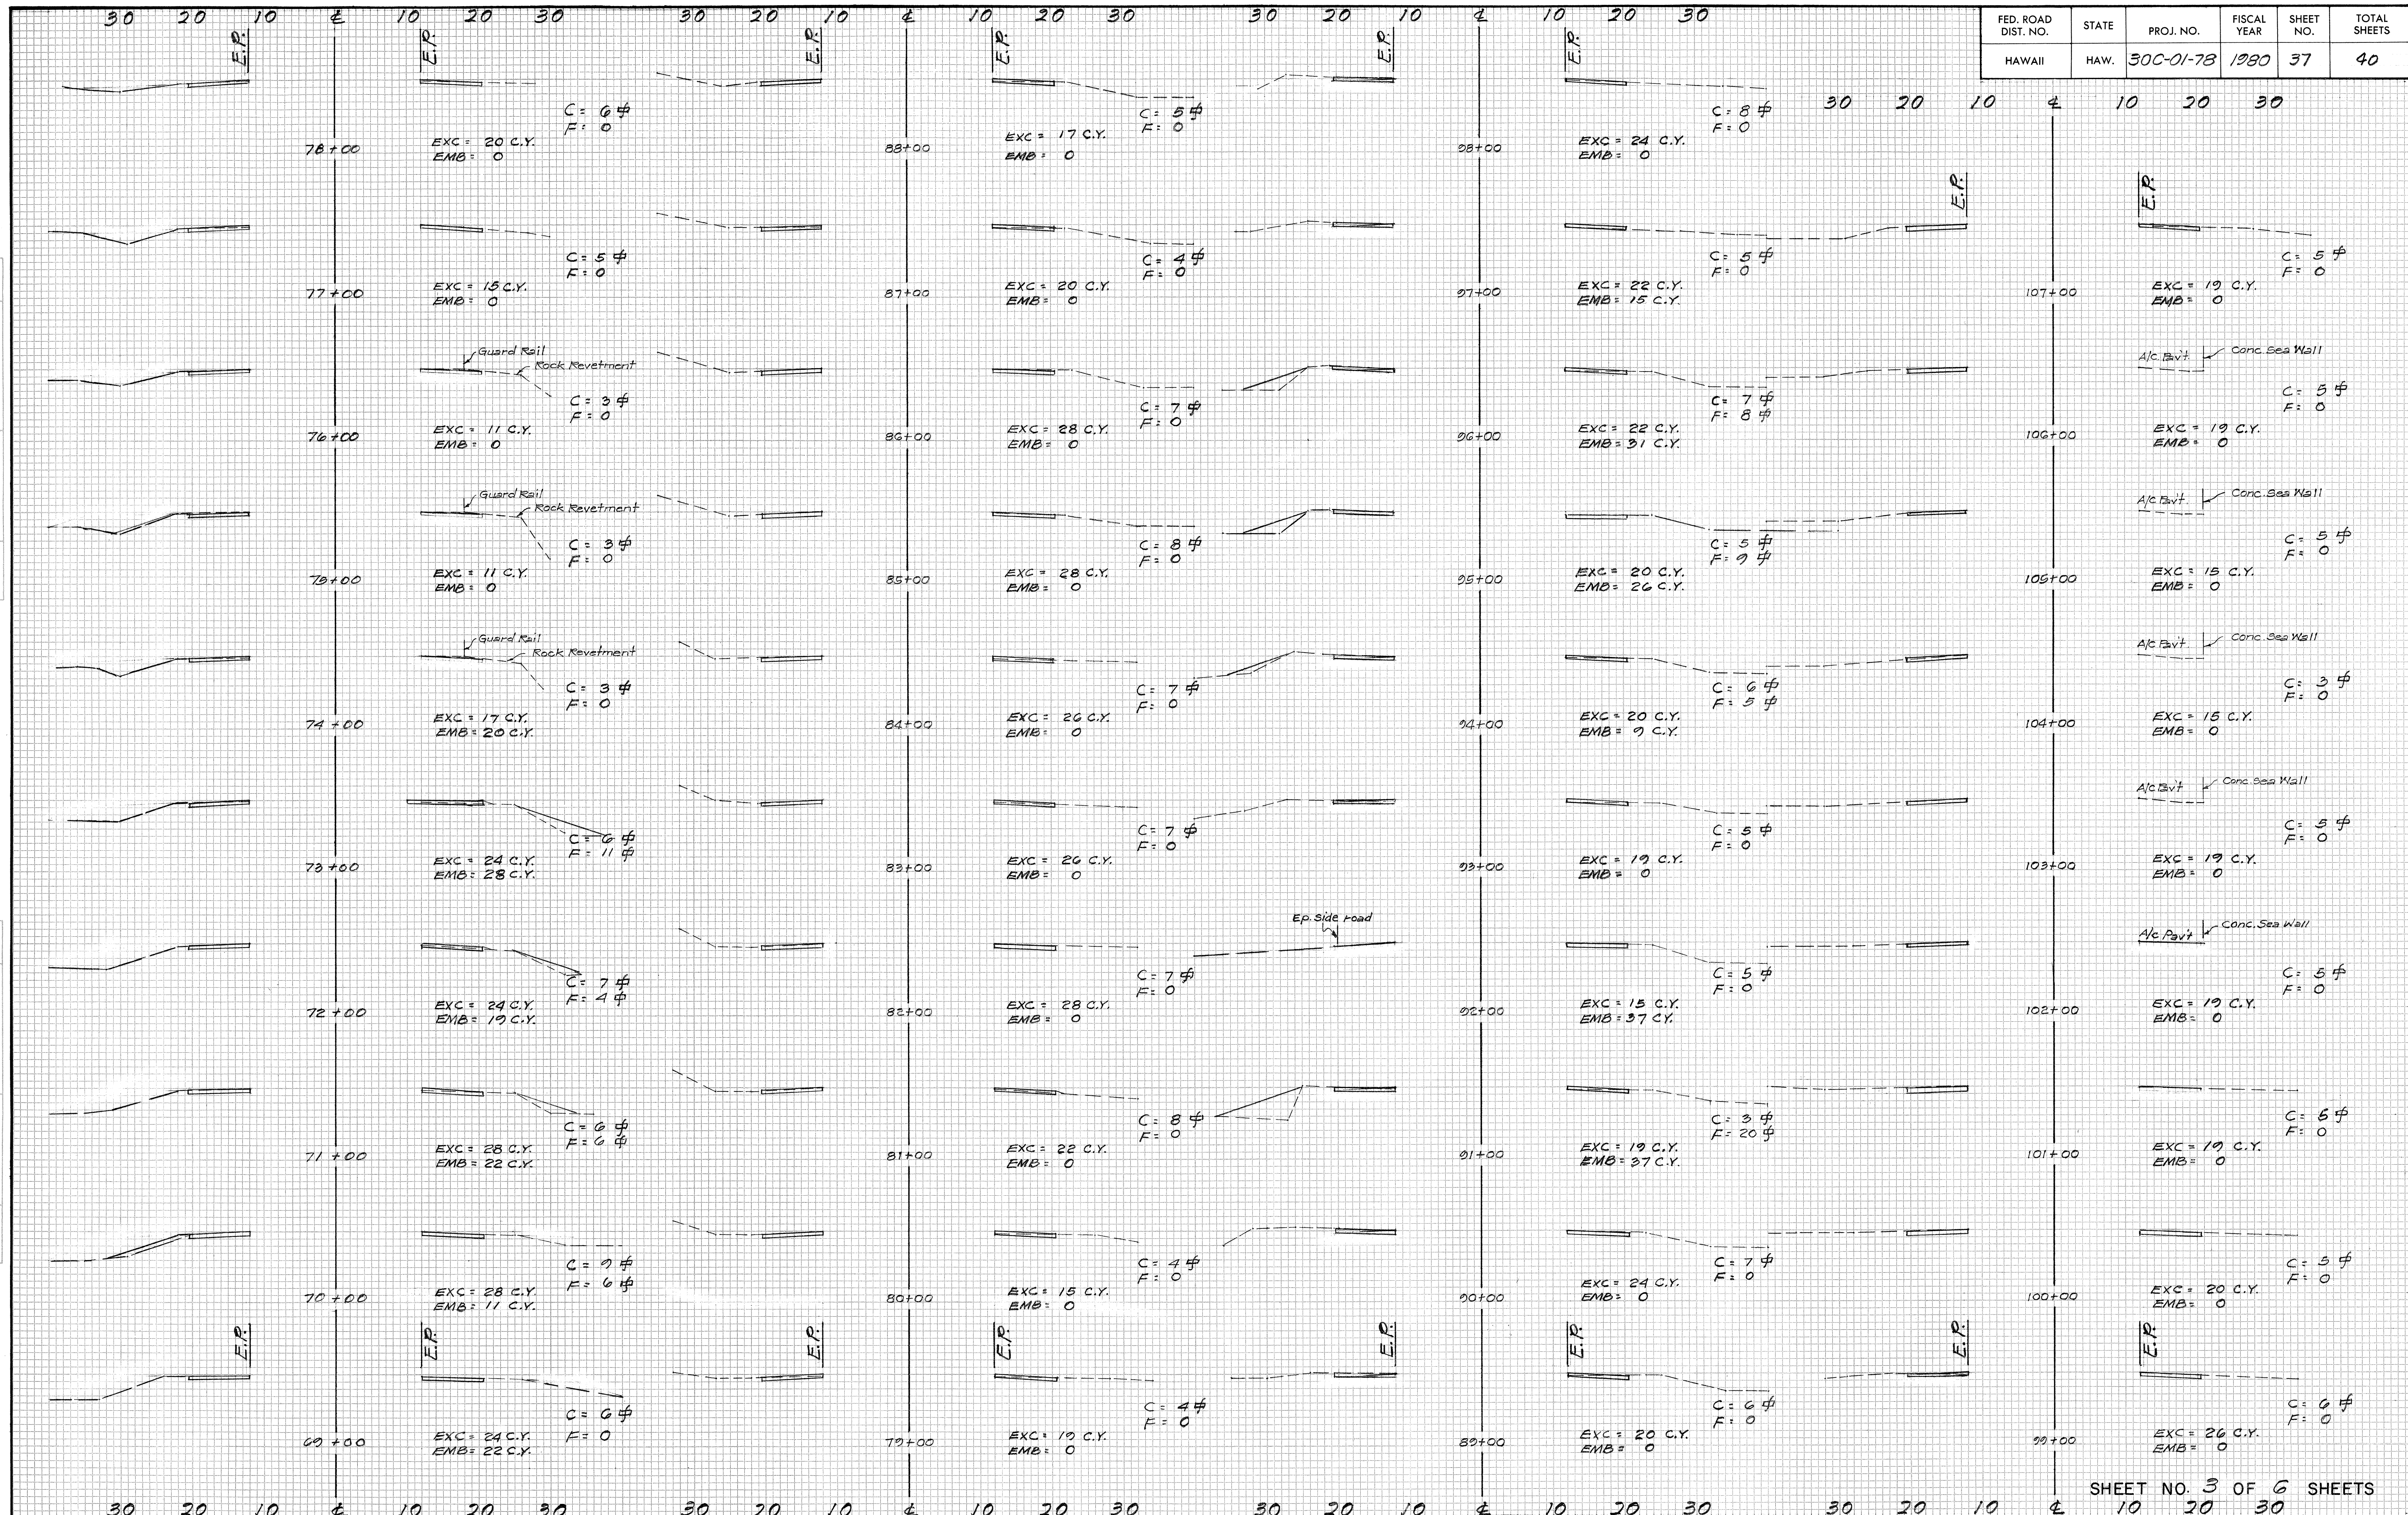

FED. ROAD DIST. NO.	STATE	PROJ. NO.	FISCAL YEAR	SHEET NO.	TOTAL SHEETS
HAWAII	HAW.	30C-01-78	1980	37	40

FED. ROAD DIST. NO.	STATE	PROJ. NO.	FISCAL YEAR	SHEET NO.	TOTAL SHEETS
HAWAII	HAW.	300-01-78	1980	39	40

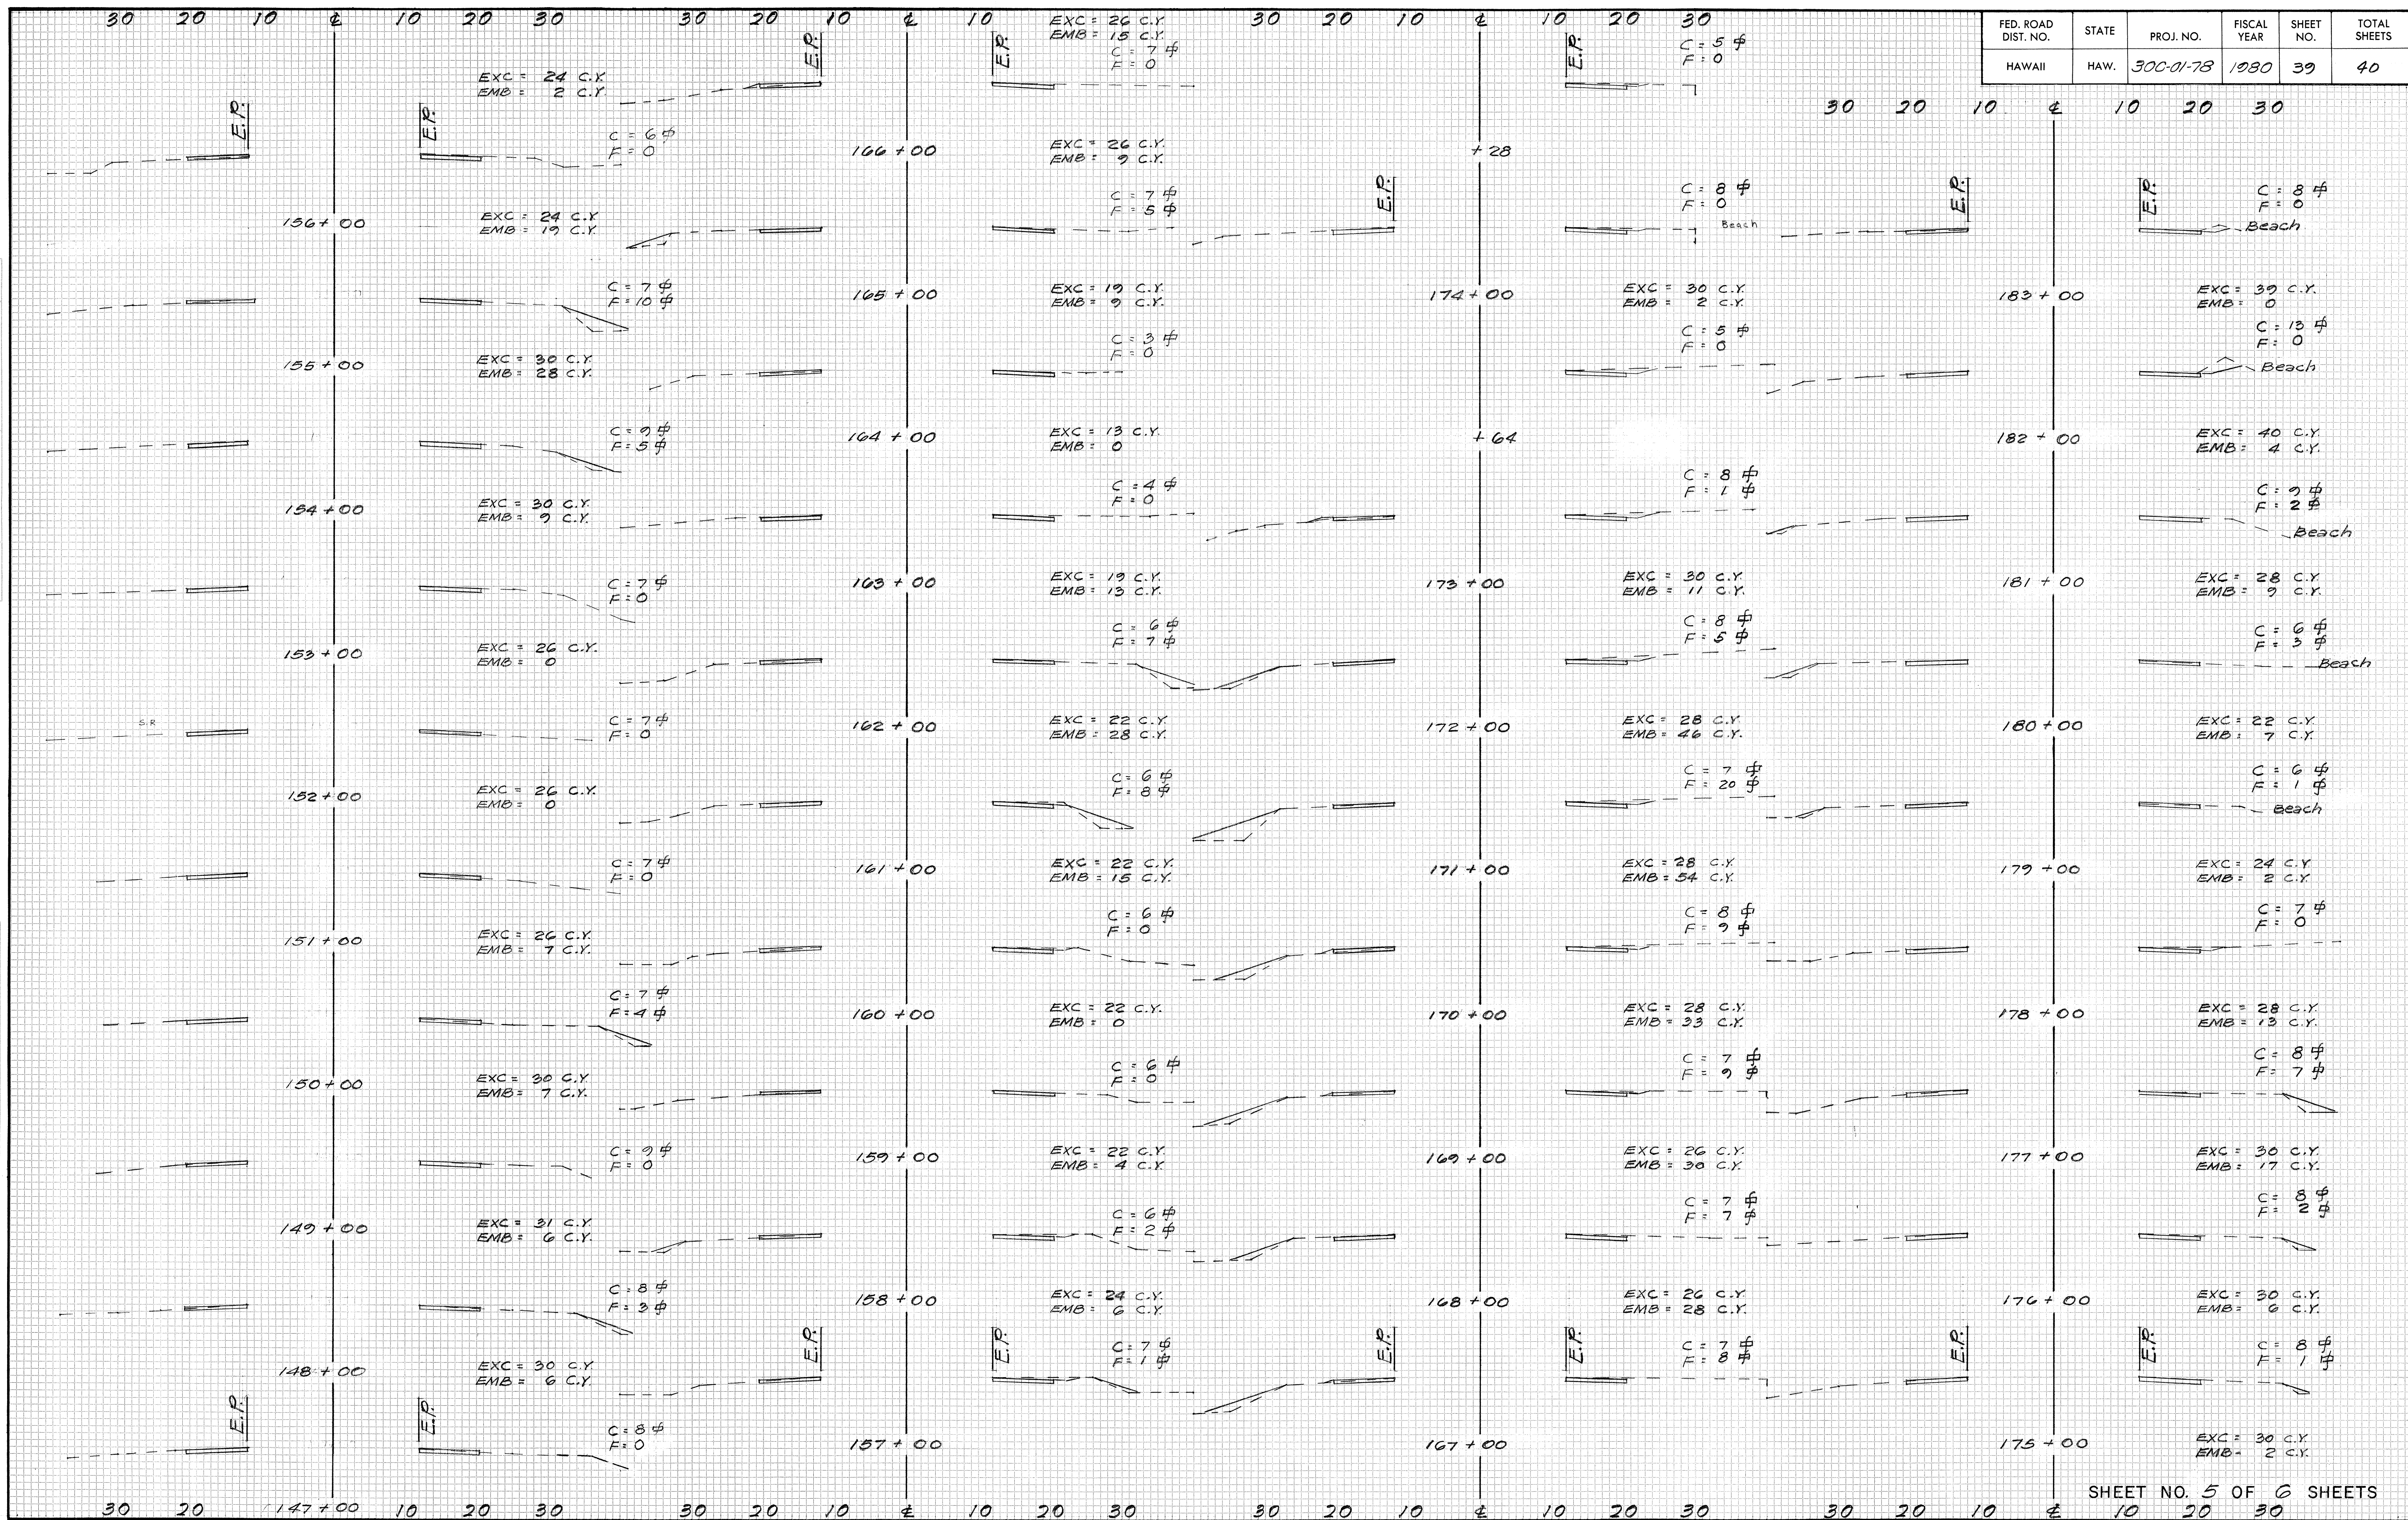

FED. ROAD DIST. NO.	STATE	PROJ. NO.	FISCAL YEAR	SHEET NO.	TOTAL SHEETS
HAWAII	HAW.	30C-01-78	1980	40	40

DATE	BY	DATE	BY

DATE	BY	DATE	BY

DATE	BY	DATE	BY

DATE	BY	DATE	BY

