INDEX TO DRAWINGS	
SHEET NO	DESCRIPTION
ı	TITLE SHEET
2-5	TYPICAL SECTIONS, GEN. NOTES & SUMMARIES
6-12∰	PLAN & PROFILE
13-31	MISCELLANEOUS, TYPICAL AND STANDARD ROADWAY DETAILS
32 - 34	DRAINAGE DETAILS
35 - 40	CROSS SECTIONS
₩ 12S-1	CHANGE ORDER WORK AT
	UKUMEHAME BRIDGE
· ·	
3	
	•

TOTAL SHEET COUNT AFTER "AS-BUILT"
POSTINGS: 41 SHEETS

## STATE OF HAWAII DEPARTMENT OF TRANSPORTATION HIGHWAYS DIVISION HONOLULU, HAWAII

"AS - BUILT" PLANS OF
HONOAPIILANI HIGHWAY
GUARDRAIL AND SHOULDER IMPROVEMENTS

VICINITY OF OLOWALU TO VICINITY OF PAPALAUA

PROJECT NO. 30C - 01 - 78

## SCALES

PLAN

I IN. = 100 FT. HOR. I IN. = 100 FT.


PROFILE

VER. | IN. = 10 FT.

X-SECTIONS

HOR. | IN. = 10 FT. VER. | IN. = 10 FT.

DISTRICT OF LAHAINA ISLAND OF MAUI

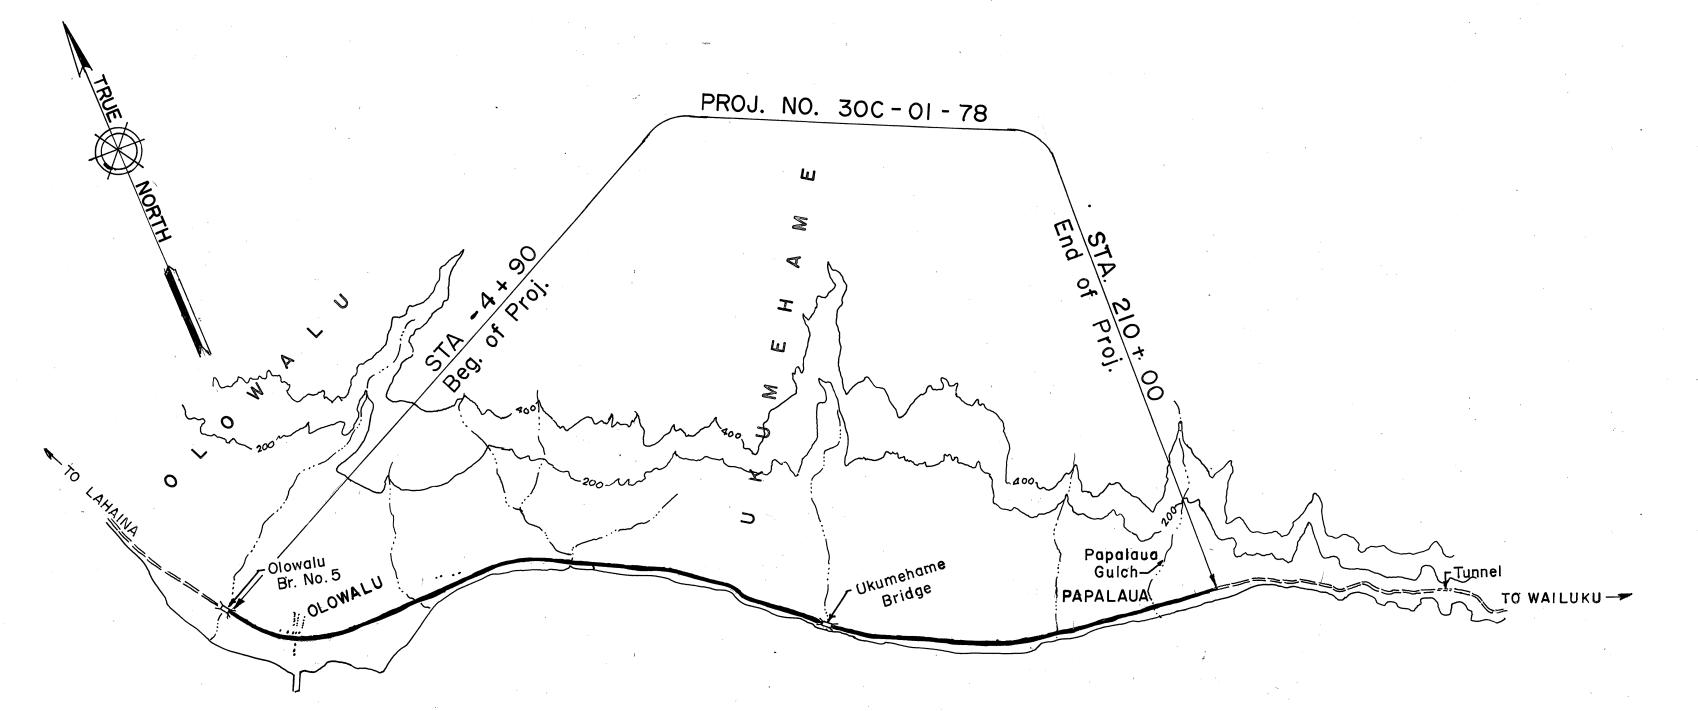


LAYOUT OF PROJECT

SCALE: |" = 2000"

LENGTH OF PROJECT = 4.070 MI.

" = 6.549 KM.

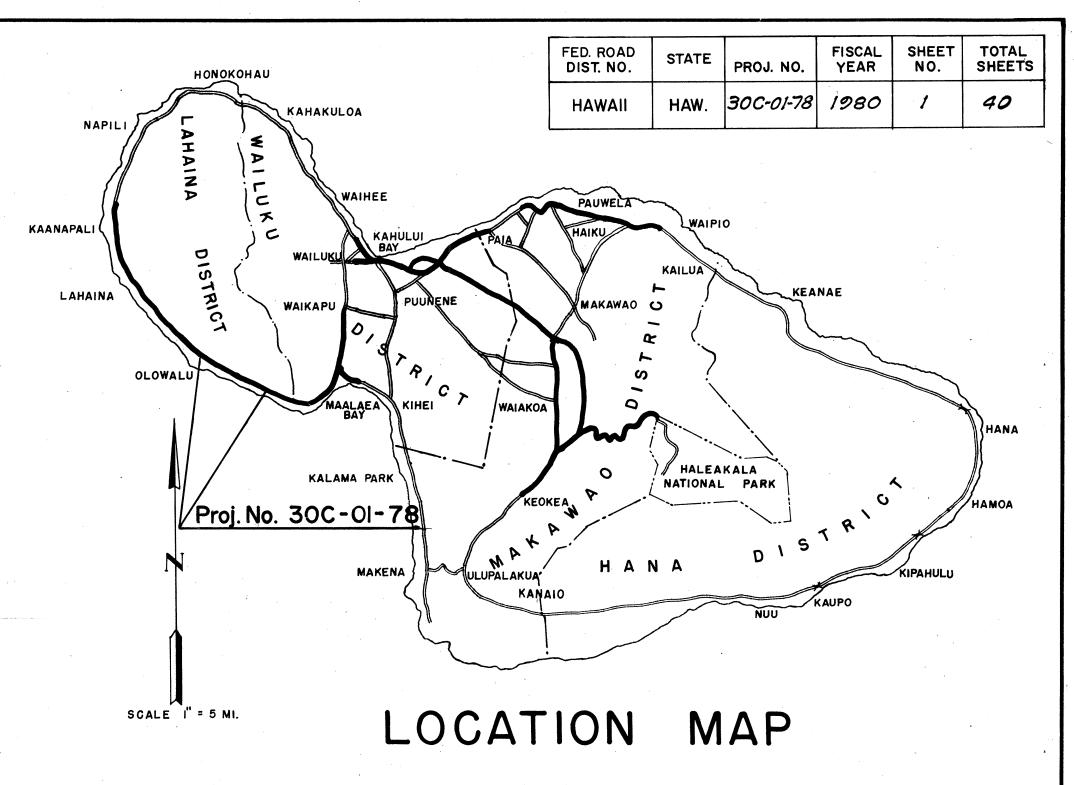

FEDERAL AID PROJECTS PREVIOUSLY CONSTRUCTED OR UNDER CONSTRUCTION

ALL CHANGES MADE DURING CONSTRUCTION HAVE BEEN INCORPORATED ON THESE PLANS IN RED EXCEPT CHANGES IN THE ORIGINAL THEORETICAL QUANTITIES. FOR ACTUAL QUANTITIES, REFER TO PROJECT LEDGER AND/OR COMPUTATION BOOK.

Menge M. Kaya
RESIDENT ENGINEER

10/7/8/

DEPARTMENT OF TRANSPORTATION
STATE OF HAWAII

APPROVED:

James R Carras 6/4/80

DIR. OF TRANSPORTATION DATE

C HIGHWAY DESIGN

Mike Miura P.S. & E. By

UI DISTRICT SIGNED BY