

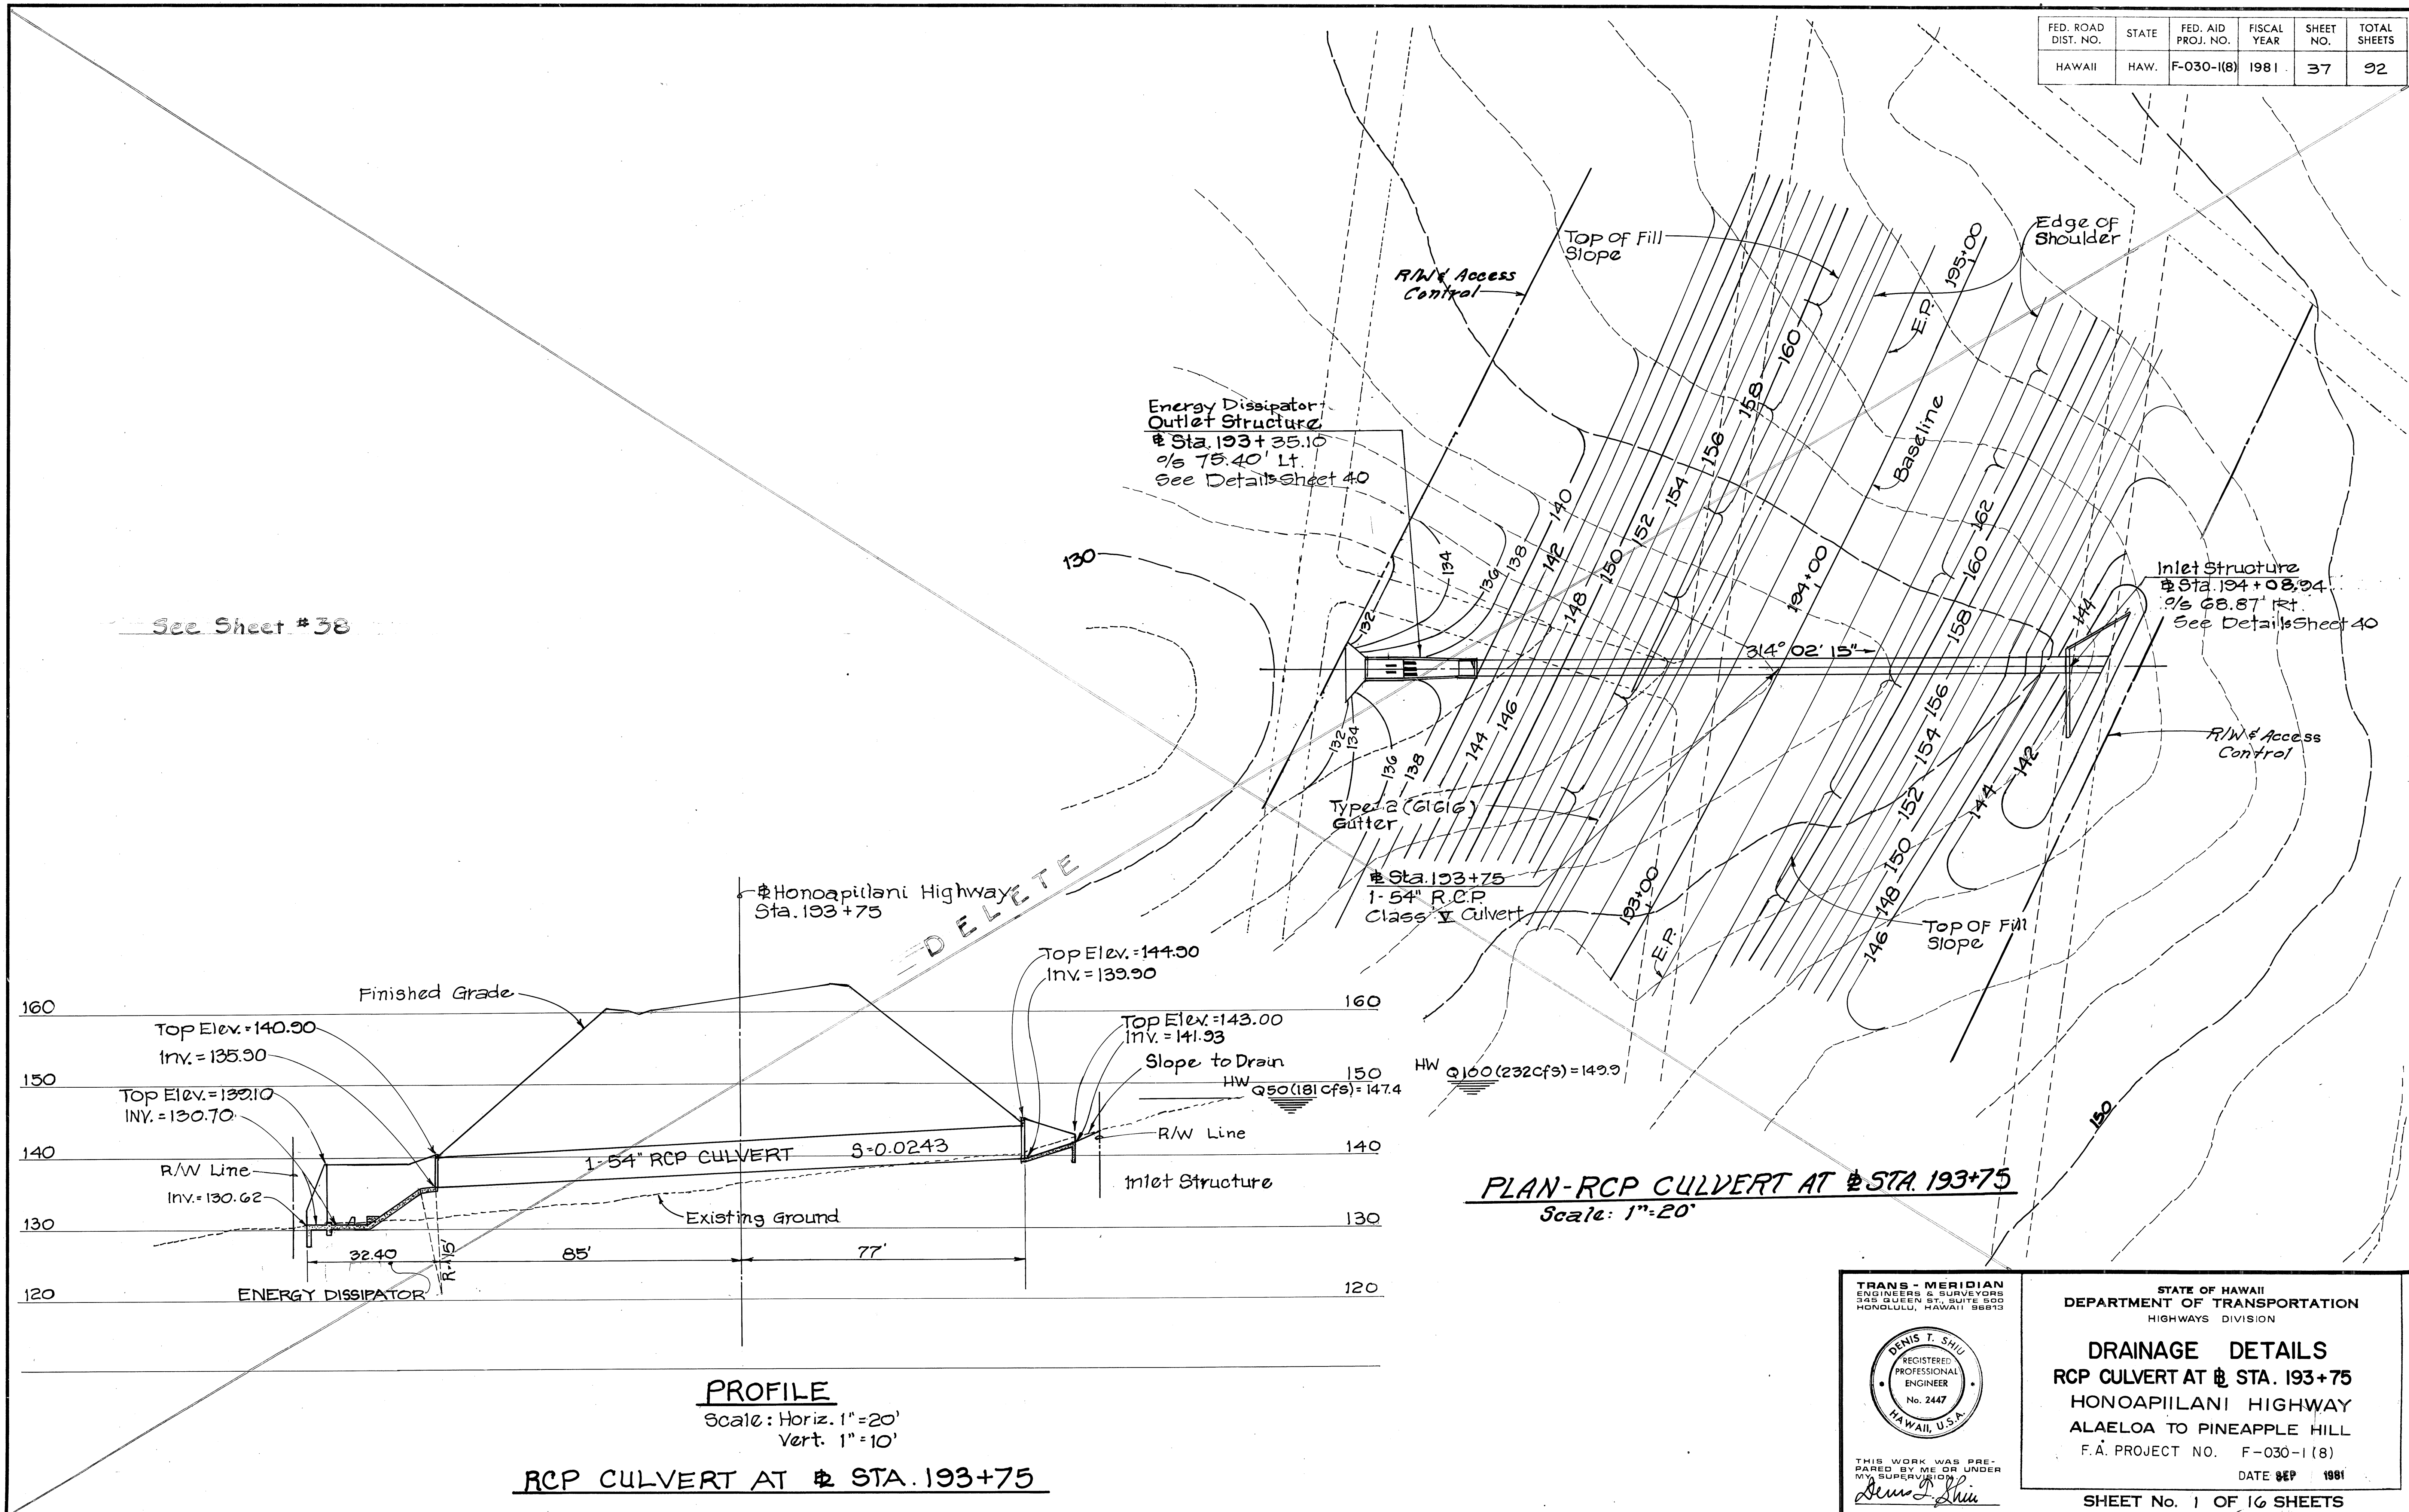


FED. ROAD DIST. NO.	STATE	FED. AID PROJ. NO.	FISCAL YEAR	SHEET NO.	TOTAL SHEETS
HAWAII	HAW.	F-030-1(8)	1981	37	92

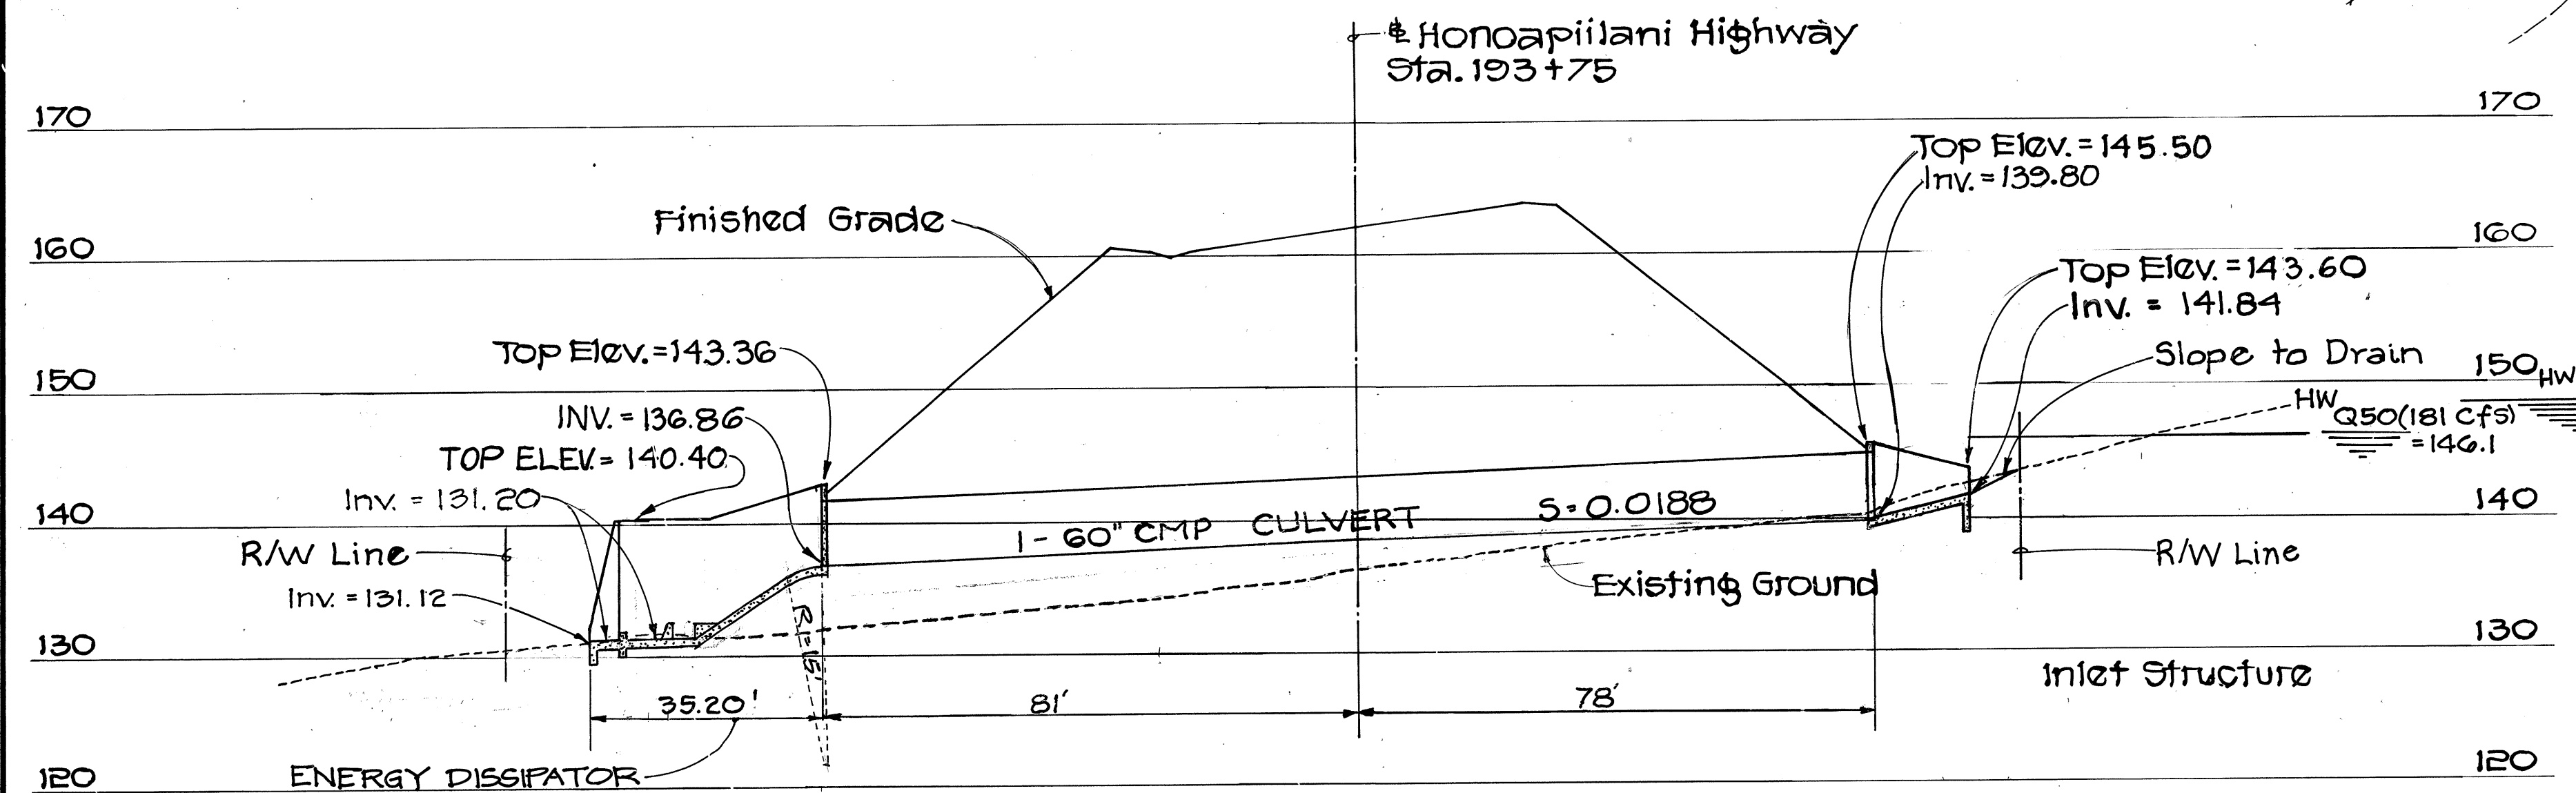

FED. ROAD DIST. NO.	STATE	FED. AID PROJ. NO.	FISCAL YEAR	SHEET NO.	TOTAL SHEETS
HAWAII	HAW.	F-030-1(8)	1981	38	92

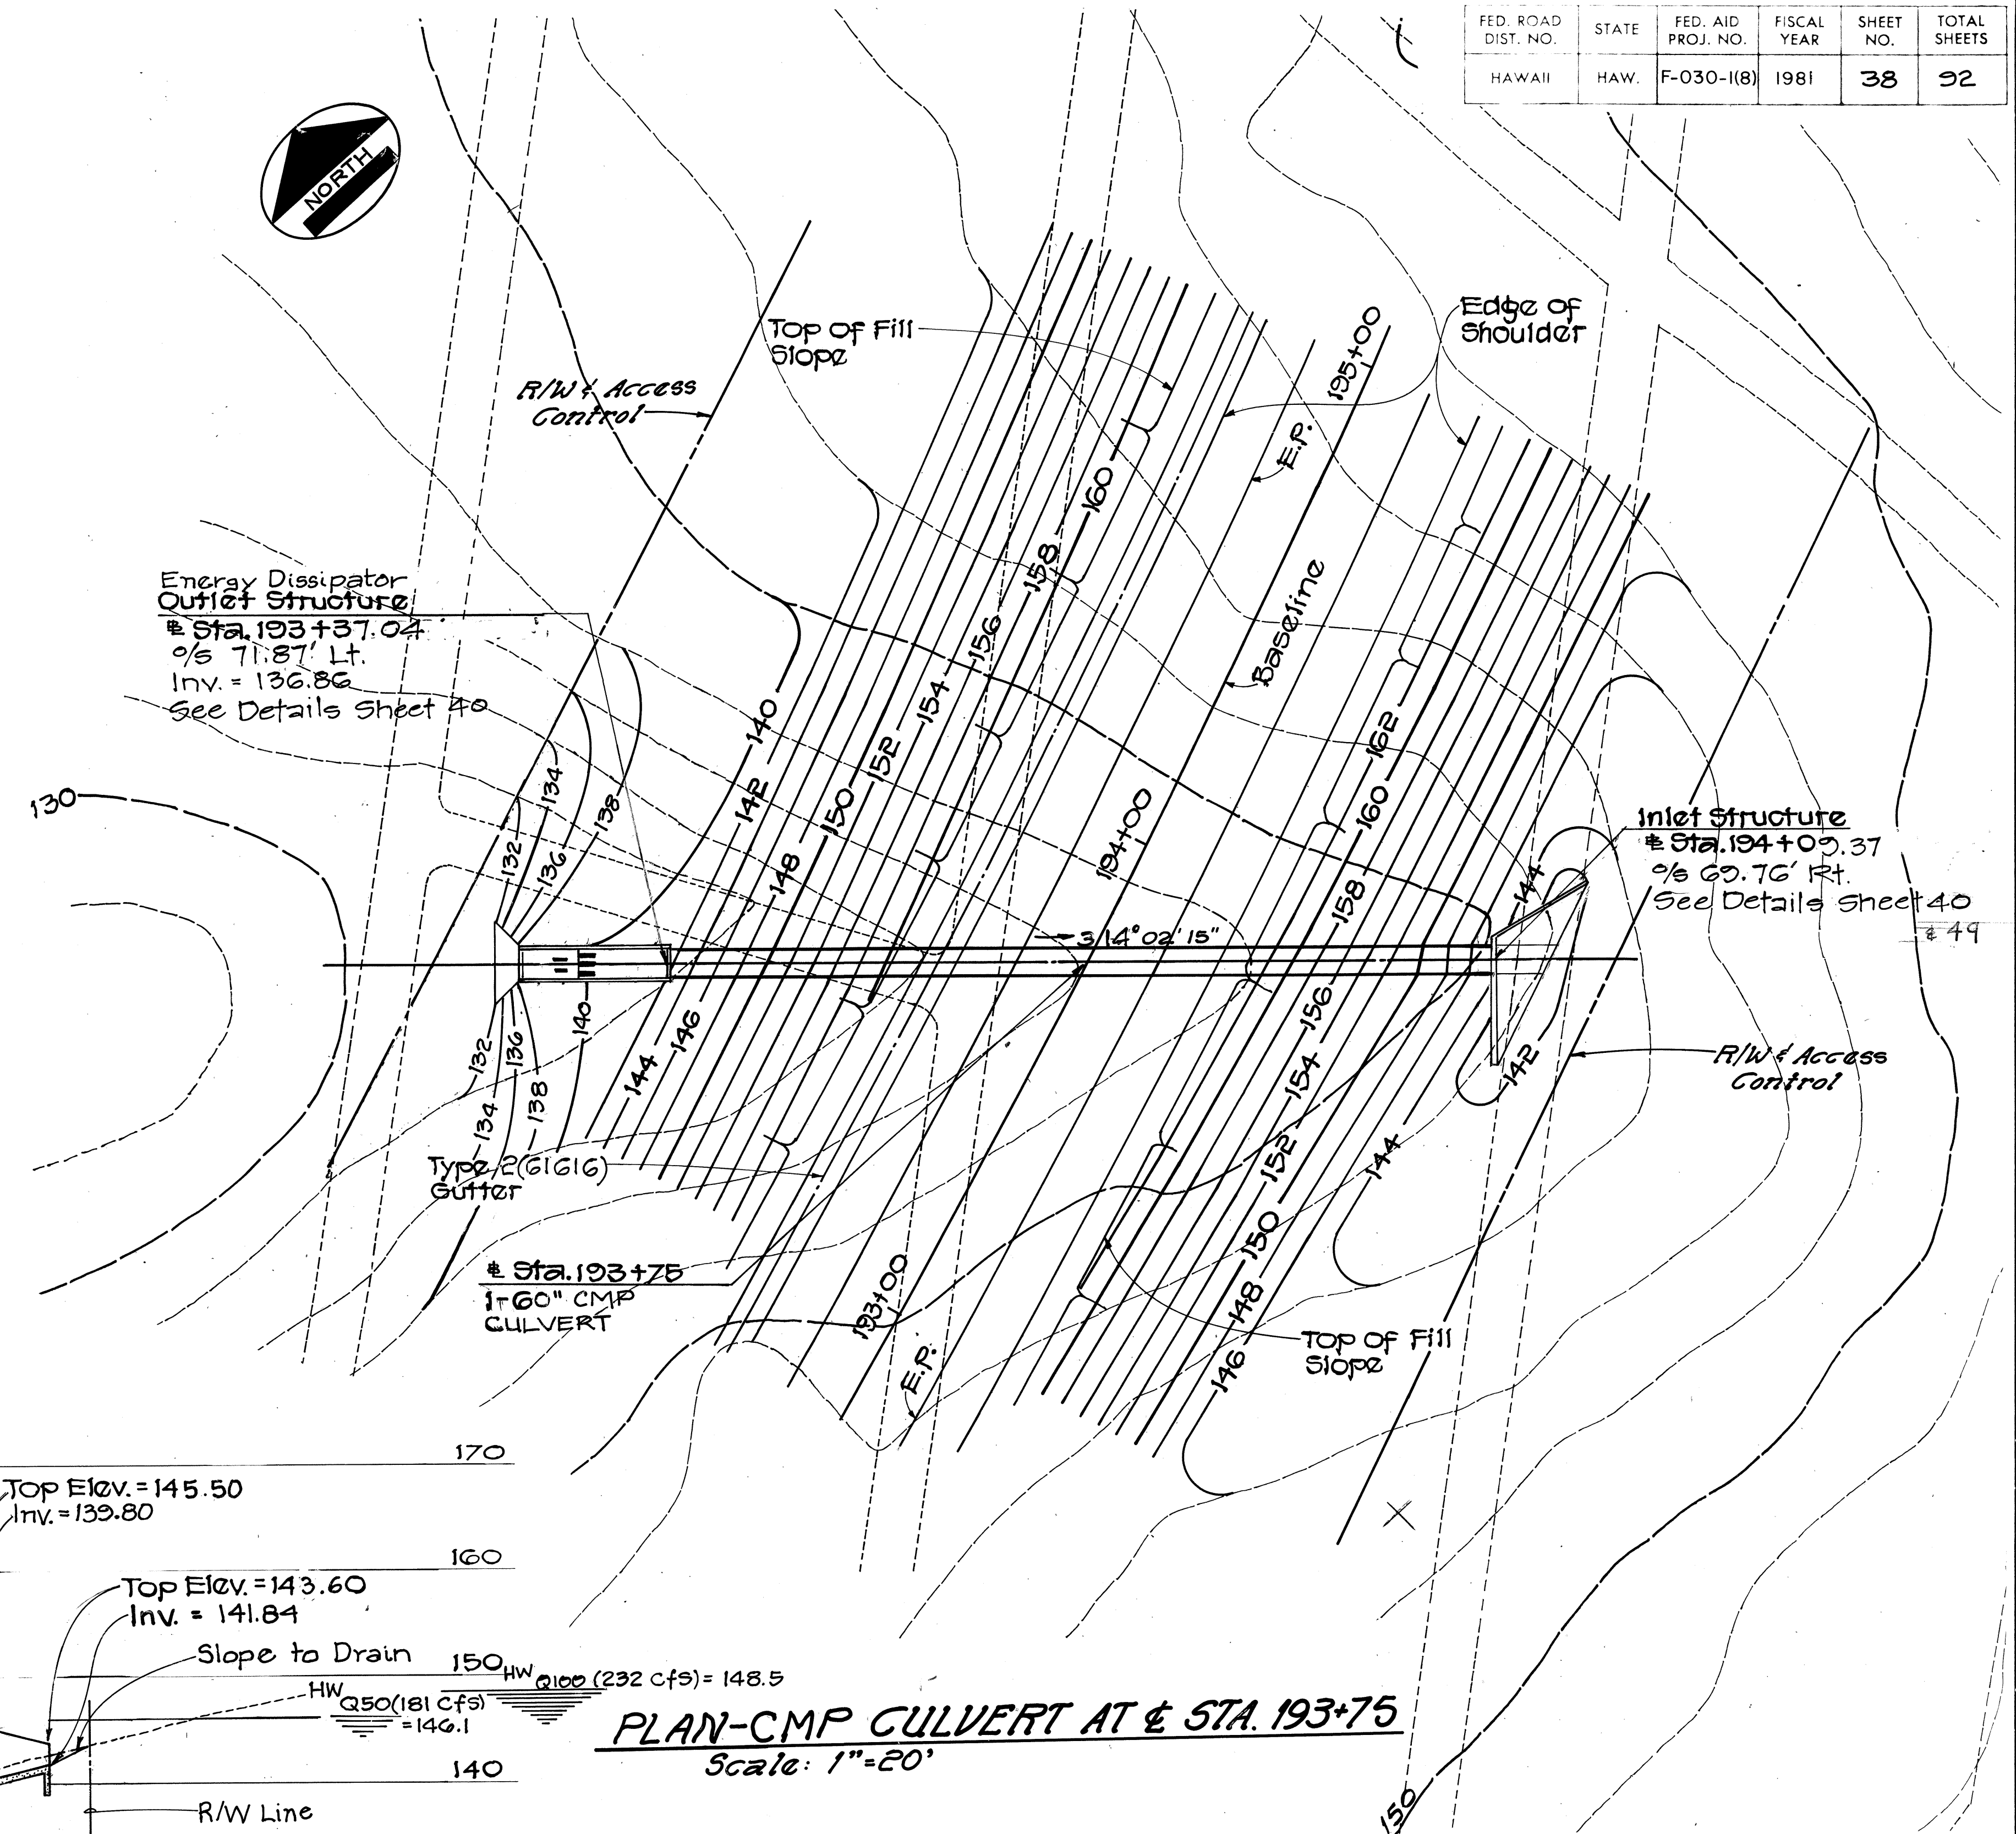

PROFILE
Scale: Horiz. 1"=20'
Vert. 1"=10'

CMP CULVERT AT STA. 193+75

PLAN-CMP CULVERT AT STA. 193+75
Scale: 1"=20'

ORIGINAL PLAN
DATE
DRAWN BY
CHECKED BY
NOTED BY
No.

TRANS - MERIDIAN
ENGINEERS & SURVEYORS
345 QUEEN ST., SUITE 500
HONOLULU, HAWAII 96813

DENIS T. SHU
REGISTERED PROFESSIONAL ENGINEER
No. 2447
HAWAII, U.S.A.



THIS WORK WAS PREPARED BY ME OR UNDER MY SUPERVISION
DENIS T. SHU

STATE OF HAWAII
DEPARTMENT OF TRANSPORTATION
HIGHWAYS DIVISION


DRAINAGE DETAILS
CMP CULVERT AT STA. 193+75
HONOAPIILANI HIGHWAY
ALAELOA TO PINEAPPLE HILL
F.A. PROJECT NO. F-030-1(8)
SCALE: AS SHOWN DATE SEP 1981

SHEET No. 2 OF 16 SHEETS

FED. ROAD DIST. NO.	STATE	FED. AID PROJ. NO.	FISCAL YEAR	SHEET NO.	TOTAL SHEETS
HAWAII	HAW.	F-030-1(8)	1981	39	92

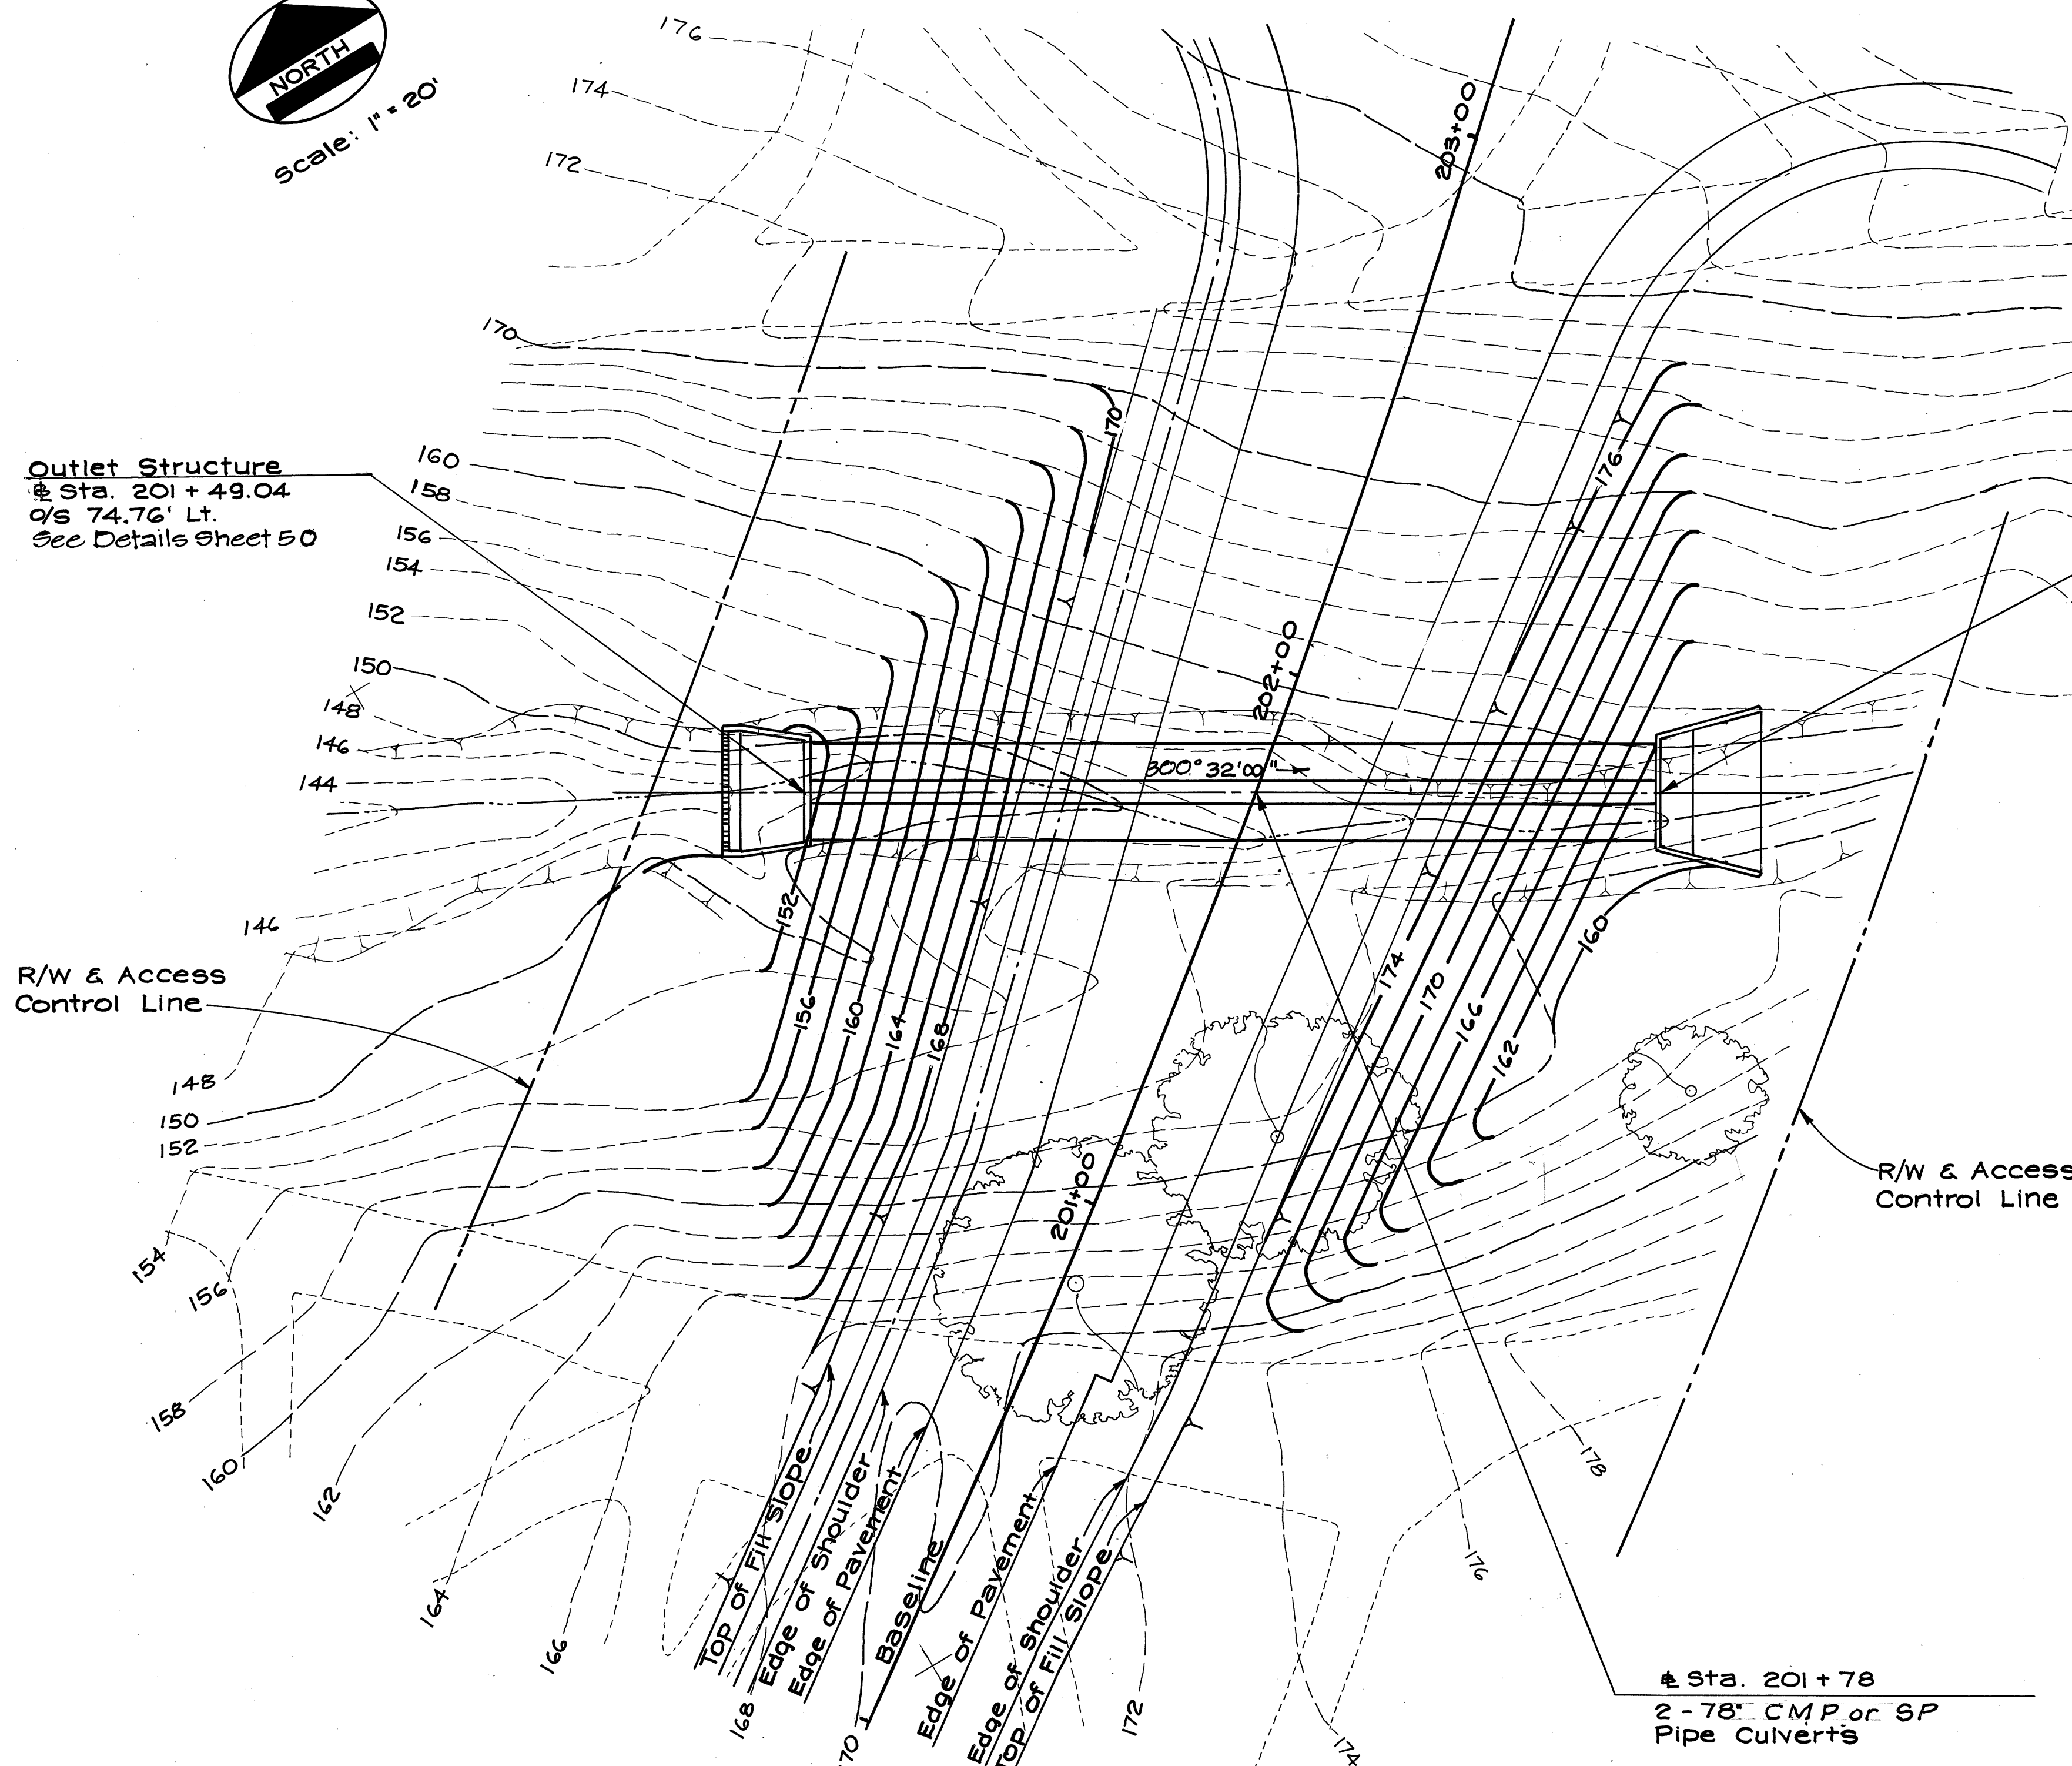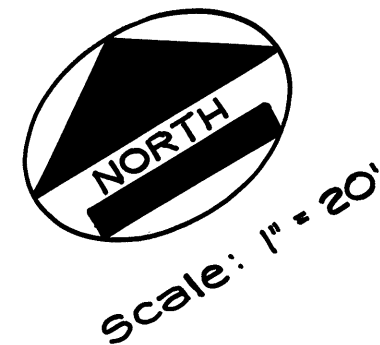


PLAN - CULVERT AT STA. 201+78
SCALE: 1" = 20'

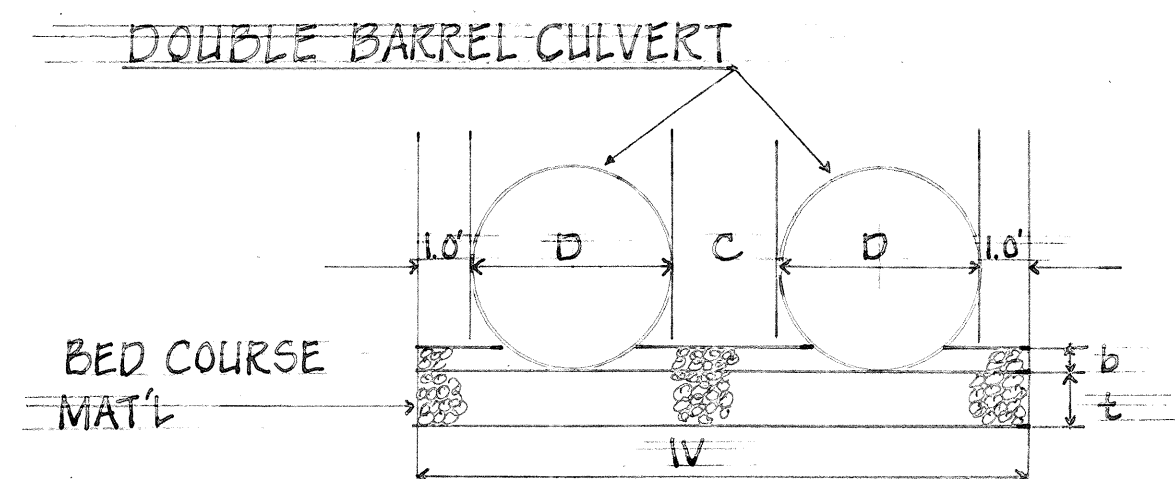

CULVERT STATION	D (in)	C (ft)	t (ft)	W (ft)	b (in)	QUANTITY (cy.)	L (ft)
201+78	78	4.01	1.0	19	8	451	152

Inlet Structure
Sta. 202+02.50
O/S 67.57'
Inv. = 154.70
See Details sheet 40

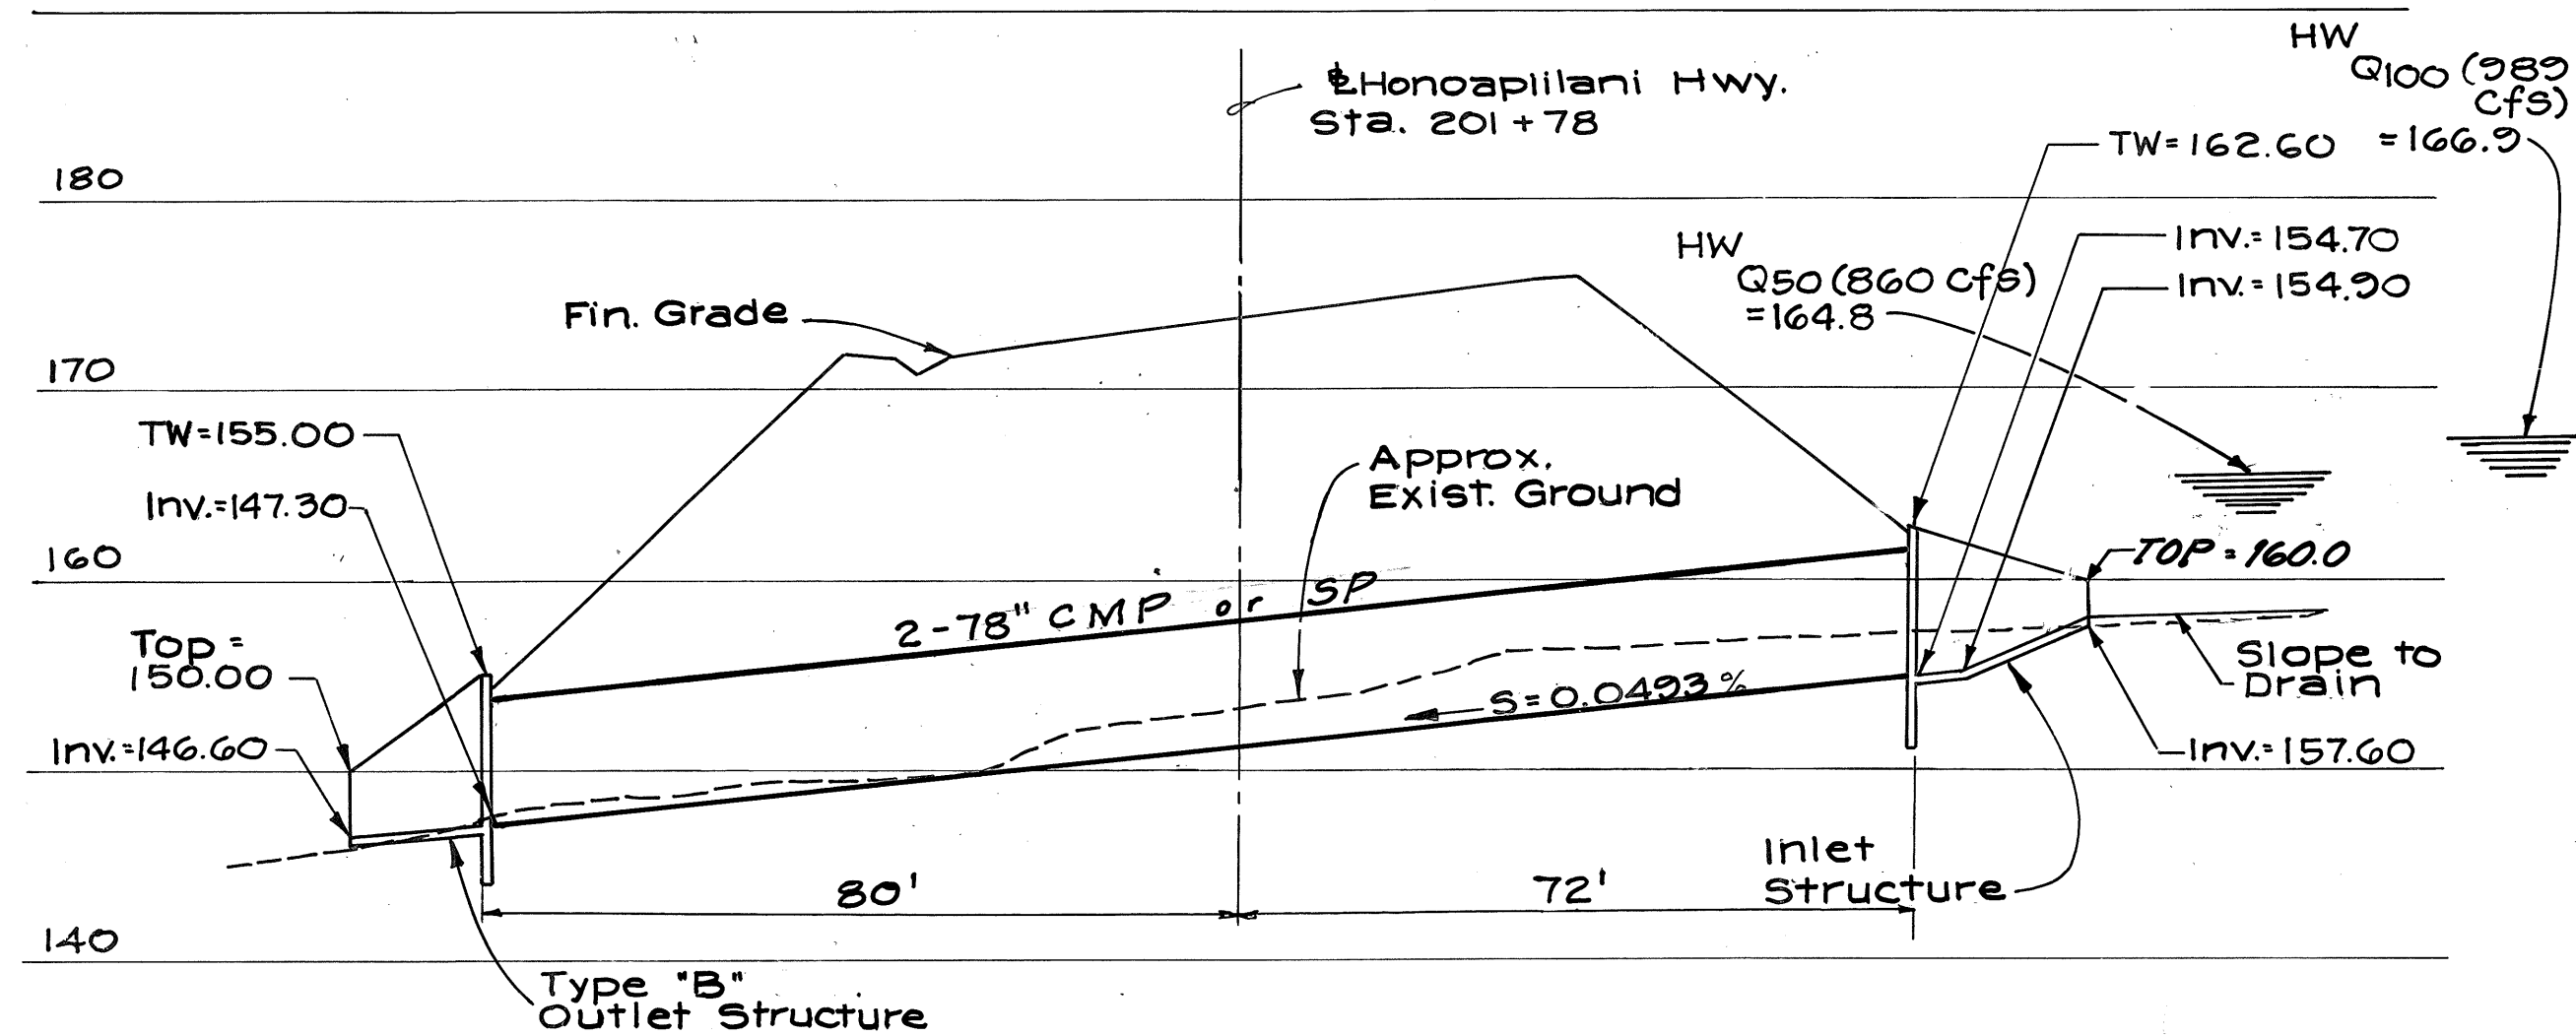

PROFILE - CULVERT STA. 201+78
SCALE: HORIZ. 1" = 20'
VERT. 1" = 10'

ORIGINAL PLAN	DATE
NO. 1	
NO. 2	
NO. 3	
NO. 92	

TRANS - MERIDIAN
ENGINEERS & SURVEYORS
345 QUEEN ST., SUITE 500
HONOLULU, HAWAII 96813

REGISTERED
PROFESSIONAL
ENGINEER
No. 2447
HAWAII, U.S.A.



THIS WORK WAS PREPARED BY ME OR UNDER MY SUPERVISION.
Denis T. Shiu

STATE OF HAWAII
DEPARTMENT OF TRANSPORTATION
HIGHWAYS DIVISION


**DRAINAGE DETAILS
CULVERT AT STA. 201+78**
HONOAPIILANI HIGHWAY
ALAELOA TO PINEAPPLE HILL
F.A. PROJECT NO. F-030-1(8)
SCALE: 1" = 50' DATE MAR 1982

SHEET No. 3 OF 16 SHEETS


FED. ROAD DIST. NO.	STATE	FED. AID PROJ. NO.	FISCAL YEAR	SHEET NO.	TOTAL SHEETS
HAWAII	HAW.	F-030-1(8)	1981	40	92

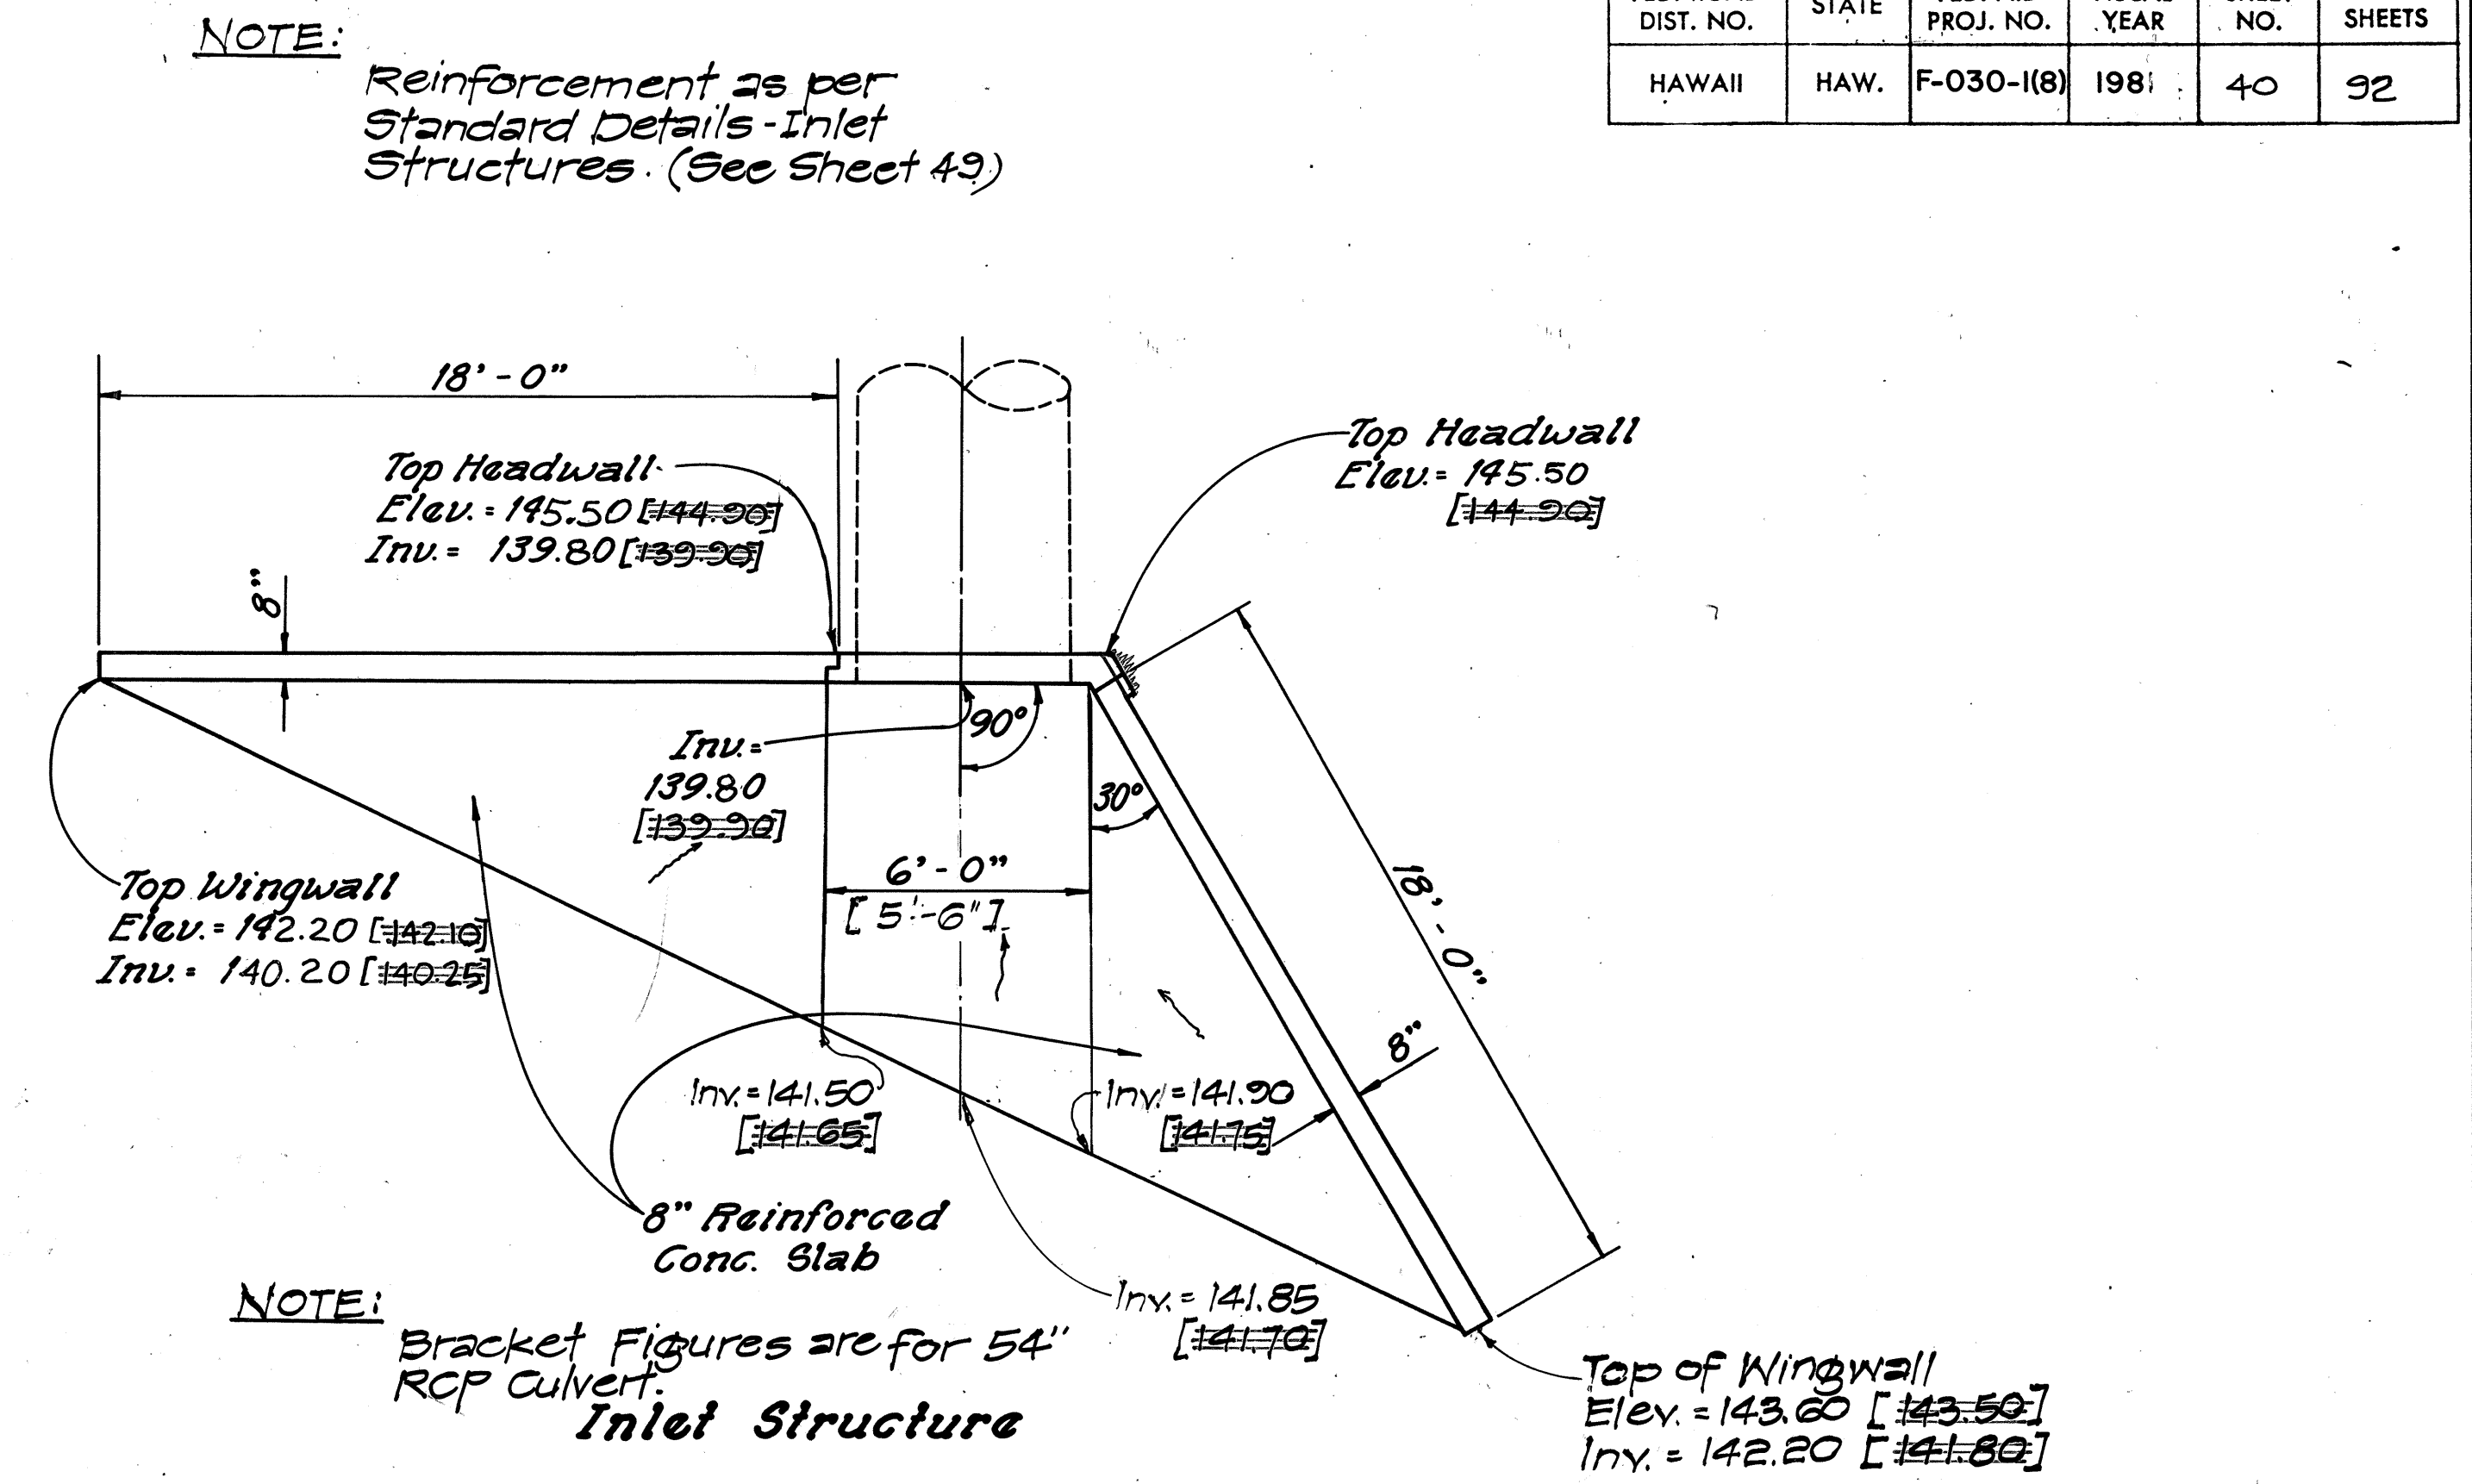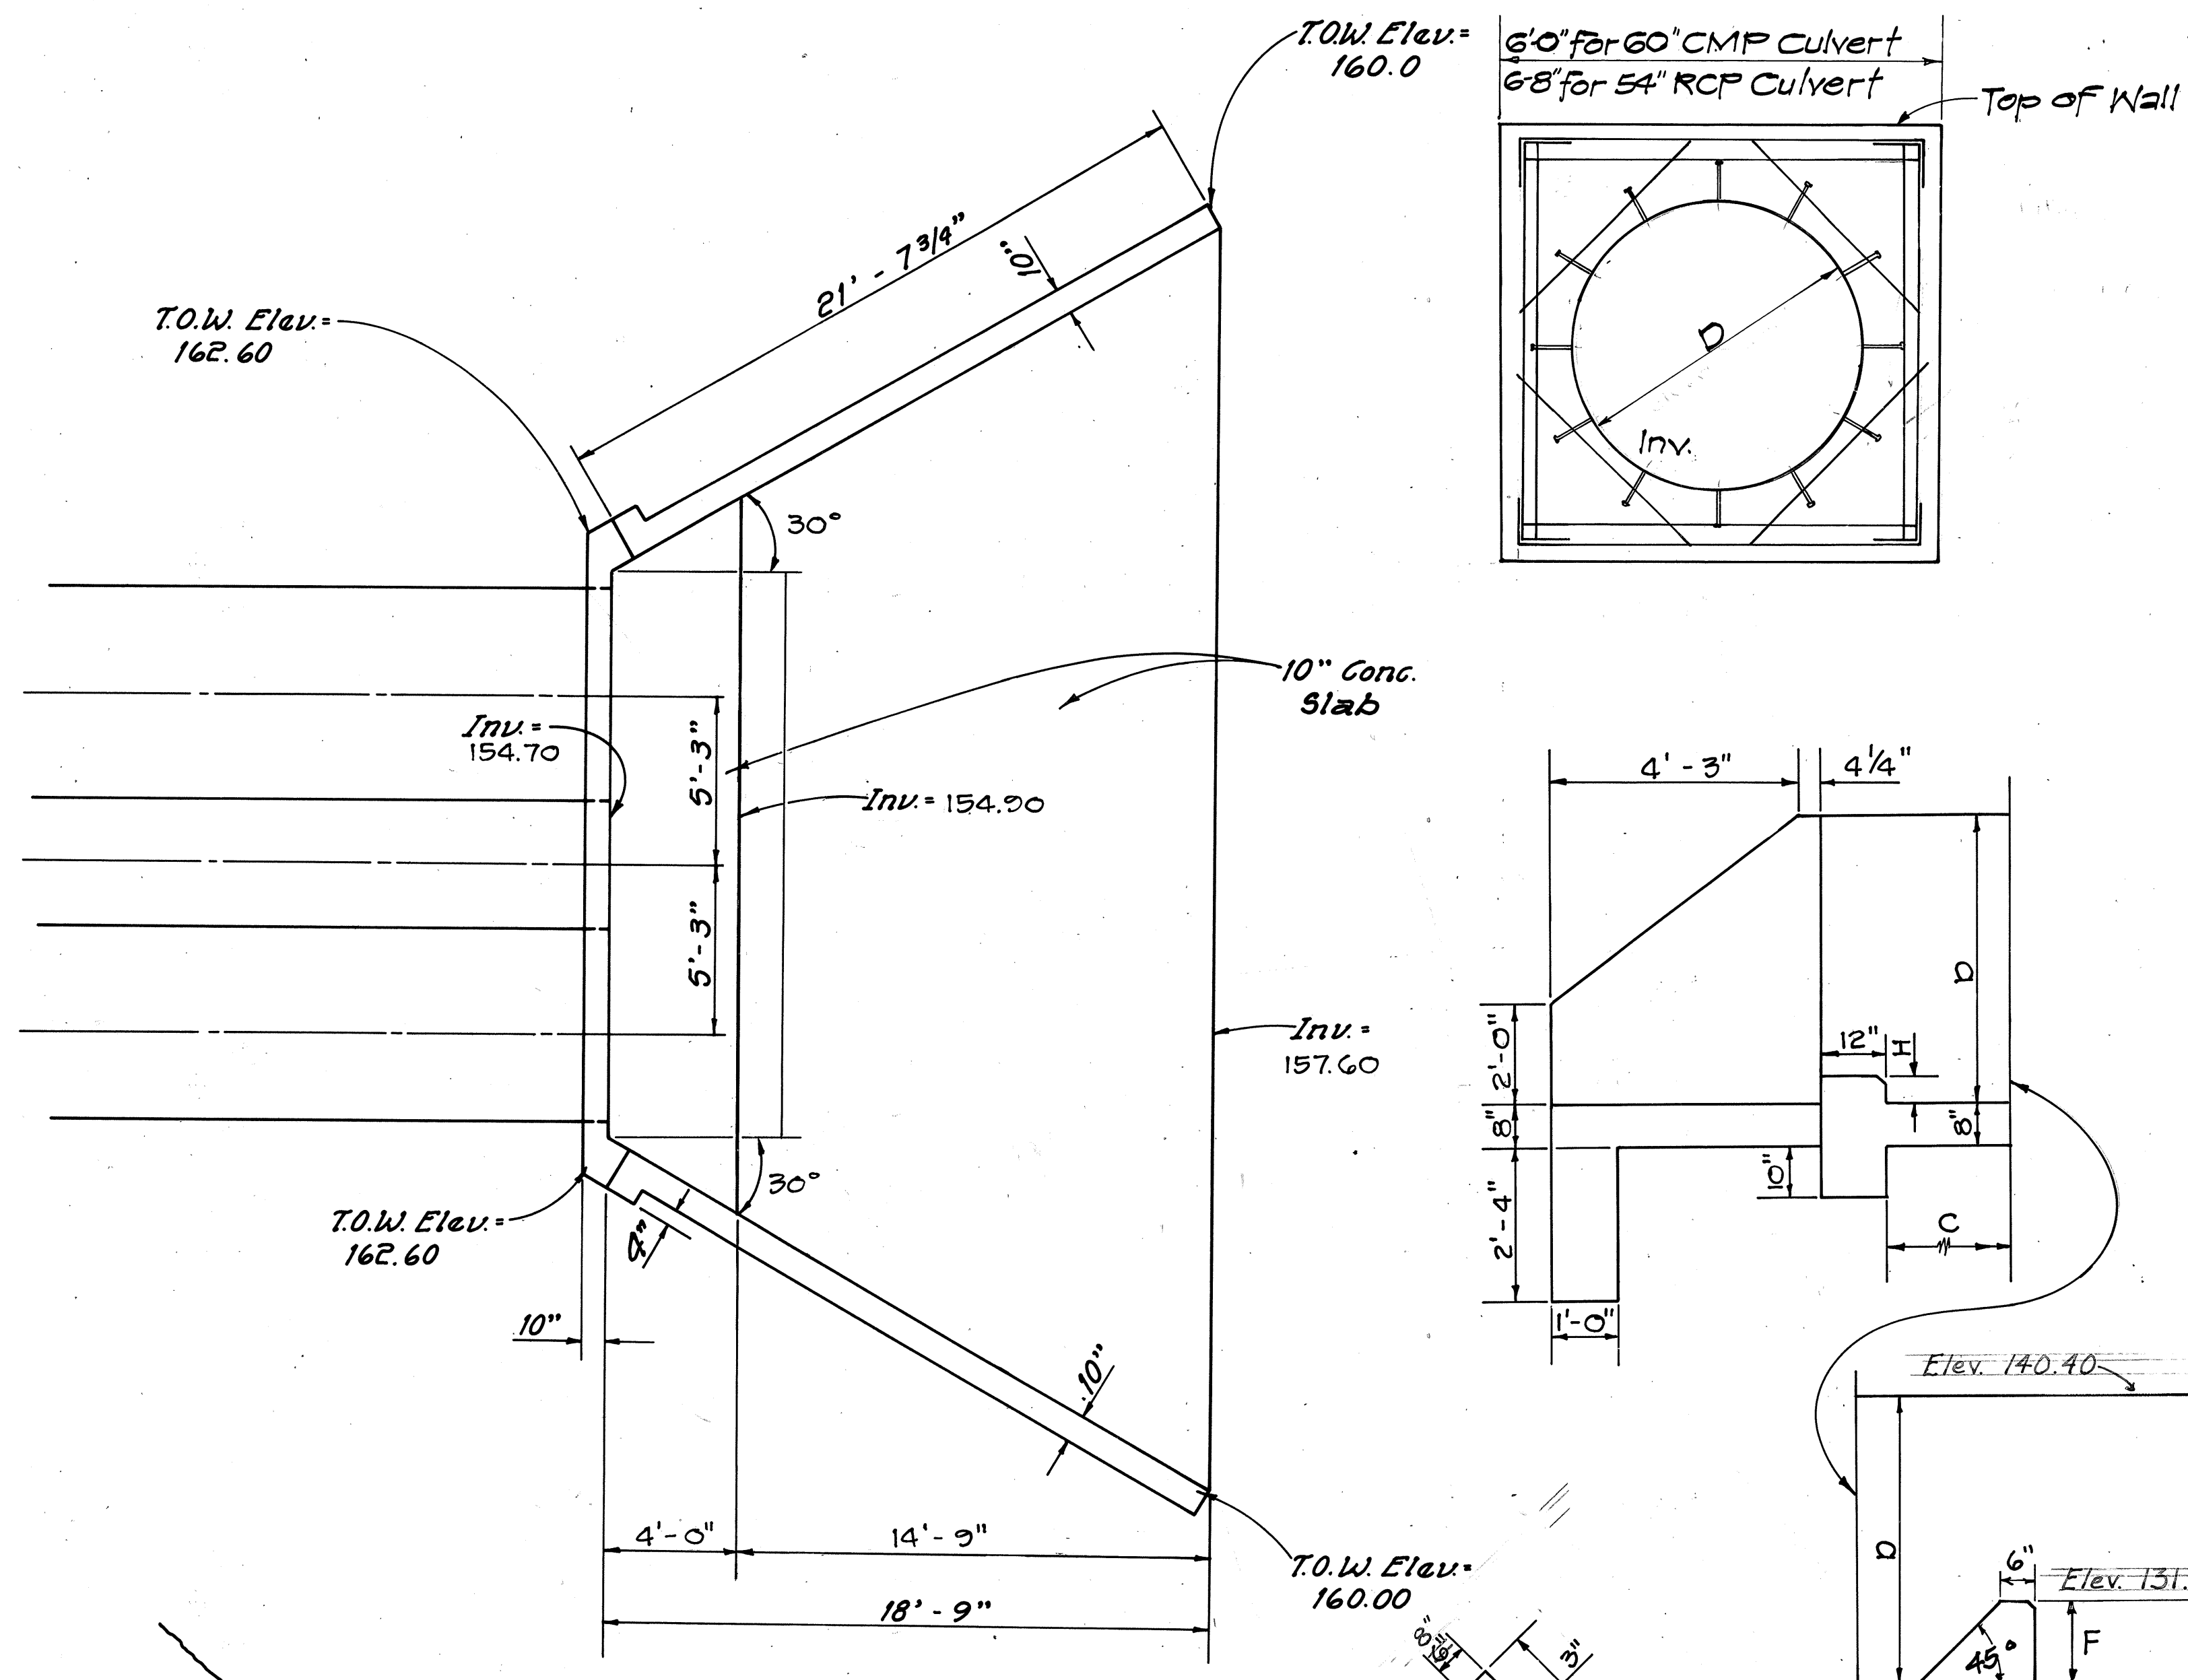



CULVERT AT STA. 193+75
Scale: 1/4" = 1'-0"

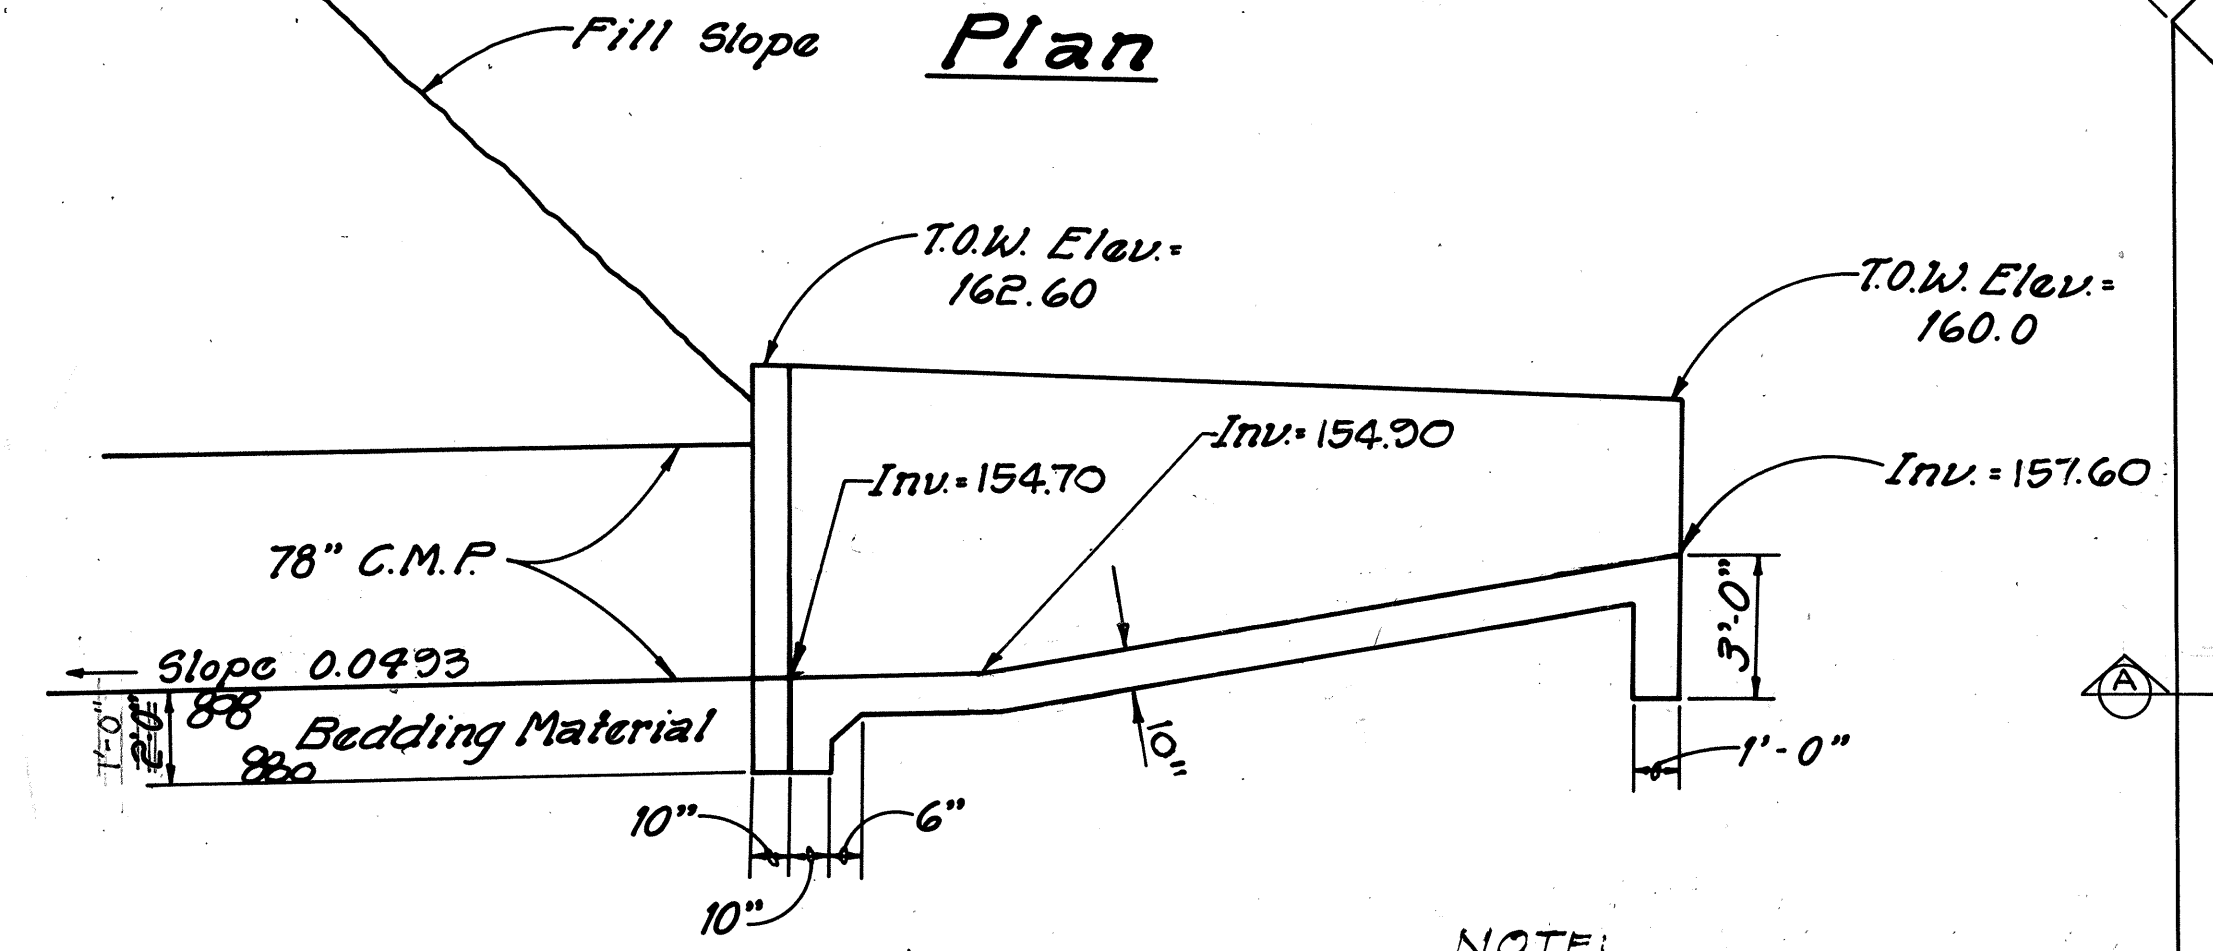

Section Inlet Structure
CULVERT AT STA. 201+78
Scale: 1/4" = 1'-0"

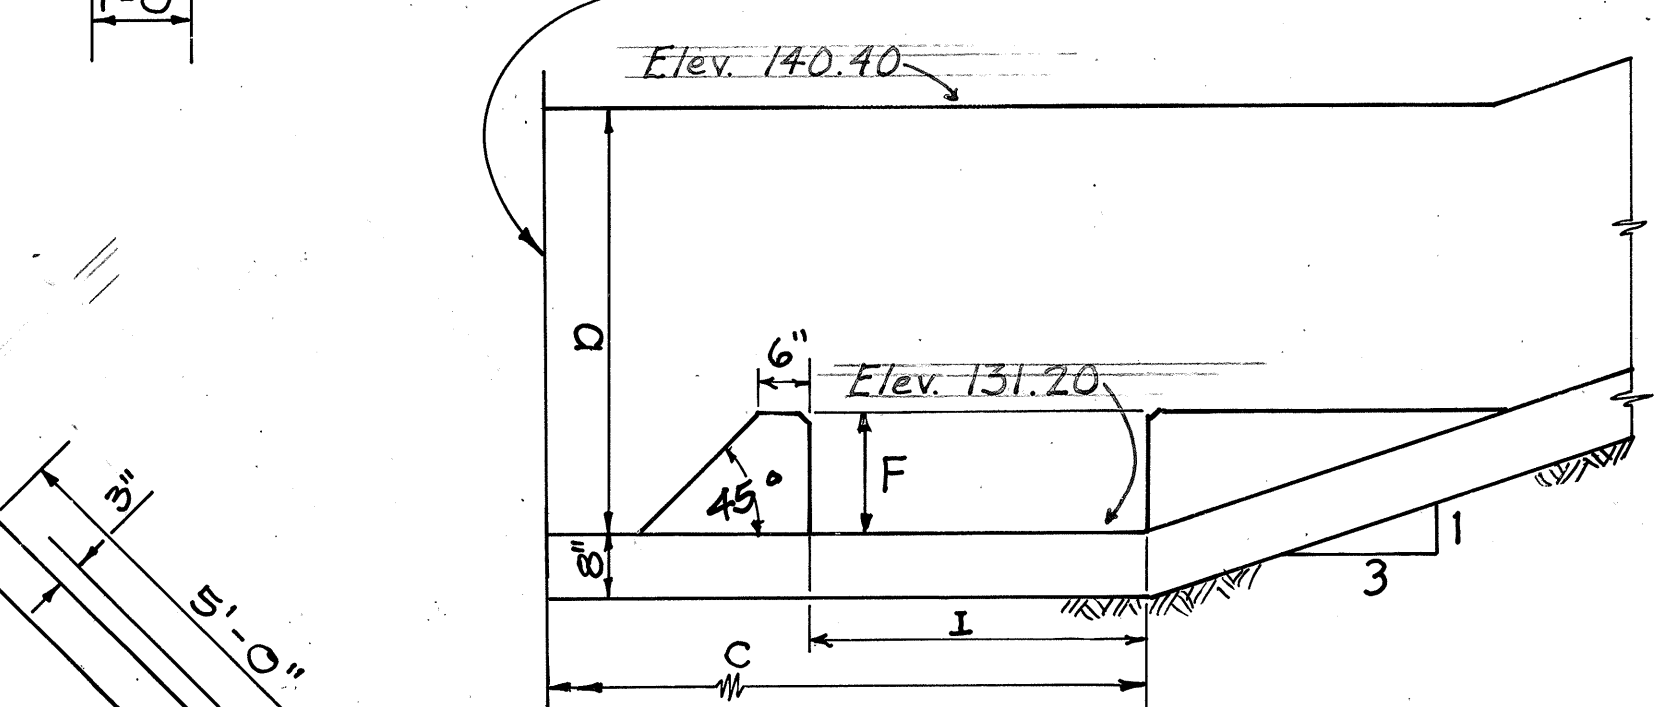


Section "A-A"
Not to Scale

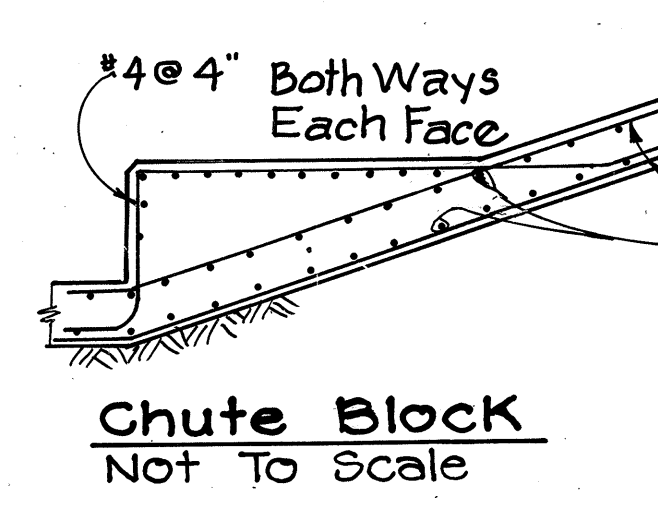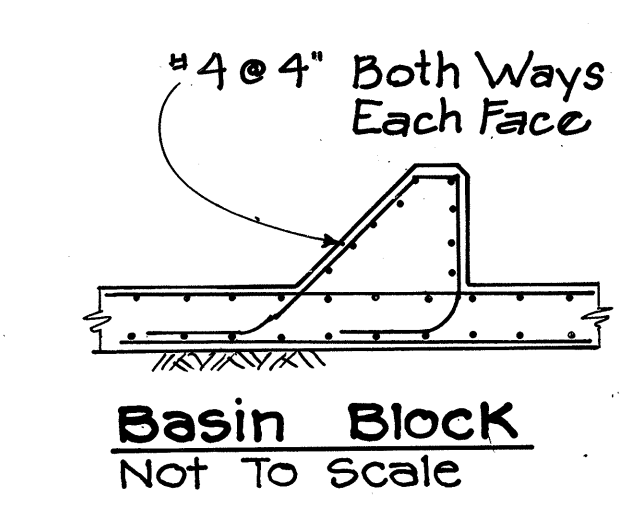


Basin Dimensions

	For 60" CMP	For 54" RCP
A =	5'-0"	5'-8"
B =	1'-3"	1'-0"
C =	11'-2"	10'-2"
D =	9'-2"	8'-5"
E =	0'-8"	0'-5"
F =	1'-5"	1'-3"
G =	1'-10"	1'-10 1/2"
H =	0'-6"	0'-6"
I =	3'-9"	3'-5"

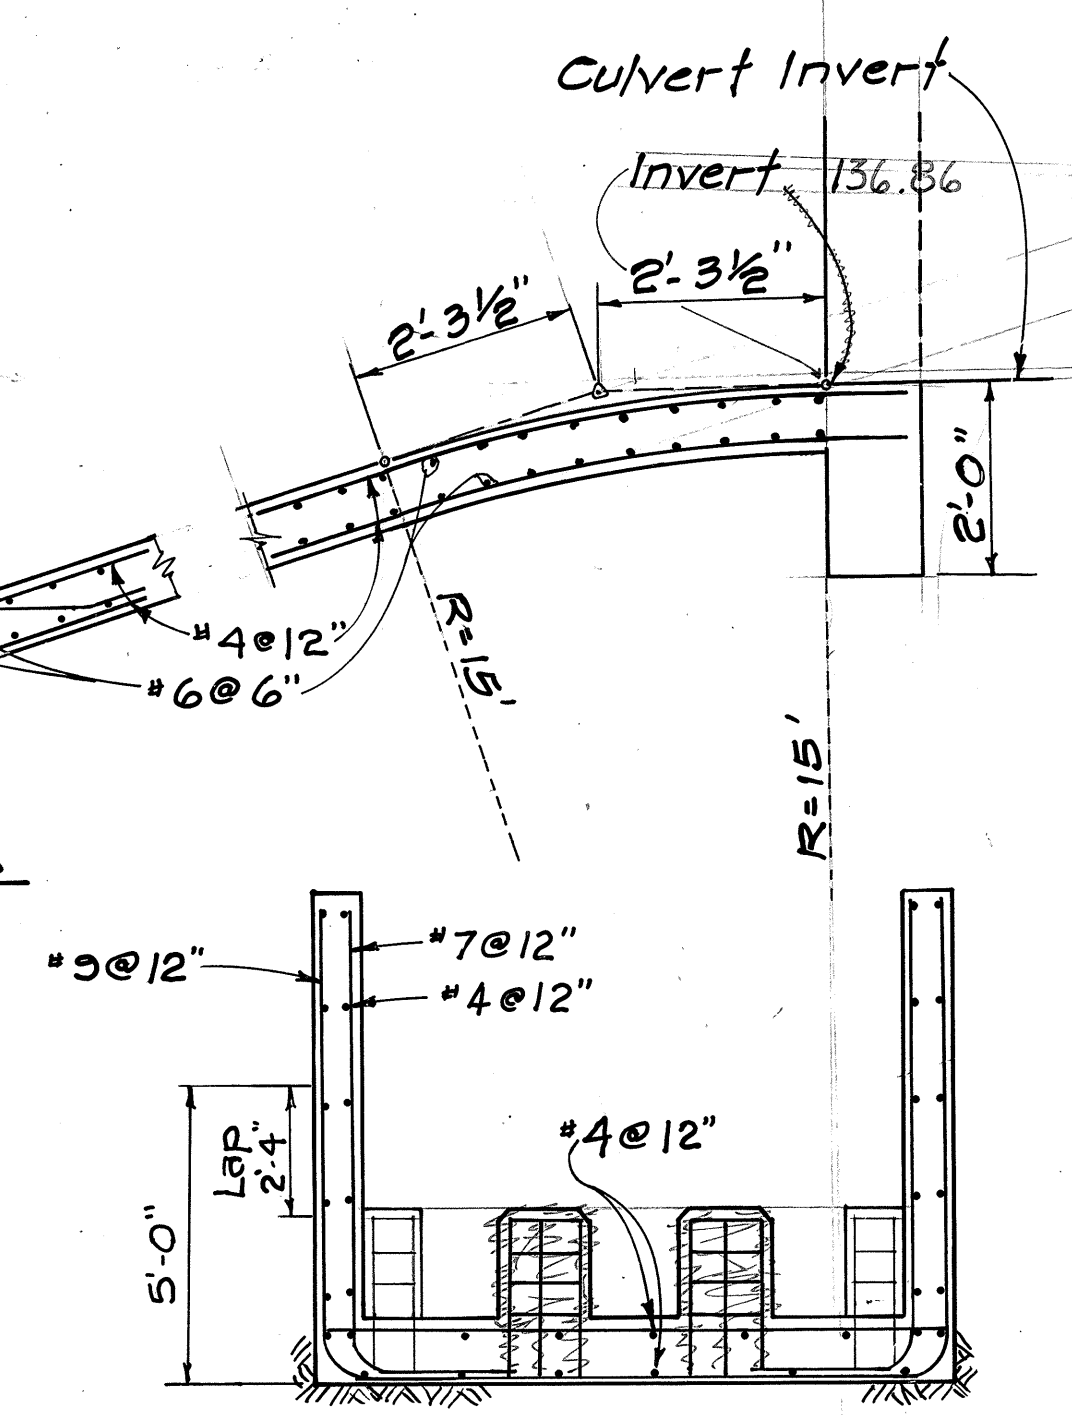

Section "B-B"
Not to Scale

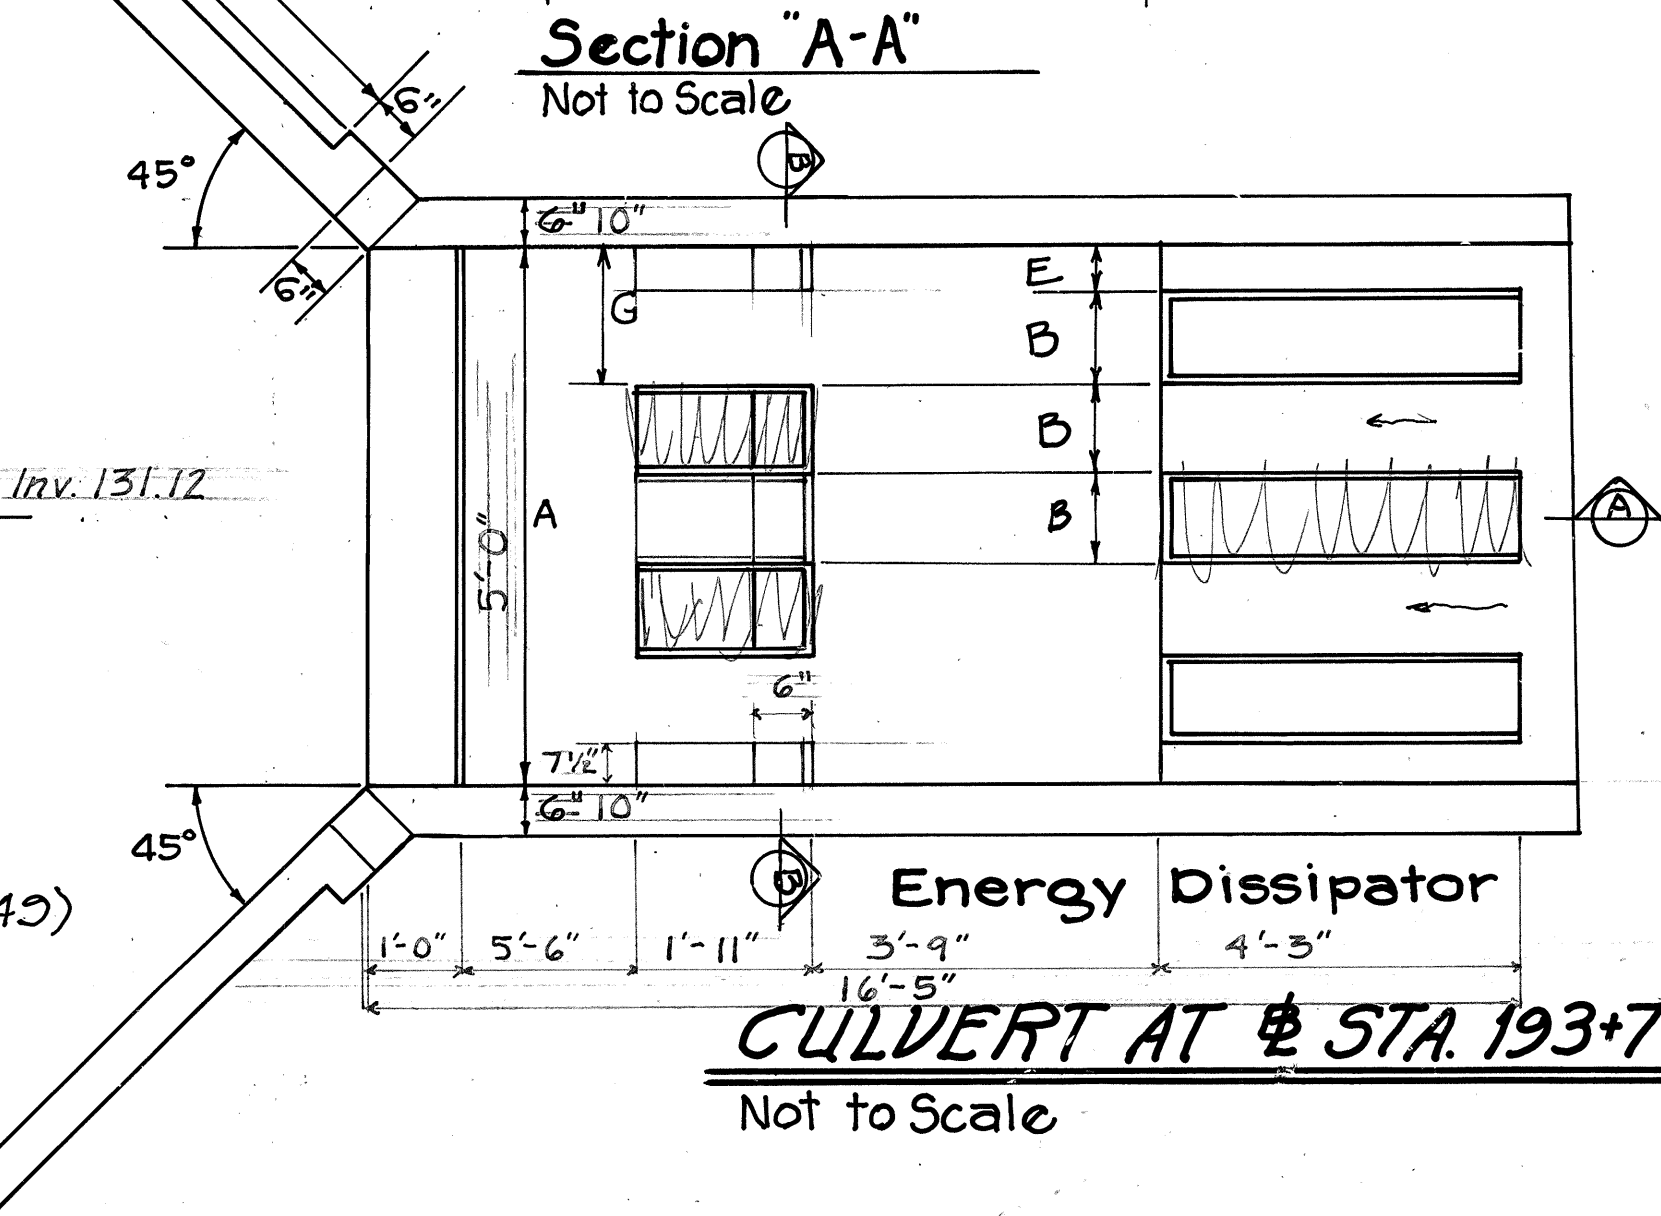

Energy Dissipator
CULVERT AT STA. 193+75
Not to Scale

TRANS-MERIDIAN
ENGINEERS & SURVEYORS
345 QUEEN ST., SUITE 500
HONOLULU, HAWAII 96813

DENIS T. SHU
REGISTERED
PROFESSIONAL
ENGINEER
No. 2447
HAWAII, U.S.A.

THIS WORK WAS PREPARED BY ME OR UNDER MY SUPERVISION

STATE OF HAWAII
DEPARTMENT OF TRANSPORTATION
HIGHWAYS DIVISION

DRAINAGE DETAILS
INLET DETAILS FOR CULVERTS AT
STA. 193+75 & STA. 201+78
HONOAPIILANI HIGHWAY
ALAELOA TO PINEAPPLE HILL
F.A. PROJECT NO. F-030-1 (8)


SCALE: AS SHOWN DATE: 10/1/81

SHEET No. 4 OF 16 SHEETS

DATE	
SURVEY PLOTTED BY	
DESIGNED BY	
TRACED BY	
NOTE BOOK	
QUANTITIES BY	
CHECKED BY	

FED. ROAD DIST. NO.	STATE	FED. AID PROJ. NO.	FISCAL YEAR	SHEET NO.	TOTAL SHEETS
HAWAII	HAW.	F-030-1(8)	1981	41	92

TRENCH DETAIL

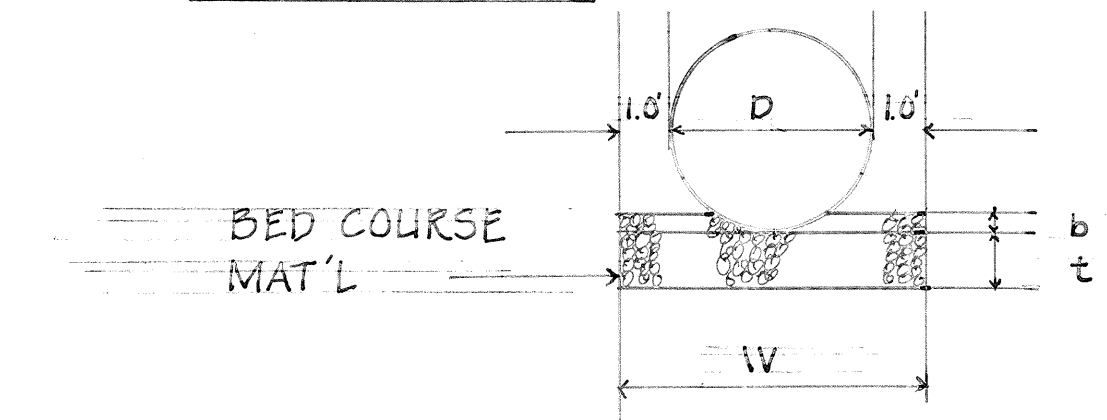

CULVERT STATION	D (in.)	t (ft.)	W (ft.)	b (in.)	QUANTITY (c.y.)	L (ft.)
193+75	60	1.0	7	6	15	42.5
209+37	120	1.5	12	12	210	220.4
221+19	108	2.5	11	11	451	357.7

Outlet Structure
 @ Sta. 209 + 14.84
 9/8 114.00' Lt.
 Inv. = 147.50' .61


Energy Dissipator
 See Details Sheet 45

R/W & Access Control Line

Inlet Structure
 @ Sta. 209 + 56.97
 9/8 102.74' Rt.
 Inv. = 158.10' 159.00
 See Details Sheet 44

R/W & Access Control Line

@ Sta. 209 + 37
 1- 120" CMP or Structural Plate Culvert
 For Profile, see sheet 43

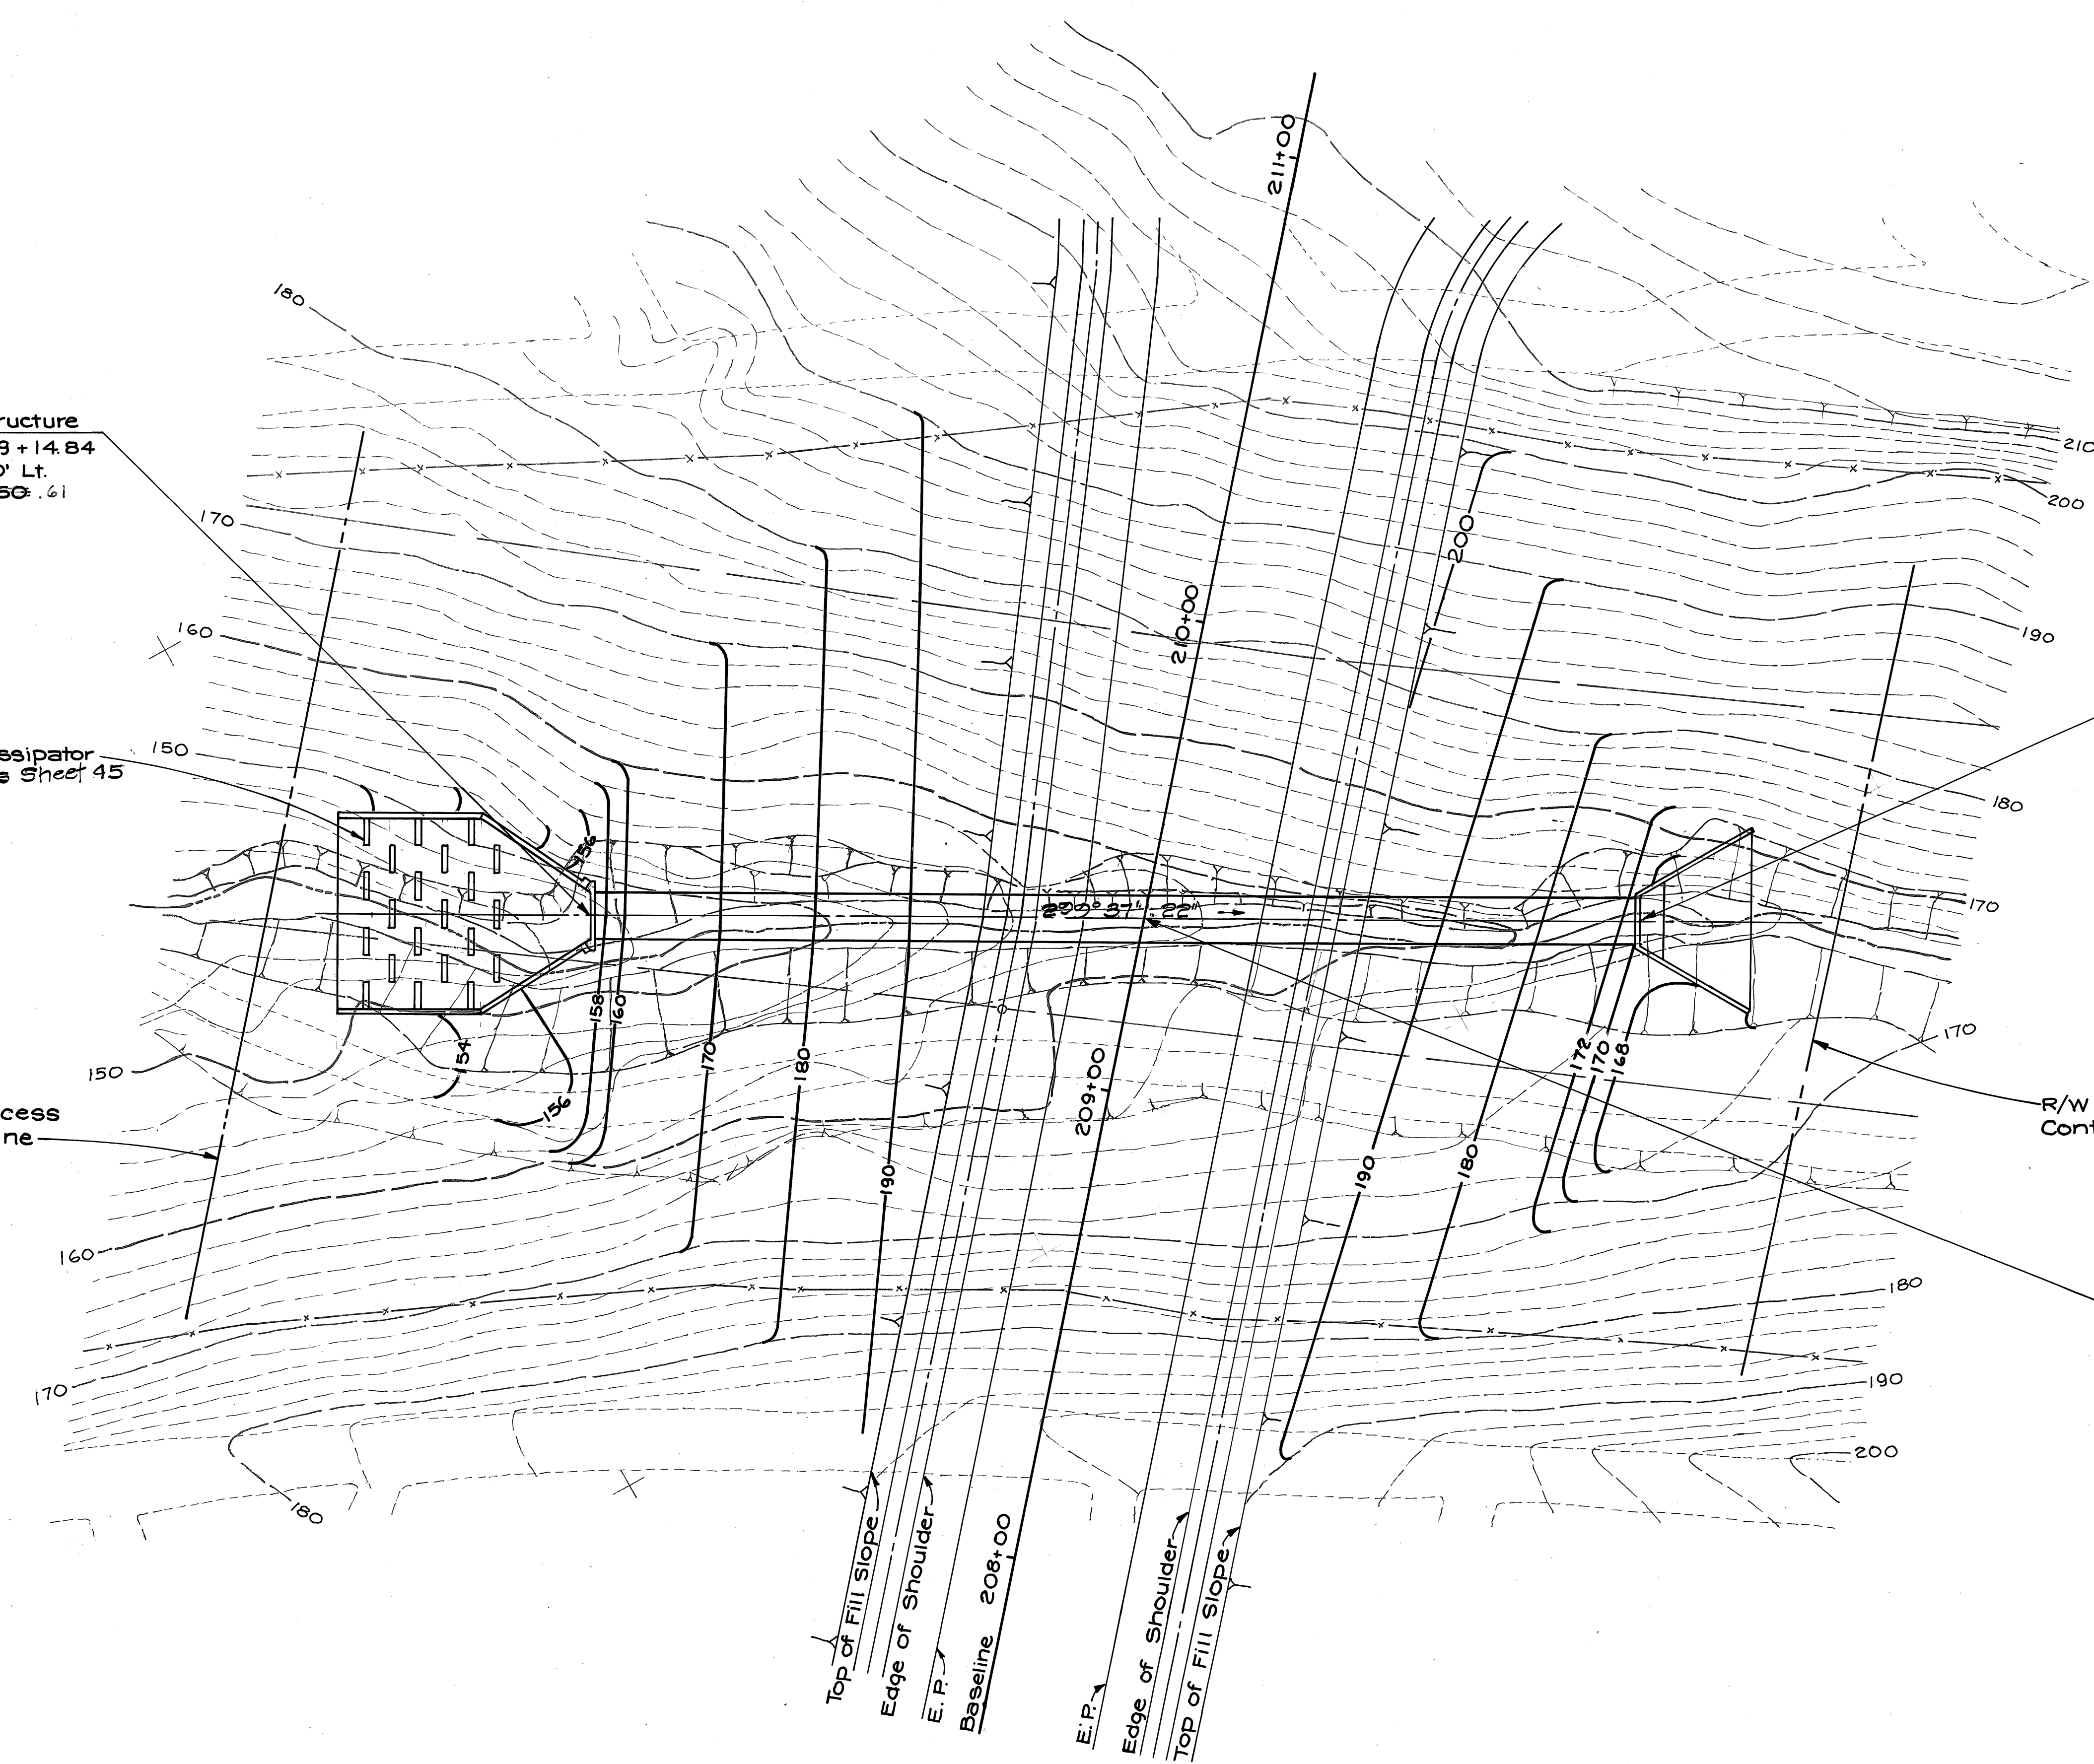


PLAN - CULVERT AT @ STA. 209 + 37

SCALE : 1" = 20'

ORIGINAL PLAN	DATE
SURVEY PLOTTED BY	
DRAWN BY	
DESIGNED BY	
CHECKED BY	
NOTE BOOK	
No.	

TRANS - MERIDIAN
ENGINEERS & SURVEYORS
345 QUEEN ST., SUITE 500
HONOLULU, HAWAII 96813

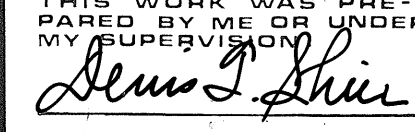
THIS WORK WAS PREPARED BY ME OR UNDER MY SUPERVISION


STATE OF HAWAII
DEPARTMENT OF TRANSPORTATION
HIGHWAYS DIVISION

DRAINAGE DETAILS
CULVERT AT @ STA. 209 + 37
 HONOAPIILANI HIGHWAY
 ALAELOA TO PINEAPPLE HILL
 F.A. PROJECT NO. F-030-1 (8)
 SCALE: AS SHOWN DATE **MAR 1982**

SHEET No. 5 OF 16 SHEETS

FED. ROAD DIST. NO.	STATE	FED. AID PROJ. NO.	FISCAL YEAR	SHEET NO.	TOTAL SHEETS
HAWAII	HAW.	F-030-1(8)	1981	42	92

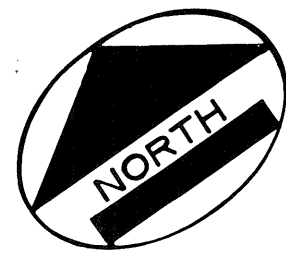

Curve Data
 $\Delta = 40^{\circ}00'00''$
 $R = 67.00'$
 $T = 24.39'$
 $\Delta/10 = 4^{\circ}00'00''$
 $C_H = 4.6851'$

Outlet Structure
 @ Sta. 221 + 05.31
 O/S 170.84 Lt.
 Inv. = 181.50, 182.86
 See Details - Sheet 44

Curve Data
 $\Delta = 30^{\circ}00'00''$
 $R = 71.79'$
 $T = 19.23'$
 $\Delta/8 = 3^{\circ}45'00''$
 $C_H = 4.70'$

Inlet Structure
 @ Sta. 222 + 12.76
 O/S 152.21 Rt.
 Inv. = 196.20
 See Details Sheet 44

R/W & Access Control Line


R/W & Access Control Line

@ Sta. 221 + 19
 1-108" CMP or Structural Plate Culvert

PLAN - CULVERT AT @ STA.221 + 19

SCALE: 1" = 20'

DATE	
SURVEY PLOTTED BY	
ORIGINAL PLAN	
DRAWN BY	
TRACED BY	
DESIGNED BY	
CHECKED BY	
NOTE BOOK	
No.	

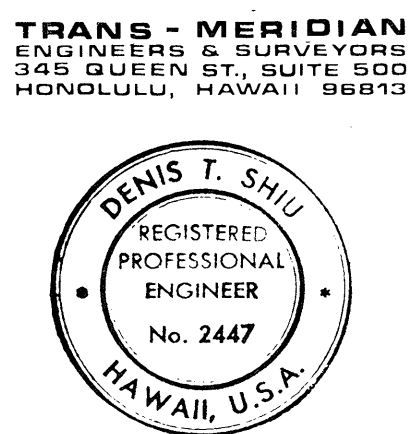

THIS WORK WAS PREPARED BY ME OR UNDER MY SUPERVISION
Denis T. Shiu

STATE OF HAWAII
 DEPARTMENT OF TRANSPORTATION
 HIGHWAYS DIVISION

DRAINAGE DETAILS
 CULVERT AT @ STA.221+19
 HONOAPILANI HIGHWAY
 ALAEOLO TO PINEAPPLE HILL
 F.A. PROJECT NO. F-030-1(8)
 SCALE: AS SHOWN DATE: MAR 1982
 SHEET No. 6 OF 16 SHEETS

FED. ROAD DIST. NO.	STATE	FED. AID PROJ. NO.	FISCAL YEAR	SHEET NO.	TOTAL SHEETS
HAWAII	HAW.	F-030-1(8)	1981	42 A	96

CULVERT & CURVE NO. 2 DATA
 $\Delta = 48^{\circ} 00' 00''$
 $R = 191.01'$
 $T = 85.04'$
 $L = 160.02'$
 $C = 155.39'$

36" Inlet Pipe
Sta. 5+13.50
= Honoapiilani Hwy
Sta. 240+21.13
9/5 104.36' Rt.
Top Elev. = 250.00

CULVERT & CURVE NO. 1 DATA
 $\Delta = 36^{\circ} 00' 00''$
 $R = 191.01'$
 $T = 62.06'$
 $L = 120.01'$
 $C = 118.05'$

**& CURVES NO. 1 & NO. 2
CULVERT SEGMENT DATA**
 $\Delta = 3^{\circ} 00' 00''$
 $R = 191.01'$
 $T = 5.00'$
 $L = 10.00'$
 $C = 10.00'$

② CURVE DATA
 $\Delta = 43^{\circ} 30' 00''$
 $R = 2650.00'$
 $L = 2011.93'$
 $C = 1963.95'$
P.C. = 238+23.62

Inlet structure
w/ Debris Rack
Sta. 5+35.27
= Honoapiilani Hwy
Sta. 240+13.08
9/5 124.79' Rt.
Top = 242.70 239.27
Inv. = 236.70 233.27

Outlet structure
w/ Cattle Guard
Sta. 0+35.01
= Honoapiilani Hwy
Sta. 243+72.47
9/5 123.04' Lt.
Top = 197.50
Inv. = 191.50

Begin Wall
Sta. 0+15.43
9/5 14.05' Lt.
= Honoapiilani Hwy
Sta. 243+97.75'
9/5 128.13' Lt.

NOTE:
This culvert at Sta. 240+65
shall require no elongation.

PLAN - CMP CULVERT AT STA. 240+65
SCALE: 1" = 20'

TRANS-MERIDIAN
ENGINEERS & SURVEYORS
345 QUEEN ST., SUITE 500
HONOLULU, HAWAII 96813

THIS WORK WAS PREPARED BY ME OR UNDER MY SUPERVISION

Denis T. Shiu

STATE OF HAWAII
DEPARTMENT OF TRANSPORTATION
HIGHWAYS DIVISION

DRAINAGE DETAILS


HONOAPIILANI HIGHWAY
ALAELOA TO PINEAPPLE HILL

F.A. PROJECT NO. F-030-1(8)
SCALE: AS SHOWN DATE FEB. 1983


SHEET No. 7 A OF 20 SHEETS

DATE	
DESIGNED BY	
DRAWN BY	
CHECKED BY	
NOTED BY	
NO.	


FED. ROAD DIST. NO.	STATE	FED. AID PROJ. NO.	FISCAL YEAR	SHEET NO.	TOTAL SHEETS
HAWAII	HAW.	F-030-1(8)	1981	42 D	96

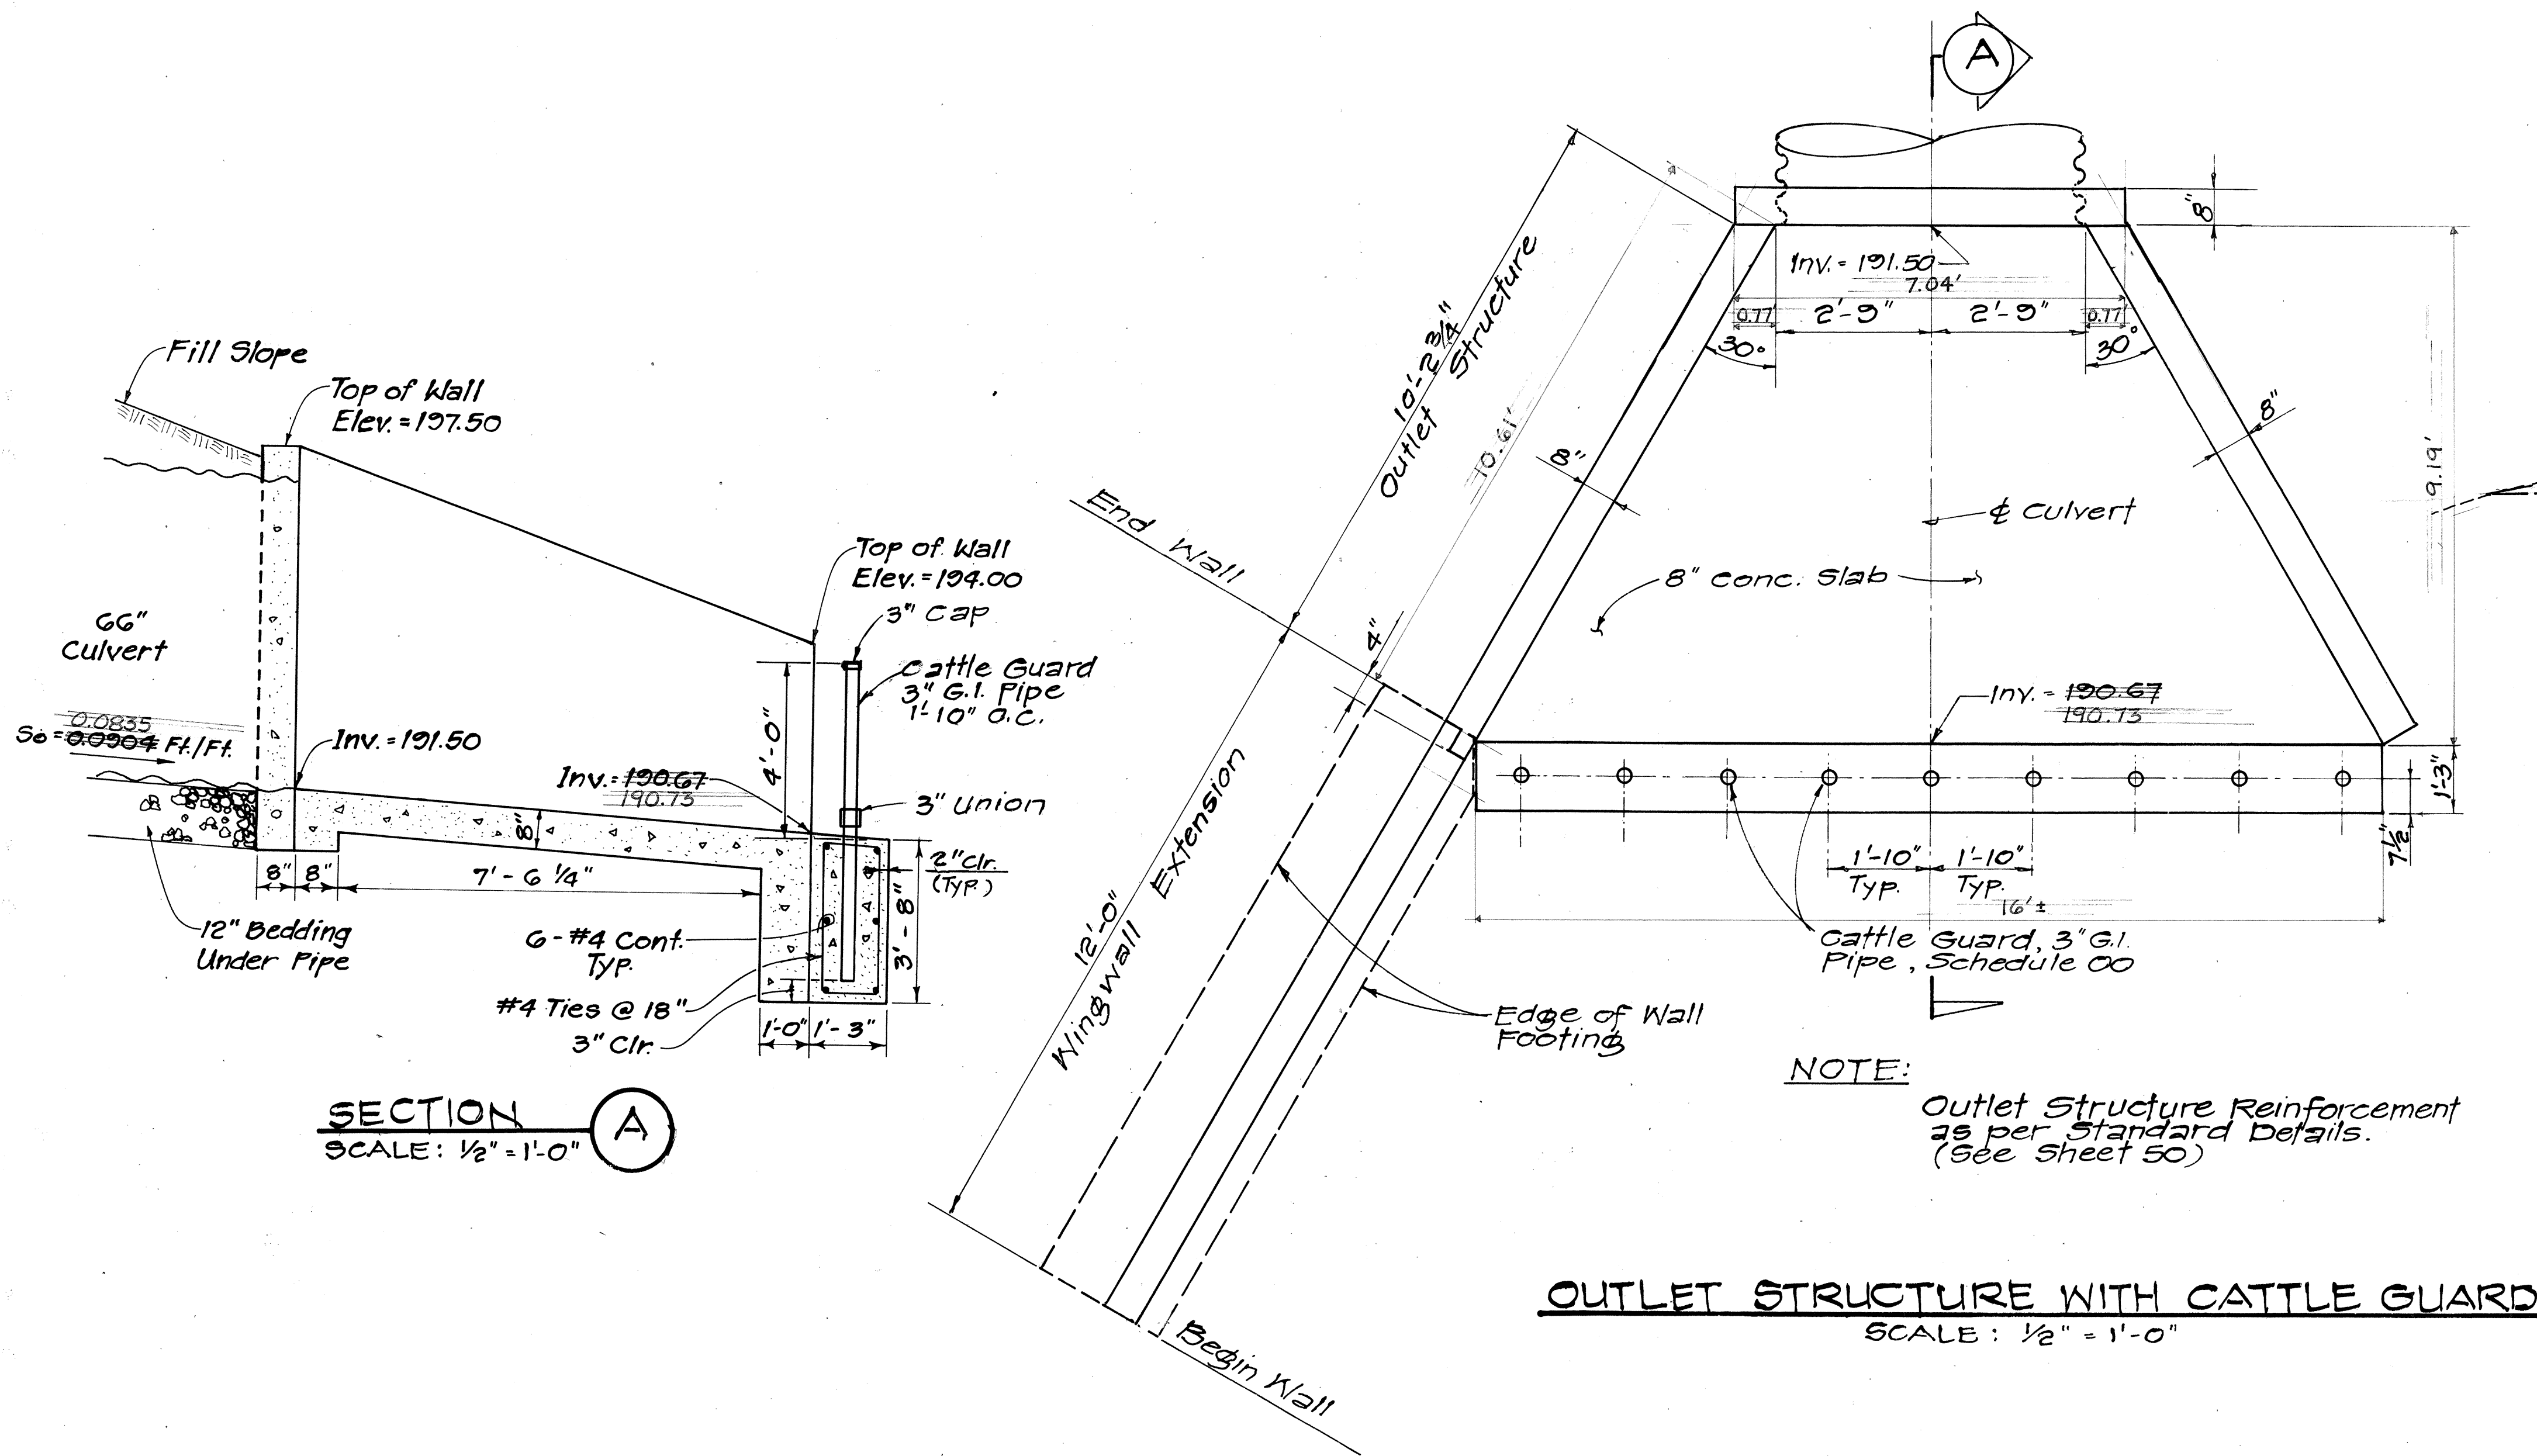

OUTLET STRUCTURE WITH CATTLE GUARD
SCALE: 1/2" = 1'-0"

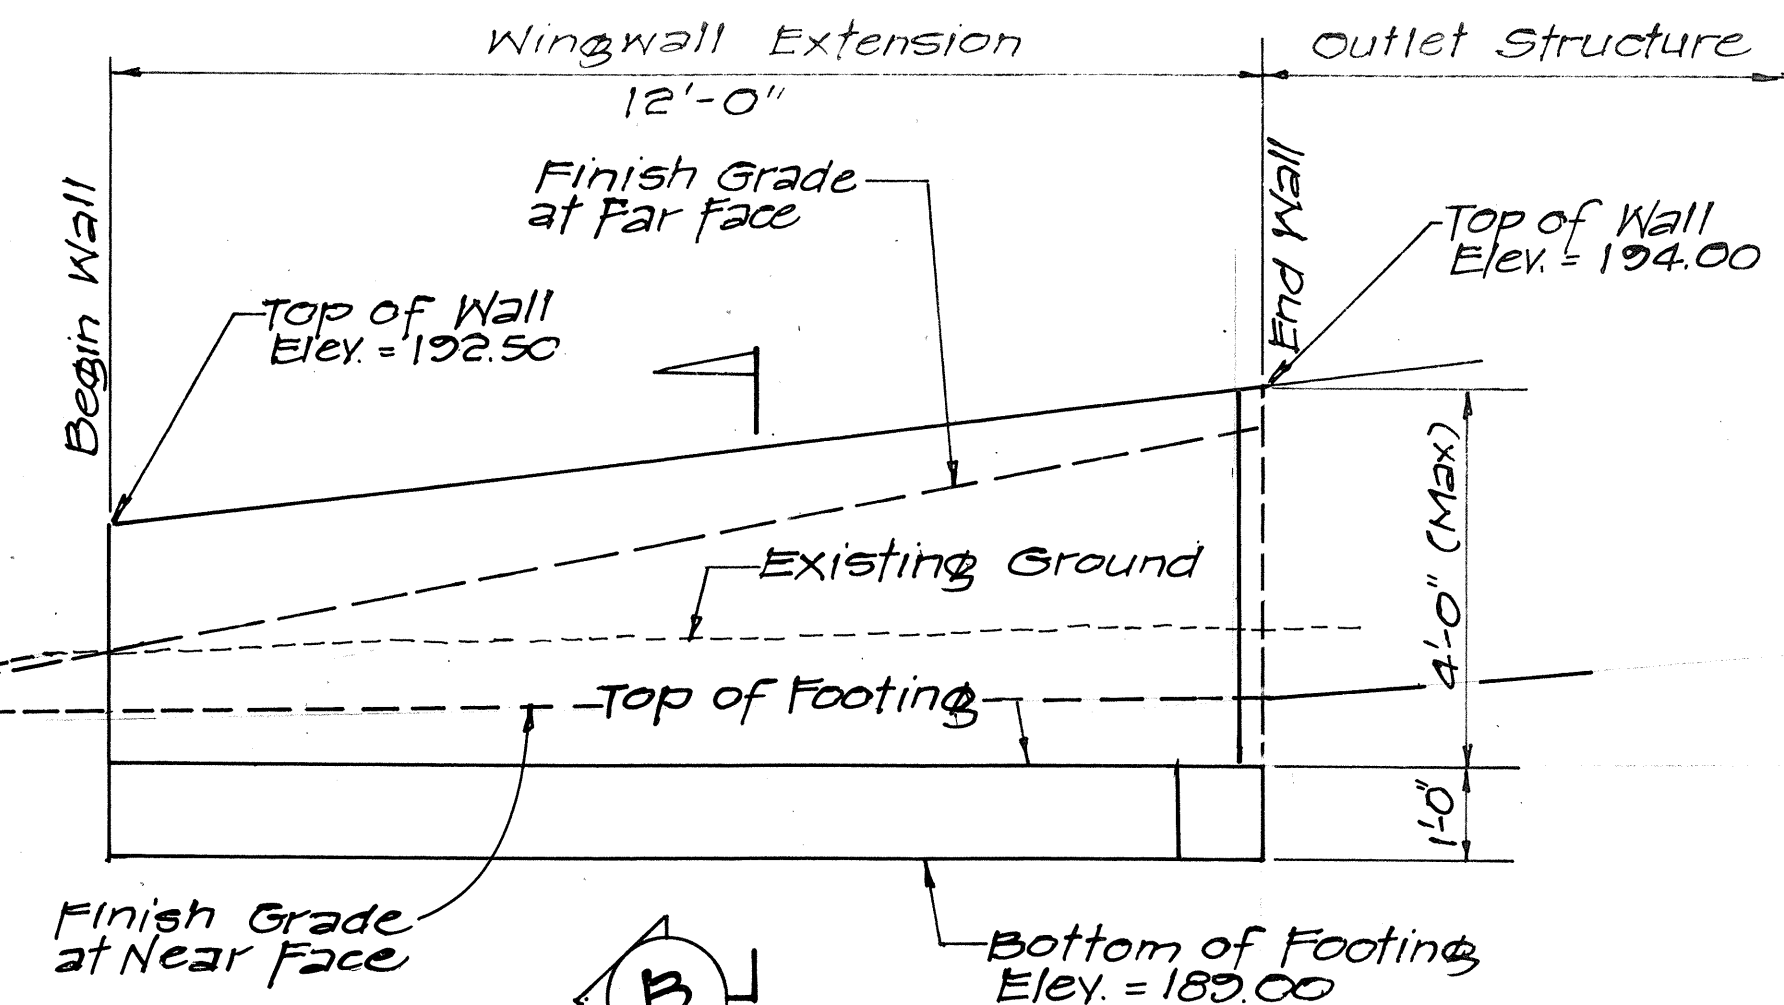

WINGWALL EXTENSION
SCALE: 1/2" = 1'-0"

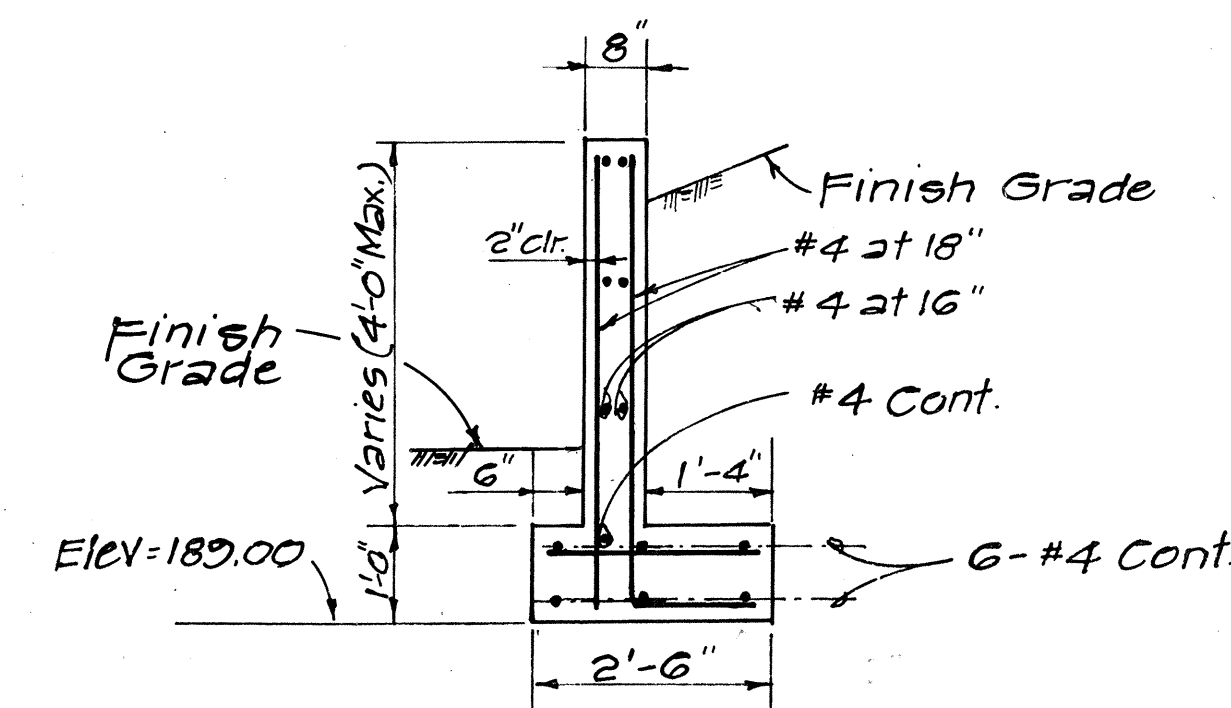

SECTION B
SCALE: 1/2" = 1'-0"

DATE	
DESIGNED BY	
TRACED BY	
NOTED BY	
CHECKED BY	
ORIGINAL PLAN	
NOTE BOOK	
No.	

TRANS-MERIDIAN
ENGINEERS & SURVEYORS
545 QUEEN ST., SUITE 500
HONOLULU, HAWAII 96813

DENIS T. SHU
REGISTERED
PROFESSIONAL
ENGINEER
No. 2447
HAWAII, U.S.A.

THIS WORK WAS PREPARED BY ME OR UNDER MY SUPERVISION

Denis T. Shu

STATE OF HAWAII
DEPARTMENT OF TRANSPORTATION
HIGHWAYS DIVISION


DRAINAGE PLAN

HONOAPIILANI HIGHWAY
ALAELOA TO PINEAPPLE HILL


F.A. PROJECT NO. F-030-1(8)
SCALE: AS SHOWN DATE FEB. 1983

SHEET No. 7D OF 20 SHEETS

FED. ROAD DIST. NO.	STATE	FED. AID PROJ. NO.	FISCAL YEAR	SHEET NO.	TOTAL SHEETS
HAWAII	HAW.	F-030-1(8)	1981	43	92

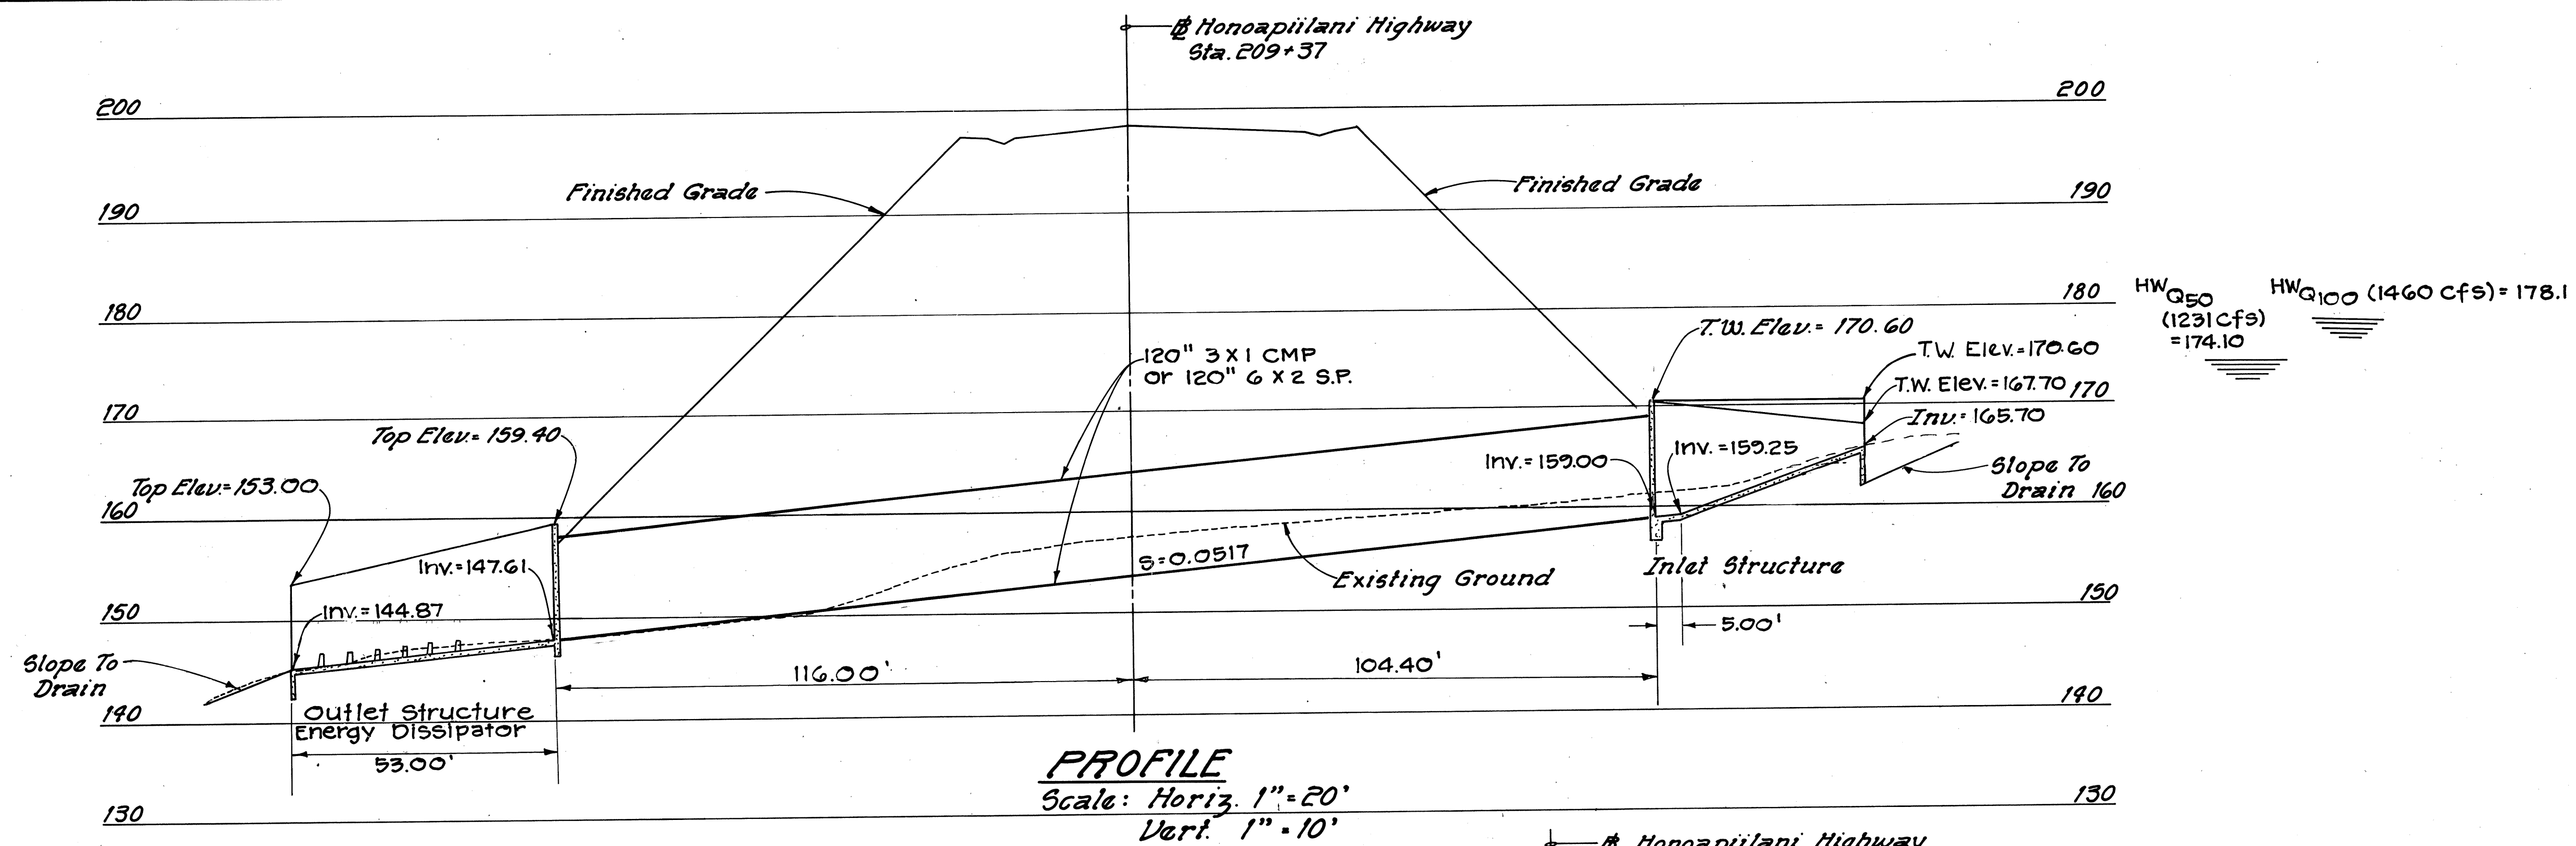


CULVERT AT STA. 209 + 37

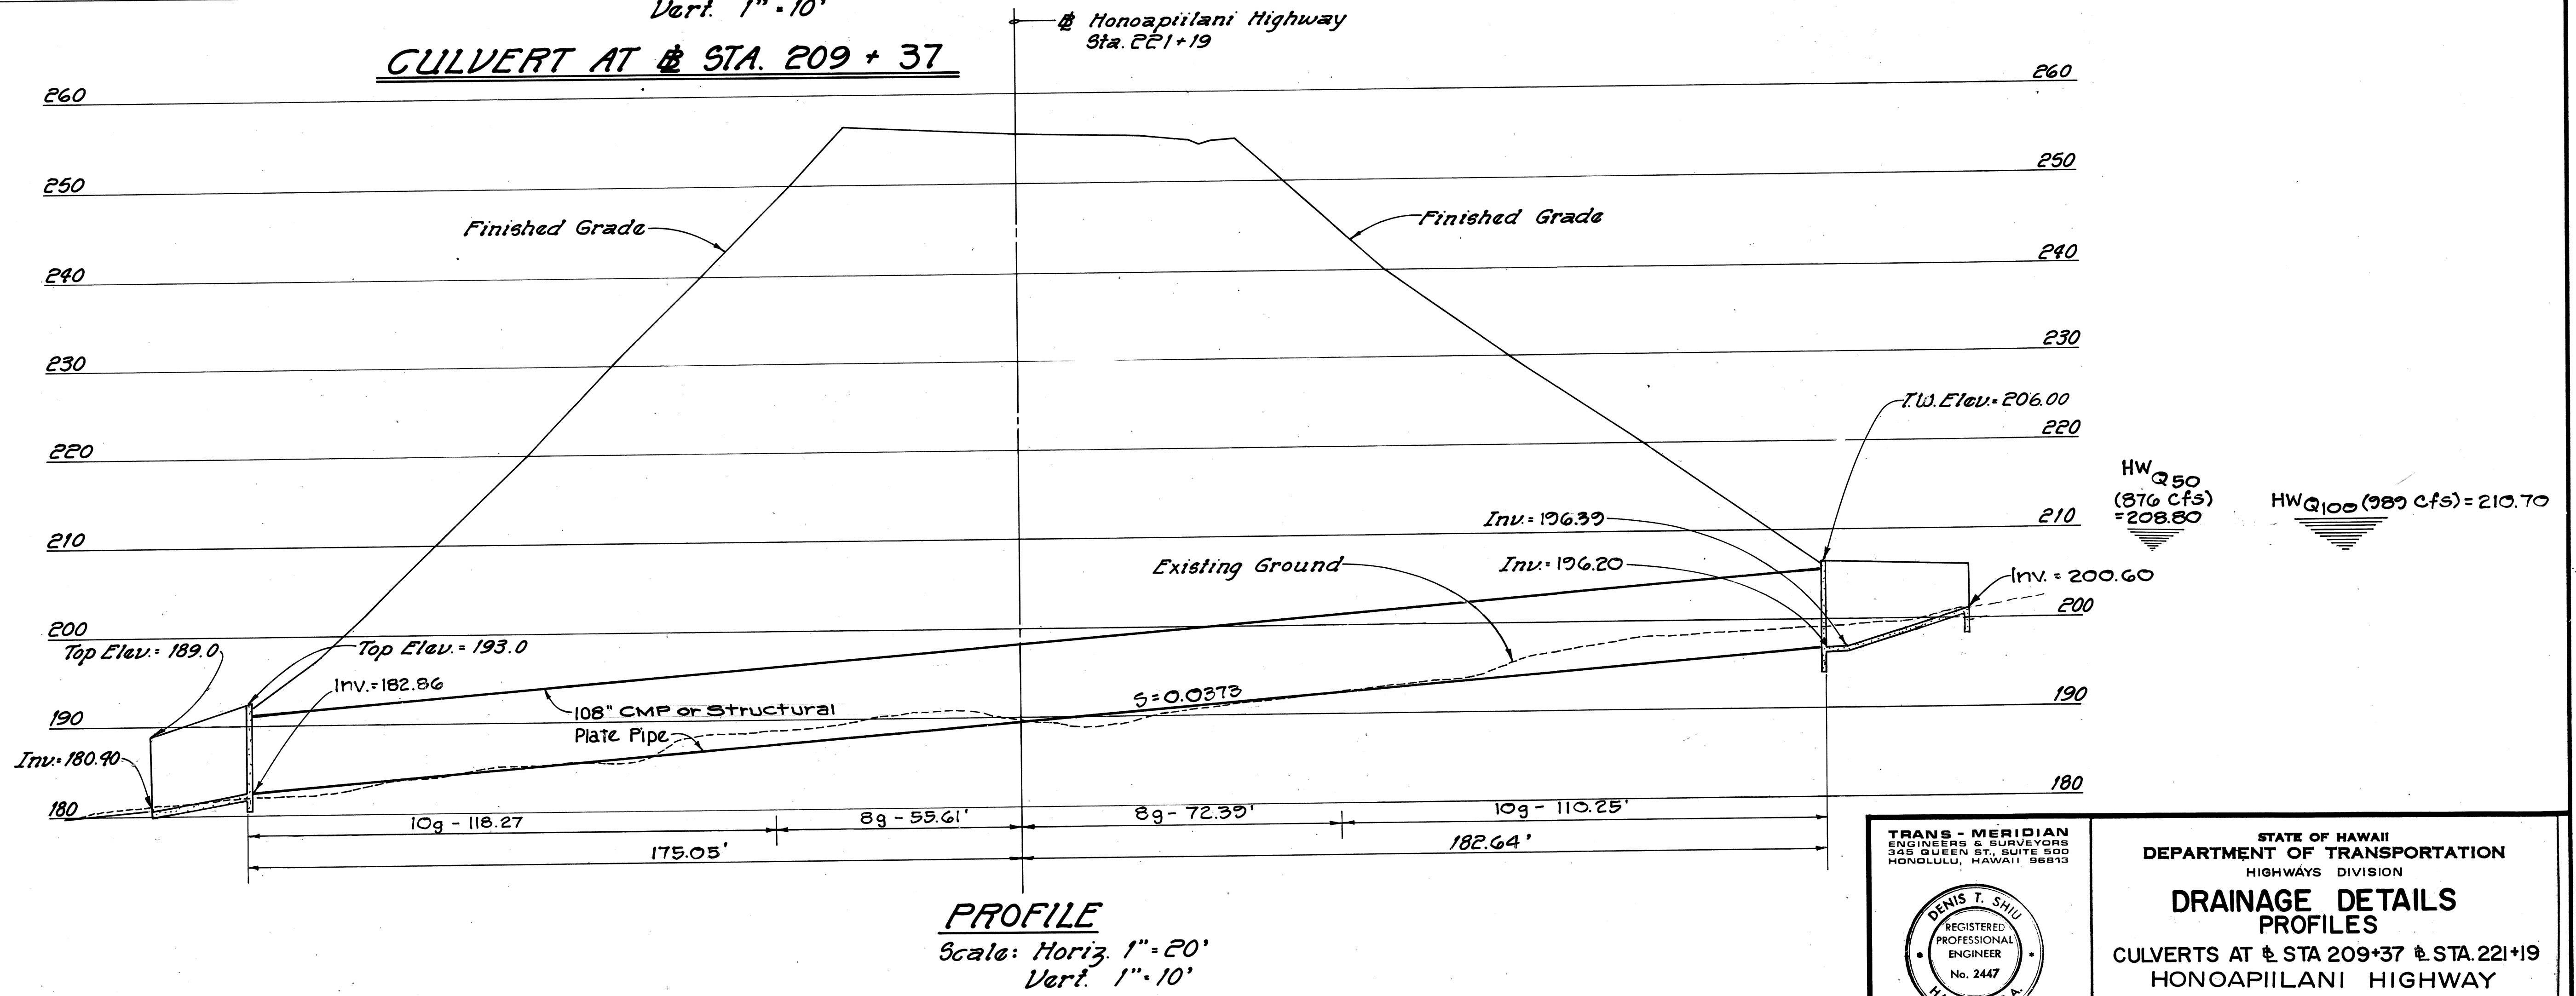

CULVERT AT STA. 221 + 19

TRANS - MERIDIAN
ENGINEERS & SURVEYORS
245 QUEEN ST., SUITE 500
HONOLULU, HAWAII 96813

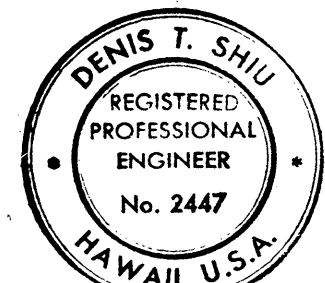

THIS WORK WAS PREPARED BY ME OR UNDER MY SUPERVISION
Denis T. Shiu

STATE OF HAWAII
DEPARTMENT OF TRANSPORTATION
HIGHWAYS DIVISION

DRAINAGE DETAILS PROFILES

CULVERTS AT STA 209+37 & STA. 221+19
HONOAPIILANI HIGHWAY

ALAELOA TO PINEAPPLE HILL



F.A. PROJECT NO. F-030-1(8)

SCALE: AS SHOWN DATE SEP 1981



SHEET No. 7 OF 16 SHEETS

DATE	
SURVEY PLOTTED BY	
DRAWN BY	
DESIGNED BY	
CHECKED BY	
NOTE BOOK	
No.	


FED. ROAD DIST. NO.	STATE	FED. AID PROJ. NO.	FISCAL YEAR	SHEET NO.	TOTAL SHEETS
HAWAII	HAW.	F-030-1(8)	1981	44	92

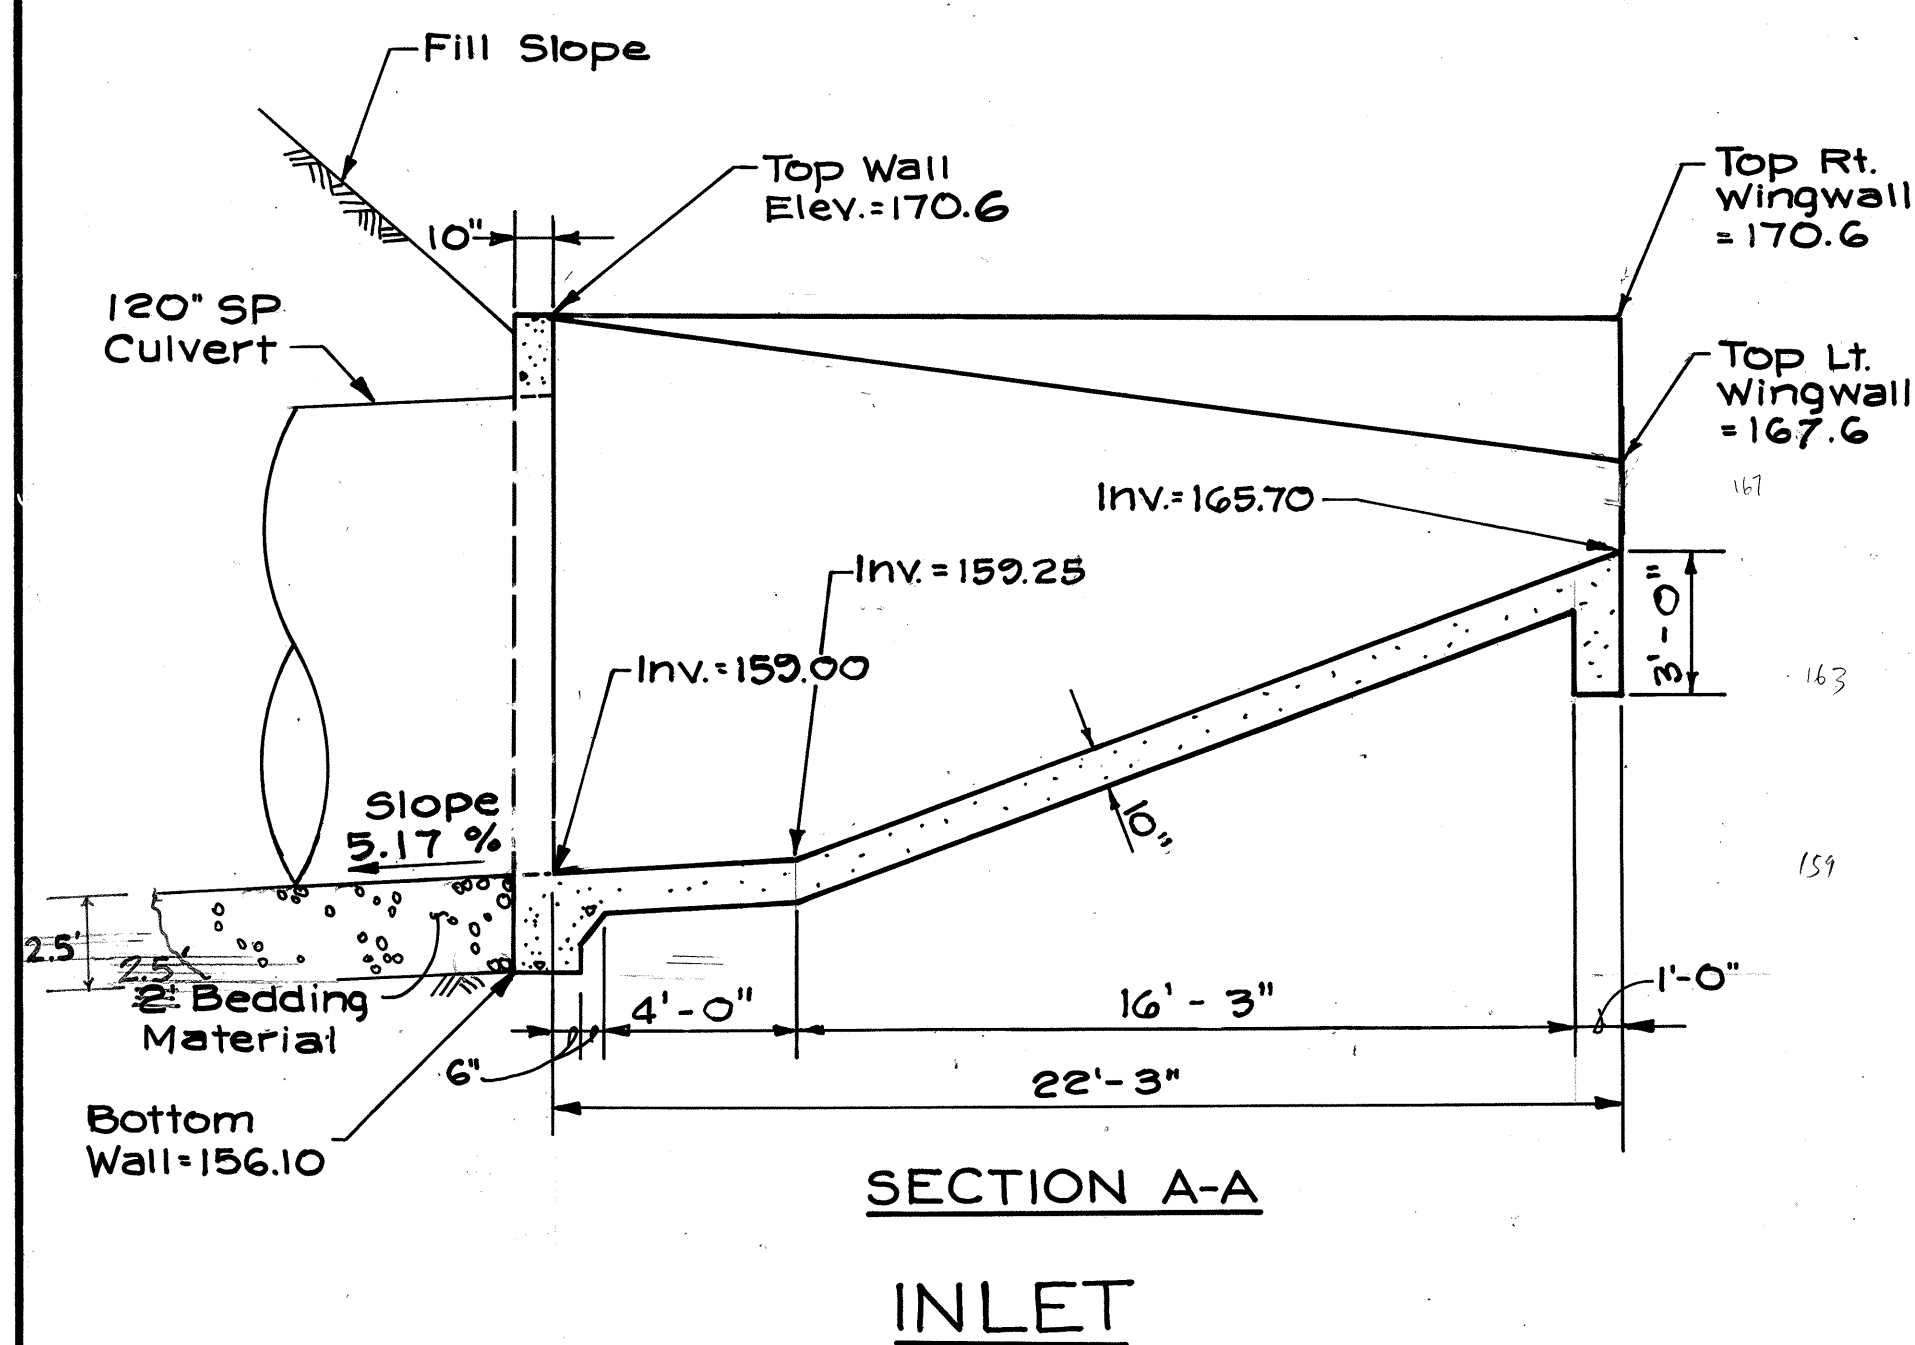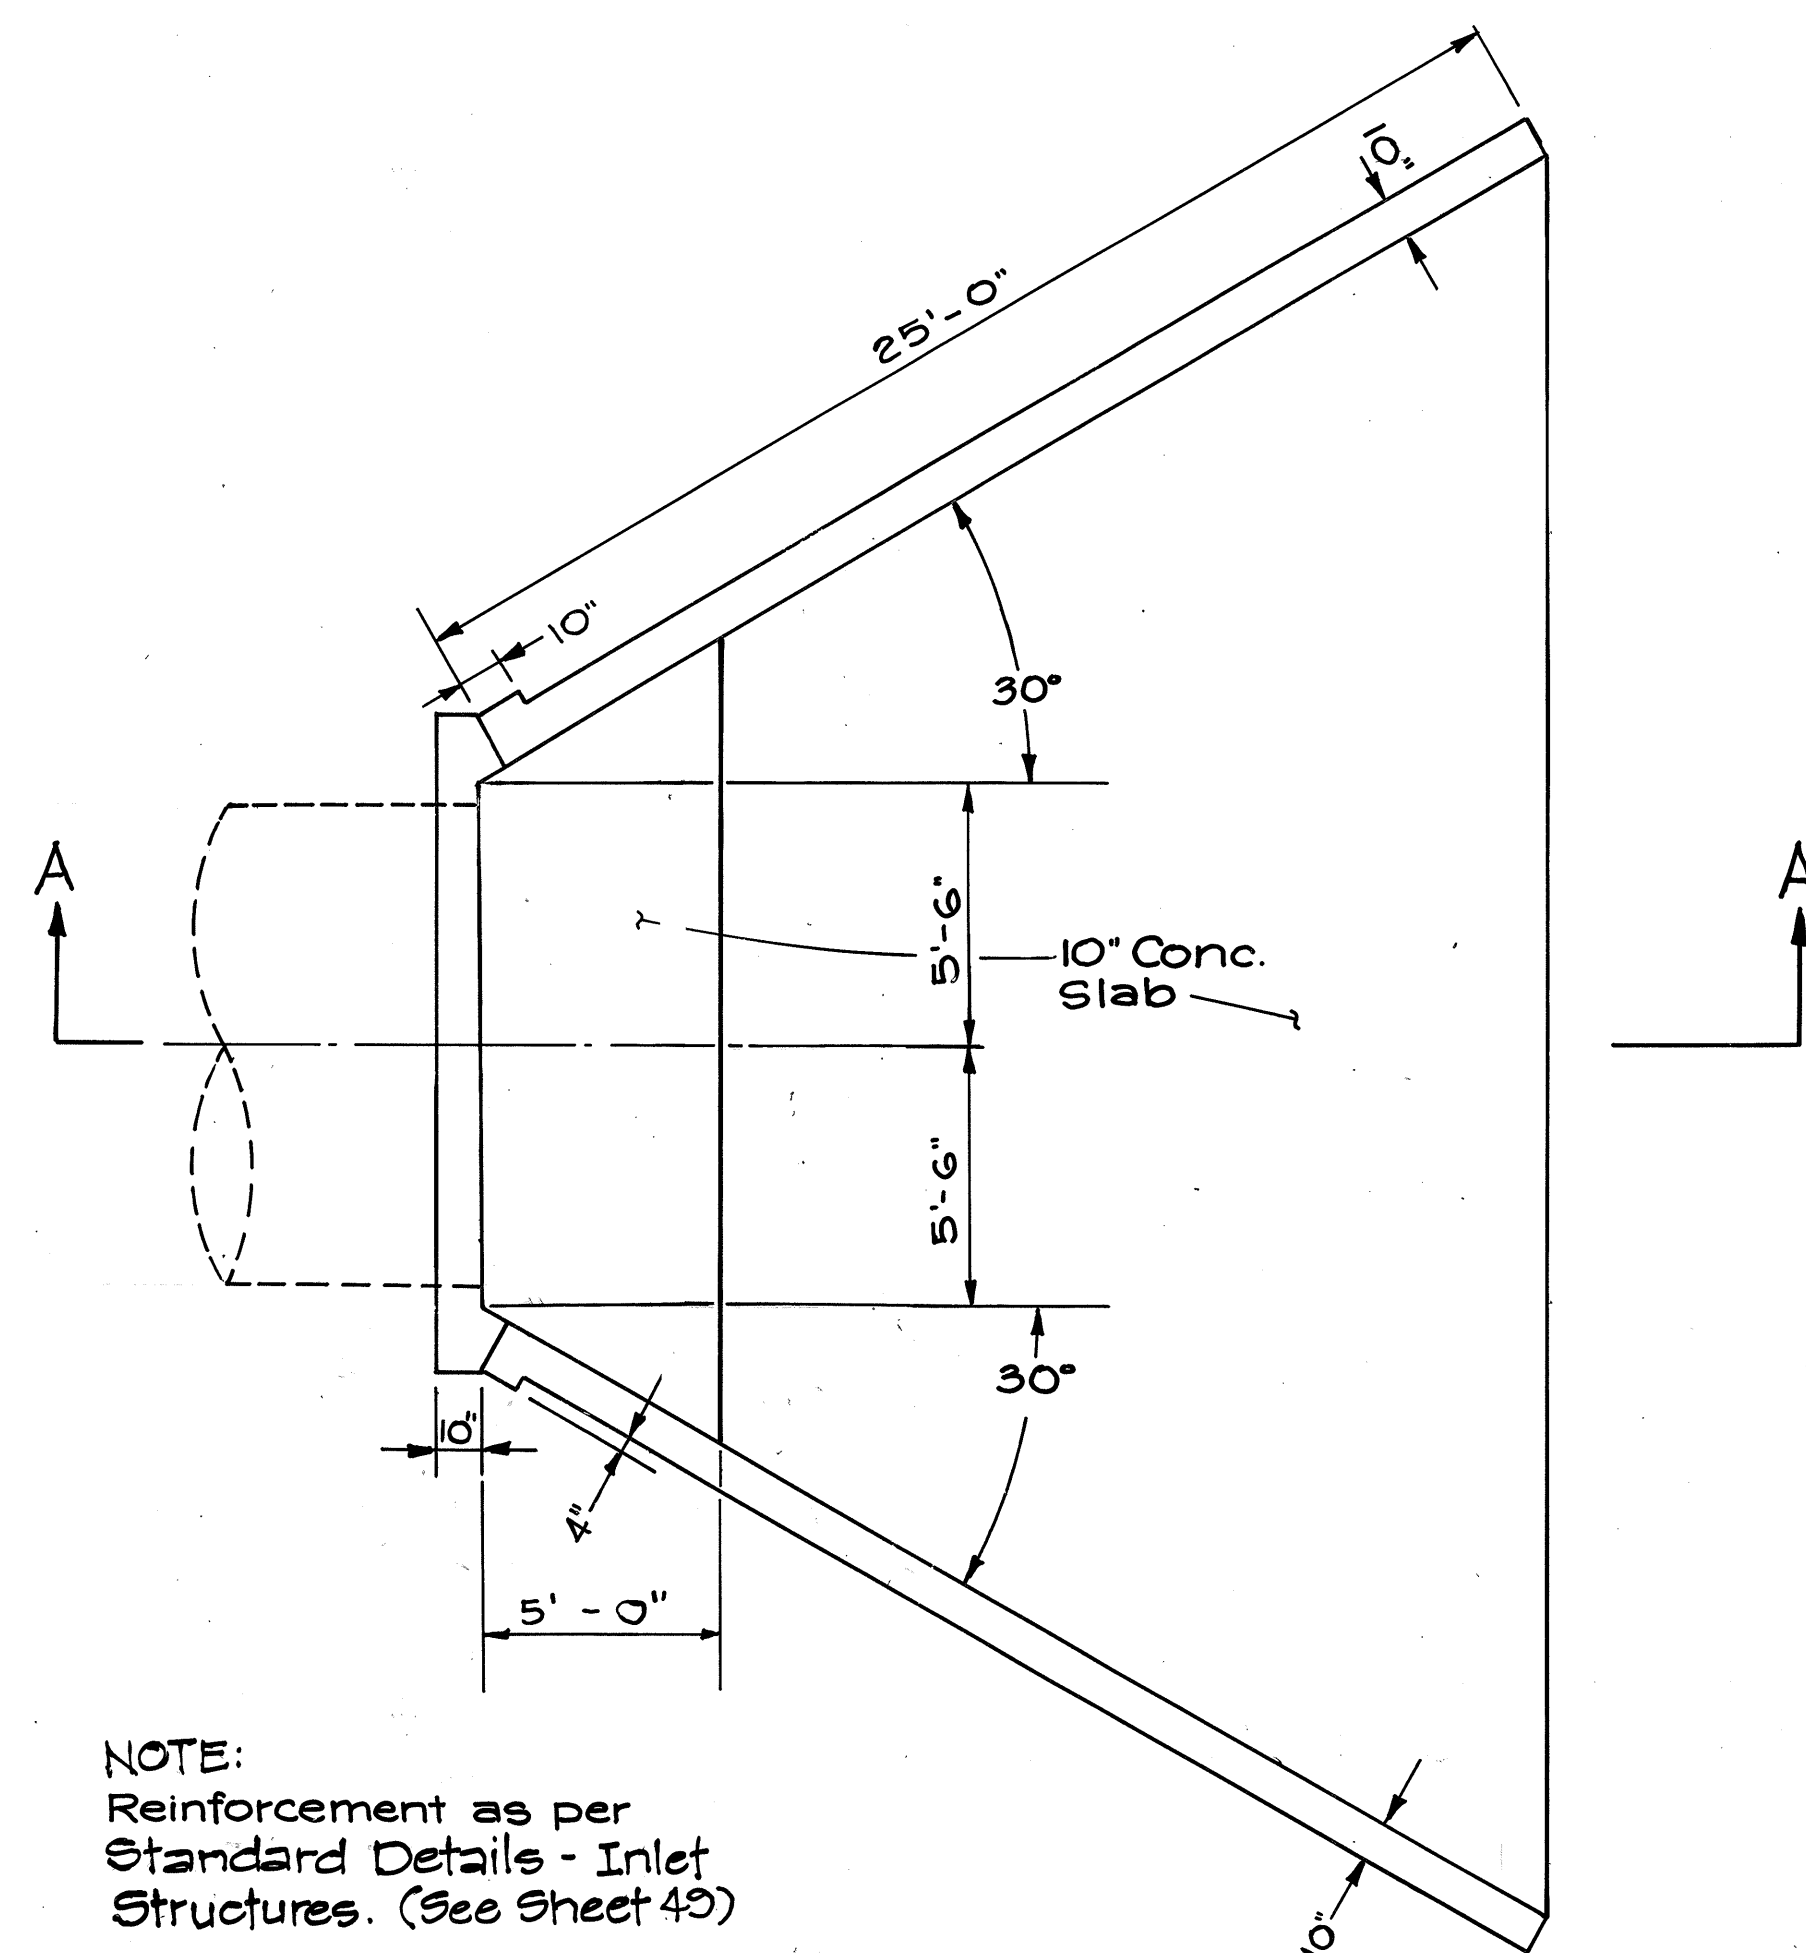

CULVERT AT STA. 209 + 37
NOT TO SCALE

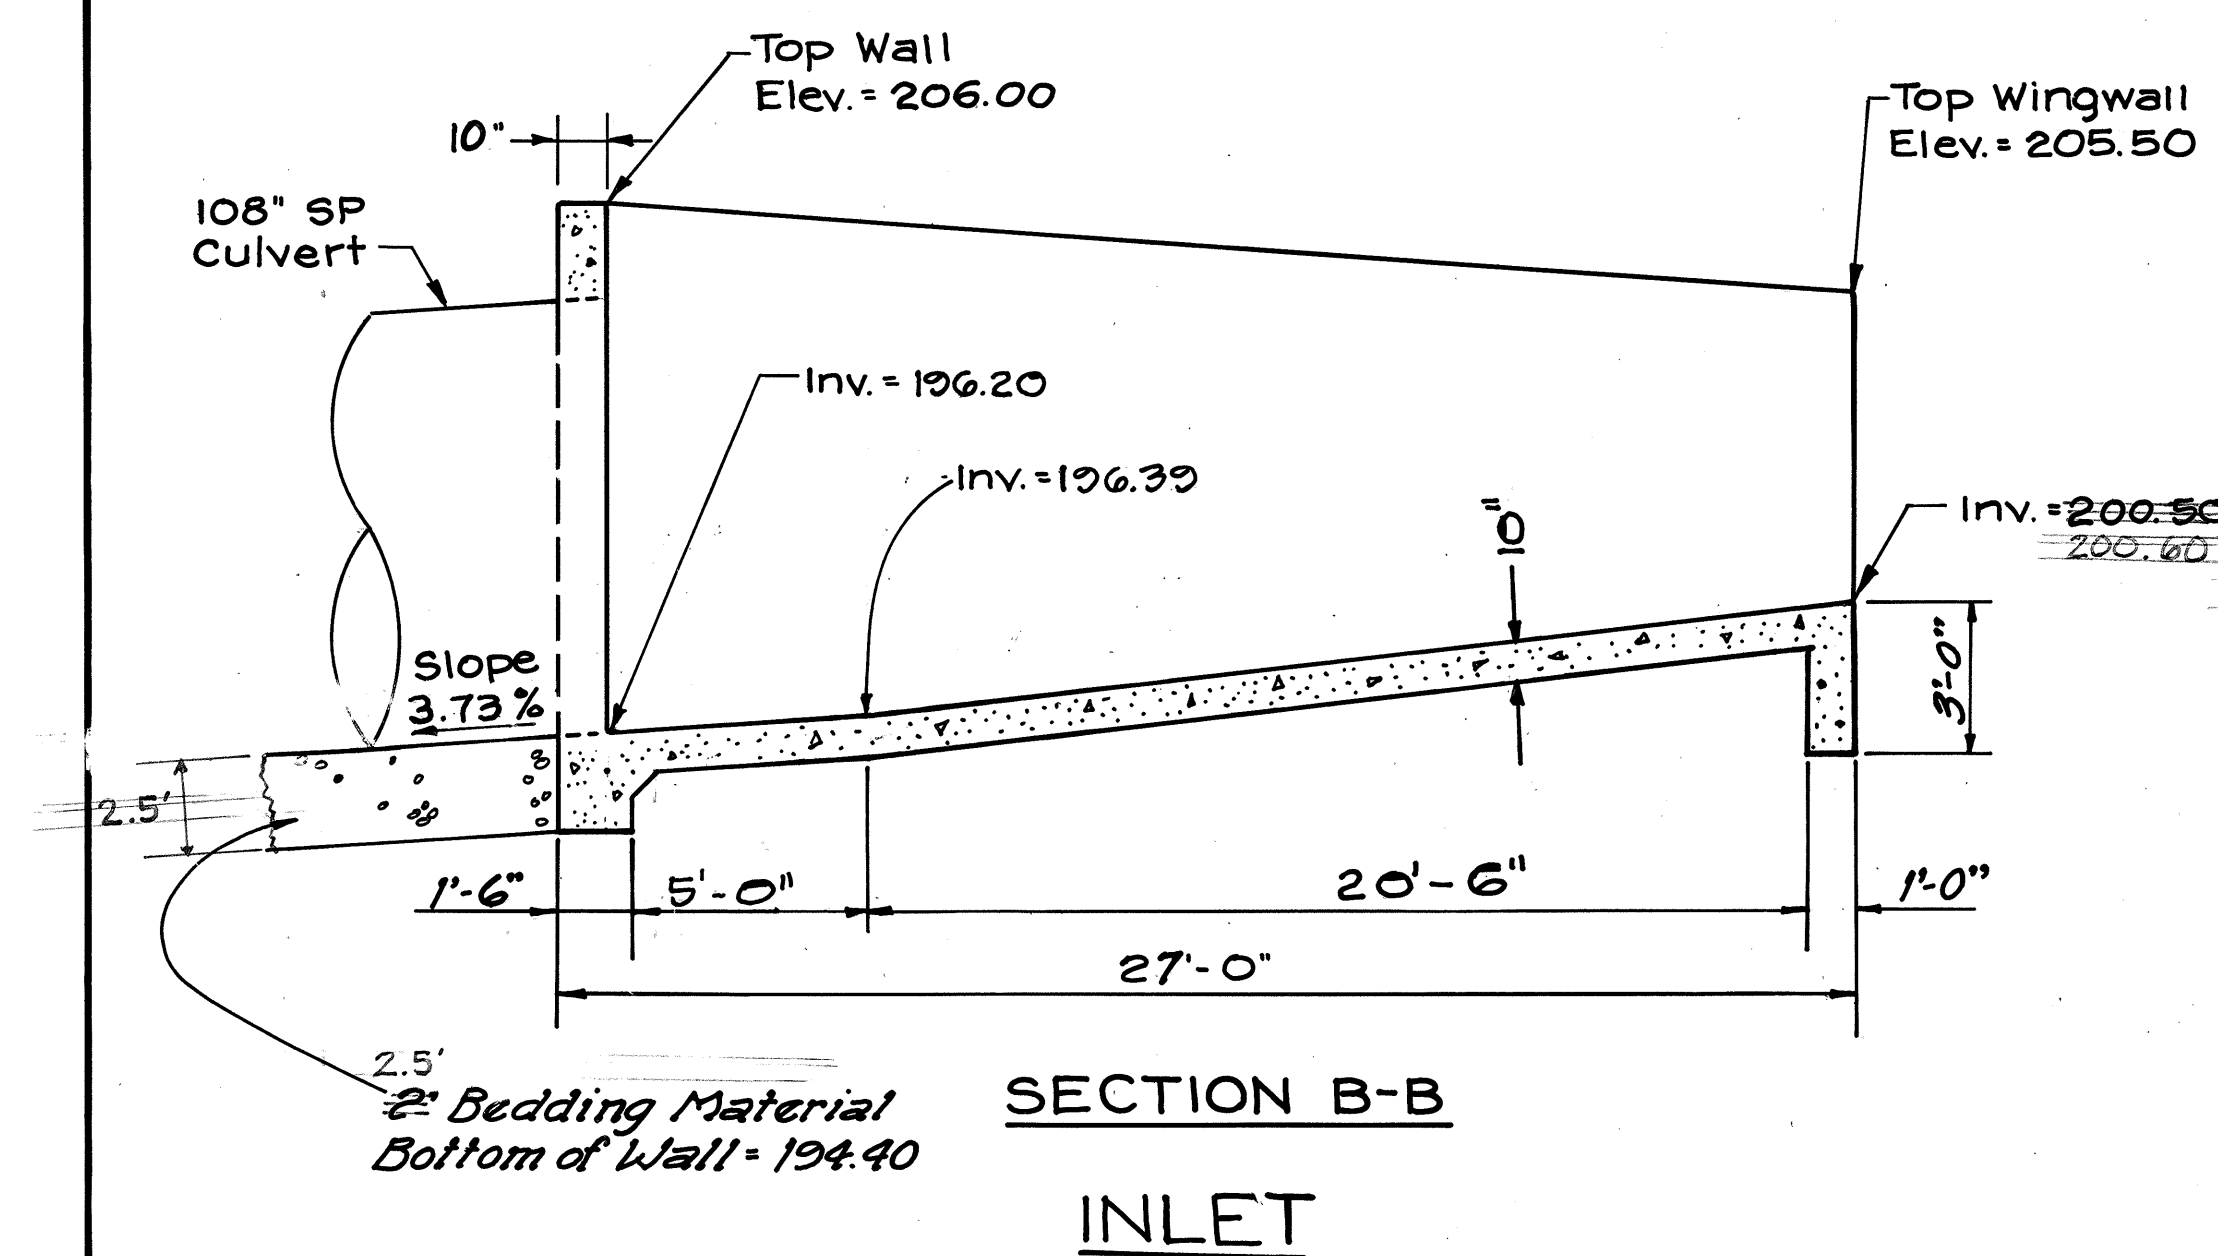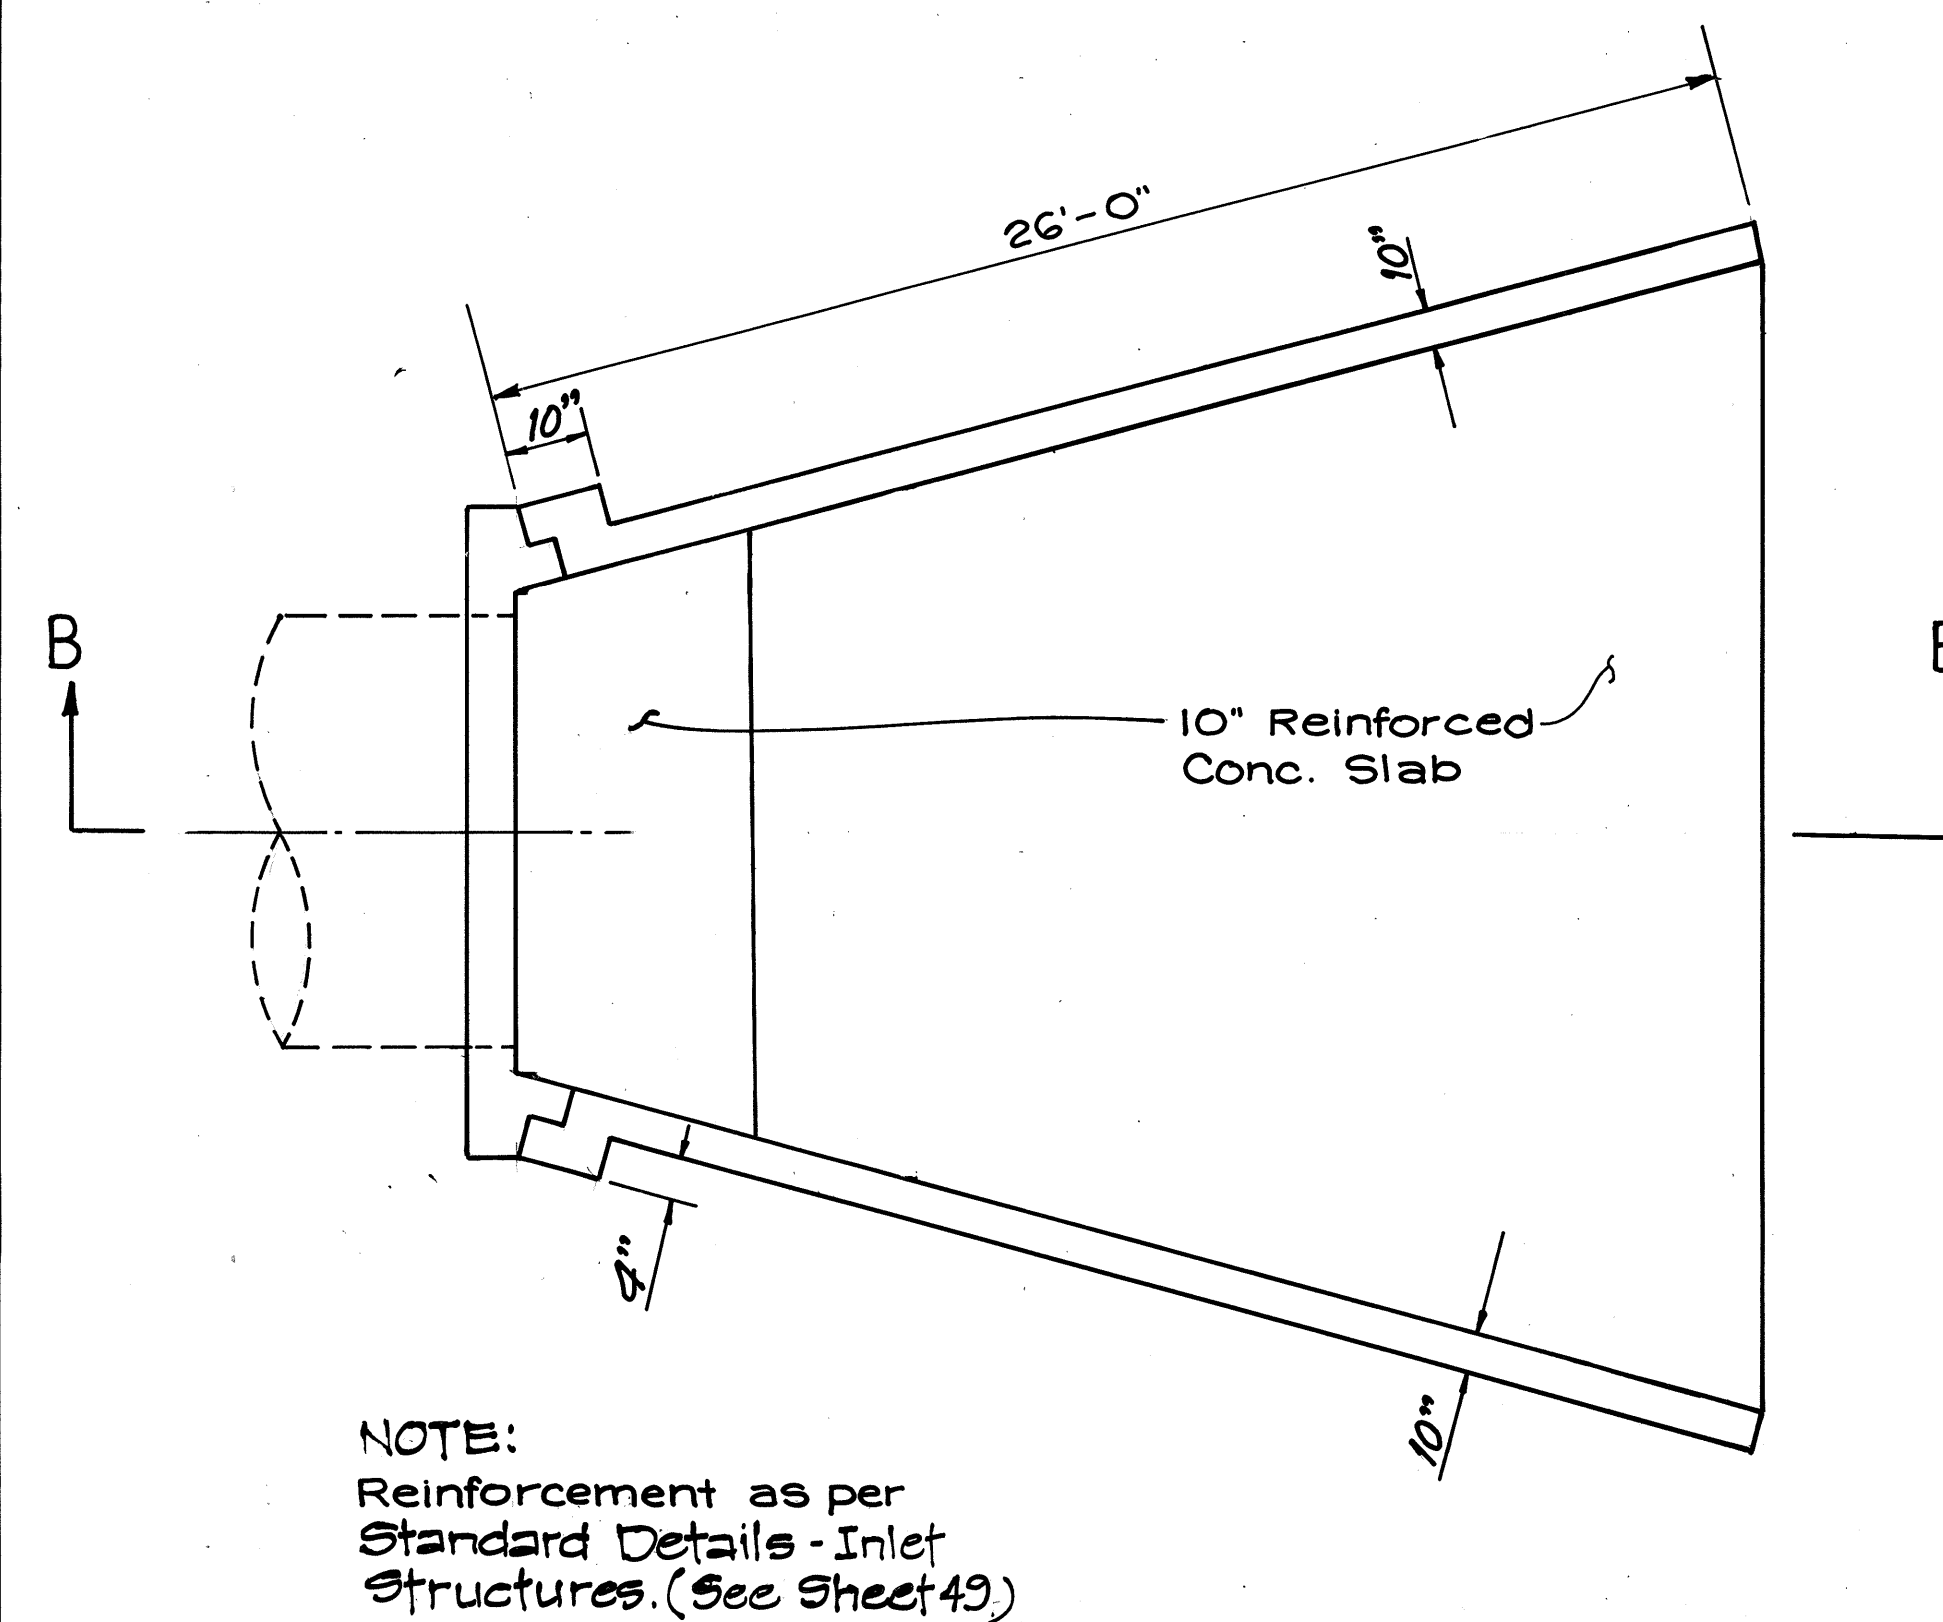


CULVERT AT STA. 221+19
NOT TO SCALE

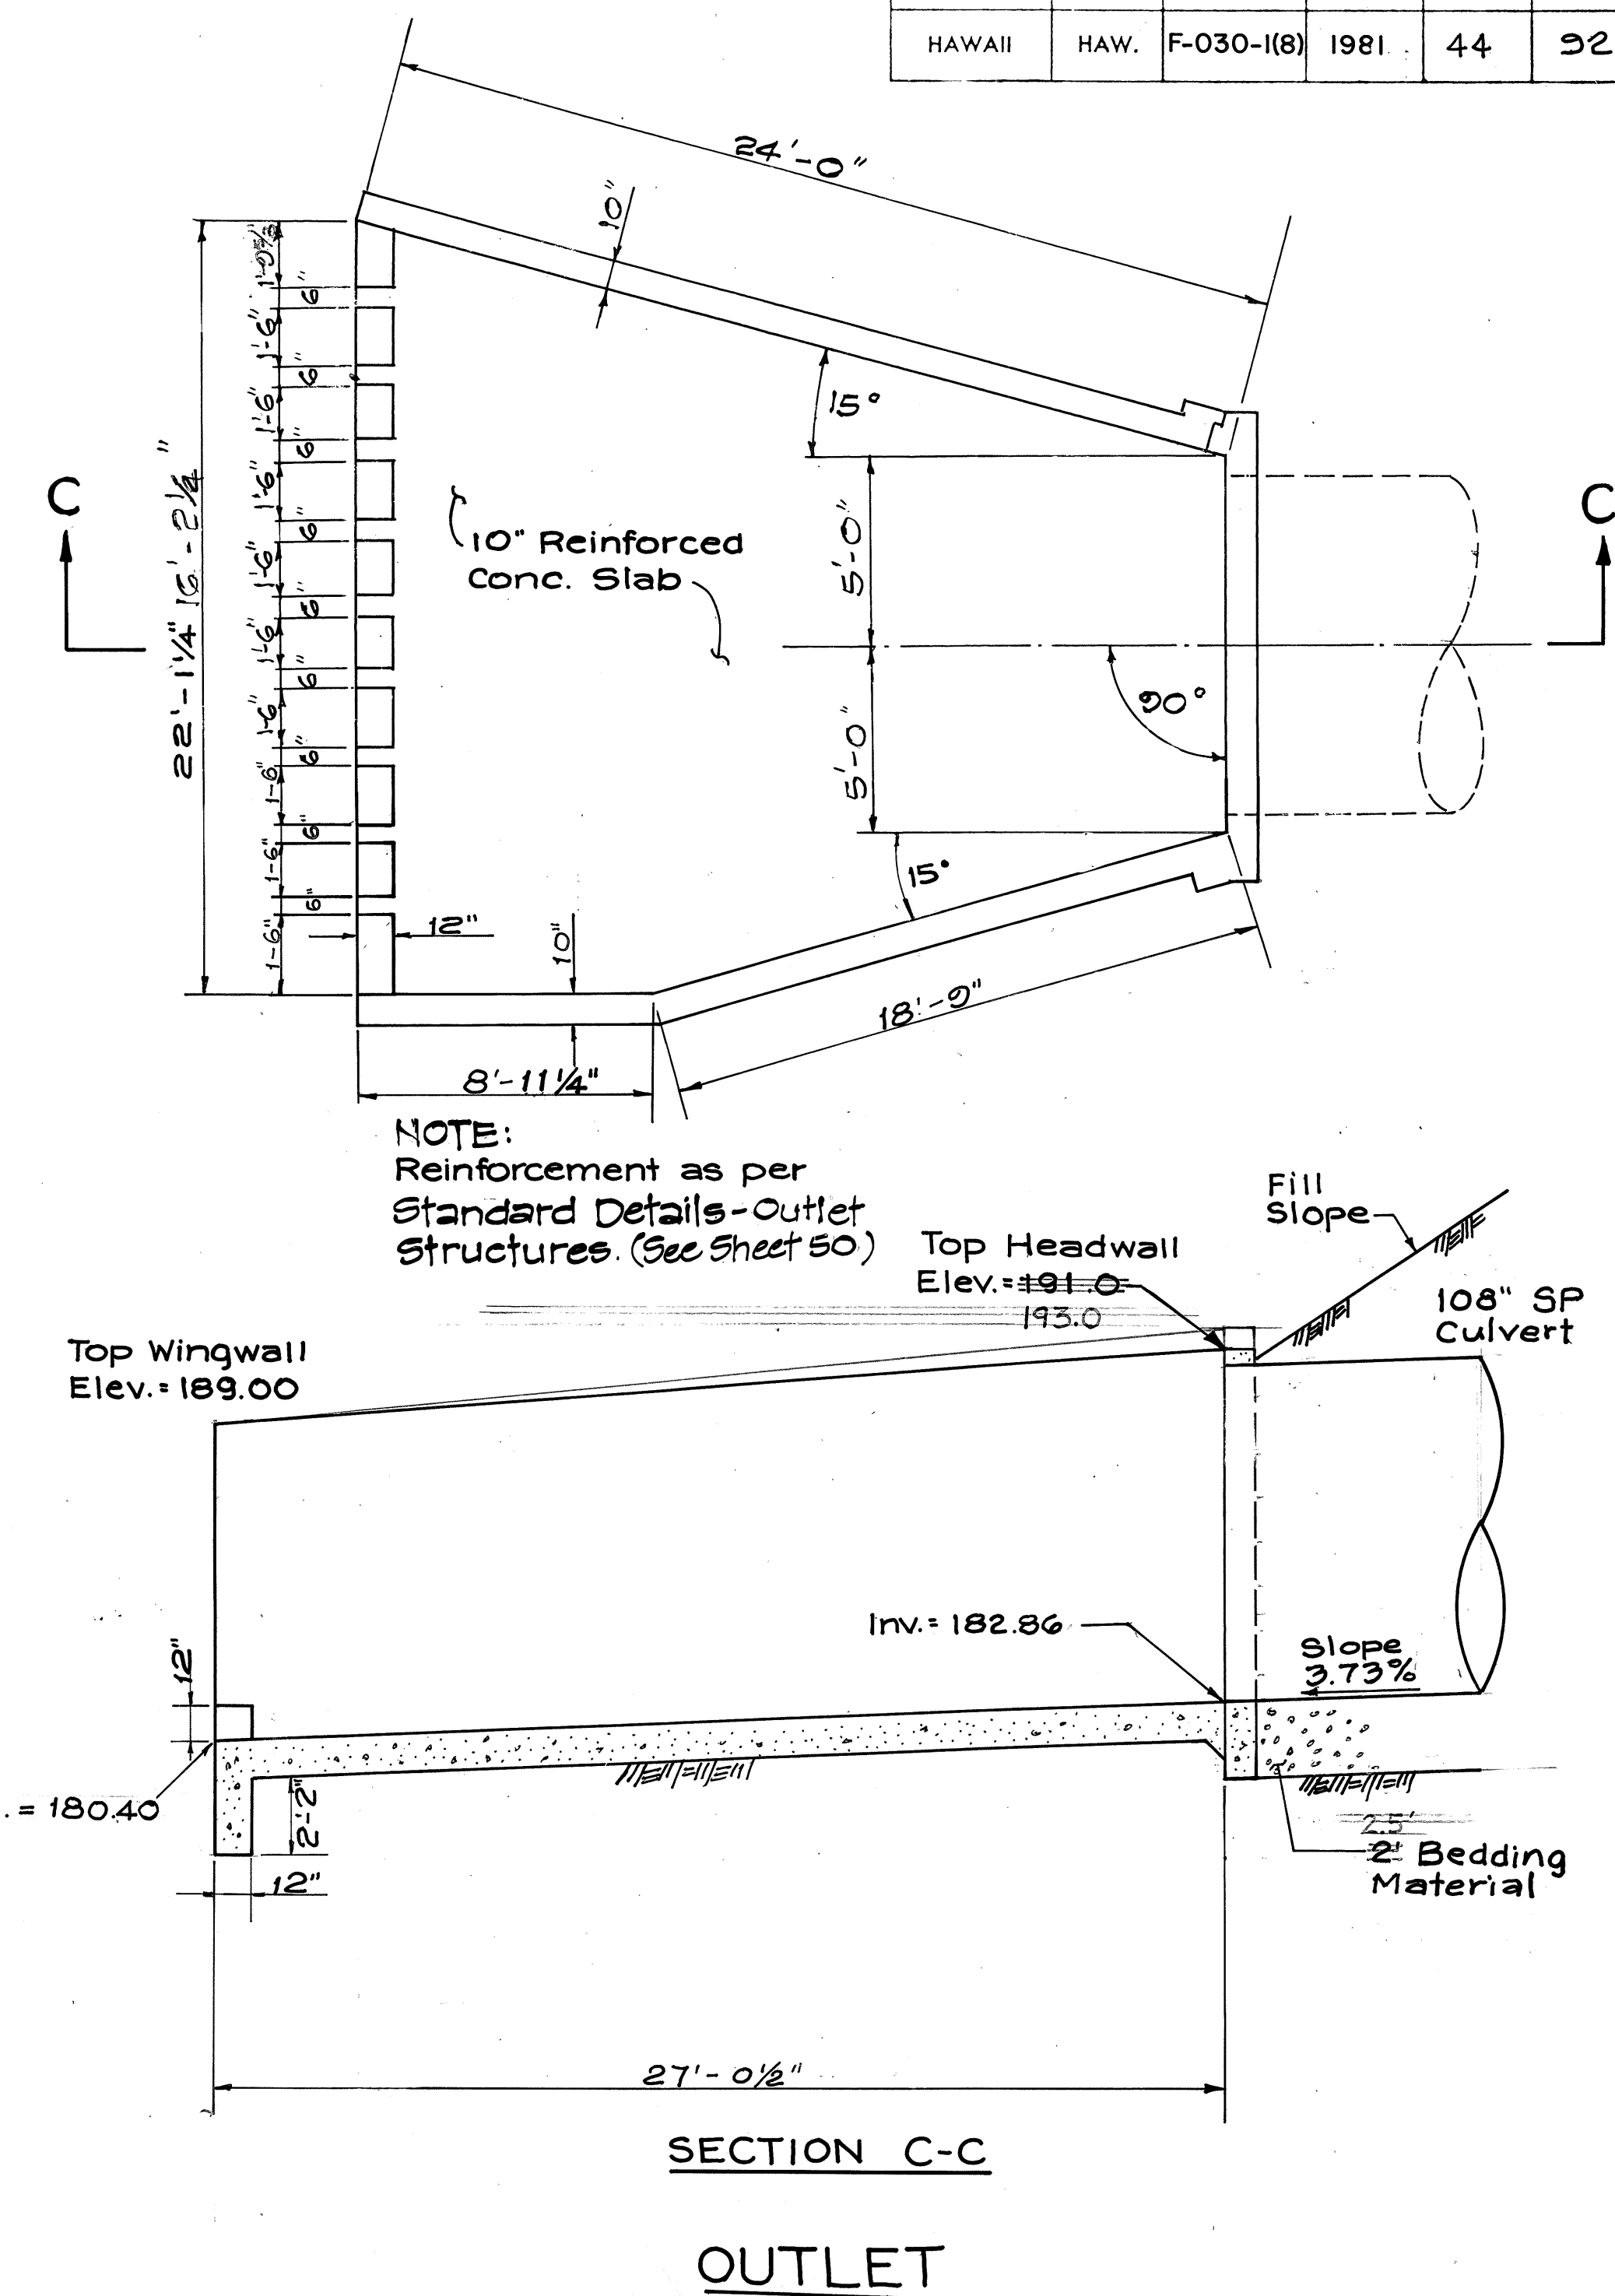

ORIGINAL PLAN	SURVEY PLOTTED BY _____ DATE _____
NOTE BOOK	DRAWN BY _____
	TRACED BY _____
	DESIGNED BY _____
	QUANTITIES BY _____
No. _____	CHECKED BY _____

TRANS - MERIDIAN
ENGINEERS & SURVEYORS
345 QUEEN ST., SUITE 500
HONOLULU, HAWAII 96813

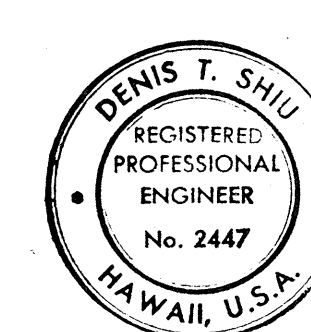




THIS WORK WAS PREPARED BY ME OR UNDER MY SUPERVISION.

Genis I. Shinn

STATE OF HAWAII
DEPARTMENT OF TRANSPORTATION
HIGHWAYS DIVISION





DRAINAGE DETAILS
CULVERT AT & STA. 209+37
CULVERT AT & STA. 221 + 19
HONOAPIILANT HIGHWAY
ALAELOA TO PINEAPPLE HILL
F.A. PROJECT NO. F-030-1 (8)
SCALE: AS SHOWN DATE Mar 1982
SHEET No. 8 OF 16 SHEETS

FED. ROAD DIST. NO.	STATE	FED. AID PROJ. NO.	FISCAL YEAR	SHEET NO.	TOTAL SHEETS
HAWAII	HAW.	F-030-1(8)	1981	45	92

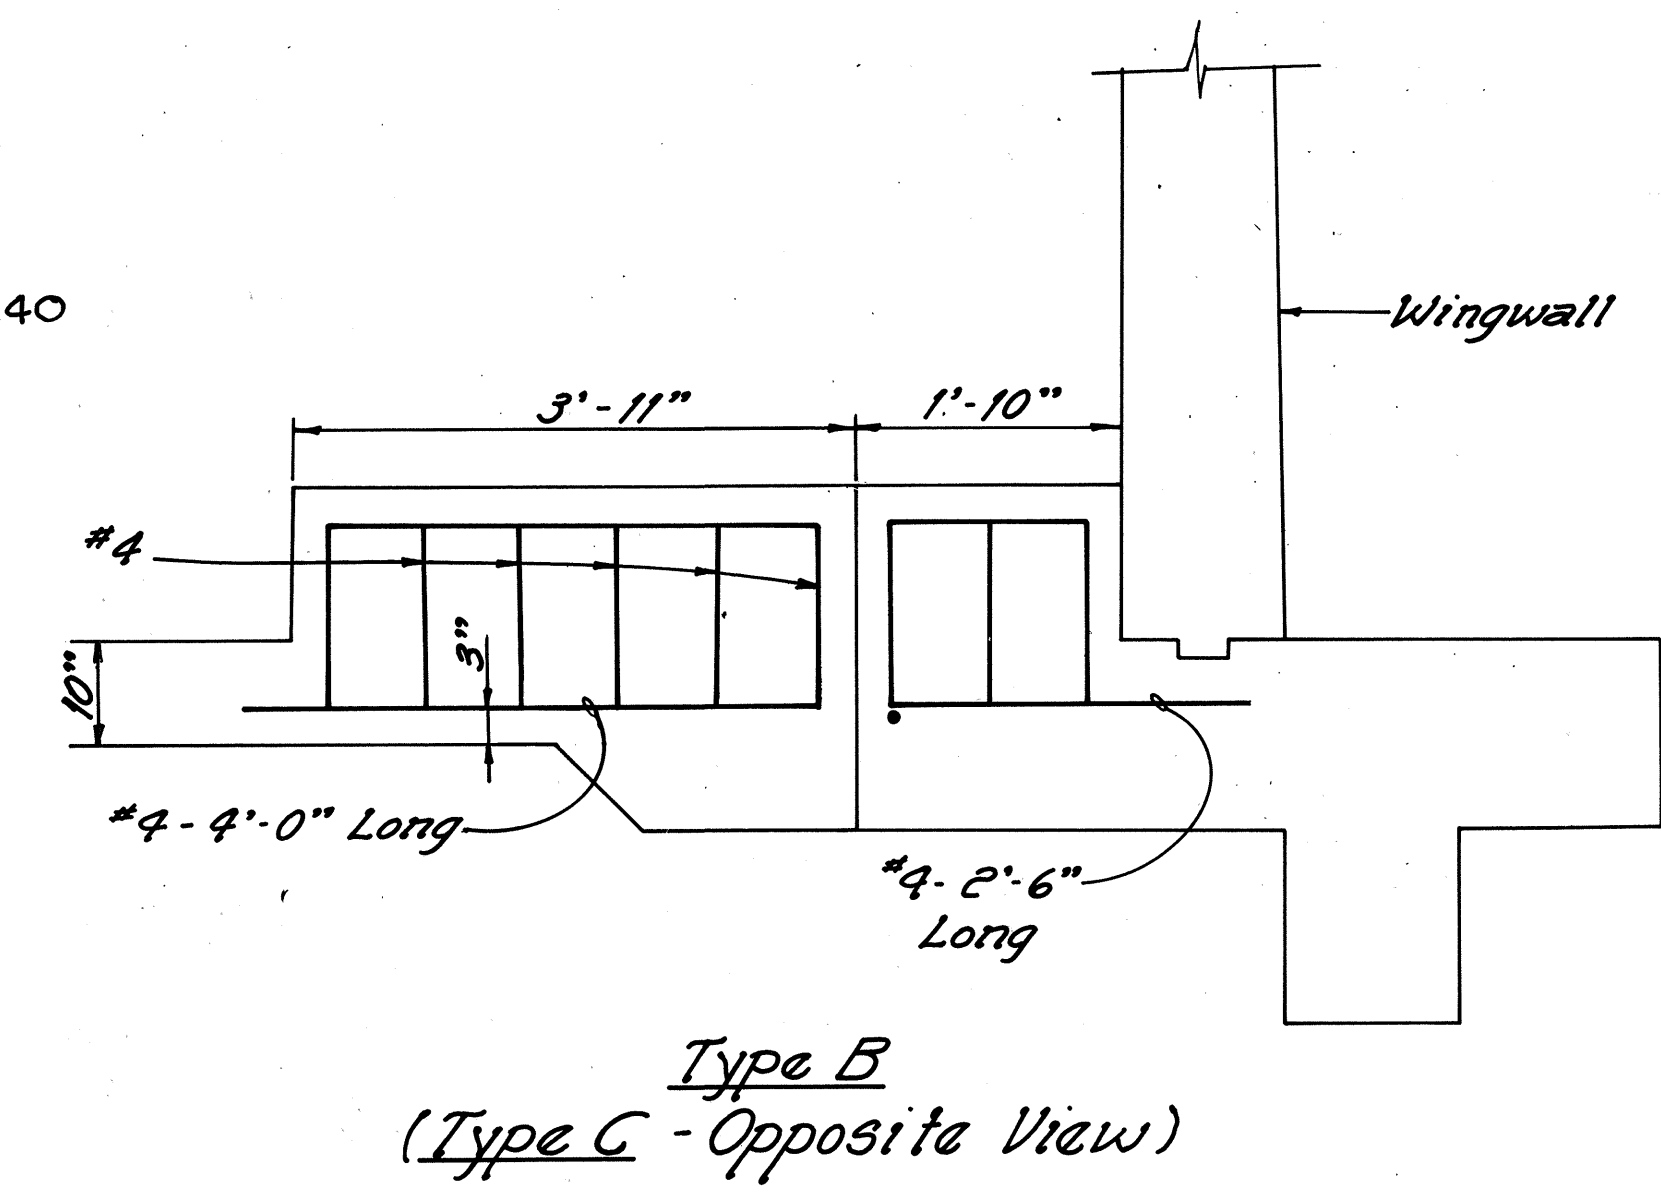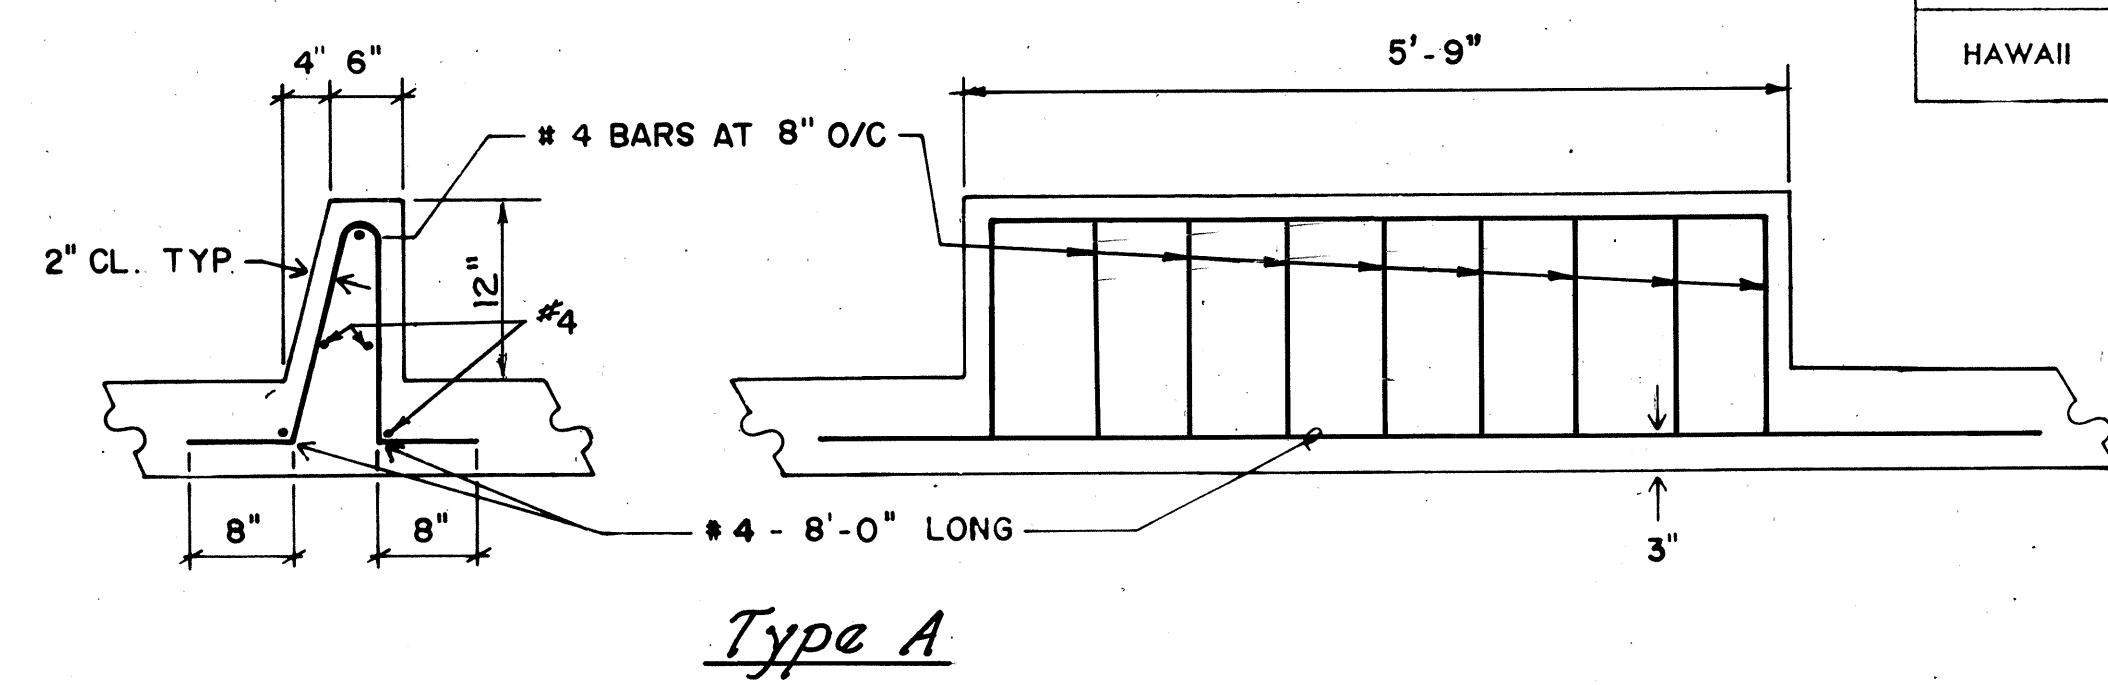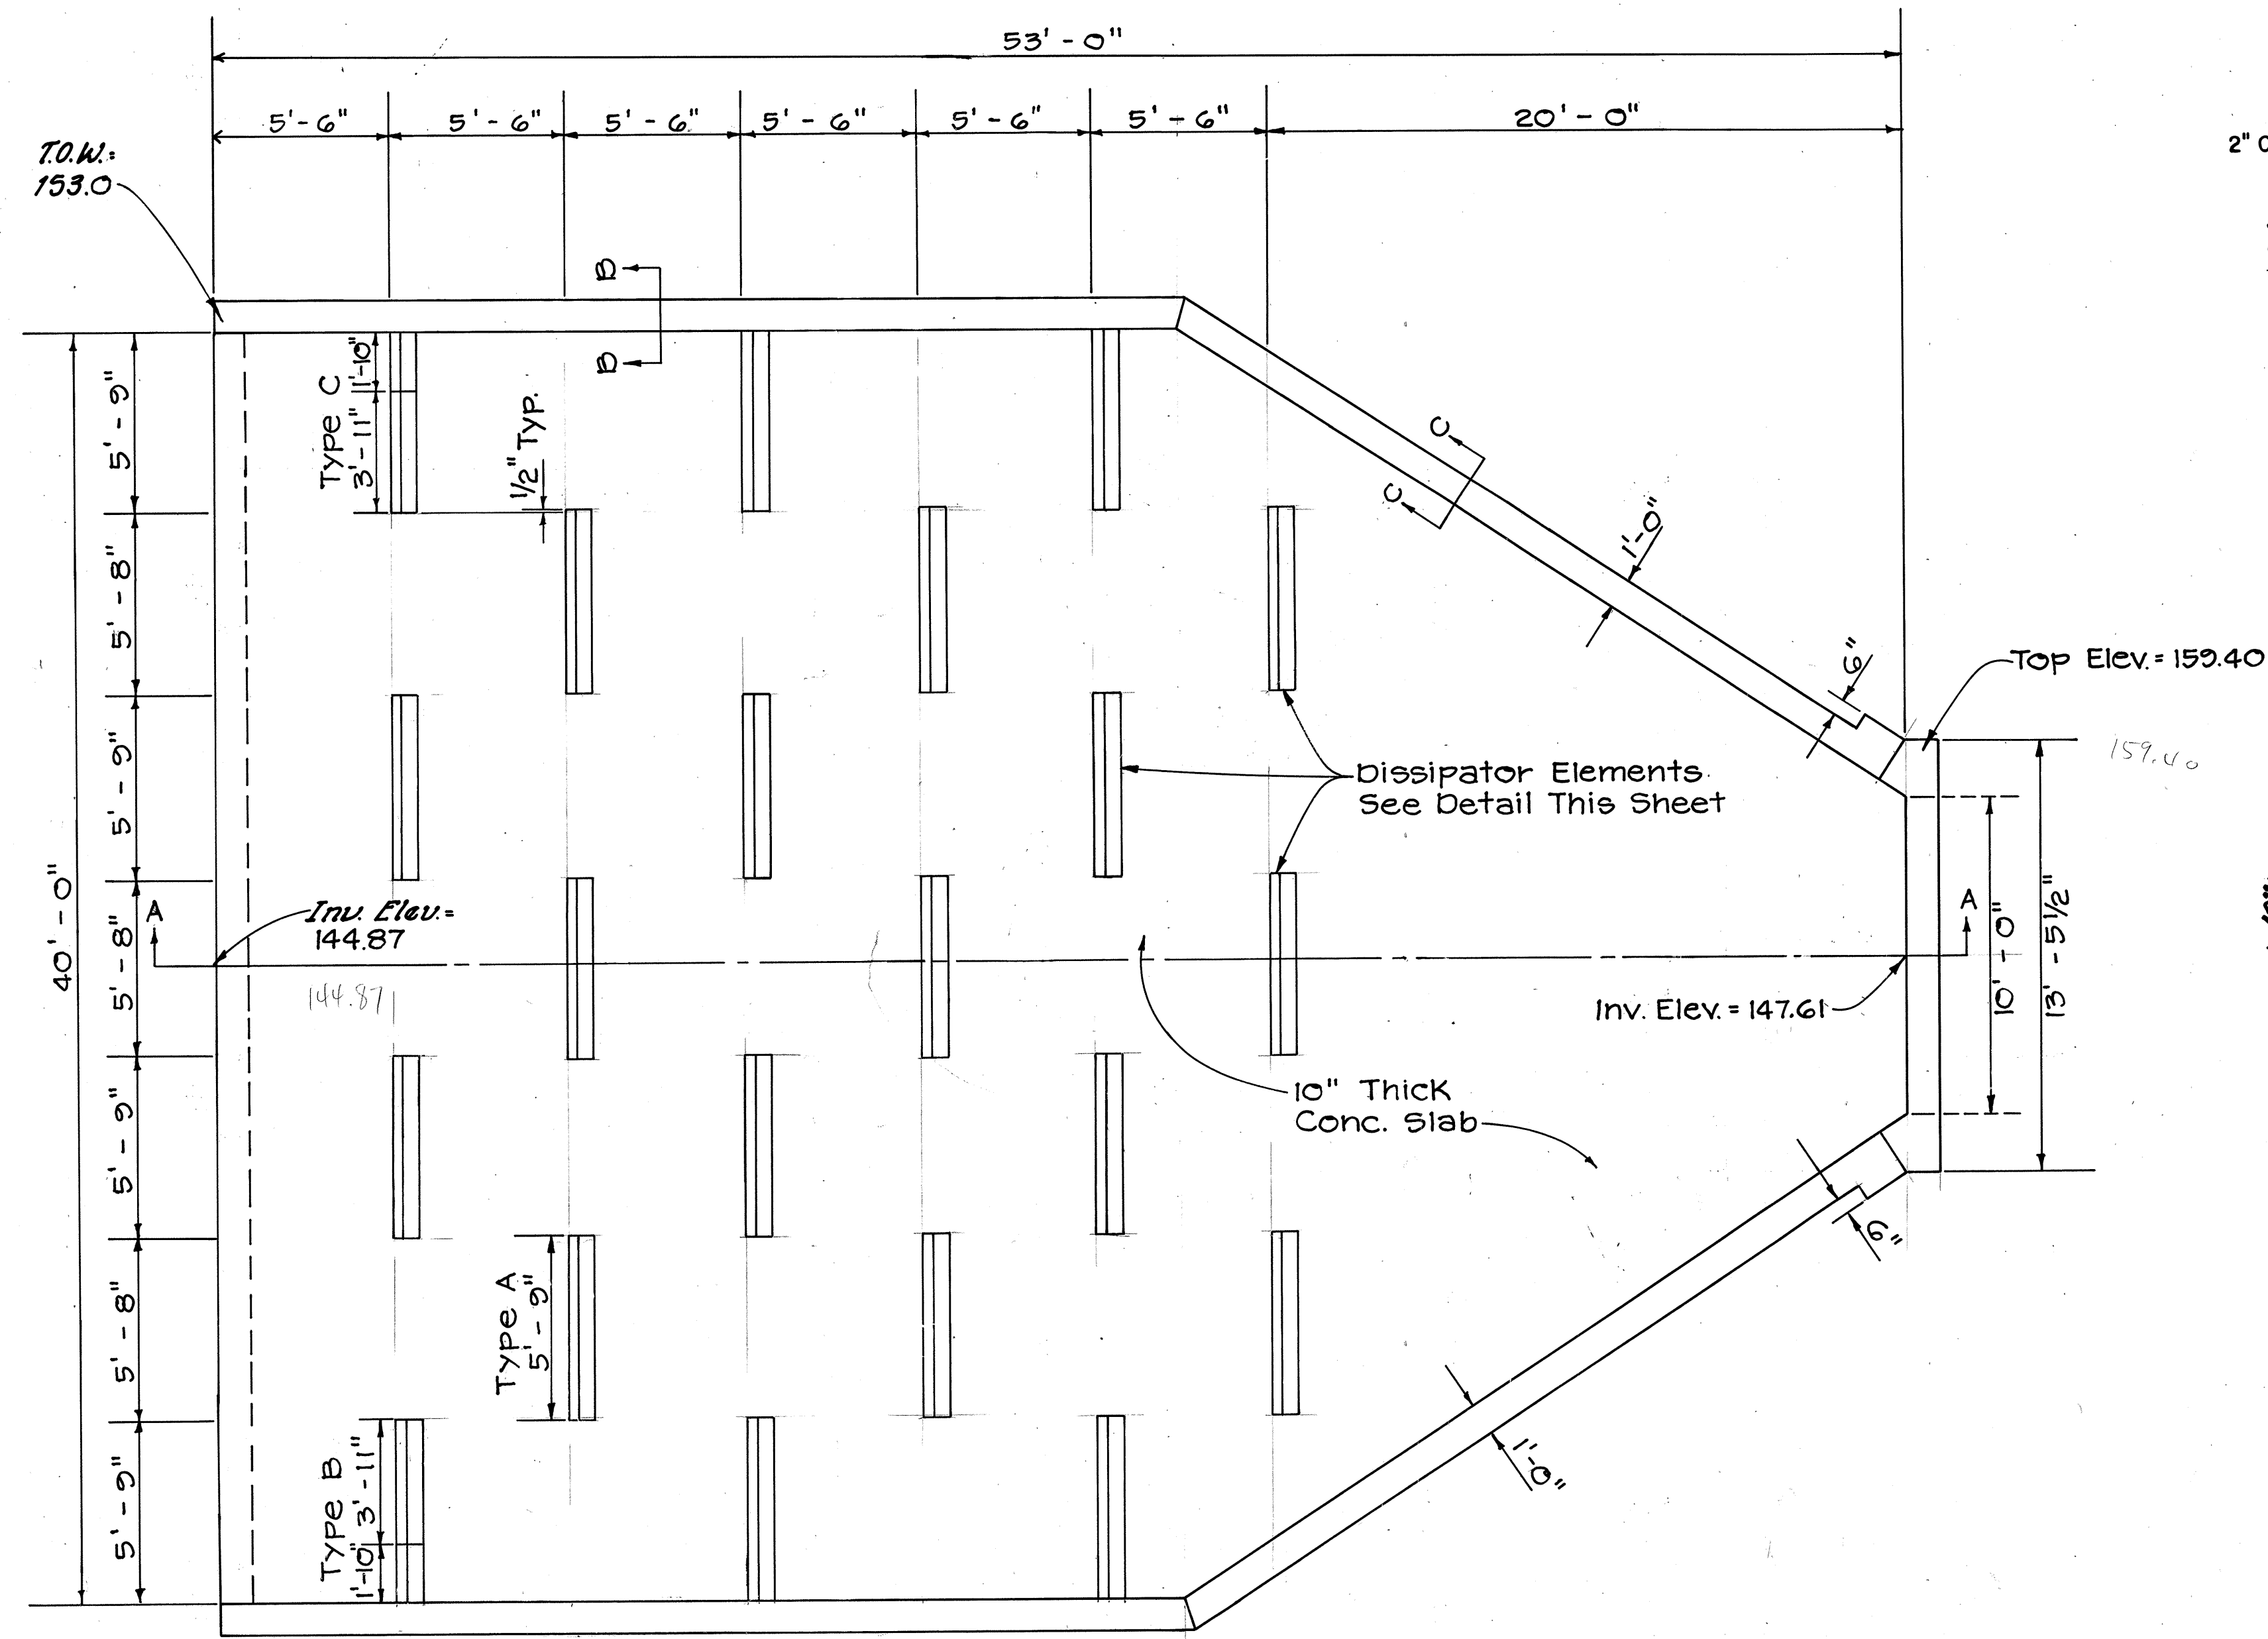

DISSIPATOR ELEMENTS
Scale: 3/4" = 1'-0"

PLAN
Scale: 1/4" = 1'-0"

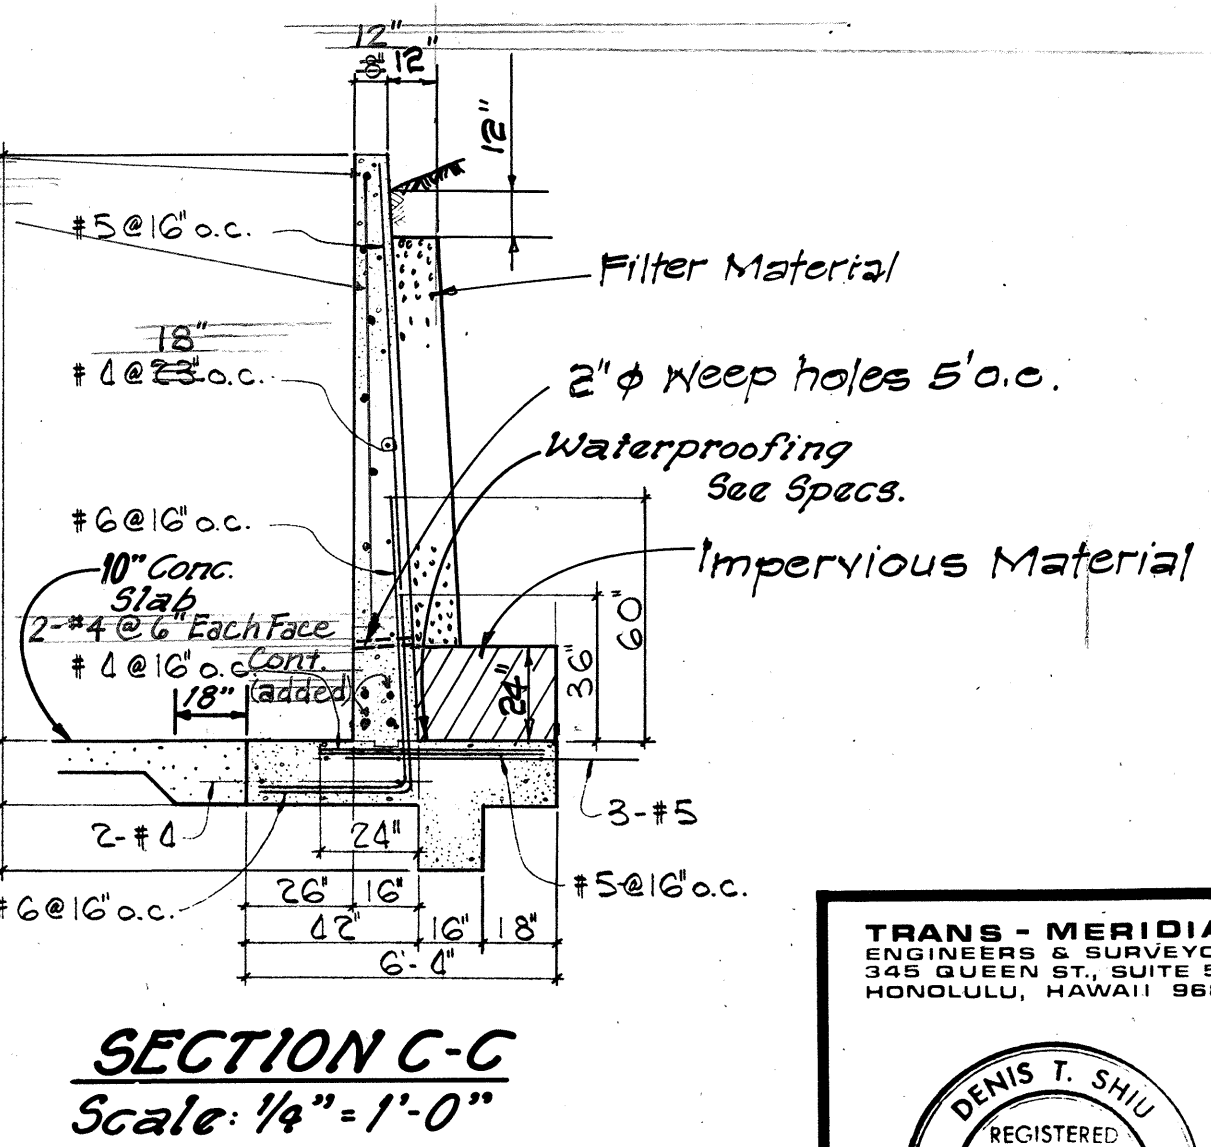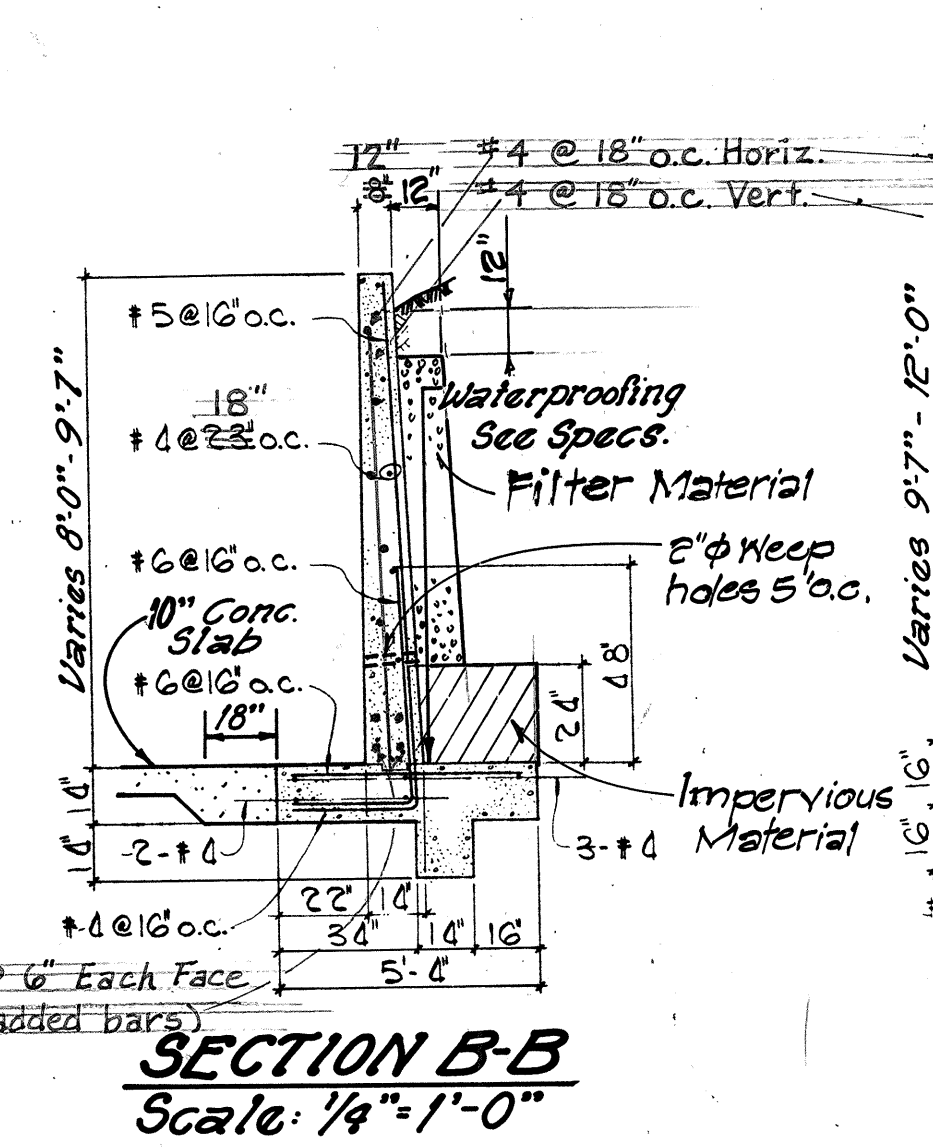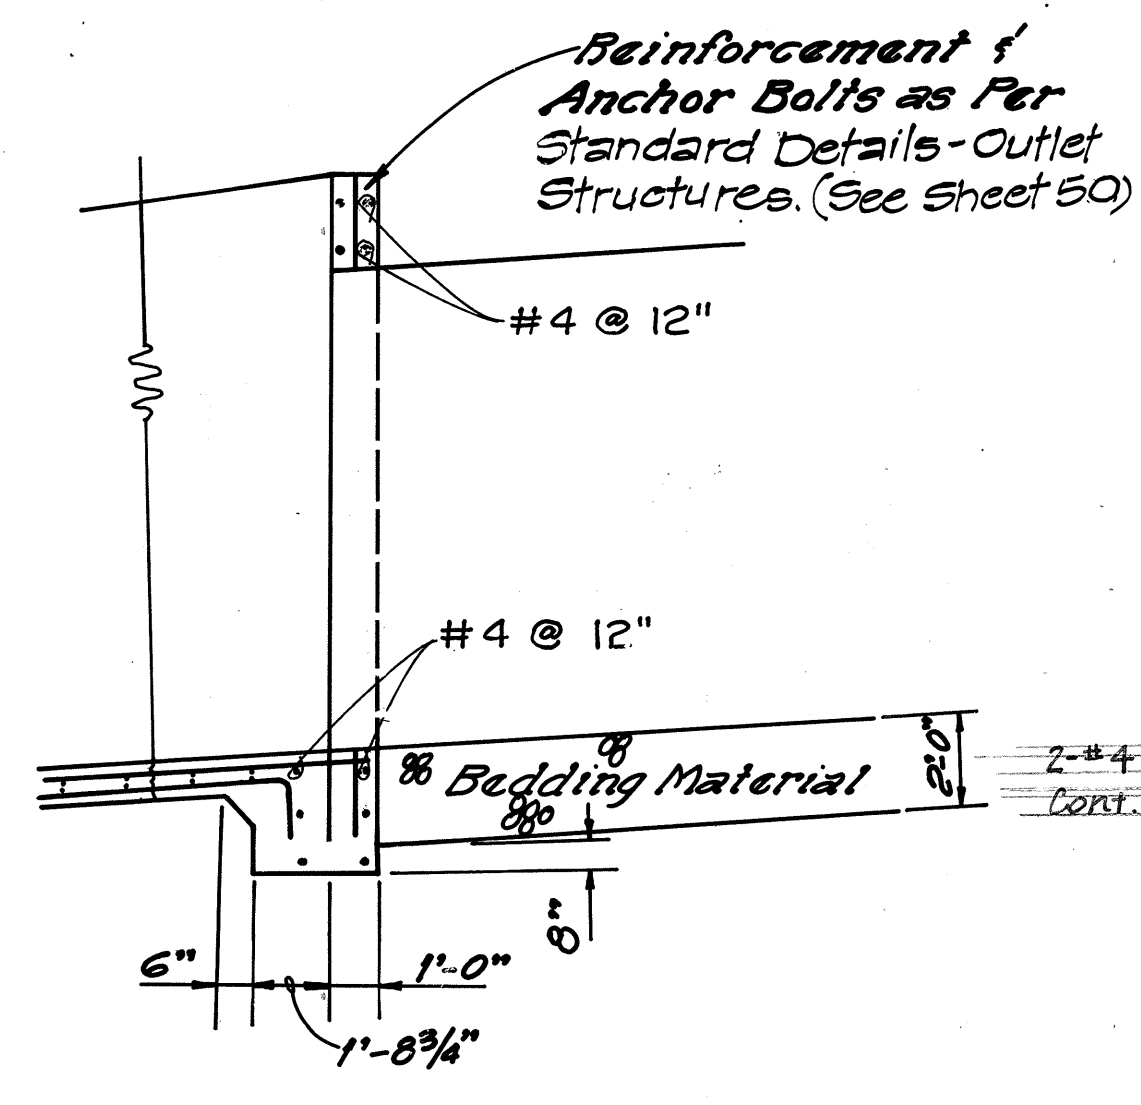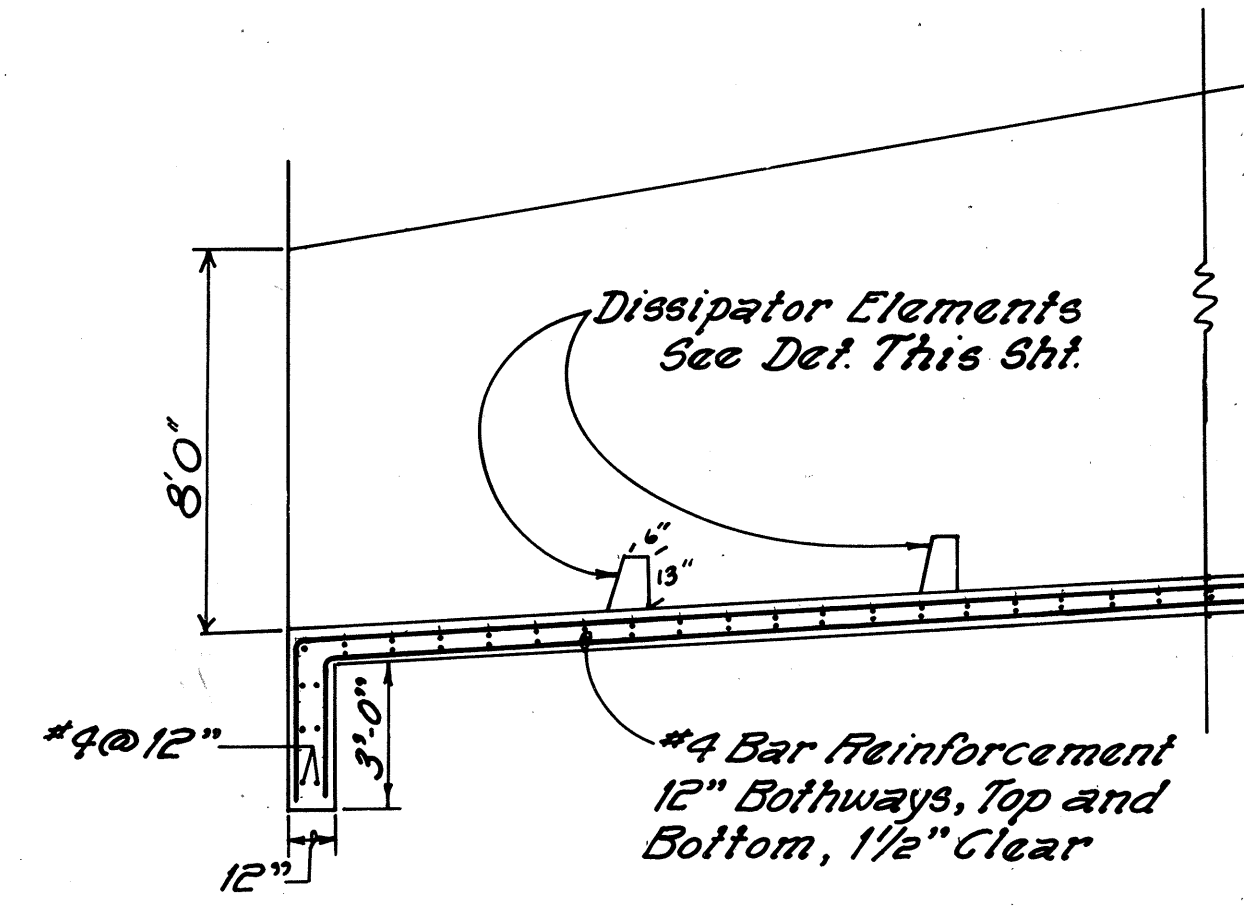

TRANS - MERIDIAN
ENGINEERS & SURVEYORS
345 QUEEN ST., SUITE 500
HONOLULU, HAWAII 96813

DENIS T. SHU
REGISTERED
PROFESSIONAL
ENGINEER
No. 2447
HAWAII, U.S.A.


THIS WORK WAS PRE-
PARED BY ME OR UNDER
MY SUPERVISION
Date: 10/82

STATE OF HAWAII
DEPARTMENT OF TRANSPORTATION
HIGHWAYS DIVISION


DRAINAGE DETAILS
ENERGY DISSIPATOR FOR CULVERT
AT STA. 209+37
HONOAPIILANI HIGHWAY
ALAELOA TO PINEAPPLE HILL
F.A. PROJECT NO. F-030-1(8)
SCALE: AS SHOWN DATE: MAR 1982

SHEET No. 9 OF 16 SHEETS

Begin Type 2-GIGIG Gutter or
End Type 2-GIGIG Gutter

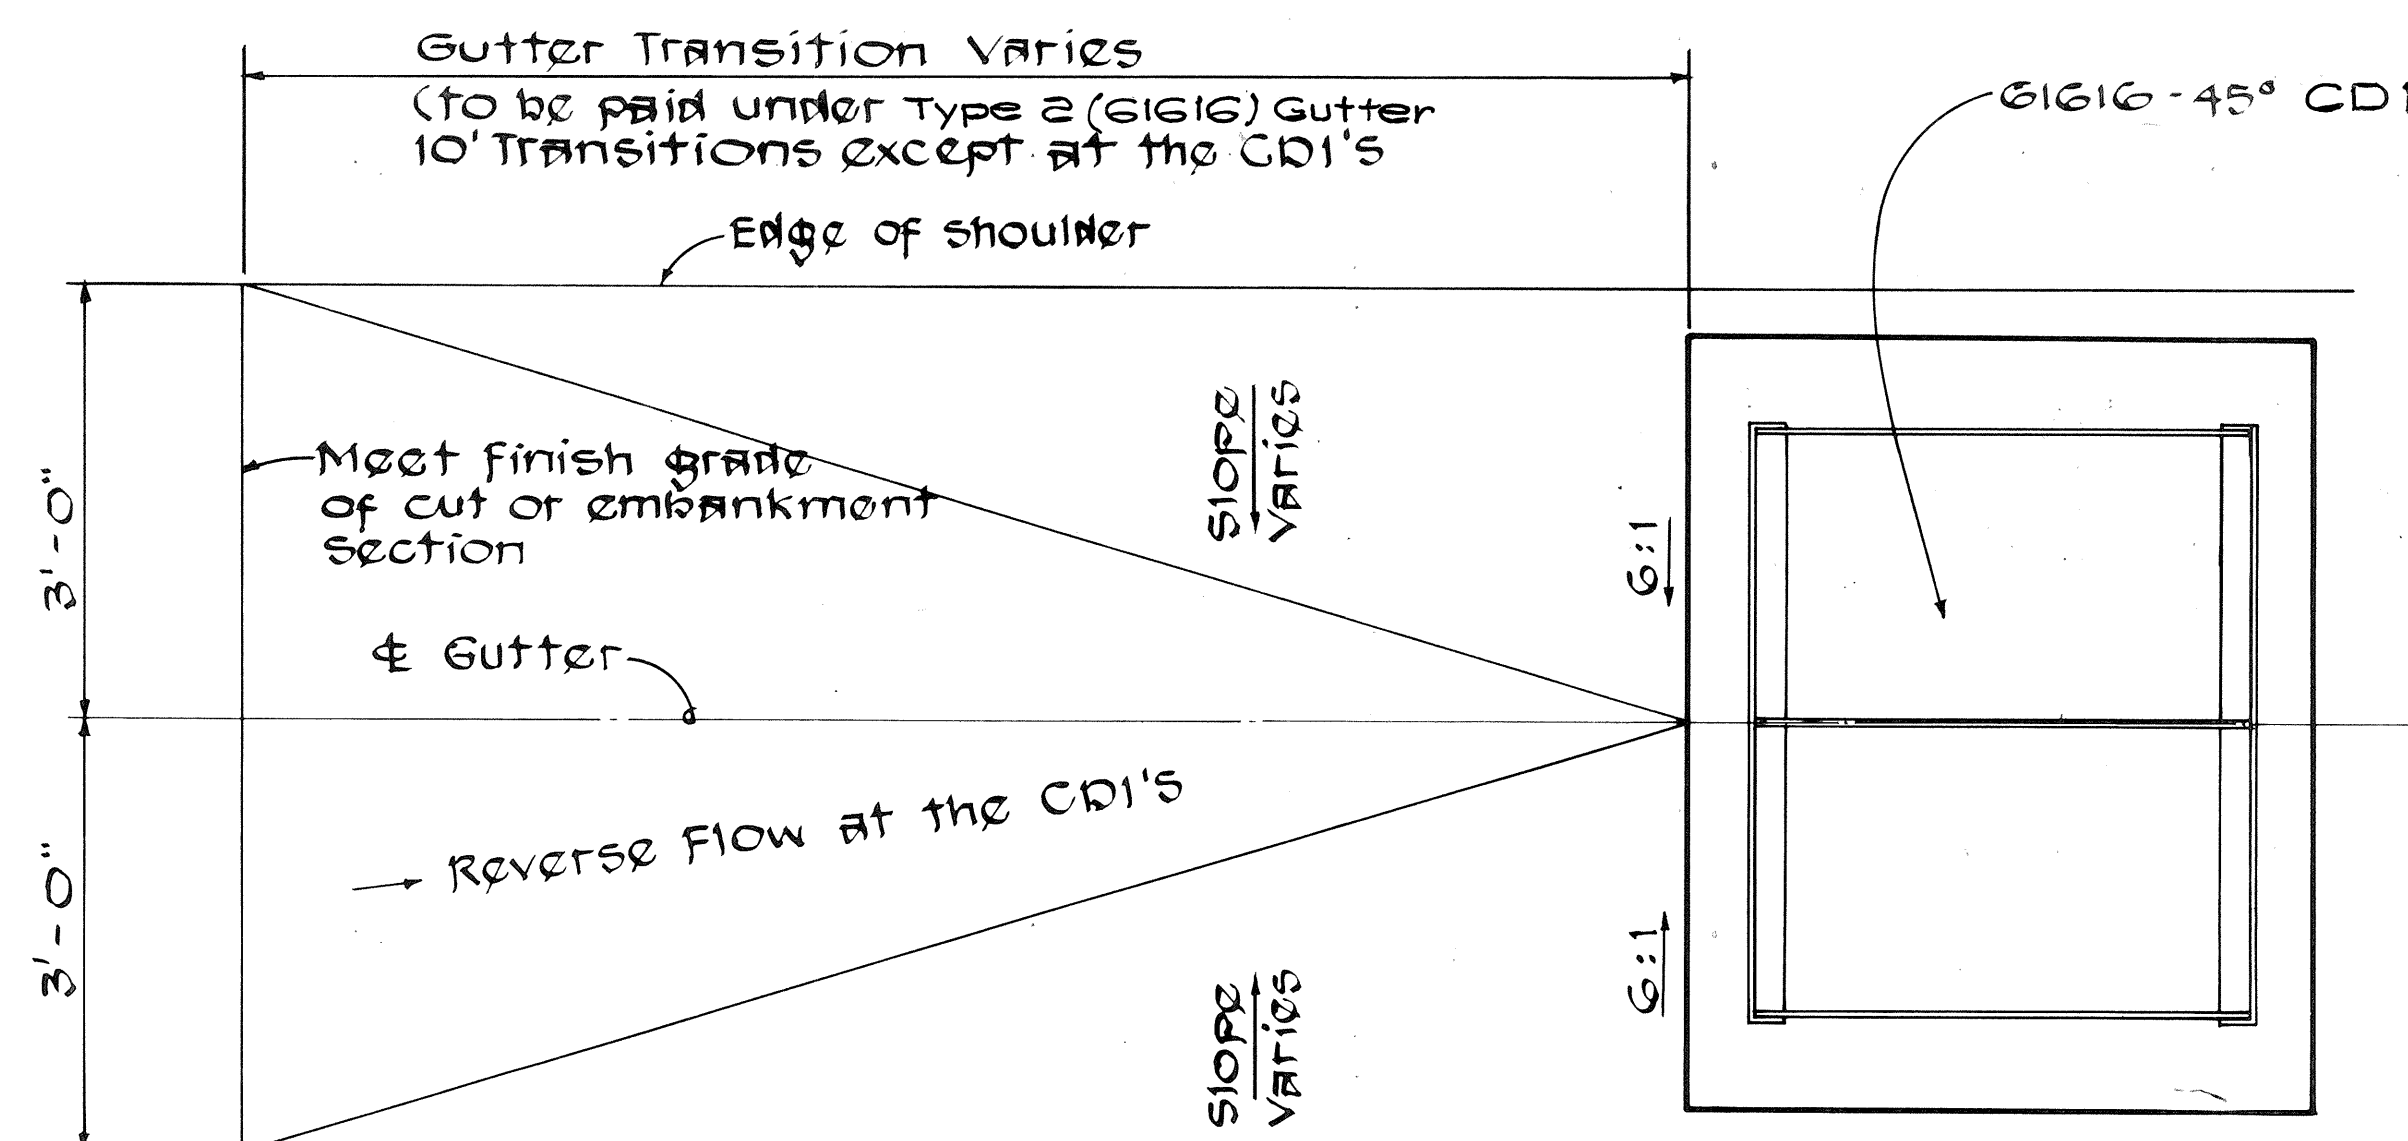

TYPICAL GUTTER TRANSITION AT TERMINATION
OR BEGINNING OF TYPE 2 (GIGIG) GUTTER
SCB/C: 3/4" = 1'-0"

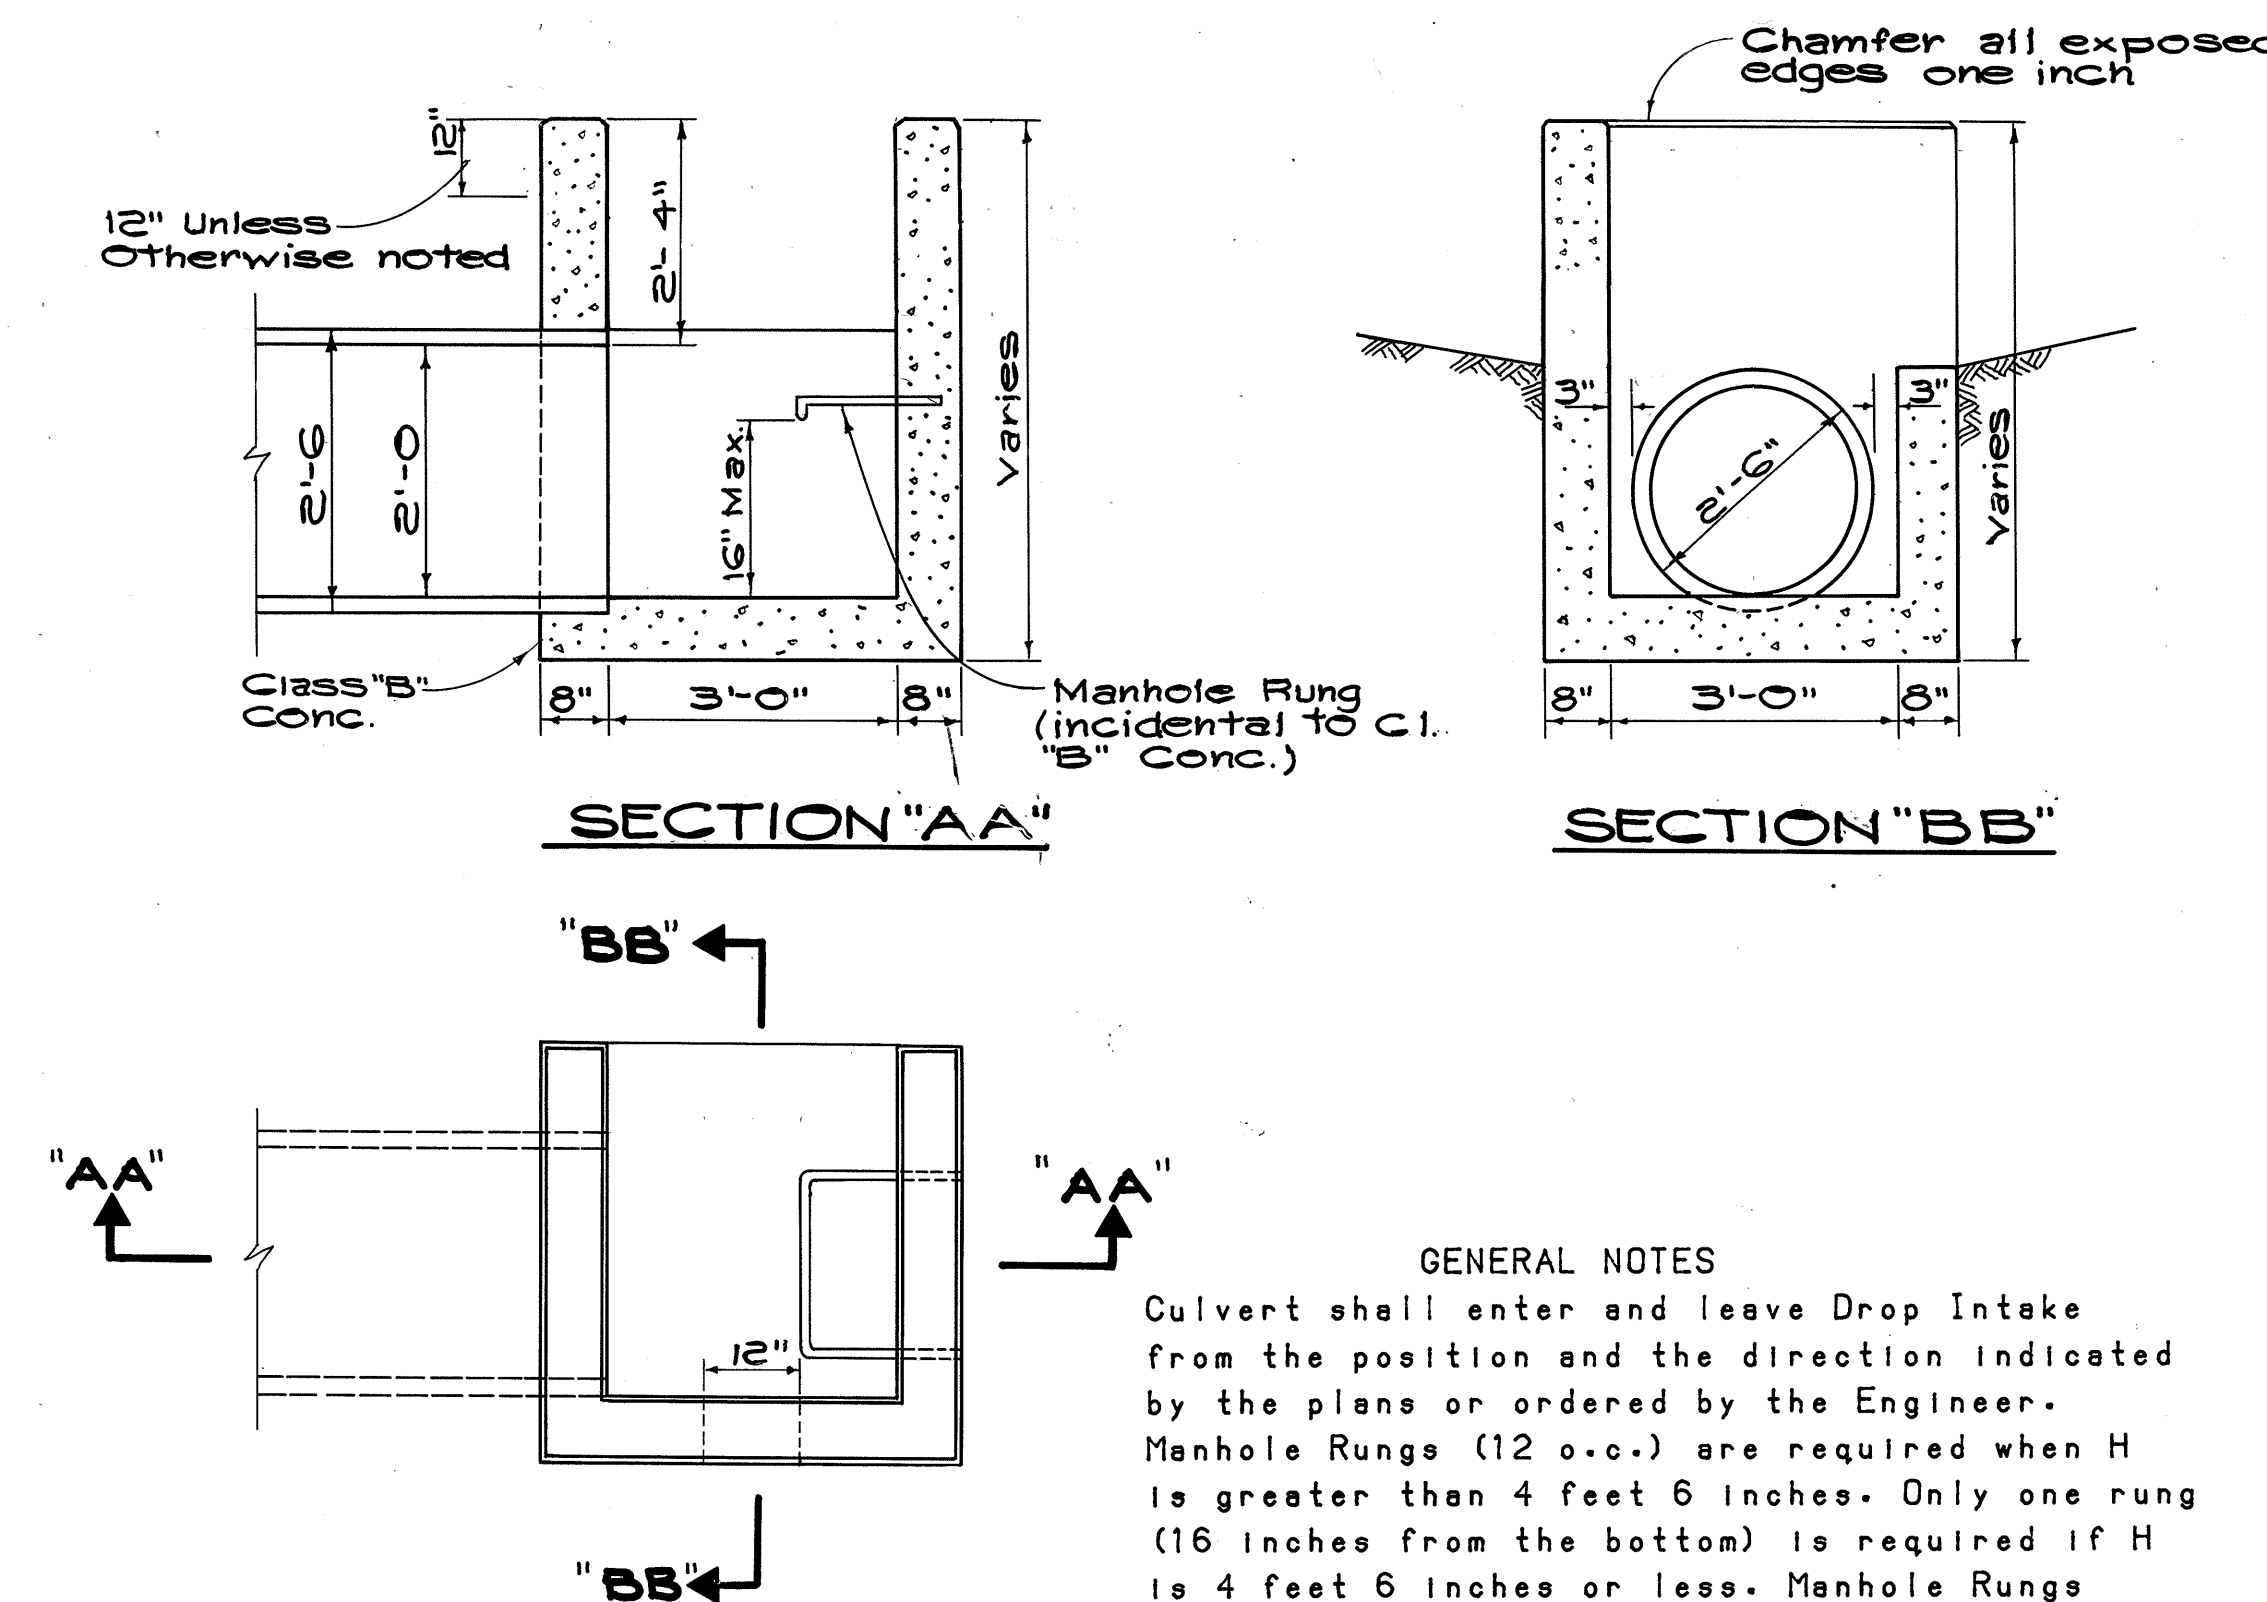


GENERAL NOTES


Culvert shall enter and leave Drop Intake from the position and the direction indicated by the plans or ordered by the Engineer. Manhole Rungs (12 o.c.) are required when H is greater than 4 feet 6 inches. Only one rung (16 inches from the bottom) is required if H is 4 feet 6 inches or less. Manhole Rungs may be placed at any location as ordered by the Engineer.

may be placed at any location
the Engineer.


PLAN
TYPE A
CONC. DROP INTAKE DETAIL
NOT TO SCALE

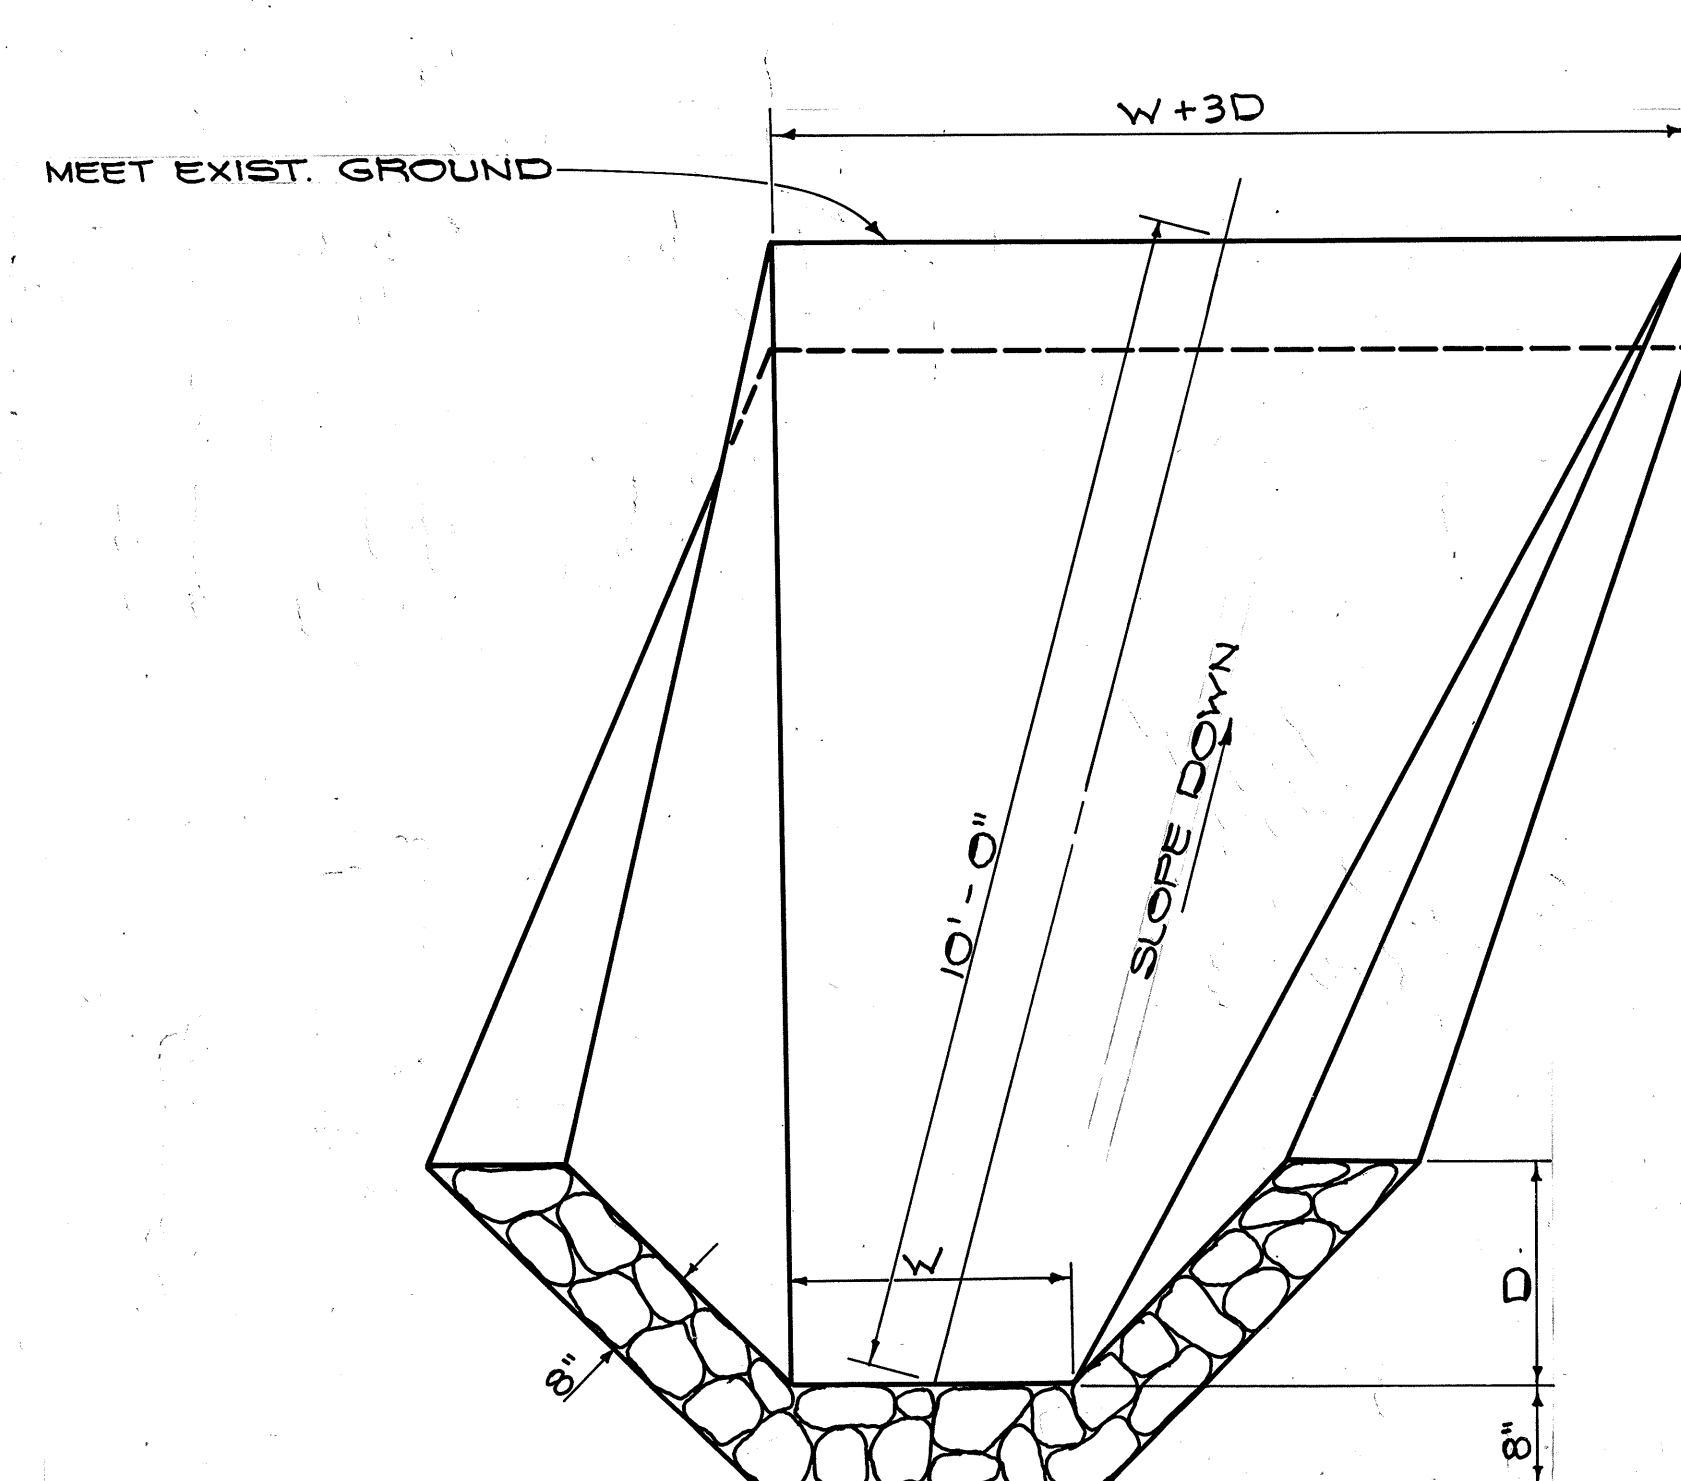


ISOMETRIC
FLARED GRP DRAINAGE DITCH END SECTION
NOT TO SCALE

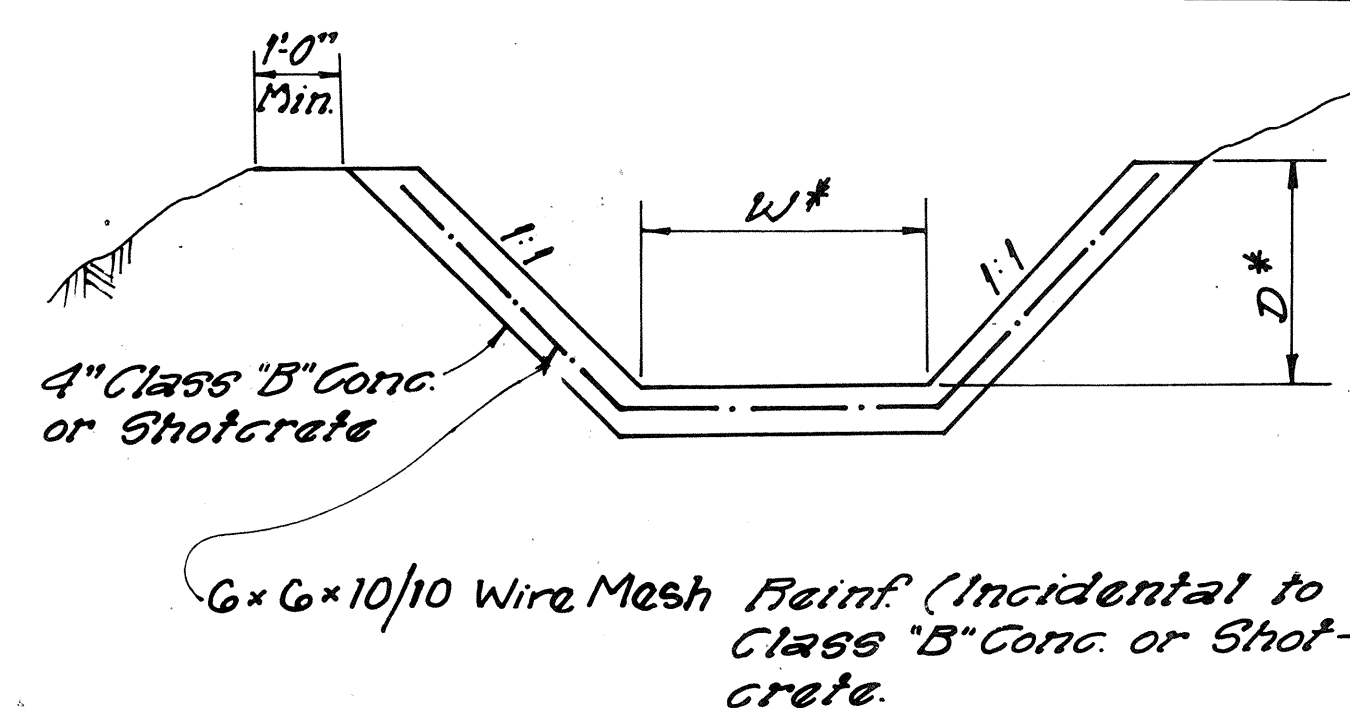


LINED TRAPEZOIDAL
DRAINAGE DITCH
* See Drainage Plans
NOT TO SCALE

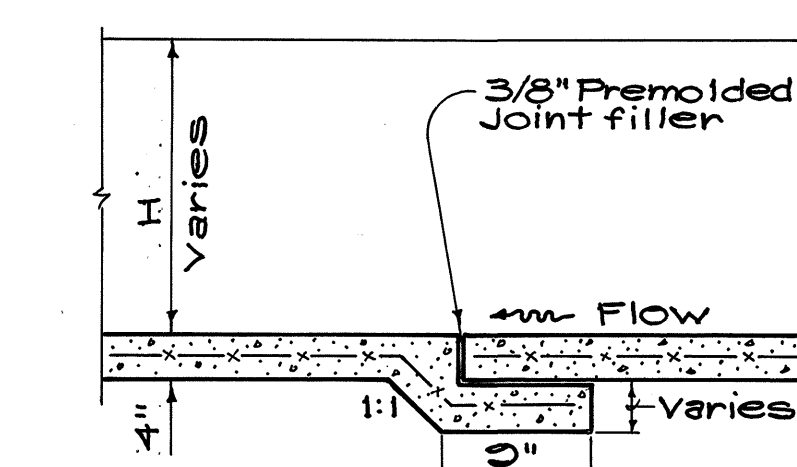

EXPANSION JOINT @ 75' O.C.

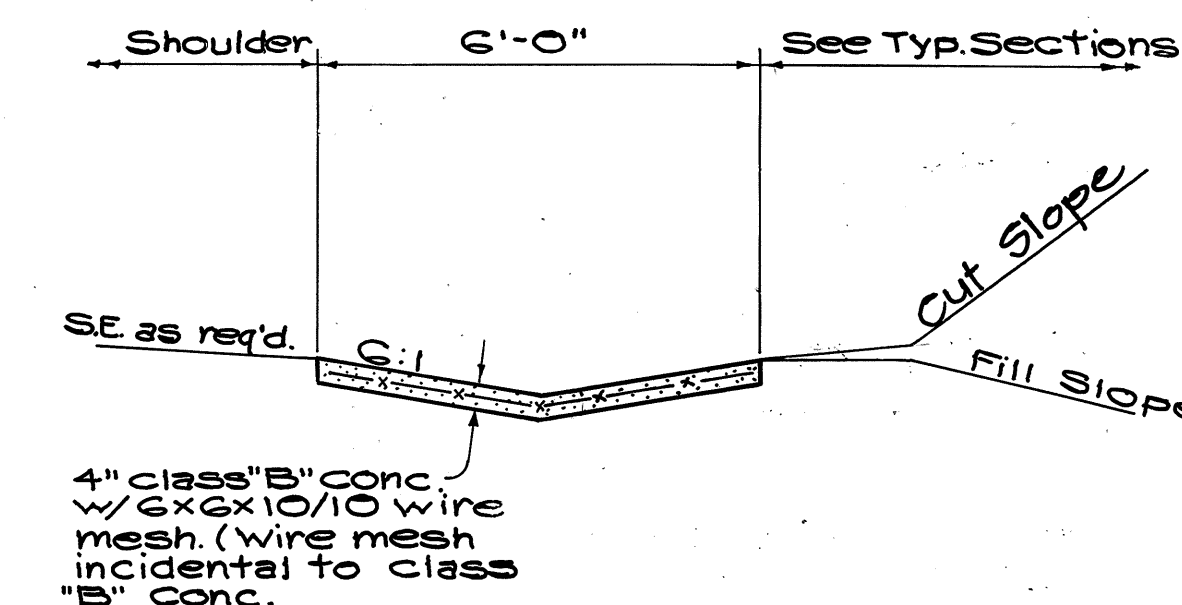

TYPE 2 (61616) CONC. GUTTER
NOT TO SCALE

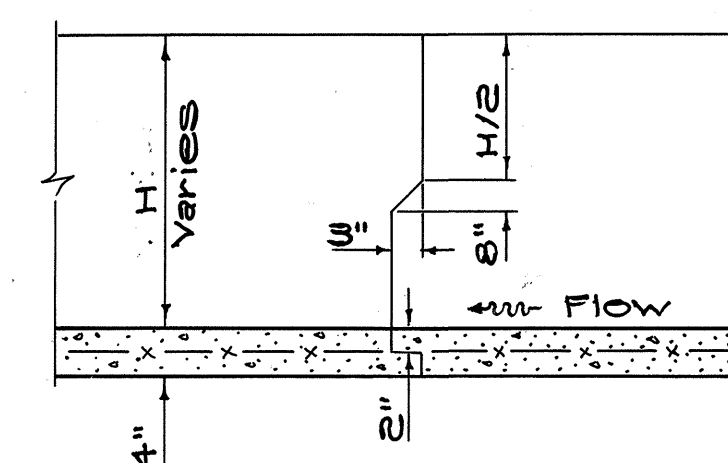

CONSTRUCTION JOINT@25' OC
DRAINAGE DITCH DETAIL
NOT TO SCALE



THIS WORK WAS PREPARED BY ME OR UNDER MY SUPERVISION.

James L. Shinn


DRAINAGE DETAILS

HONOAPIILANI HIGHWAY
ALAELOA TO PINEAPPLE HILL
F.A. PROJECT NO. F-030-1 (8)
SCALE: AS SHOWN DATE SEP. 1981
SHEET No. 10 OF 10 SHEETS


FED. ROAD DIST. NO.	STATE	FED. AID PROJ. NO.	FISCAL YEAR	SHEET NO.	TOTAL SHEETS
HAWAII	HAW.				

GENERAL NOTE


1. All welds 3/8" unless otherwise noted.

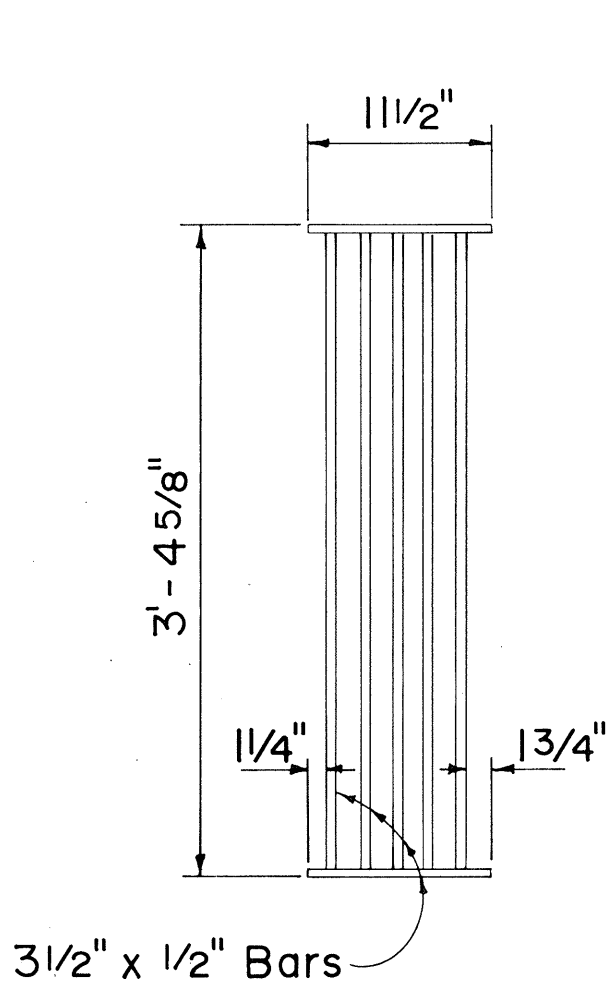


PLAN

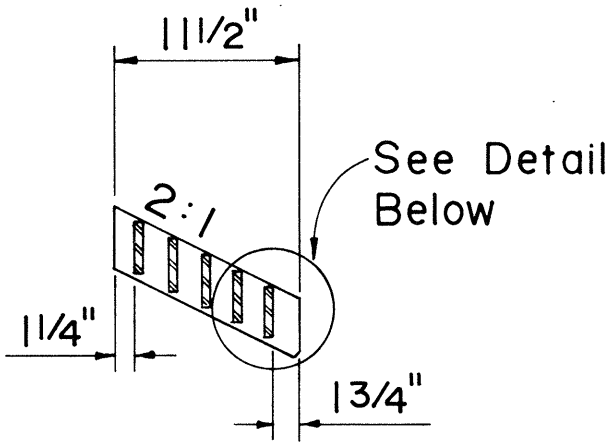


SECTION

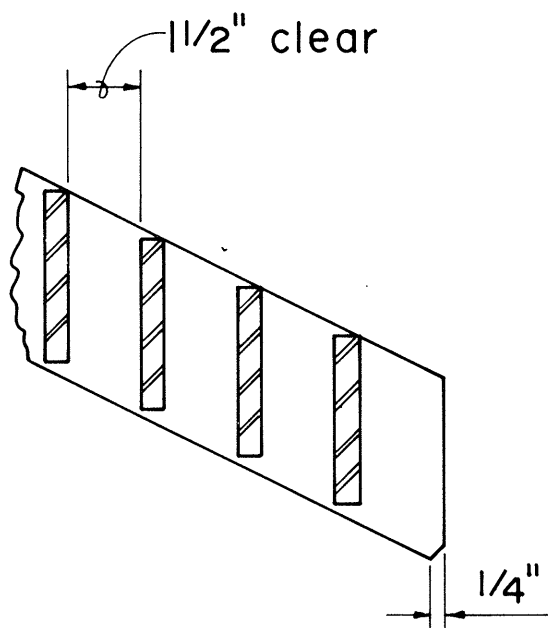

GRATE

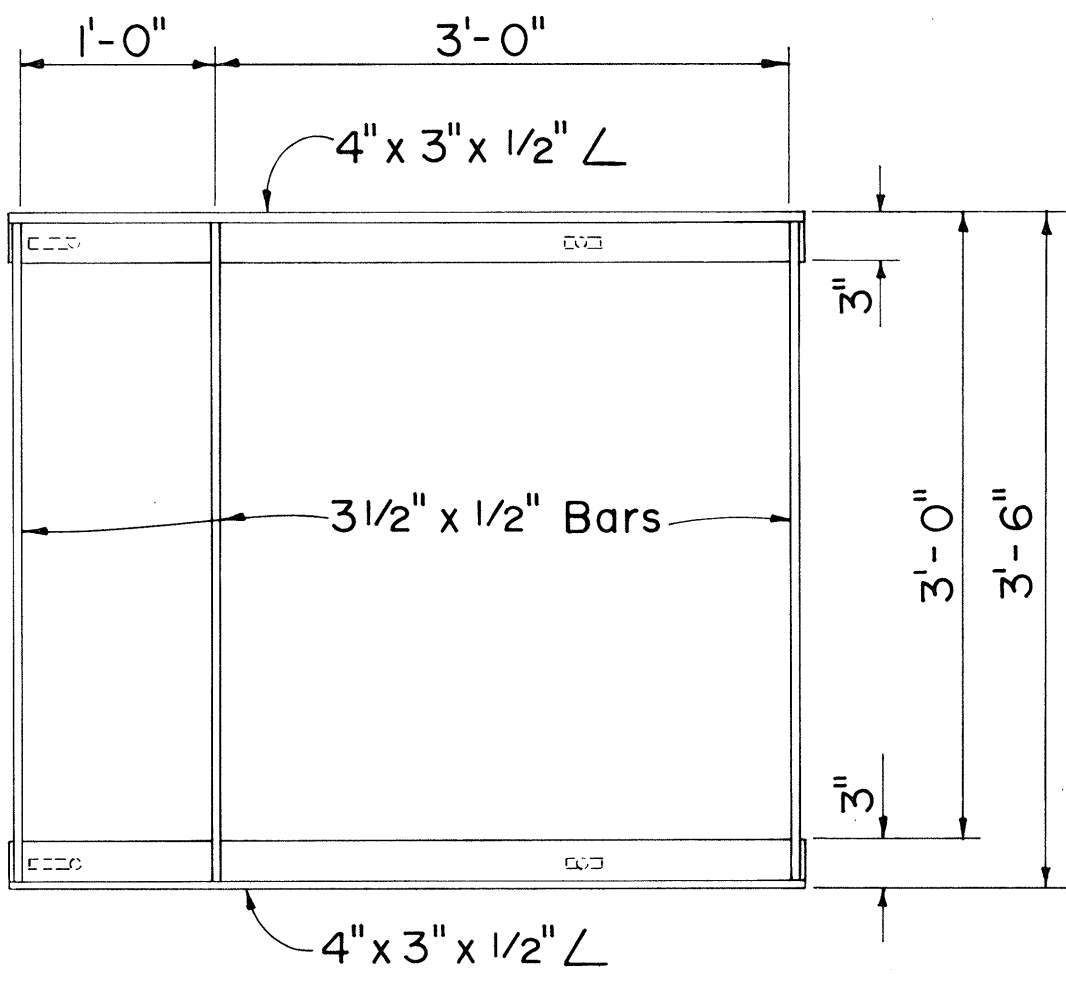


PLAN

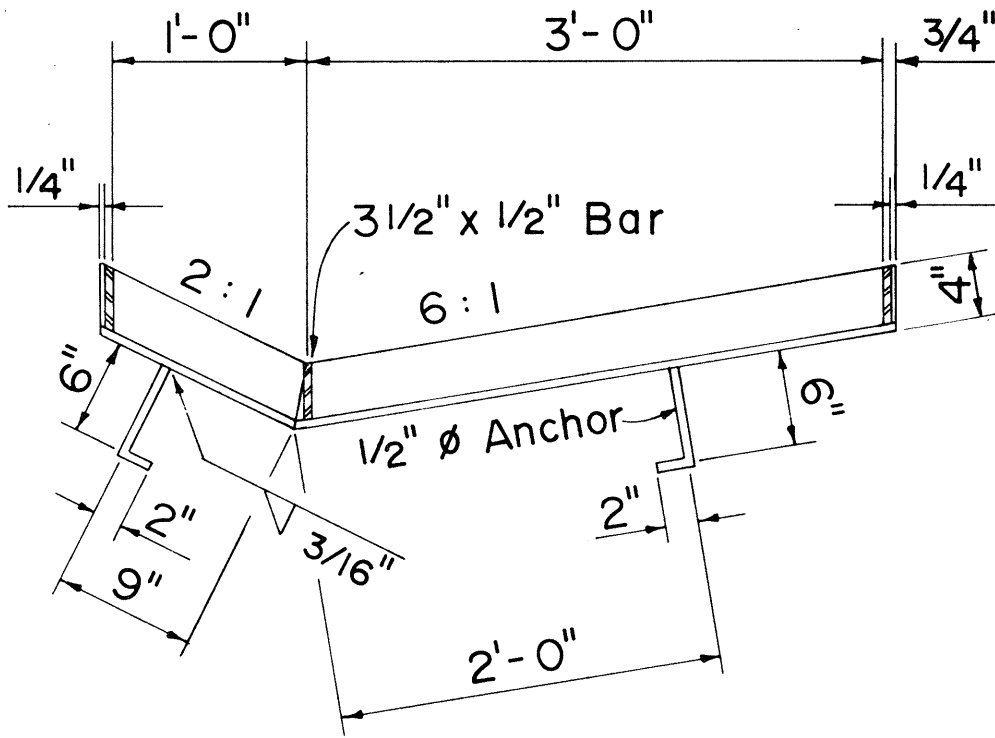


SECTION


FRAME

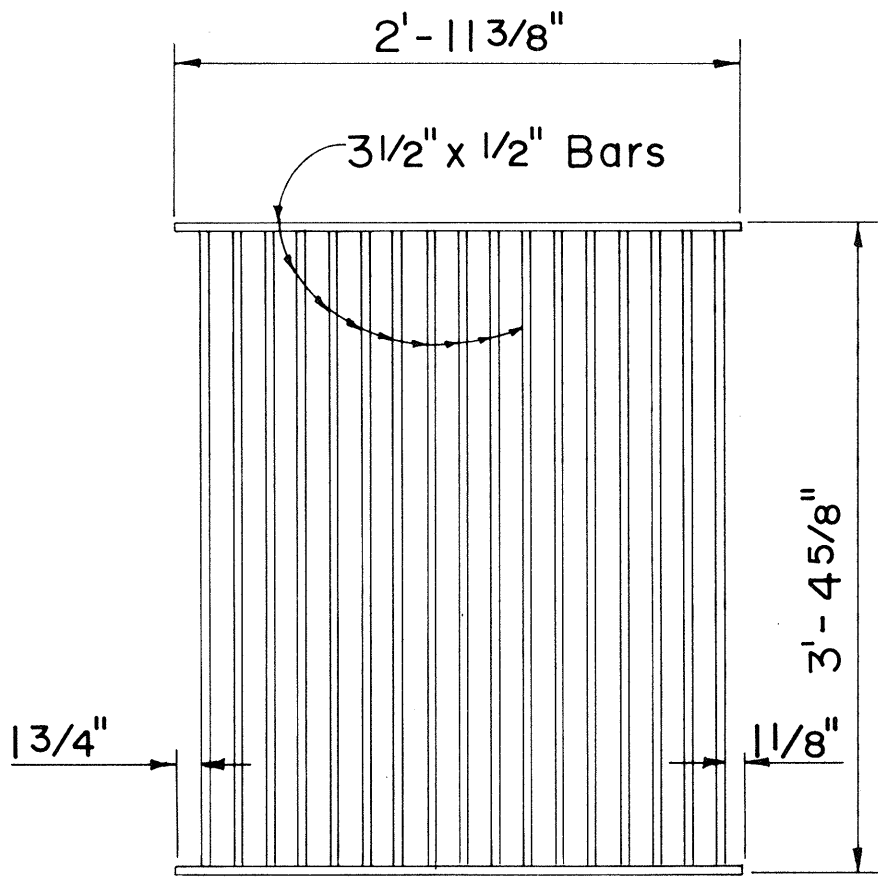


PLAN

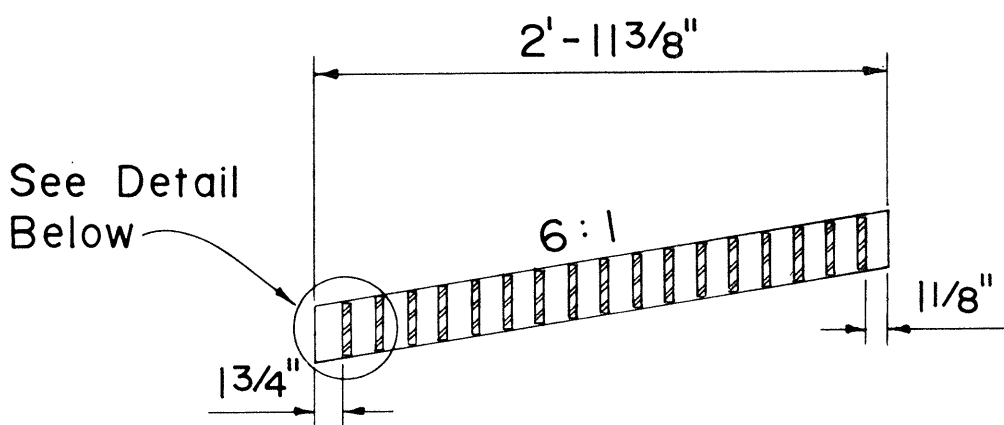


SECTION

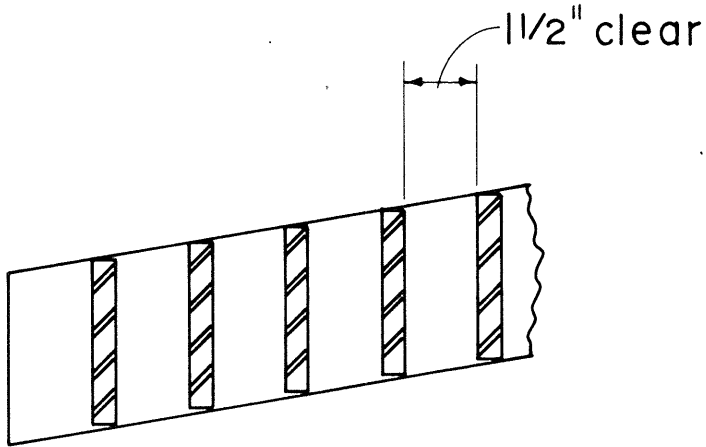

GRATE

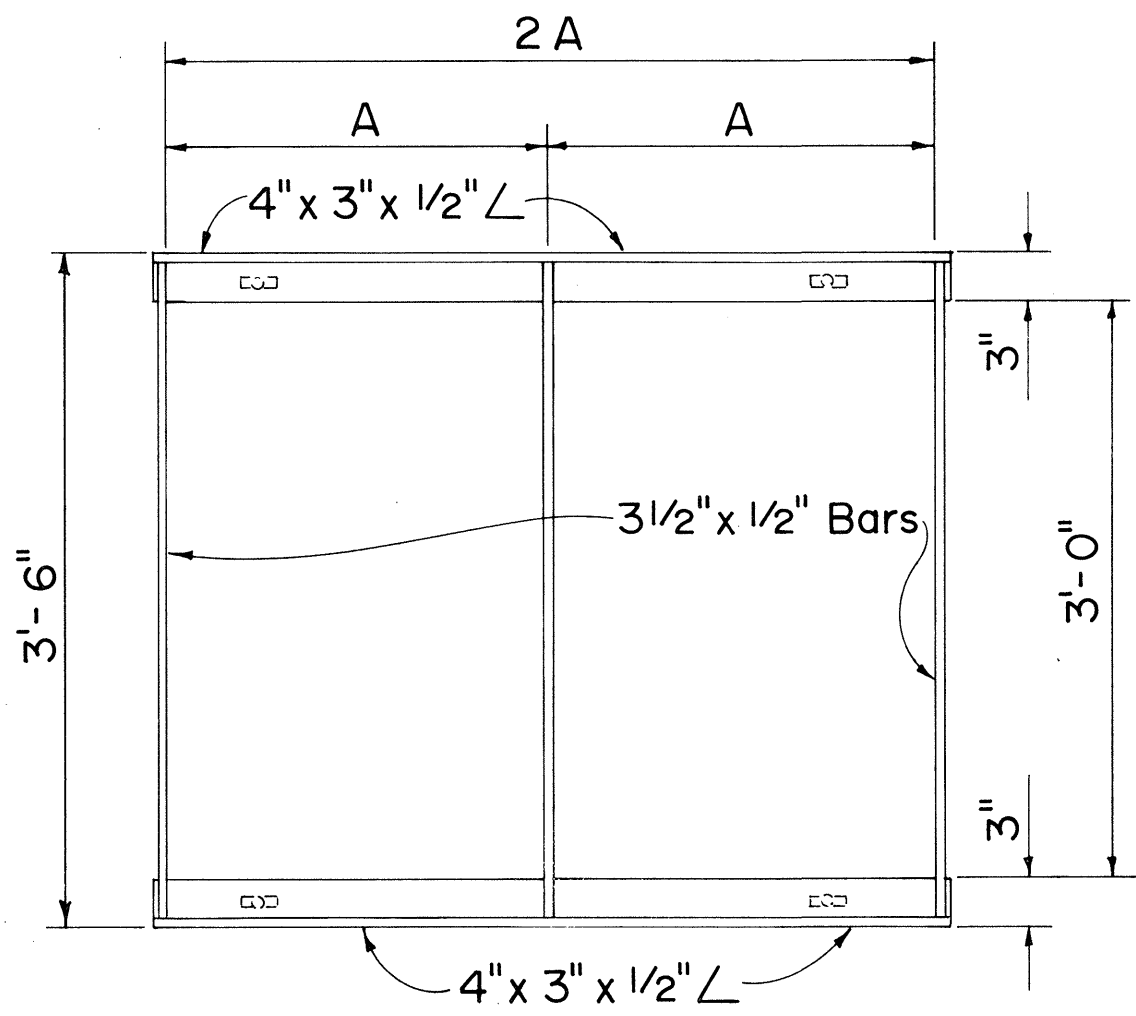


PLAN

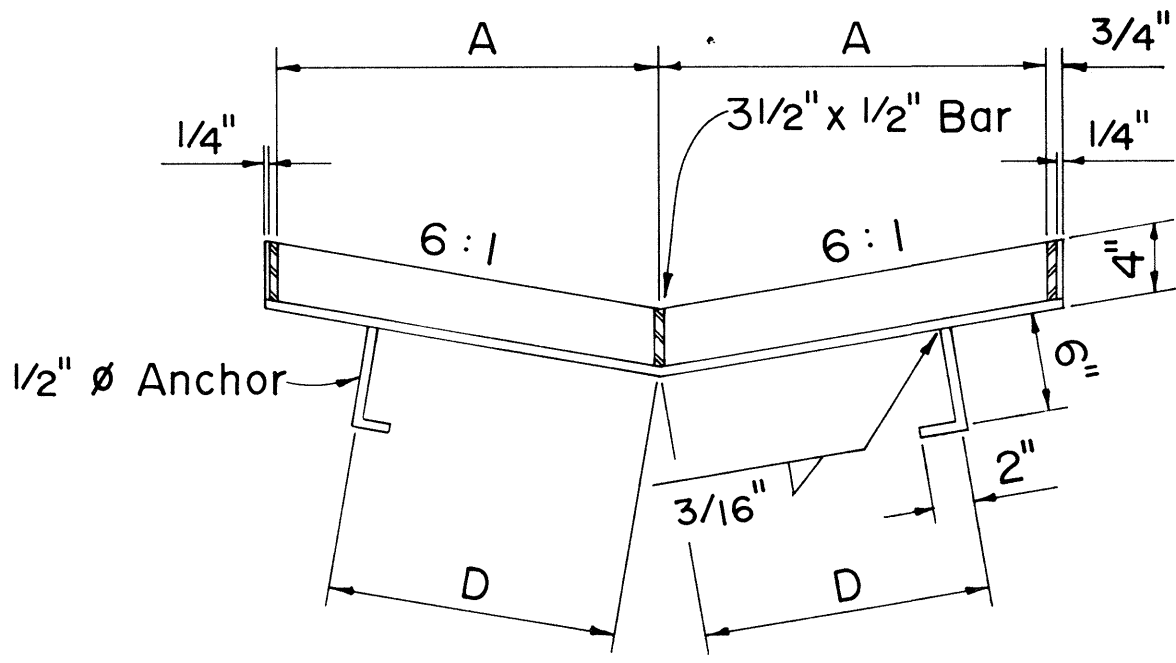


SECTION

FRAME

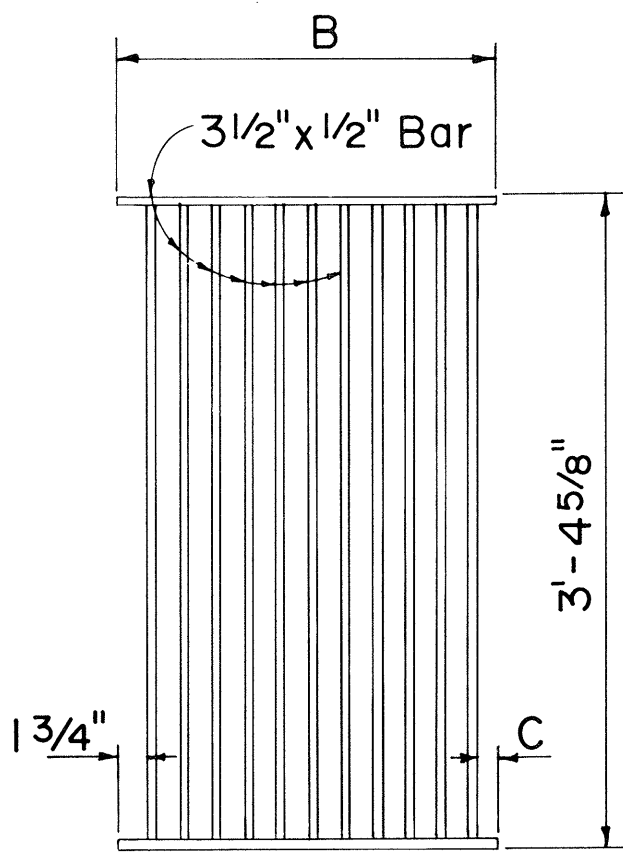

PLAN

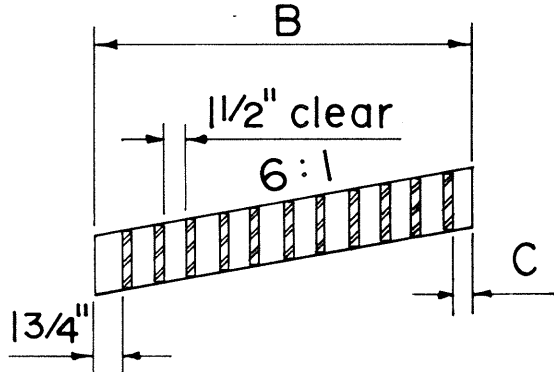

SECTION

GRATE

61614 OR 61616 STEEL FRAME AND GRATE

DIMENSIONS					
TYPE	NO. BARS	A	B	C	D
61614	11	2'-0"	1'-11 1/2"	1 1/4"	1'-6"
61616	17	3'-0"	2'-11 3/8"	1 1/8"	2'-0"

APPROVAL RECOMMENDED:
P. Takano
 HYDRAULIC DESIGN ENGINEER 6-19-79 DATE

APPROVED:
Herbert Zafraishi
 ASSISTANT CHIEF, ENGINEERING 6-22-79 DATE

NO.	REVISION	APPROVED BY	DATE
1.	Supersedes Sht. DH 8 & DH 9 approved 12-17-69	H.L.	6/22/79


STATE OF HAWAII DEPARTMENT OF TRANSPORTATION HIGHWAYS DIVISION	
STANDARD DETAILS	
61214, 61614 & 61616 STEEL FRAMES AND GRATES	
Not To Scale	Date: Dec. 1977
SHEET NO.	OF SHEETS DH 8

61214 STEEL FRAME AND GRATES


SURVEY PLOTTED BY	DATE
DRAWN BY	
DESIGNED BY	
QUANTITIES BY	
CHECKED BY	
ORIGINAL PLAN	
NOTE BOOK	
NO.	

FED. ROAD DIST. NO.	STATE	FED. AID PROJ. NO.	FISCAL YEAR	SHEET NO.	TOTAL SHEETS
HAWAII	HAW.	F-030-1(8)	1981	49	92


* Unless otherwise shown on plans

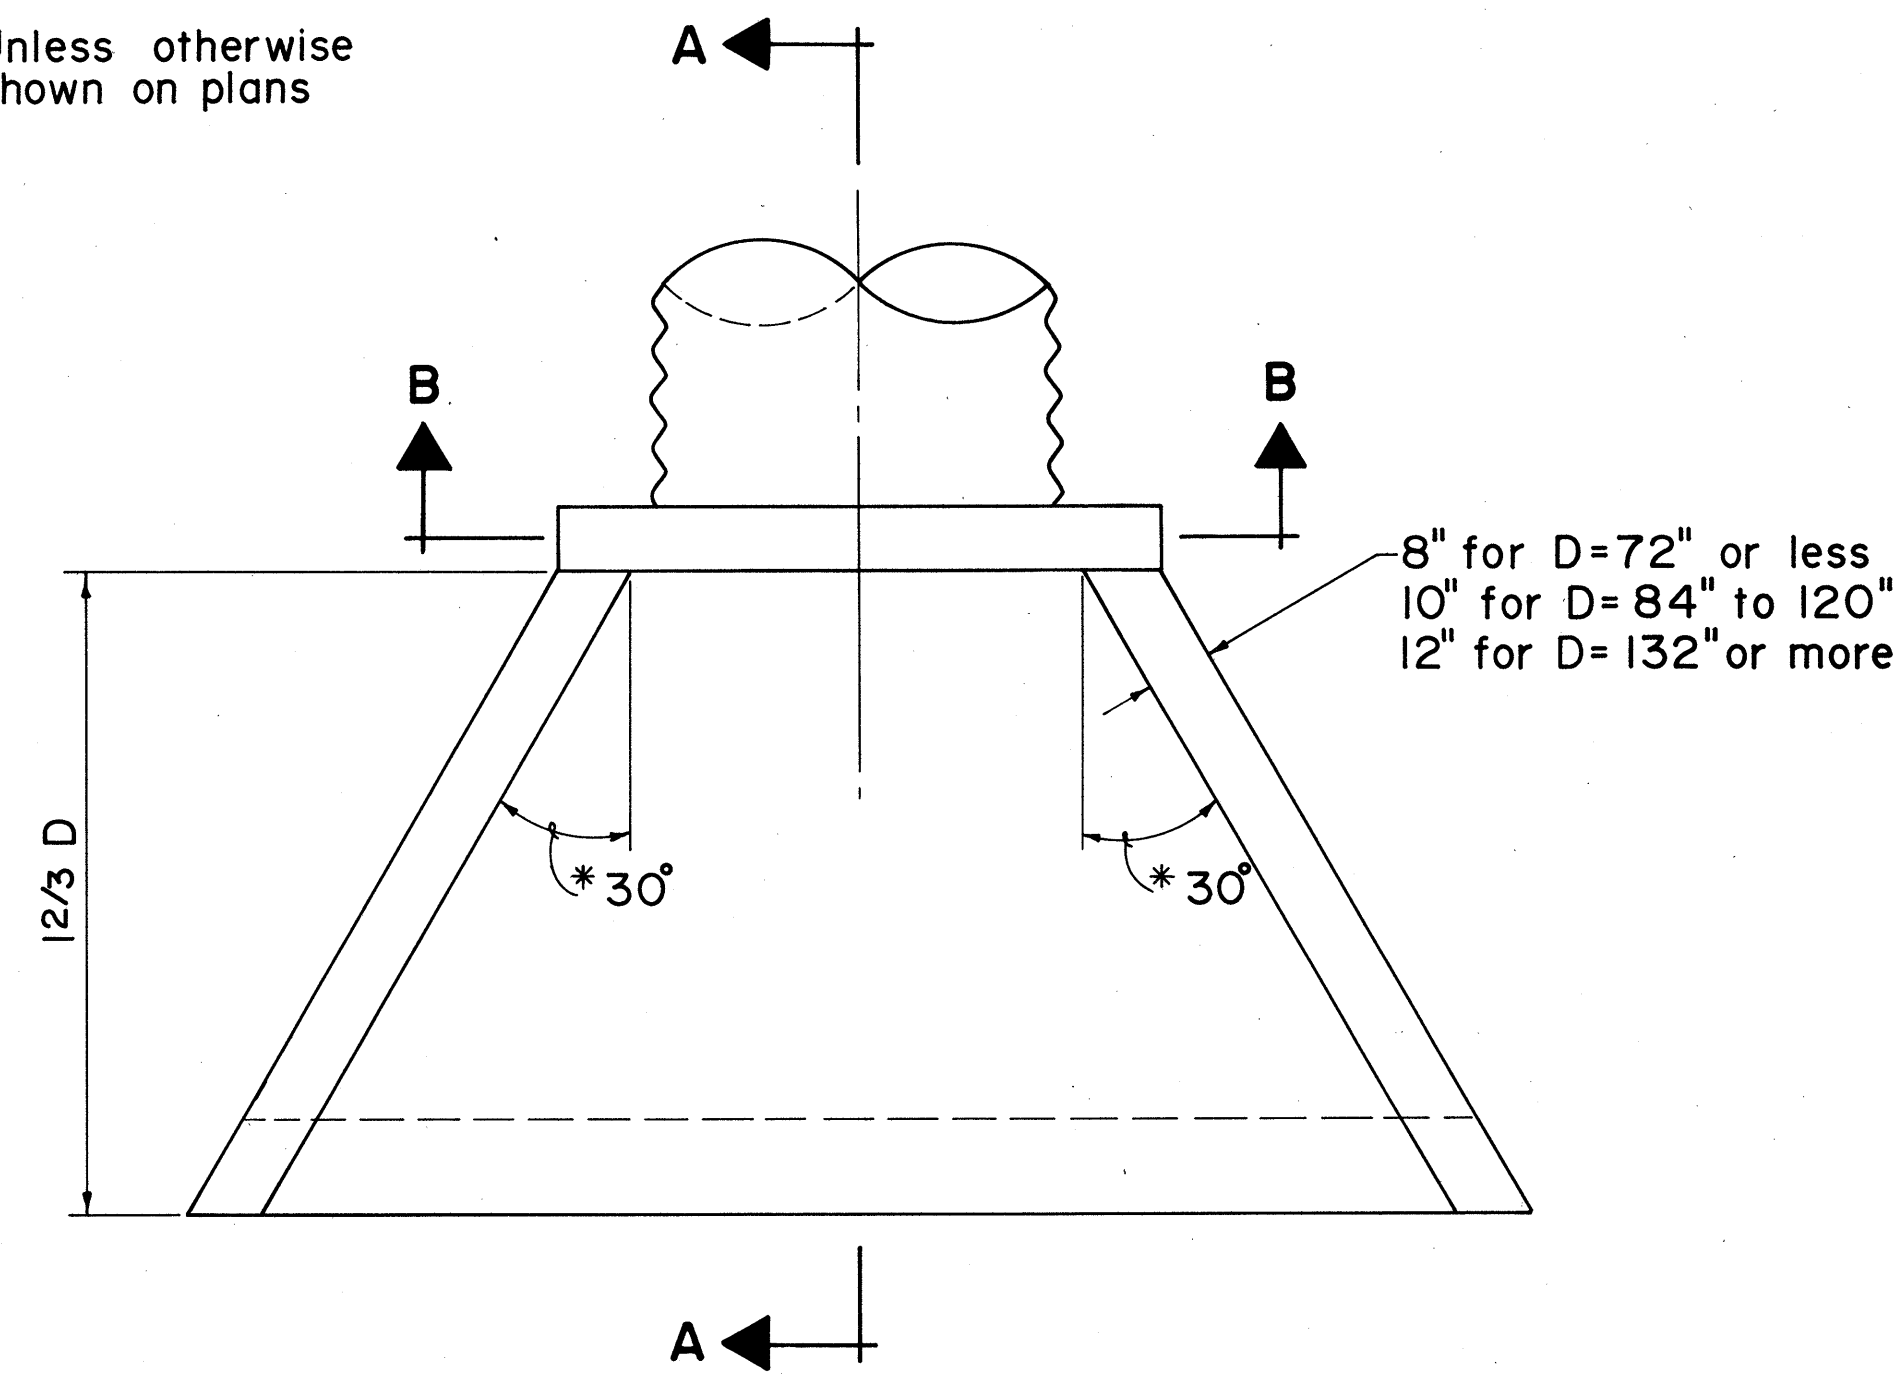

PLAN

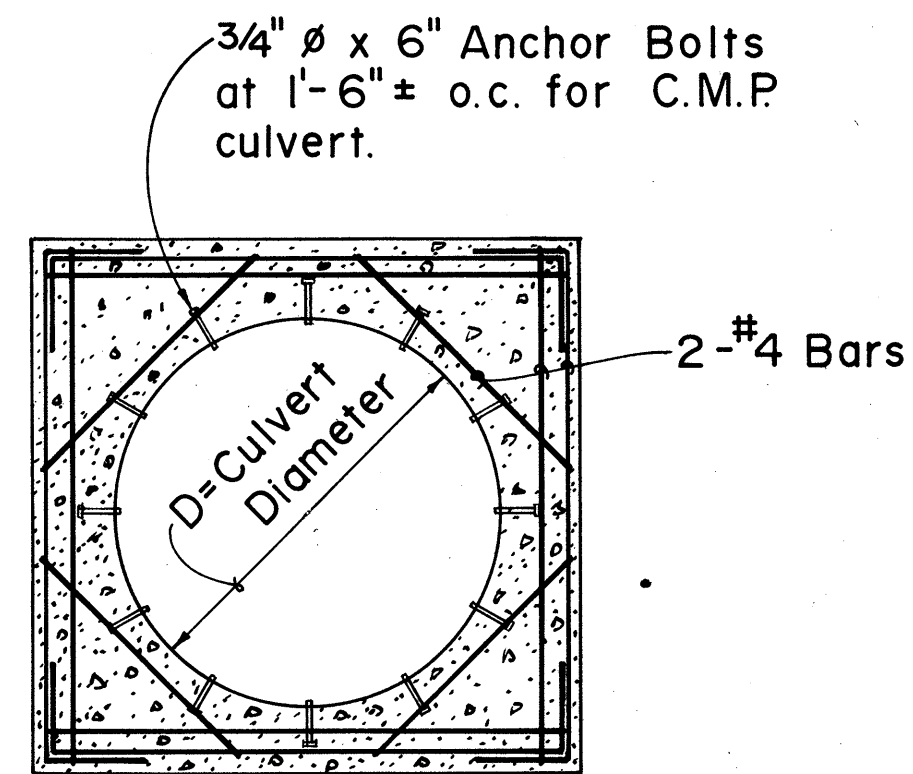


SECTION B-B

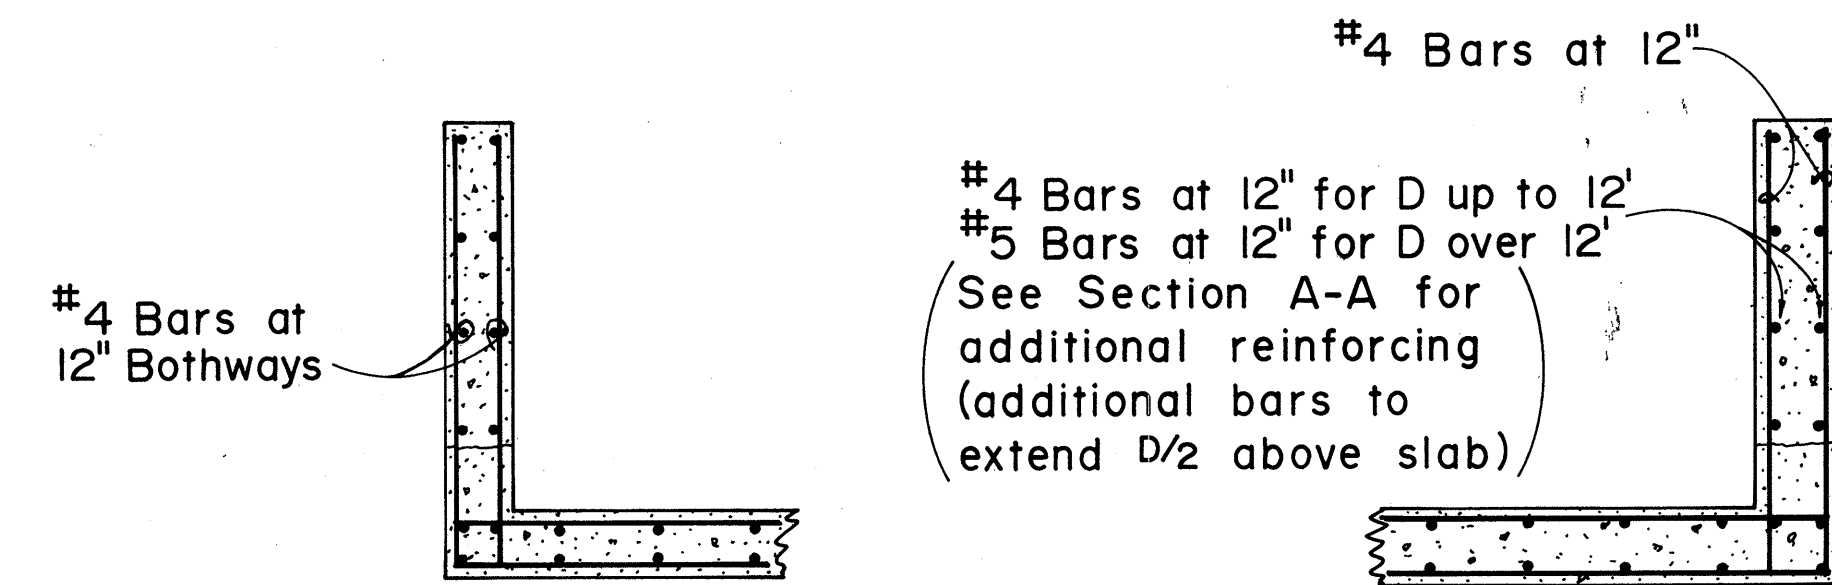

8" WING WALL

10" TO 12" WING WALLS

TYPICAL WING WALL REINFORCING

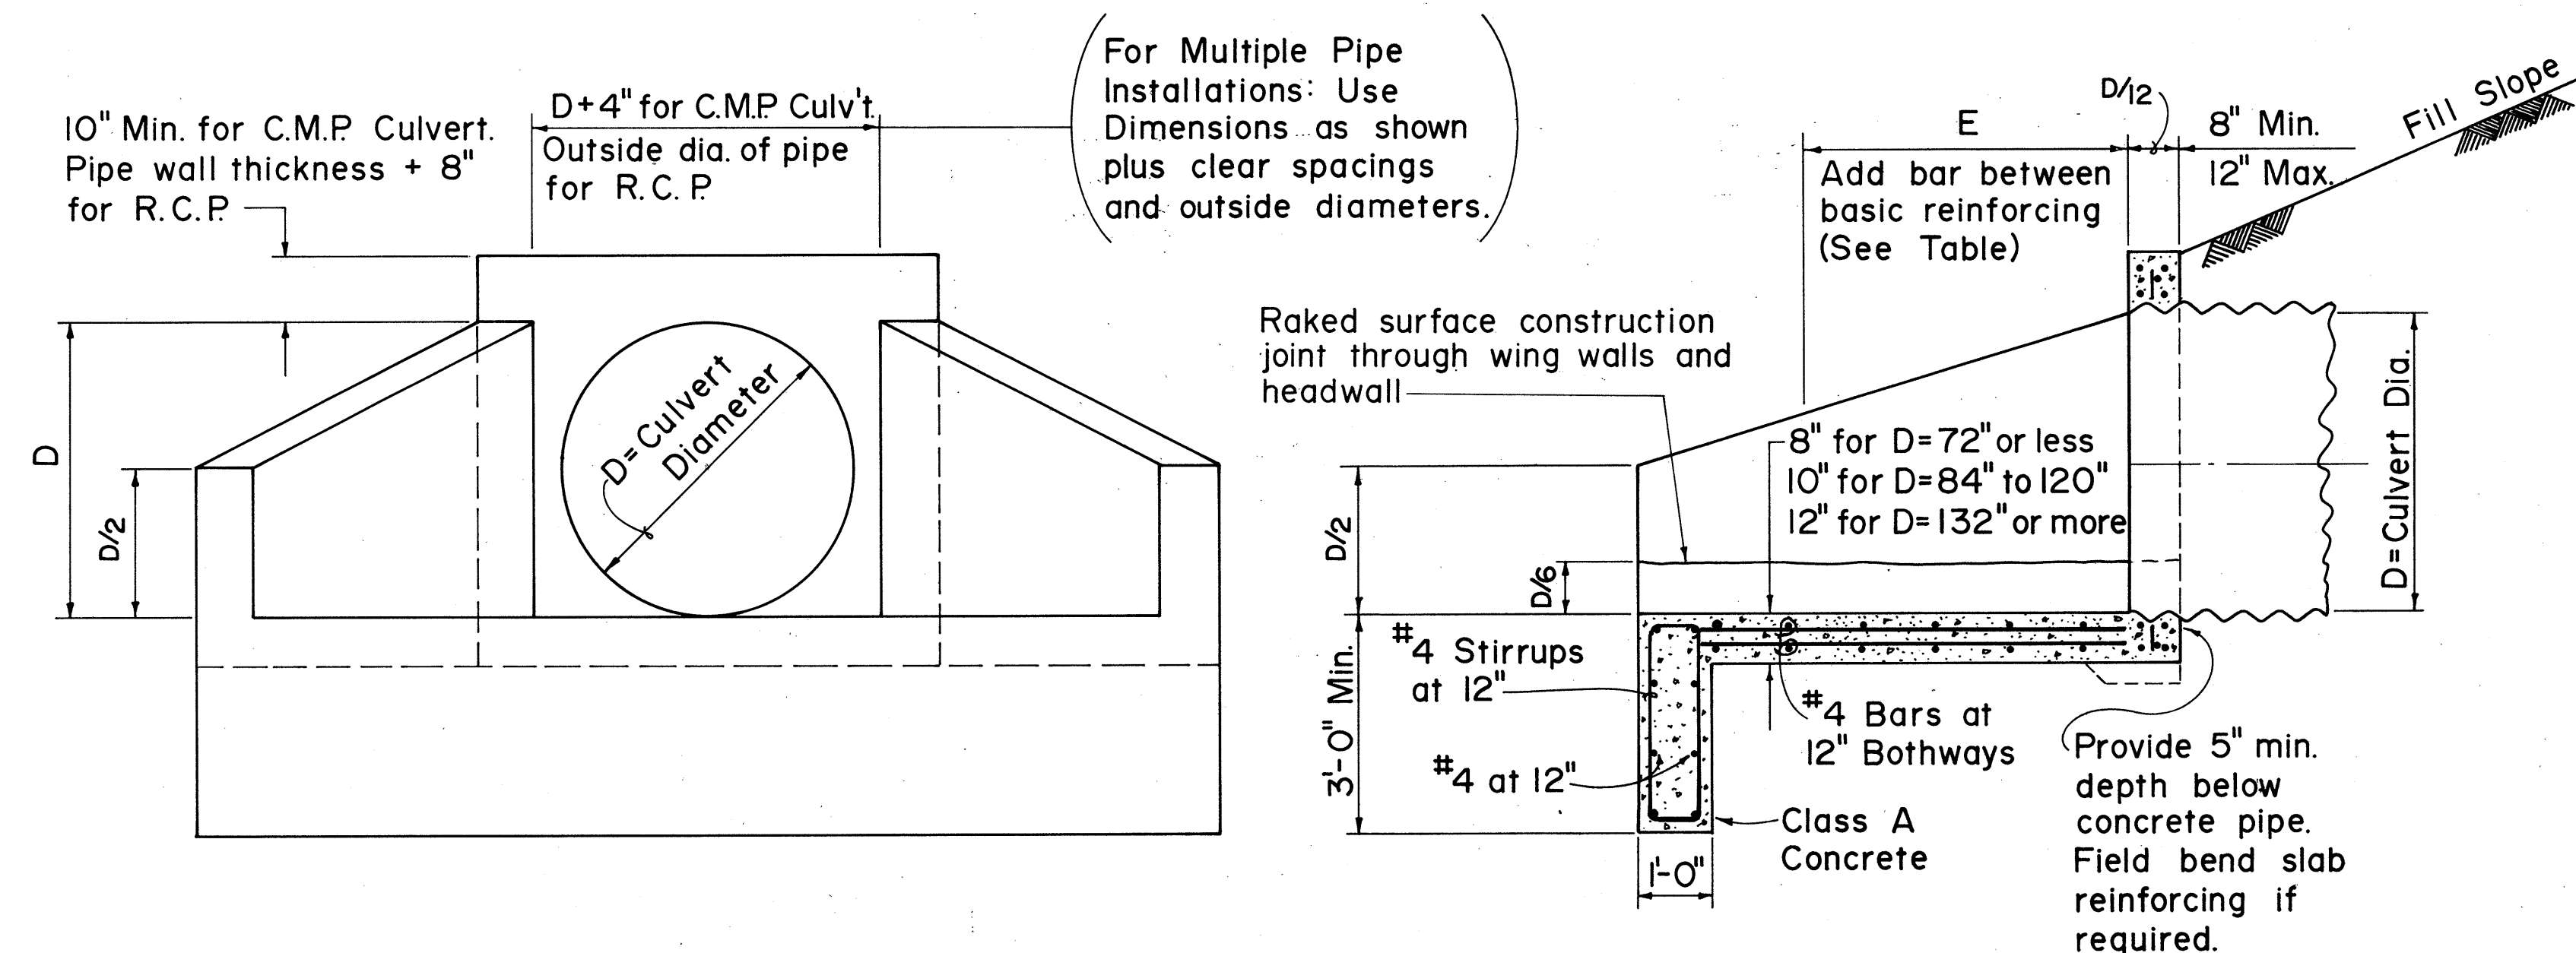

FRONT ELEVATION

SECTION A-A

CULVERT DIA. (INCHES)	ADD BAR SIZE	E (FEET)
108	#4	3
120	#4	5
144	#5	8
180	#7	11

ADDITIONAL REINFORCING

APPROVAL RECOMMENDED:
P. Nakano
 HYDRAULIC DESIGN ENGINEER 6-19-79 DATE
 APPROVED:
Herbert Zaleski
 ASSISTANT CHIEF, ENGINEERING 6-22-79 DATE




NO.	REVISION	APPROVED BY	DATE
1.	Supersedes Sht. DH 13 approved 12-17-69	H.P.	6/22/79

STATE OF HAWAII DEPARTMENT OF TRANSPORTATION HIGHWAYS DIVISION
STANDARD DETAILS INLET STRUCTURES
Not To Scale Date: Dec. 1977
SHEET No. 13 OF 16 SHEETS DH 13

INLET STRUCTURE FOR CULVERT SIZES 48 IN. TO 180 IN. DIAMETER


ORIGINAL PLAN	DATE
SURVEY PLOTTED BY	
DRAWN BY	
TRACED BY	
DESIGNED BY	
QUANTITIES BY	
CHECKED BY	
No.	

FED. ROAD DIST. NO.	STATE	FED. AID PROJ. NO.	FISCAL YEAR	SHEET NO.	TOTAL SHEETS
HAWAII	HAW.	F-030-1(8)	1981	50	92

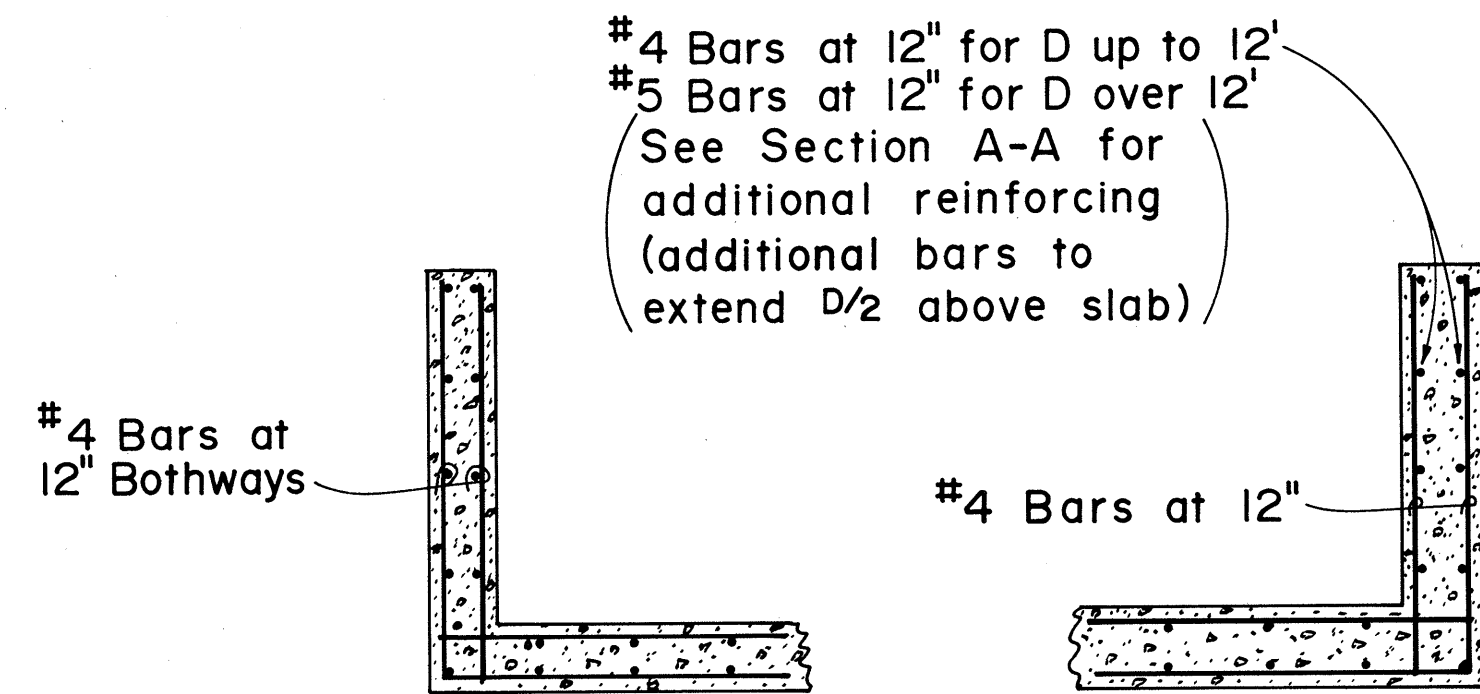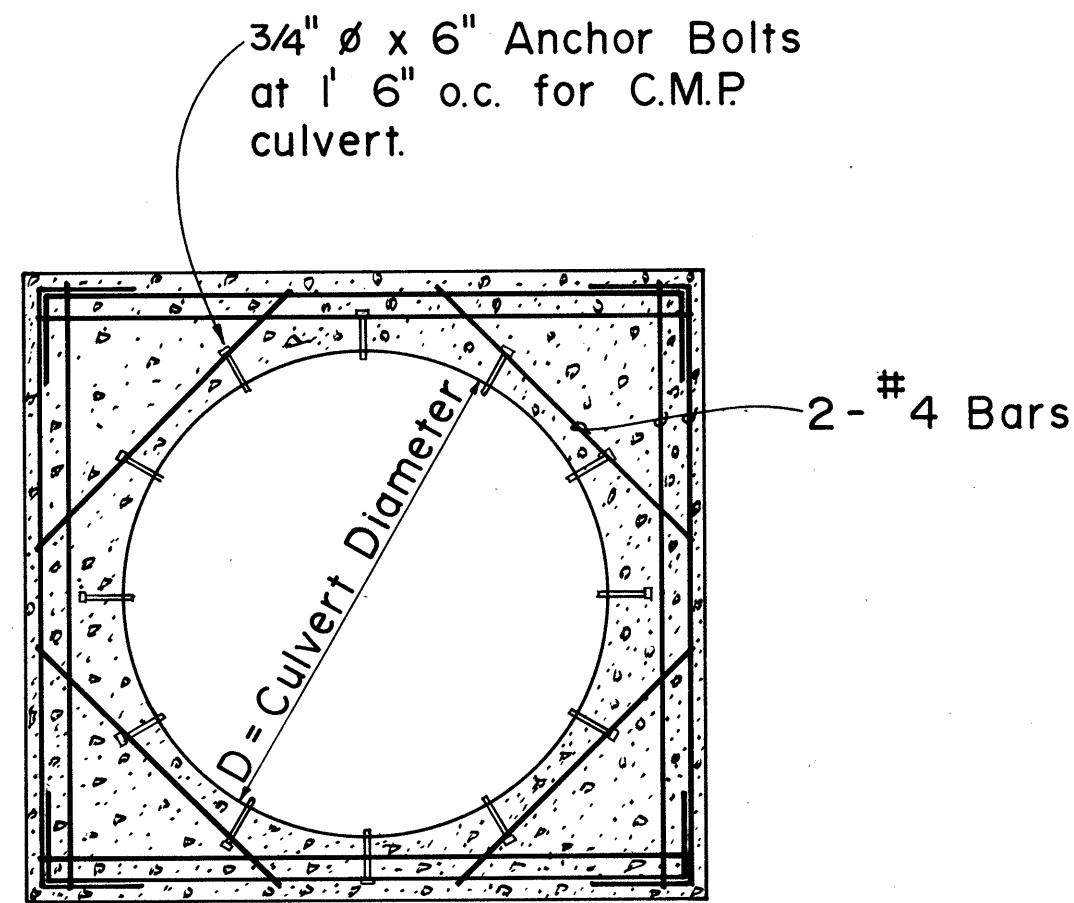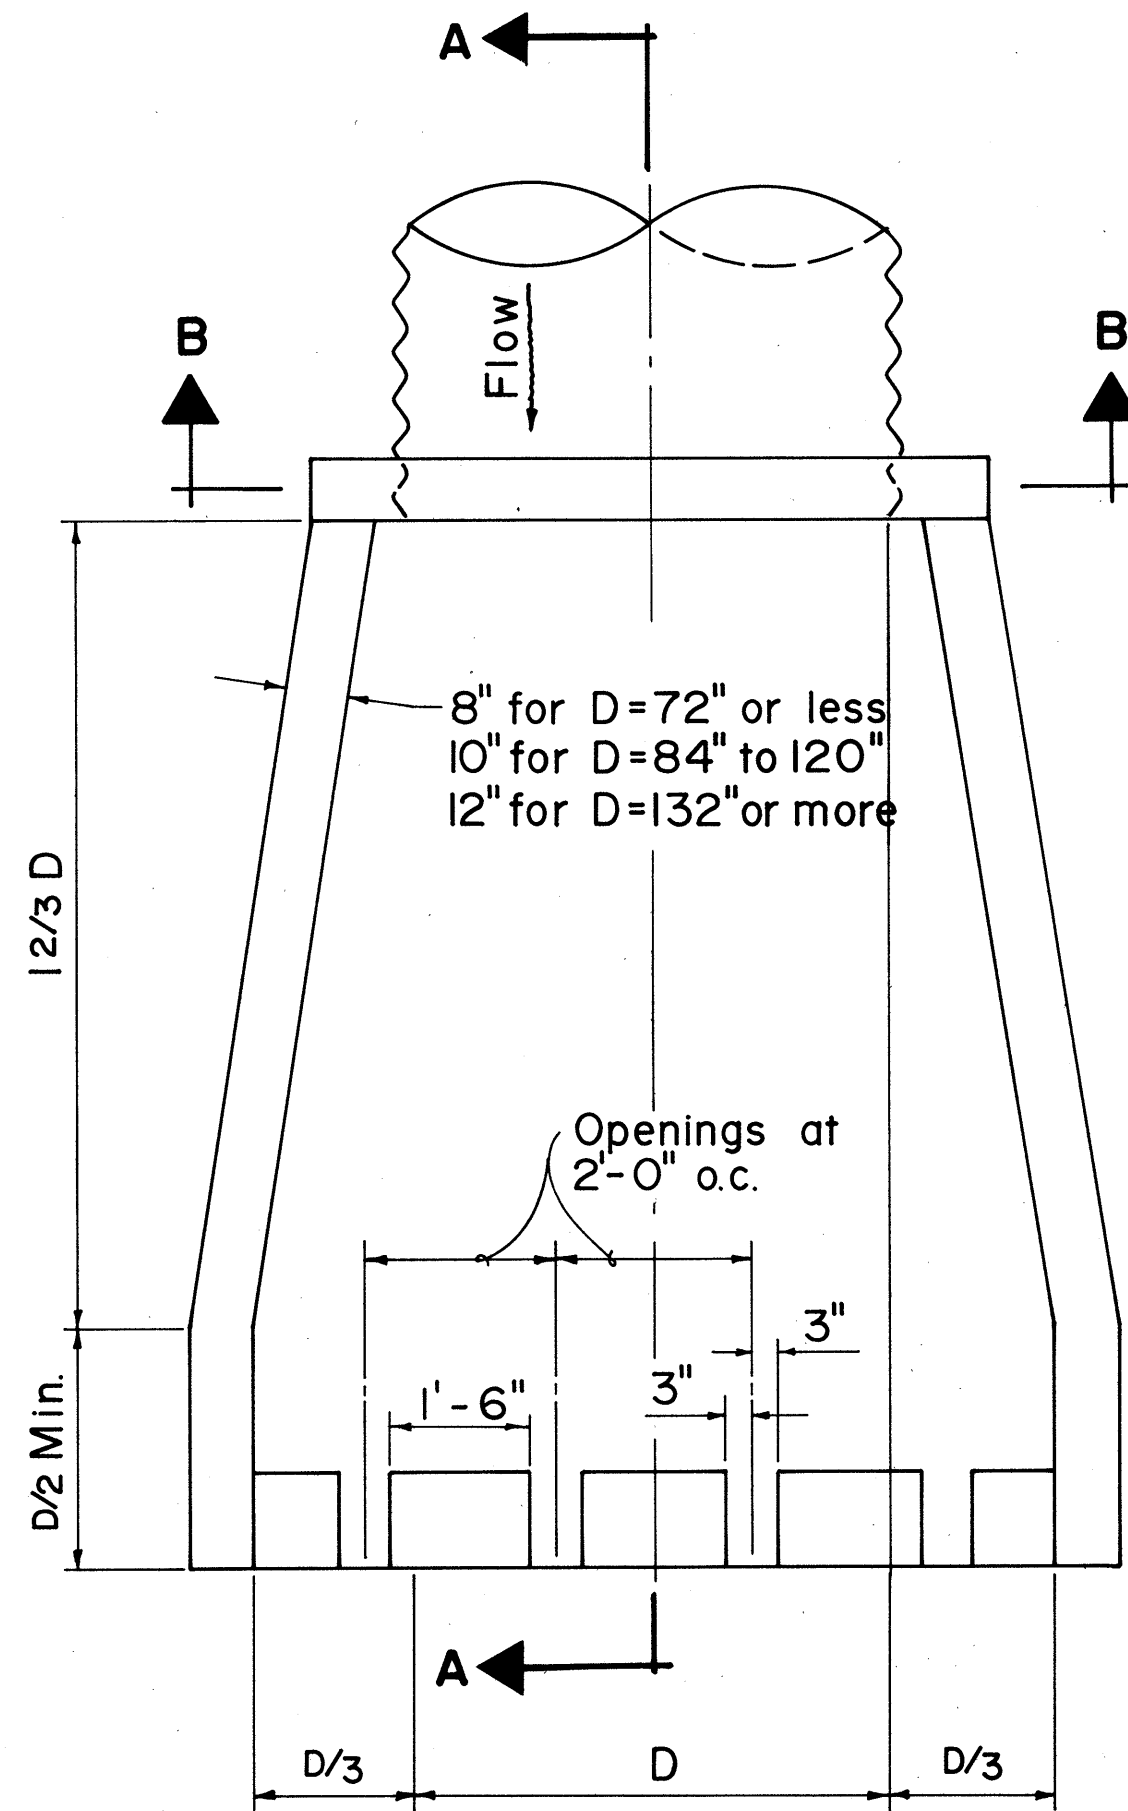

8" WING WALL 10" TO 12" WING WALLS

TYPICAL WING WALL REINFORCING

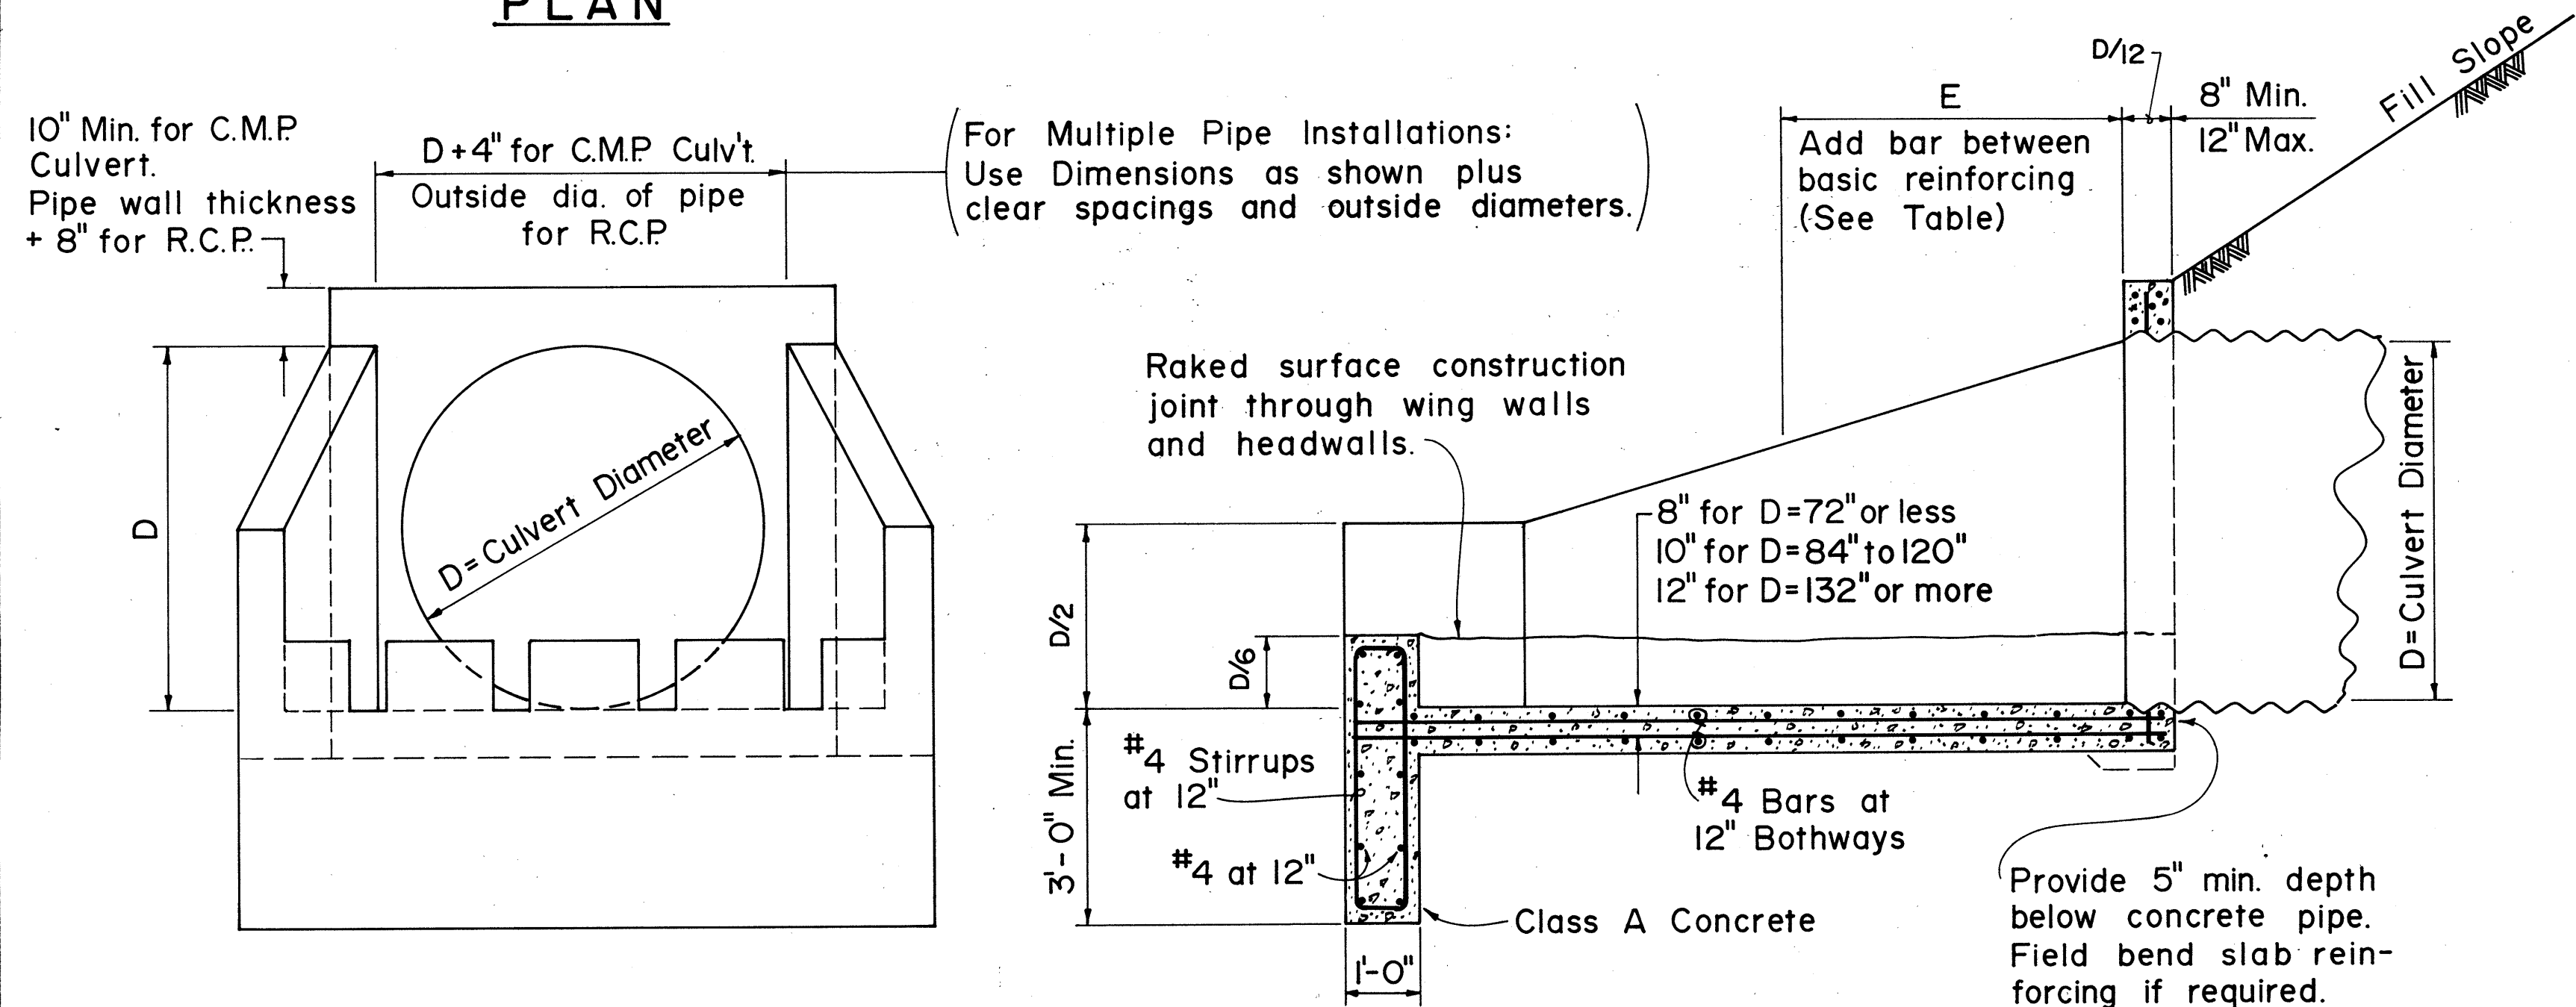

CULVERT DIA. (INCHES)	ADD BAR SIZE	E (FEET)
108	#4	3
120	#4	5
144	#5	8
180	#7	11

ADDITIONAL REINFORCING

APPROVAL RECOMMENDED:

P. Sakano 6-19-79
HYDRAULIC DESIGN ENGINEER DATE

APPROVED:

Harbert Zaleishi 6-22-79
ASSISTANT CHIEF, ENGINEERING DATE

NO.	REVISION	APPROVED BY	DATE
1.	Supersedes Sht. DH 15 approved 12-17-69	H.P.	6/22/79

STATE OF HAWAII
DEPARTMENT OF TRANSPORTATION
HIGHWAYS DIVISION

STANDARD DETAILS

OUTLET STRUCTURE

Not To Scale Date: Dec. 1977

SHEET NO. 14 OF 16 SHEETS DH 15



ORIGINAL PLAN	DATE
SURVEY PLOTTED BY	
DESIGNED BY	
TRACED BY	
NOTE BOOK	
DESIGNED BY	
QUANTITIES BY	
CHECKED BY	
No.	

OUTLET STRUCTURE FOR CULVERT SIZES 48 IN. TO 180 IN. DIAMETER

FED. ROAD DIST. NO.	STATE	FED. AID PROJ. NO.	FISCAL YEAR	SHEET NO.	TOTAL SHEETS
HAWAII	HAW.	F-030-101	1981	51	92

GENERAL NOTES

- All 3pc. bodies to have 0.109" thick sides and 0.138" thick center panels. Width of center panels to be greater than 20% of the pipe periphery. Multiple panel bodies to have lap seams which are to be tightly joint by 3/8" galvanized rivets or bolts.
- Reinforced edges to be supplemented with galvanized stiffener angles for the 60" thru 84" round, 77"x 52" and 83"x 57" pipe - arch sizes. The angles will be 2"x 2" x 1/4" for the 60" thru 72" round, 77"x 52" and 83"x 57" pipe - arch sizes and 2 1/2" x 2 1/2" x 1/4" for 78" and 84" round. The angles to be attached by 3/8" galvanized nuts and bolts.
- Angle reinforcement will be placed under the center panel seams on the 77" x 52" and 83" x 57" pipe - arch sizes.
- Galvanized toe plate to be available as an accessory when specified.
- End of pipe to be finished with annular corrugations to conform to flared end section so that no leakage results from the connection. Other designs may be used with approval of the Engineer.
- Contractor has the option of using either Type A or B "Precast Concrete Flared End Section".

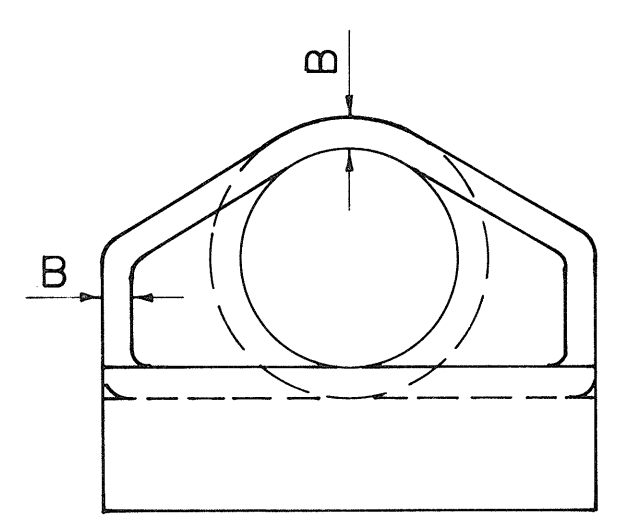
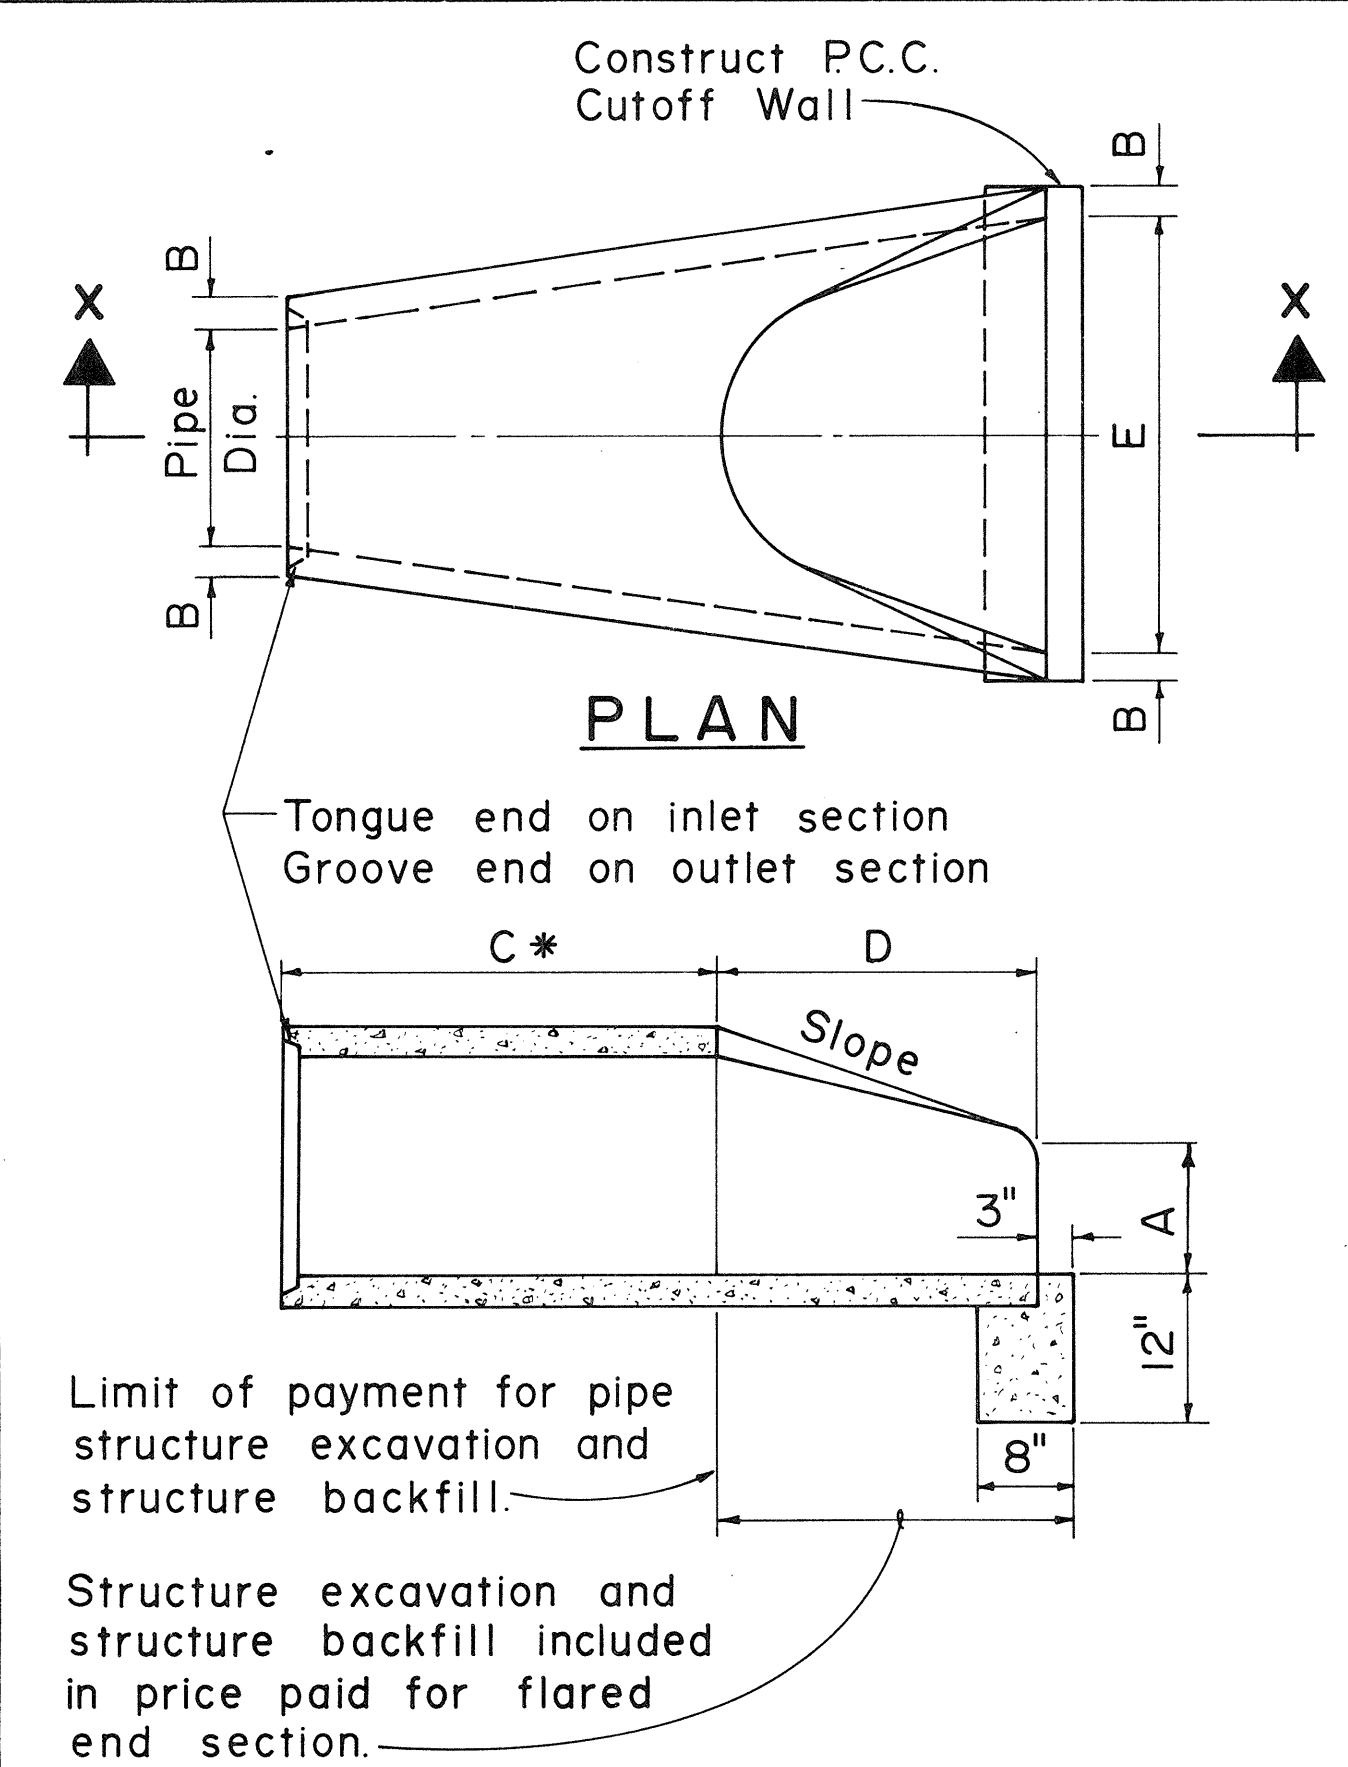


END VIEW

*C dimension shall be as desired by manufacturer and will be paid for at the price paid for concrete pipe.

MINIMUM DIMENSIONS						
PIPE DIA.	A	B	C*	D	E	SLOPE
12"	4"	2"		2'-0"	2'-0"	2:1 or Flatter
18"	9"	2 1/2"		2'-3"	3'-0"	
24"	9 1/2"	3"		3'-7 1/2"	4'-0"	
30"	1'-0"	3 1/2"		4'-6"	5'-0"	
36"	1'-3"	4"		5'-3"	6'-0"	
42"	1'-9"	4 1/2"		5'-3"	6'-6"	
48"	2'-0"	5"		6'-0"	7'-0"	
54"	2'-3"	5 1/2"		5'-5"	7'-6"	

SECTION X-X
PRECAST CONCRETE FLARED END SECTION TYPE A

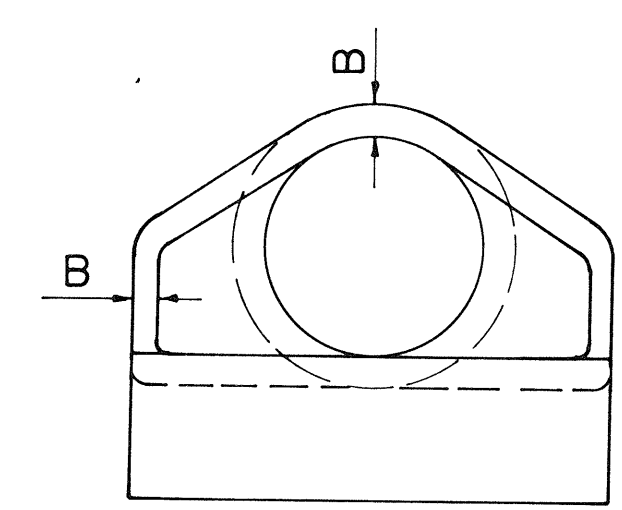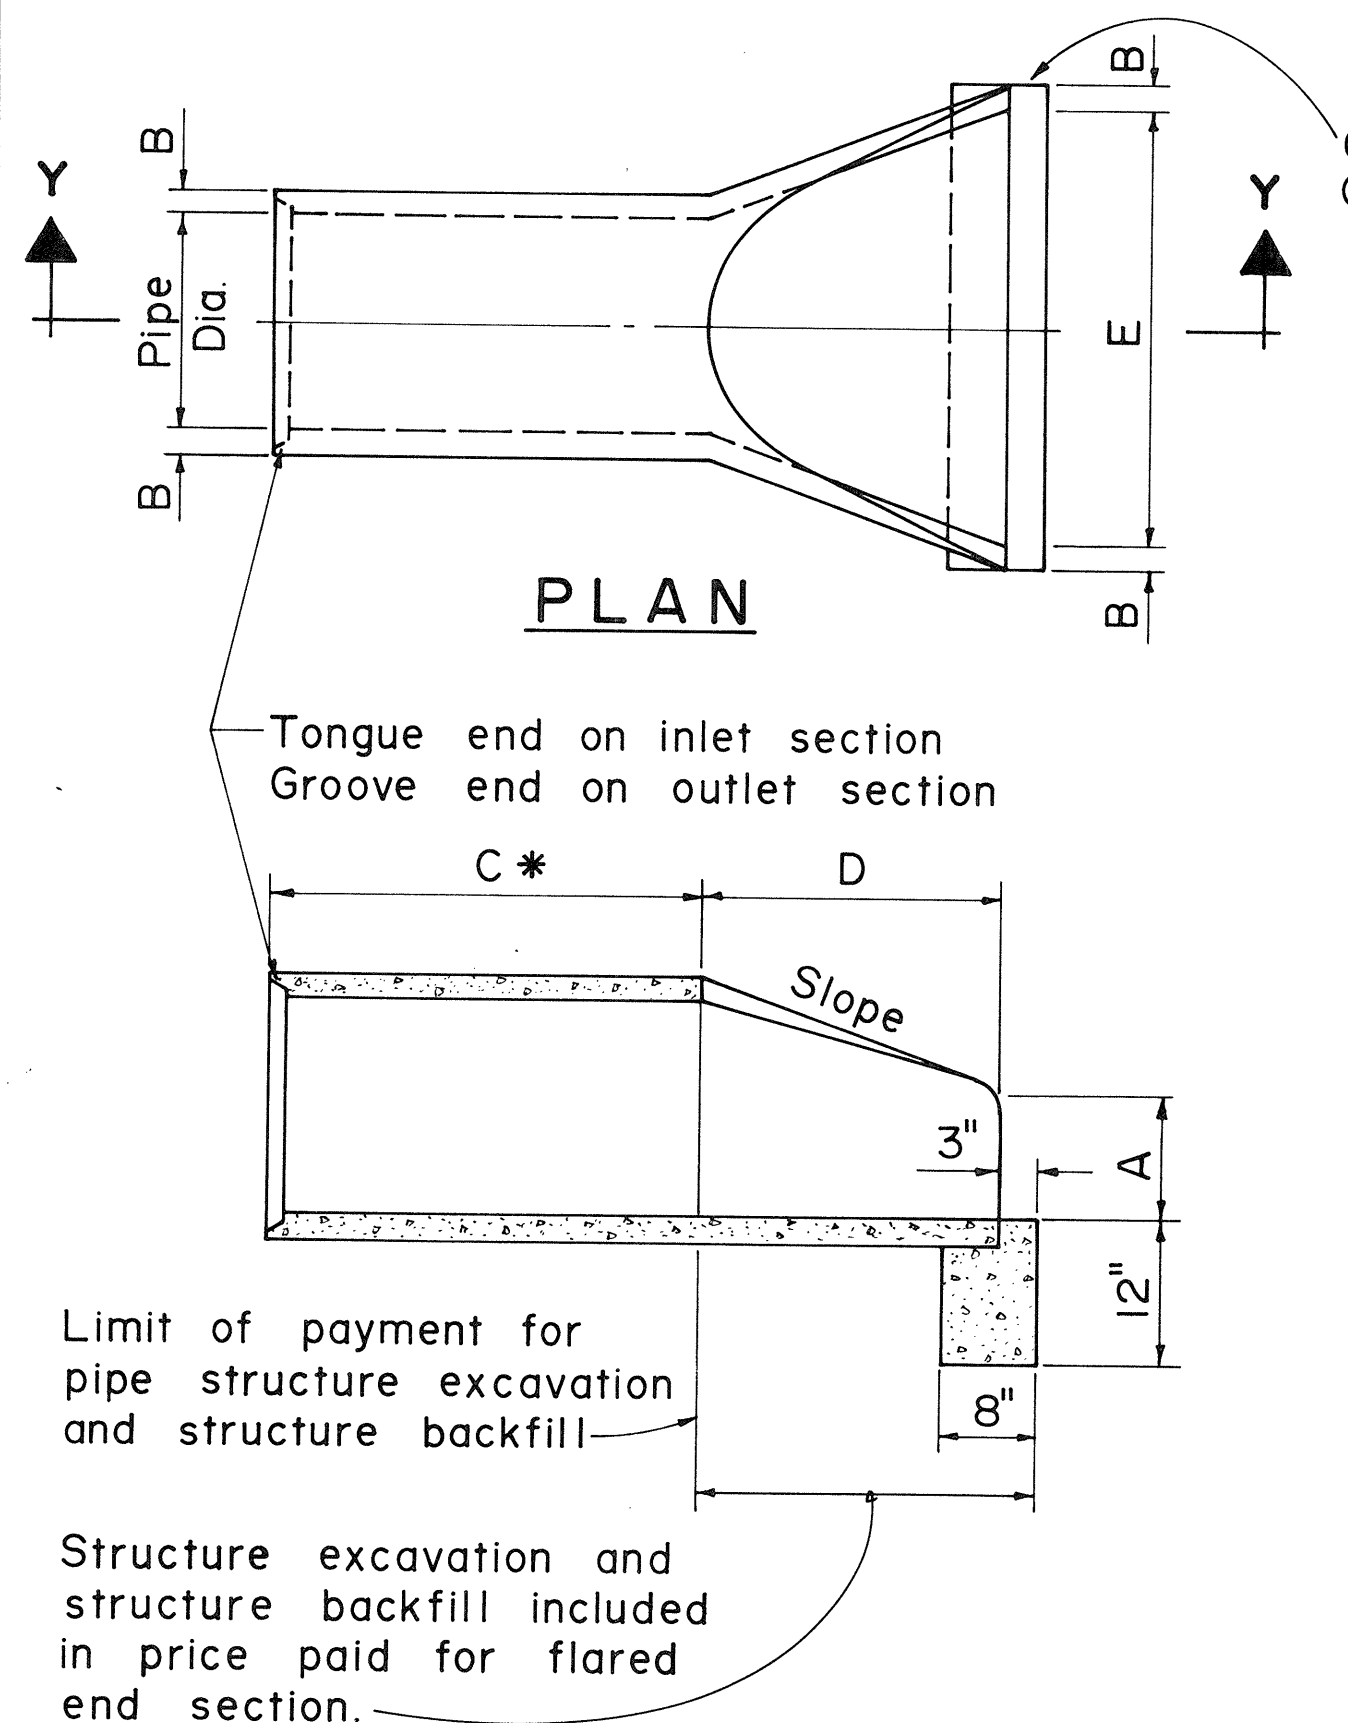


END VIEW

*C dimension shall be as desired by manufacturer and will be paid for at the price paid for concrete pipe.

MINIMUM DIMENSIONS						
PIPE DIA.	A	B	C*	D	E	SLOPE
12"	4"	1 3/4"		1'-10"	2'-0"	2:1 or Flatter
18"	9"	2"		2'-1"	3'-0"	
24"	9 1/2"	2 1/2"		3'-6"	4'-0"	
30"	1'-0"	3"		4'-5"	5'-0"	
36"	1'-3"	3 3/8"		5'-2"	6'-0"	
42"	1'-9"	3 3/4"		5'-3"	6'-6"	
48"	2'-0"	4 1/4"		6'-0"	7'-0"	
54"	2'-3"	4 5/8"		5'-6"	6'-10"	

SECTION Y-Y
PRECAST CONCRETE FLARED END SECTION TYPE B

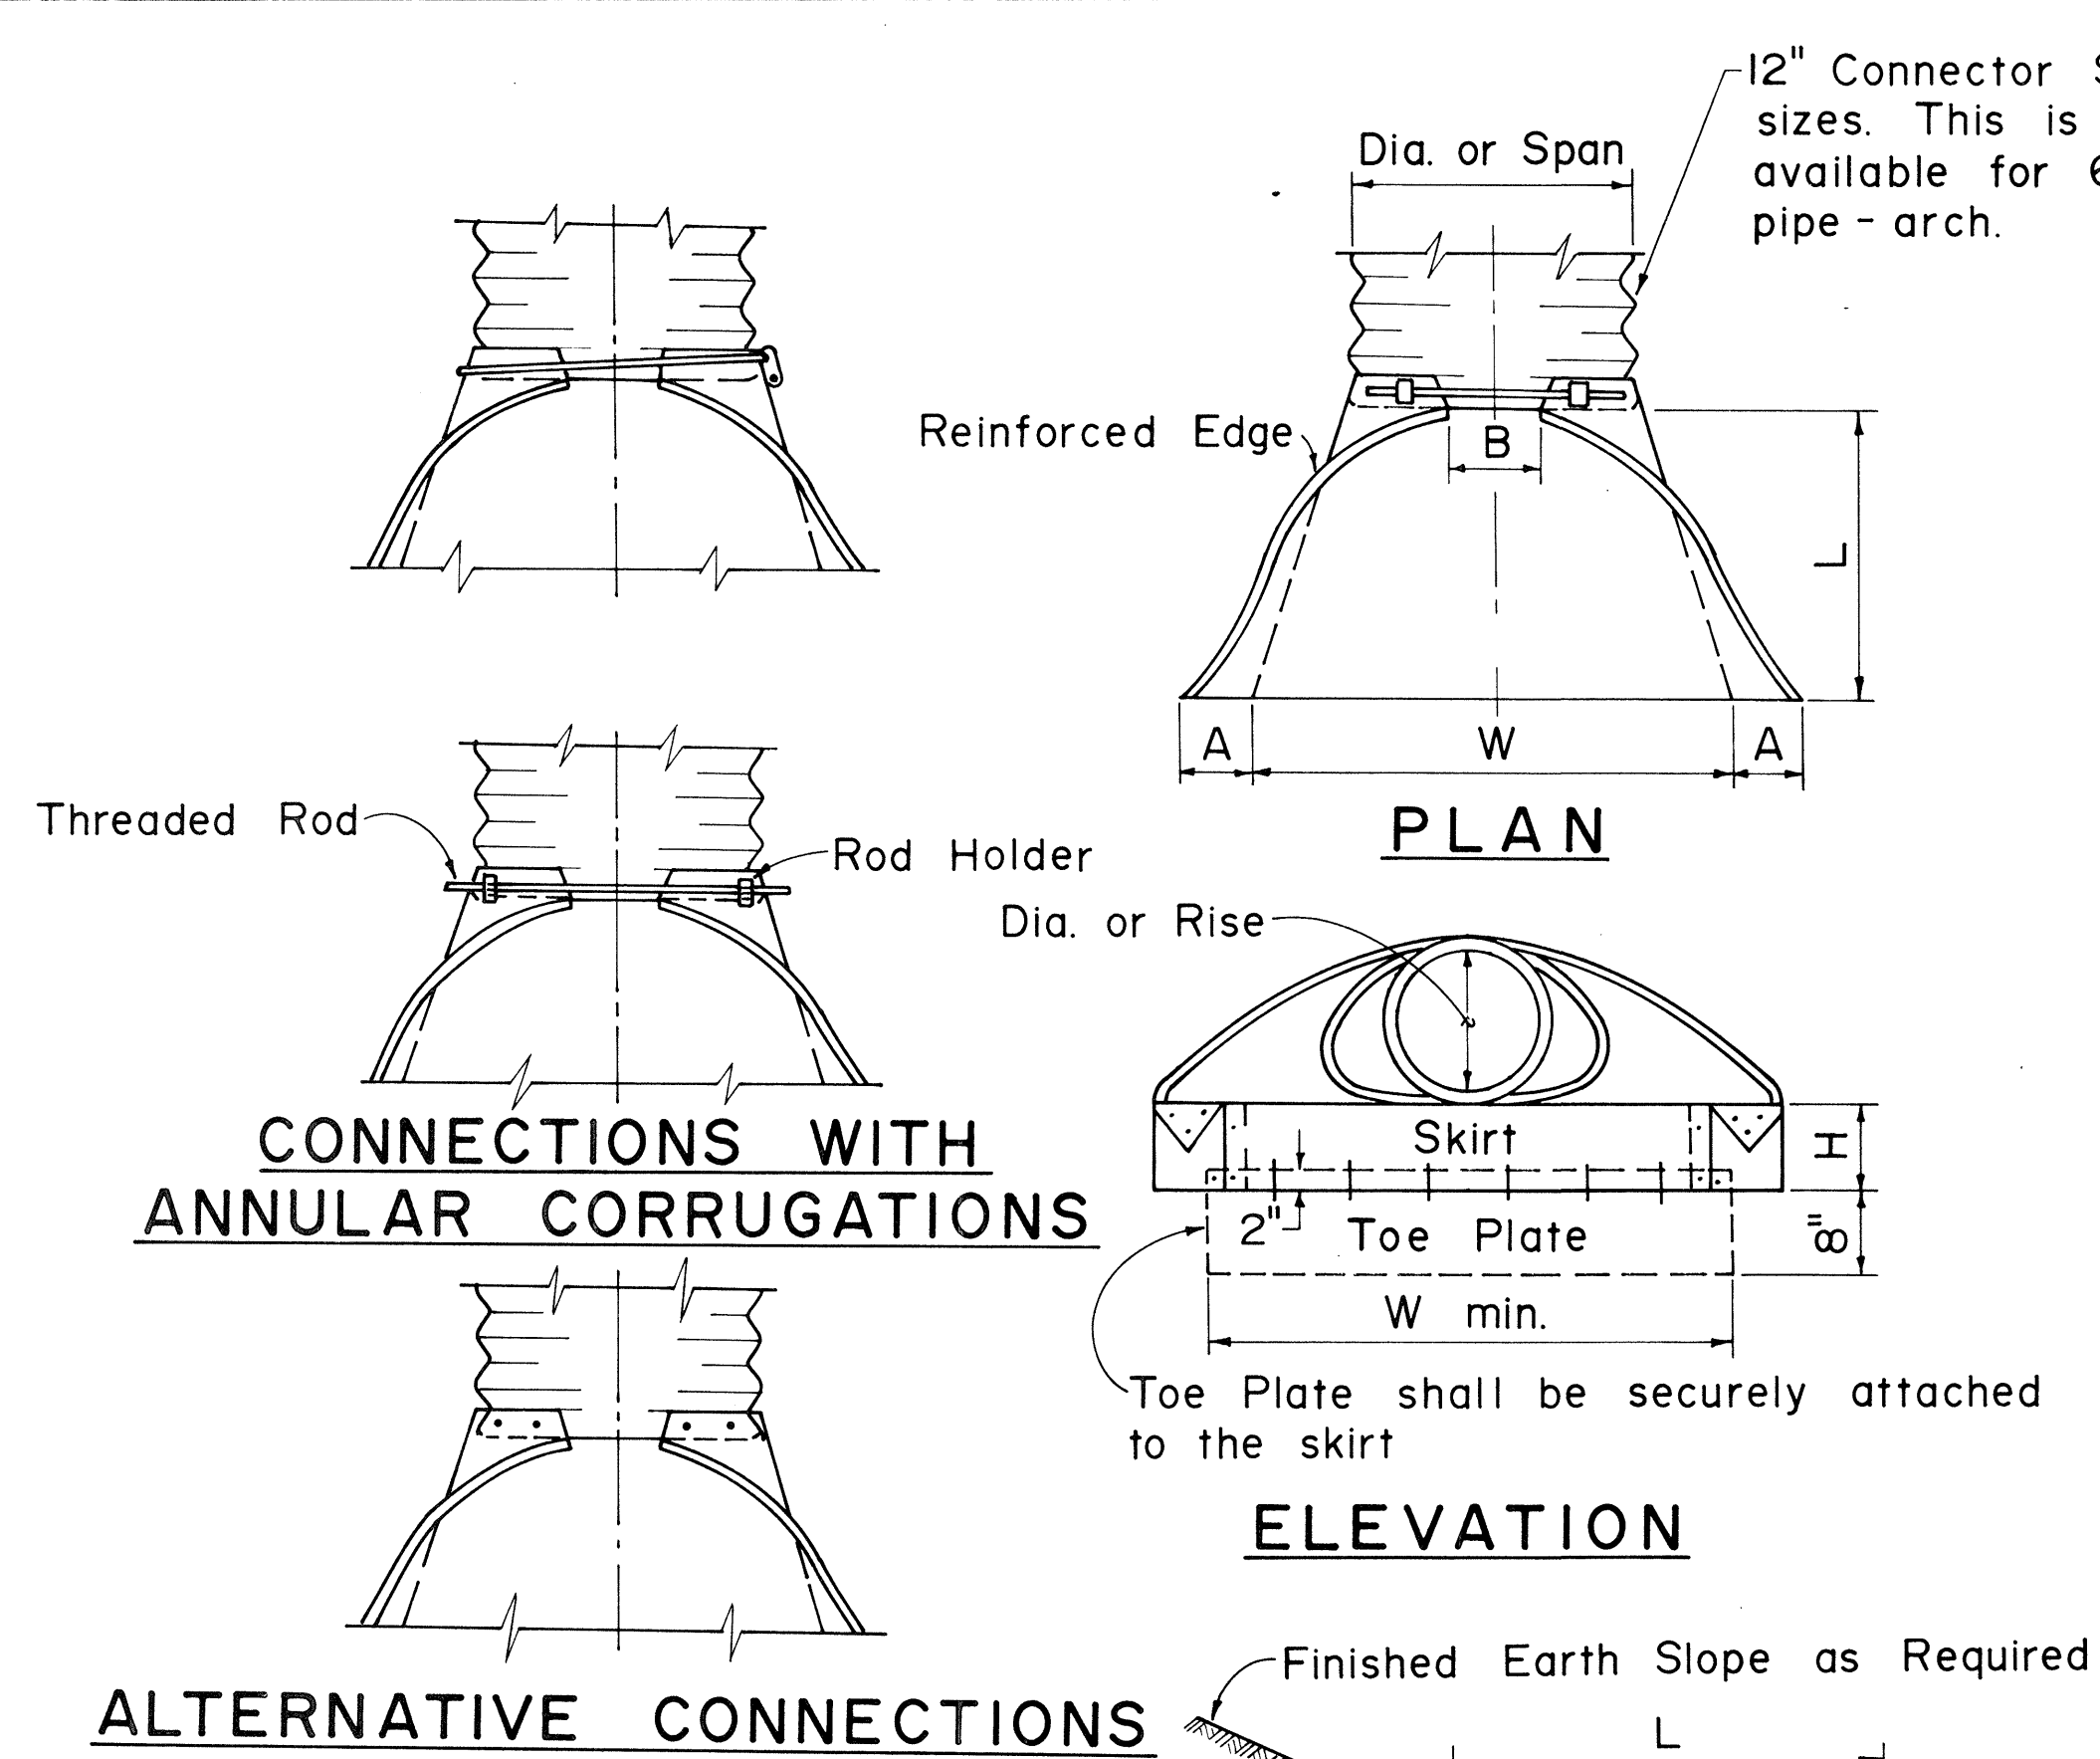

CONNECTIONS WITH
ANNULAR CORRUGATIONS

PLAN

ELEVATION

ALTERNATIVE CONNECTIONS

Limit of payment for pipe structure excavation and structure backfill

Structure excavation and structure backfill included in price paid for flared end section

Toe Plate if required by Special Provisions.

TYPICAL CROSS-SECTION

CIRCULAR PIPES						
PIPE DIA.	THICKNESS	DIMENSIONS-INCHES				
		A	B	H	L	W
		1 ±	MAX	1 ±	1 1/2 ±	2 ±
12"	0.064"	6	6	6	21	24
15"	0.064"	7	8	6	26	30
18"	0.064"	8	10	6	31	36
21"	0.064"	9	12	6	36	42
24"	0.064"	10	13	6	41	48
30"	0.079"	12	16	8	51	60
36"	0.079"	14	19	9	60	72
42"	0.109"	16	22	11	69	84
48"	0.109"	18	27	12	78	90
54"	0.109"	18	30	12	84	102
60"	0.109"	18	33	12	87	114
66"	0.109"	18	36	12	87	120
72"	0.109"	18	39	12	87	126
78"	0.109"	18	42	12	87	132
84"	0.109"	18	45	12	87	138

PIPE - ARCHES							
INCHES		THICKNESS	DIMENSIONS-INCHES				
			A	B	H	L	W
SPAN	RISE		1 ±	MAX	1 ±	1 1/2 ±	2 ±
21	15	0.064"	7	10	6	23	36
24	18	0.064"	8	12	6	28	42
28	20	0.064"	9	14	6	32	48
35	24	0.079"	10	16	6	39	60
42	29	0.079"	12	18	8	46	75
49	33	0.102"	13	21	9	53	85
57	38	0.102"	18	26	12	63	90
64	43	0.102"	18	30	12	70	102
71	47	0.102"	18	33	12	77	114
77	52	0.102"	18	36	12	77	126
83	57	0.102"	18	39	12	77	138

FLARED END SECTIONS FOR C.M.P. CULVERTS

NO.	REVISION	APPROVED BY	DATE
1.	Replaces Sht. DH 14 approved 12-17-69	H.T.	6/22/79

APPROVAL RECOMMENDED:
T. Nakano
HYDRAULIC DESIGN ENGINEER DATE 6-19-79

APPROVED:
Harold Zafraishi
ASSISTANT CHIEF, ENGINEERING DATE 6-22-79

STATE OF HAWAII
DEPARTMENT OF TRANSPORTATION
HIGHWAYS DIVISION

STANDARD DETAILS
FLARED END SECTION
FOR CULVERTS

Not To Scale Date June 1979





SHEET No. 15 OF 16 SHEETS DH 14

ORIGINAL PLAN	DATE
SURVEY PLOTTED BY	
DRAWN BY	
DESIGNED BY	
QUANTITIES BY	
CHECKED BY	


FED. ROAD DIST. NO.	STATE	FED. AID PROJ. NO.	FISCAL YEAR	SHEET NO.	TOTAL SHEETS
HAWAII	HAW.	F-030-1(8)	1981	52	92

GENERAL NOTES

1. All coupling band connection hardware shall be galvanized or electro plated in accordance with Standard Specifications.
2. For pipe arches use same width band as for round pipe of same periphery.
3. Two pieces band required for pipe greater than 48" diameter.
4. Fillet welds of equivalent strengths may be substituted for spot welds or rivets.
5. Dimensions and thickness shown are in inches and are nominal.
6. Band thickness shall be not more than 2 standard thicknesses lighter than the thickness of the pipe, and, in no case shall be lighter than 0.079 inch.

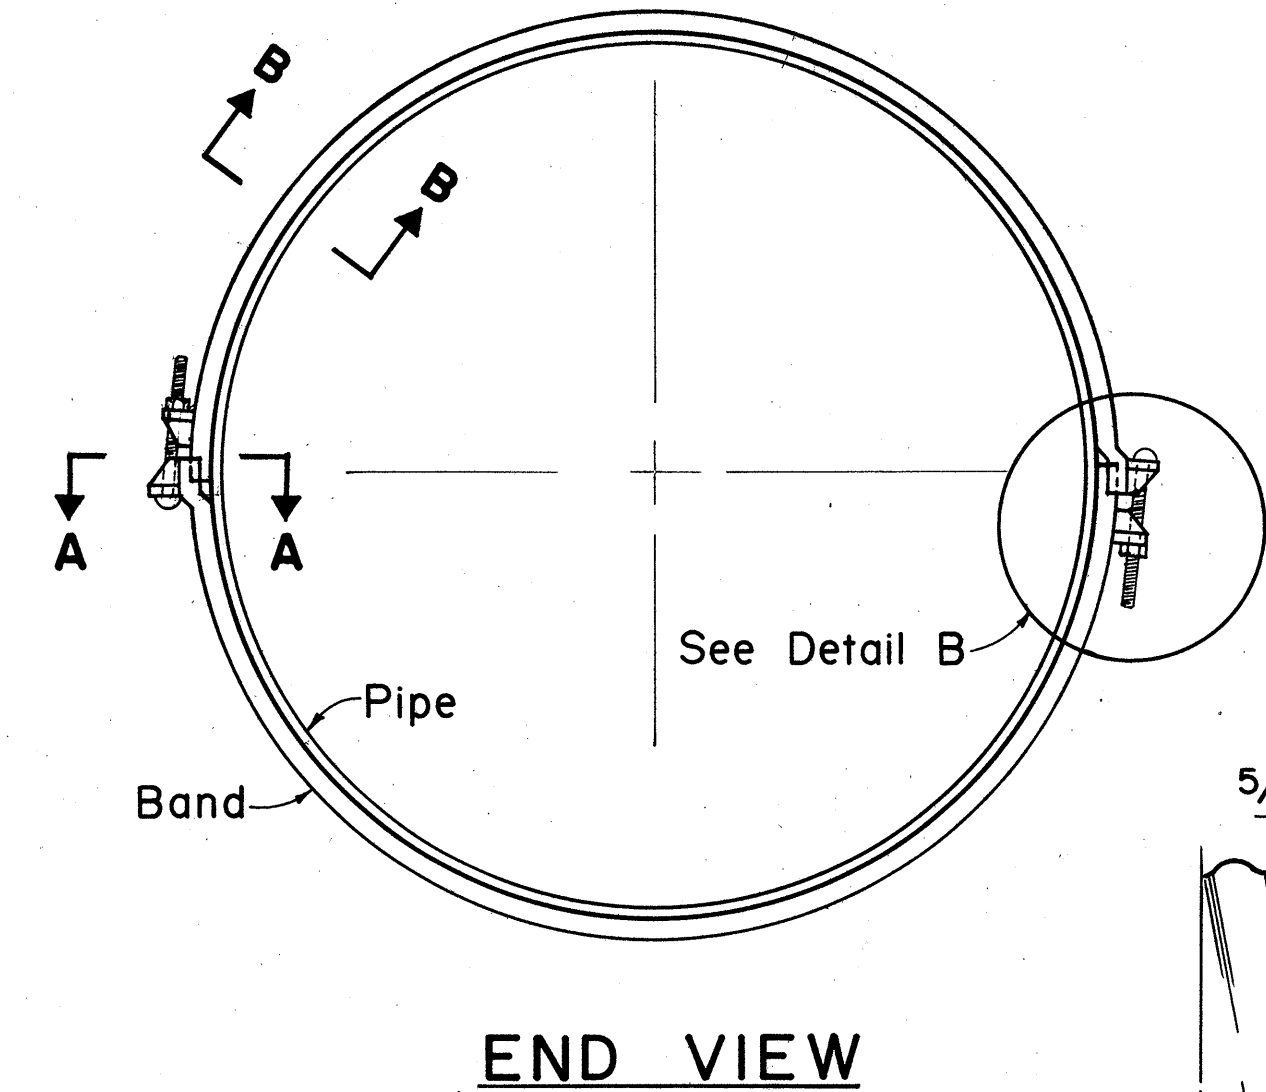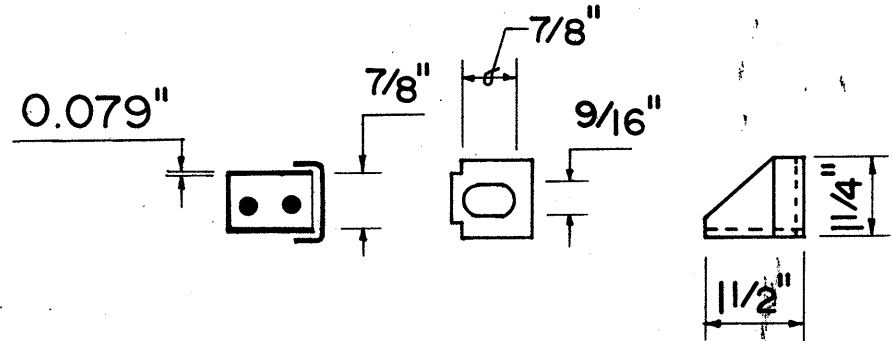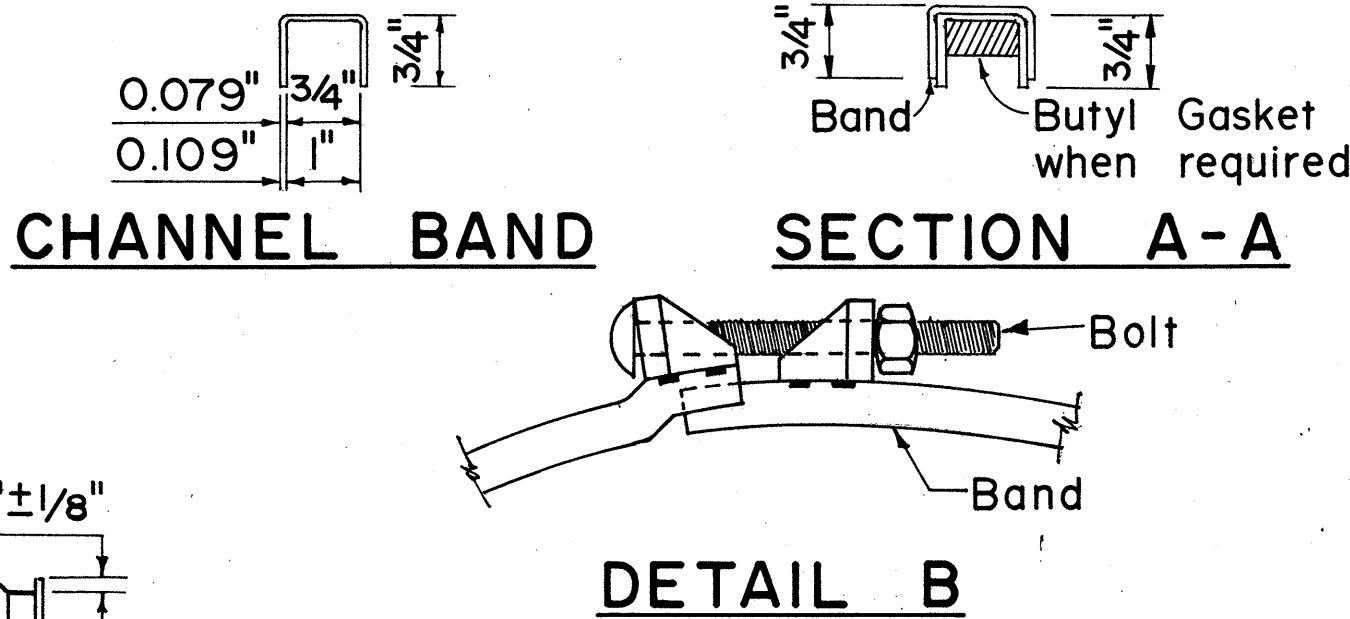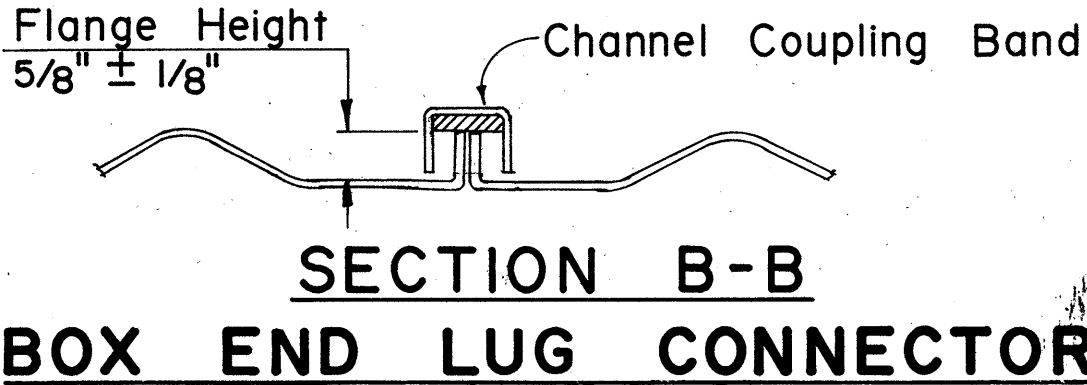


REFORMED END CHANNEL COUPLING BAND FOR USE ON REFORMED END C.M.P.

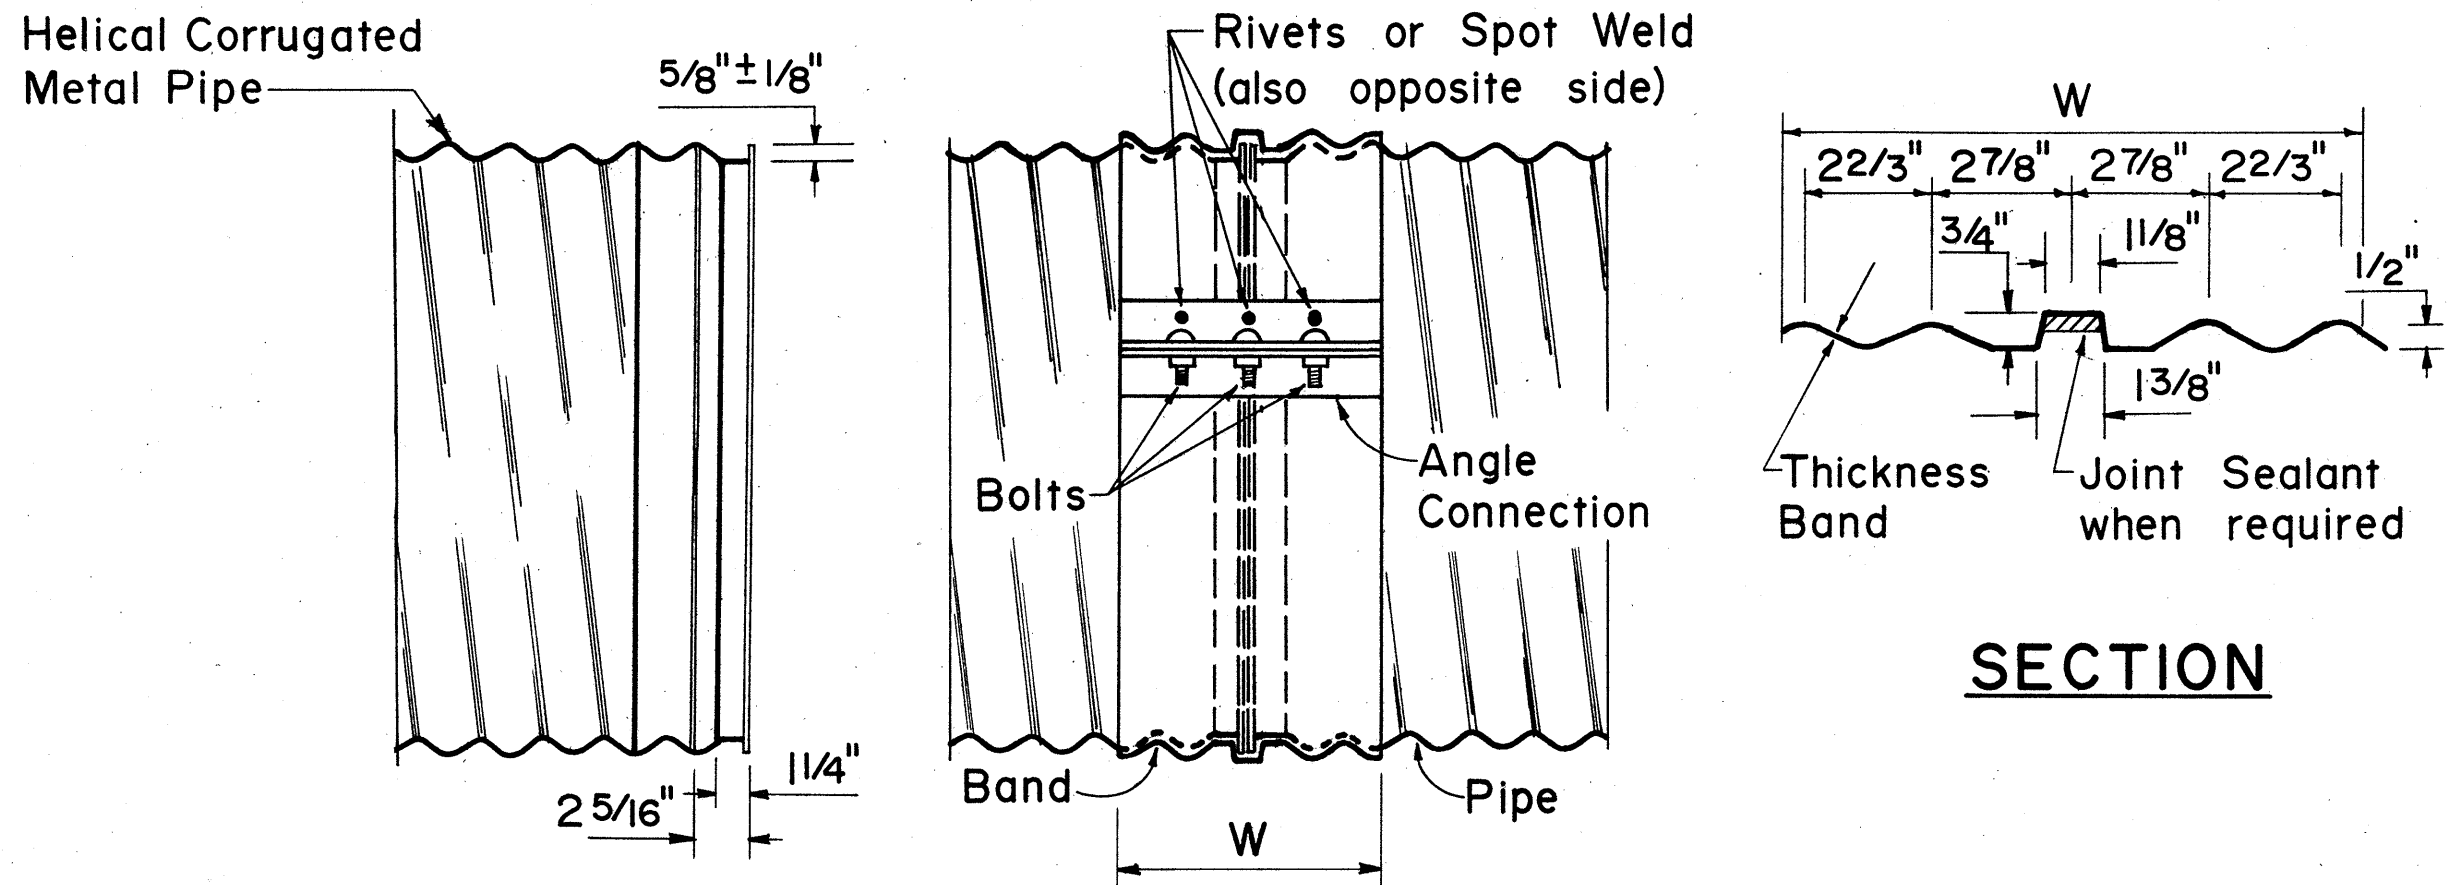


REFORMED END SIDE VIEW

WING CHANNEL COUPLING BAND FOR REFORMED END H.C.M.P.

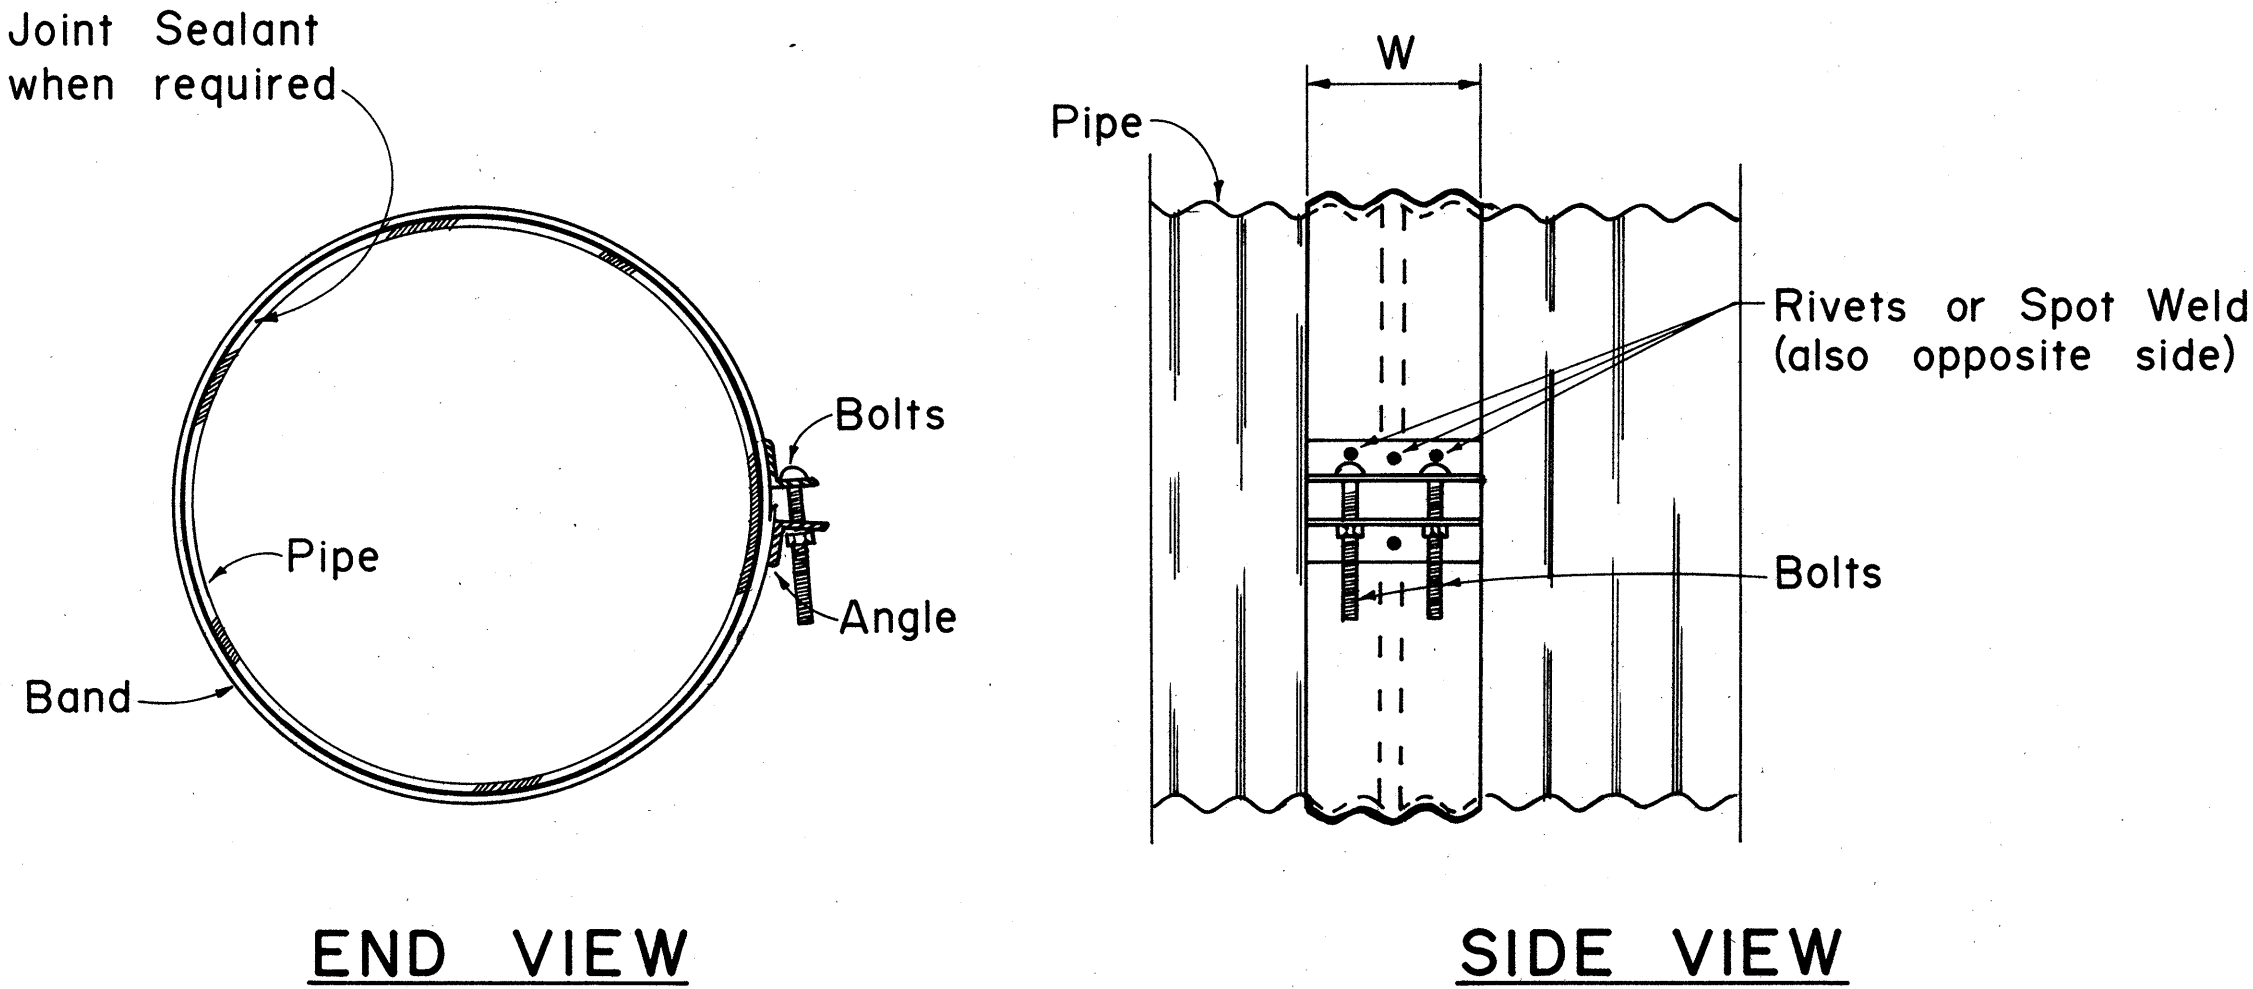

ANNULAR COUPLING BAND

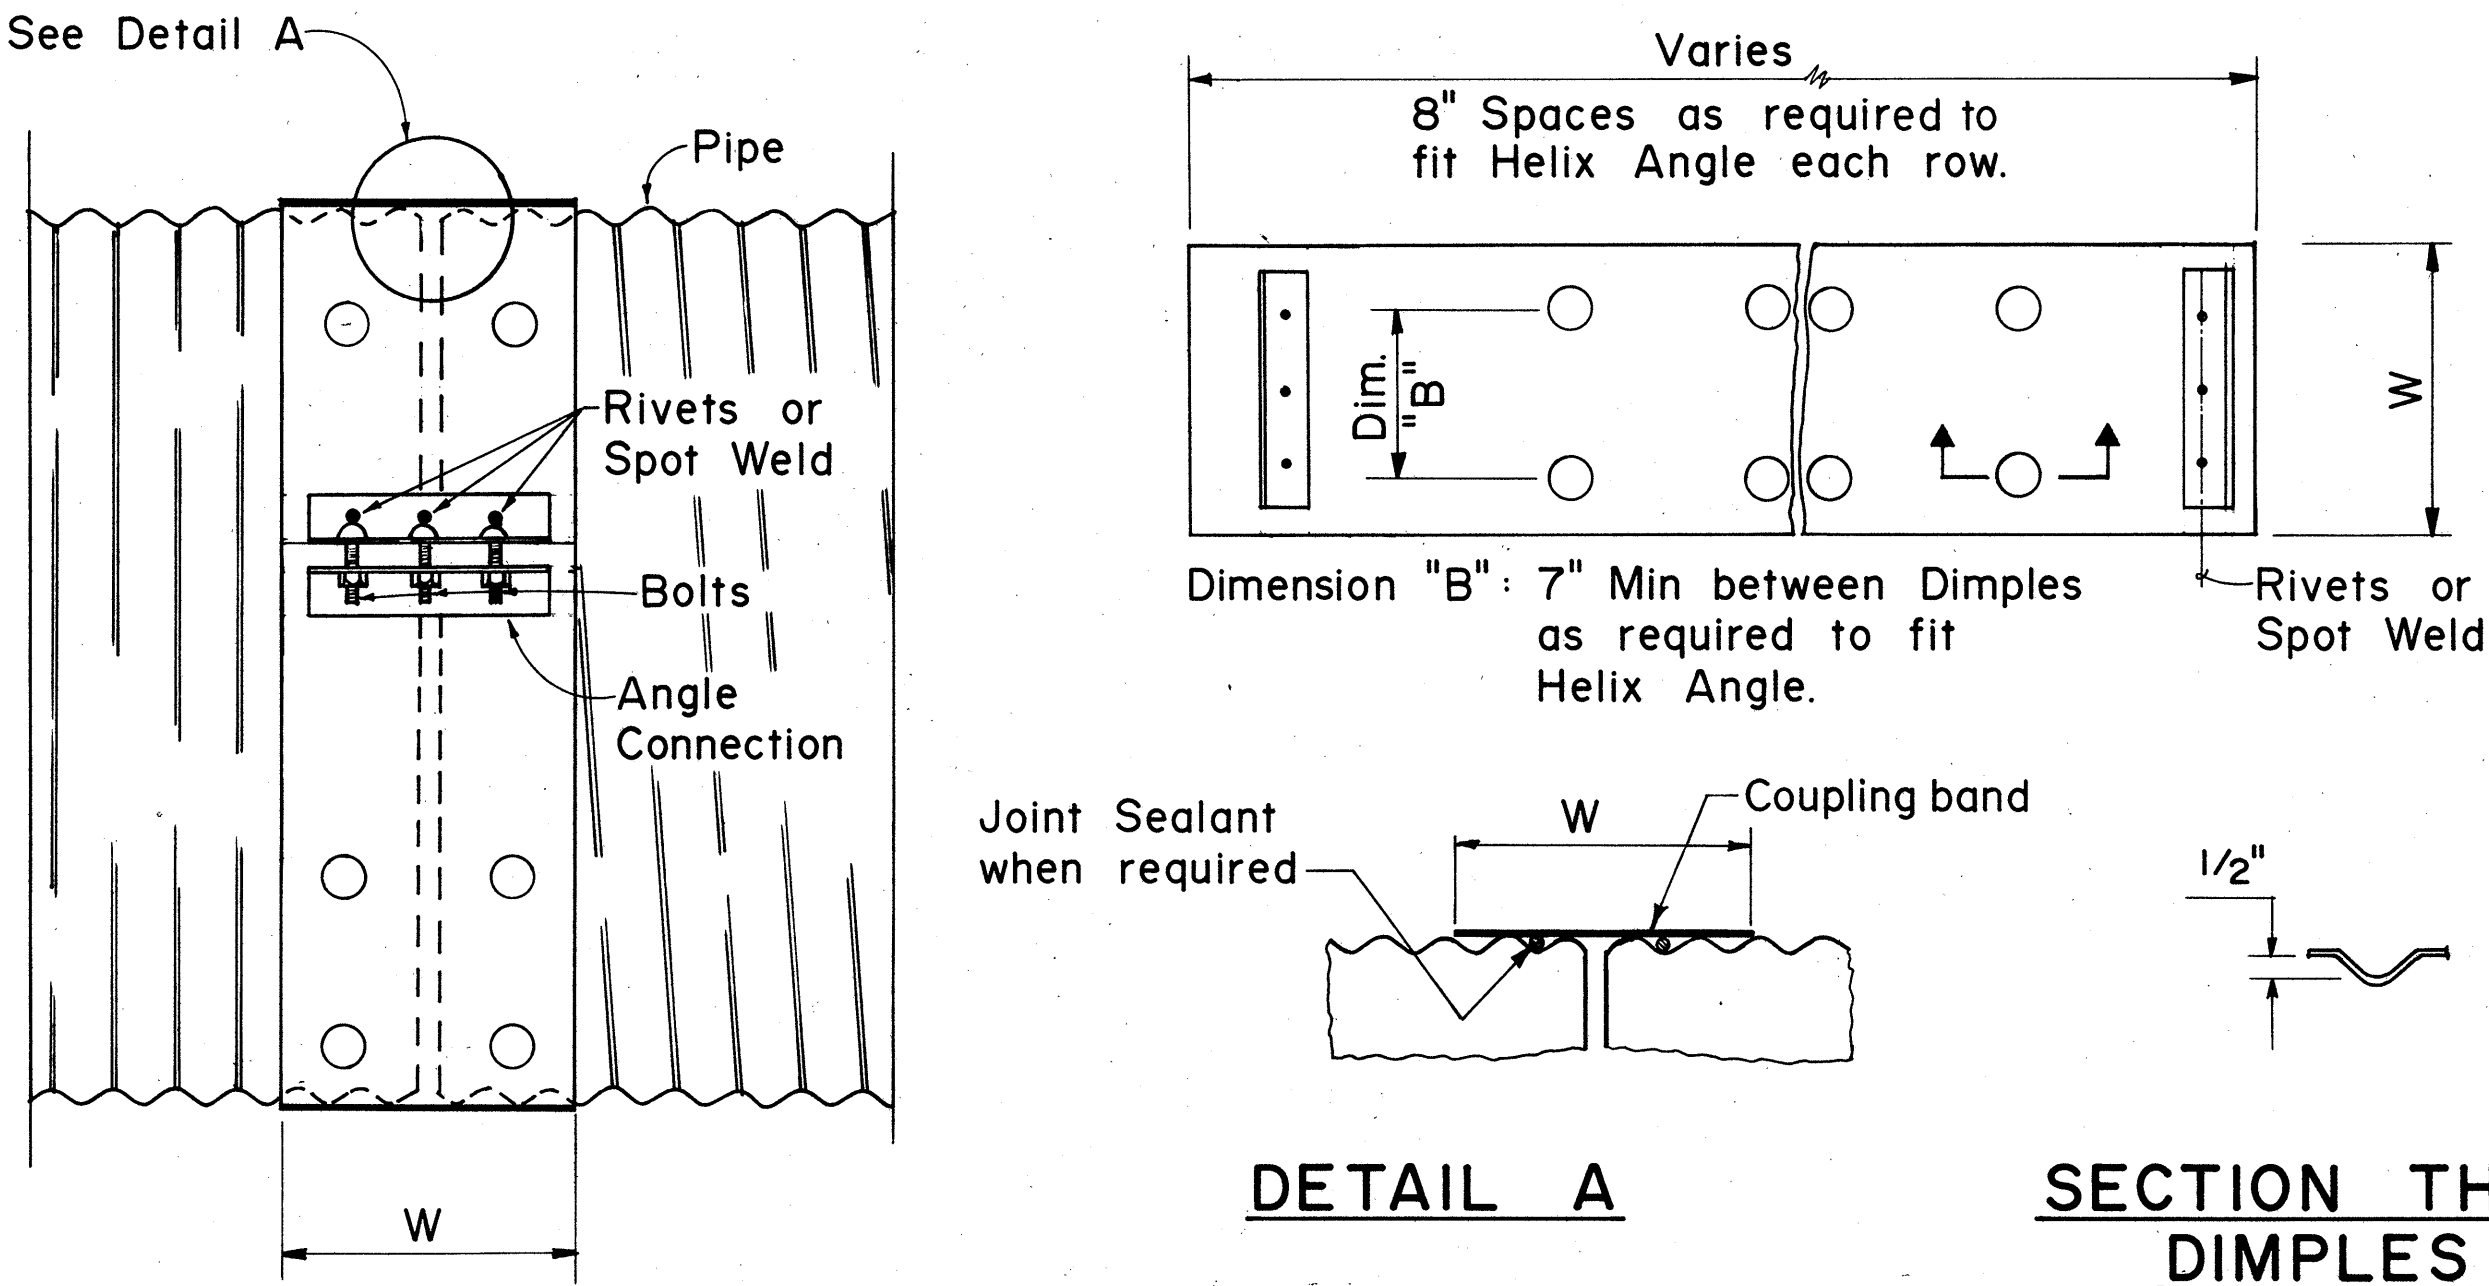

UNIVERSAL COUPLING BAND ANGLE CONNECTION

COUPLING TYPE	CORRUGATION	PIPE SIZE	W	PIPE WALL THICKNESS	ANGLE CONNECTIONS-QUANTITIES PER CONNECTION			
					DIMENSIONS	BOLTS	RIVETS	SPOT WELD
UNIVERSAL	22 2/3 x 1/2	12 - 36	10 1/2	0.079-0.138	2 ea 2 x 2 x 3/16 x 7	2 ea 1/2 x 6	3 ea 3/8	3 ea 1/2
		42 - 60	16 1/2	0.168	2 ea 2 x 2 x 3/16 x 12	3 ea 1/2 x 6	4 ea 3/8	5 ea 1/2
		66 - 84	16 1/2	0.168	2 ea 2 x 2 x 3/16 x 12	3 ea 1/2 x 6	4 ea 3/8	
	3 x 1	36 - 72	10 1/2	0.079-0.138	2 ea 2 x 2 x 3/16 x 7	2 ea 1/2 x 6	3 ea 3/8	
		78 - 120	16 1/2	0.079-0.138	2 ea 2 x 2 x 3/16 x 12	3 ea 1/2 x 6	4 ea 3/8	
ANNULAR	22 2/3 x 1/2	12 - 36	7	0.079-0.138	2 ea 2 x 2 x 3/16 x 7	2 ea 1/2 x 6	3 ea 3/8	3 ea 1/2
		42 - 72	12	0.079-0.168	2 ea 2 x 2 x 3/16 x 12	3 ea 1/2 x 6	4 ea 3/8	5 ea 1/2
		78 - 84	12	0.168	2 ea 2 x 2 x 3/16 x 12	3 ea 1/2 x 6	4 ea 3/8	5 ea 1/2
	3 x 1	36 - 42	14	0.079-0.109	2 ea 2 x 2 x 3/16 x 12	3 ea 1/2 x 6	4 ea 3/8	
		48 - 84	14	0.079-0.109	2 ea 2 x 2 x 3/16 x 12	3 ea 1/2 x 6	4 ea 3/8	5 ea 1/2
		90 - 120	14	0.079-0.109	2 ea 2 x 2 x 3/16 x 12	3 ea 1/2 x 6	4 ea 3/8	

COUPLING TYPE	CORRUGATION	PIPE SIZE	W	PIPE WALL THICKNESS	LUG TYPE CONNECTORS-QUANTITIES PER CONNECTION		
					DIMENSIONS	BOLTS	SPOT WELD
CHANNEL	22 2/3 x 1/2	12 - 72		0.079-0.138	2 ea Lugs	1 ea 1/2 x 6	4 ea 1/2
	3 x 1	36 - 72		0.079-0.138	2 ea Lugs	1 ea 1/2 x 6	4 ea 1/2
WING	22 2/3 x 1/2	12 - 72	12	0.079-0.138	6 ea Lugs	3 ea 1/2 x 6	12 ea 1/2
		78 - 84	12	0.168	6 ea Lugs	3 ea 1/2 x 6	12 ea 1/2
	3 x 1	36 - 120	12	0.079-0.109	6 ea Lugs	3 ea 1/2 x 6	12 ea 1/2

APPROVAL RECOMMENDED:

P. Takano 9-7-79
HYDRAULIC DESIGN ENGINEER DATE

APPROVED:

Shuhent Z. Zafarshi 9-14-79
ASSISTANT CHIEF, ENGINEERING DATE

NO.	REVISION	APPROVED BY	DATE

STATE OF HAWAII
DEPARTMENT OF TRANSPORTATION
HIGHWAYS DIVISION

STANDARD DETAILS
C.M.P. COUPLING DETAILS
STANDARD JOINT

Not To Scale Date: Sept. 1979

SHEET No. 16 OF 16 SHEETS DH 18

ORIGINAL PLAN	DATE
DESIGNED BY	
TRACED BY	
NOTED BY	
CHECKED BY	