


INDEX TO DRAWINGS	
SHEET NO.	DESCRIPTION
1	TITLE SHEET
2-3	TYPICAL SECTIONS
4-7	PLAN & PROFILE
8-9	SUPERELEVATION DIAGRAMS
10-11	BORING LOGS
12-20	DETAIL PLAN OF ROADWAY
21-28	ROADWAY STANDARD DETAILS
29-31	DRAINAGE SUMMARY
32-36	DRAINAGE PLAN
37-52	DRAINAGE DETAILS
53-57	SIGNING & PAVEMENT MARKINGS
58-78	SIGNING & PAVEMENT DETAILS
79-81	EROSION CONTROL PLAN
82-92	CROSS SECTIONS
C.O.42A, C.O.42B	DRAINAGE DETAILS
C.O.42C, C.O.42D	DRAINAGE PLAN
NEW TOTAL 138 SHEETS	

STATE OF HAWAII
DEPARTMENT OF TRANSPORTATION
HIGHWAYS DIVISION
HONOLULU, HAWAII
"AS BUILT"
PLANS FOR
HONOAPIILANI HIGHWAY
ALAELOA TO PINEAPPLE HILL
PROJECT NO. F-030-1(8)

DISTRICT OF LAHAINA
ISLAND OF MAUI

SCALES		
PLAN		1" = 100'
PROFILE	HOR.	1" = 100'
	VER.	1" = 10'
CROSS SECTIONS	HOR.	1" = 40'
	VER.	1" = 40'

GROSS LENGTH OF PROJECT	1.06 MILES
BRIDGES OVER 20'-0" SPAN	0.00 MILES
NET LENGTH OF ROADWAY	1.06 MILES

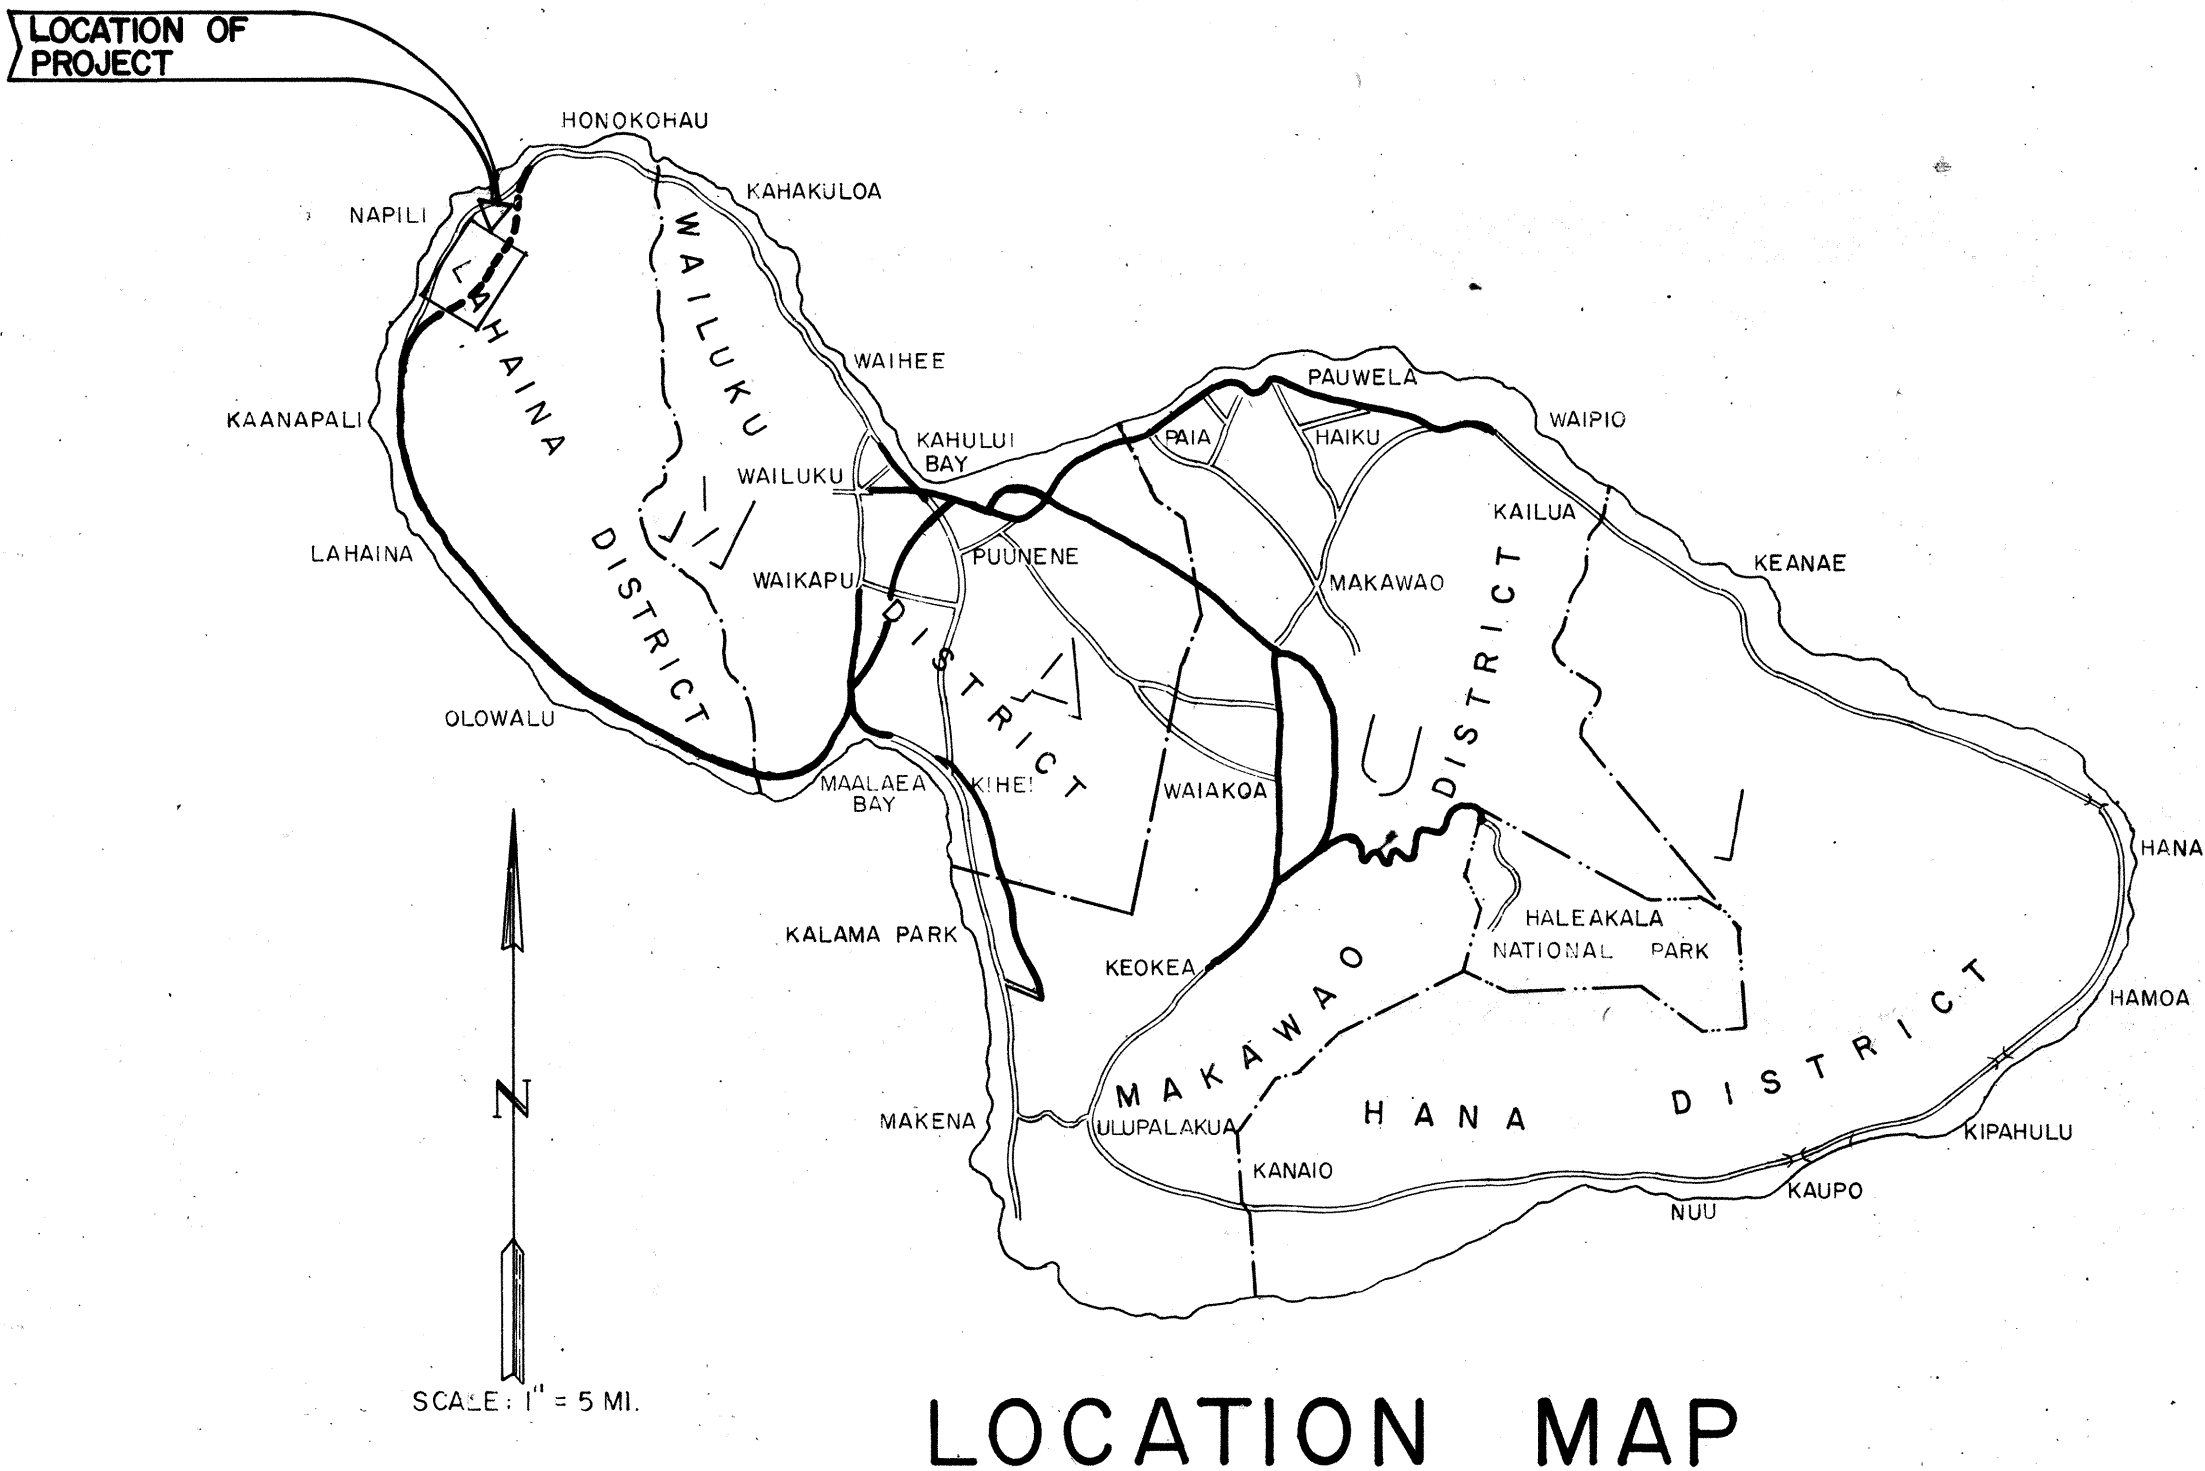

FEDERAL AID PROJECTS PREVIOUSLY CONSTRUCTED OR UNDER CONSTRUCTION

DESIGN DESIGNATION	
ADT (1981)	10,929
ADT (2001)	22,662
DHV	1,360
D	55/45
T	4.0
T24	6.0
V	60 MPH

CHANGES MADE DURING CONSTRUCTION HAVE BEEN INCORPORATED ON THESE PLANS EXCEPT CHANGES IN THE ORIGINAL THEORETICAL QUANTITIES. FOR ACTUAL QUANTITIES, REFER TO PROJECT LEDGER AND/OR COMPUTATION BOOK.

Manuel J. Silva
RESIDENT ENGINEER

25 April 84
DATE

DEPARTMENT OF TRANSPORTATION
FEDERAL HIGHWAY ADMINISTRATION

APPROVED:

DEPARTMENT OF TRANSPORTATION
STATE OF HAWAII

APPROVED:

TRANS-MERIDIAN ENGINEERS
& SURVEYORS, INC.
DESIGNED BY

L. CHAR
P. S. & E. BY

548-7532
PHONE

SEPT. 1981
DATE

