
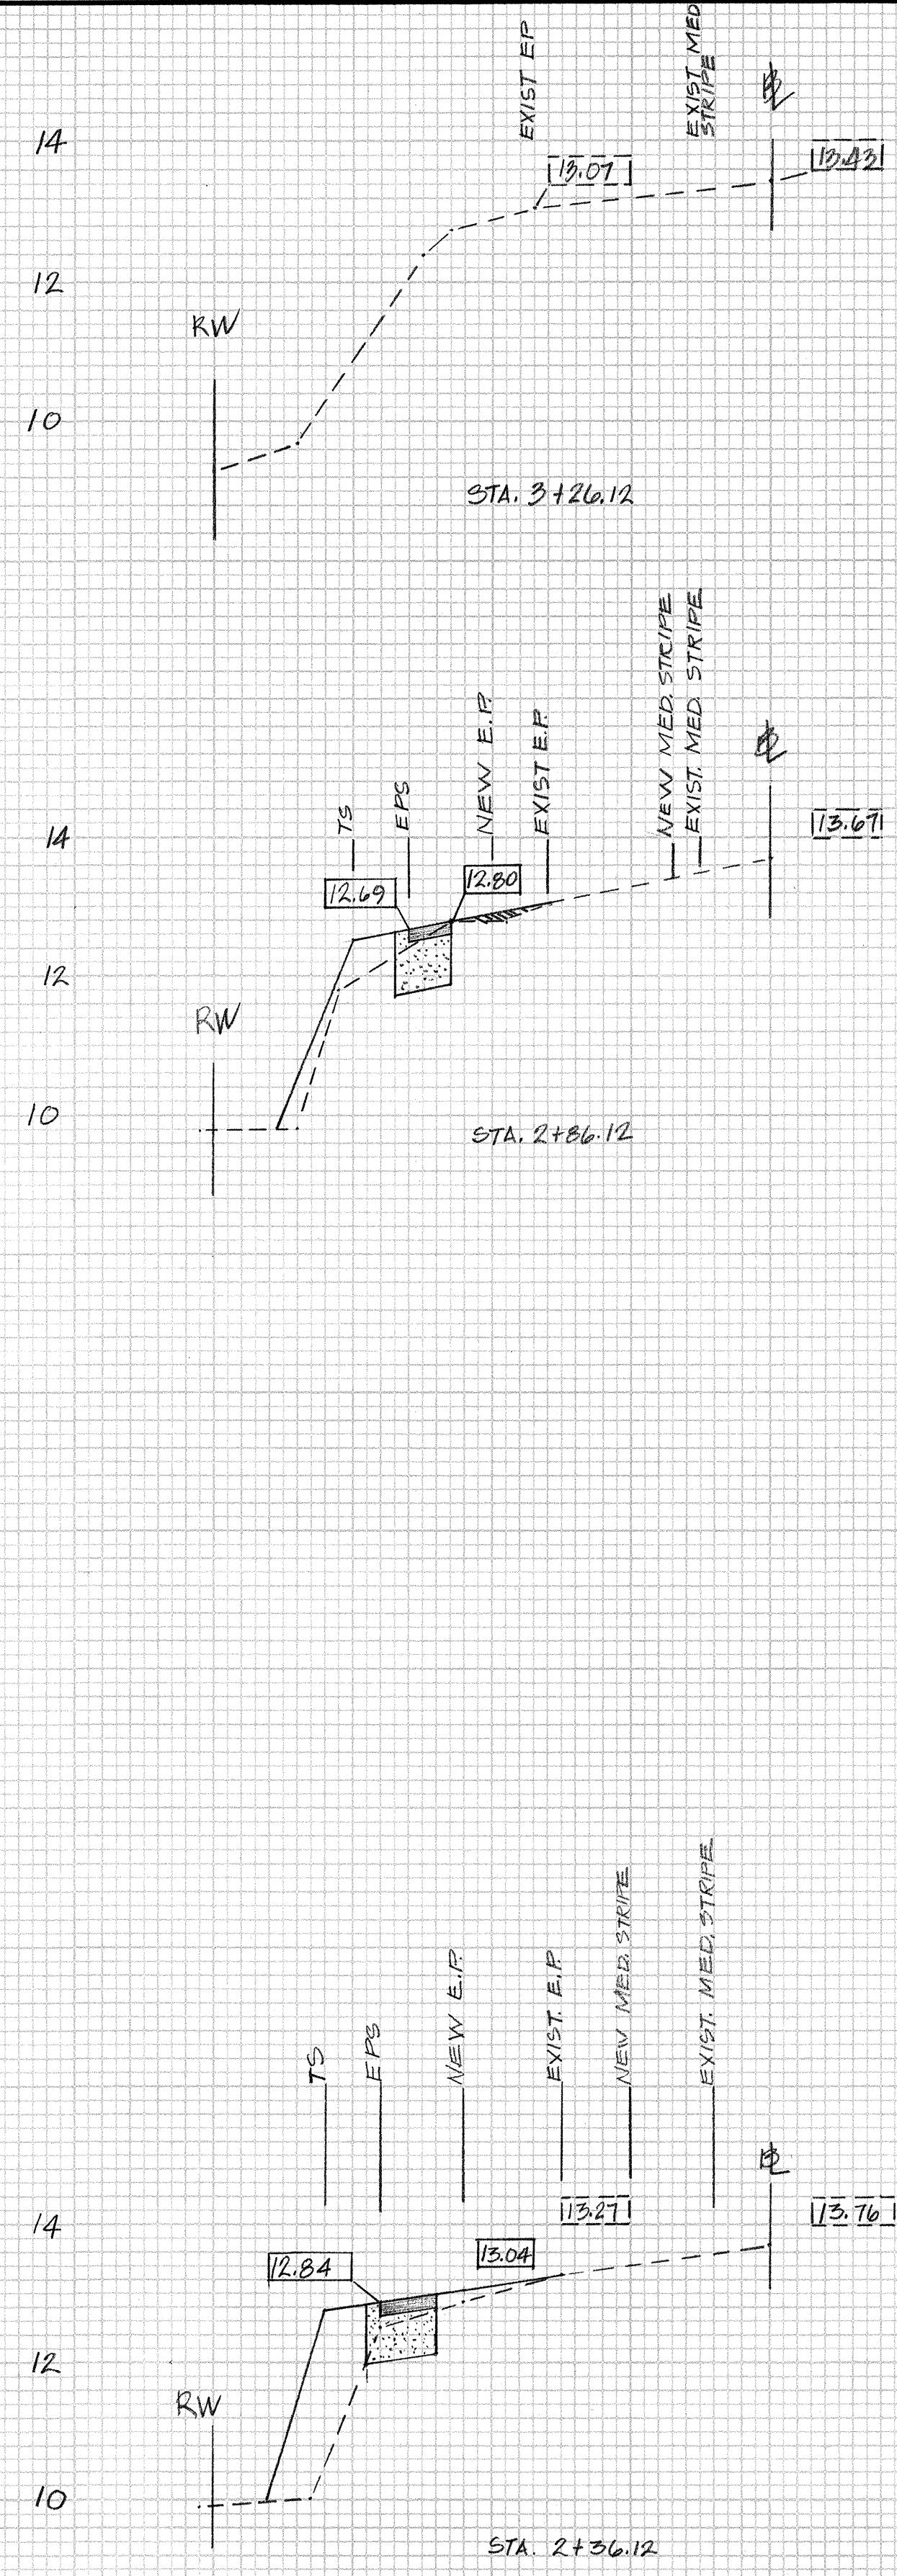


FINAL	DATE
SURVEY	BY
NOTED	PLANNED
BOOK	PLANNED
NO.	AREAS CHECKED

ORIGINAL	DATE
SURVEY	BY
NOTED	PLANNED
BOOK	PLANNED
NO.	AREAS CHECKED

FED. ROAD DIST. NO.	STATE	FED. AID PROJ. NO.	FISCAL YEAR	SHEET NO.	TOTAL SHEETS
HAWAII	HAW.	HES-030-1(17)	1983	C.O.7S-1	

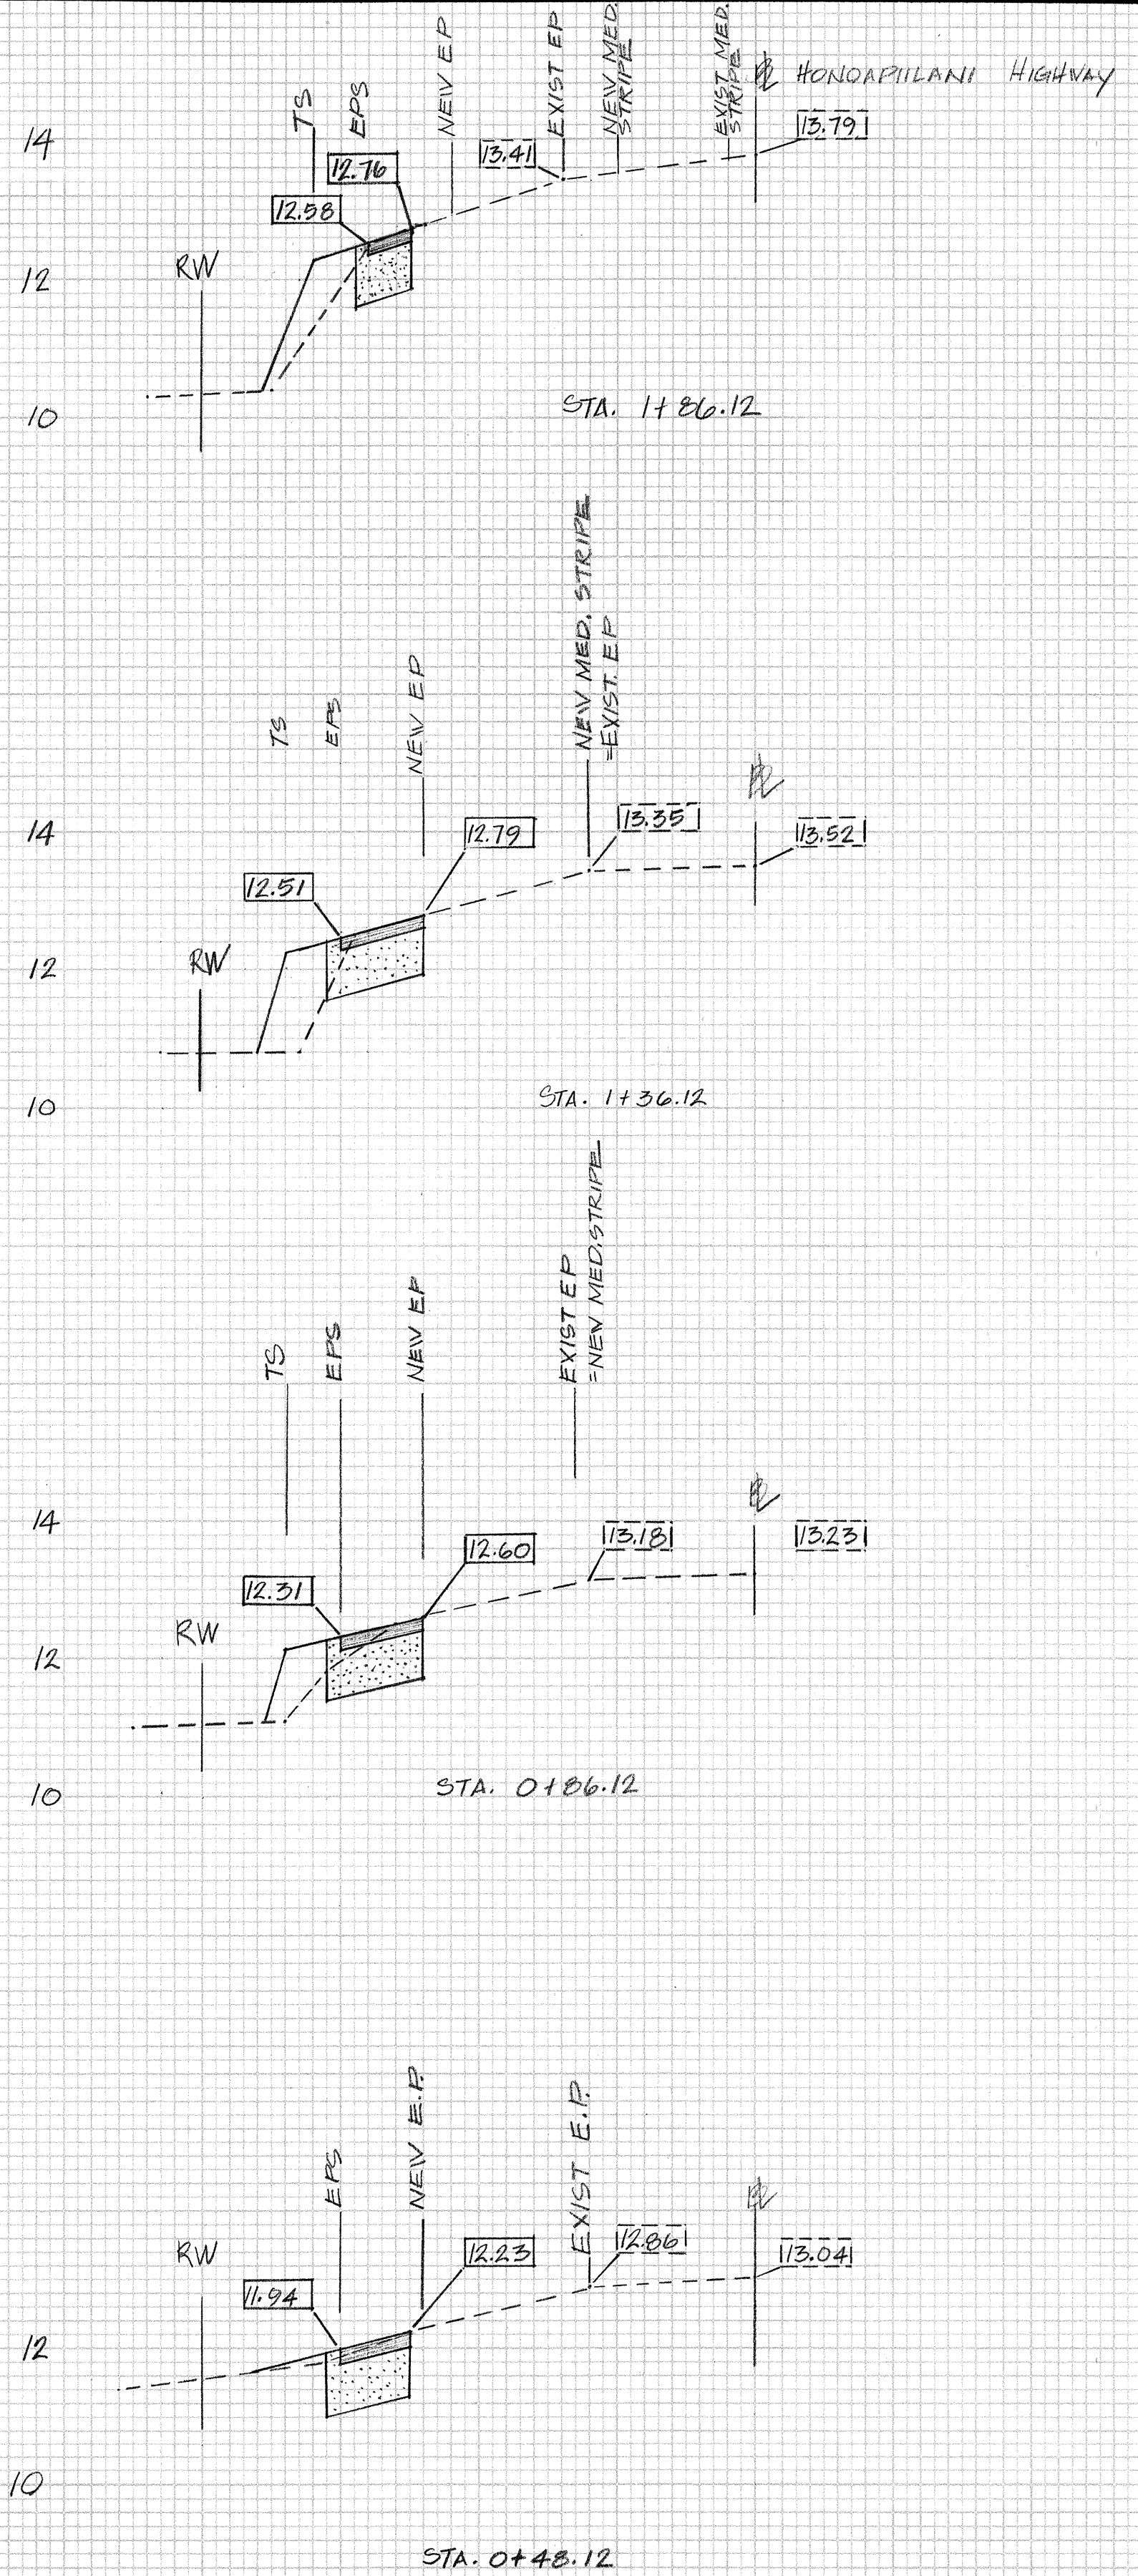

- LEVELLING COURSE
- EXISTING ELEV. TO REMAIN
- NEW FINISH GRADES
- EPS EDGE OF PAVED SHOULDER
- TS TOP OF SLOPE

CROSS SECTIONS (CCO NO 3)
HONOAPIILANI HIGHWAY, VAHIKULI RD. TO FLEMING RD.
SCALE: HOR. 1" = 10'
VERT. 1" = 2'

STATE OF HAWAII
DEPARTMENT OF TRANSPORTATION
HIGHWAYS DIVISION
CROSS SECTIONS
PROJECT: HONOAPIILANI HIGHWAY,
TRAFFIC SIGNALS AT
FLEMING RD.
PROJ. NO. HES-030-1(17)
DATE: JAN. 16, 1984


C.O.7S-1

DATE	BY
FINAL SURVEY	PLANNED
NOTE BOOK	AREAS CHECKED
NO.	

REFERENCE: FIELD BK. 30 MISC. 6
Pgs. 15-22

DATE	BY
9-22-83	AW & CREW
9-29-83	GH
NOTE BOOK	AREAS CHECKED
NO.	

FED. ROAD DIST. NO.	STATE	FED. AID PROJ. NO.	FISCAL YEAR	SHEET NO.	TOTAL SHEETS
HAWAII	HAW.	HES-030-1(17)	1983	C.O.8	

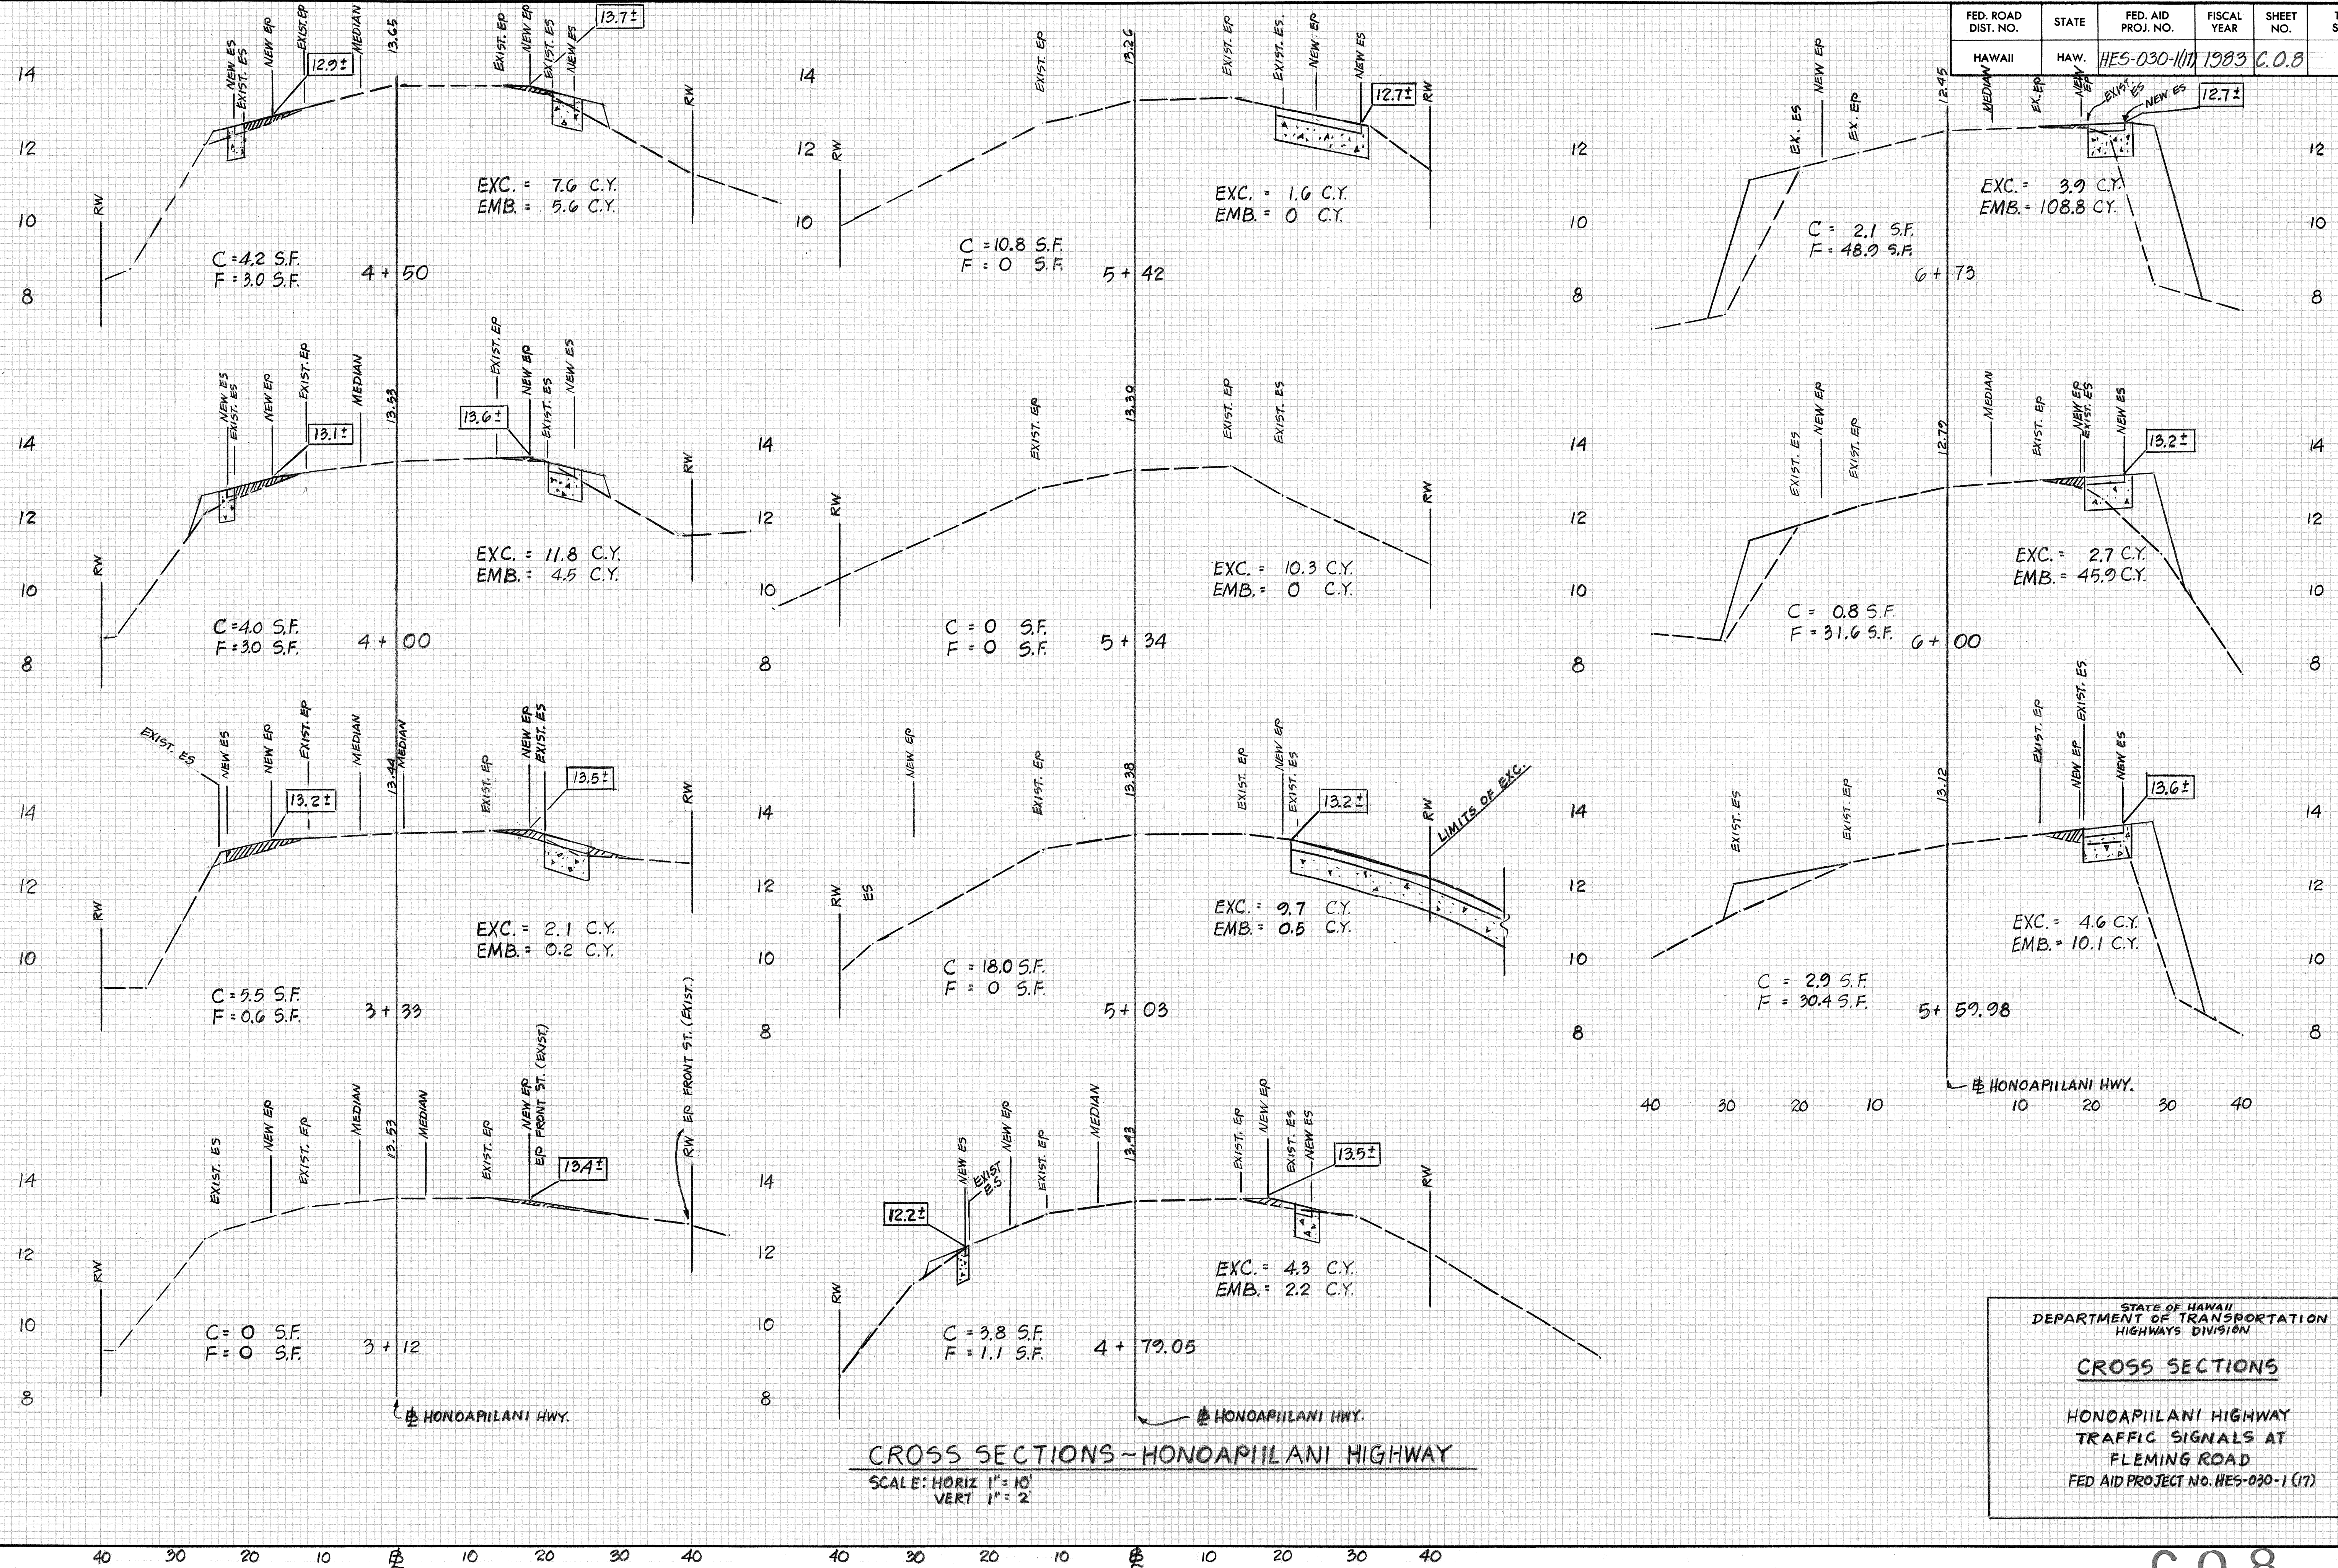

CROSS SECTIONS - HONOAPIILANI HIGHWAY

SCALE: HORIZ 1" = 10'
VERT 1" = 2'

STATE OF HAWAII
DEPARTMENT OF TRANSPORTATION
HIGHWAYS DIVISION

CROSS SECTIONS


HONOAPIILANI HIGHWAY
TRAFFIC SIGNALS AT
FLEMING ROAD
FED AID PROJECT NO. HES-030-1 (17)

FED. ROAD DIST. NO.	STATE	FED. AID PROJ. NO.	FISCAL YEAR	SHEET NO.	TOTAL SHEETS
HAWAII	HAW.	HES-030-1117	1983	C.O. 9	


DATE	BY	FINAL SURVEY	PLOTTED	NOTED	AREAS CHECKED

REFERENCE:
FIELD BK. 30 MISC. G
PGS. 15-22

DATE	BY	ORIGINAL SURVEY	PLOTTED	NOTED	AREAS CHECKED
9-22-83	AV & CREW				
7-30-83	GH				

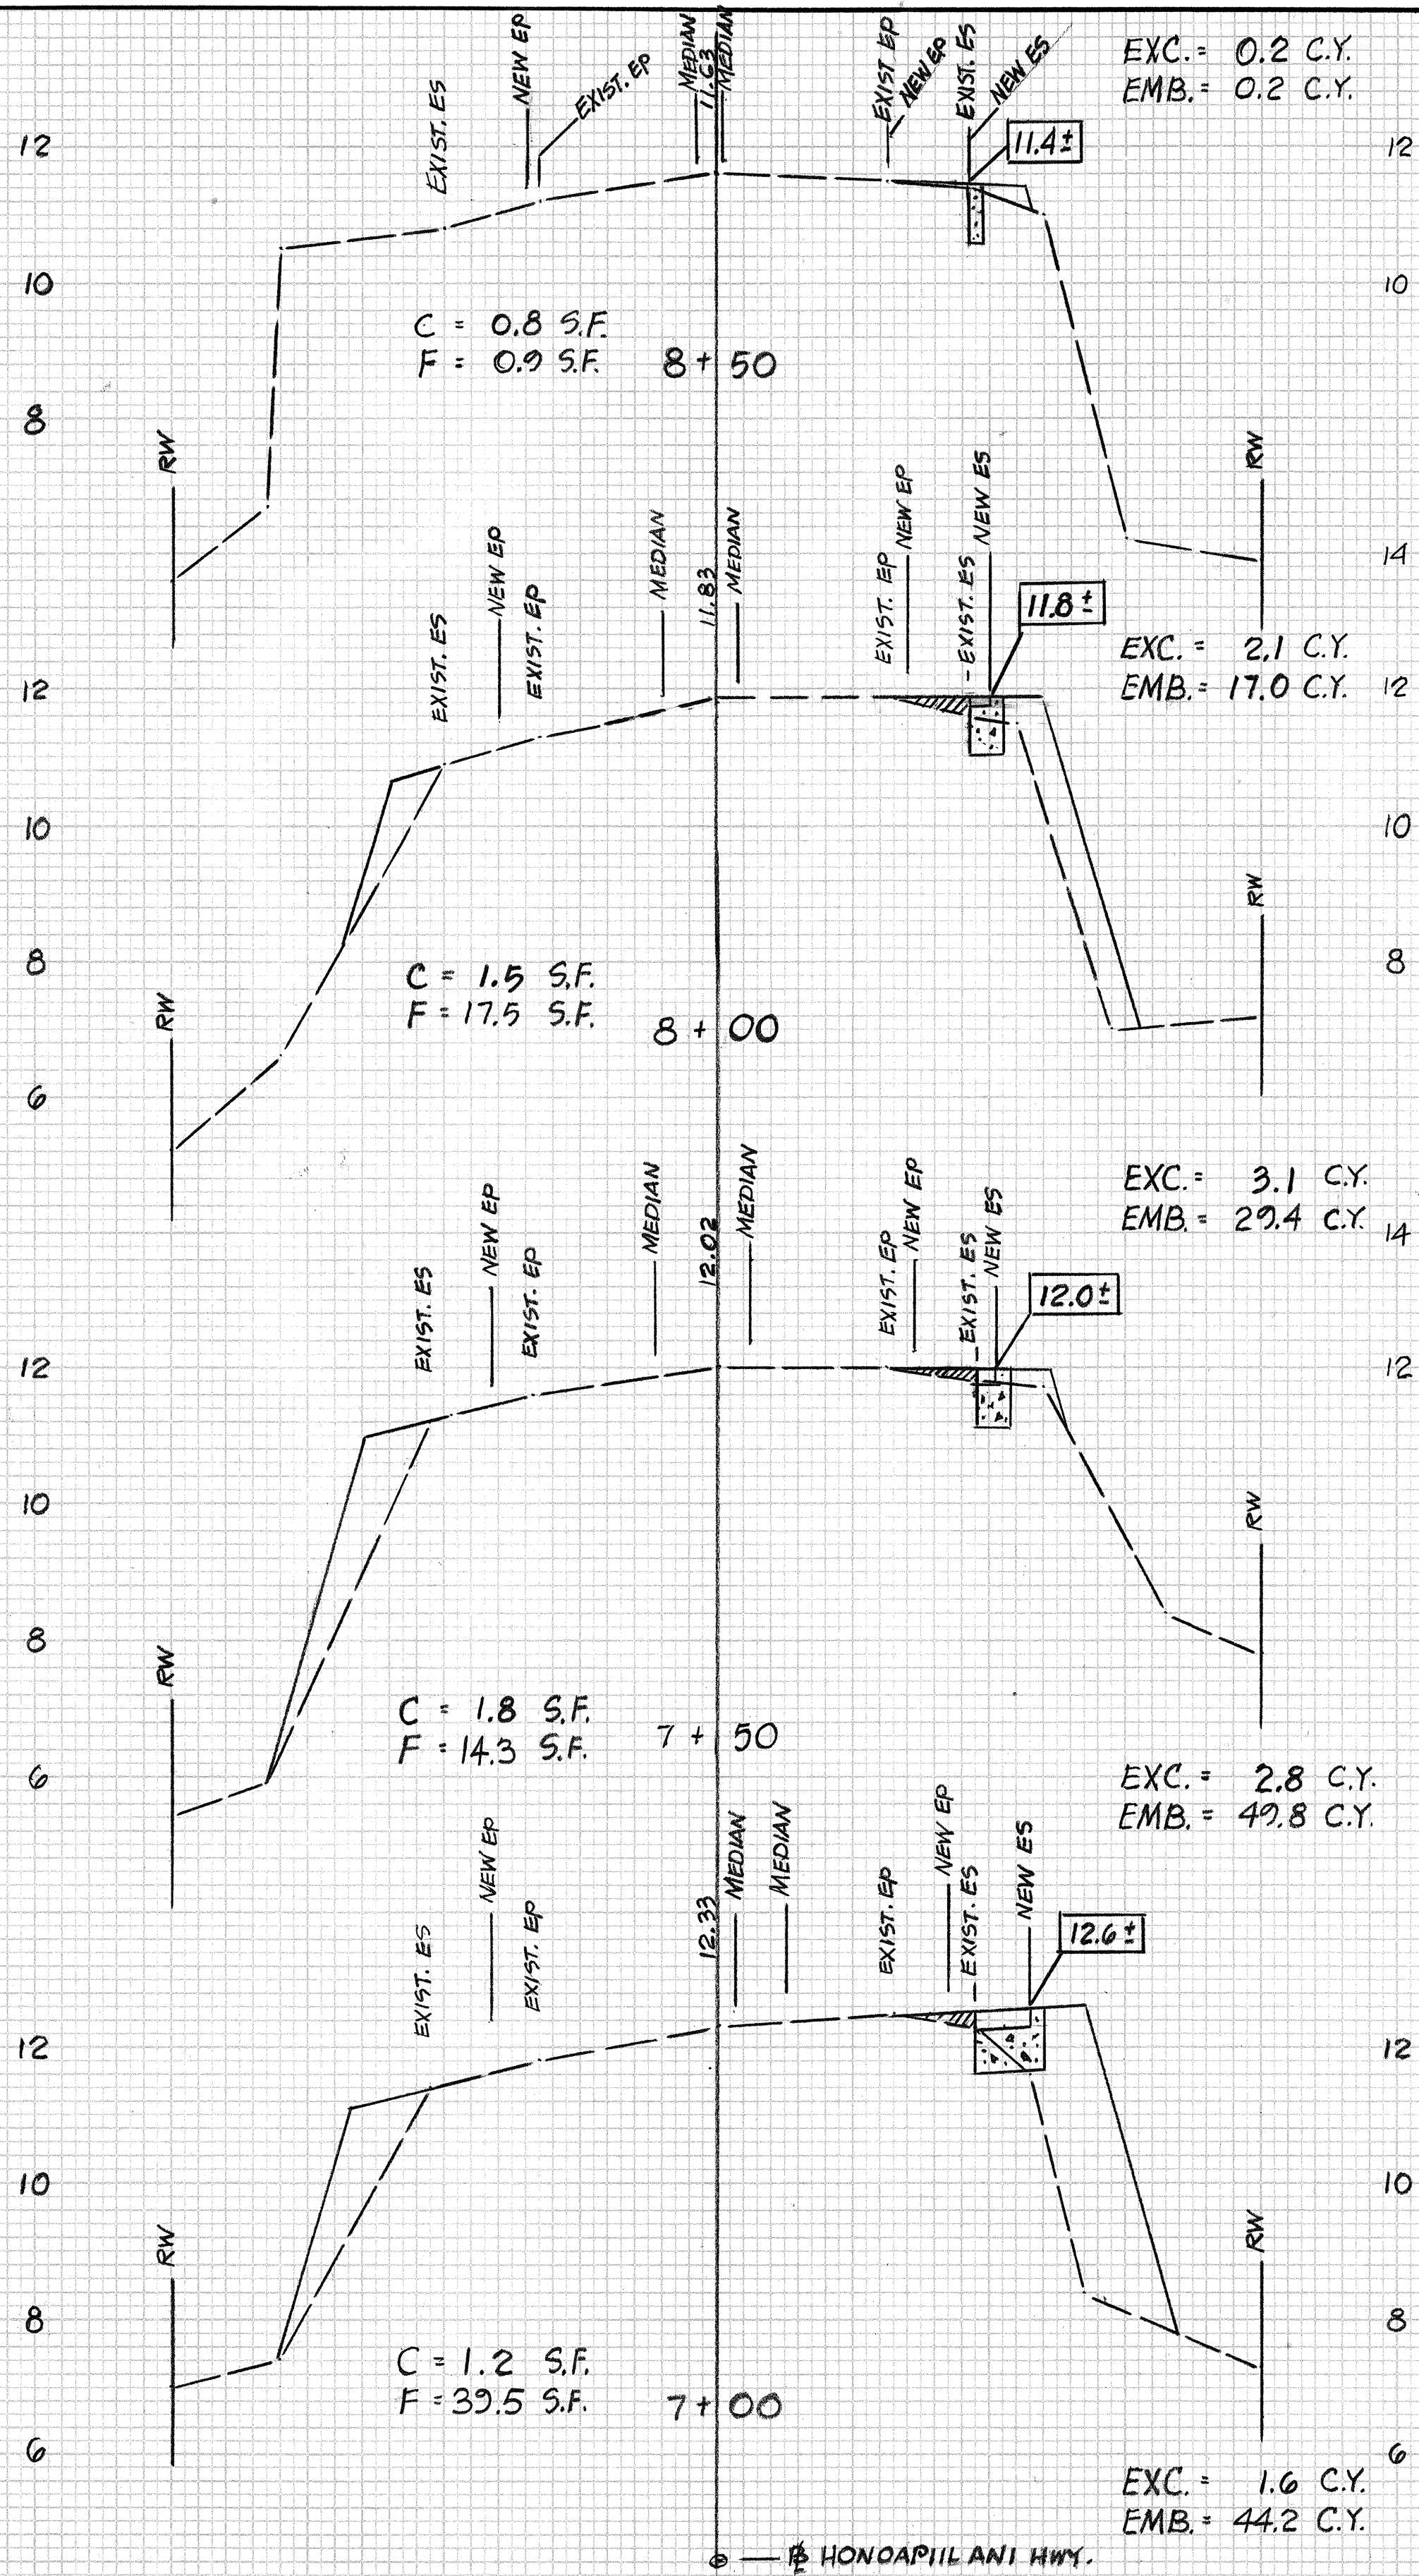

CROSS SECTIONS - HONOAPIILANI HIGHWAY
SCALE: HORIZ 1"=10'
VERT 1"=2'

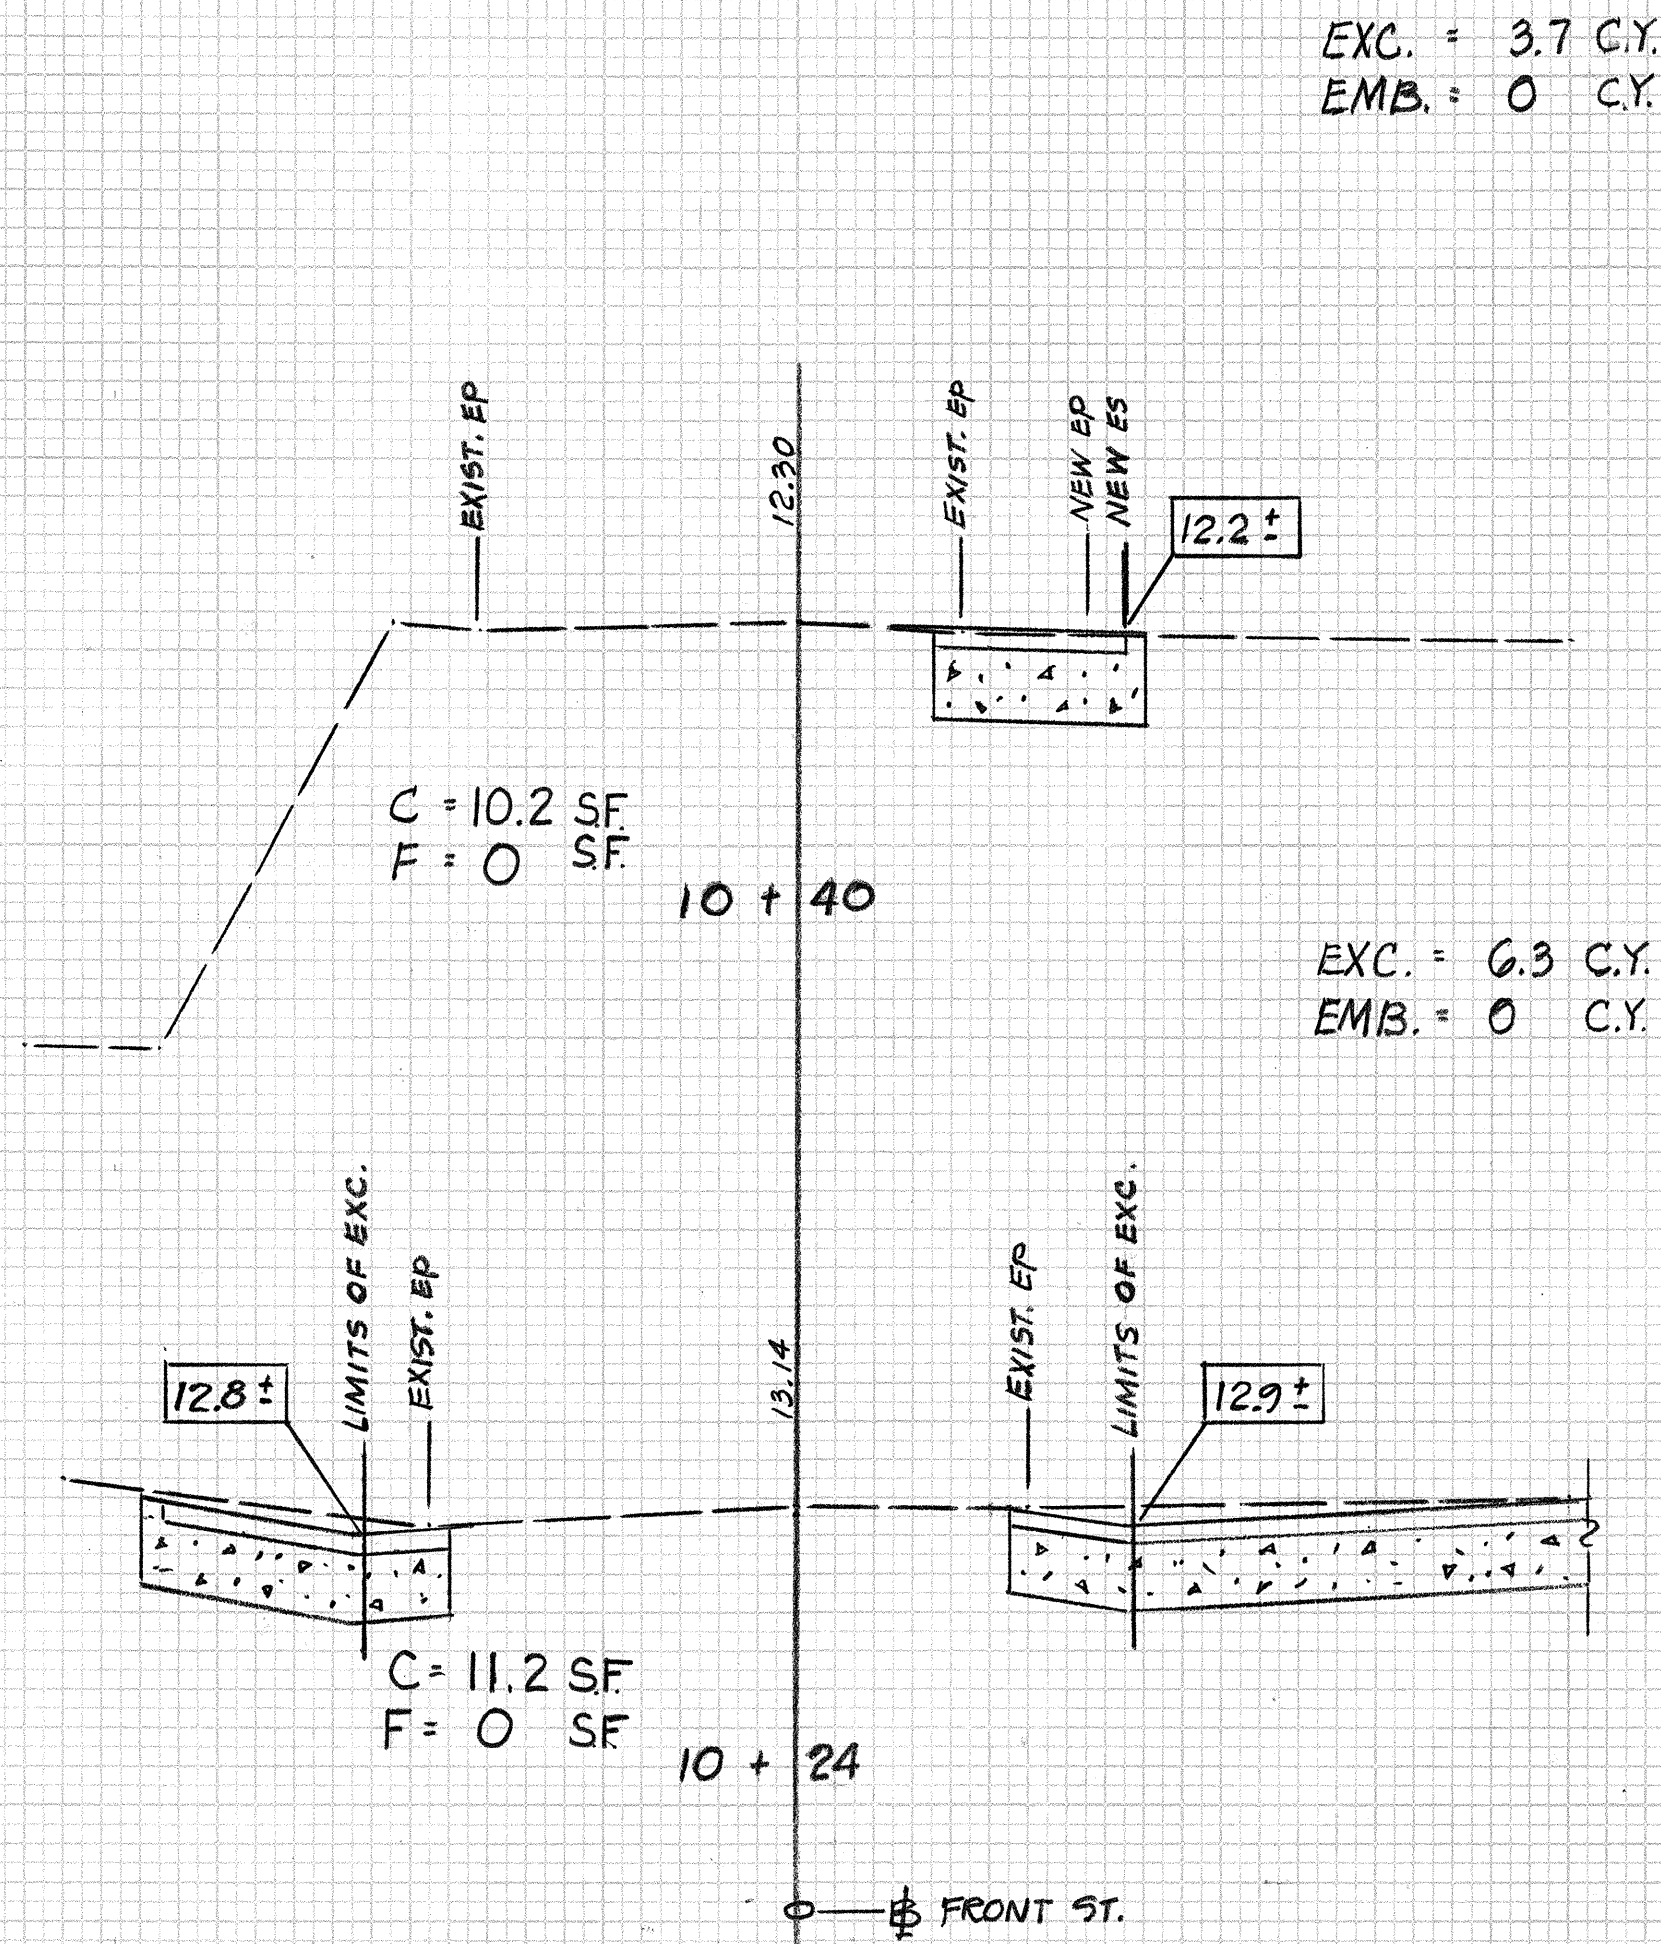

CROSS SECTIONS - FRONT STREET
SCALE: HORIZ 1"=10'
VERT 1"=2'

