

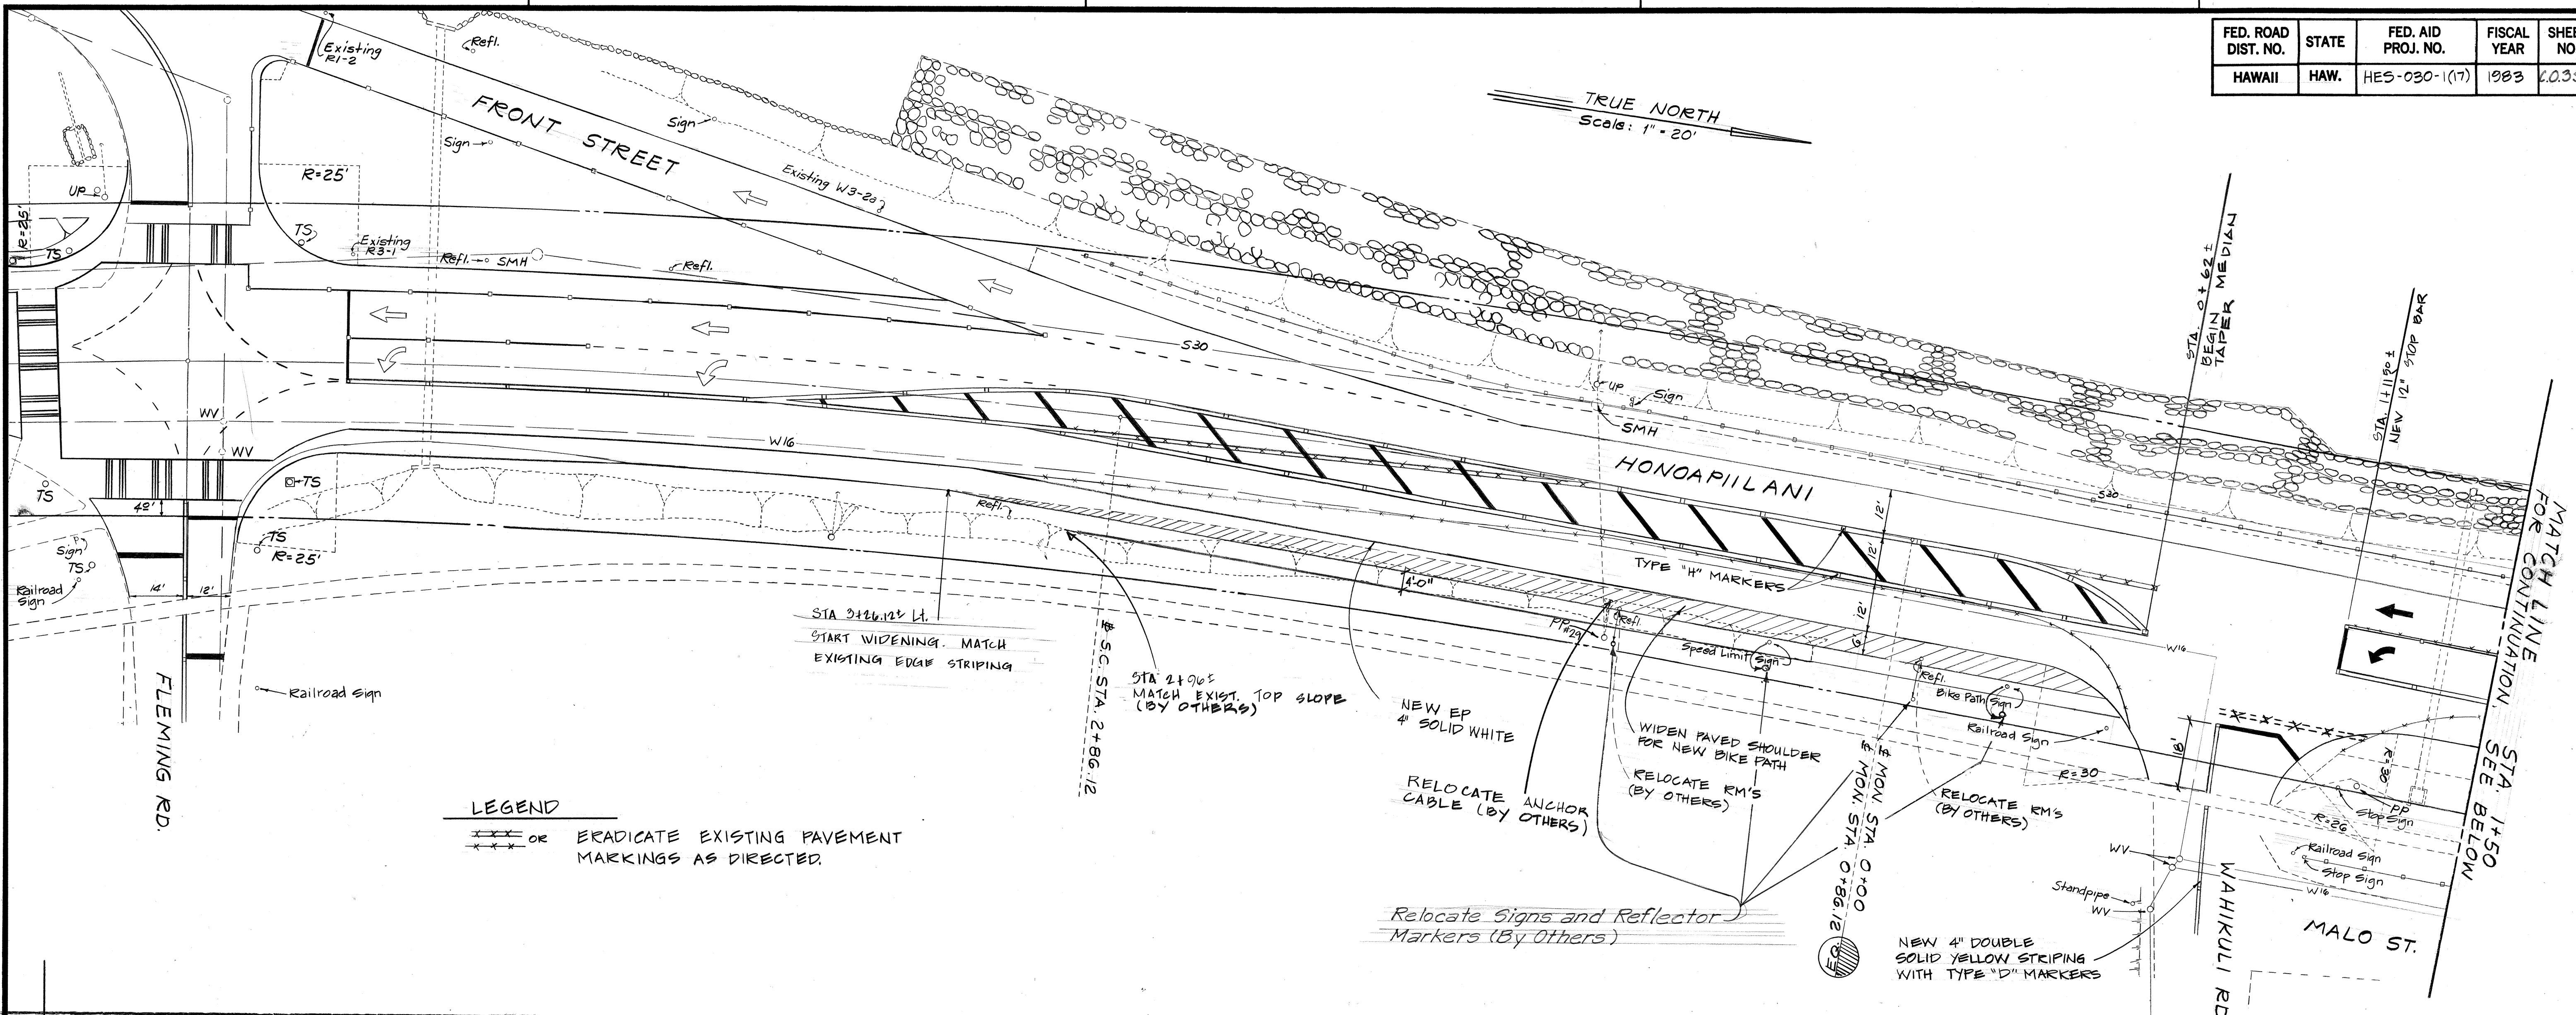


FED. ROAD DIST. NO.	STATE	FED. AID PROJ. NO.	FISCAL YEAR	SHEET NO.	TOTAL SHEETS
HAWAII	HAW.	HES-030-1(17)	1983	2035-1	

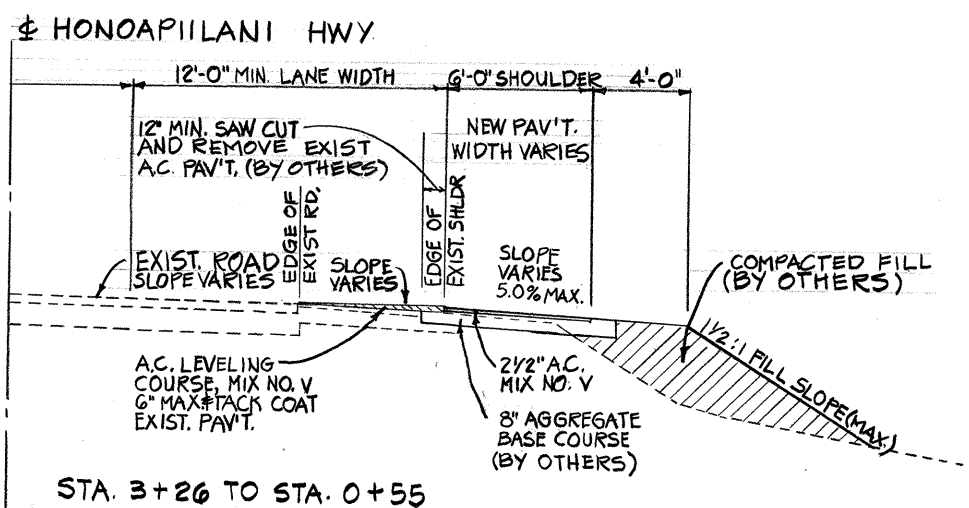

LEGEND
 ---- OR ERADICATE EXISTING PAVEMENT MARKINGS AS DIRECTED

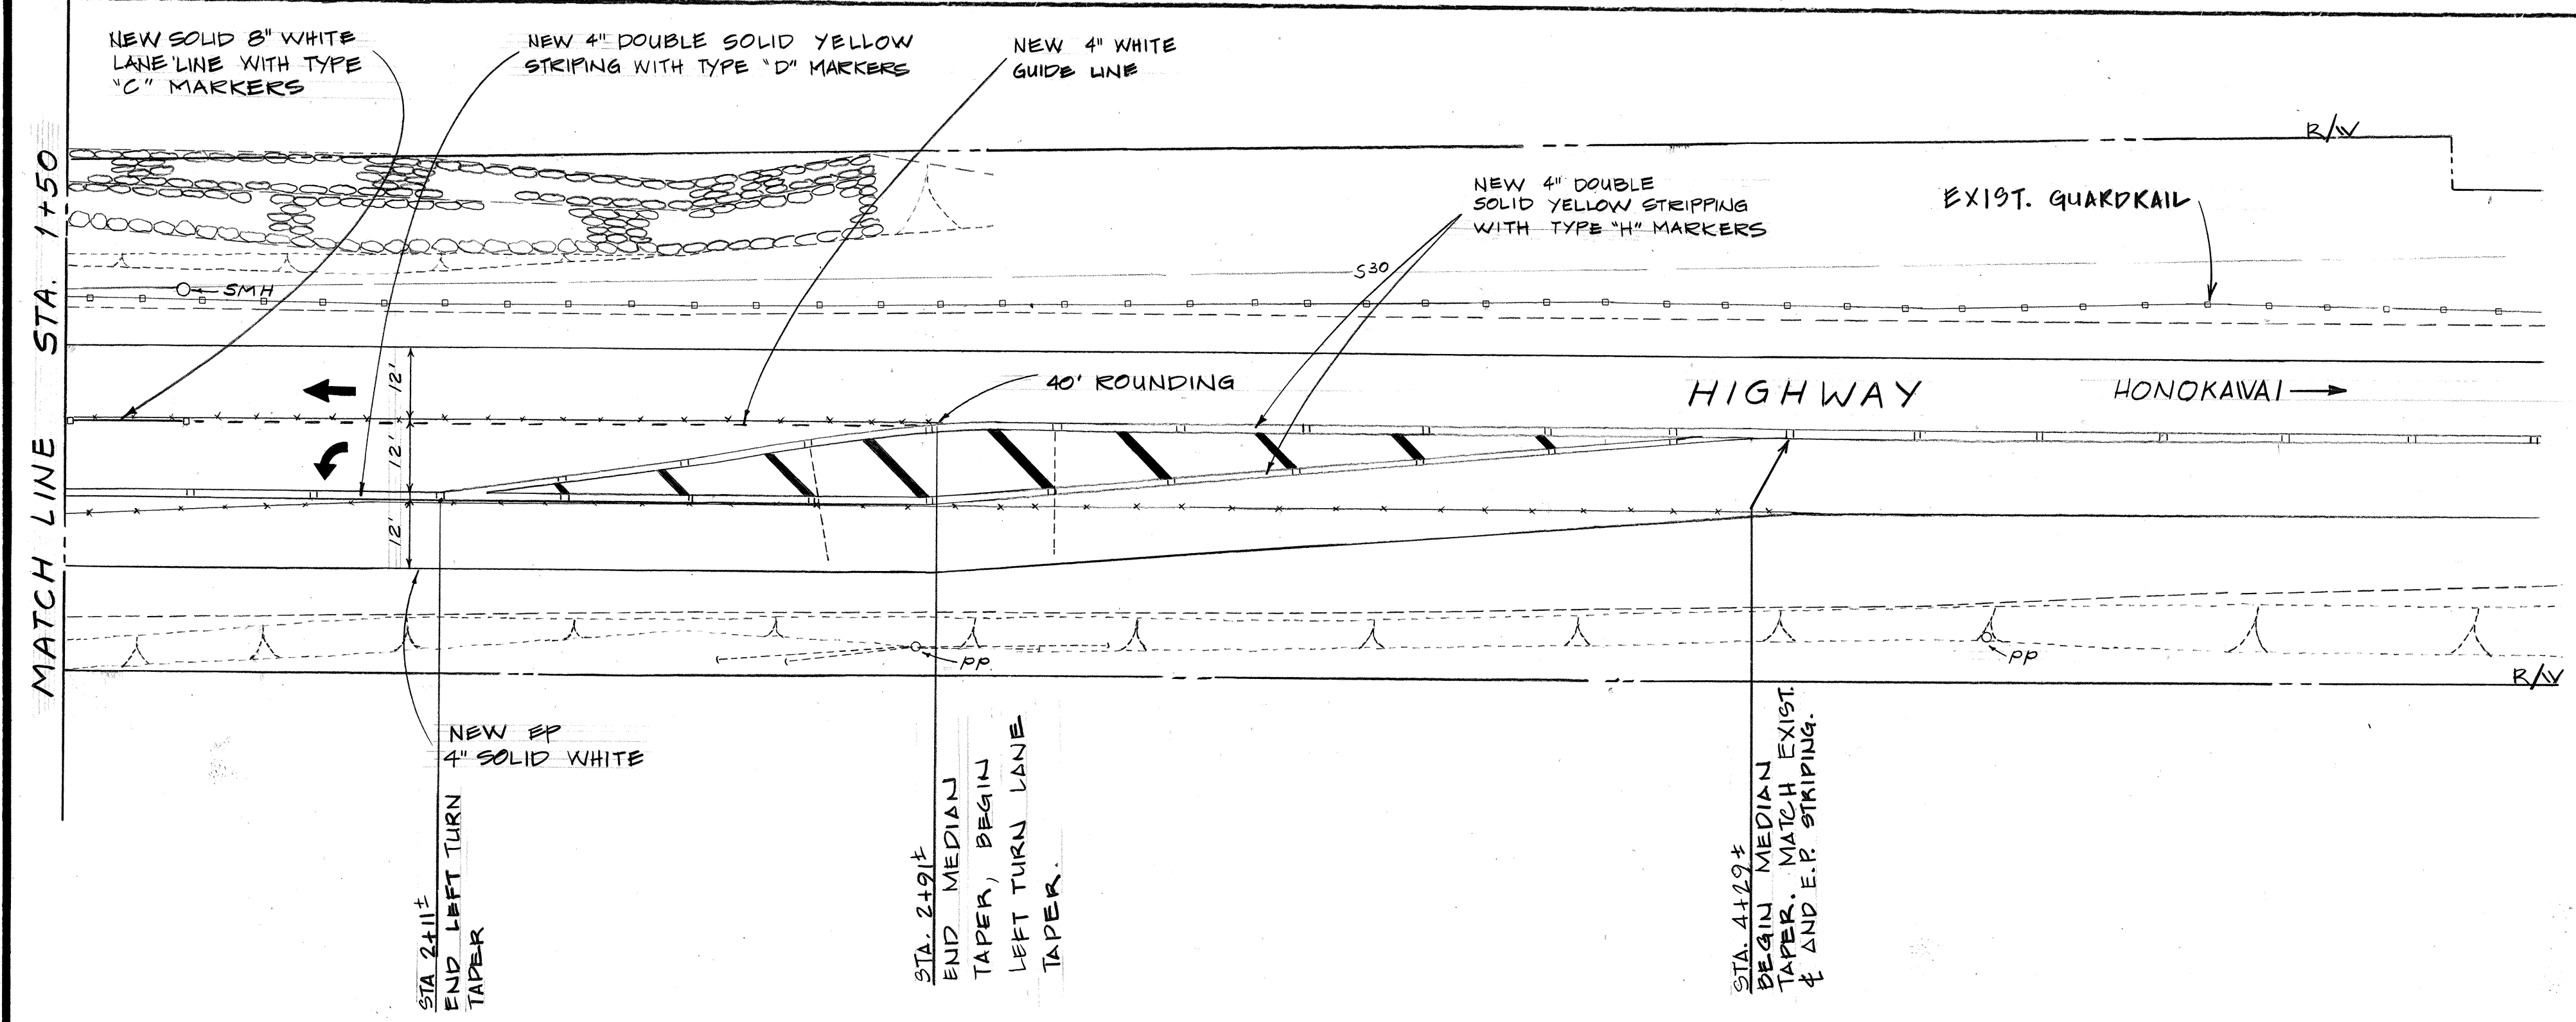

TYPICAL SECTION: C.C.O. No. 3
 SCALE: 1/8" = 1'-0"

ESTIMATED QUANTITIES		
No.	ITEM DESCRIPTION	QTY UNIT
203.0100	ROADWAY EXCAVATION	50 CY
203.0210	IMPORTED BORROW	30 CY
304.1110	AGGREGATE BASE	40 CY
401.0500	MIX II AC	30 TON
629.1010	PAVEMENT STRIPING	2120 L.F.
629.1030	PAVEMENT ARROWS	6 EA.
629.2030	TYPE "C" PAVEMENT MARKERS	4 EA.
629.2040	TYPE "D" PAVEMENT MARKERS	8 EA.
629.2070	TYPE "H" PAVEMENT MARKERS	43 EA.
629.3011	REMOVE PAVEMENT STRIPING	1046 L.F.
629.4011	REMOVE PAVEMENT MARKERS	62 EA.

STATE OF HAWAII
 DEPARTMENT OF TRANSPORTATION
 HIGHWAYS DIVISION

GEOMETRICS & STRIPING PLAN
 C.C.O. No. 3
 HONOAPIILANI HIGHWAY
 TRAFFIC SIGNALS AT
 FLEMING ROAD
 FED. AID PROJECT NO. HES-030-1(17)


SCALE: AS SHOWN DATE: 12-09-83

SHEET NO. OF SHEETS

DATE	
SURVEY PLOTTED BY	
DRAWN BY	
TRACED BY	
NOTED BY	
CHECKED BY	
ORIGINAL PLAN	
NOTE BOOK	
No.	

FED. ROAD DIST. NO.	STATE	FED. AID PROJ. NO.	FISCAL YEAR	SHEET NO.	TOTAL SHEETS
HAWAII	HAW.	HES-030-1(17)	1983	4	22

DATE	PLANNED BY
	DRAWN BY
	DESIGNED BY
	CHECKED BY
	NOTED BY
	QUANTITIES BY
	NO.

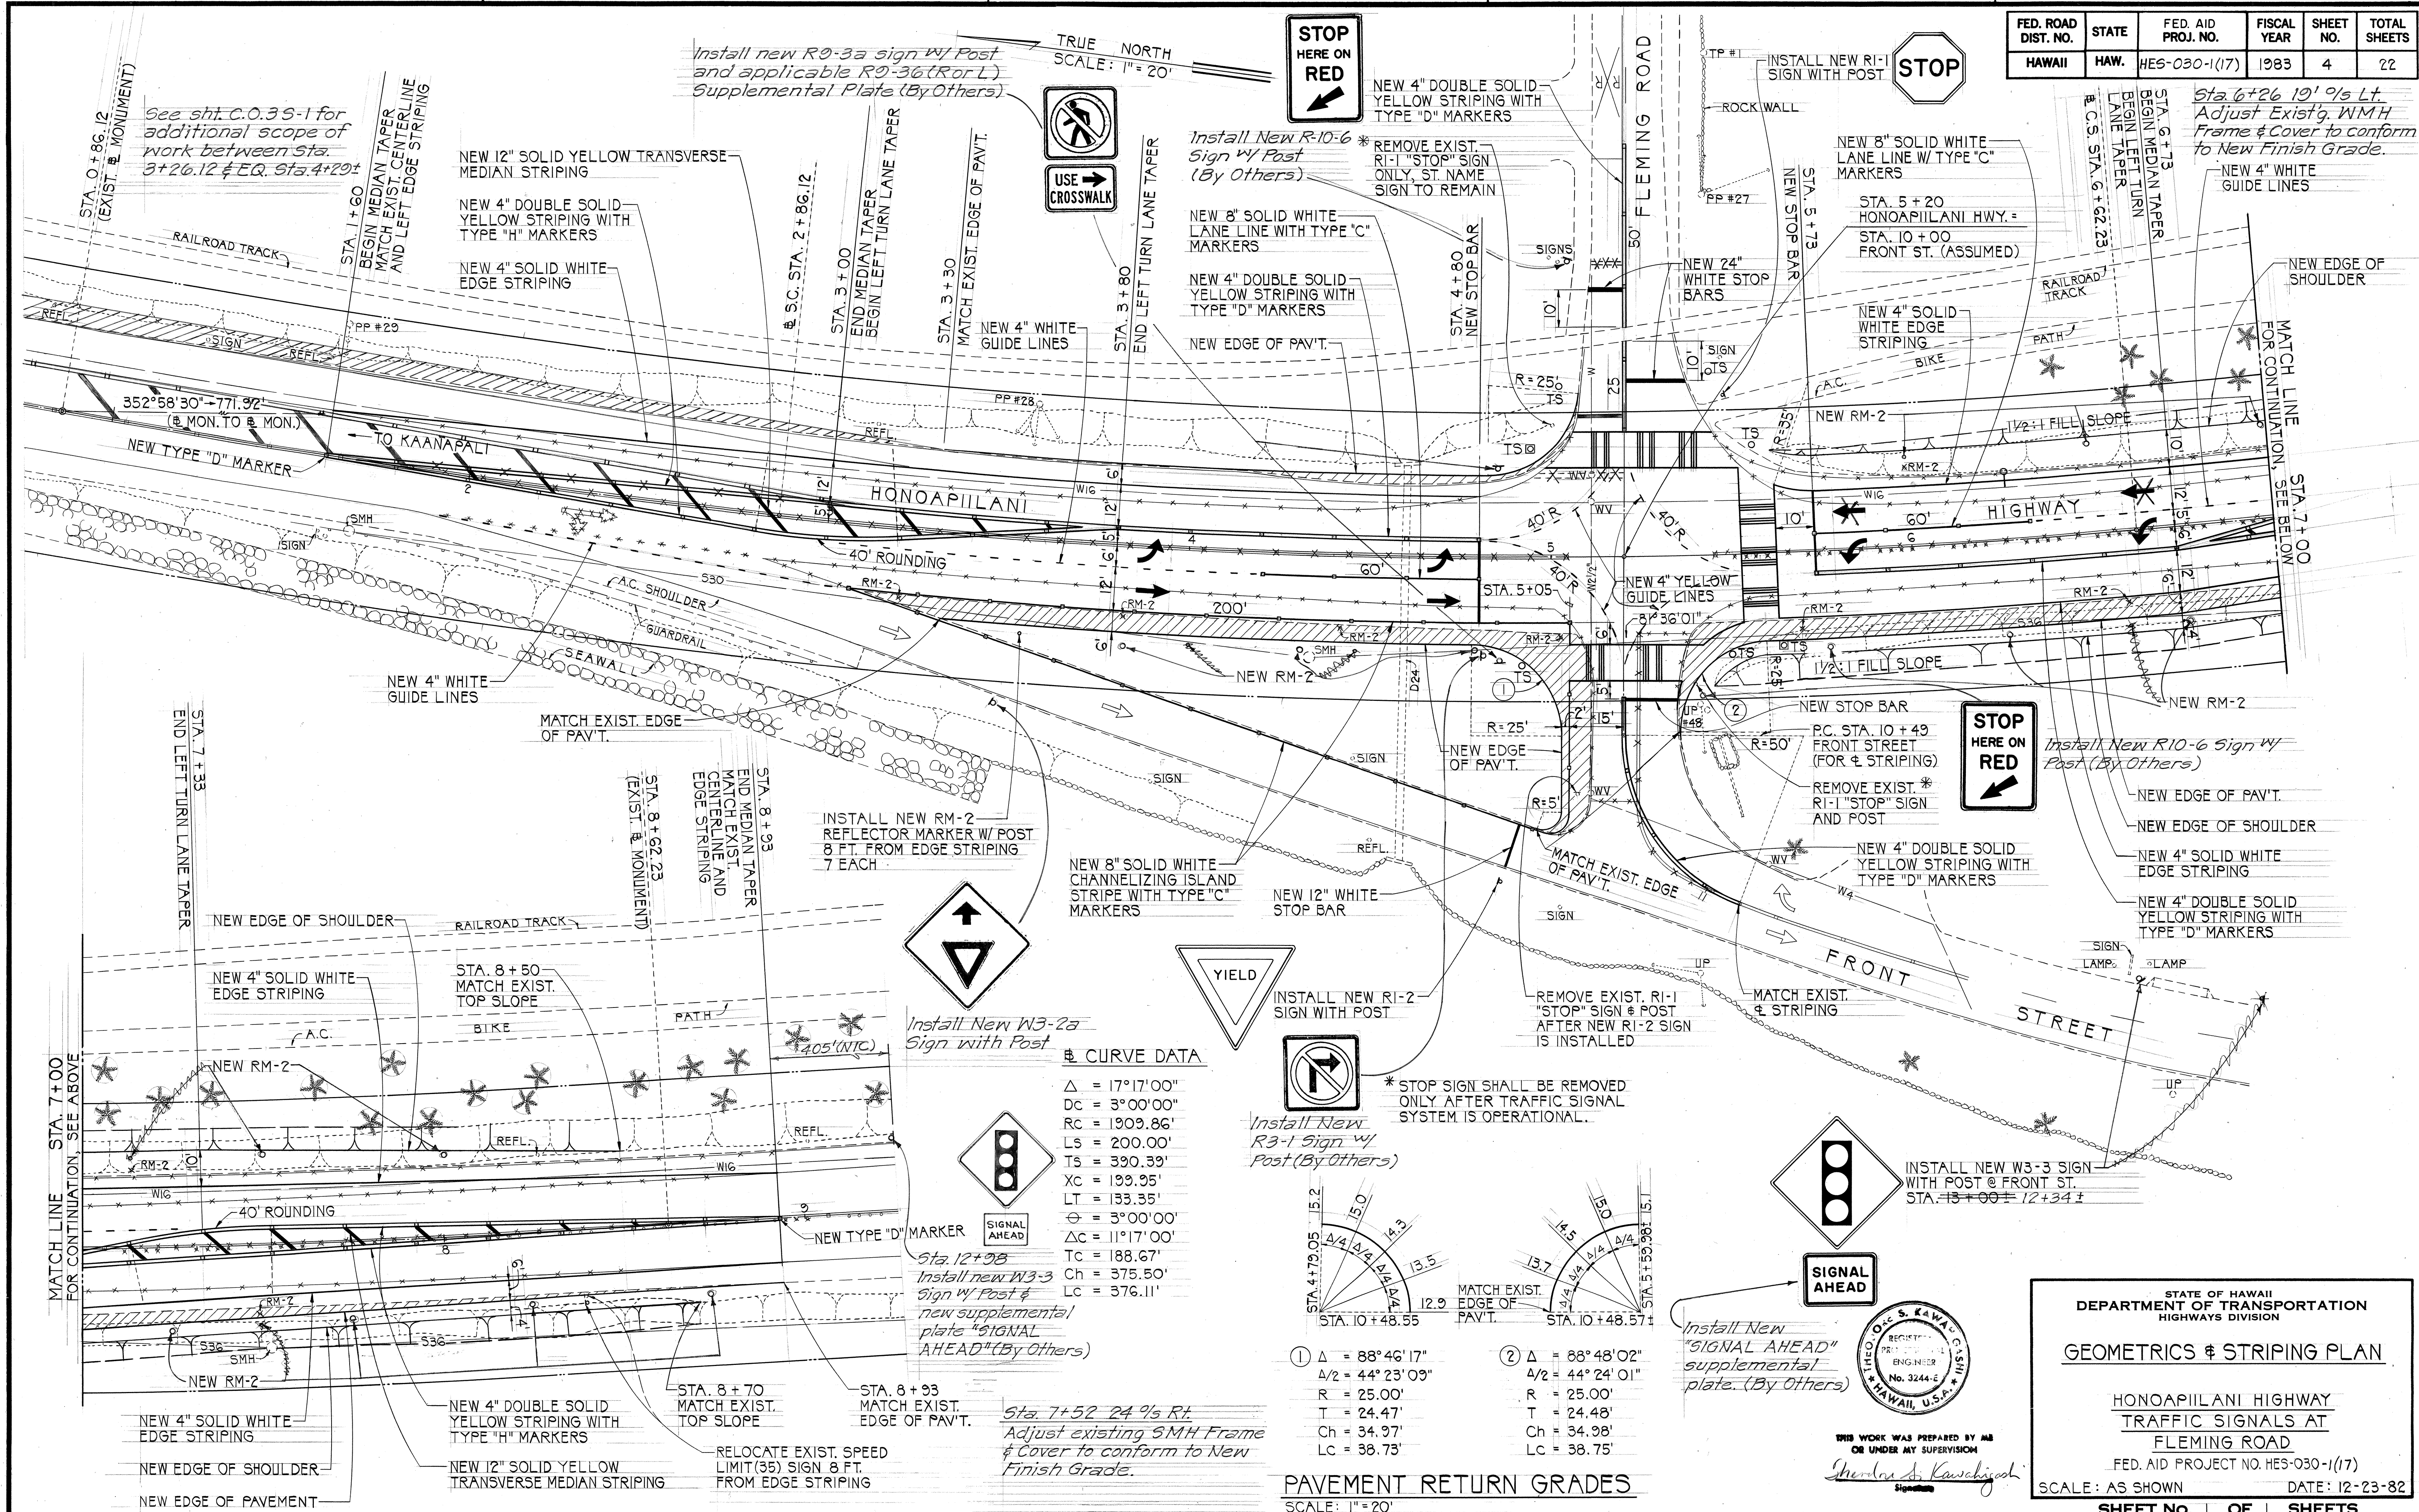

STATE OF HAWAII
DEPARTMENT OF TRANSPORTATION
HIGHWAYS DIVISION

GEOMETRICS & STRIPING PLAN

HONOAPIILANI HIGHWAY
TRAFFIC SIGNALS AT
FLEMING ROAD

FED. AID PROJECT NO. HES-030-1(17)

SCALE: AS SHOWN DATE: 12-23-82

SHEET NO. 4 OF 4 SHEETS