
INDE	TO DDAWINGO
1	X TO DRAWINGS
SHEET NO.	DESCRIPTION
1 7	TITLE SHEET
2 L	EGEND, NOTES & TYP. ROADWAY SECTIONS
3 7	RAFFIC CONTROL PLAN
1 4	SEOMETRICS AND STRIPING PLAN
(in the second s	RAFFIC SIGNAL PLAN
6 0	ONTROLLER SEQUENCE DIAGRAM
	MISCELLANEOUS DETAILS
28-9	ROSS SECTIONS
10-22	TANDARD DETAILS
	-
① c.o.	3S-I ② C.O. 7S-I ARE
SUPPL	EMENT SHEETS TO THE
CONTE	RACT PLANS.
NEW	TOTAL: 24 SHEETS
	***************************************
*	



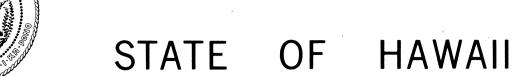

## DEPARTMENT OF TRANSPORTATION HIGHWAYS DIVISION


HONOLULU, HAWAII


"AS BUILT"

PLANS FOR

## HONOAPIILANI HIGHWAY TRAFFIC SIGNALS AT FLEMING ROAD FEDERAL AID PROJECT NO. HES-030-1(17)

DISTRICT OF LAHAINA
ISLAND OF MAUI

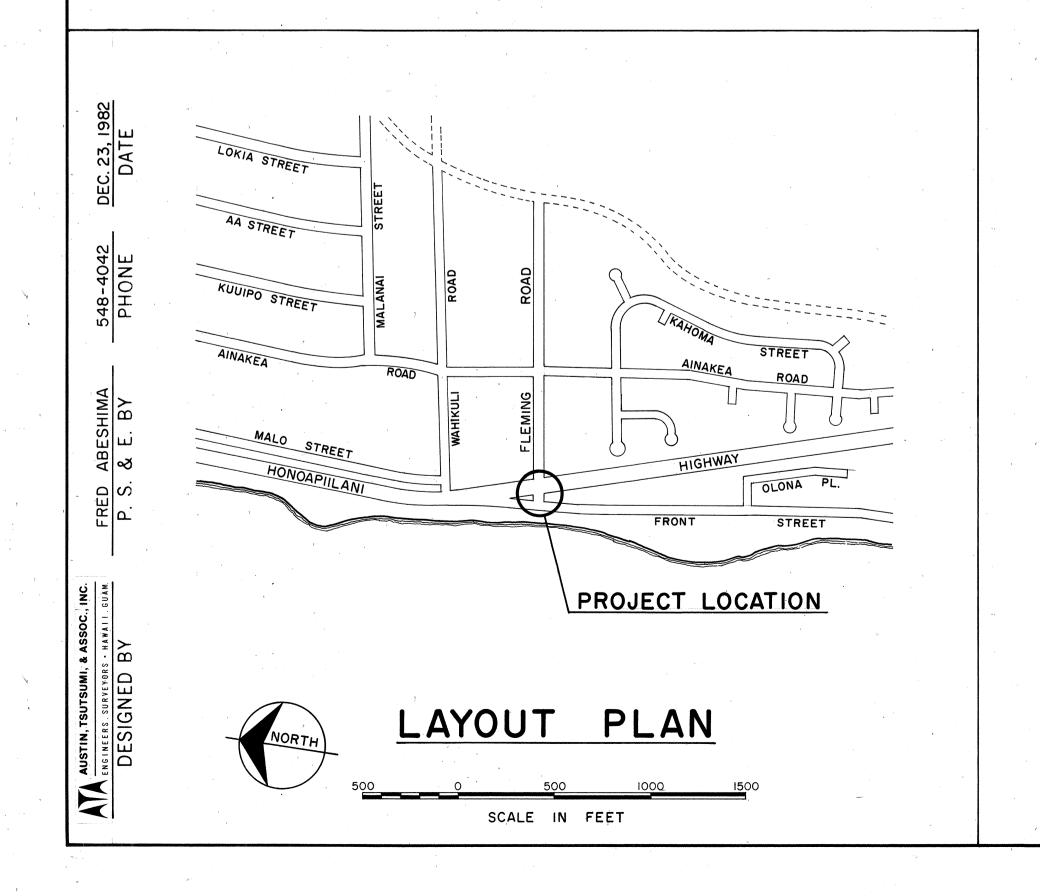

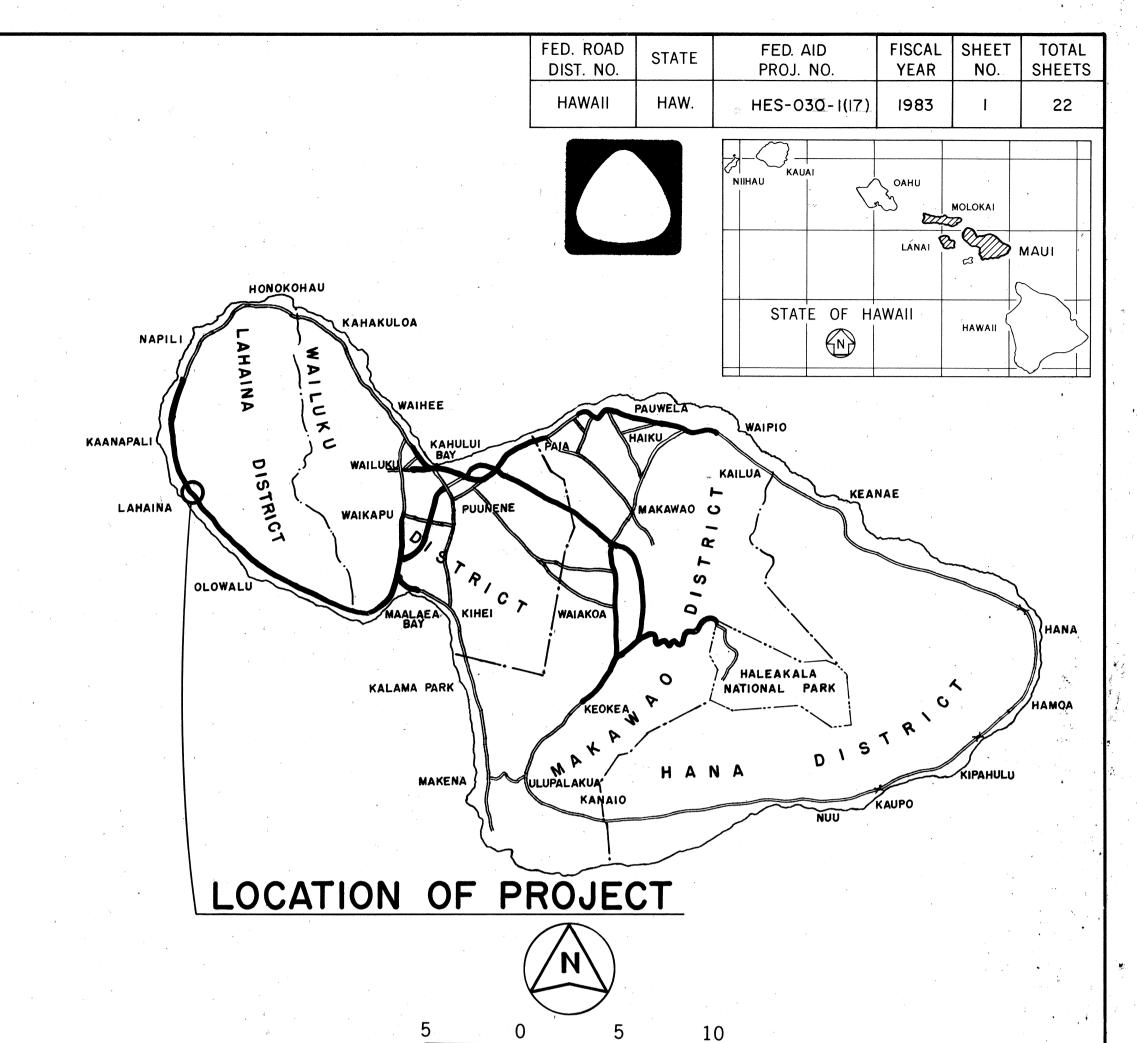

FEDERAL AID PROJECTS PREVIOUSLY CONSTRUCTED OR UNDER CONSTRUCTION

CHANGES MADE DURING CONSTRUCTION HAVE BEEN INCORPORATED ON THESE PLANS EXCEPT CHANGES IN THE ORIGINAL THEORETICAL QUANTITIES, FOR ACTUAL QUANTITIES, REFER TO PROJECT LEDGER AND/OR COMPUTATION BOOK.

Flerdinand Cajigae 3/12/84
RESIDENT ENGINEER DATE

<b>V</b>
83
E

DEPARTMENT OF TRANSPORTATION		
,		
1/-/		
1/25/83		
DATE		