
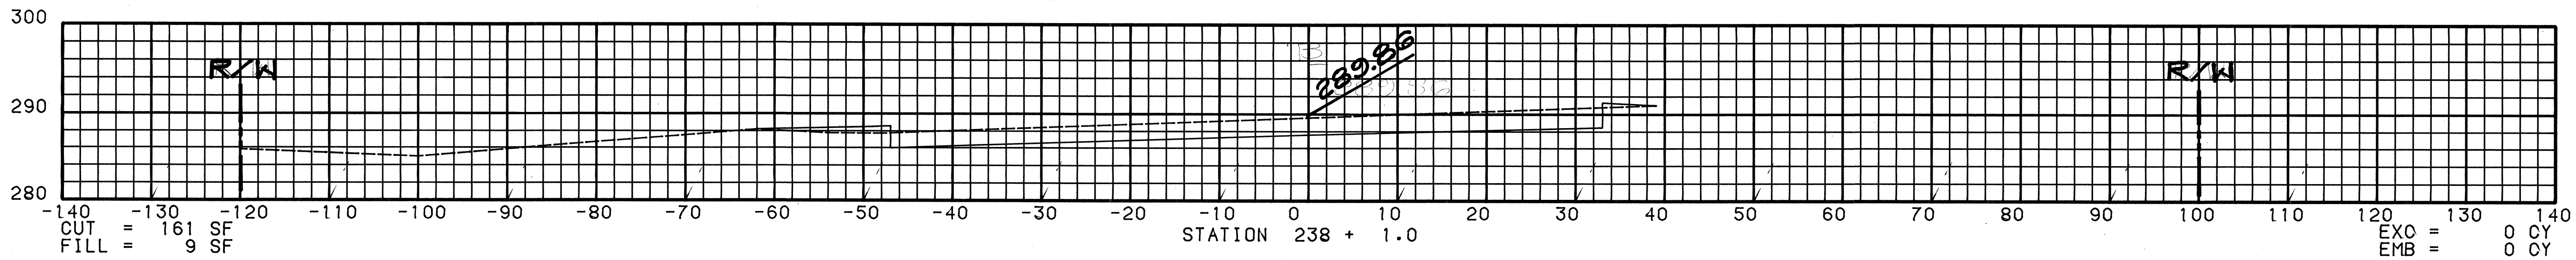
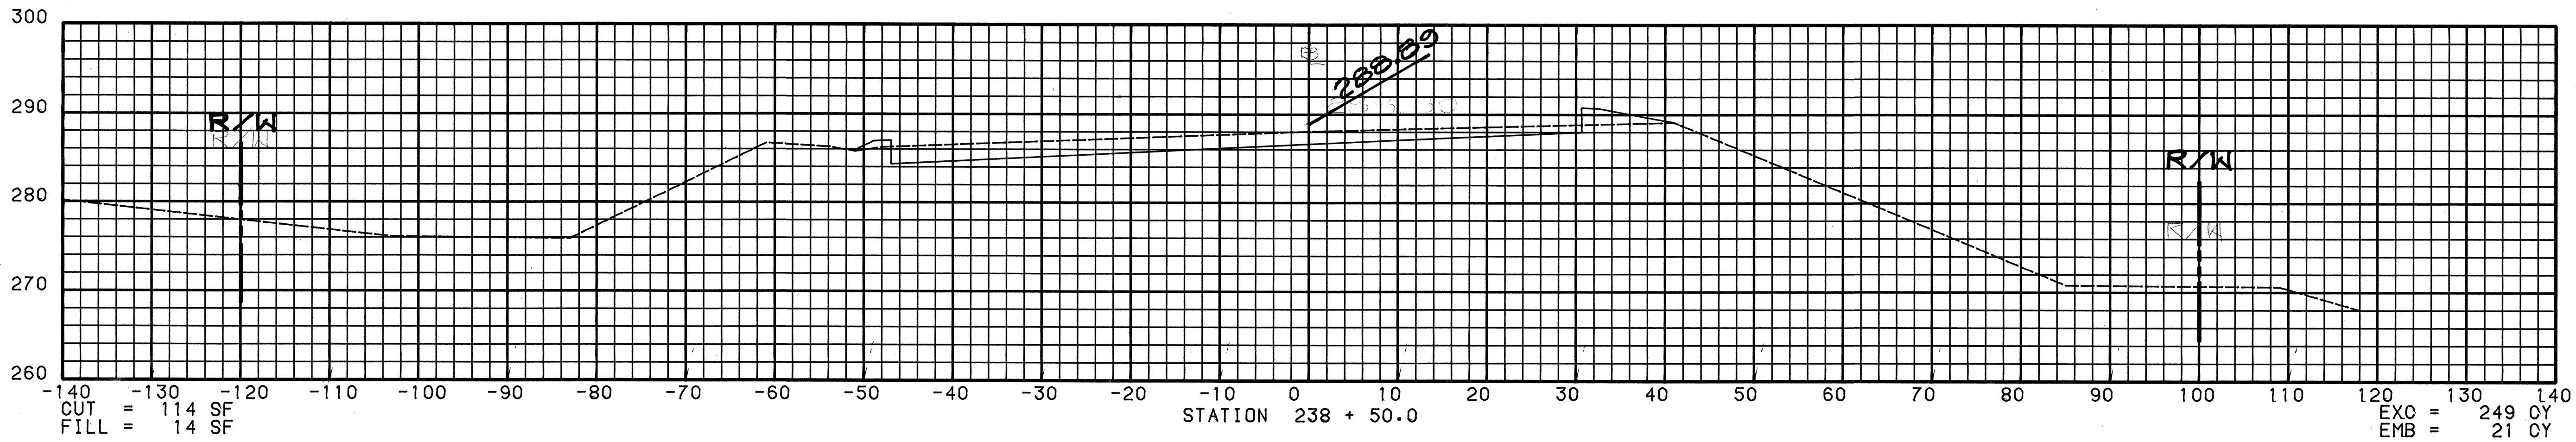
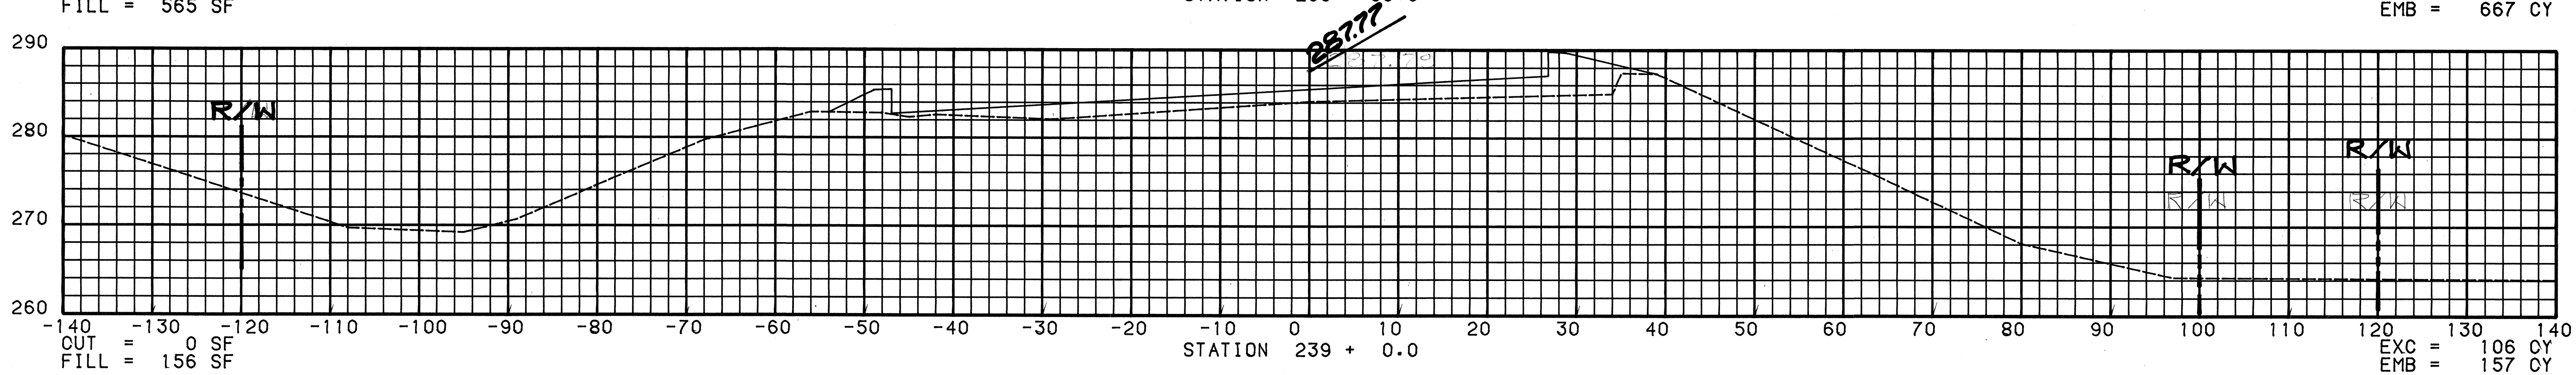




FED. ROAD DIST. NO.	STATE	FED. AID PROJ. NO.	FISCAL YEAR	SHEET NO.	TOTAL SHEETS
HAWAII	HAW.	F-030-(118)	1984	118	169

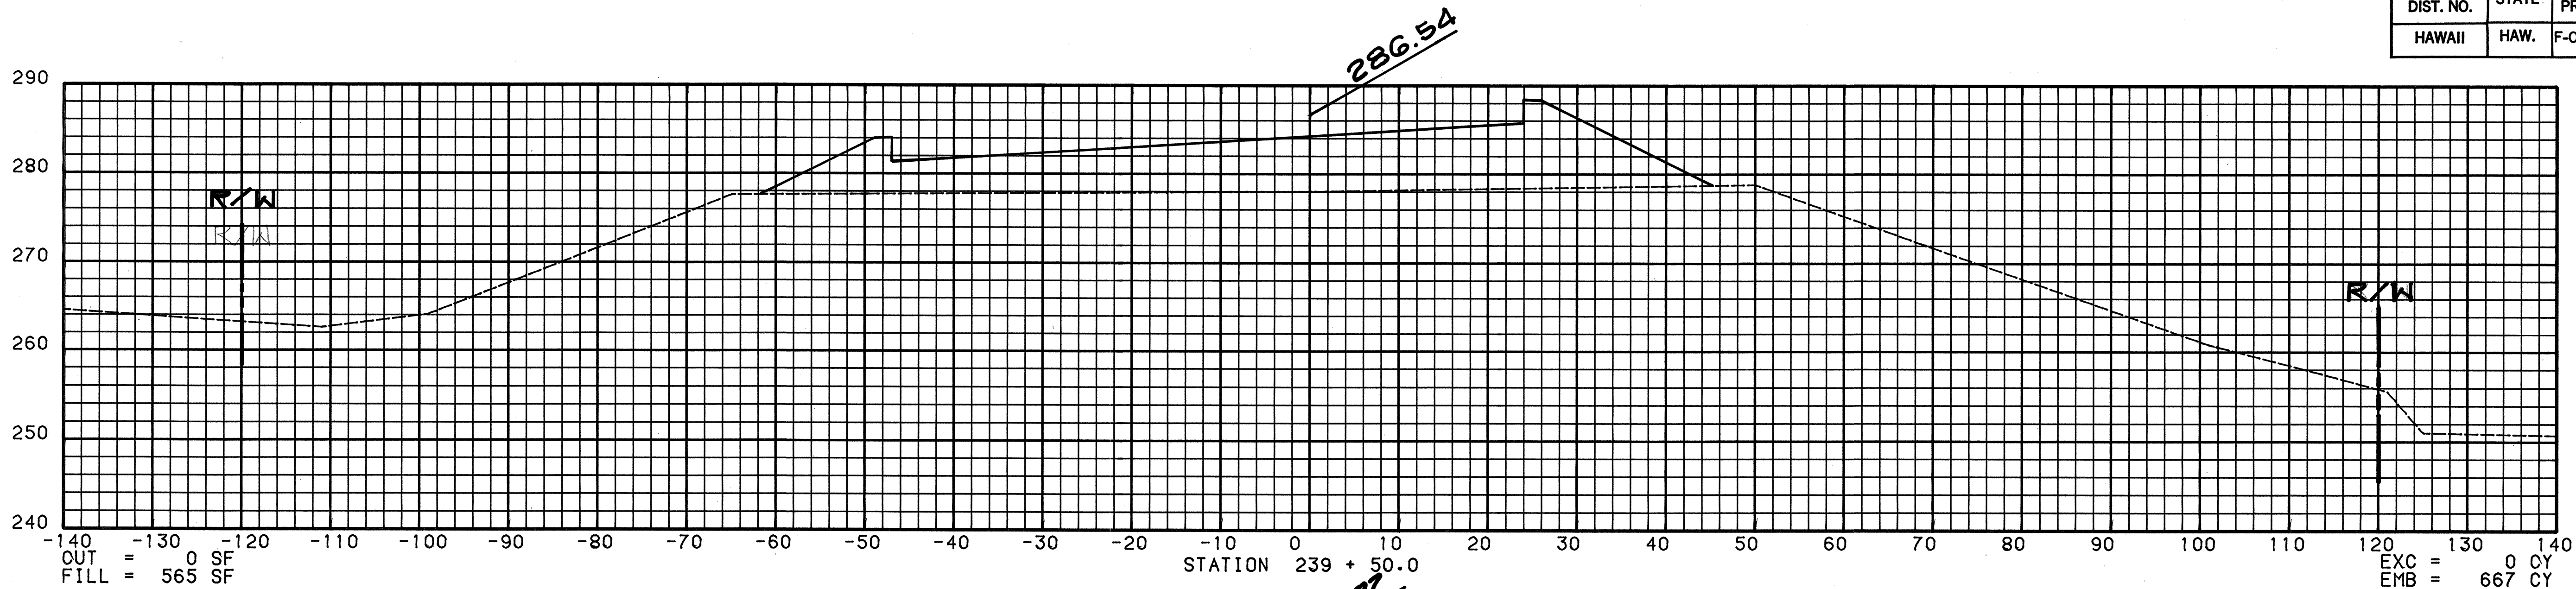

SCALE : HORIZONTAL 1 INCH = 10 FEET
 VERTICAL 1 INCH = 10 FEET

ORIGINAL PLAN
 SURVEY PLOTTED BY
 DRAWN BY
 TRACED BY
 NOTE BOOK
 DESIGNED BY
 QUANTITIES BY
 CHECKED BY
 No.



FED. ROAD DIST. NO.	STATE	FED. AID PROJ. NO.	FISCAL YEAR	SHEET NO.	TOTAL SHEETS
HAWAII	HAW.	F-030-1(18)	1984	119	169

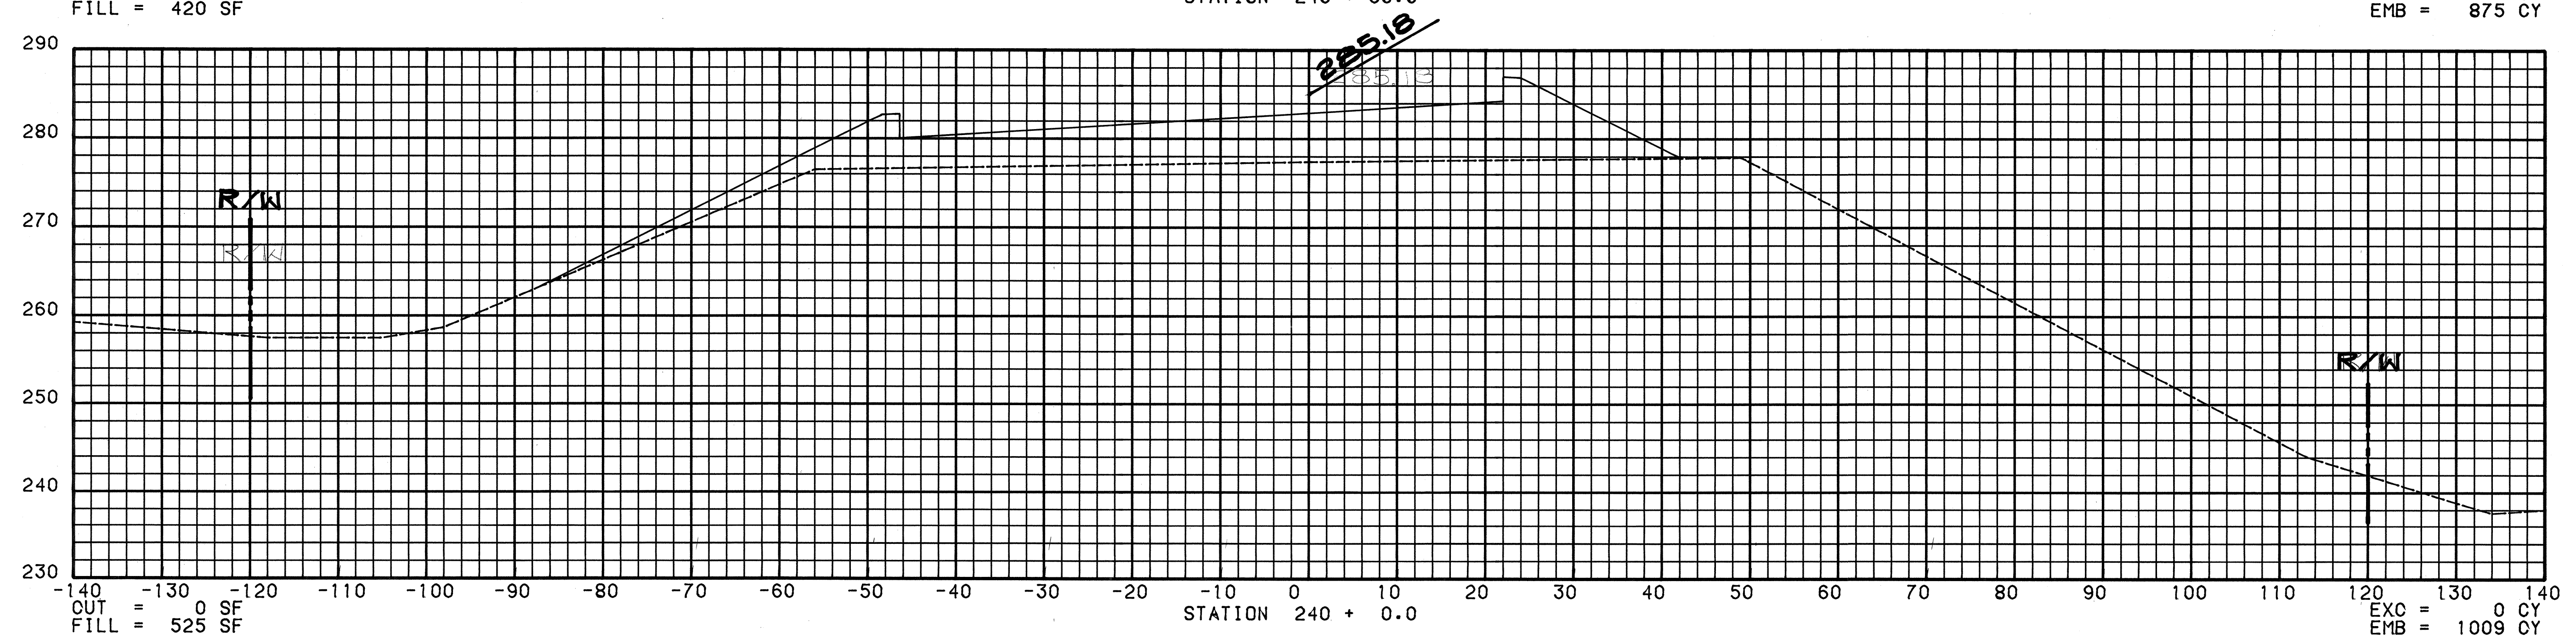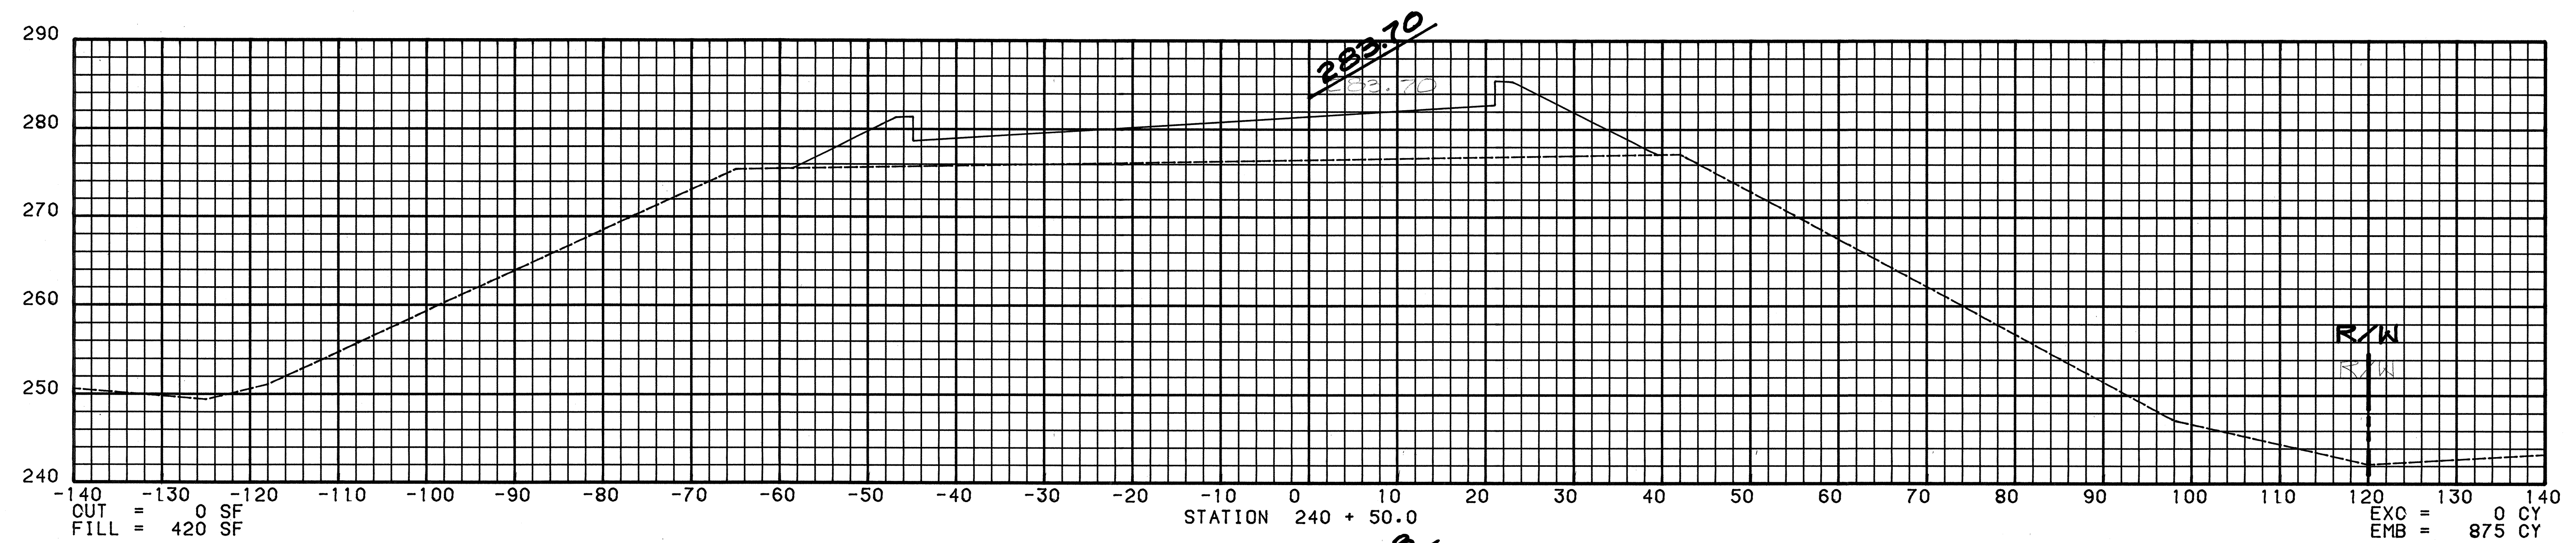

SCALE : HORIZONTAL 1 INCH = 10 FEET
VERTICAL 1 INCH = 10 FEET

ORIGINAL PLAN	SURVEY PLOTTED BY _____	DATE _____
	DRAWN BY _____	" _____
	TRACED BY _____	" _____
NOTE BOOK	DESIGNED BY _____	" _____
	QUANTITIES BY _____	" _____
No. _____	CHECKED BY _____	" _____



FED. ROAD DIST. NO.	STATE	FED. AID PROJ. NO.	FISCAL YEAR	SHEET NO.	TOTAL SHEETS
HAWAII	HAW.	F-030-1(18)	1984	120	169

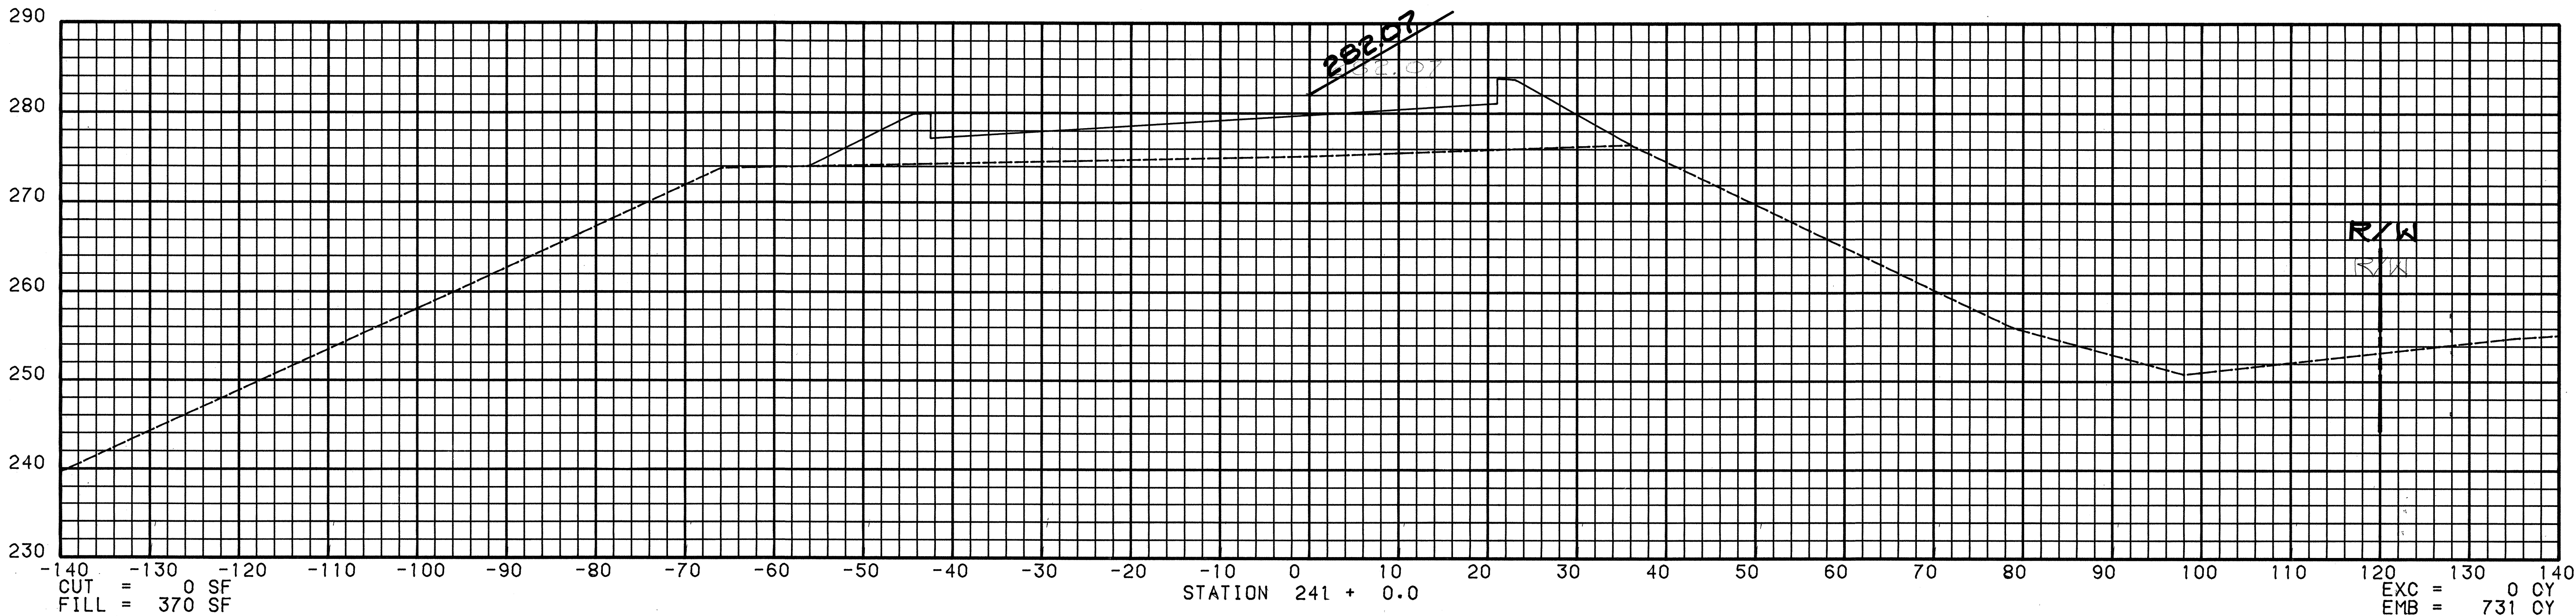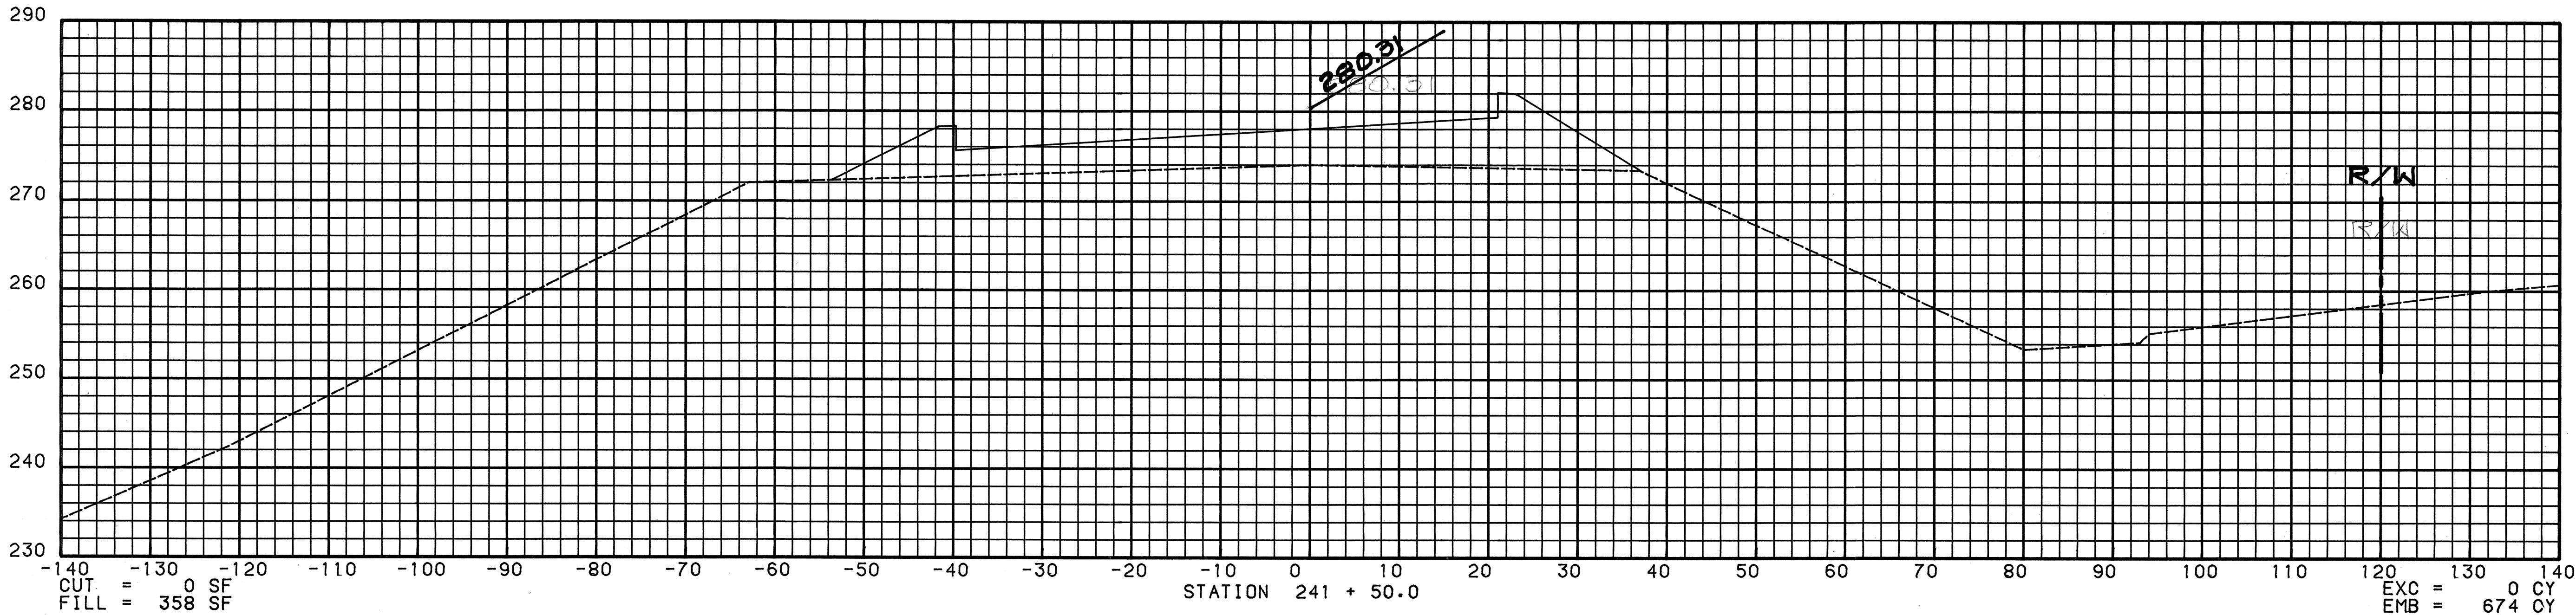

SCALE : HORIZONTAL 1 INCH = 10 FEET
VERTICAL 1 INCH = 10 FEET



ORIGINAL PLAN	SURVEY PLOTTED BY	DATE
NOTE BOOK	DRAWN BY	"
No.	TRACED BY	"
	DESIGNED BY	"
	QUANTITIES BY	"
	CHECKED BY	"

FED. ROAD DIST. NO.	STATE	FED. AID PROJ. NO.	FISCAL YEAR	SHEET NO.	TOTAL SHEETS
HAWAII	HAW.	F-030-1(18)	1984	121	169

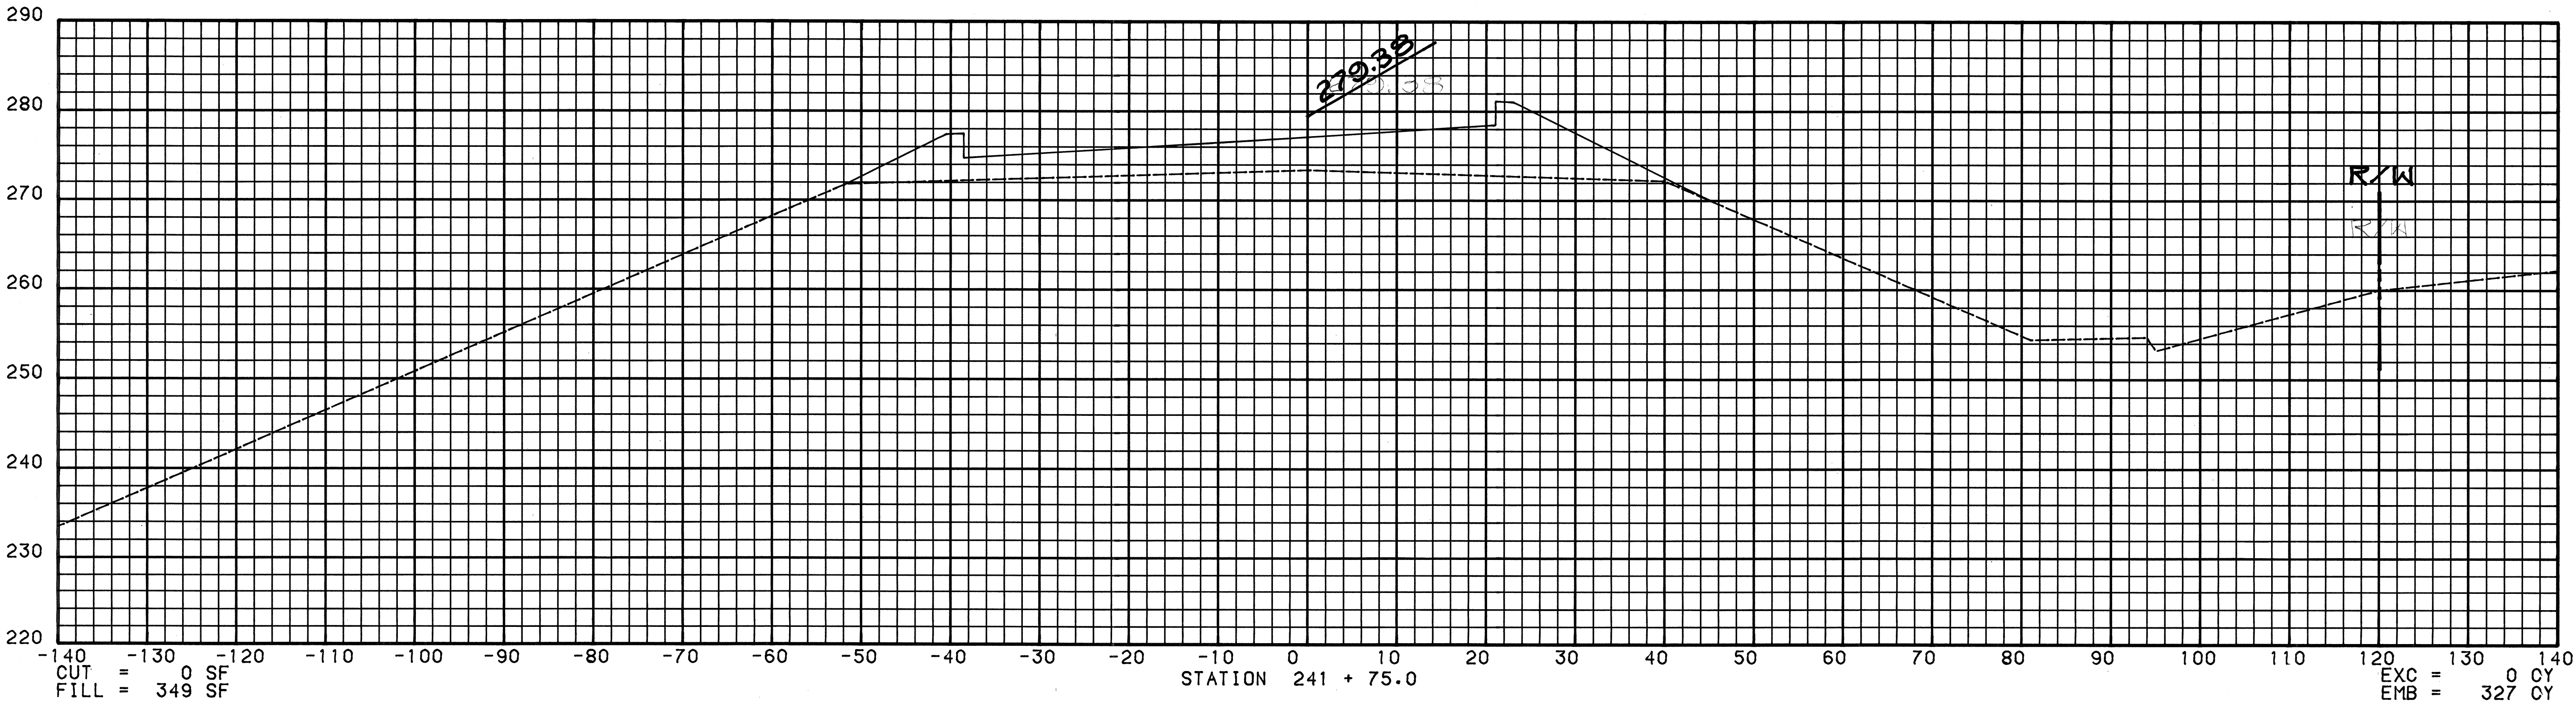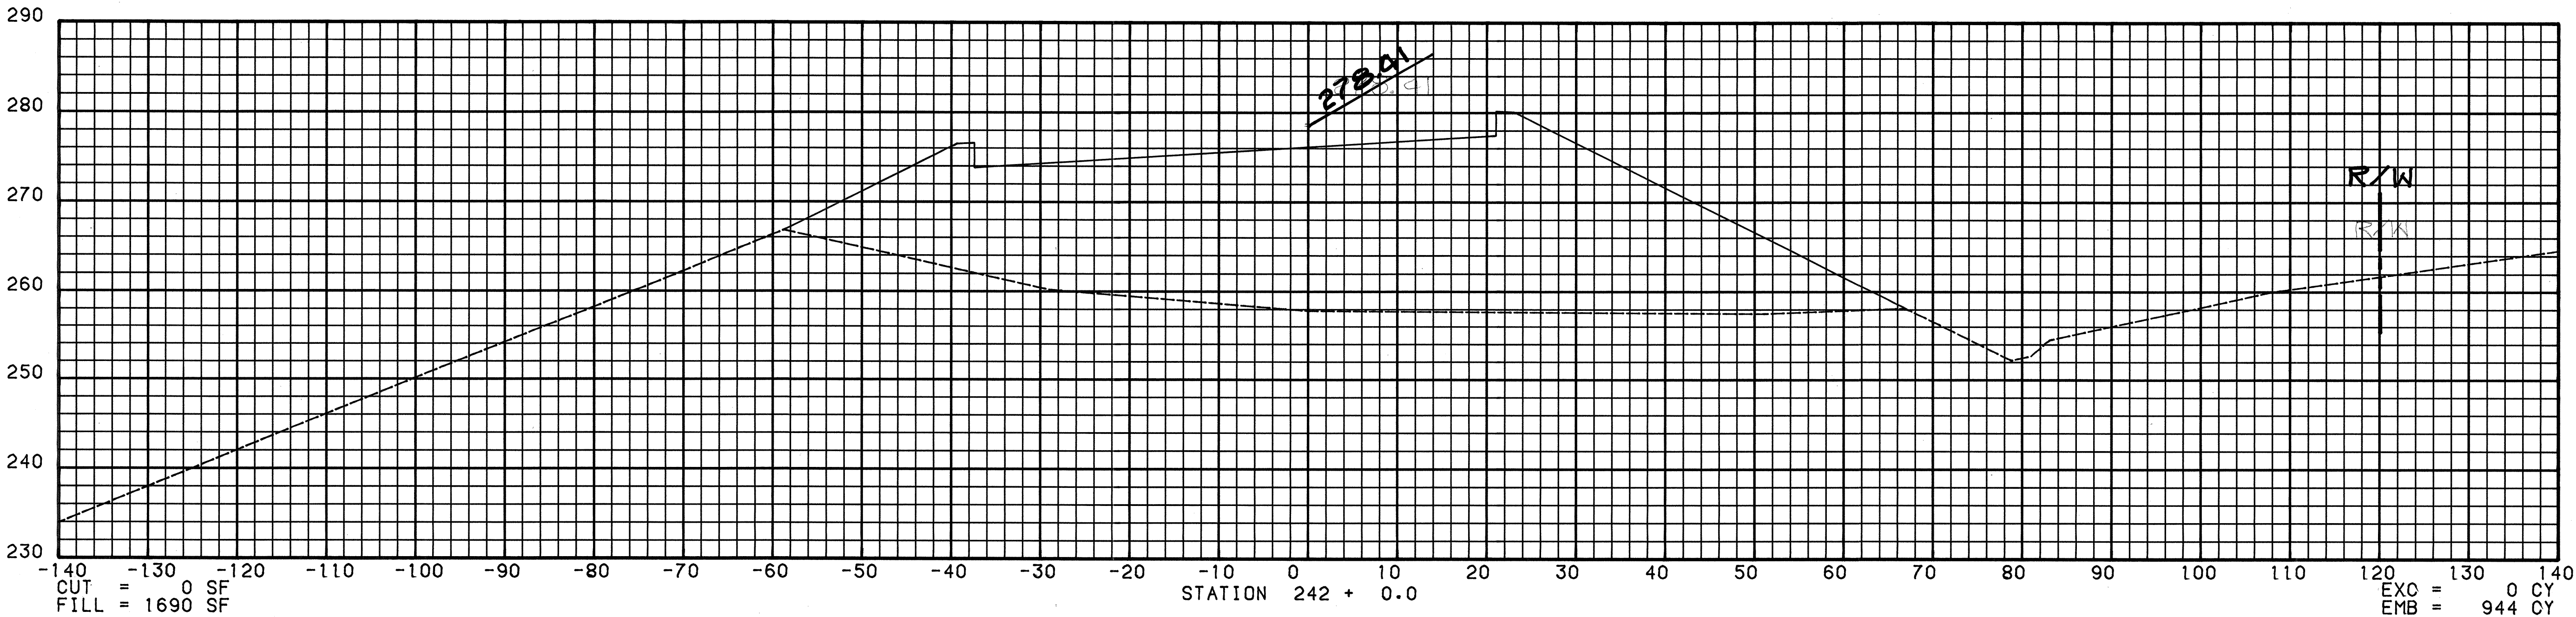


SCALE : HORIZONTAL 1 INCH = 10 FEET
VERTICAL 1 INCH = 10 FEET

FED. ROAD DIST. NO.	STATE	FED. AID PROJ. NO.	FISCAL YEAR	SHEET NO.	TOTAL SHEETS
HAWAII	HAW.	F-030-1(18)	1984	122	169

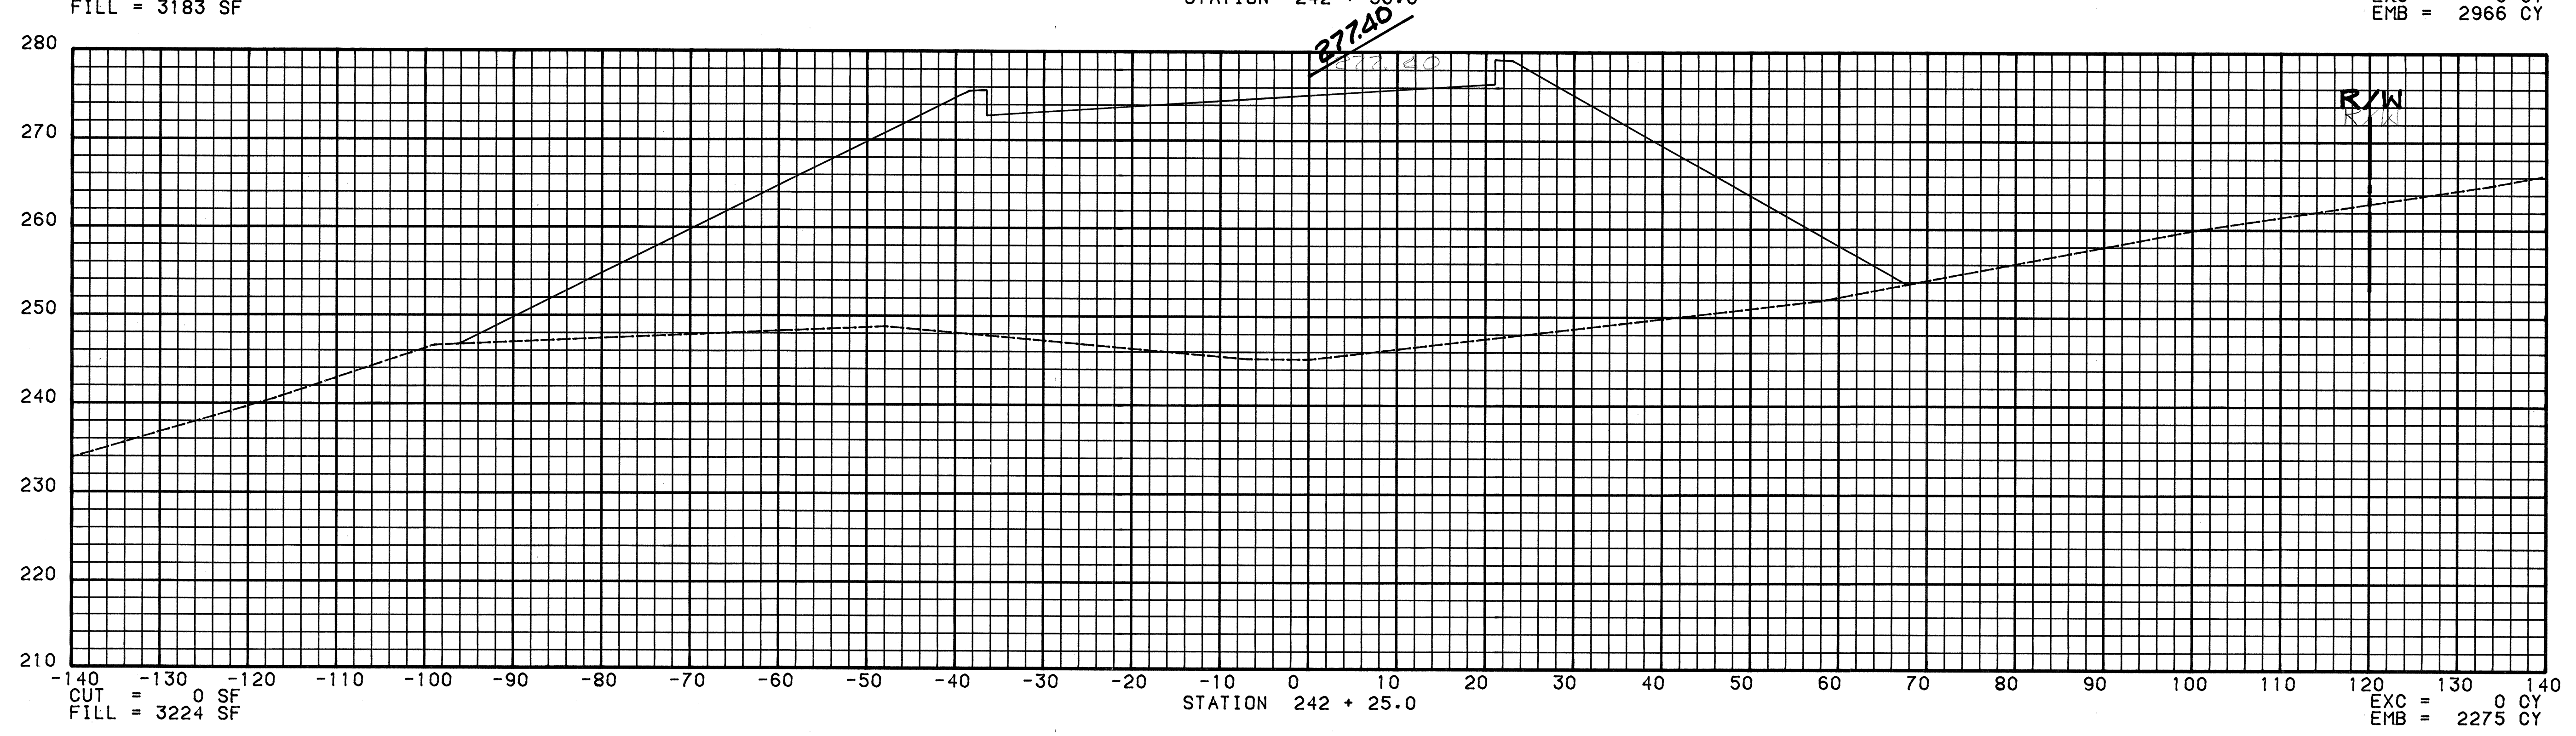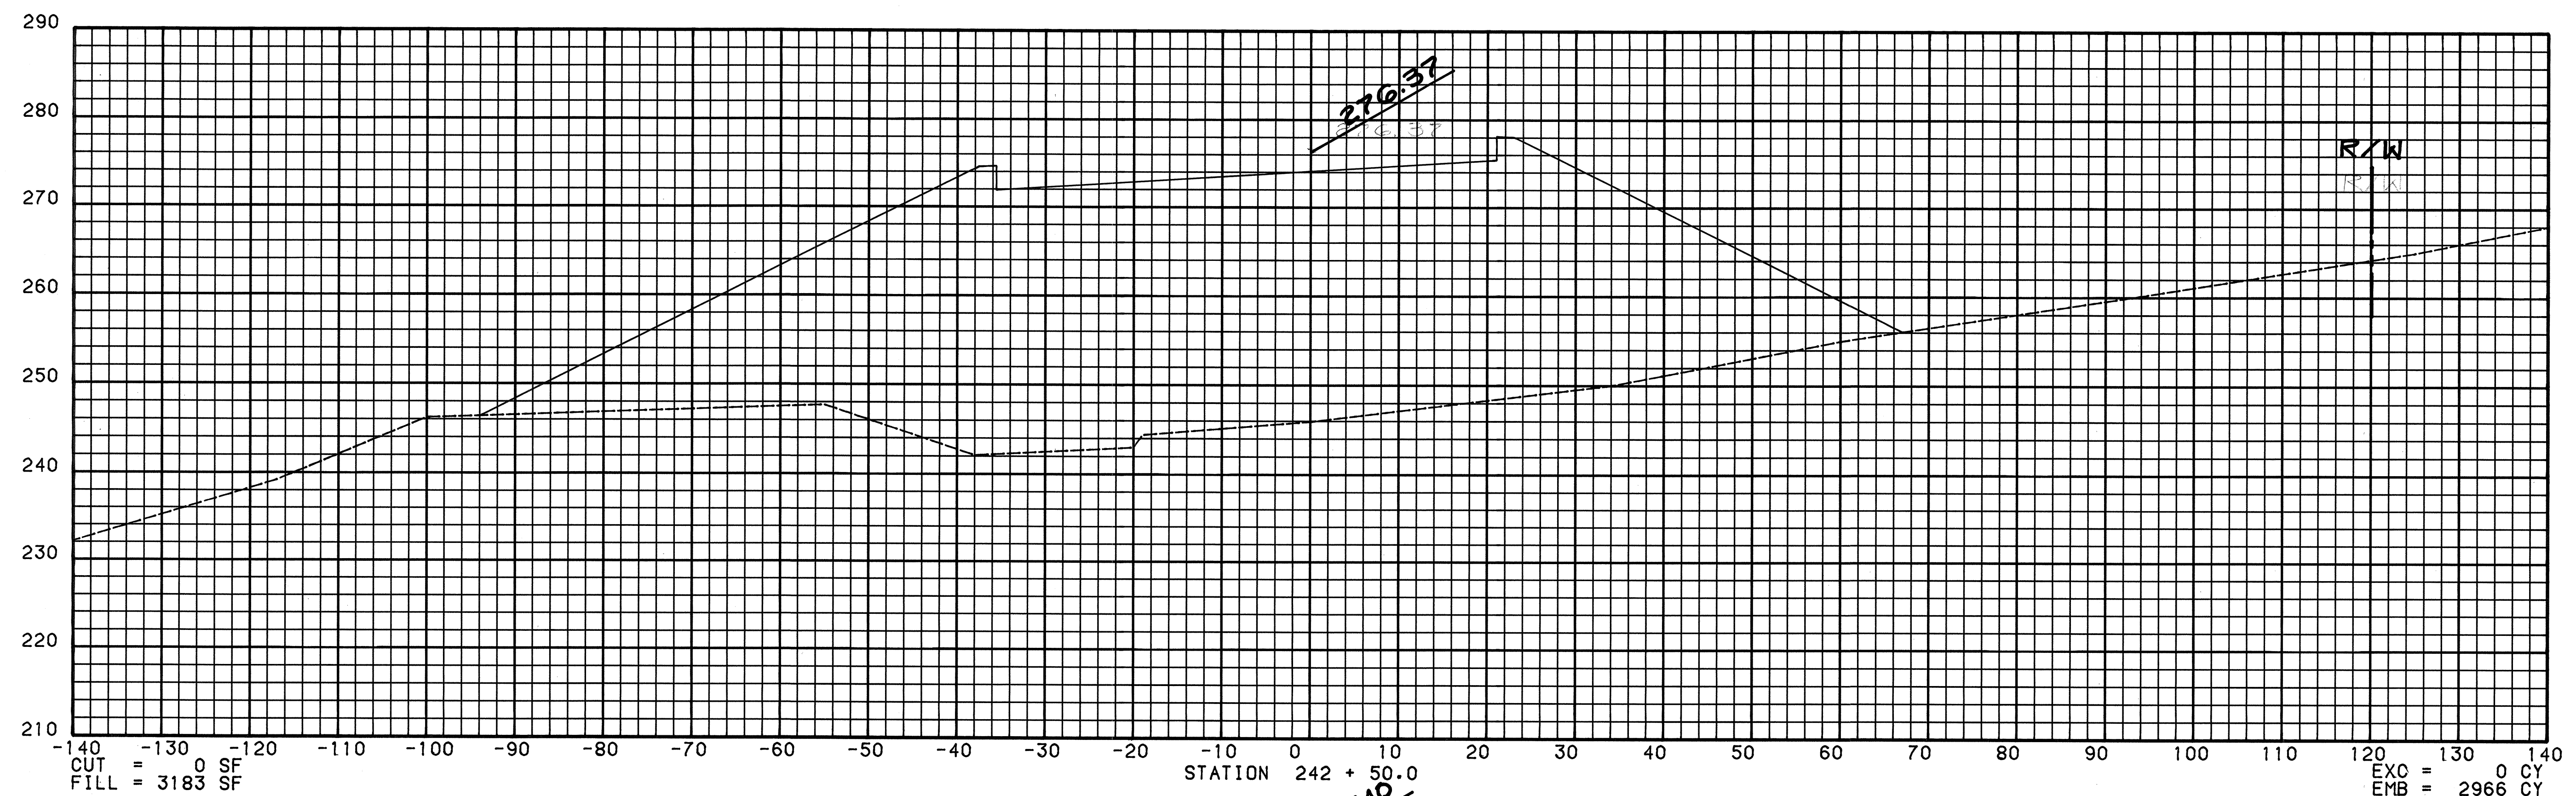

SCALE : HORIZONTAL 1 INCH = 10 FEET
VERTICAL 1 INCH = 10 FEET

FED. ROAD DIST. NO.	STATE	FED. AID PROJ. NO.	FISCAL YEAR	SHEET NO.	TOTAL SHEETS
HAWAII	HAW.	F-030-1(18)	1984	123	169

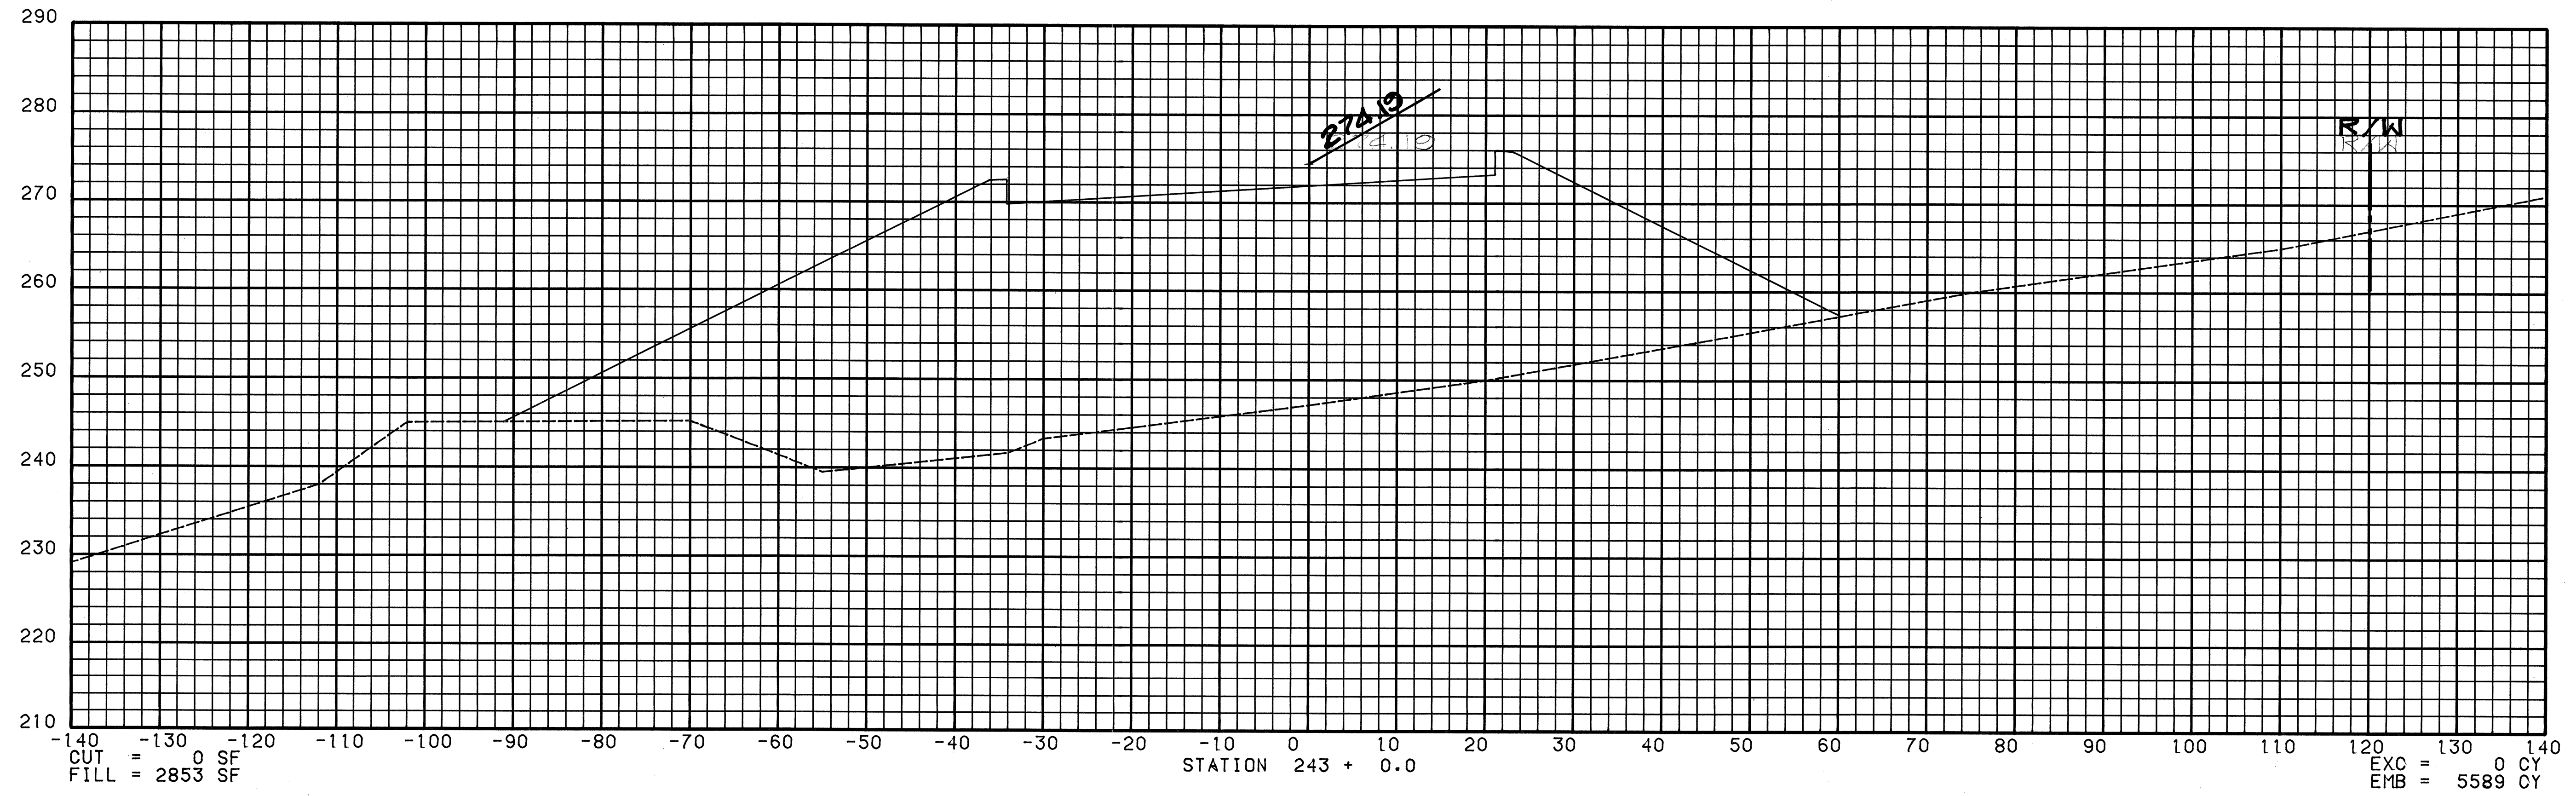


SCALE : HORIZONTAL 1 INCH = 10 FEET
VERTICAL 1 INCH = 10 FEET

ORIGINAL
PLAN
No.

SURVEY PLOTTED BY
DATE


DRAWN BY
TRACED BY
DESIGNED BY
QUANTITIES BY
CHECKED BY

FED. ROAD DIST. NO.	STATE	FED. AID PROJ. NO.	FISCAL YEAR	SHEET NO.	TOTAL SHEETS
HAWAII	HAW.	F-030-1(18)	1984	124	169

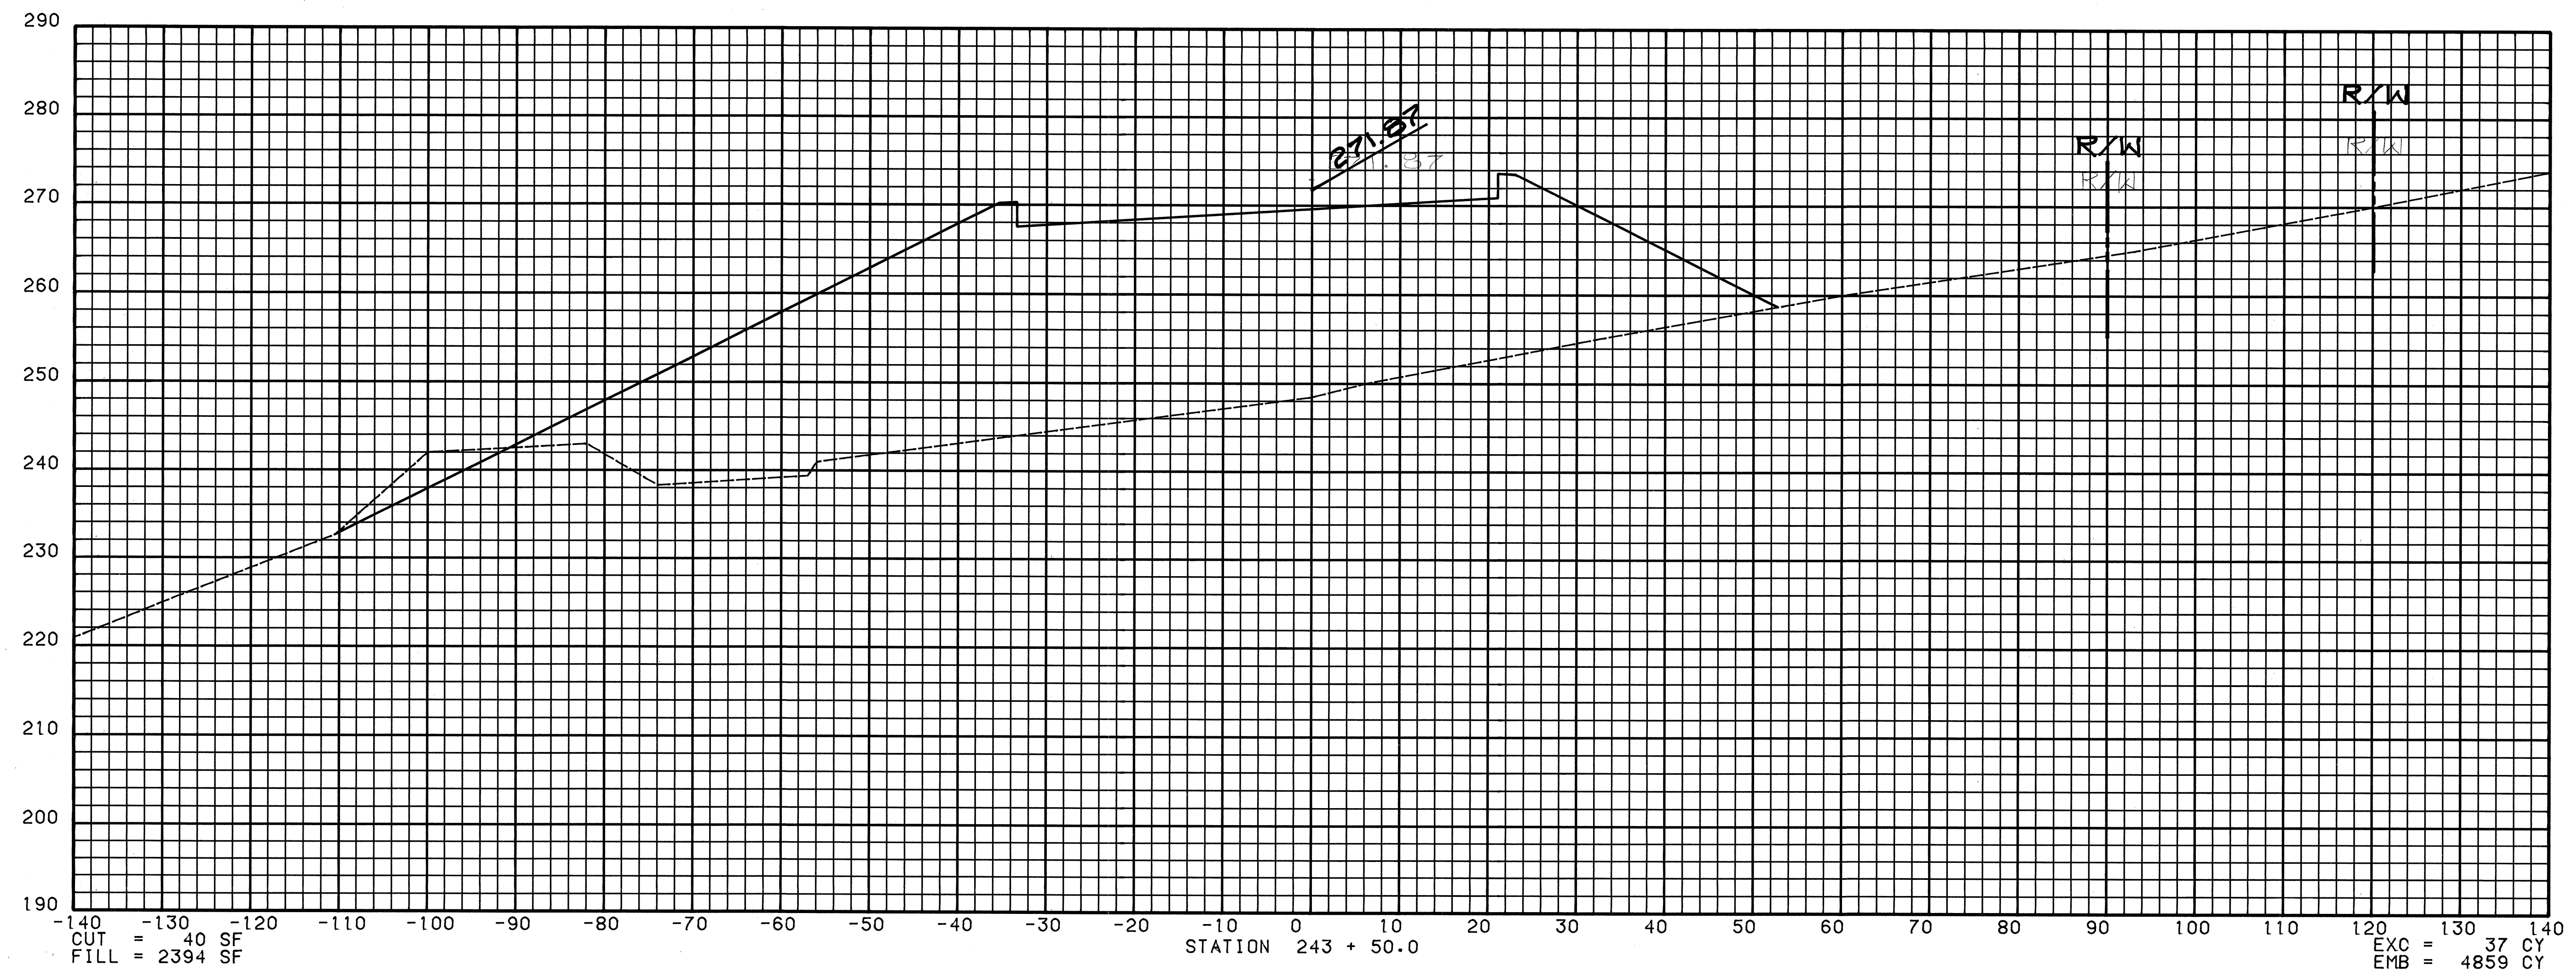


SCALE : HORIZONTAL 1 INCH = 10 FEET
VERTICAL 1 INCH = 10 FEET

FED. ROAD DIST. NO.	STATE	FED. AID PROJ. NO.	FISCAL YEAR	SHEET NO.	TOTAL SHEETS
HAWAII	HAW.	F-030-1(18)	1984	125	169

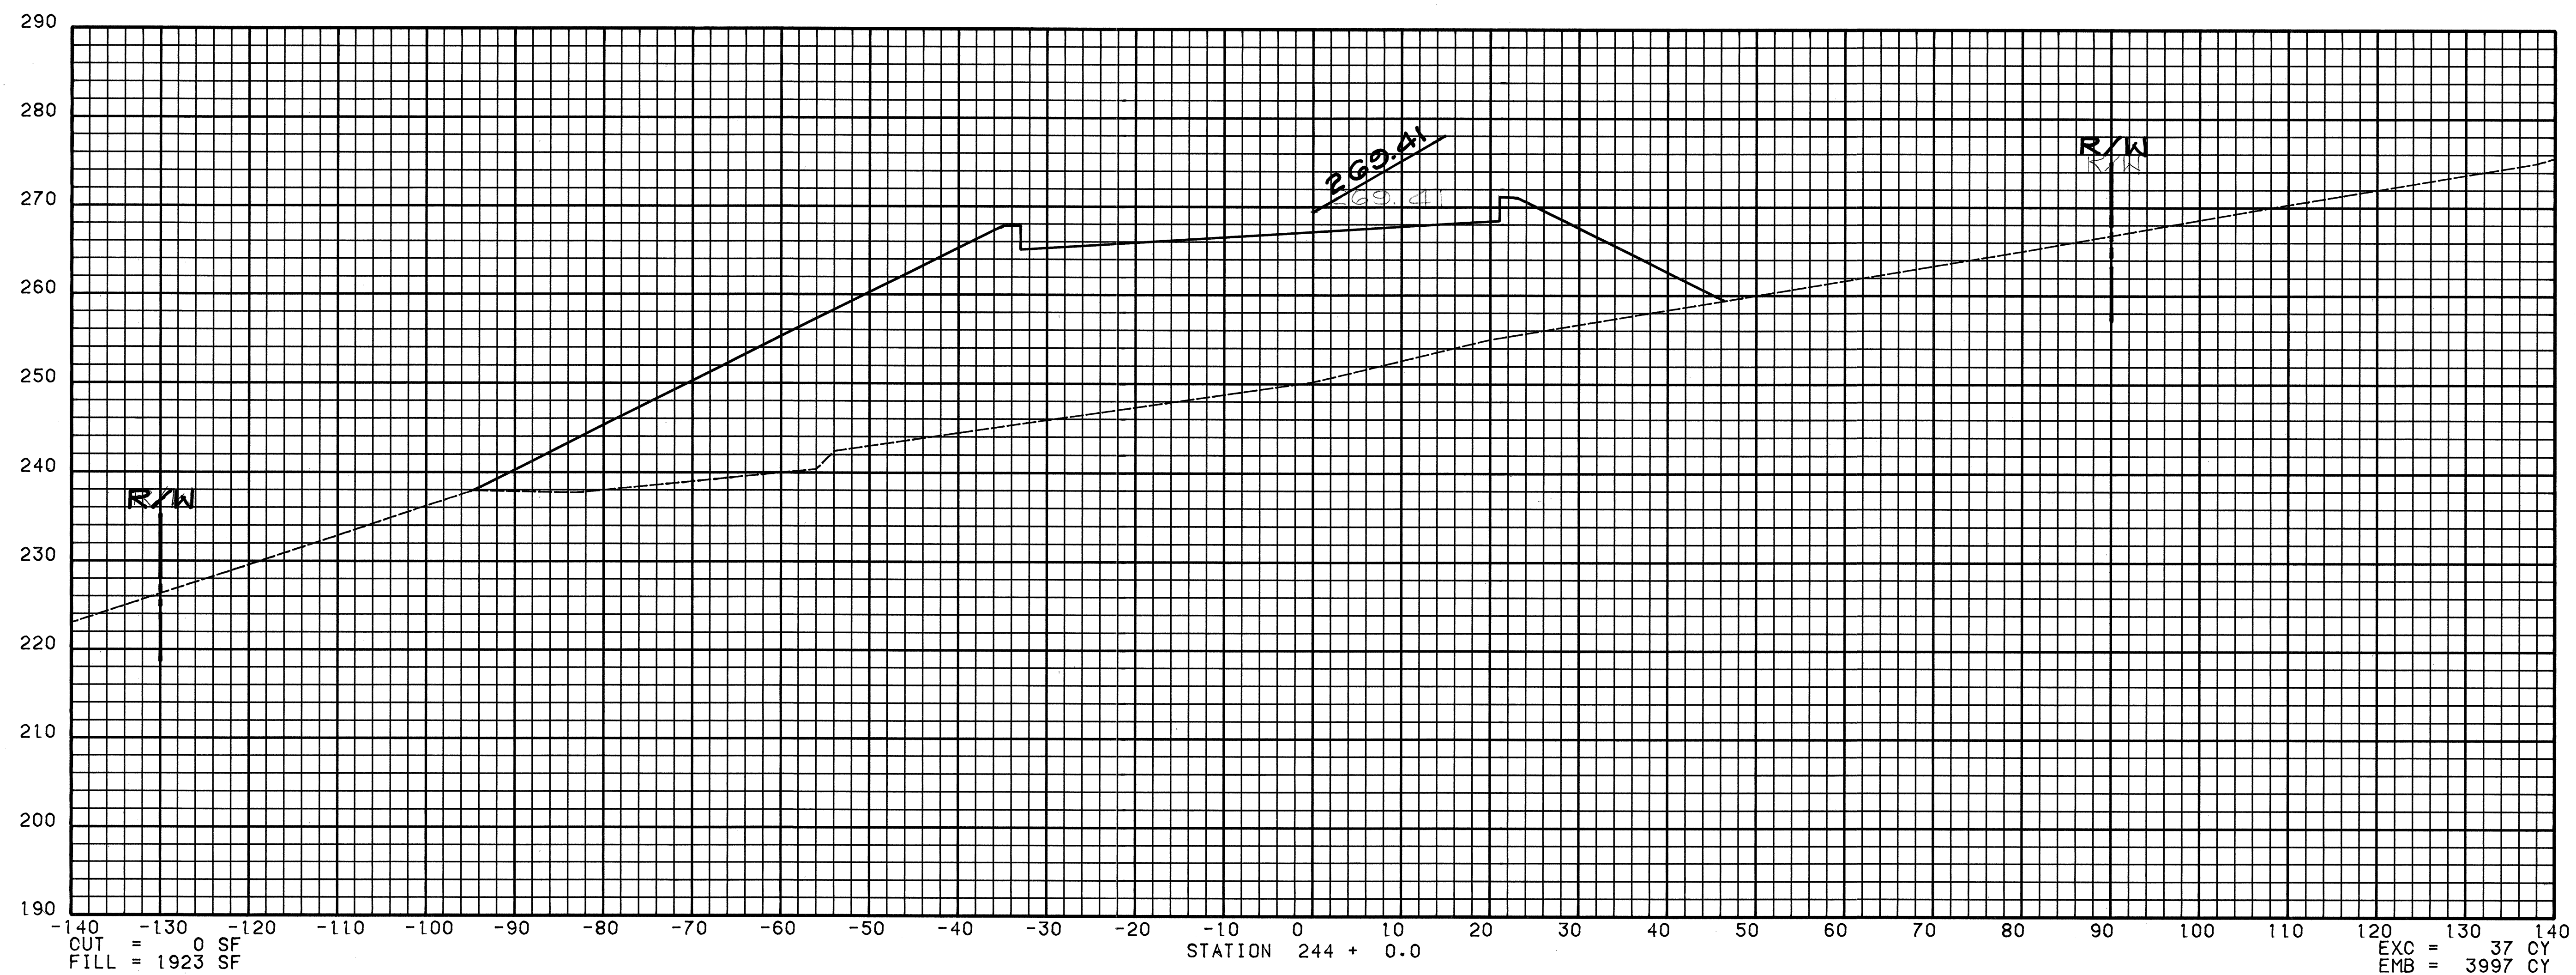


SCALE : HORIZONTAL 1 INCH = 10 FEET
VERTICAL 1 INCH = 10 FEET

FED. ROAD DIST. NO.	STATE	FED. AID PROJ. NO.	FISCAL YEAR	SHEET NO.	TOTAL SHEETS
HAWAII	HAW.	F-030-1(18)	1984	126	169


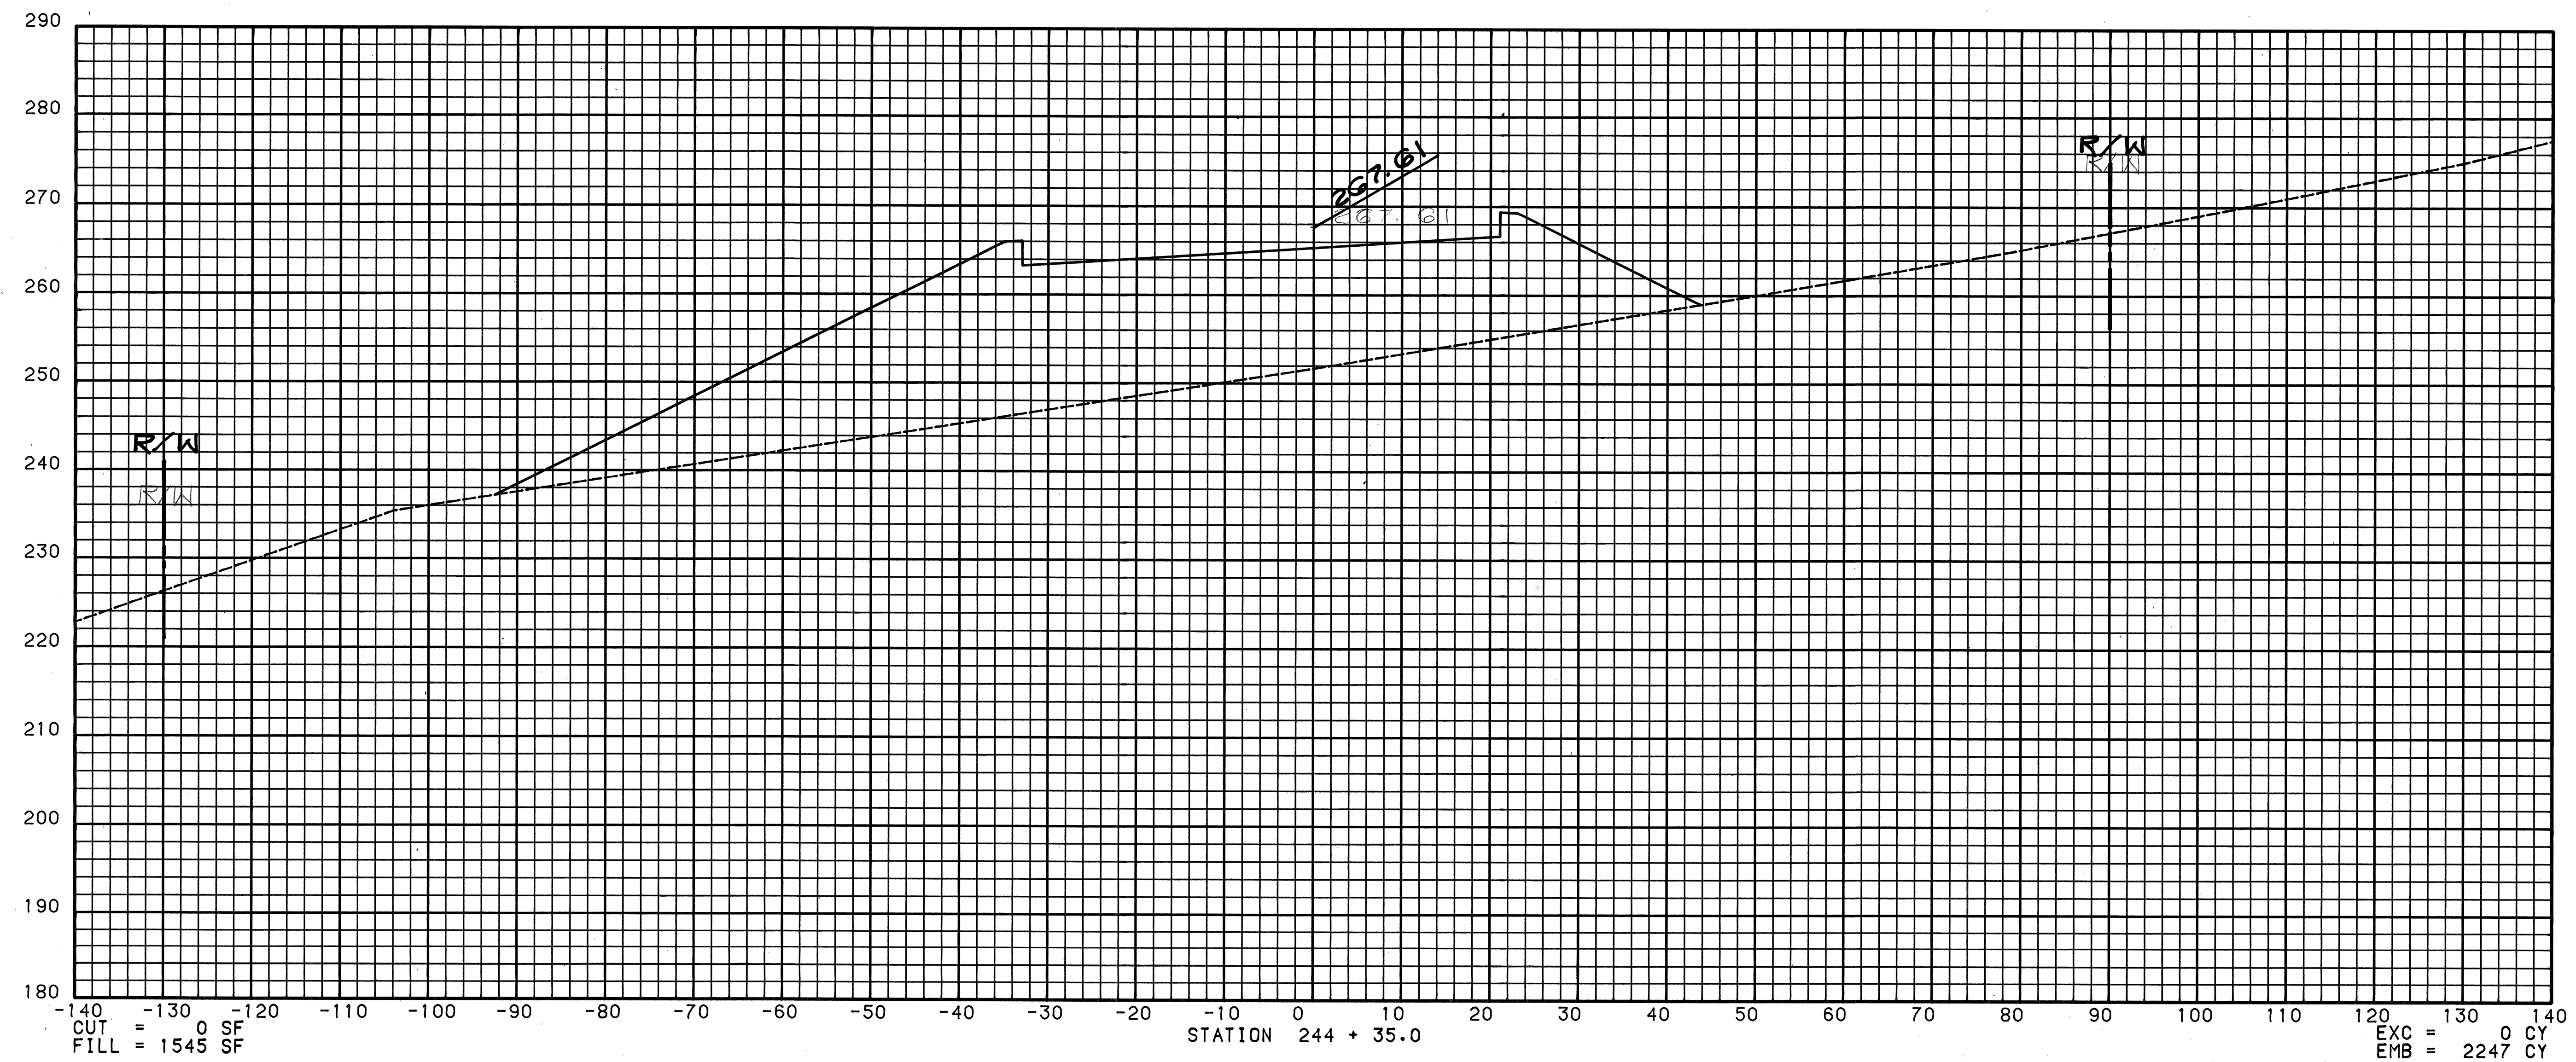


FED. ROAD DIST. NO.	STATE	FED. AID PROJ. NO.	FISCAL YEAR	SHEET NO.	TOTAL SHEETS
HAWAII	HAW.	F-030-1(18)	1984	127	169

ORIGINAL PLAN	SURVEY PLOTTED BY	DATE
NOTE BOOK No.	DRAWN BY	"
	TRACED BY	"
	DESIGNED BY	"
	QUANTITIES BY	"
	CHECKED BY	"

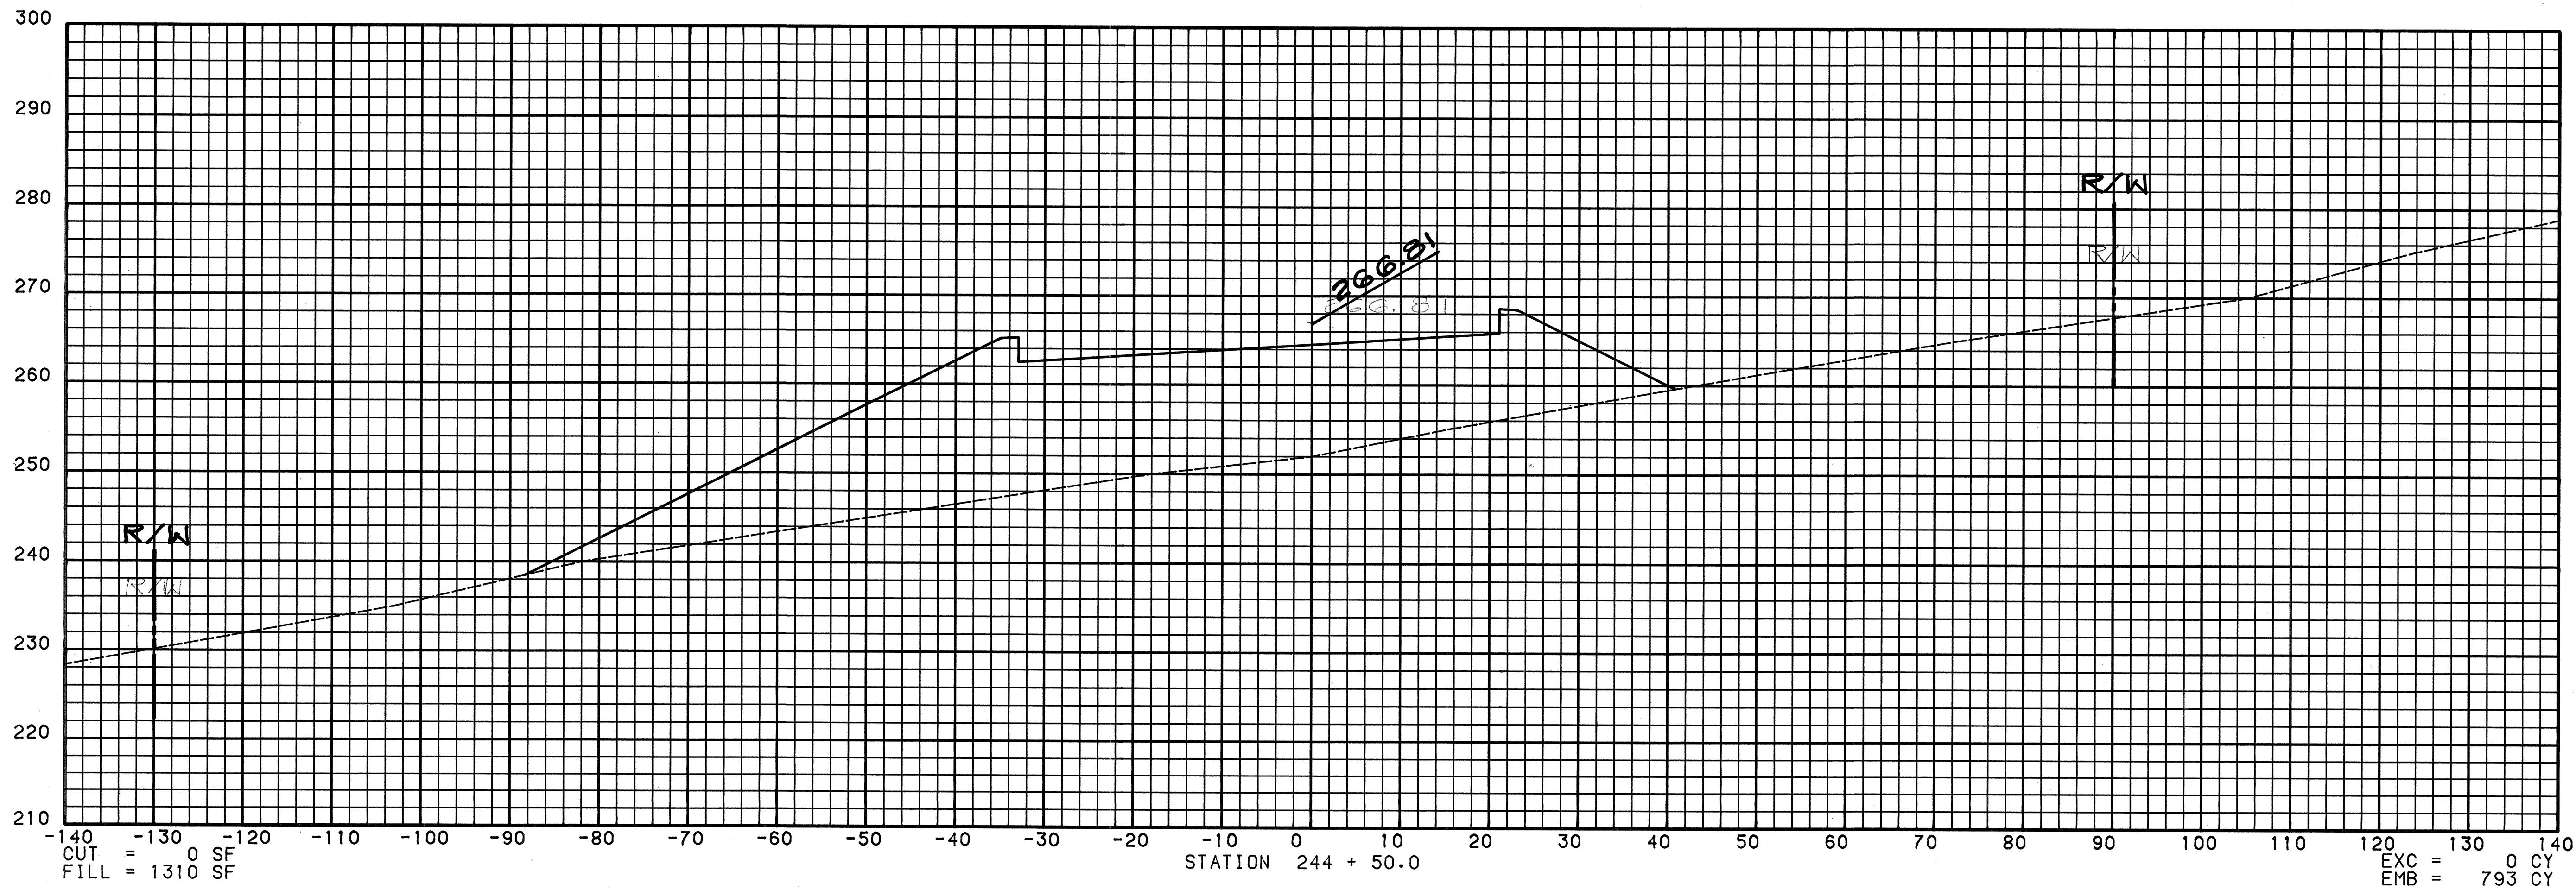



FED. ROAD DIST. NO.	STATE	FED. AID PROJ. NO.	FISCAL YEAR	SHEET NO.	TOTAL SHEETS
HAWAII	HAW.	F-030-1(18)	1984	128	169

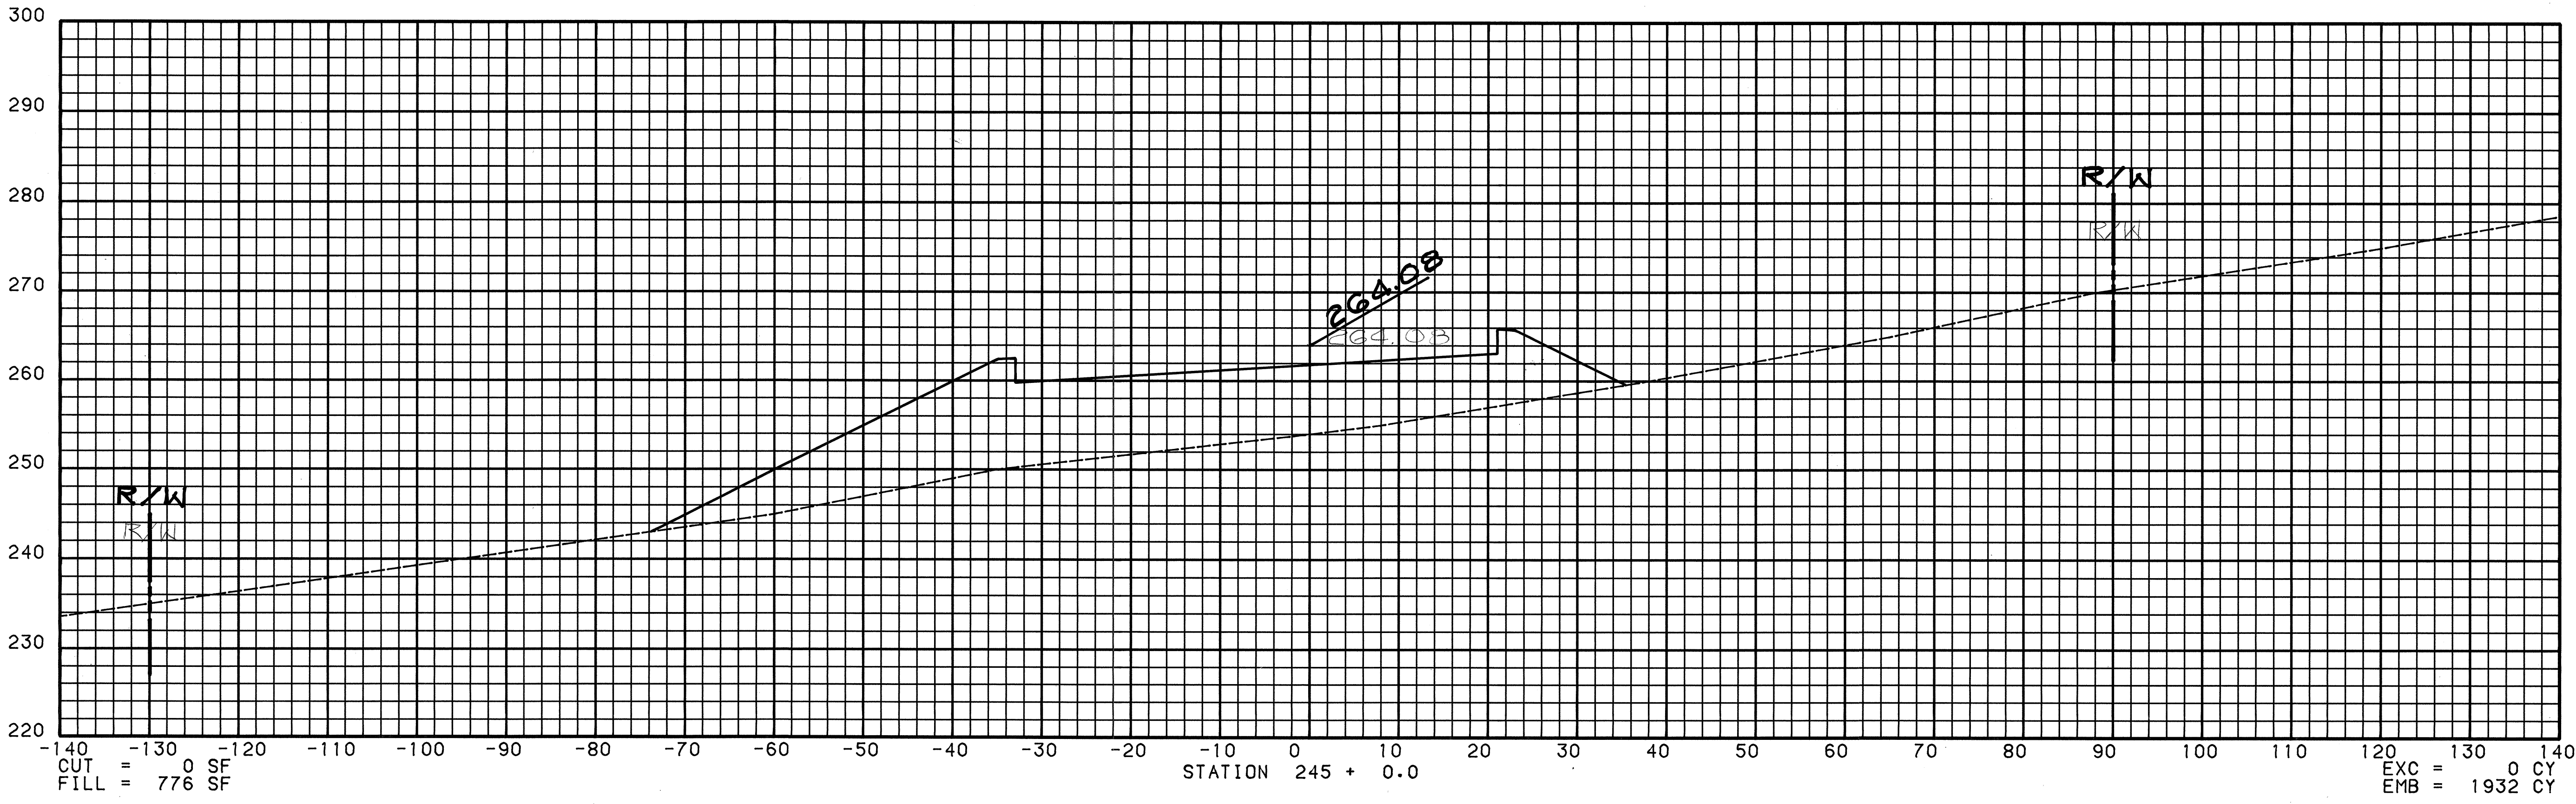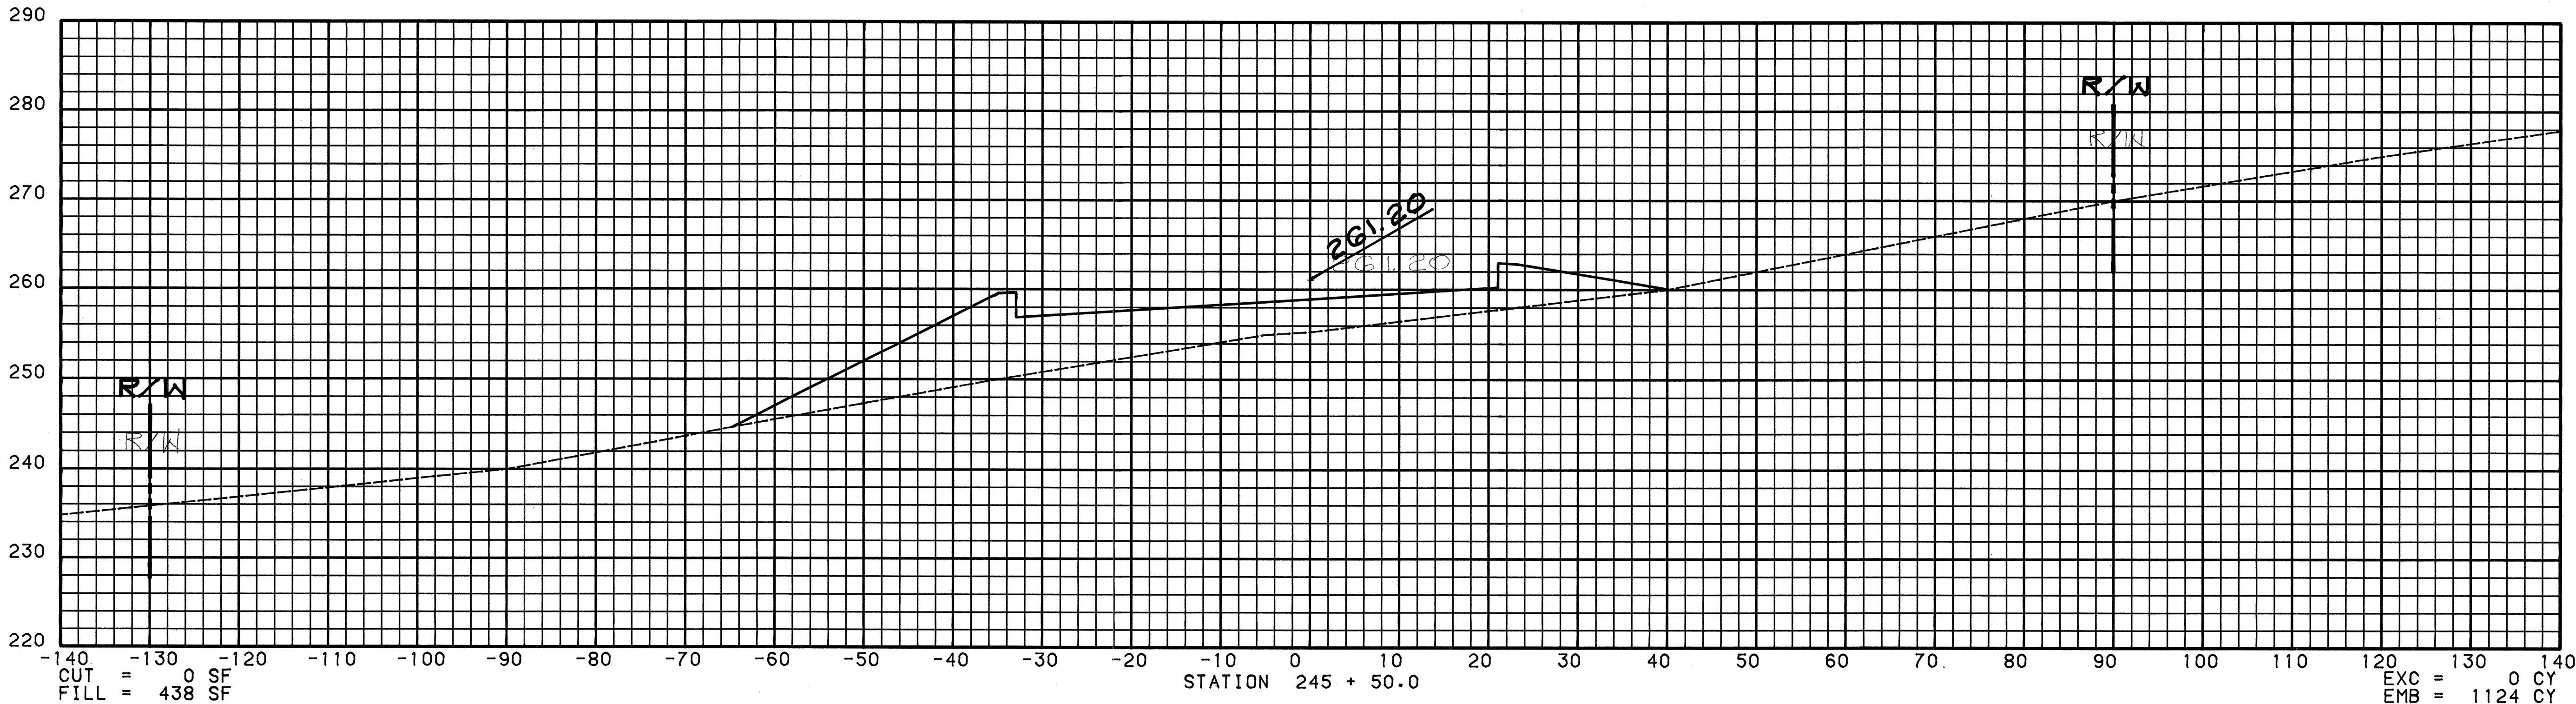

SCALE : HORIZONTAL 1 INCH = 10 FEET
 VERTICAL 1 INCH = 10 FEET



ORIGINAL PLAN
 SURVEY PLOTTED BY
 DRAWN BY
 DESIGNED BY
 NOTE BOOK
 QUANTITIES BY
 CHECKED BY
 No.

FED. ROAD DIST. NO.	STATE	FED. AID PROJ. NO.	FISCAL YEAR	SHEET NO.	TOTAL SHEETS
HAWAII	HAW.	F-030-1(18)	1984	129	169

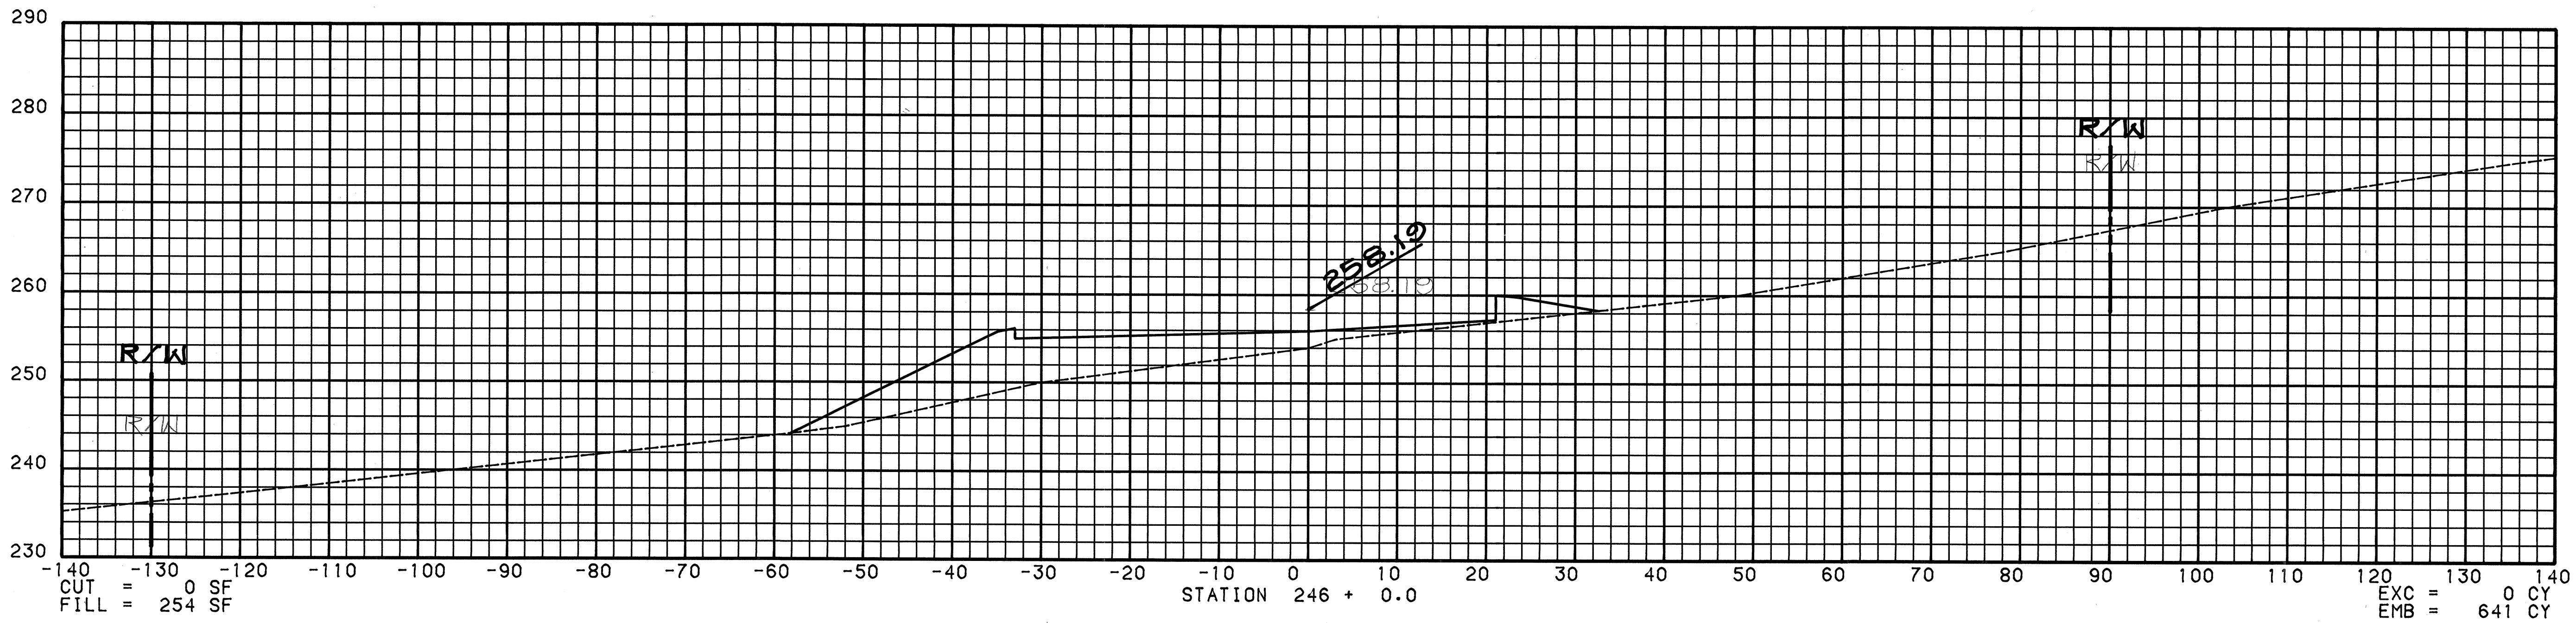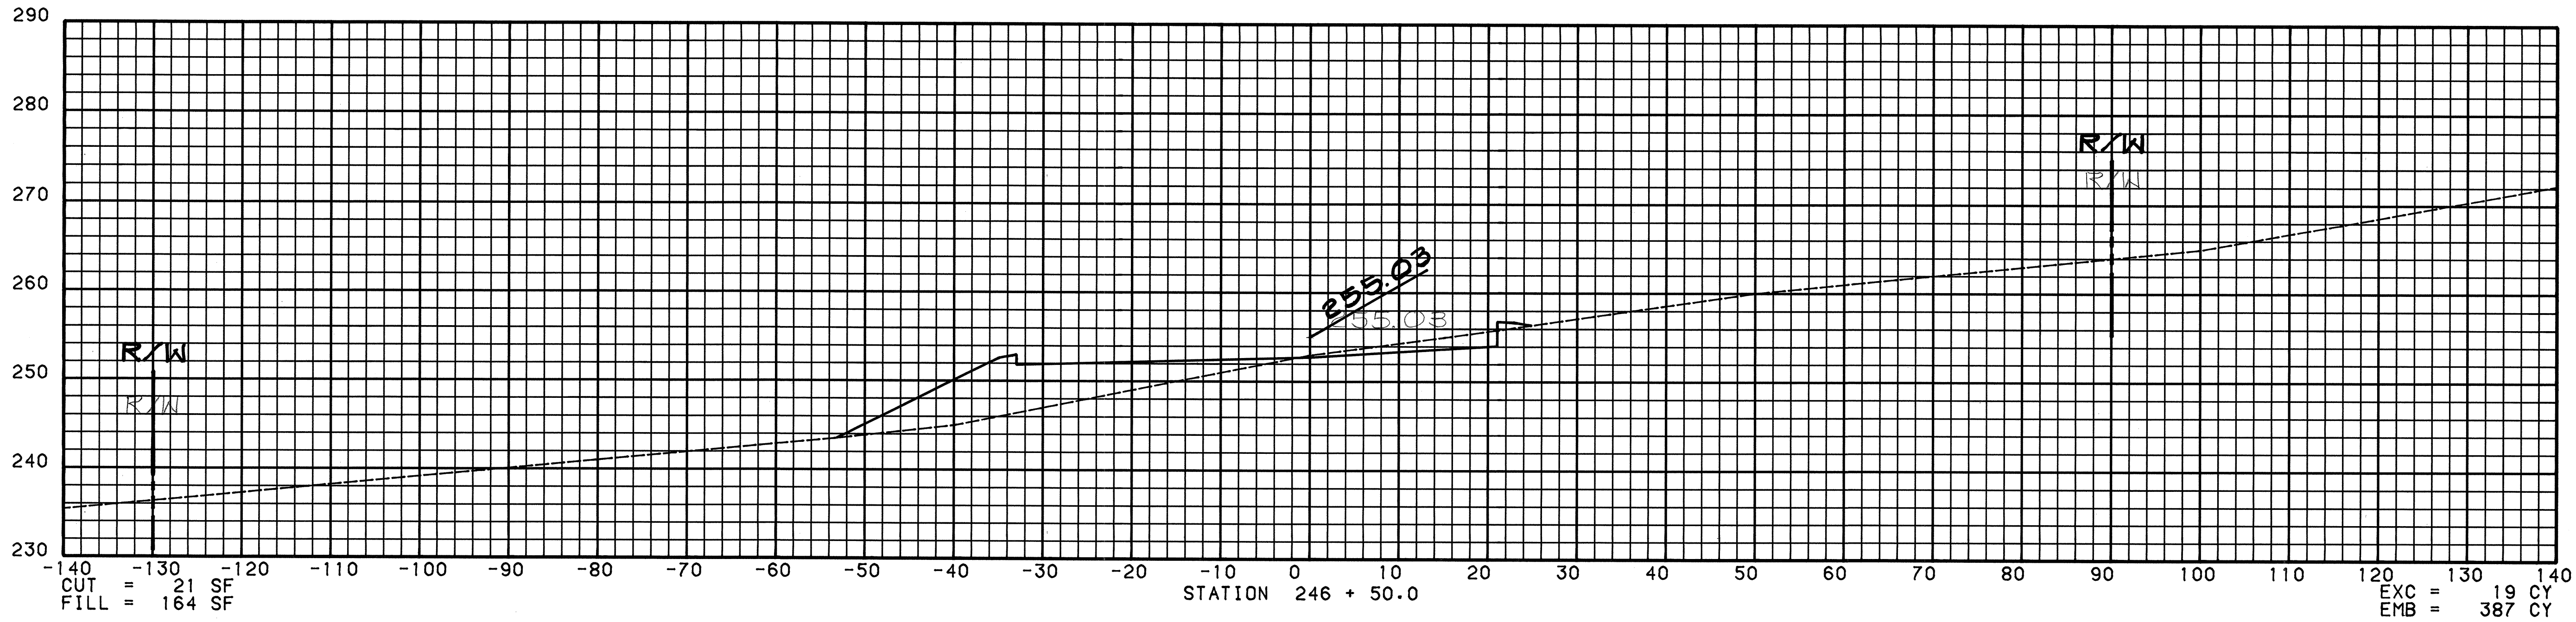




SCALE : HORIZONTAL 1 INCH = 10 FEET
VERTICAL 1 INCH = 10 FEET

FED. ROAD DIST. NO.	STATE	FED. AID PROJ. NO.	FISCAL YEAR	SHEET NO.	TOTAL SHEETS
HAWAII	HAW.	F-030-108	1984	130	169

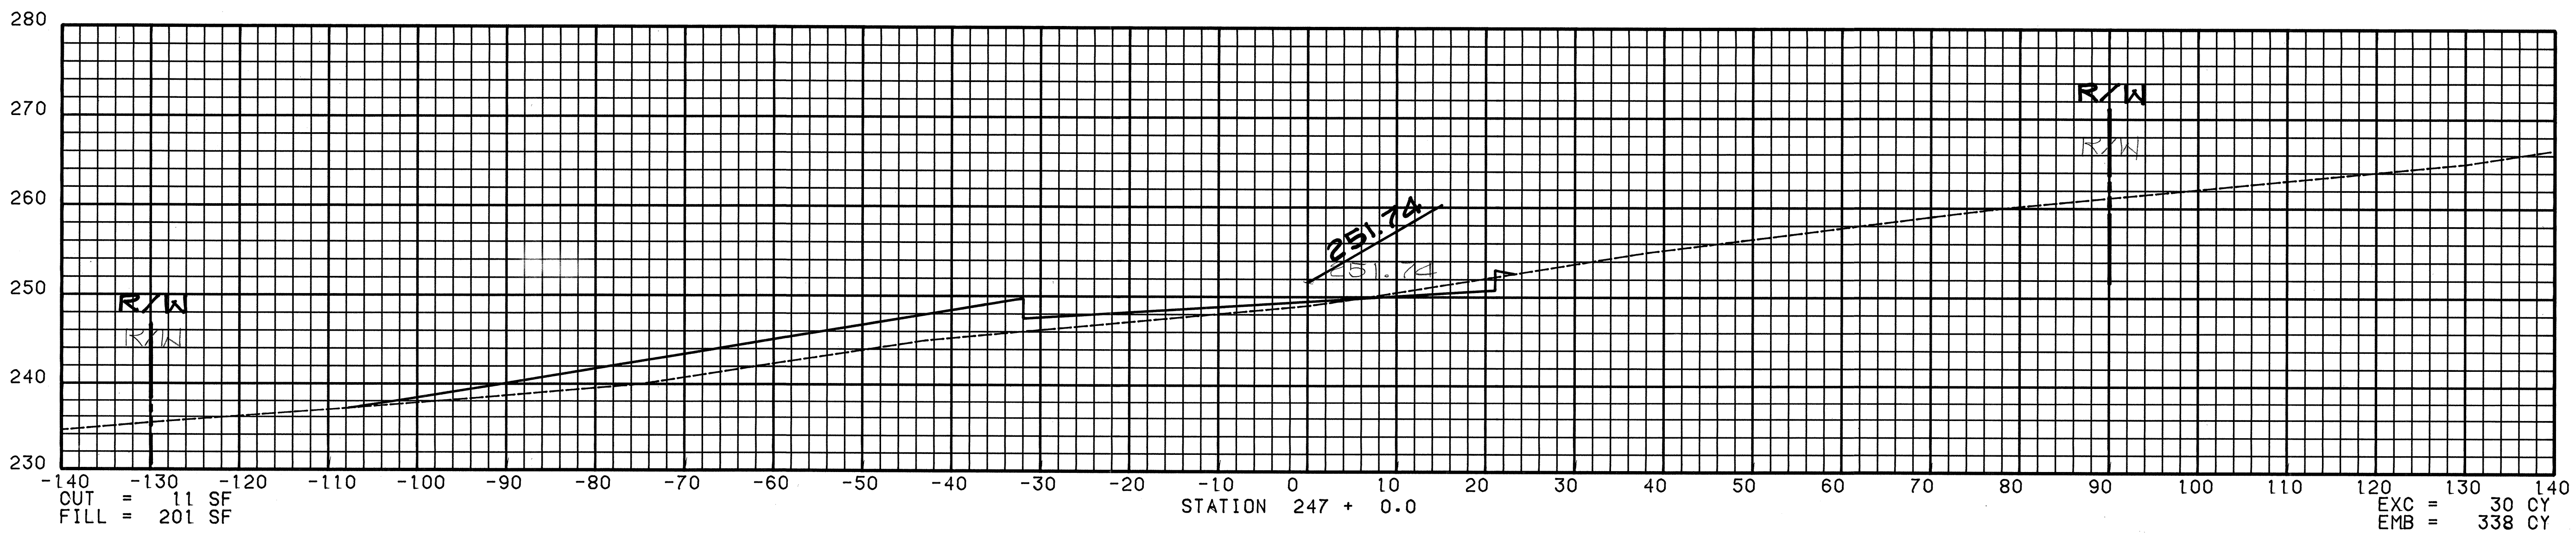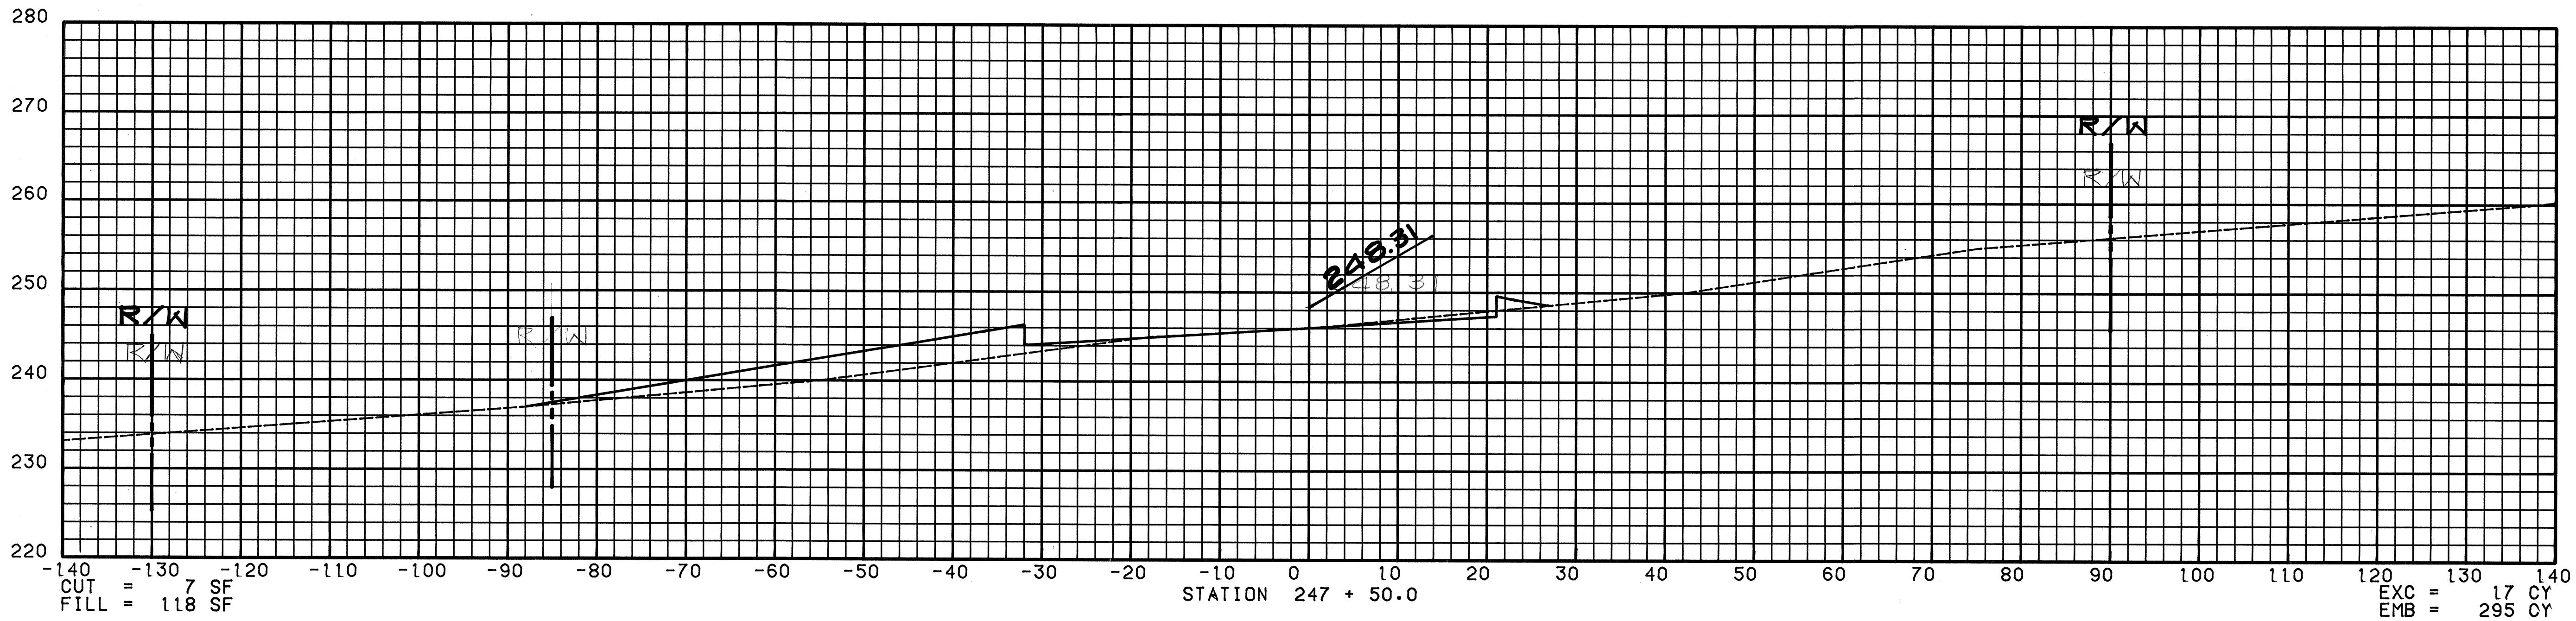

SCALE : HORIZONTAL 1 INCH = 10 FEET
VERTICAL 1 INCH = 10 FEET

FED. ROAD DIST. NO.	STATE	FED. AID PROJ. NO.	FISCAL YEAR	SHEET NO.	TOTAL SHEETS
HAWAII	HAW.	F-030-1(18)	1984	131	169


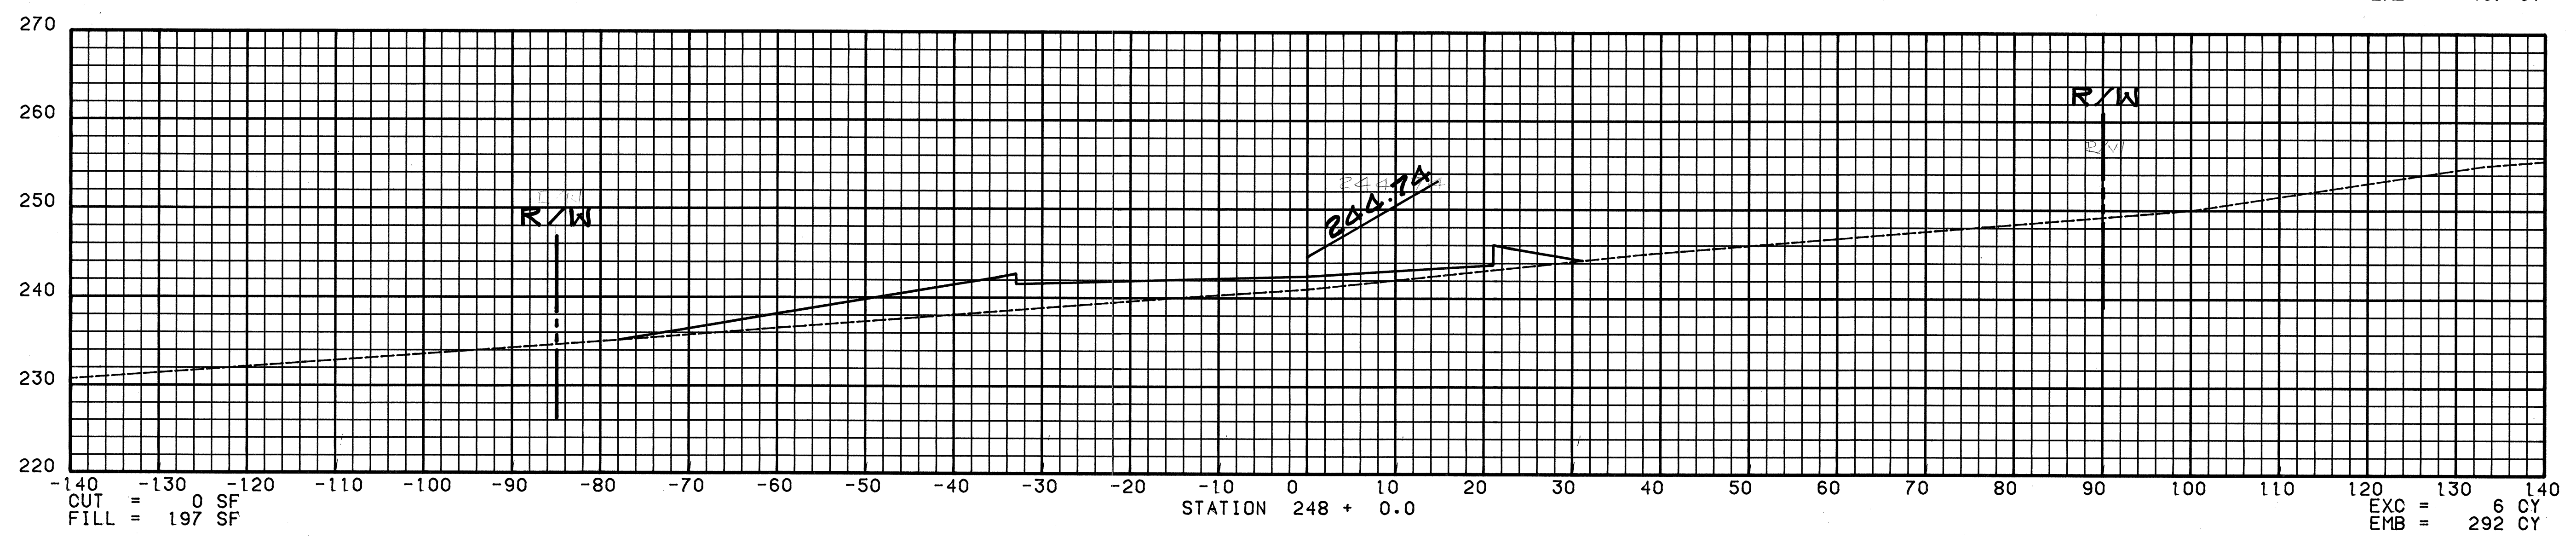
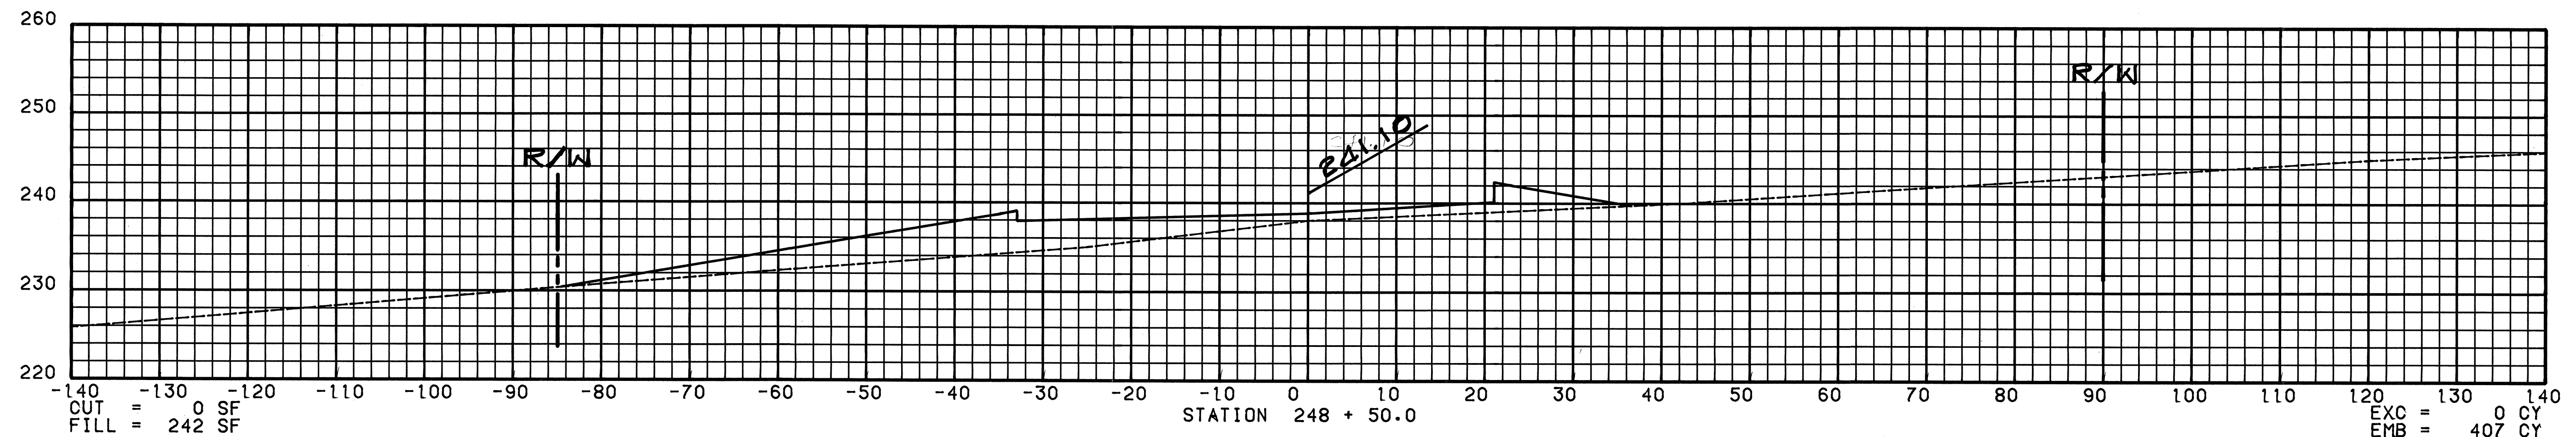
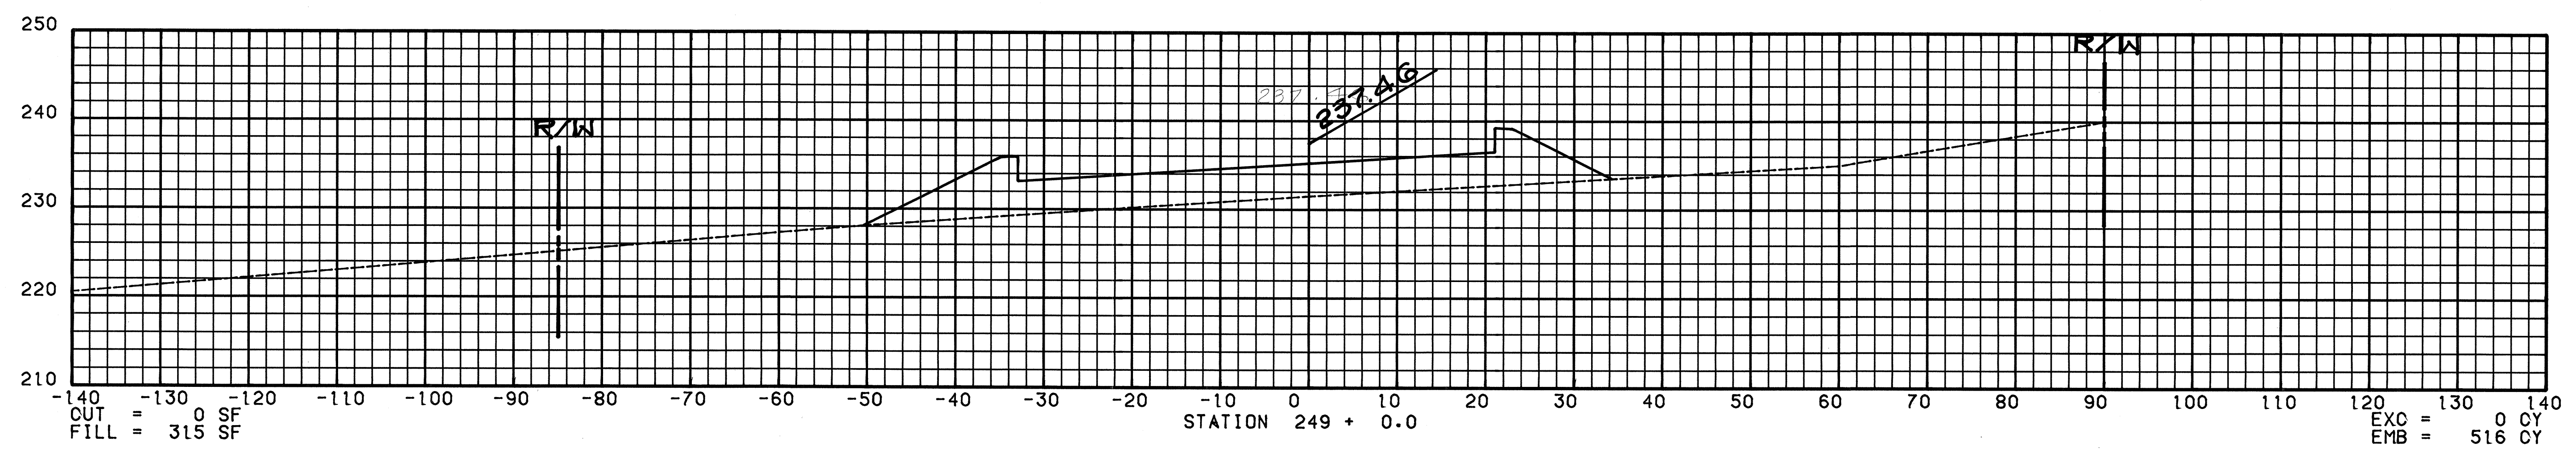


SCALE : HORIZONTAL 1 INCH = 10 FEET
 VERTICAL 1 INCH = 10 FEET

ORIGINAL
PLAN
NOTE BOOK
No.

SURVEY PLOTTED BY
DATE
DRAWN BY
TRACED BY
DESIGNED BY
QUANTITIES BY
CHECKED BY




FED. ROAD DIST. NO.	STATE	FED. AID PROJ. NO.	FISCAL YEAR	SHEET NO.	TOTAL SHEETS
HAWAII	HAW.	F-030-1(18)	1984	132	169

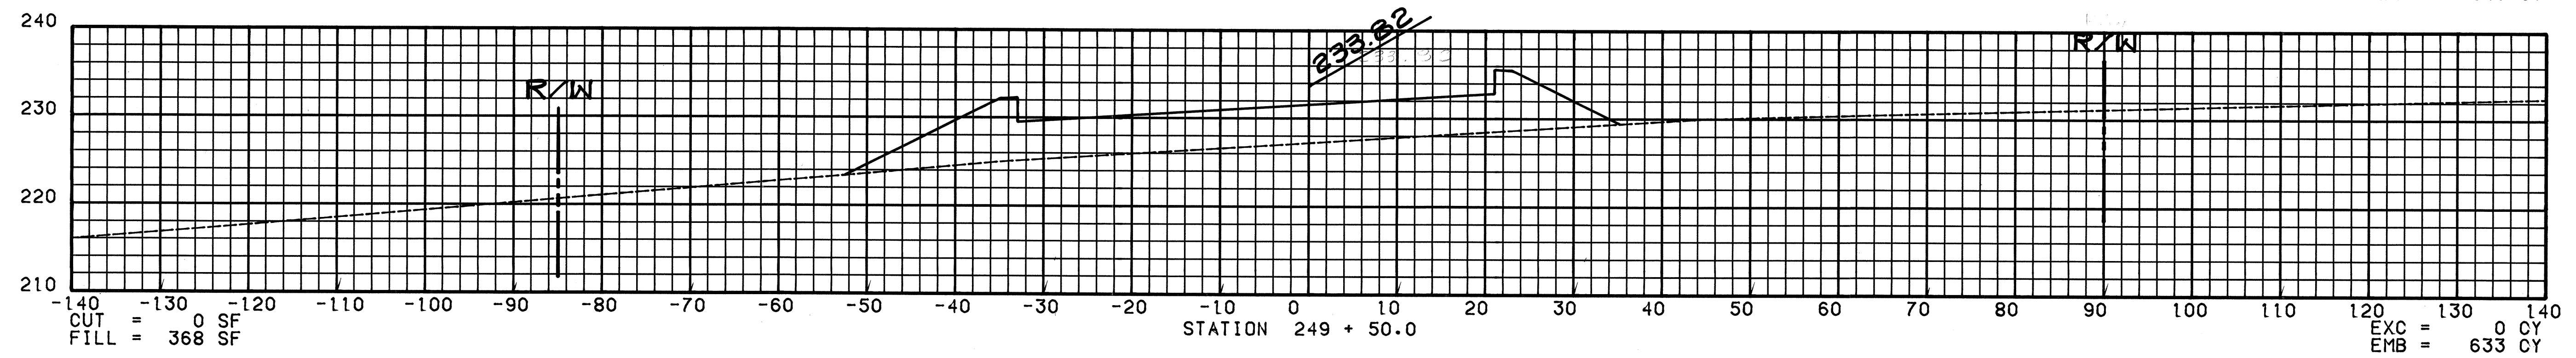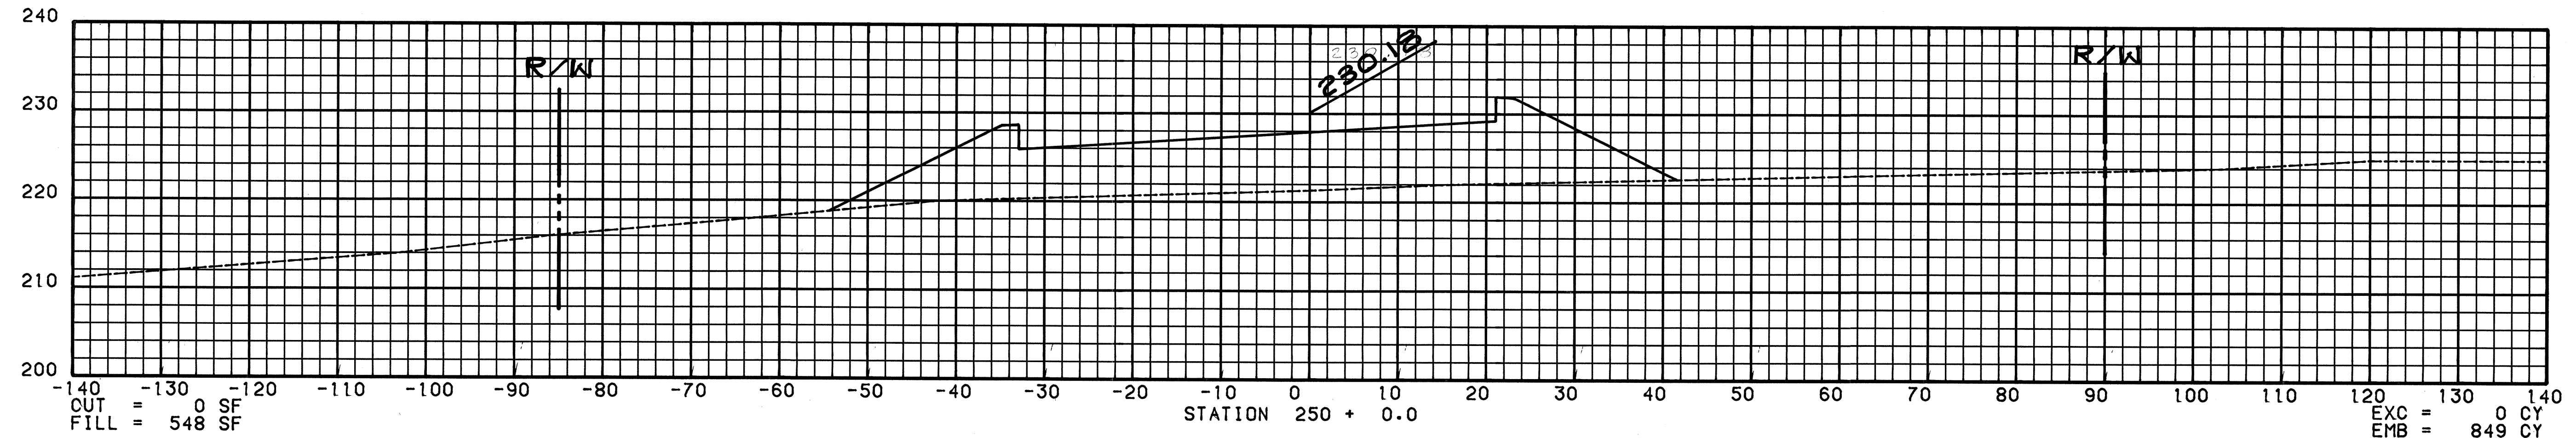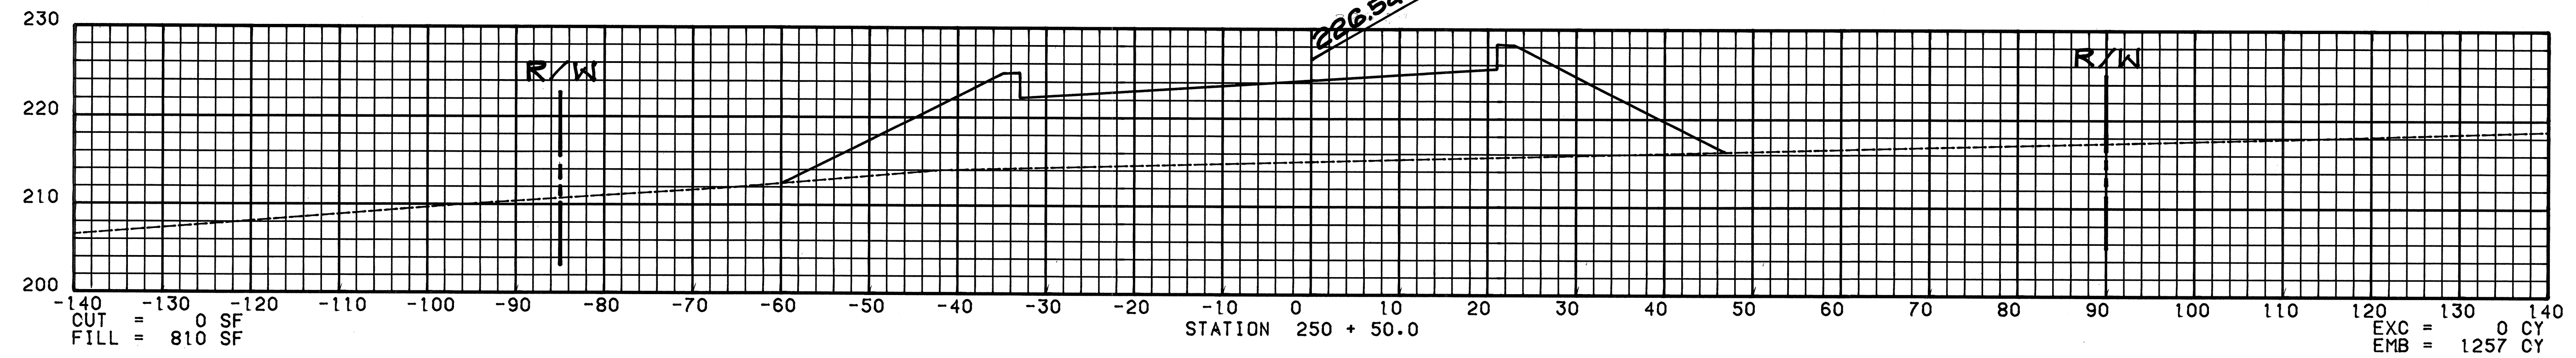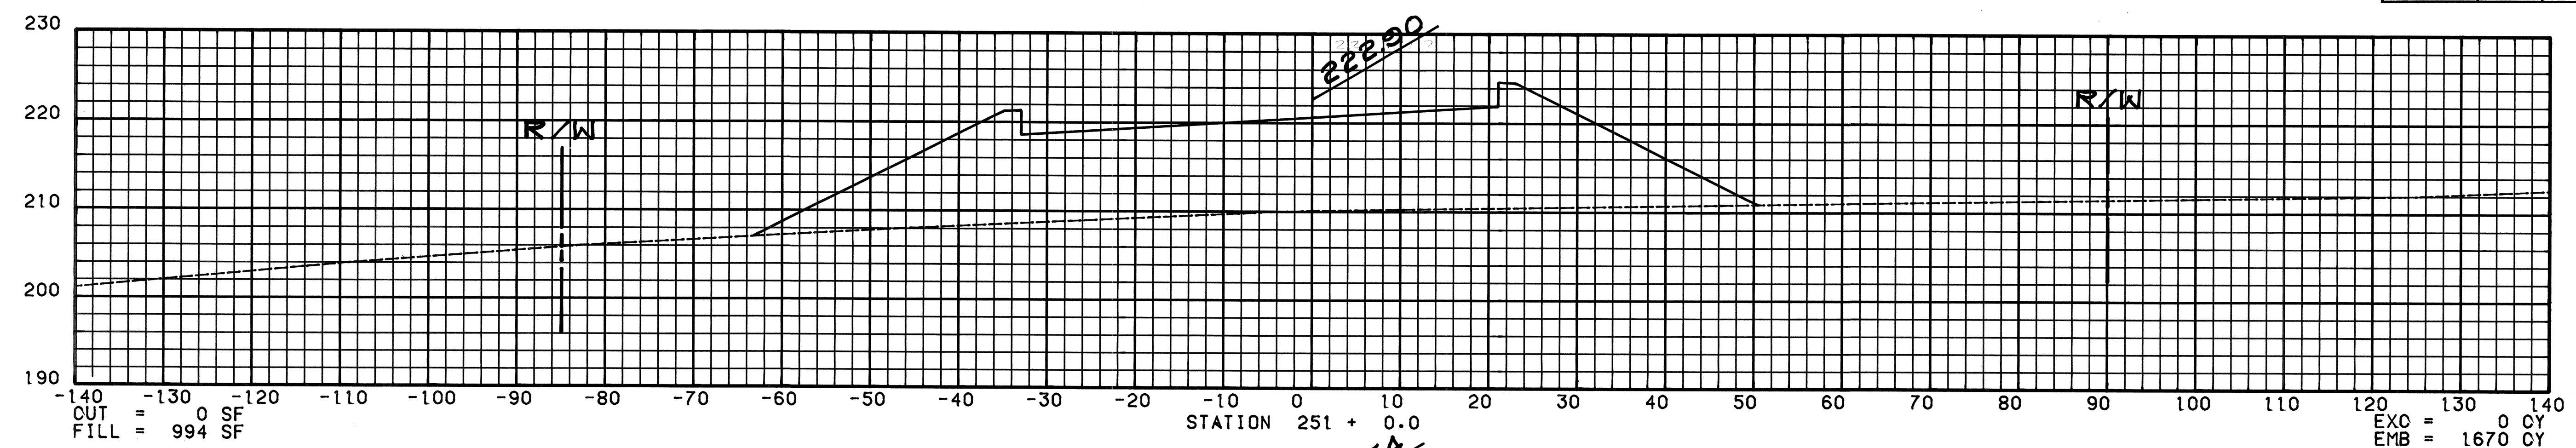

SCALE : HORIZONTAL 1 INCH = 10 FEET
VERTICAL 1 INCH = 10 FEET

ORIGINAL PLAN
DATE
DRAWN BY
DESIGNED BY
NOTE BOOK
QUANTITIES BY
CHECKED BY



FED. ROAD DIST. NO.	STATE	FED. AID PROJ. NO.	FISCAL YEAR	SHEET NO.	TOTAL SHEETS
HAWAII	HAW.	F-030-1(18)	1984	133	169

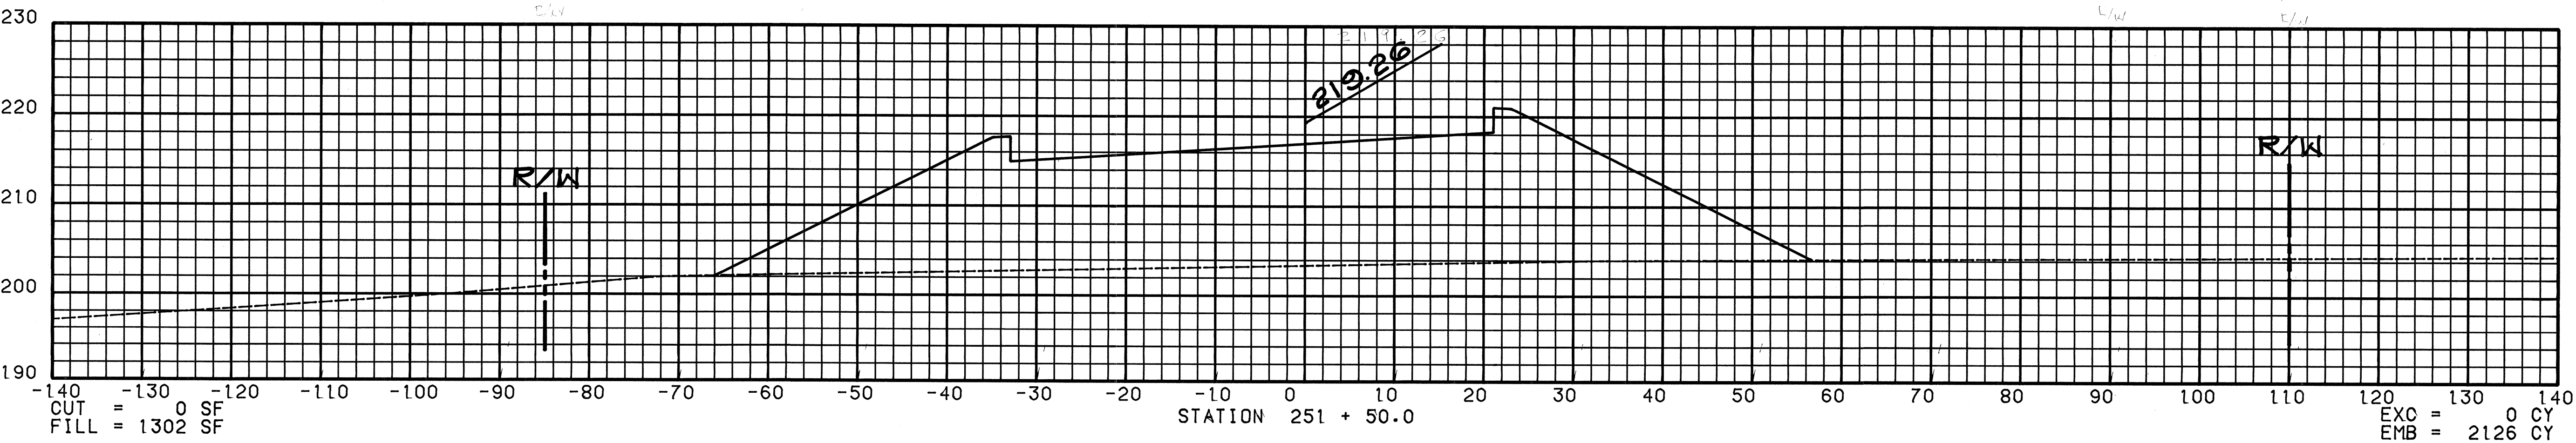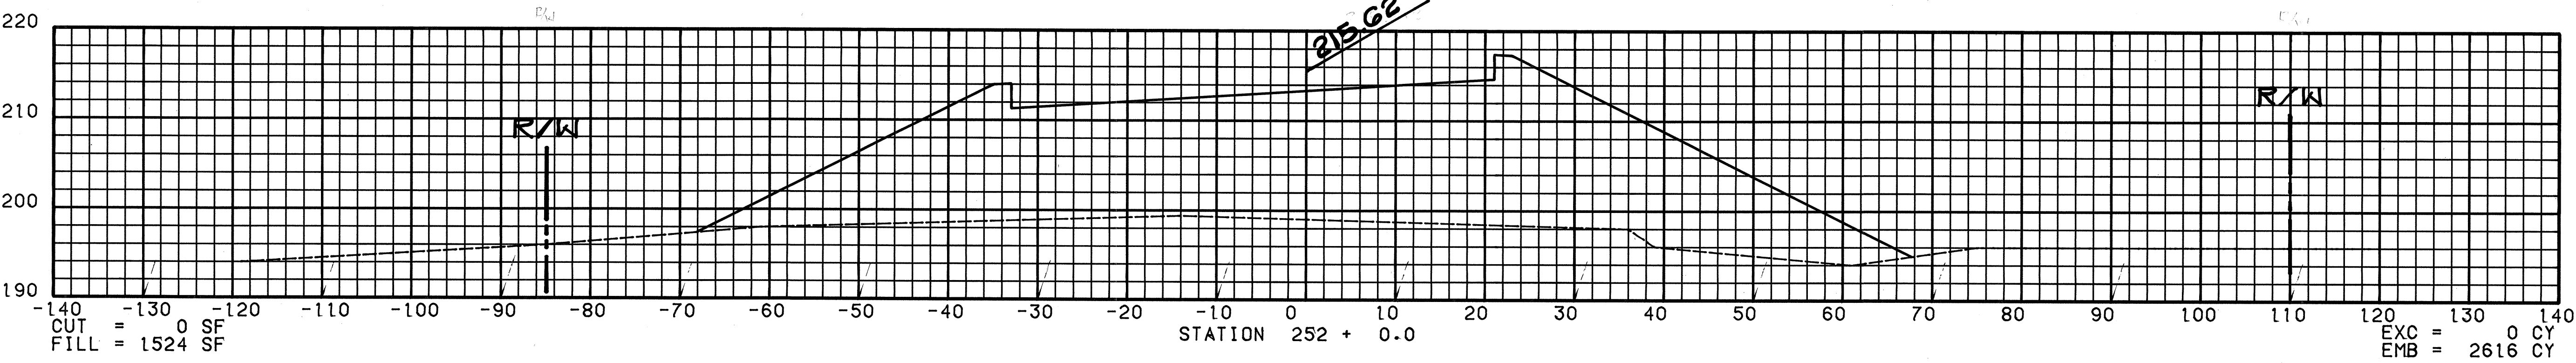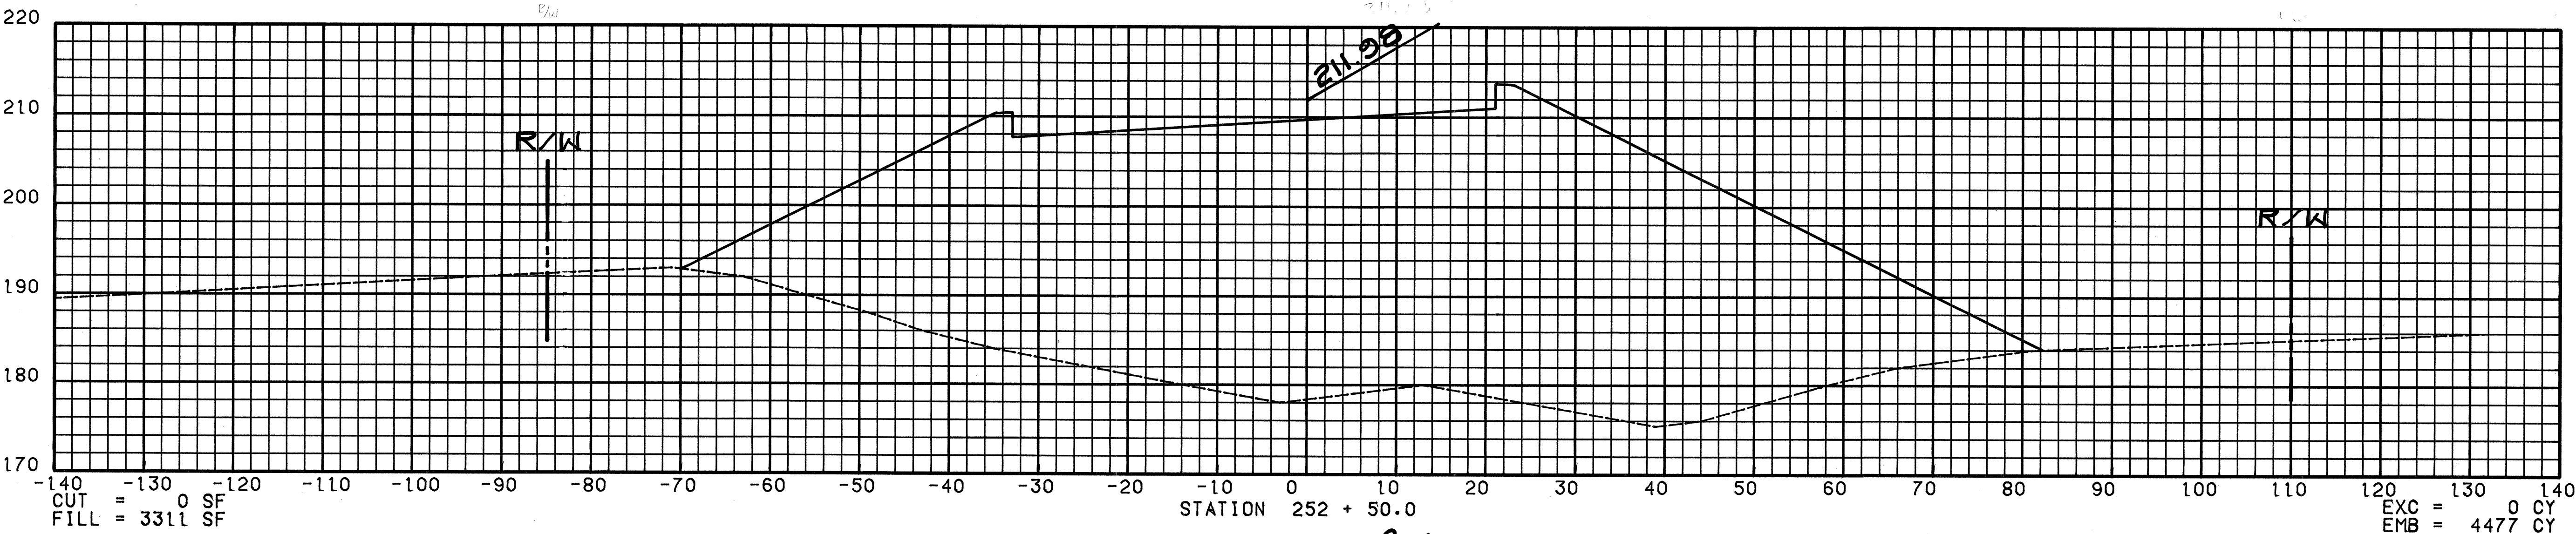

SCALE : HORIZONTAL 1 INCH = 10 FEET
 VERTICAL 1 INCH = 10 FEET

ORIGINAL PLAN
 SURVEY PLOTTED BY
 DRAWN BY
 CHECKED BY
 DESIGNED BY
 NOTE BOOK
 No.




FED. ROAD DIST. NO.	STATE	FED. AID PROJ. NO.	FISCAL YEAR	SHEET NO.	TOTAL SHEETS
HAWAII	HAW.	F-030-1(18)	1984	134	169

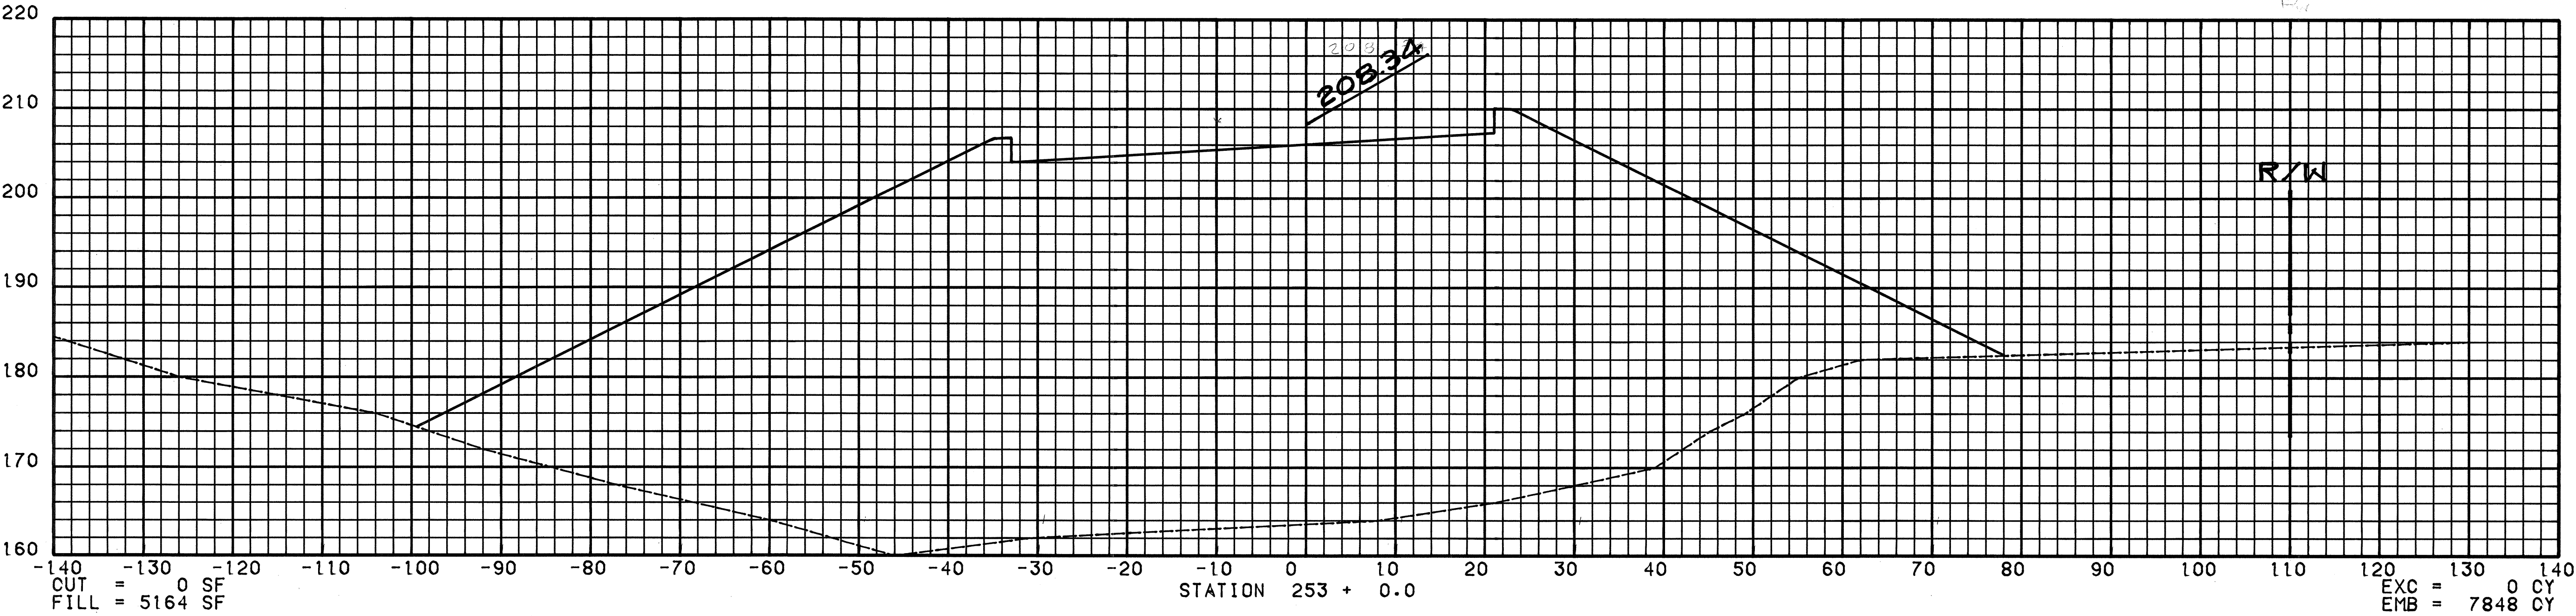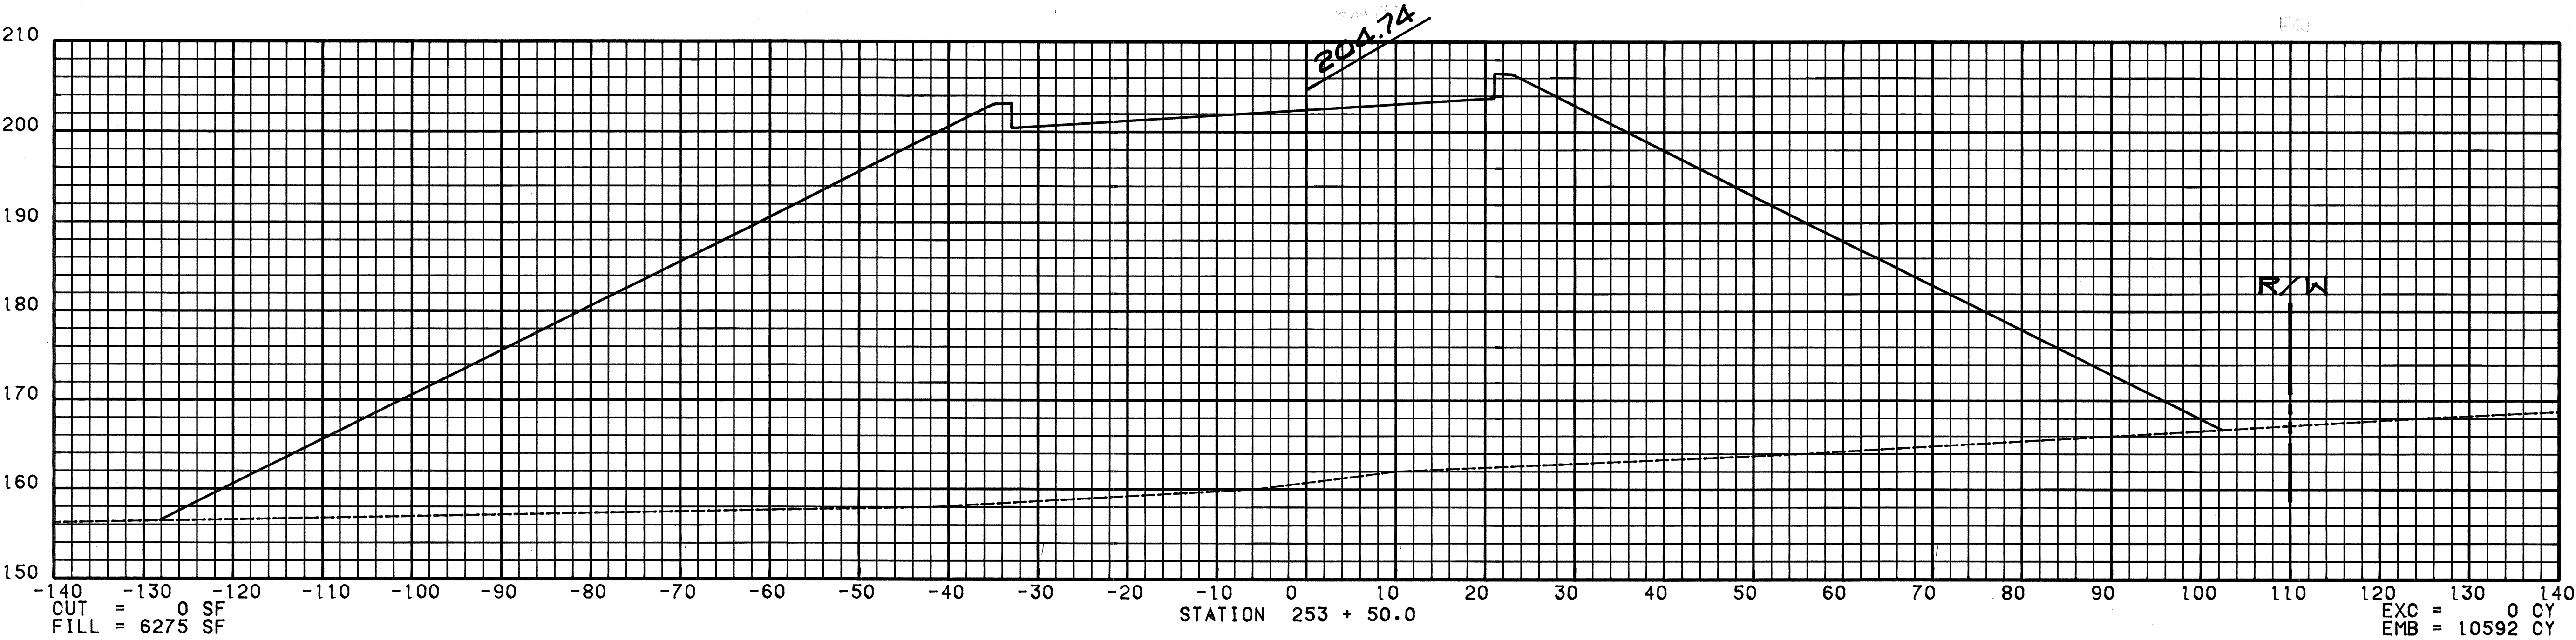

SCALE : HORIZONTAL 1 INCH = 10 FEET
VERTICAL 1 INCH = 10 FEET

ORIGINAL PLAN	SURVEY PLOTTED BY	DATE
NOTE BOOK	DRAWN BY	"
No.	DESIGNED BY	"
	QUANTITIES BY	"
	CHECKED BY	"




FED. ROAD DIST. NO.	STATE	FED. AID PROJ. NO.	FISCAL YEAR	SHEET NO.	TOTAL SHEETS
HAWAII	HAW.	F-030-1(18)	1984	135	169

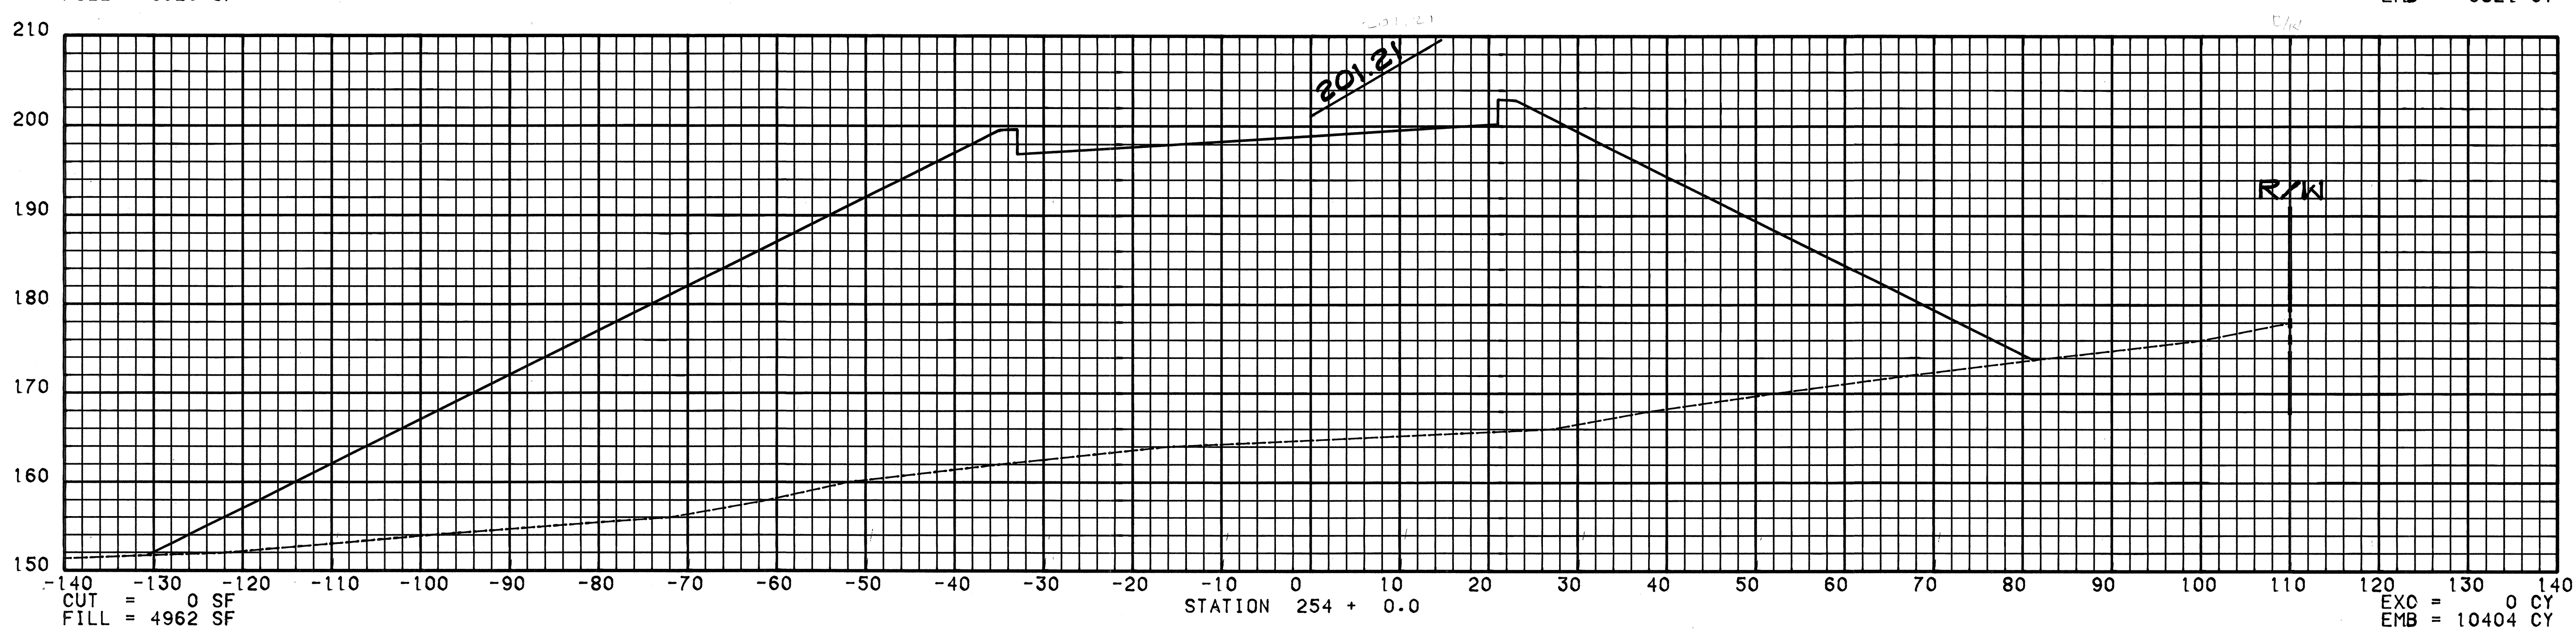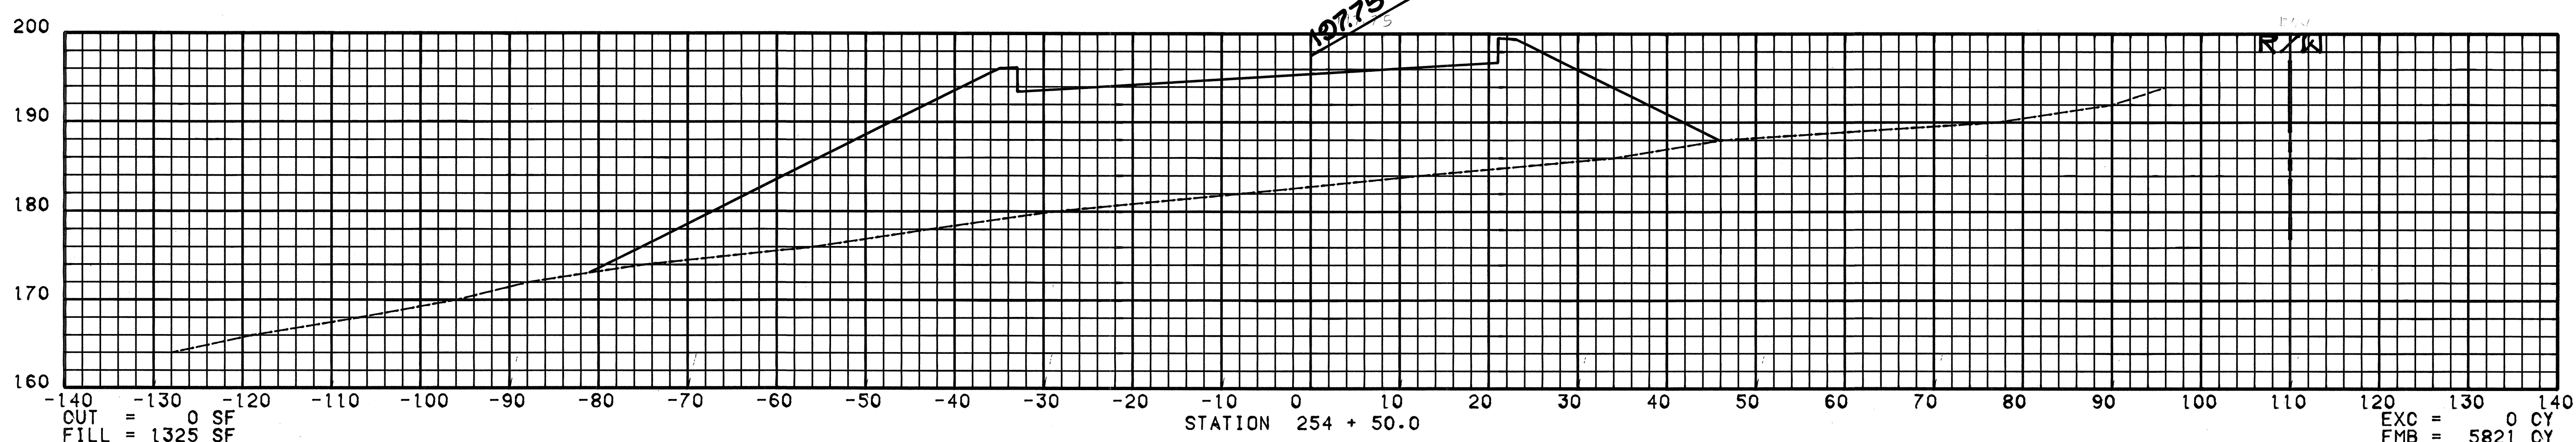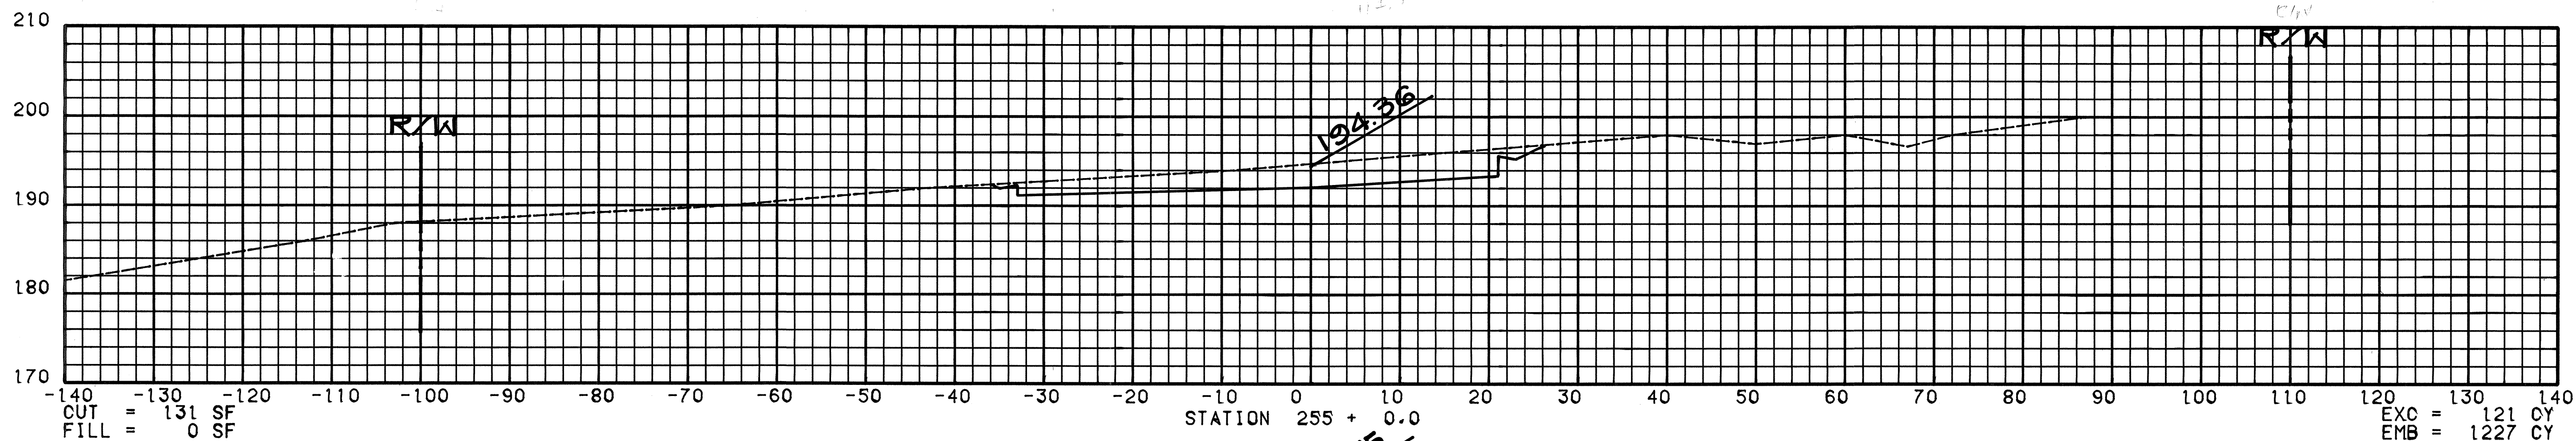

SCALE : HORIZONTAL 1 INCH = 10 FEET
 VERTICAL 1 INCH = 10 FEET

ORIGINAL PLAN
 SURVEY PLOTTED BY
 DRAWN BY
 TRACED BY
 DESIGNED BY
 QUANTITIES BY
 CHECKED BY
 No.




FED. ROAD DIST. NO.	STATE	FED. AID PROJ. NO.	FISCAL YEAR	SHEET NO.	TOTAL SHEETS
HAWAII	HAW.	F-030-1(18)	1984	136	169

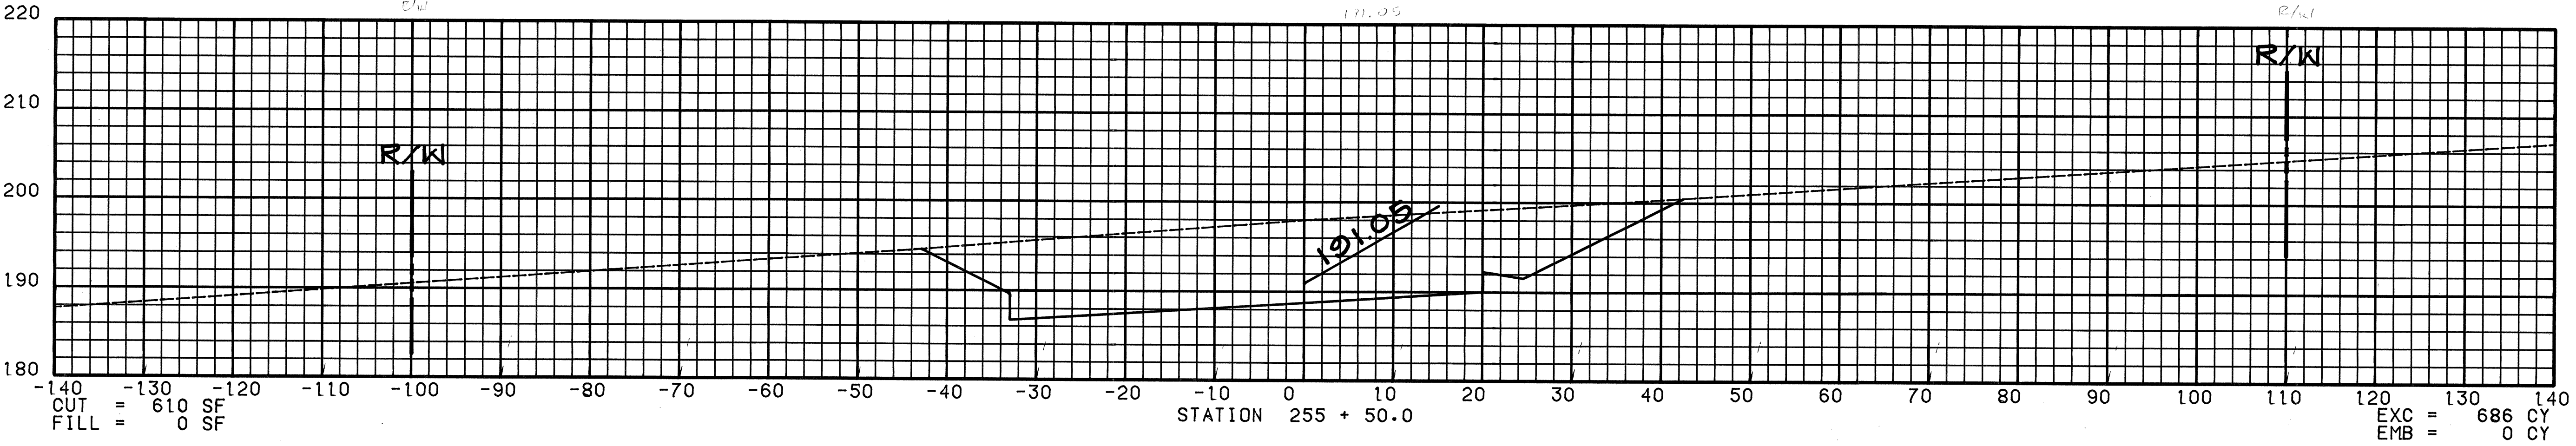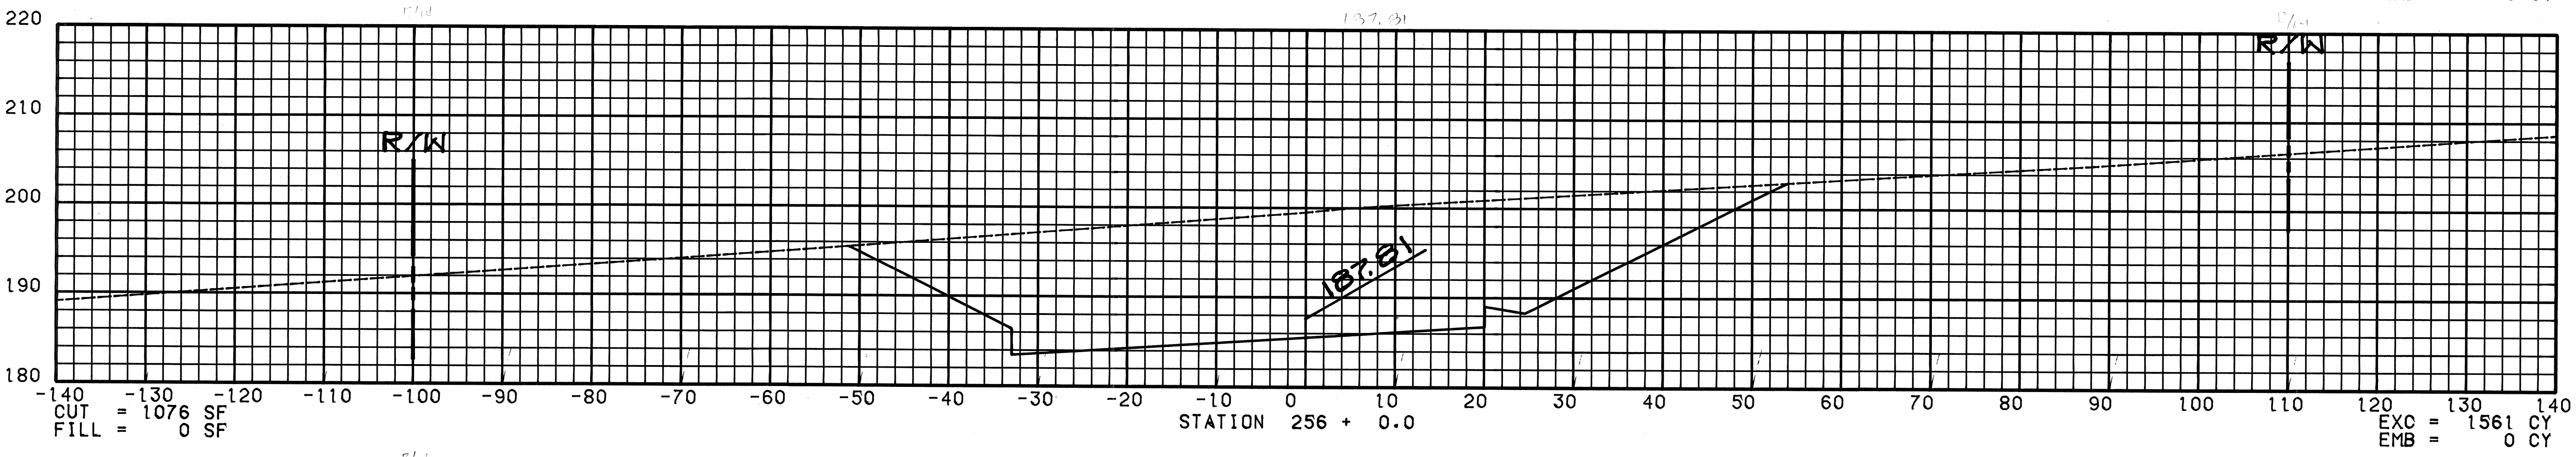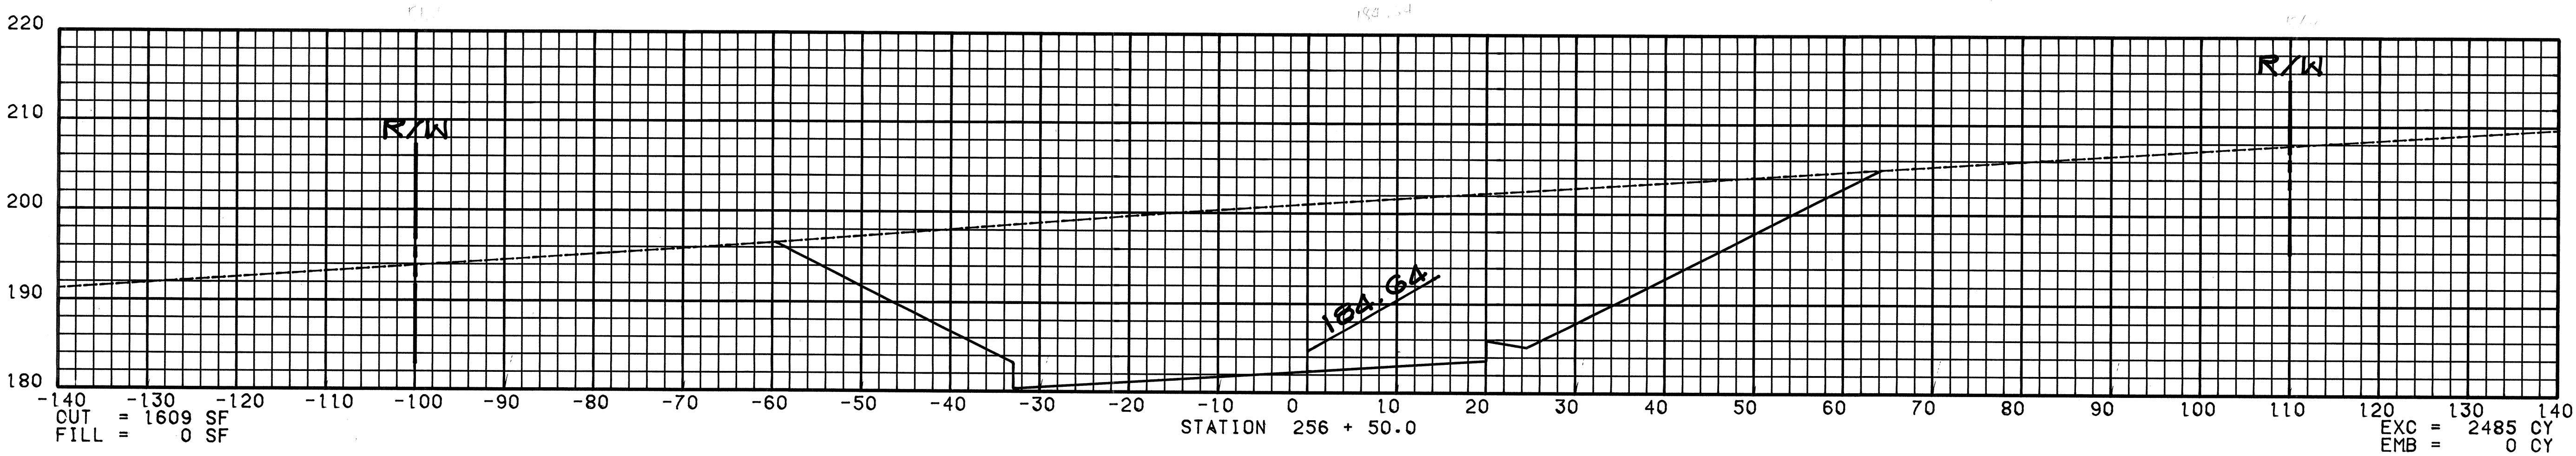

SCALE : HORIZONTAL 1 INCH = 10 FEET
 VERTICAL 1 INCH = 10 FEET

ORIGINAL PLAN
 SURVEY PLOTTED BY
 DRAWN BY
 TRACED BY
 DESIGNED BY
 QUANTITIES BY
 CHECKED BY
 No.




FED. ROAD DIST. NO.	STATE	FED. AID PROJ. NO.	FISCAL YEAR	SHEET NO.	TOTAL SHEETS
HAWAII	HAW.	F-030-1(18)	1984	137	169

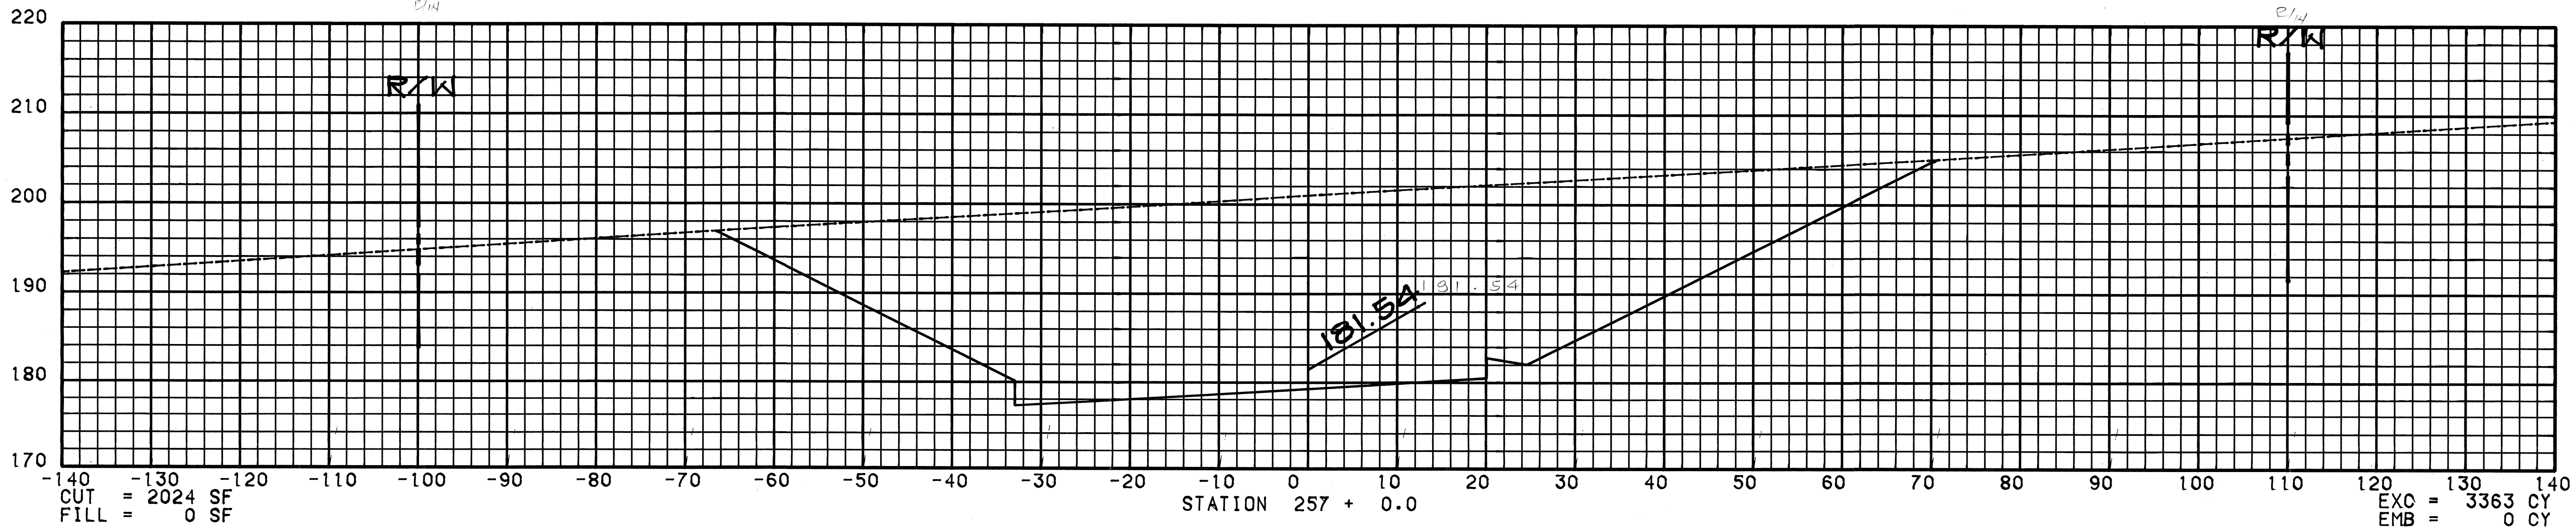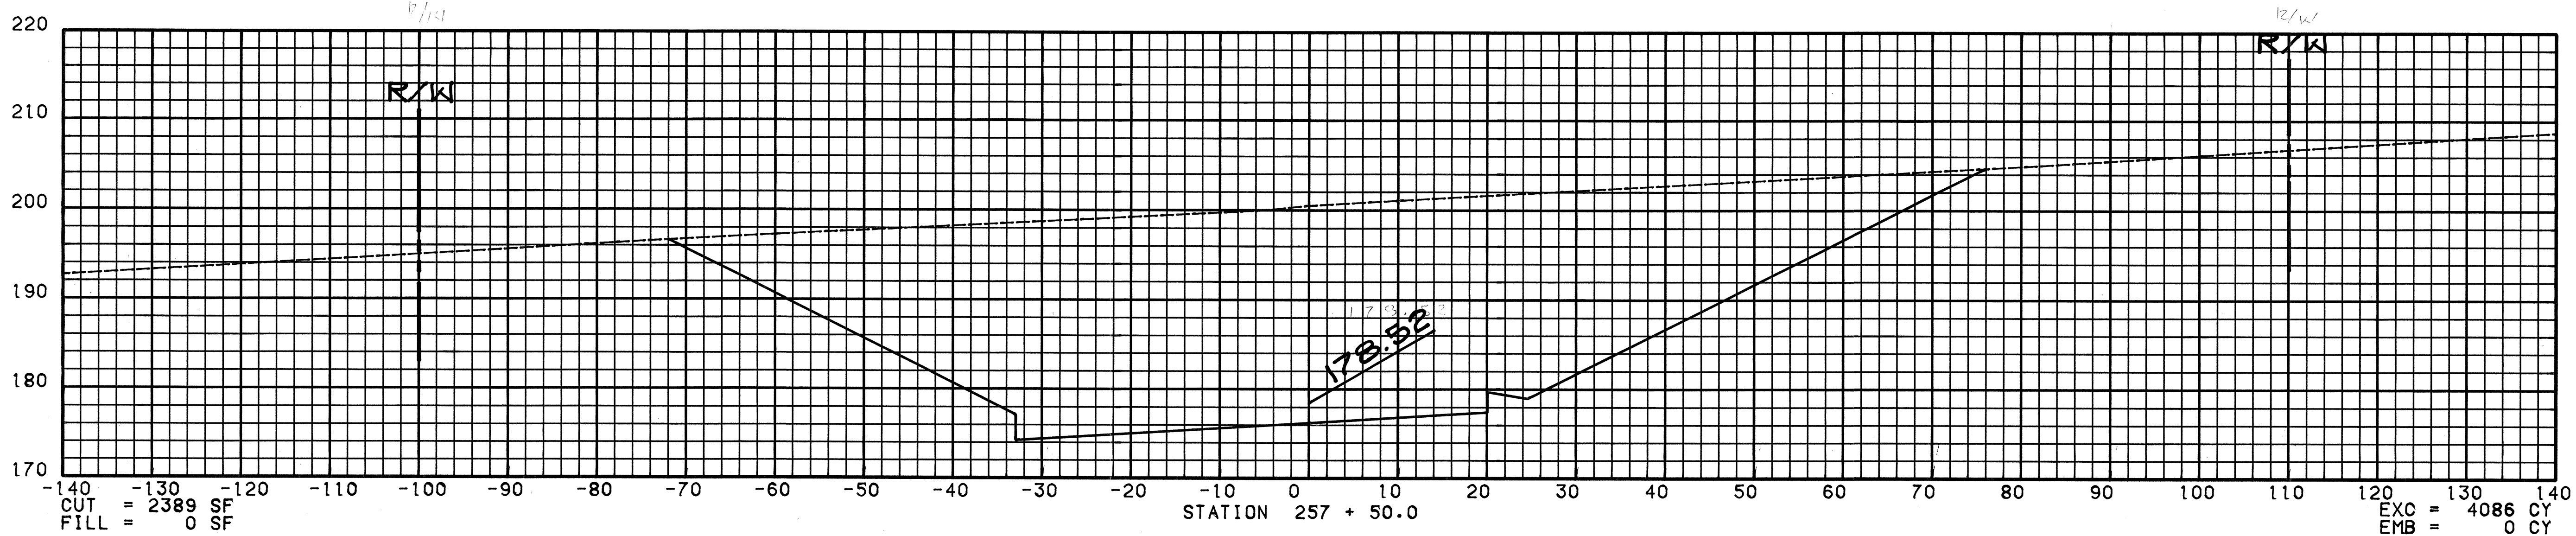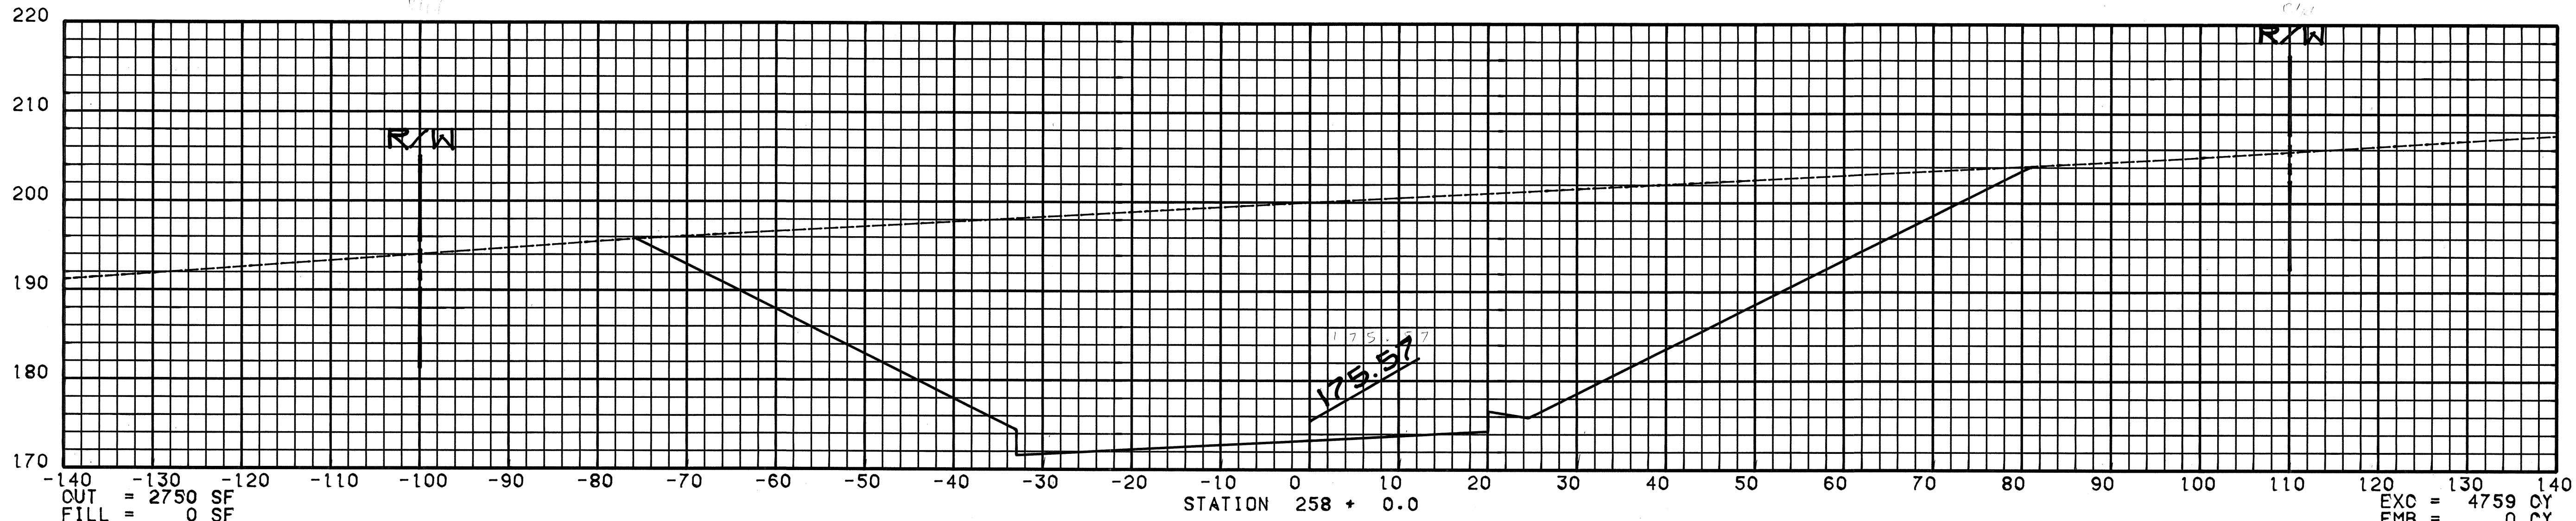

SCALE : HORIZONTAL 1 INCH = 10 FEET
VERTICAL 1 INCH = 10 FEET

ORIGINAL PLAN
SURVEY PLOTTED BY
DRAWN BY
TRACED BY
DESIGNED BY
NOTE BOOK
QUANTITIES BY
CHECKED BY
No.




FED. ROAD DIST. NO.	STATE	FED. AID PROJ. NO.	FISCAL YEAR	SHEET NO.	TOTAL SHEETS
HAWAII	HAW.	F-030-108	1984	138	169

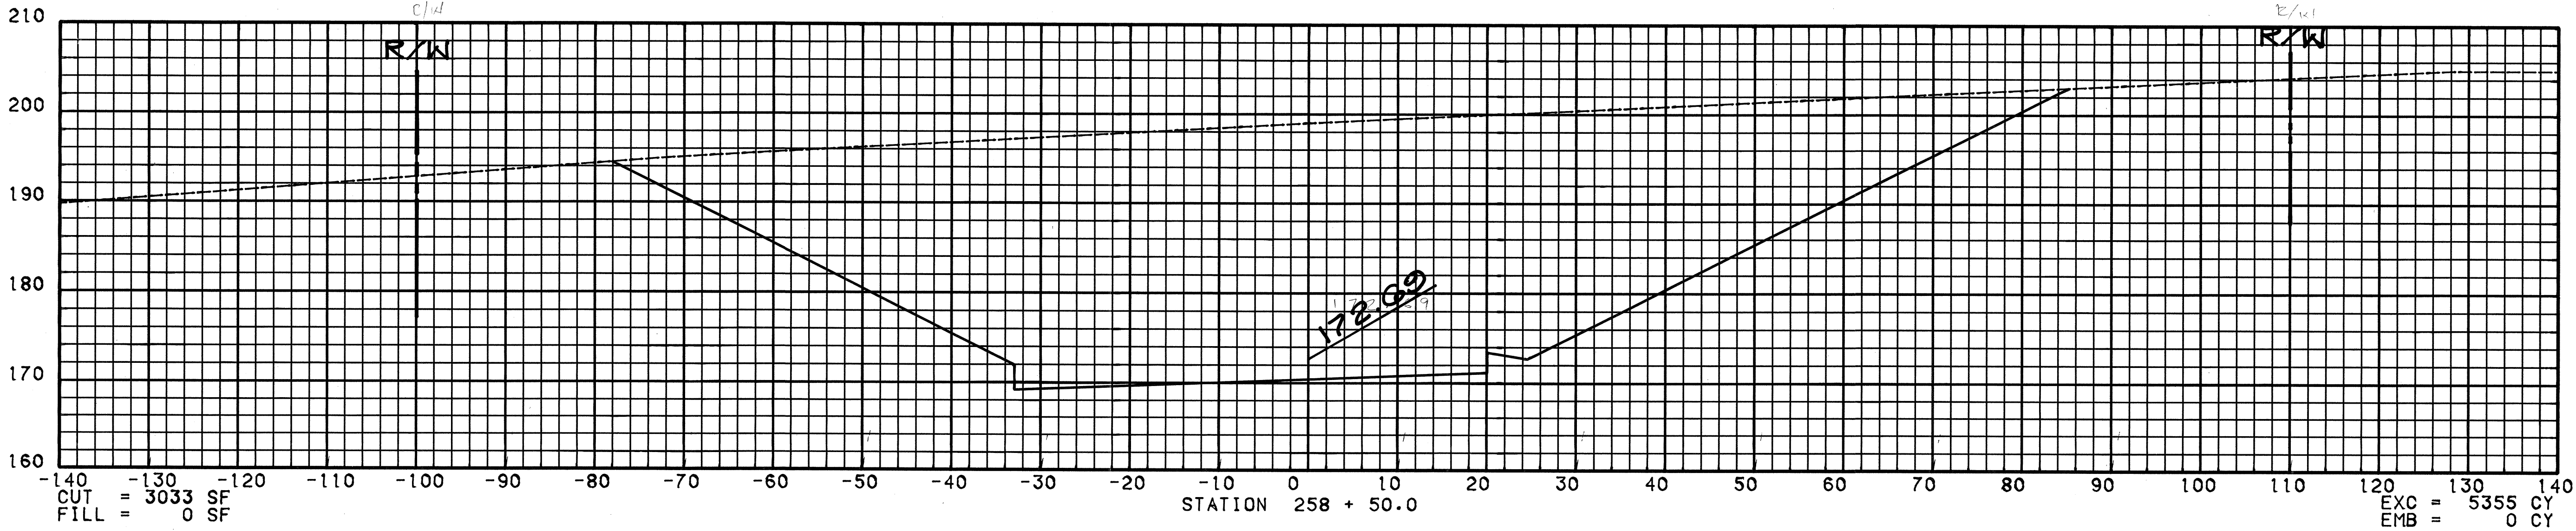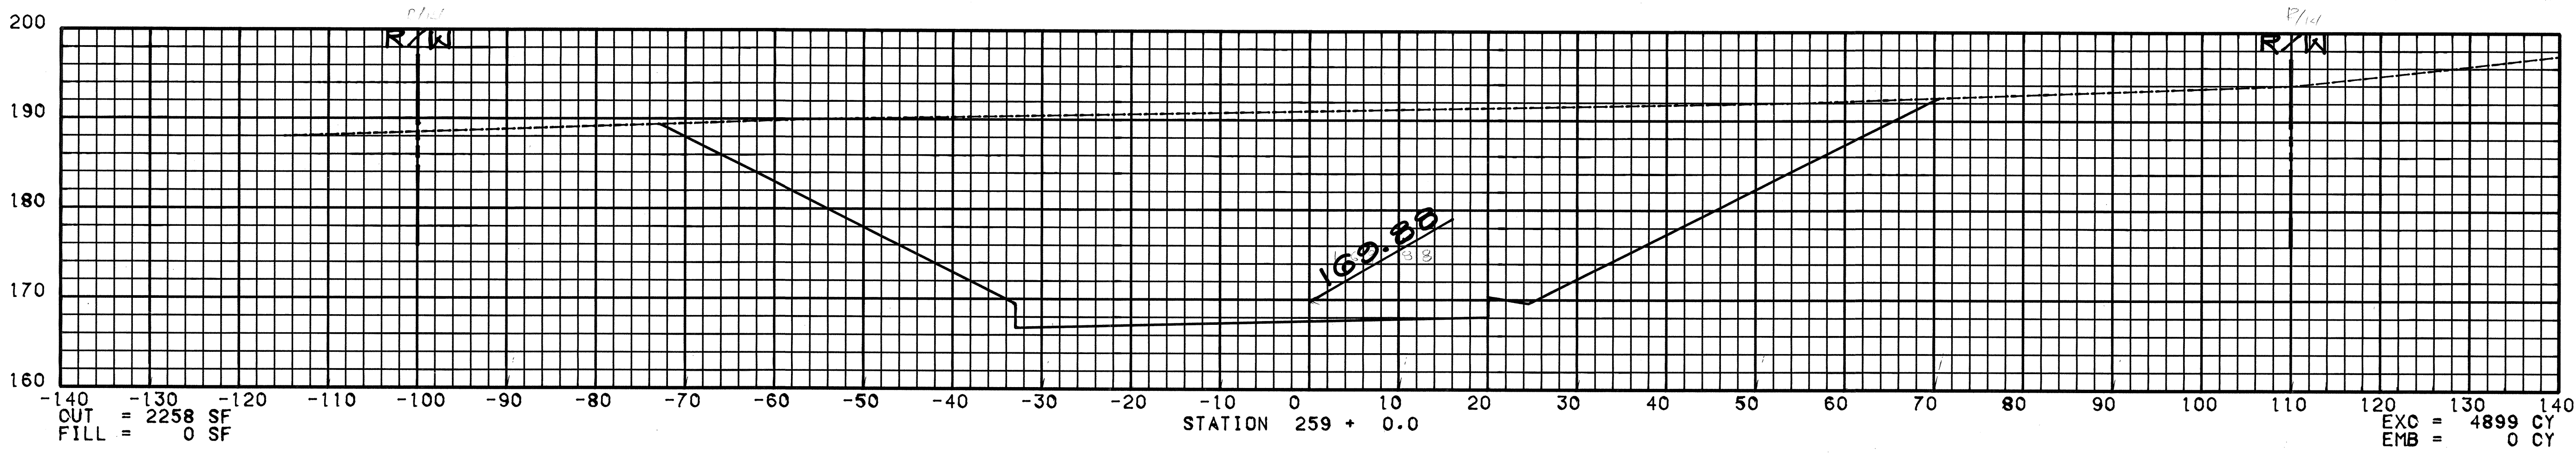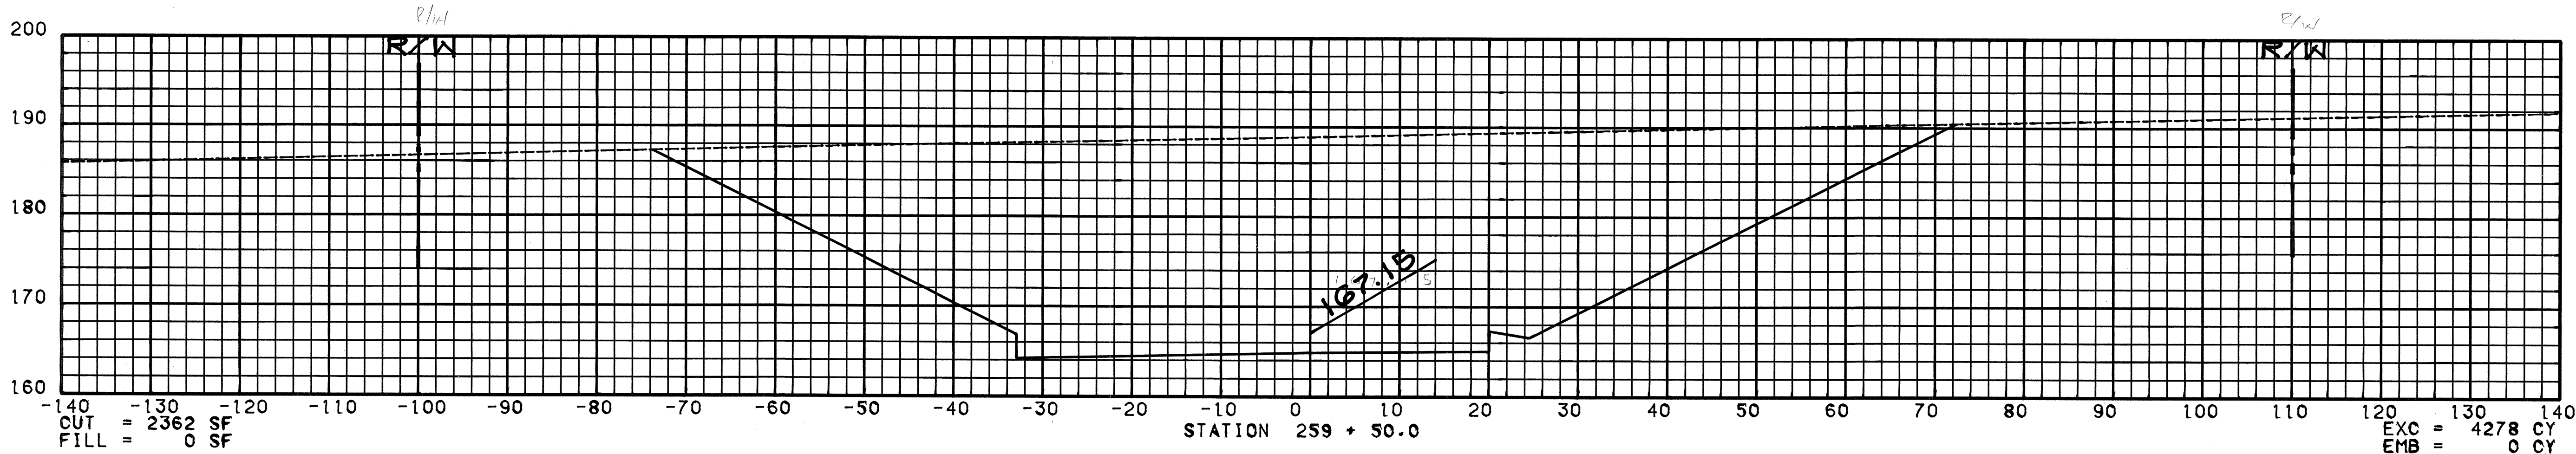

SCALE : HORIZONTAL 1 INCH = 10 FEET
VERTICAL 1 INCH = 10 FEET

ORIGINAL	SURVEY PLOTTED BY	DATE
PLAN	DRAWN BY	"
NOTE BOOK	DESIGNED BY	"
No.	CHECKED BY	"




FED. ROAD DIST. NO.	STATE	FED. AID PROJ. NO.	FISCAL YEAR	SHEET NO.	TOTAL SHEETS
HAWAII	HAW.	F-030-(118)	1984	139	169

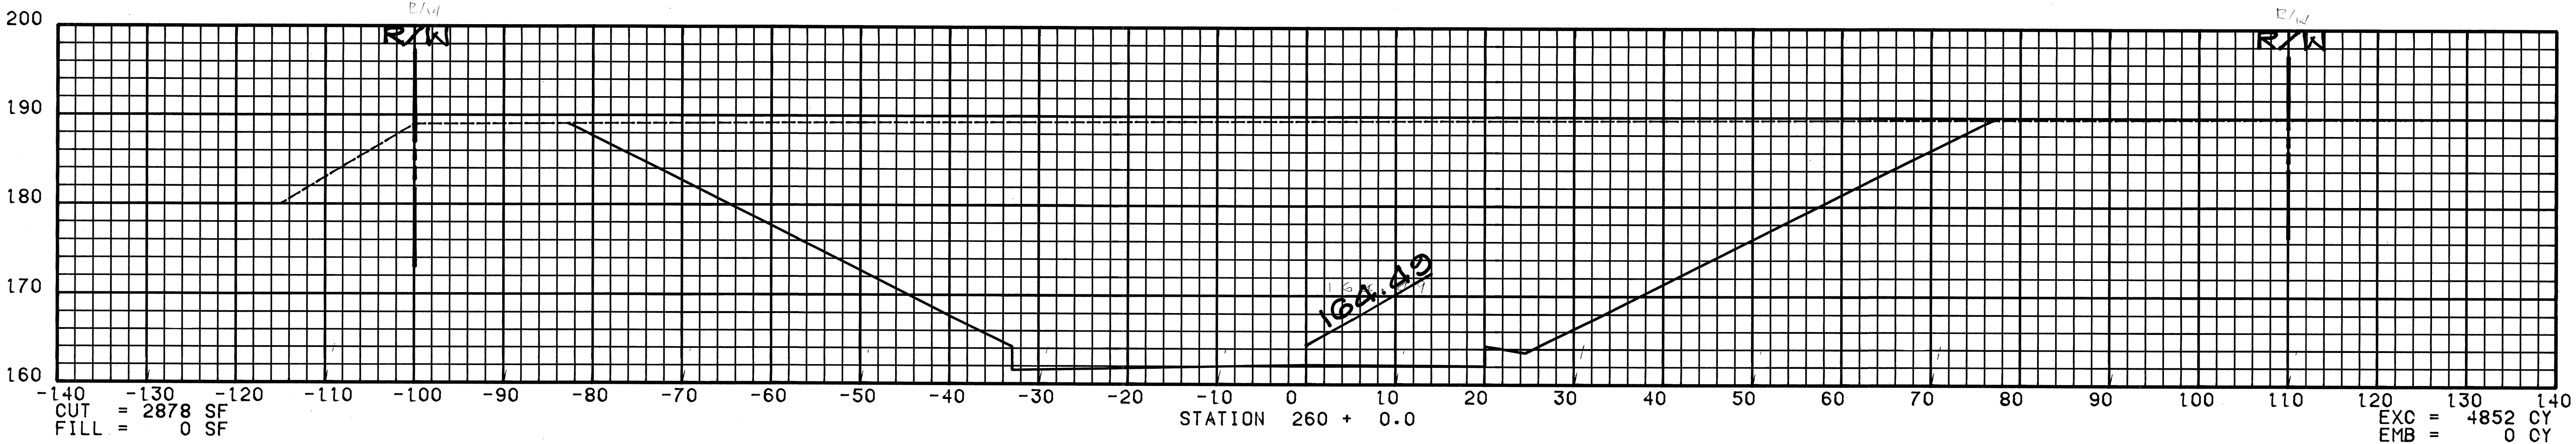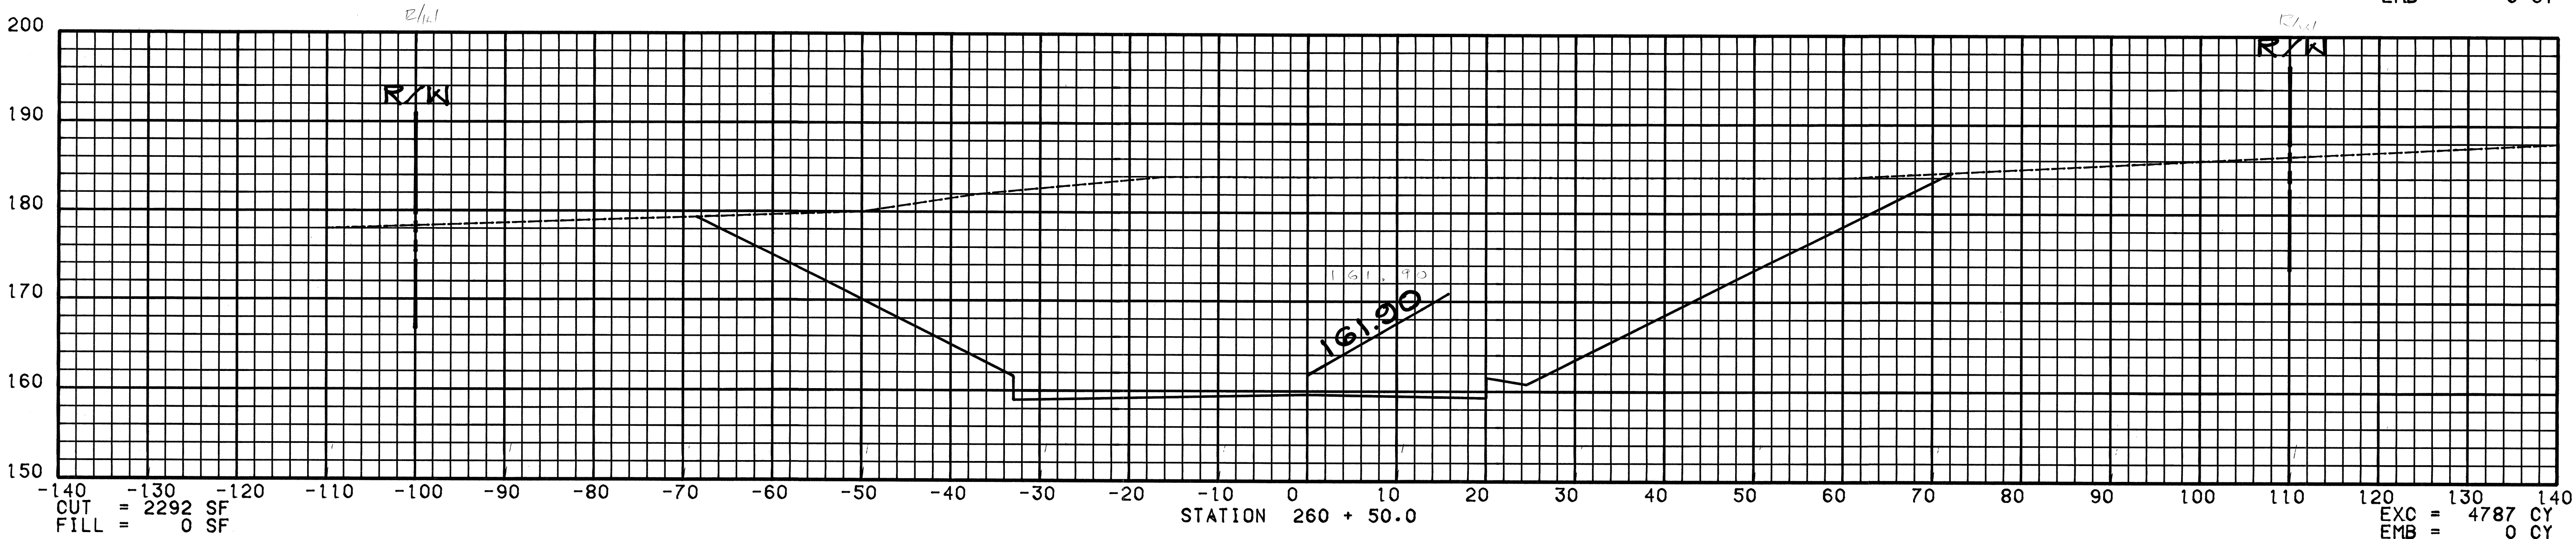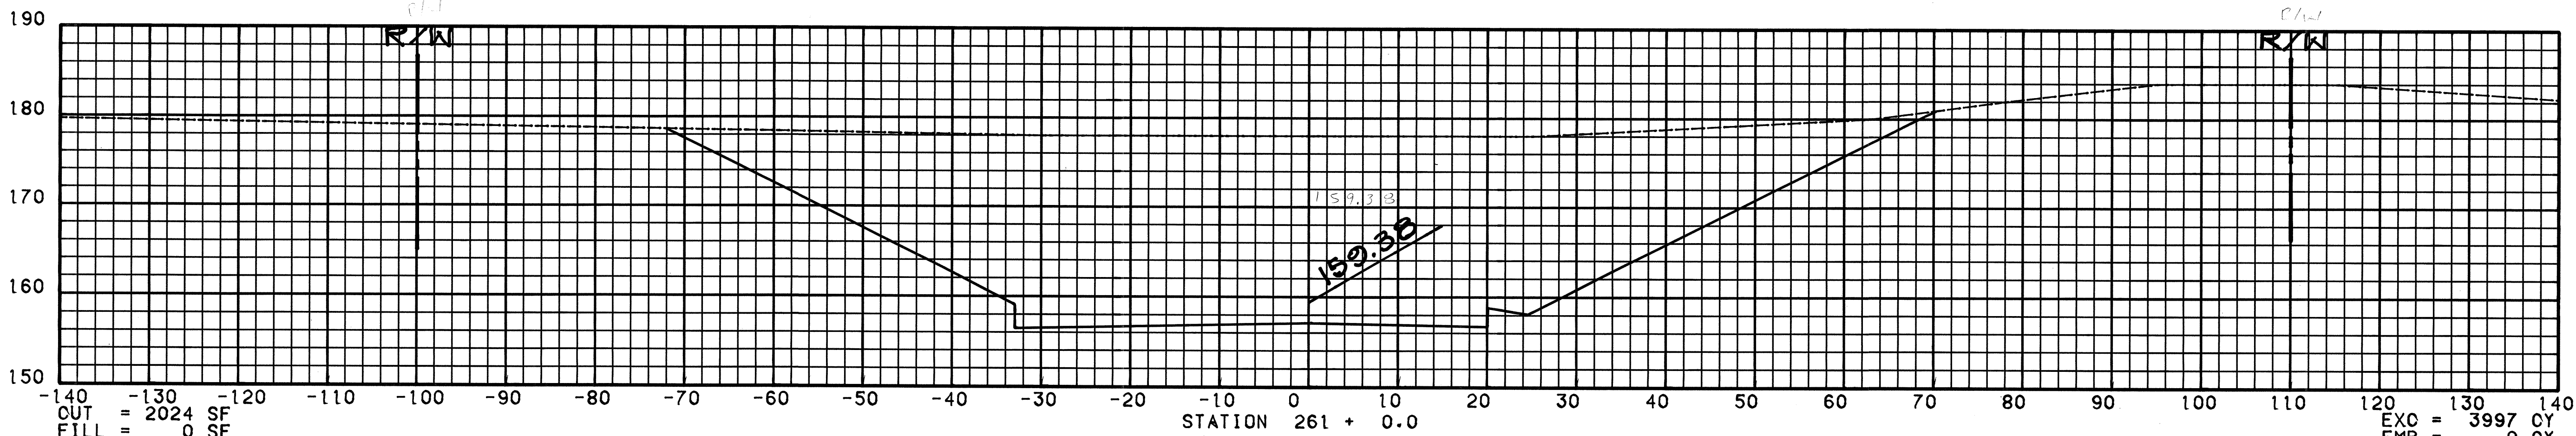

SCALE : HORIZONTAL 1 INCH = 10 FEET
VERTICAL 1 INCH = 10 FEET





ORIGINAL PLAN	SURVEY PLOTTED BY	DATE
NOTE BOOK	DRAWN BY	"
No.	DESIGNED BY	"
	CHECKED BY	"

FED. ROAD DIST. NO.	STATE	FED. AID PROJ. NO.	FISCAL YEAR	SHEET NO.	TOTAL SHEETS
HAWAII	HAW.	F-030-1(18)	1984	140	169

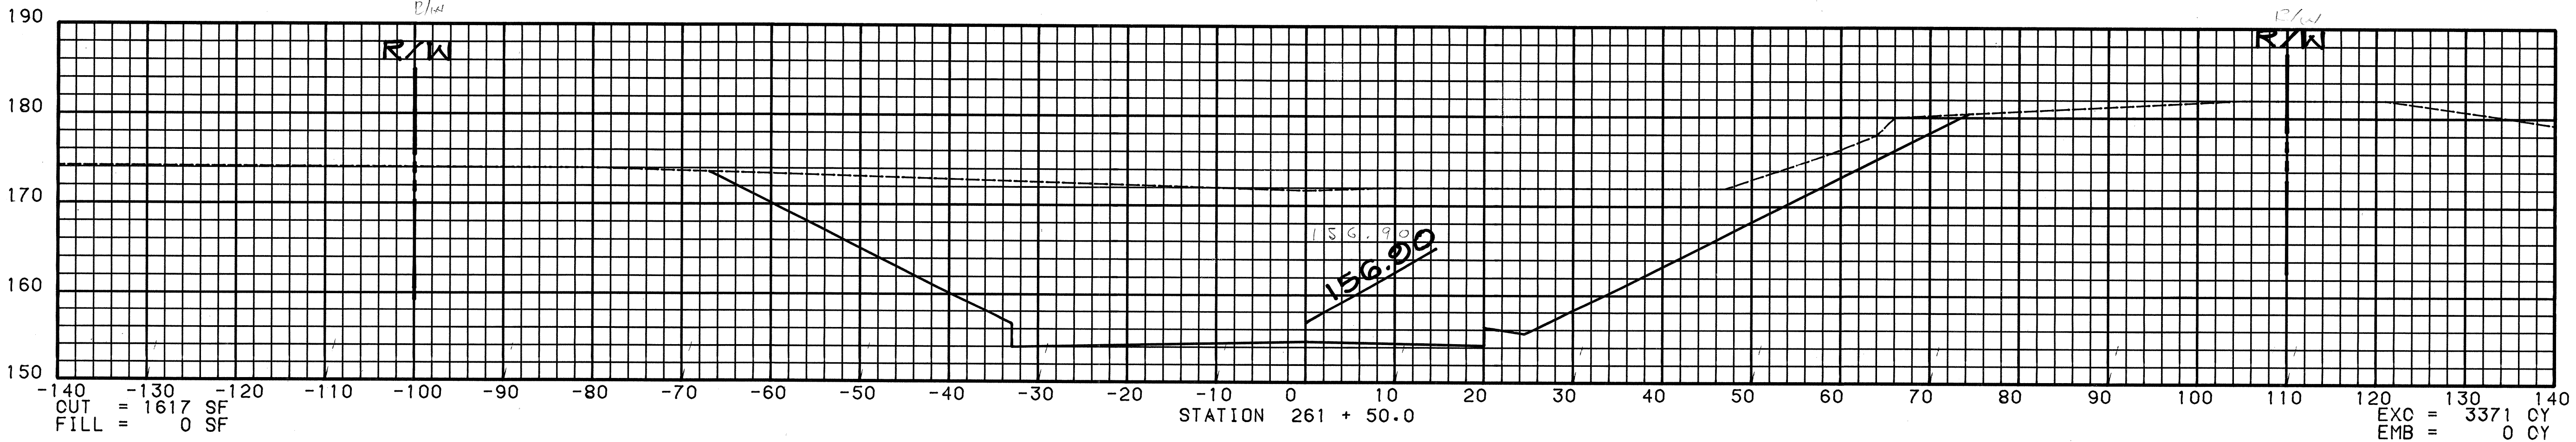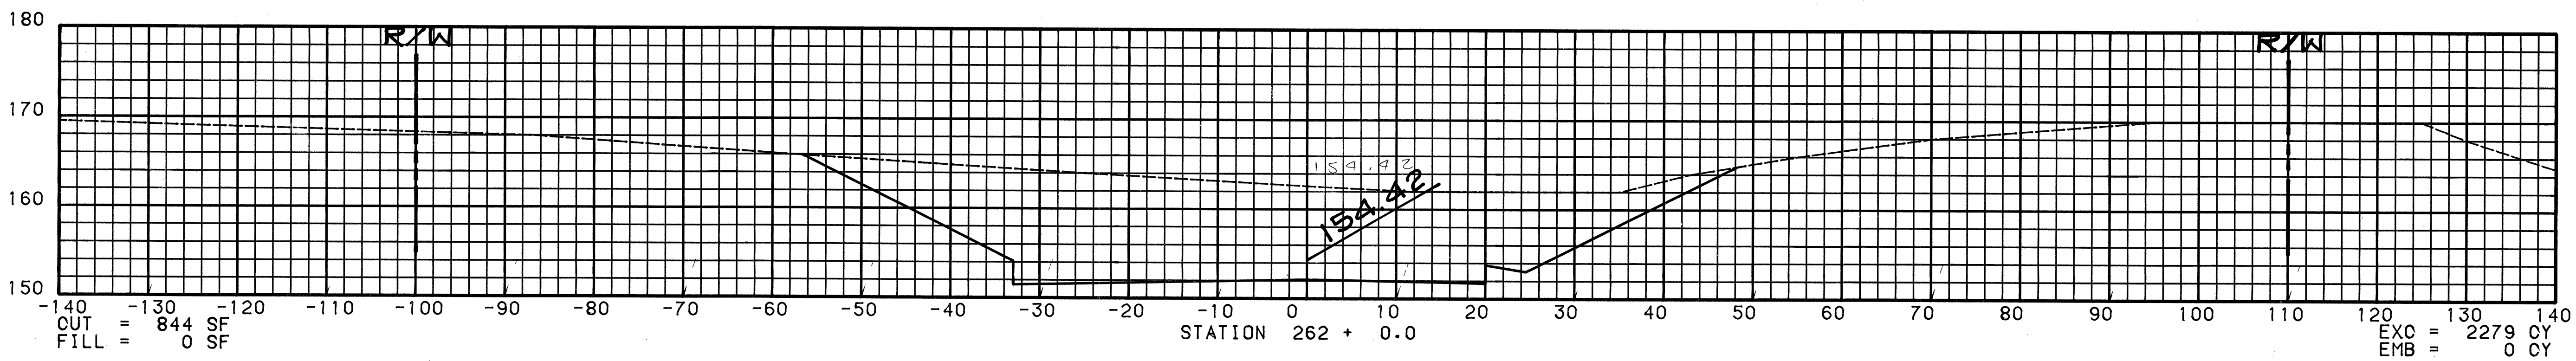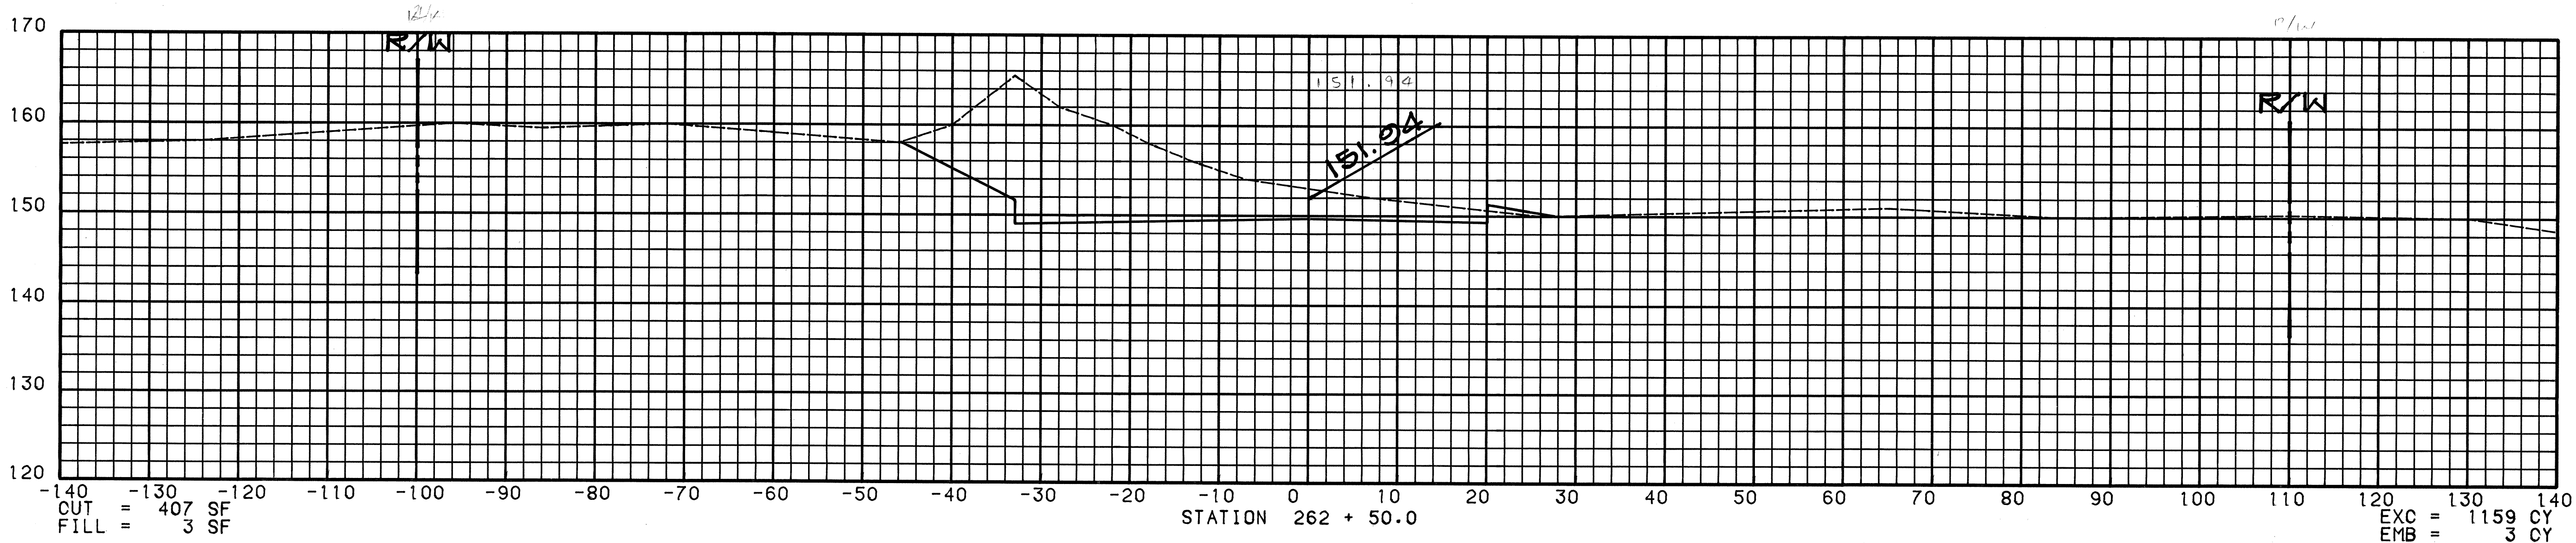

SCALE : HORIZONTAL 1 INCH = 10 FEET
 VERTICAL 1 INCH = 10 FEET

FED. ROAD DIST. NO.	STATE	FED. AID PROJ. NO.	FISCAL YEAR	SHEET NO.	TOTAL SHEETS
HAWAII	HAW.	F-030-108	1984	141	169

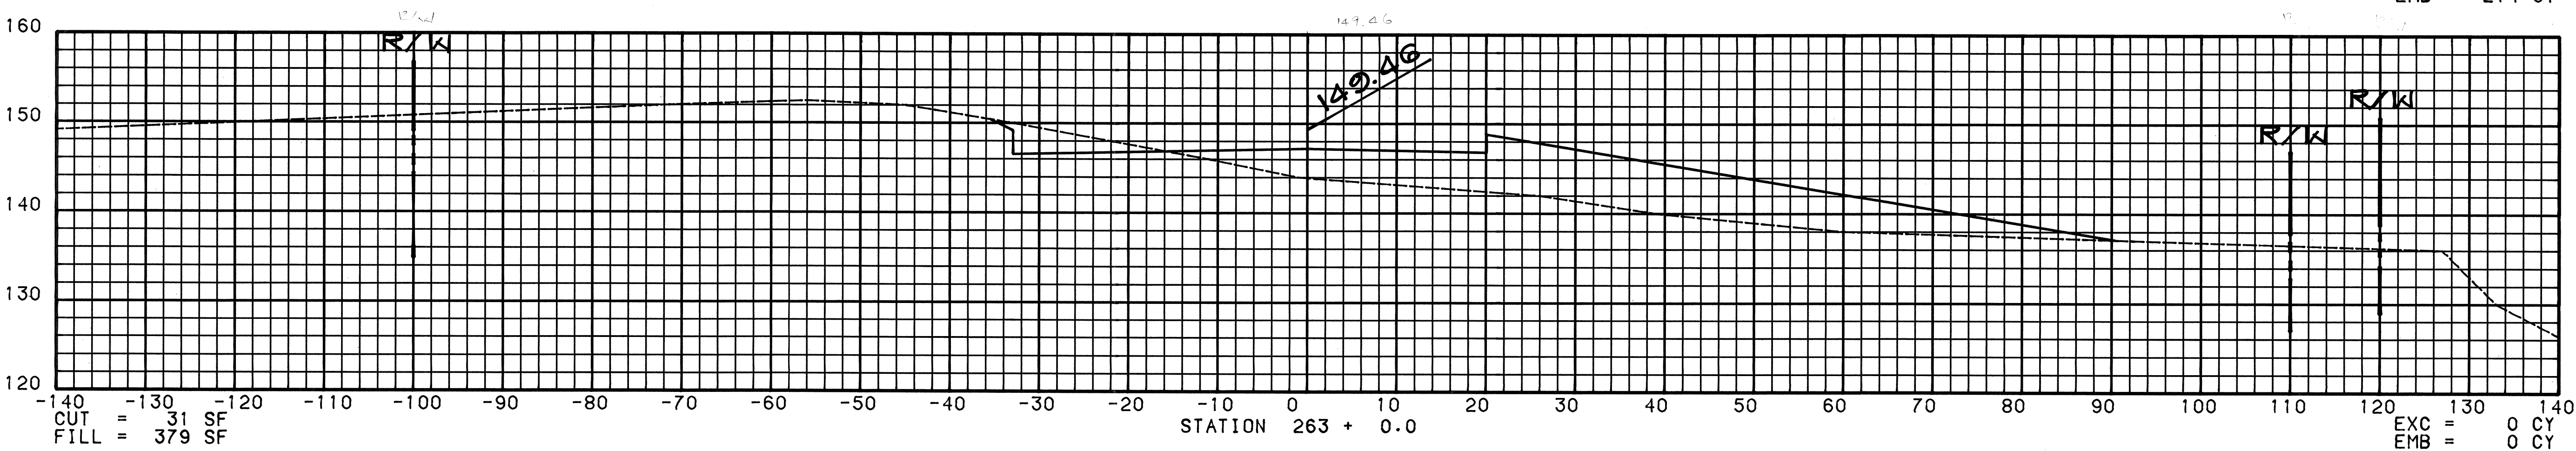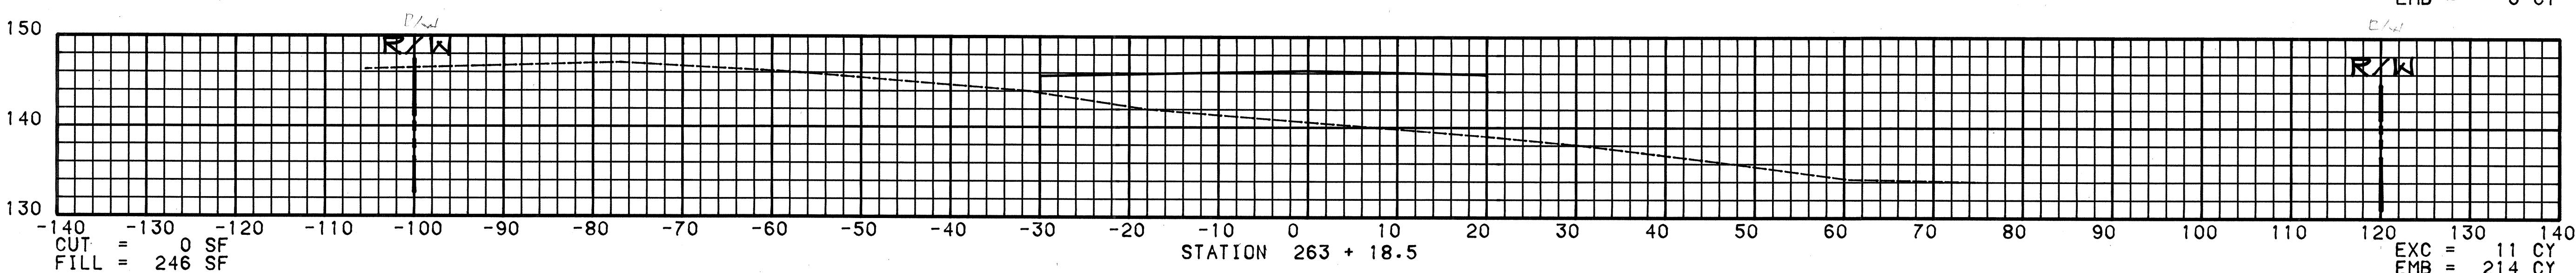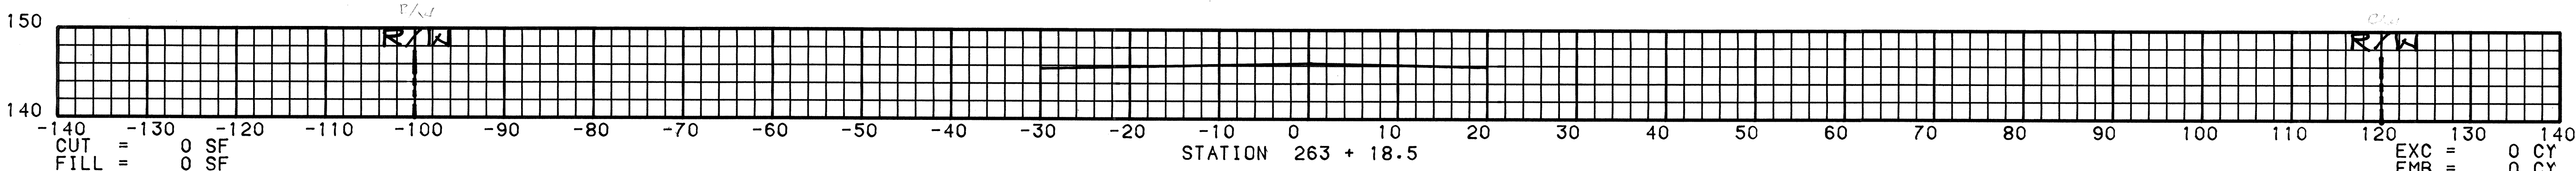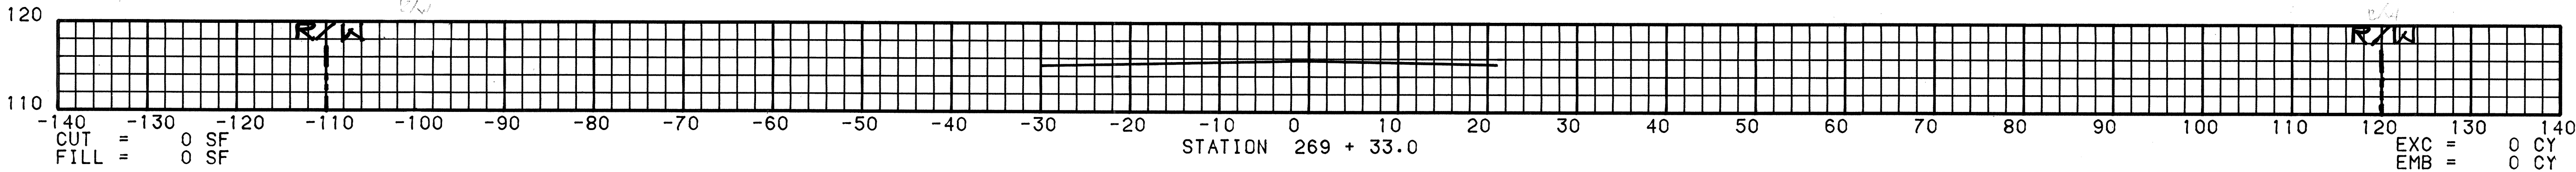

SCALE : HORIZONTAL 1 INCH = 10 FEET
VERTICAL 1 INCH = 10 FEET



ORIGINAL
PLAN
No.

SURVEY PLOTTED BY
DATE

DRAWN BY
DESIGNED BY
CHECKED BY

NOTE BOOK
QUANTITIES BY

FED. ROAD DIST. NO.	STATE	FED. AID PROJ. NO.	FISCAL YEAR	SHEET NO.	TOTAL SHEETS
HAWAII	HAW.	F-030-(118)	1984	142	169

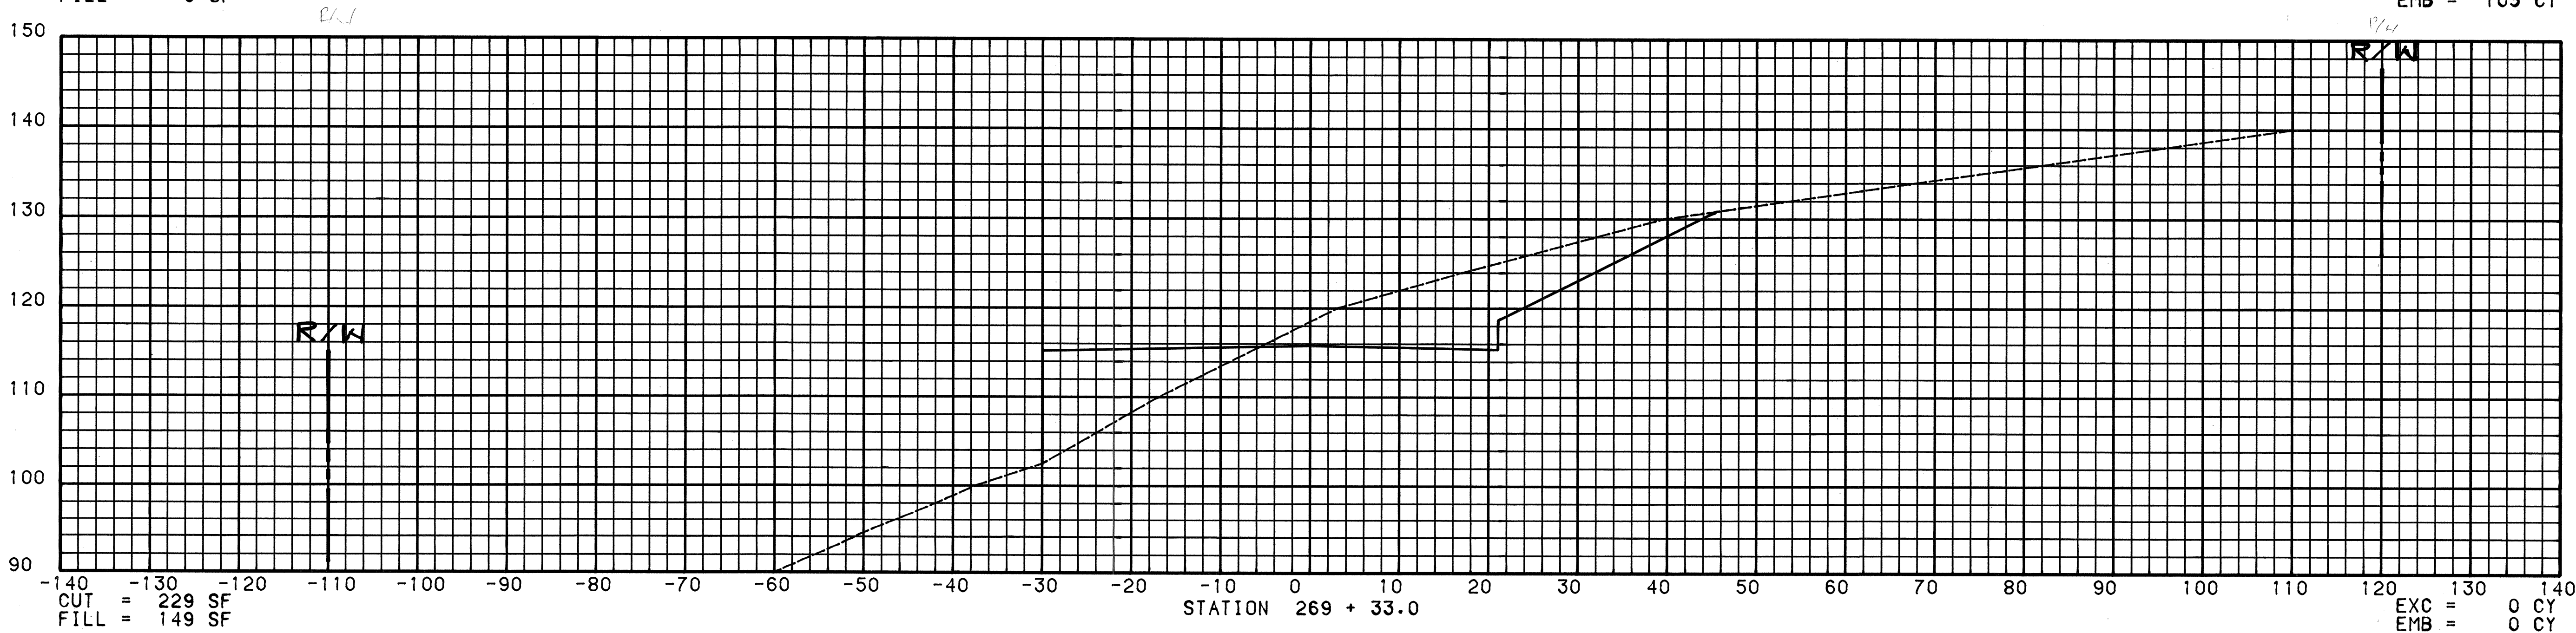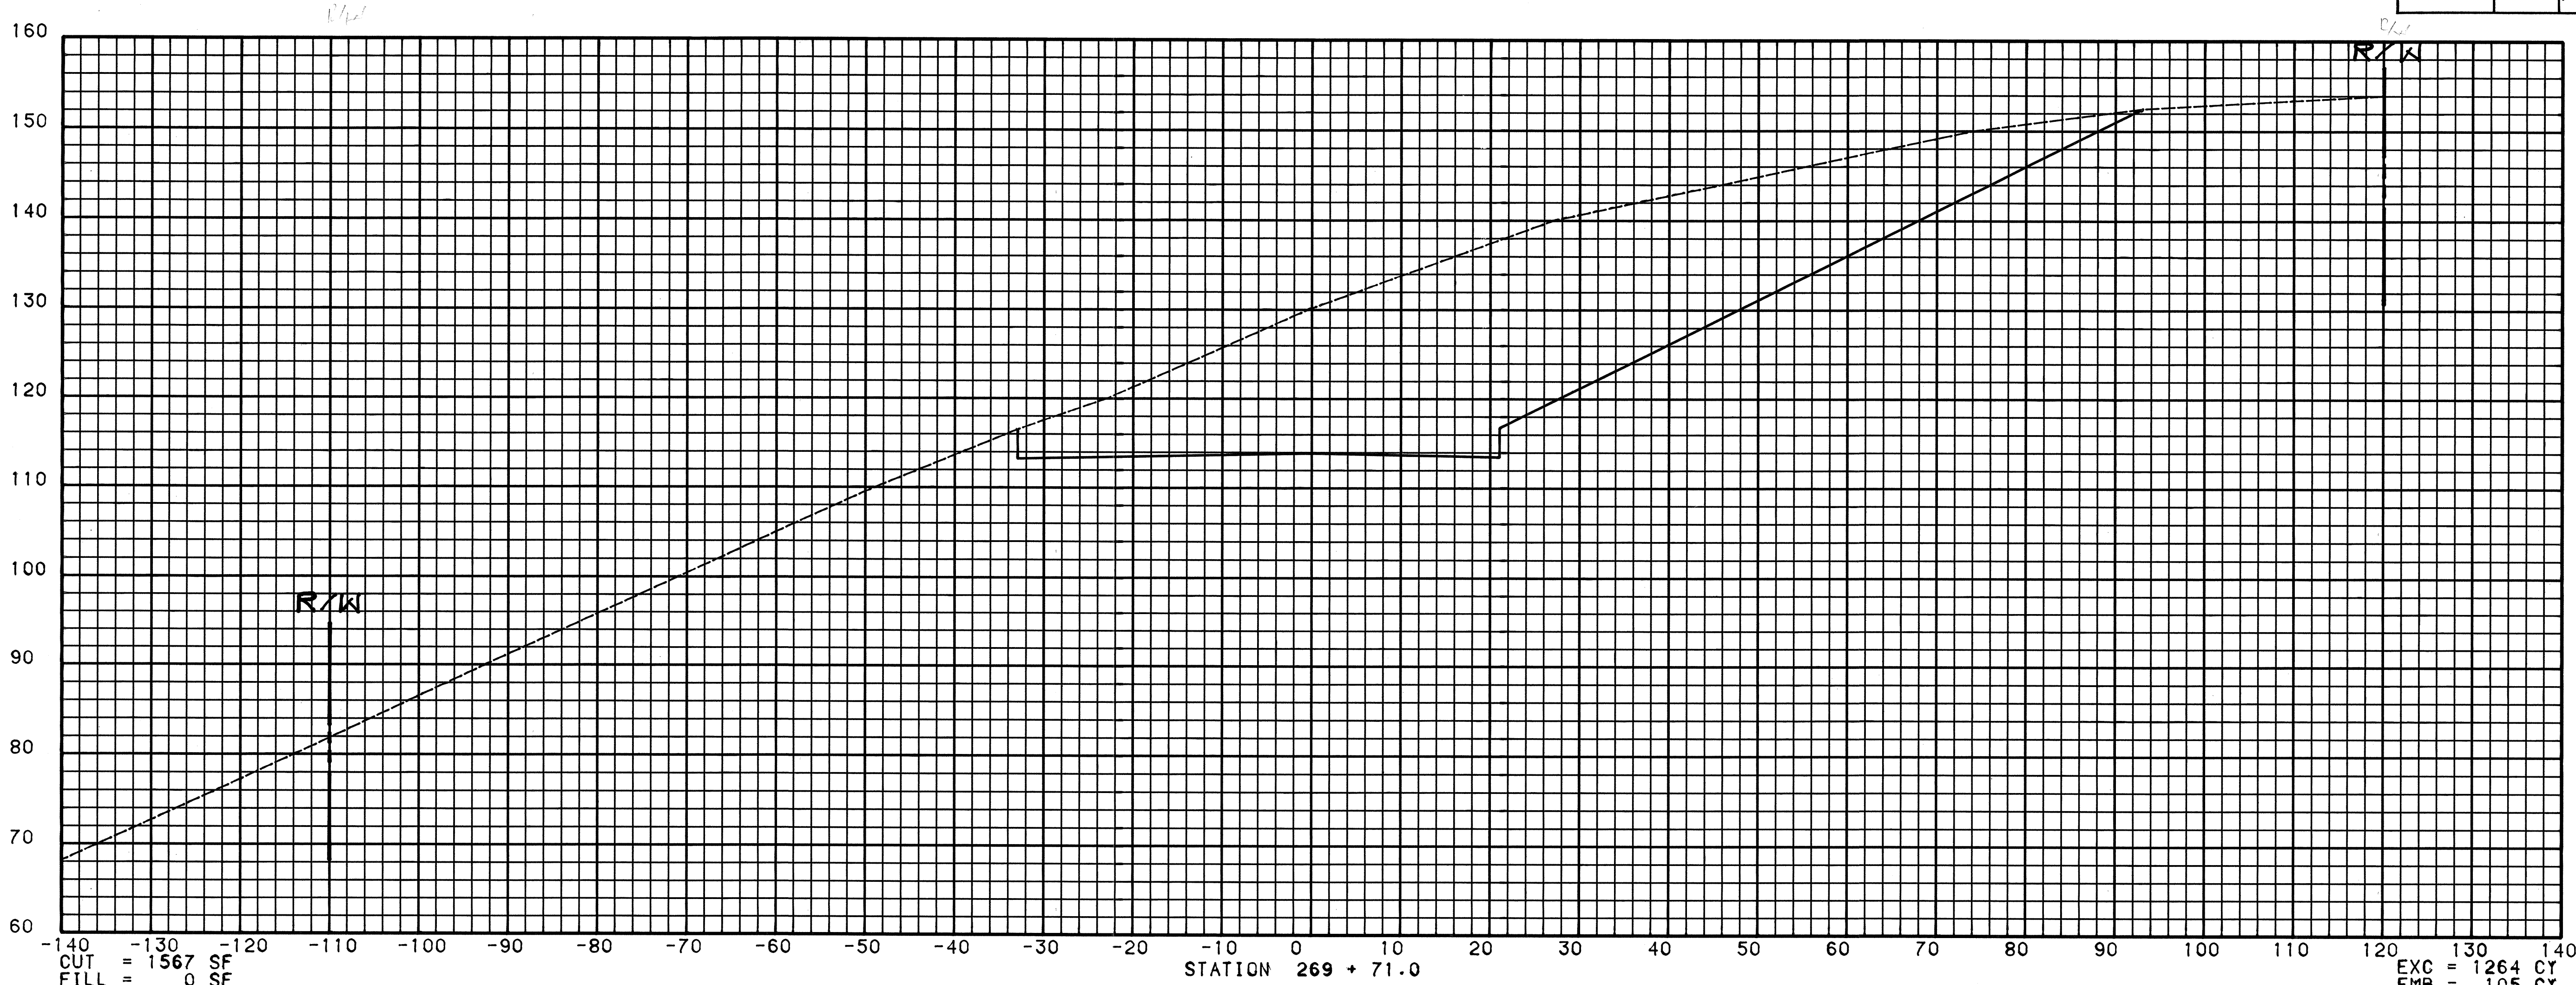


SCALE : HORIZONTAL 1 INCH = 10 FEET
VERTICAL 1 INCH = 10 FEET

ORIGINAL PLAN	SURVEY PLOTTED BY	DATE
NOTE BOOK	DRAWN BY	"
No.	TRACED BY	"
	DESIGNED BY	"
	QUANTITIES BY	"
	CHECKED BY	"


FED. ROAD DIST. NO.	STATE	FED. AID PROJ. NO.	FISCAL YEAR	SHEET NO.	TOTAL SHEETS
HAWAII	HAW.	F-030-1(18)	1984	143	169

ORIGINAL PLAN	SURVEY PLOTTED BY	DATE
NOTE BOOK	DRAWN BY	"
No.	DESIGNED BY	"
	CHECKED BY	"

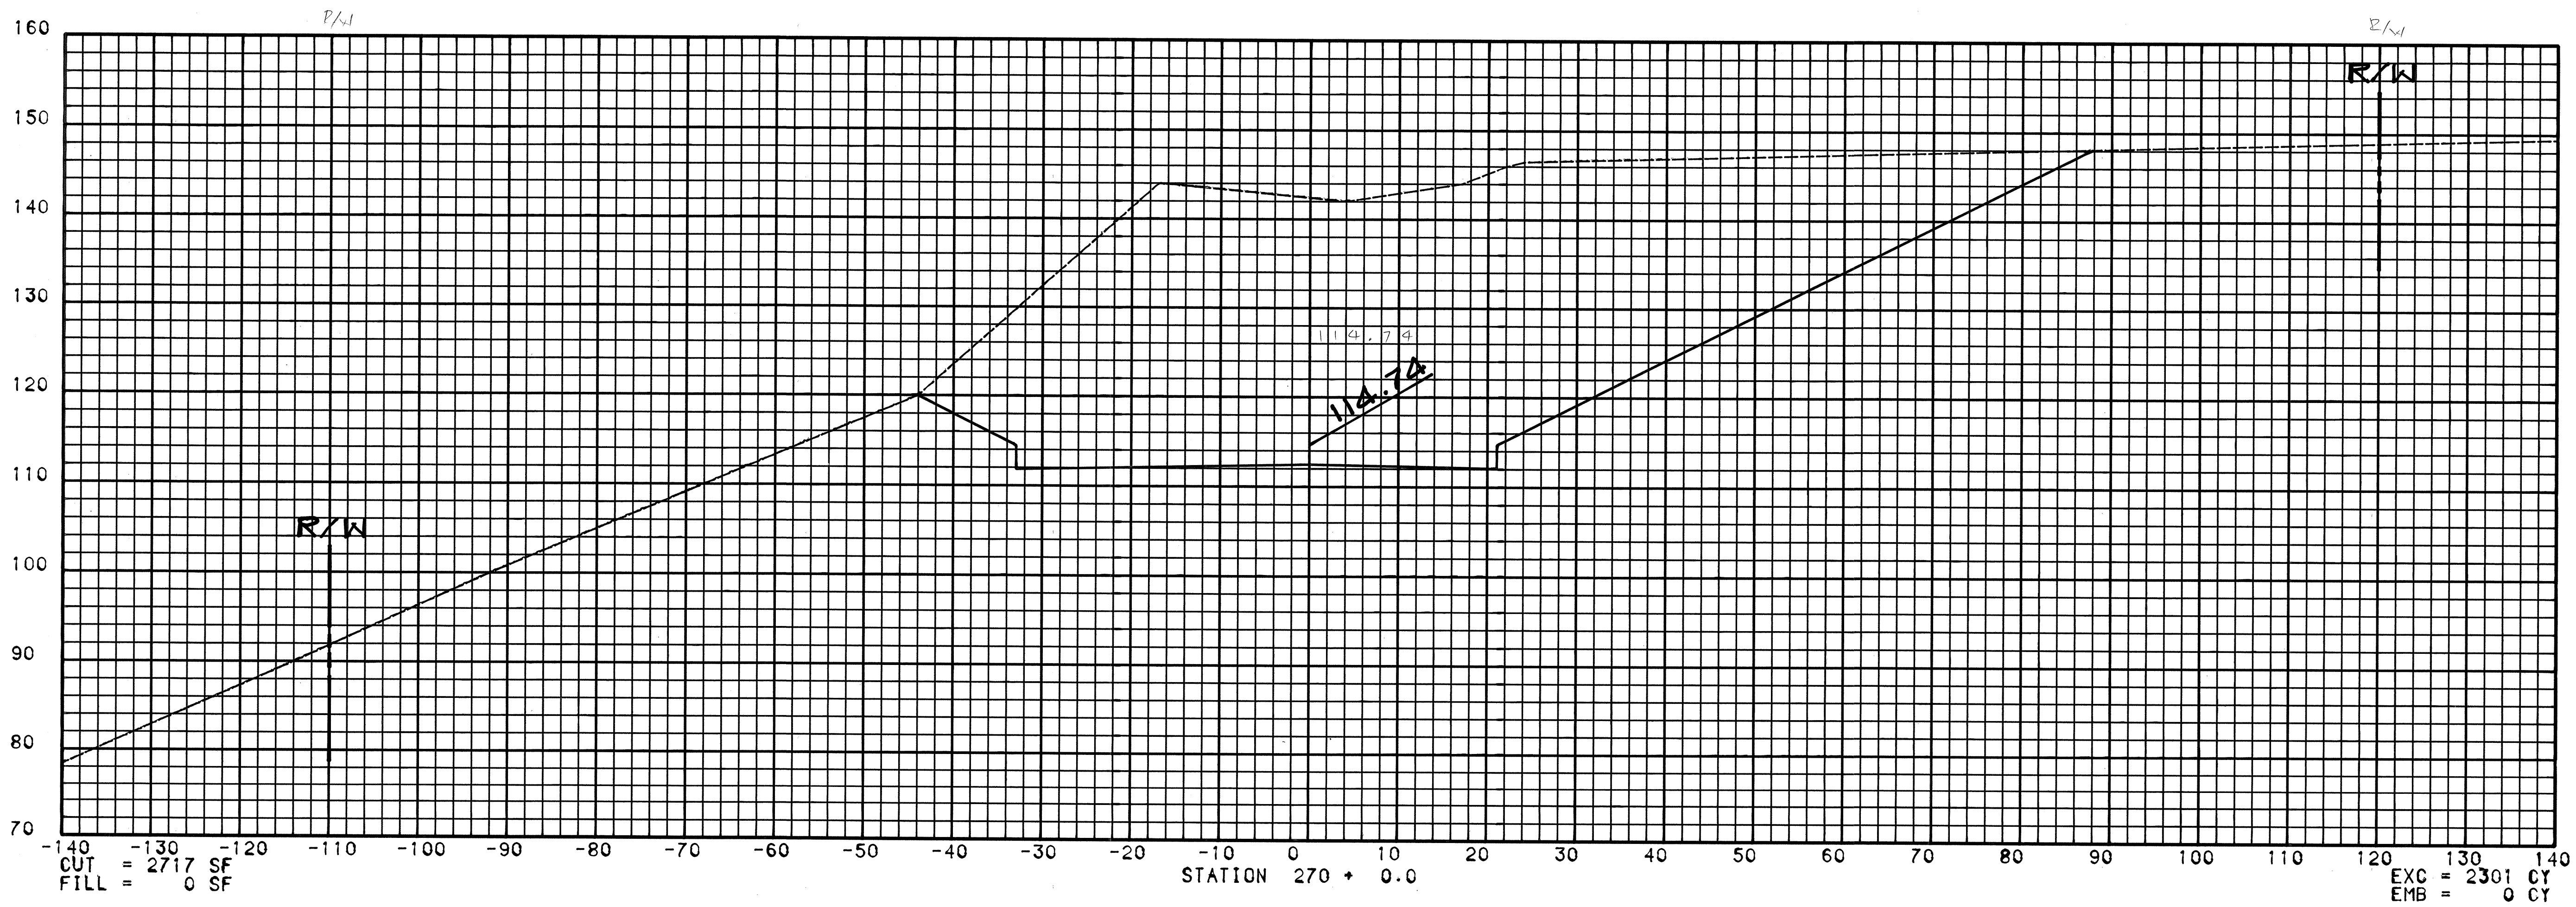



SCALE : HORIZONTAL 1 INCH = 10 FEET
VERTICAL 1 INCH = 10 FEET

FED. ROAD DIST. NO.	STATE	FED. AID PROJ. NO.	FISCAL YEAR	SHEET NO.	TOTAL SHEETS
HAWAII	HAW.	F-030-1(18)	1984	144	169

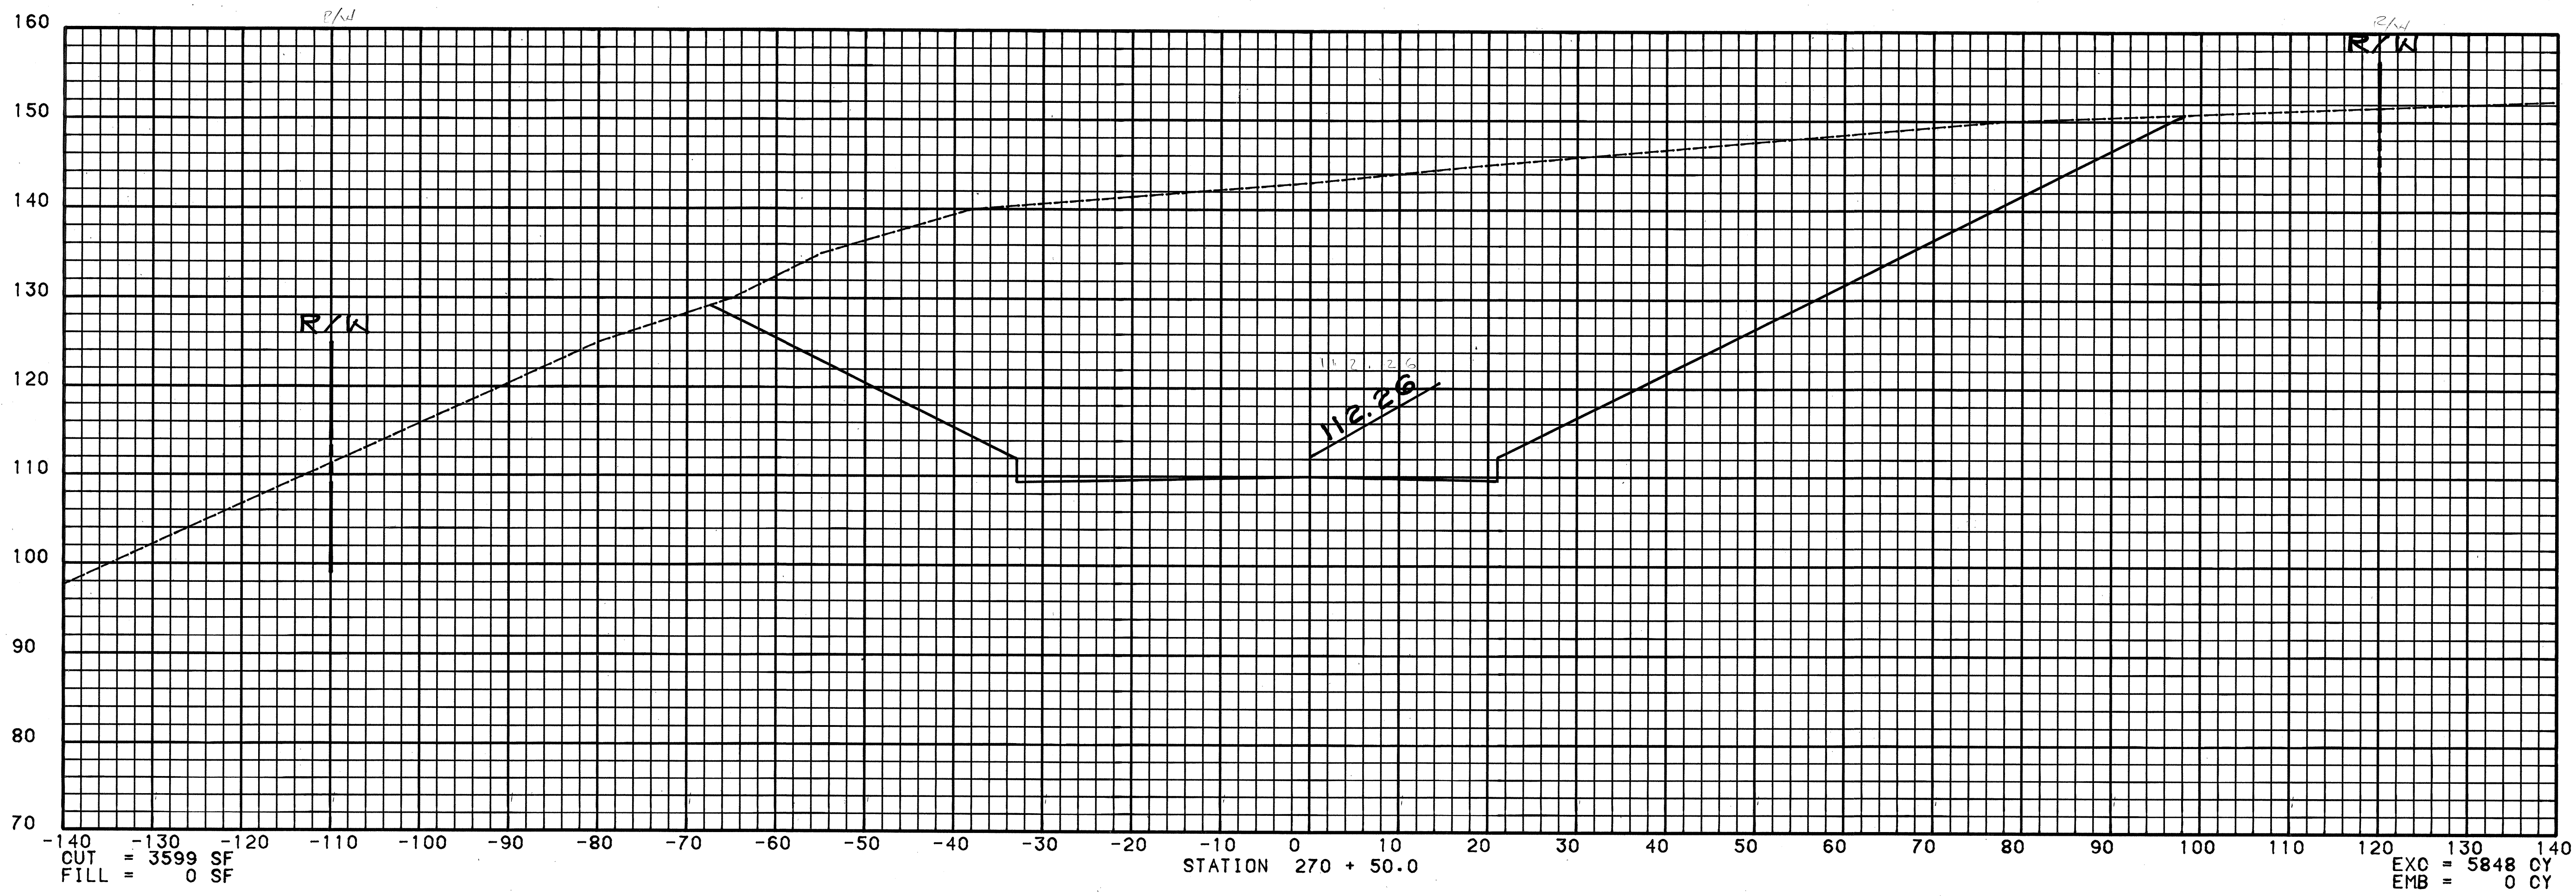

SCALE : HORIZONTAL 1 INCH = 10 FEET
VERTICAL 1 INCH = 10 FEET



FED. ROAD DIST. NO.	STATE	FED. AID PROJ. NO.	FISCAL YEAR	SHEET NO.	TOTAL SHEETS
HAWAII	HAW.	F-030-1(18)	1984	145	169

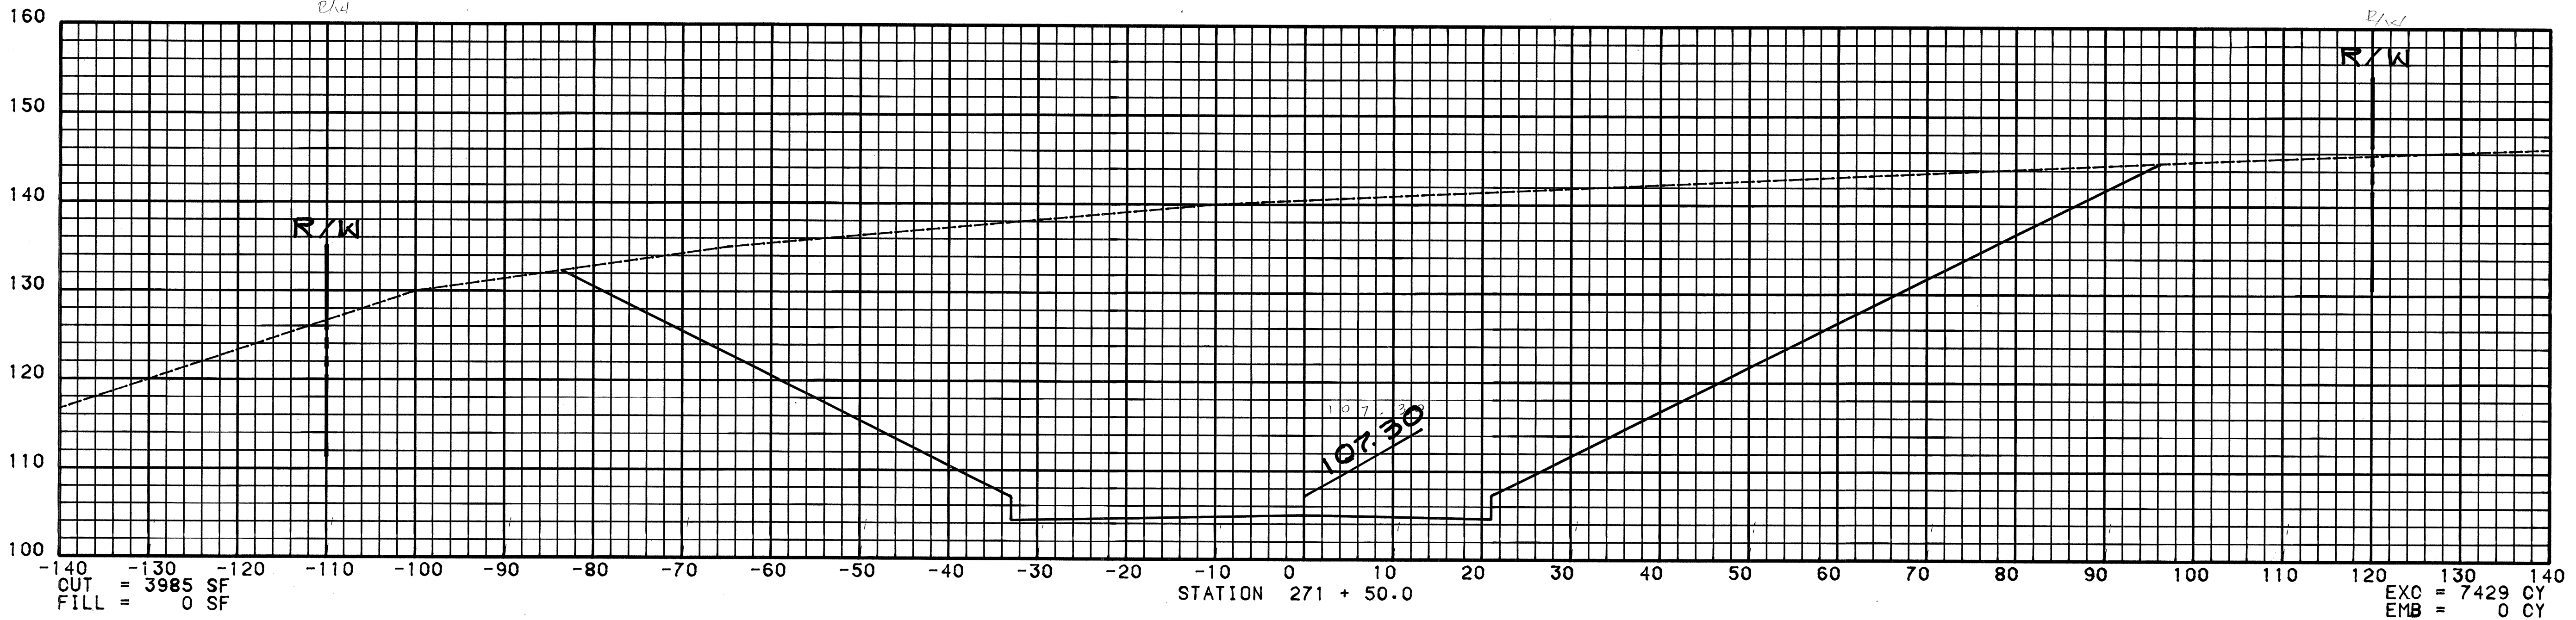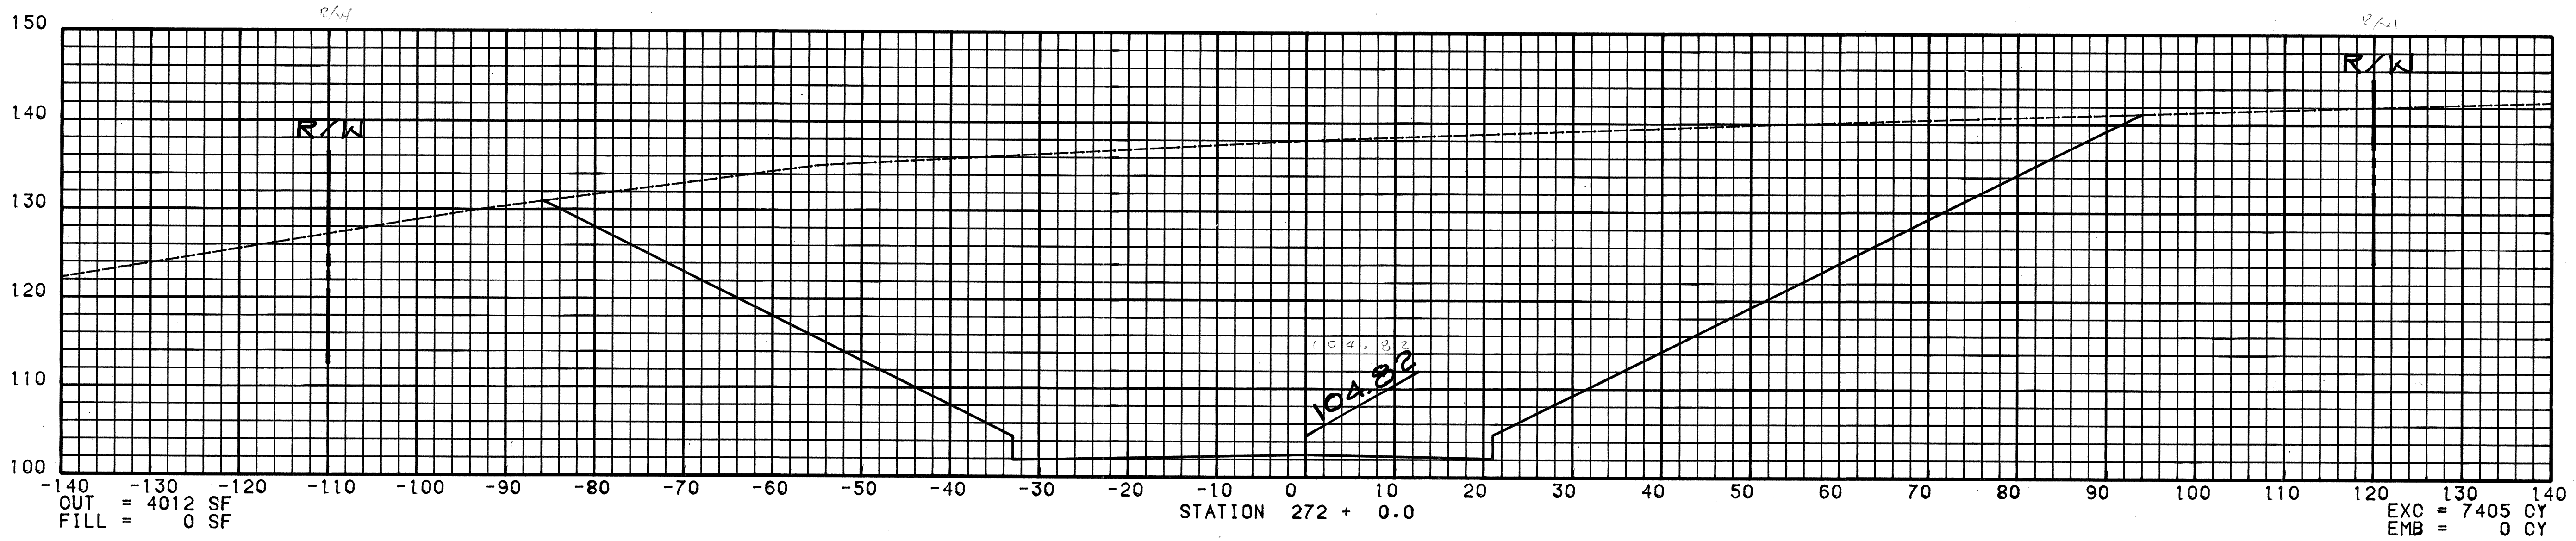

SCALE • HORIZONTAL 1 INCH = 10 FEET
 VERTICAL 1 INCH = 10 FEET

ORIGINAL PLAN
 SURVEY PLOTTED BY
 DRAWN BY
 TRACED BY
 DESIGNED BY
 NOTE BOOK
 QUANTITIES BY
 CHECKED BY
 No.




HAWAII	HAW.	F-030-1(18)	1984	146	169
--------	------	-------------	------	-----	-----

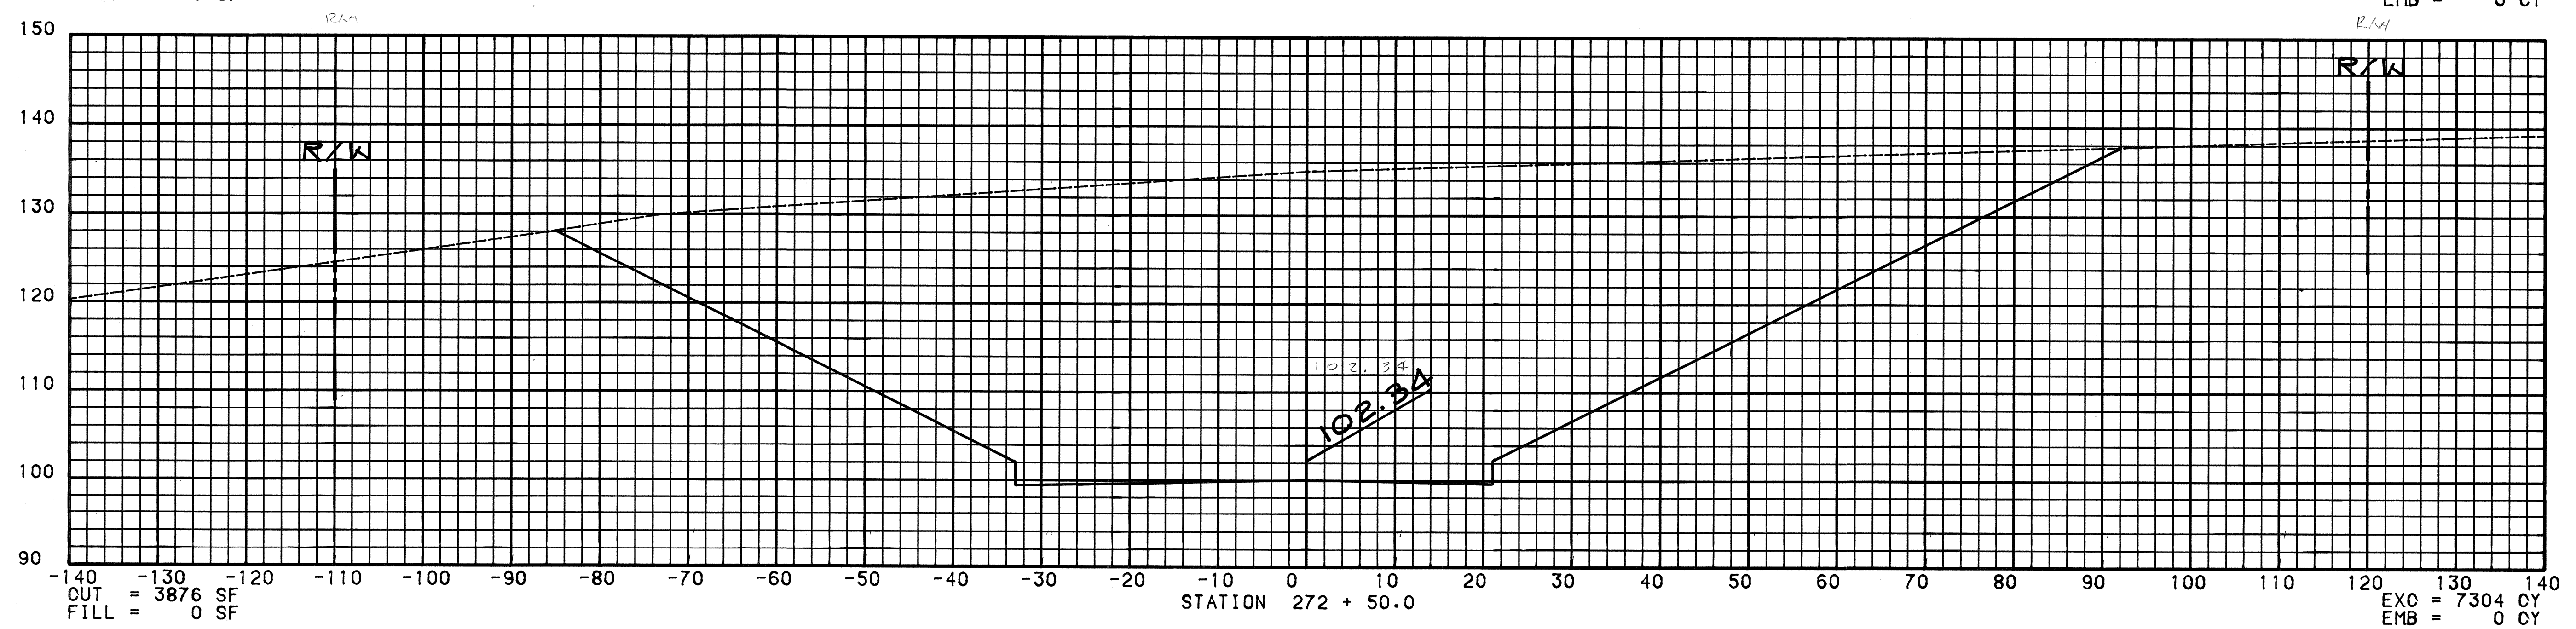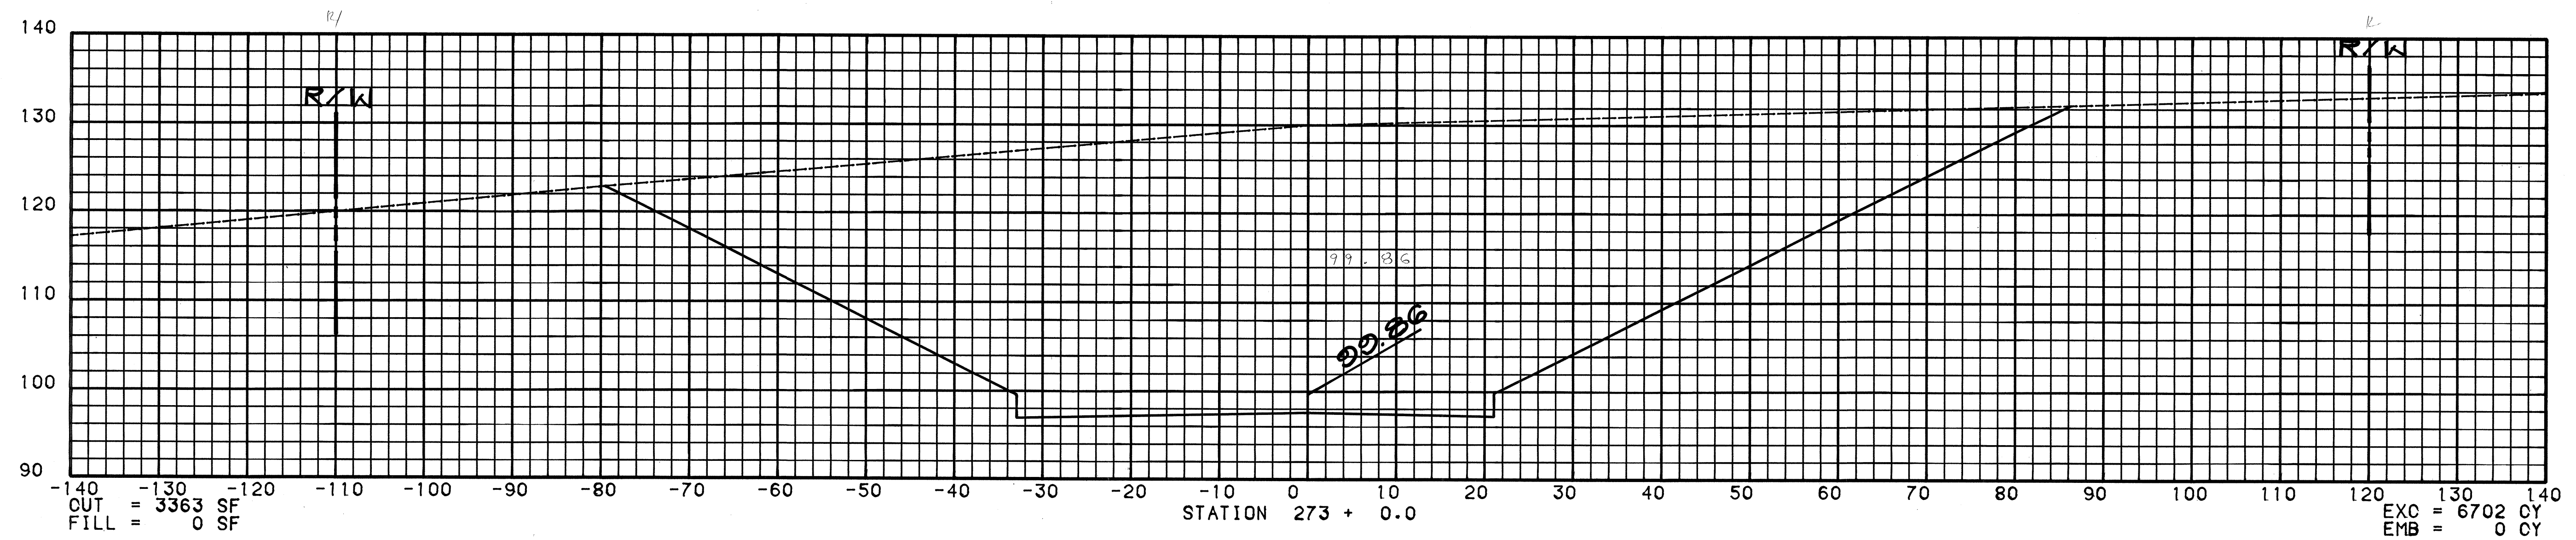

SCALE : HORIZONTAL 1 INCH = 10 FEET
VERTICAL 1 INCH = 10 FEET

ORIGINAL PLAN	SURVEY PLOTTED BY _____	DATE _____
	DRAWN BY _____	" _____
	TRACED BY _____	" _____
NOTE BOOK	DESIGNED BY _____	" _____
	QUANTITIES BY _____	" _____
No. _____	CHECKED BY _____	" _____

FED. ROAD DIST. NO.	STATE	FED. AID PROJ. NO.	FISCAL YEAR	SHEET NO.	TOTAL SHEETS
HAWAII	HAW.	F-030-(118)	1984	147	169

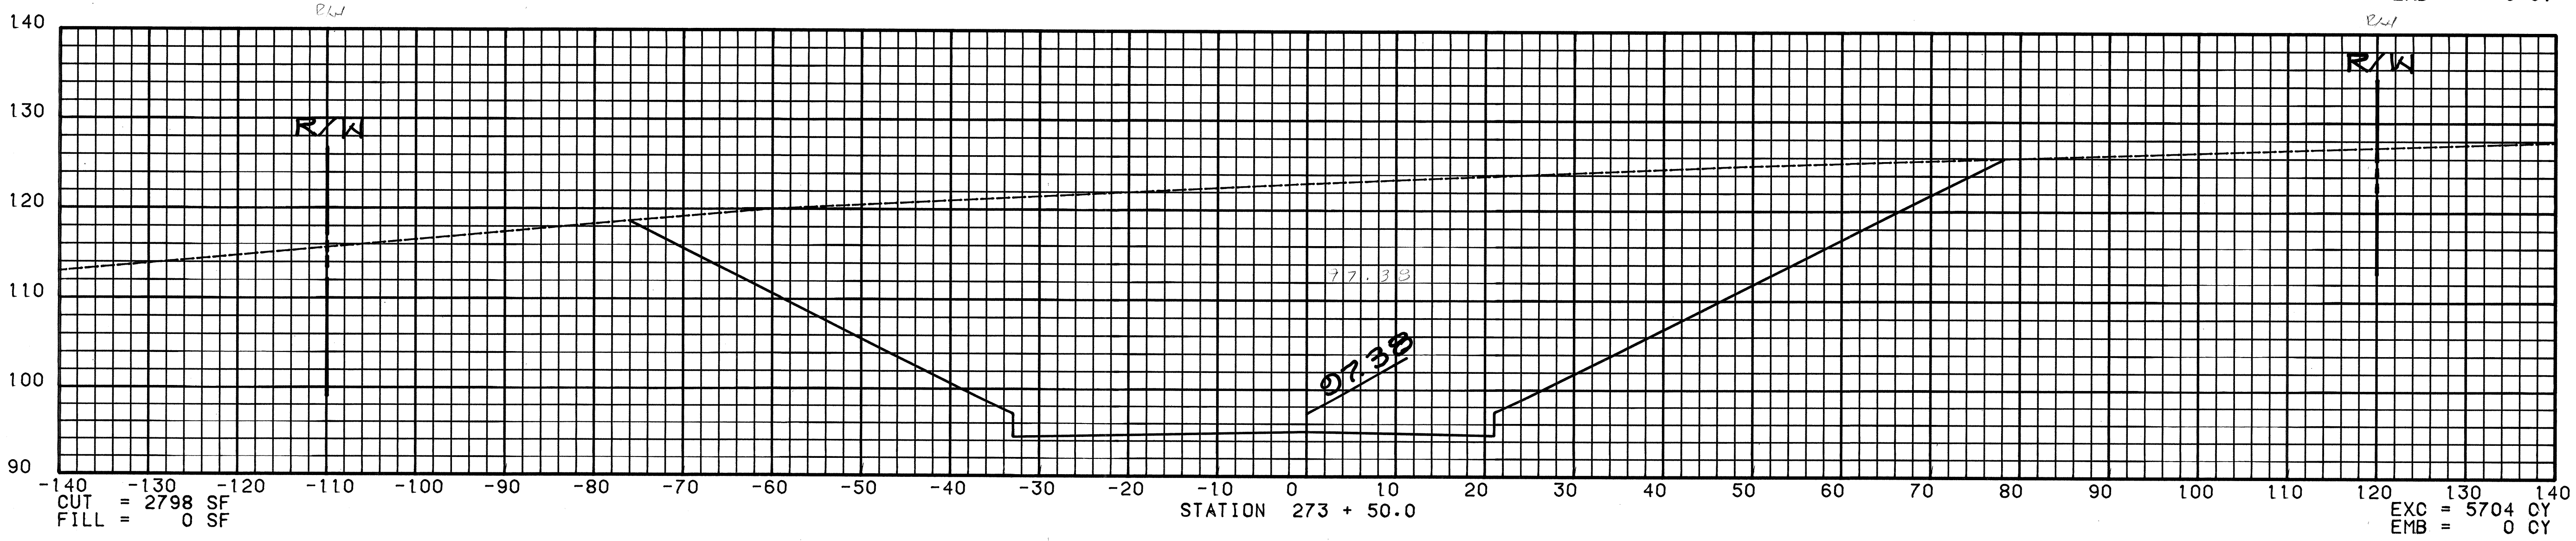
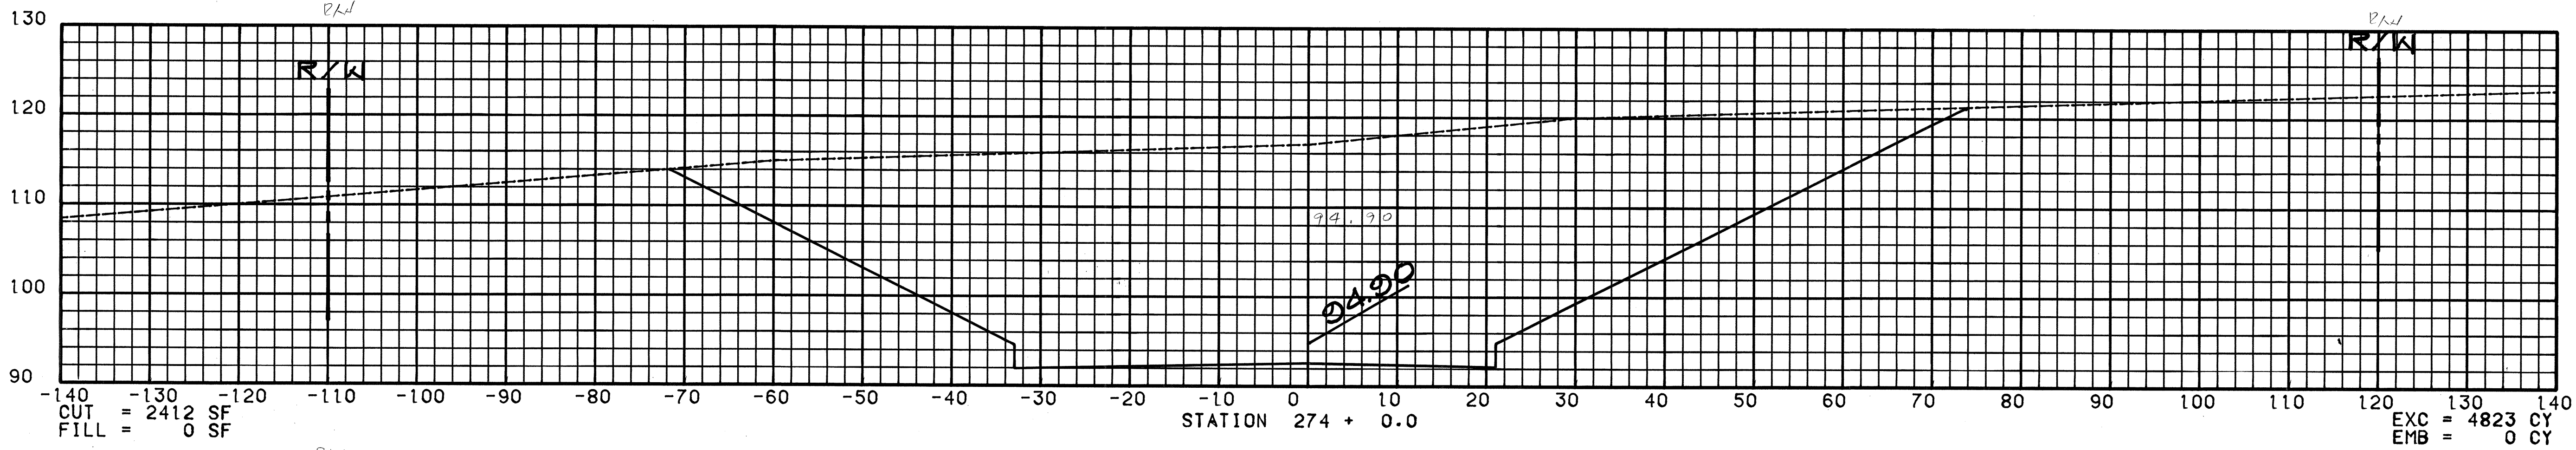
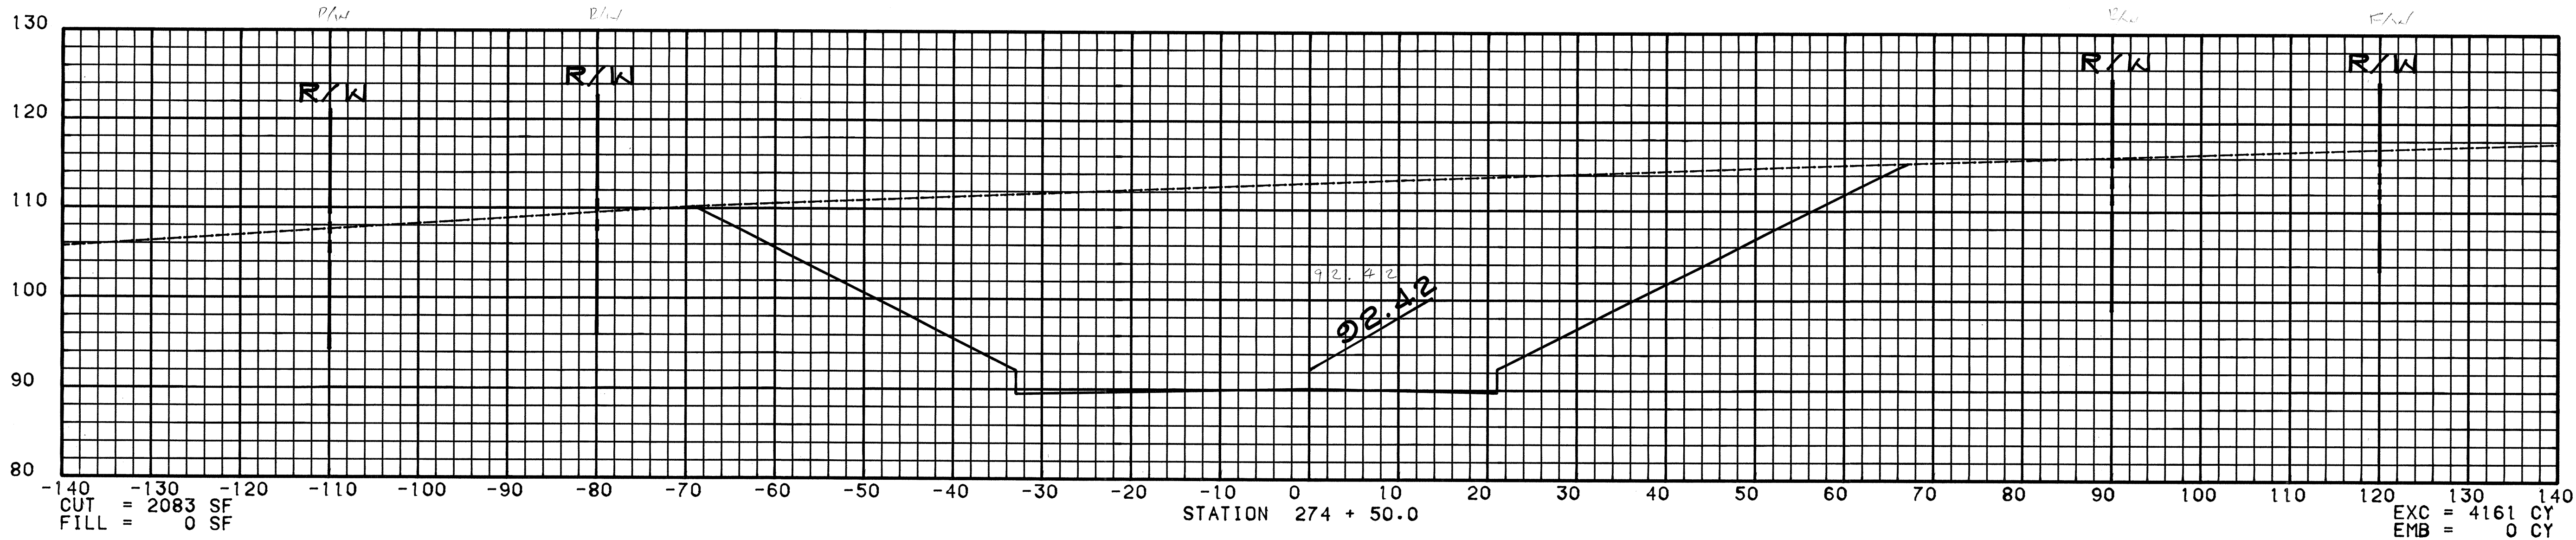


SCALE • HORIZONTAL 1 INCH = 10 FEET
VERTICAL 1 INCH = 10 FEET

ORIGINAL
PLAN
NOTE BOOK
No.

SURVEY PLOTTED BY
DATE
DRAWN BY
DESIGNED BY
CHECKED BY




FED. ROAD DIST. NO.	STATE	FED. AID PROJ. NO.	FISCAL YEAR	SHEET NO.	TOTAL SHEETS
HAWAII	HAW.	F-030-1(8)	1984	148	169

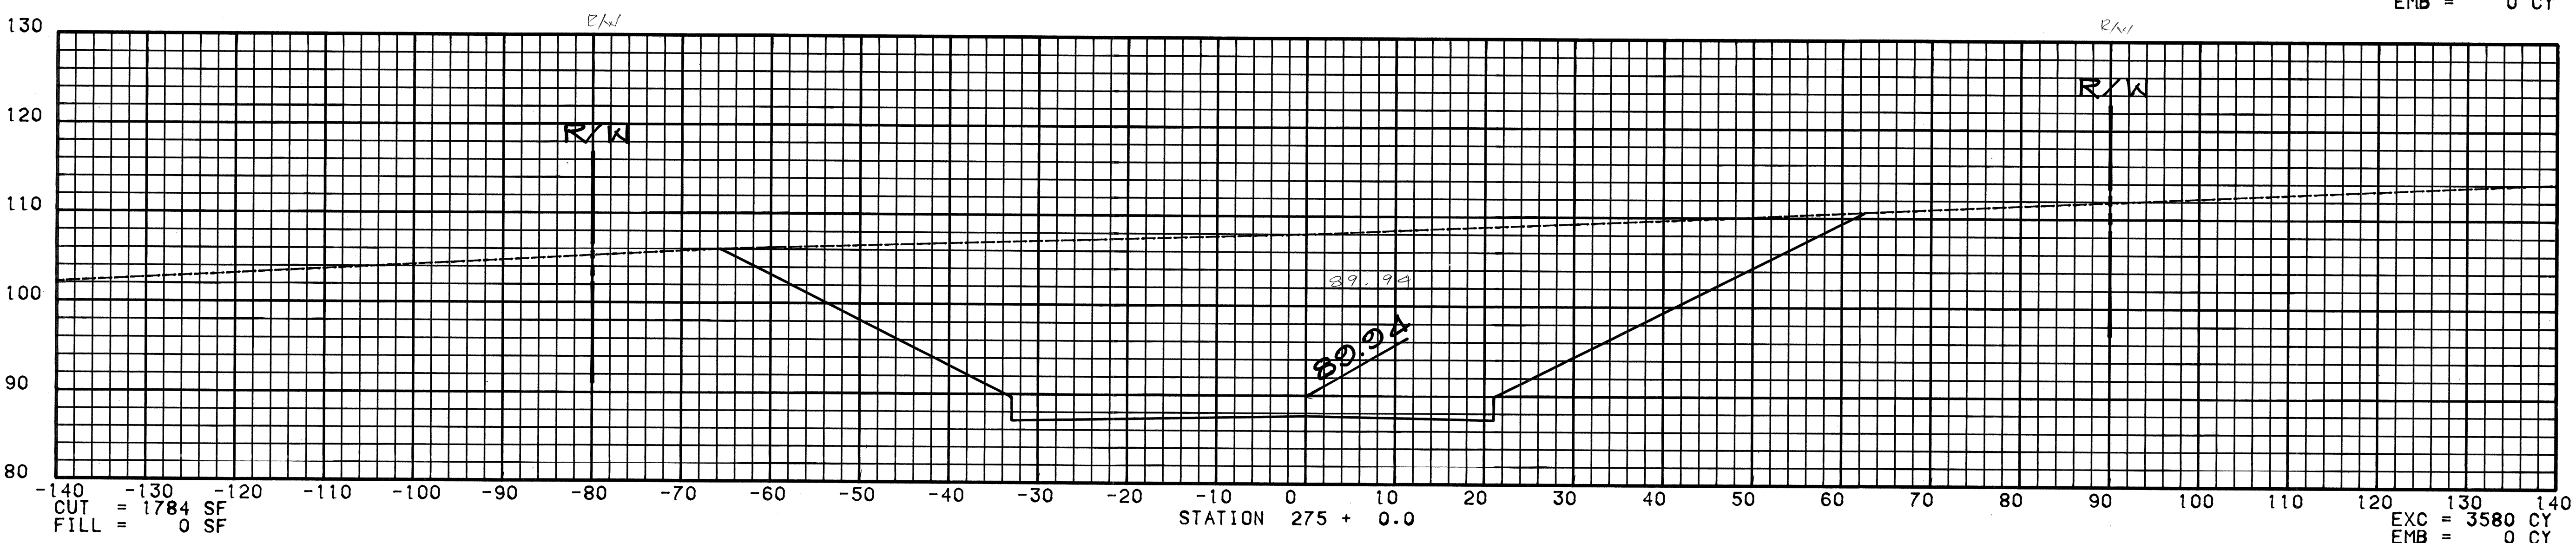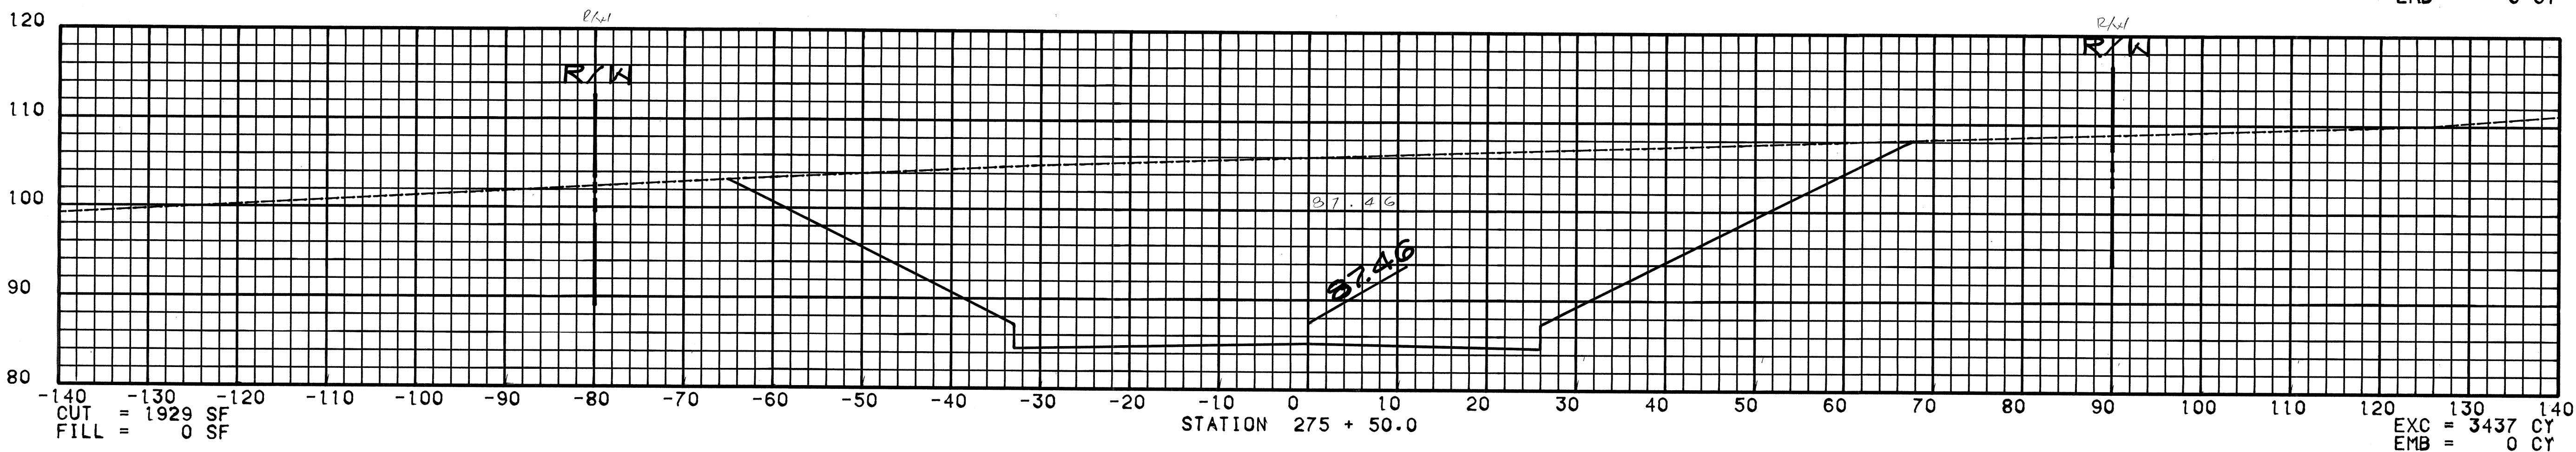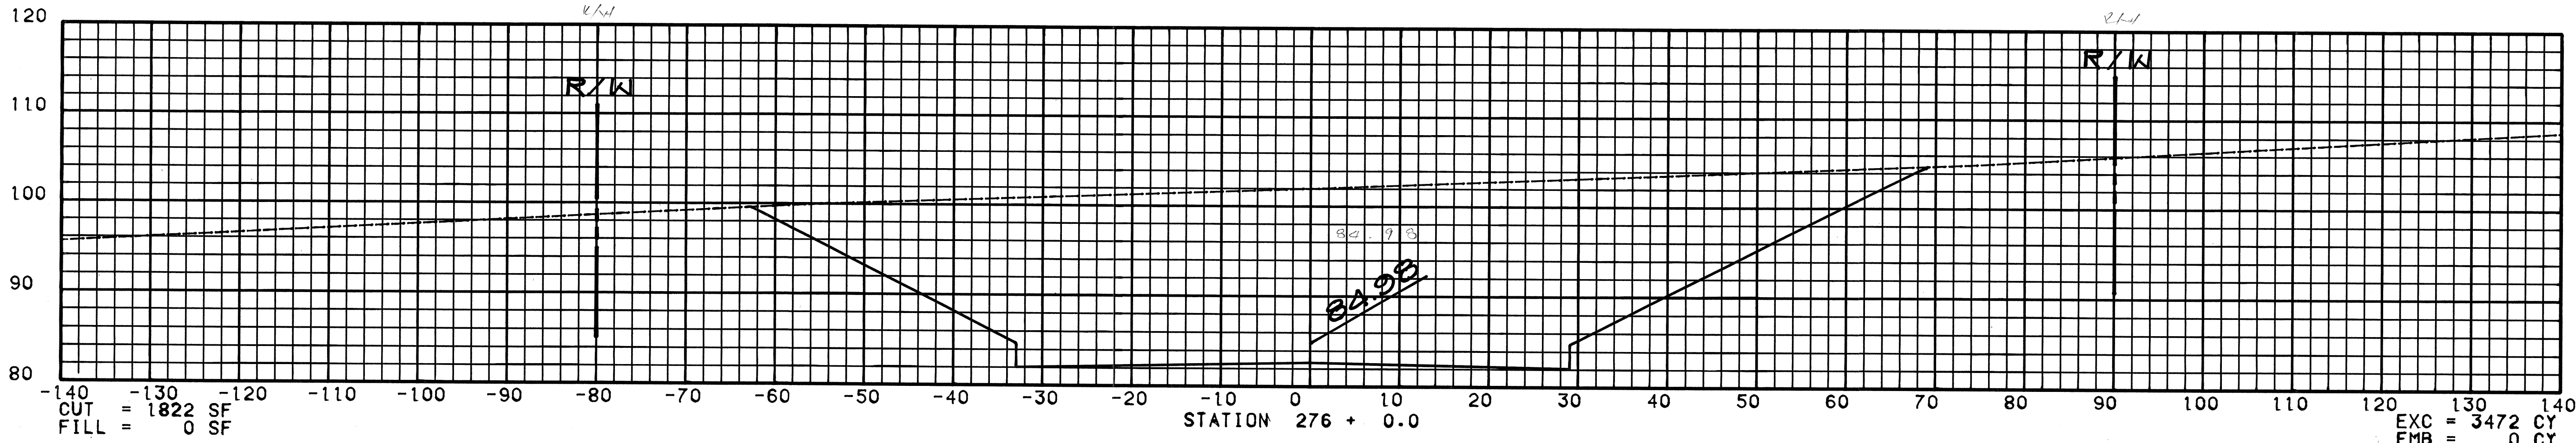

SCALE : HORIZONTAL 1 INCH = 10 FEET
 VERTICAL 1 INCH = 10 FEET

ORIGINAL PLAN
 SURVEY PLOTTED BY
 DRAWN BY
 TRACED BY
 DESIGNED BY
 QUANTITIES BY
 CHECKED BY
 No.




FED. ROAD DIST. NO.	STATE	FED. AID PROJ. NO.	FISCAL YEAR	SHEET NO.	TOTAL SHEETS
HAWAII	HAW.	F-030-1(18)	1984	149	169

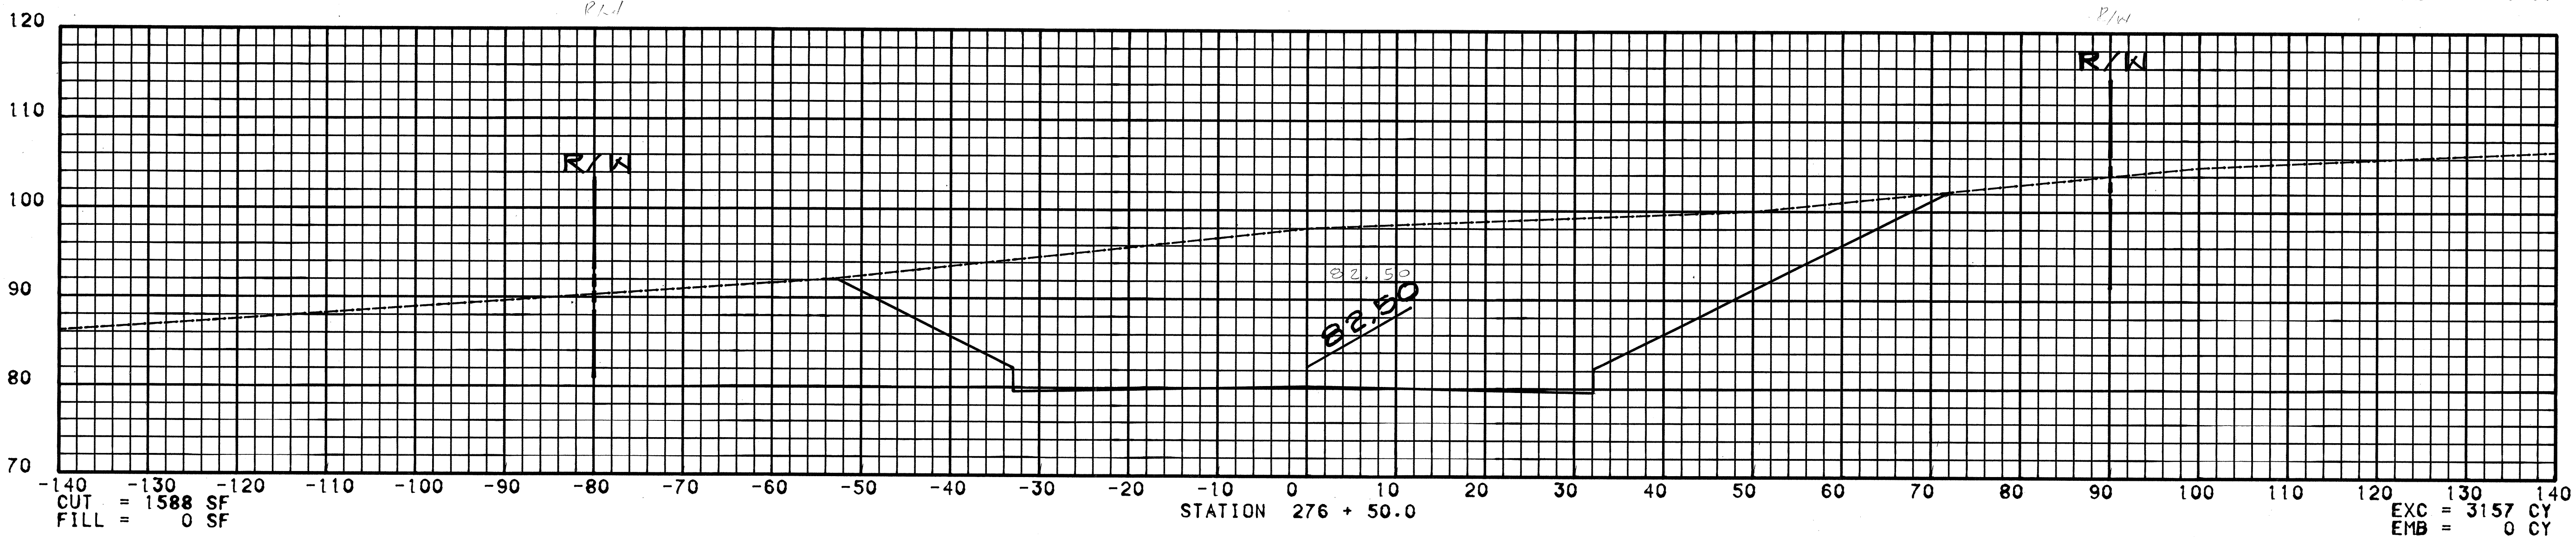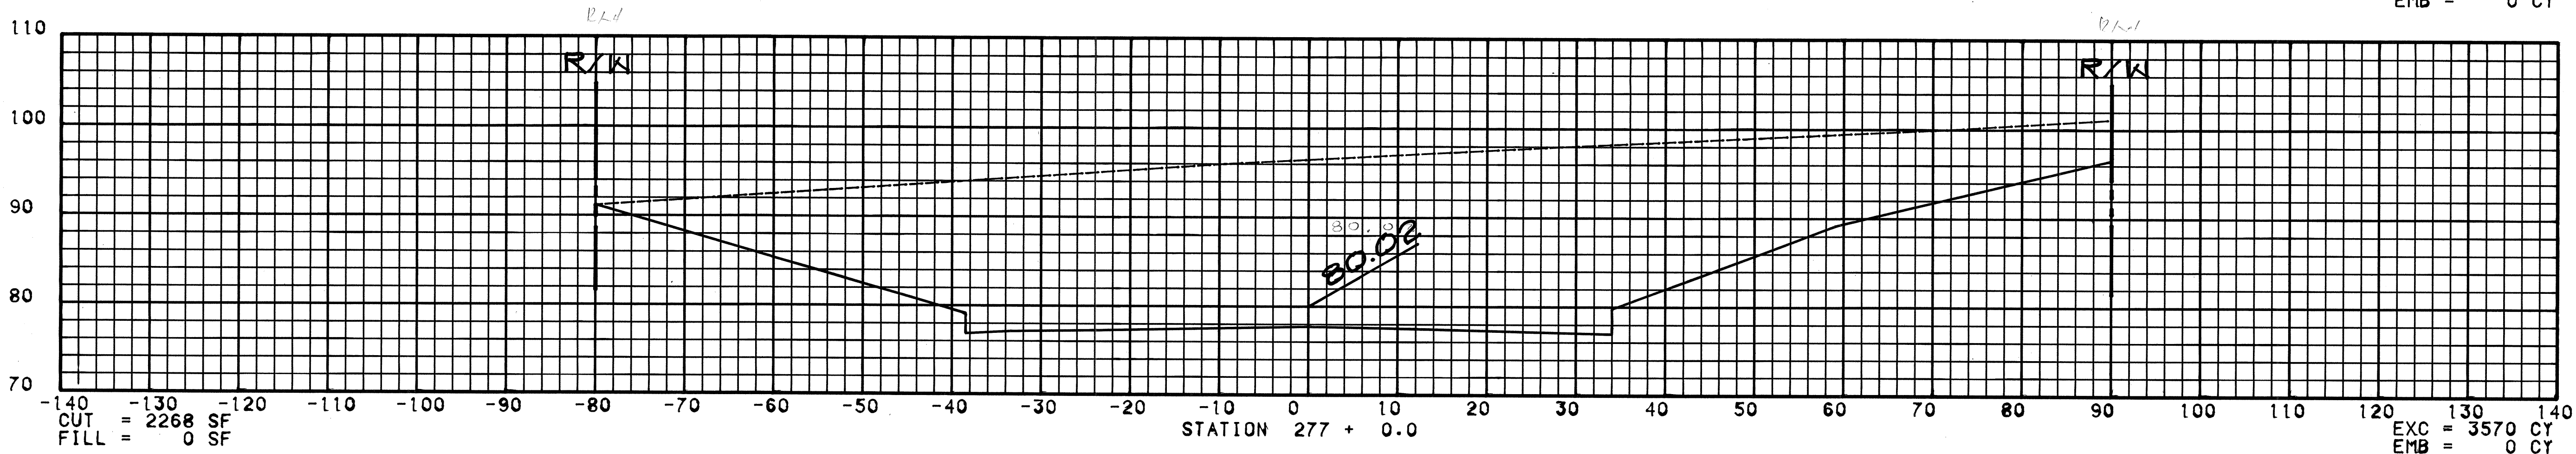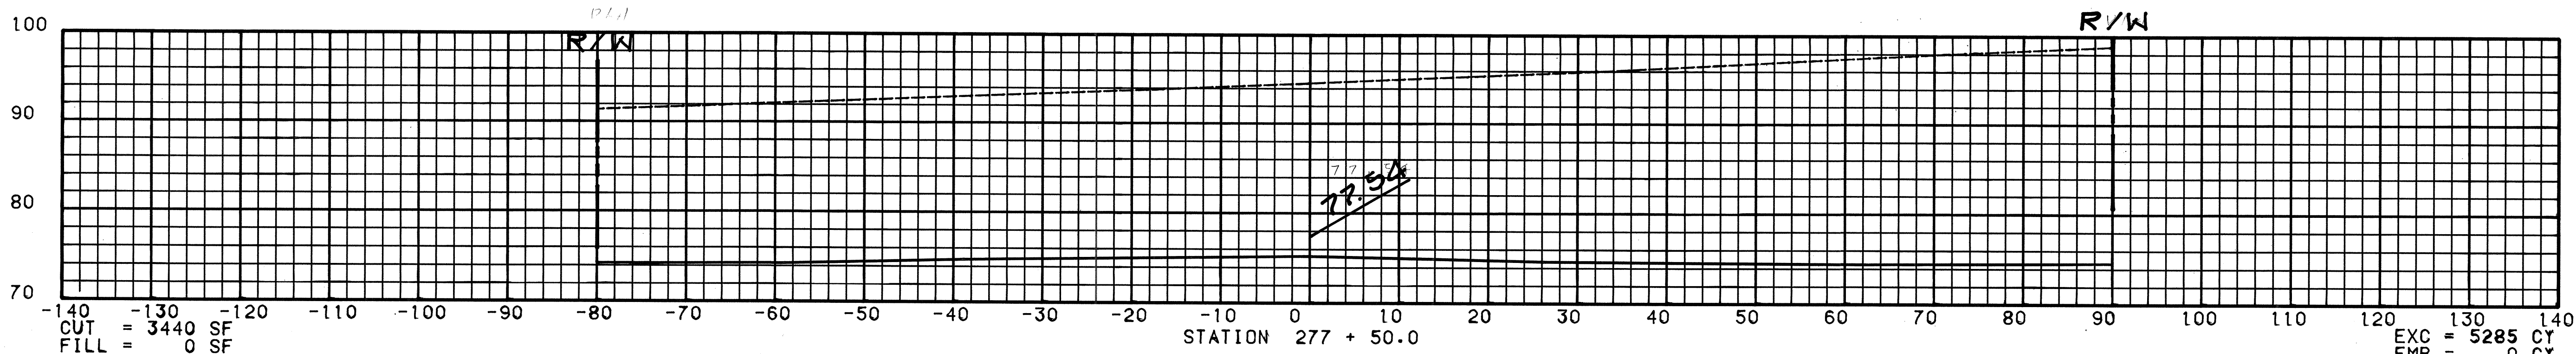

SCALE : HORIZONTAL 1 INCH = 10 FEET
VERTICAL 1 INCH = 10 FEET

ORIGINAL PLAN
DESIGNED BY
CHECKED BY
DATE
DRAWN BY
TRACED BY
NOTE BOOK
No.



FED. ROAD DIST. NO.	STATE	FED. AID PROJ. NO.	FISCAL YEAR	SHEET NO.	TOTAL SHEETS
HAWAII	HAW.	F-030-1(18)	1984	151	169

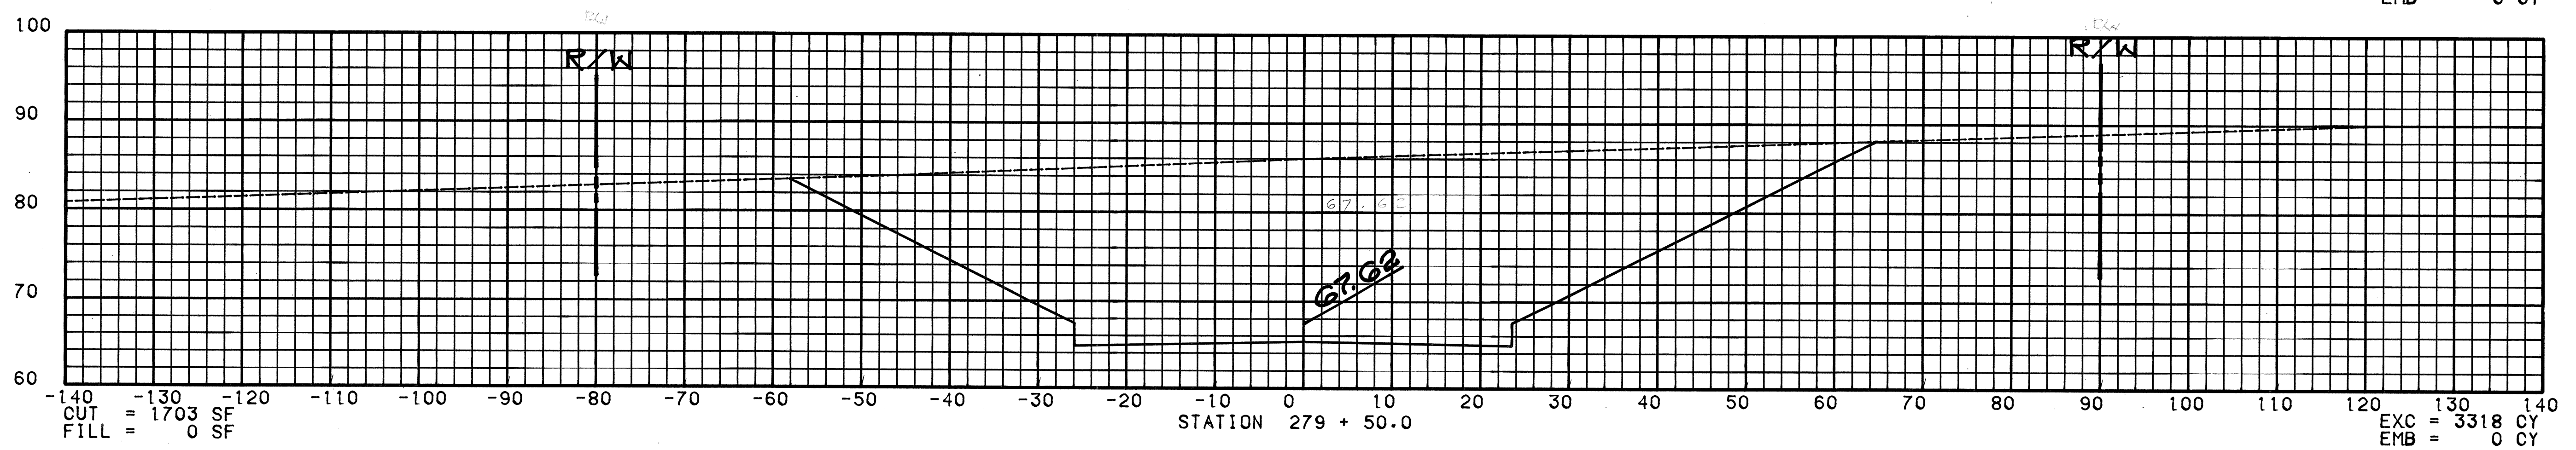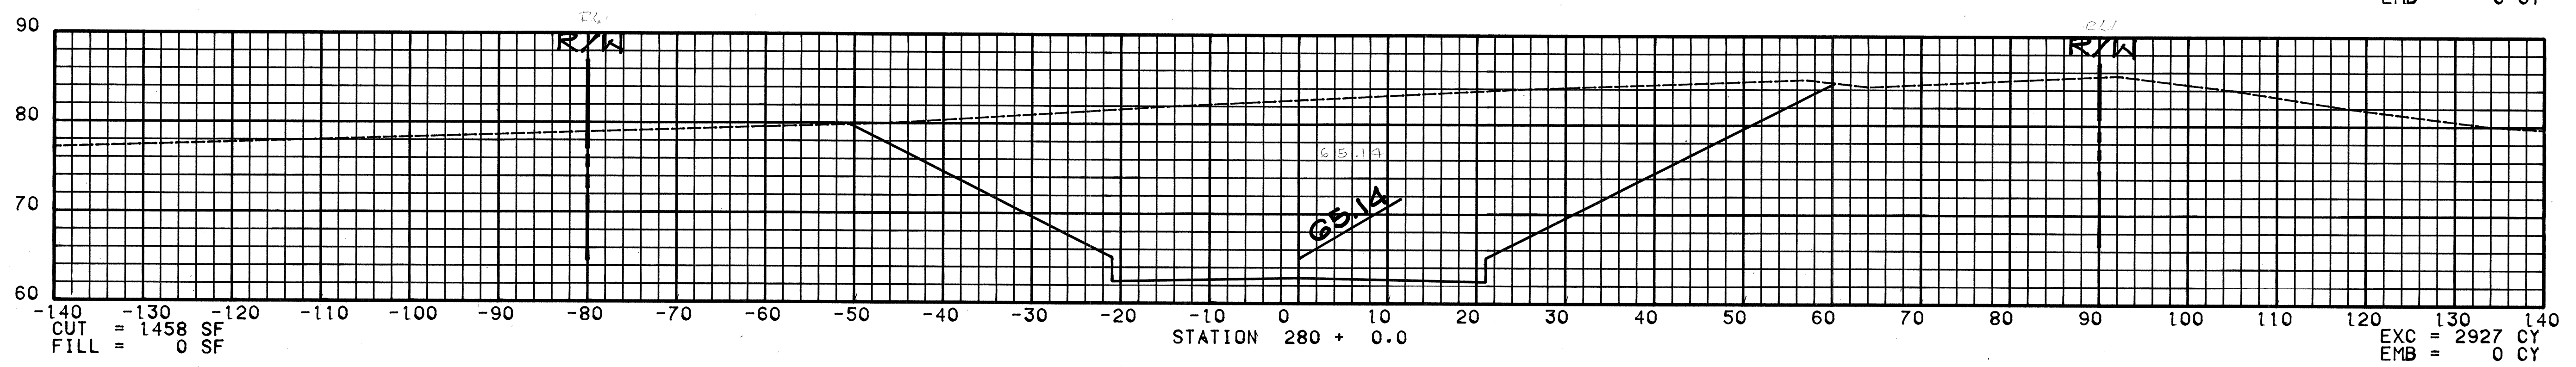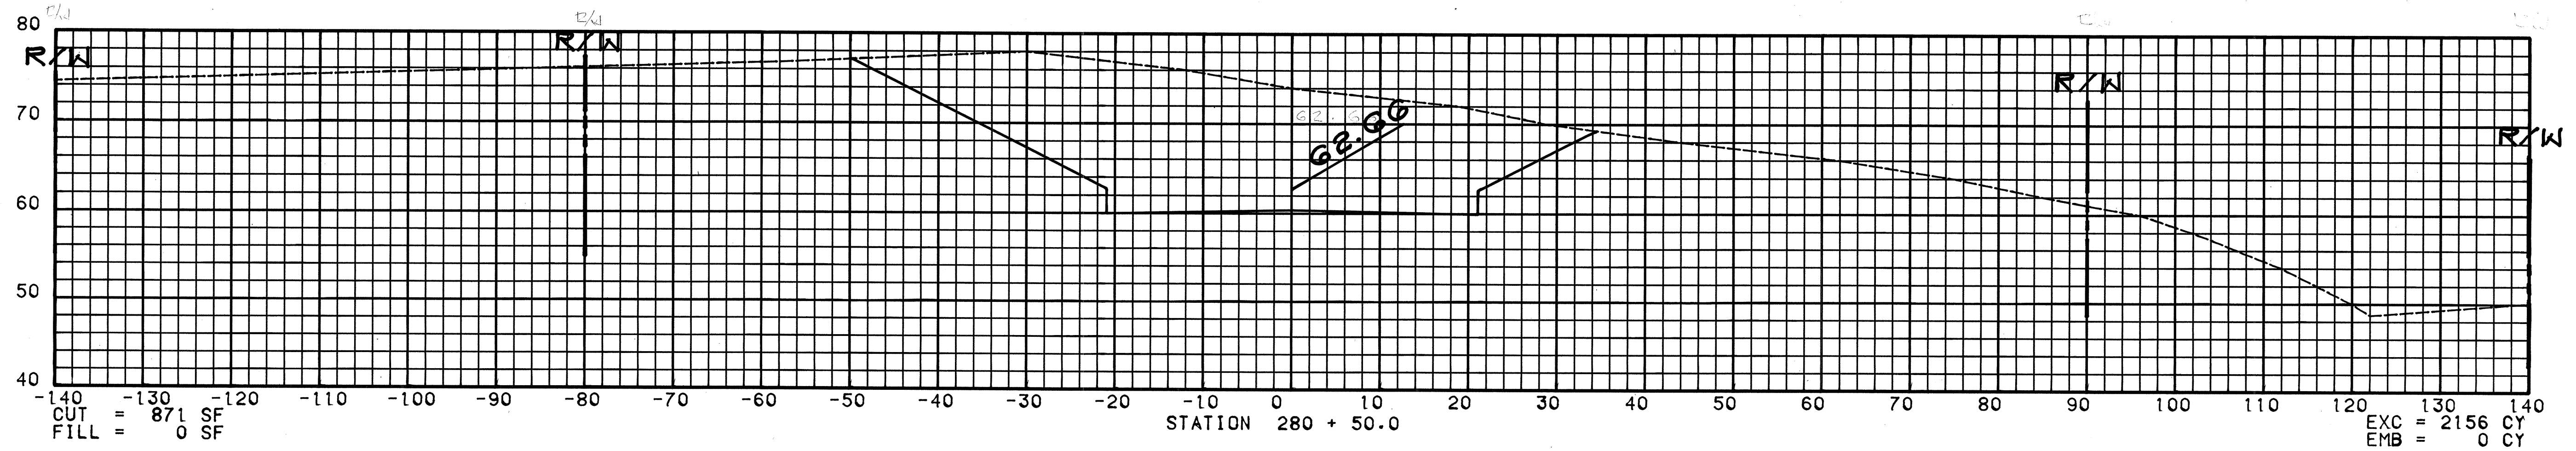

SCALE : HORIZONTAL 1 INCH = 10 FEET
VERTICAL 1 INCH = 10 FEET

ORIGINAL PLAN	SURVEY PLOTTED BY _____	DATE _____
	DRAWN BY _____	" _____
	TRACED BY _____	" _____
NOTE BOOK	DESIGNED BY _____	" _____
	QUANTITIES BY _____	" _____
No. _____	CHECKED BY _____	" _____



FED. ROAD DIST. NO.	STATE	FED. AID PROJ. NO.	FISCAL YEAR	SHEET NO.	TOTAL SHEETS
HAWAII	HAW.	F-030-(08)	1984	152	169

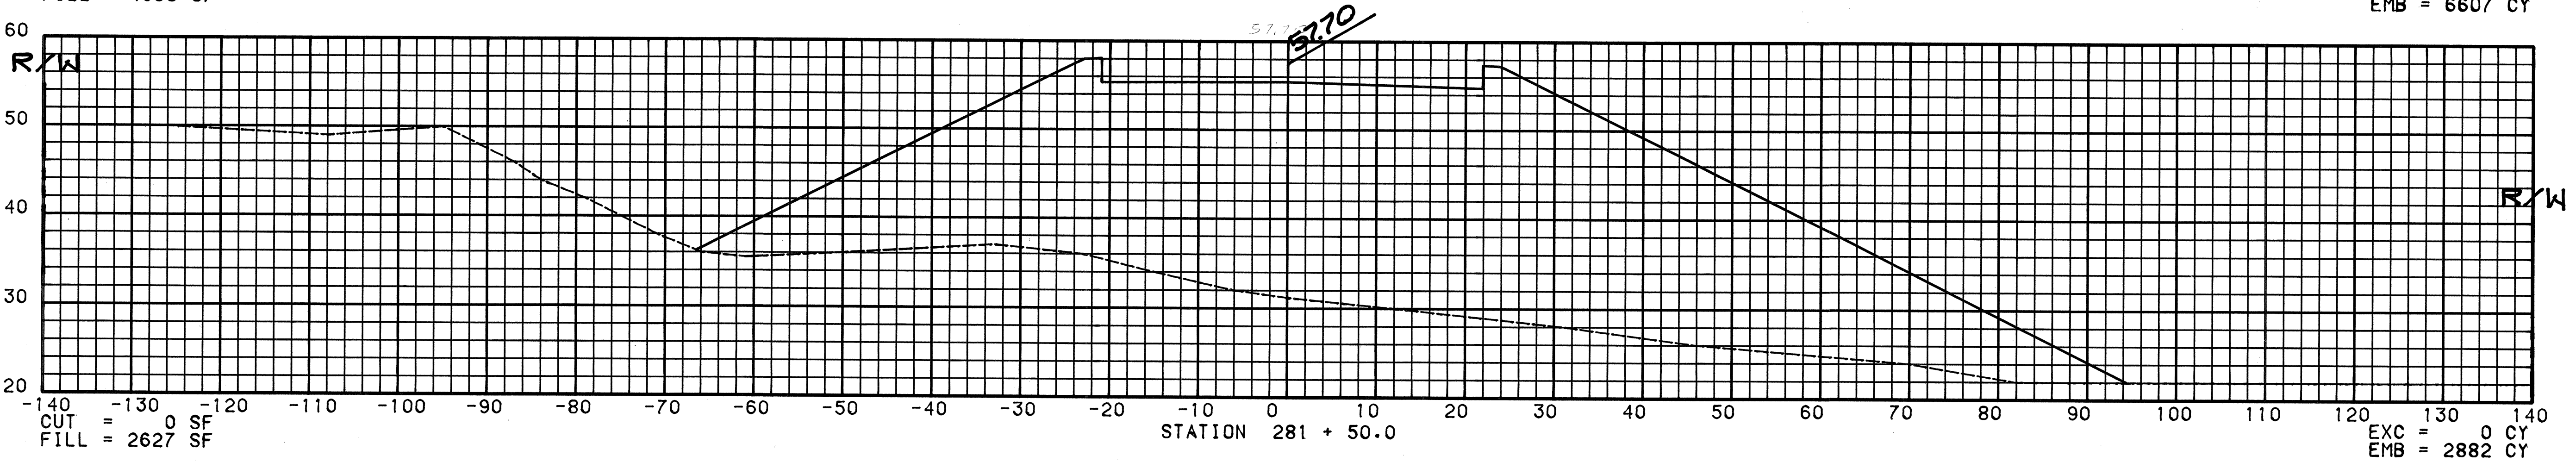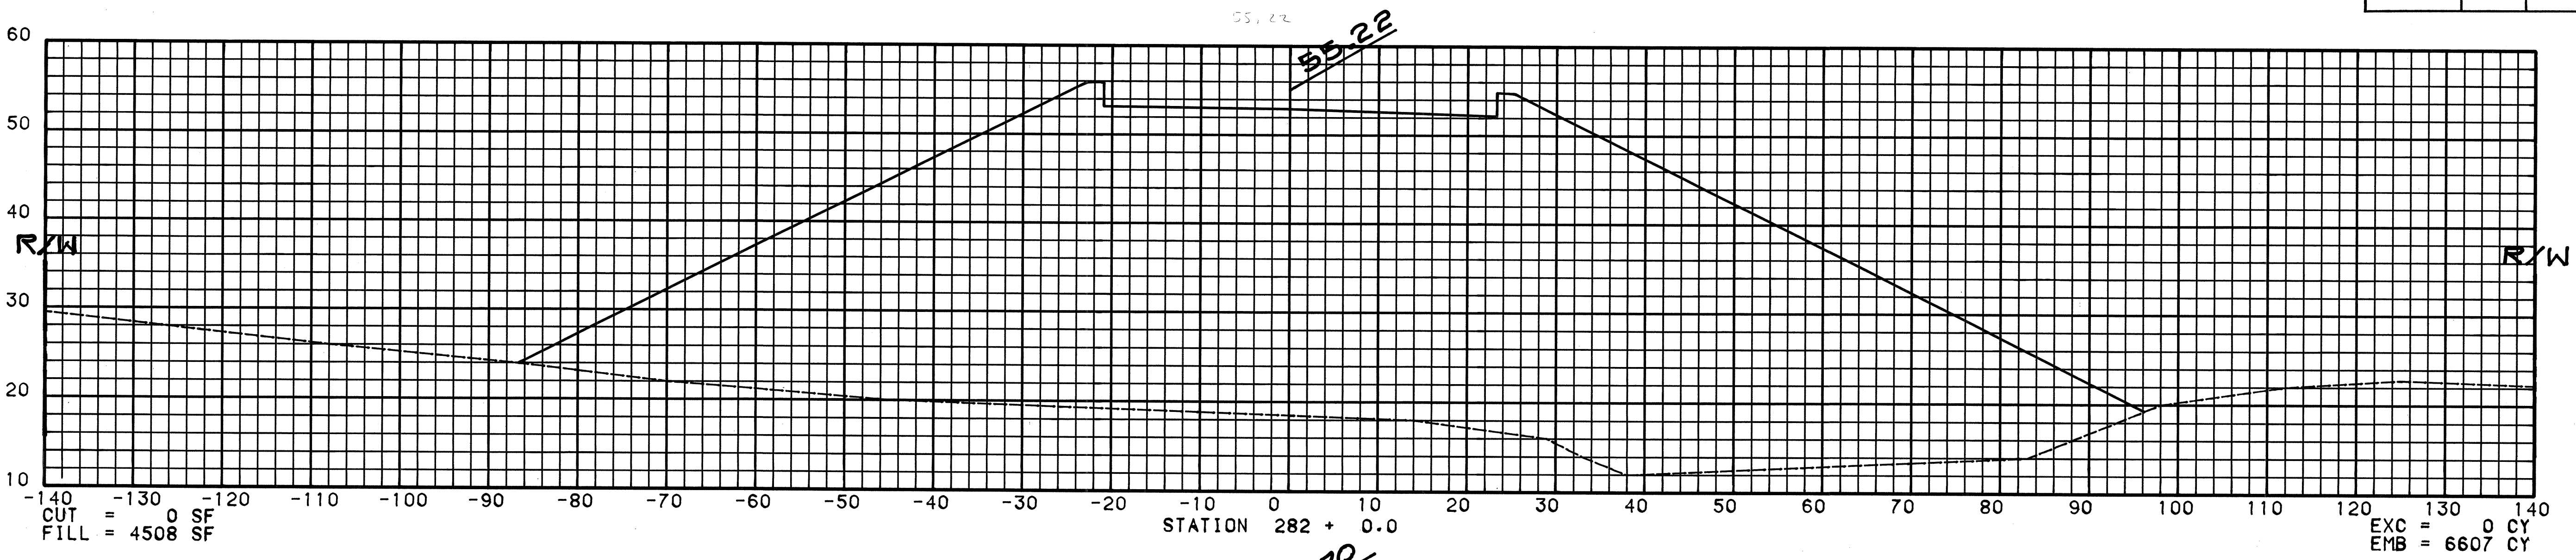

SCALE : HORIZONTAL 1 INCH = 10 FEET
VERTICAL 1 INCH = 10 FEET

ORIGINAL PLAN
DRAWN BY
CHECKED BY
DATE
DESIGNED BY
NOTED BY
No.

FED. ROAD DIST. NO.	STATE	FED. AID PROJ. NO.	FISCAL YEAR	SHEET NO.	TOTAL SHEETS
HAWAII	HAW.	F-030-(118)	1984	153	169

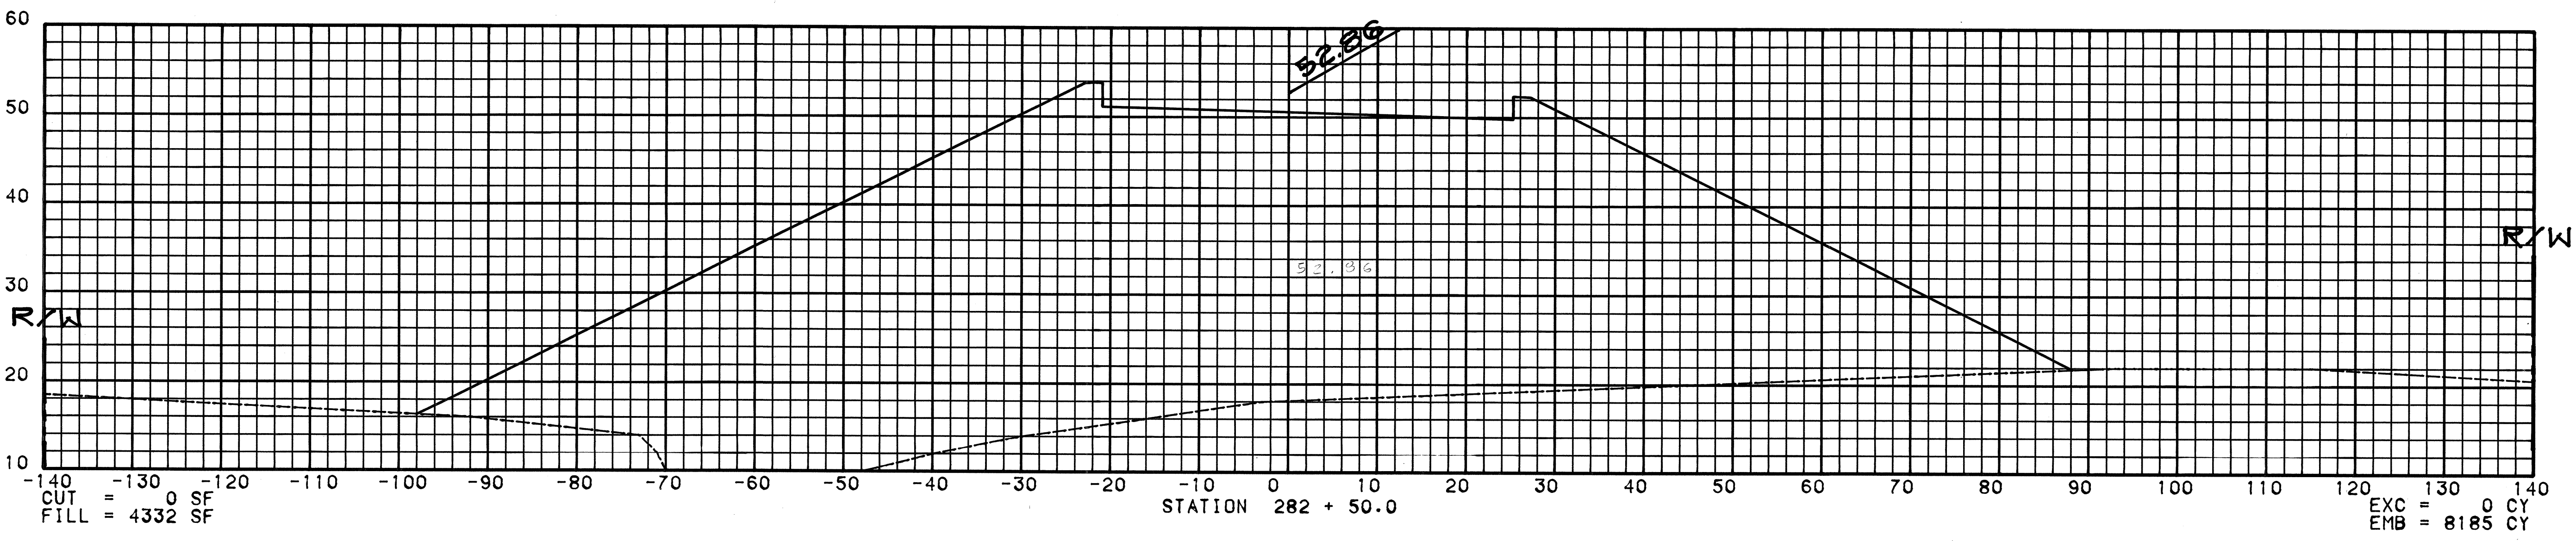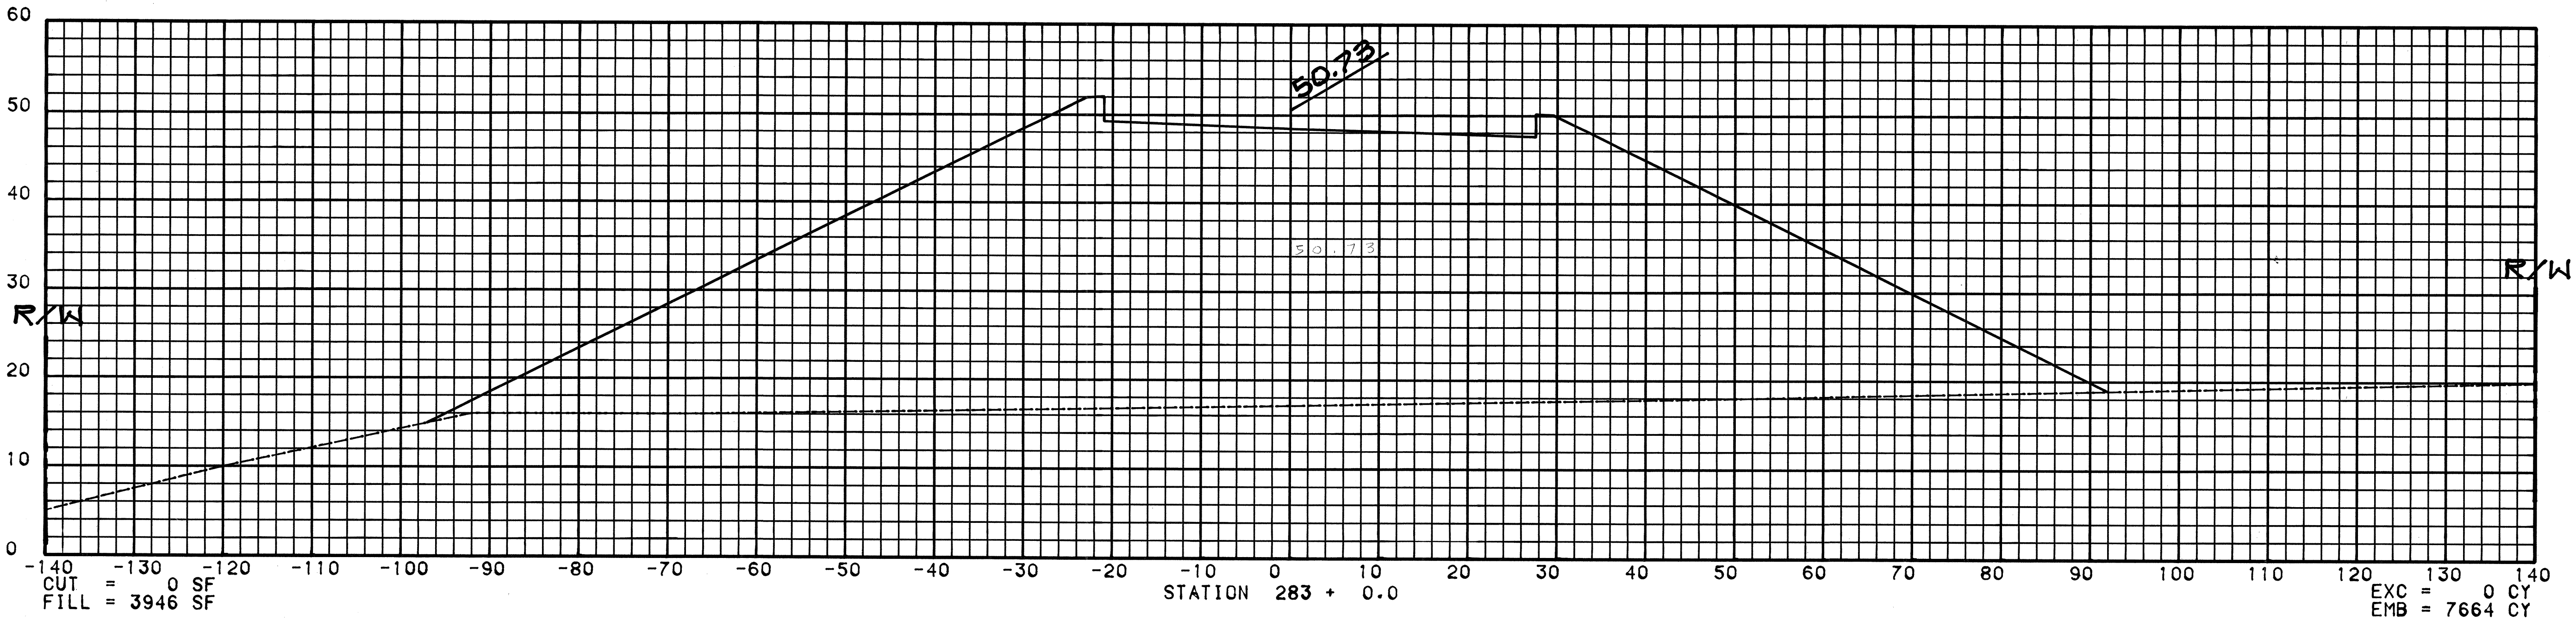




SCALE : HORIZONTAL 1 INCH = 10 FEET
VERTICAL 1 INCH = 10 FEET

ORIGINAL
PLAN
NOTE BOOK
No.

SURVEY PLOTTED BY
DATE

DRAWN BY
TRACED BY
DESIGNED BY
QUANTITIES BY
CHECKED BY




FED. ROAD DIST. NO.	STATE	FED. AID PROJ. NO.	FISCAL YEAR	SHEET NO.	TOTAL SHEETS
HAWAII	HAW.	F-030-1(18)	1984	154	169

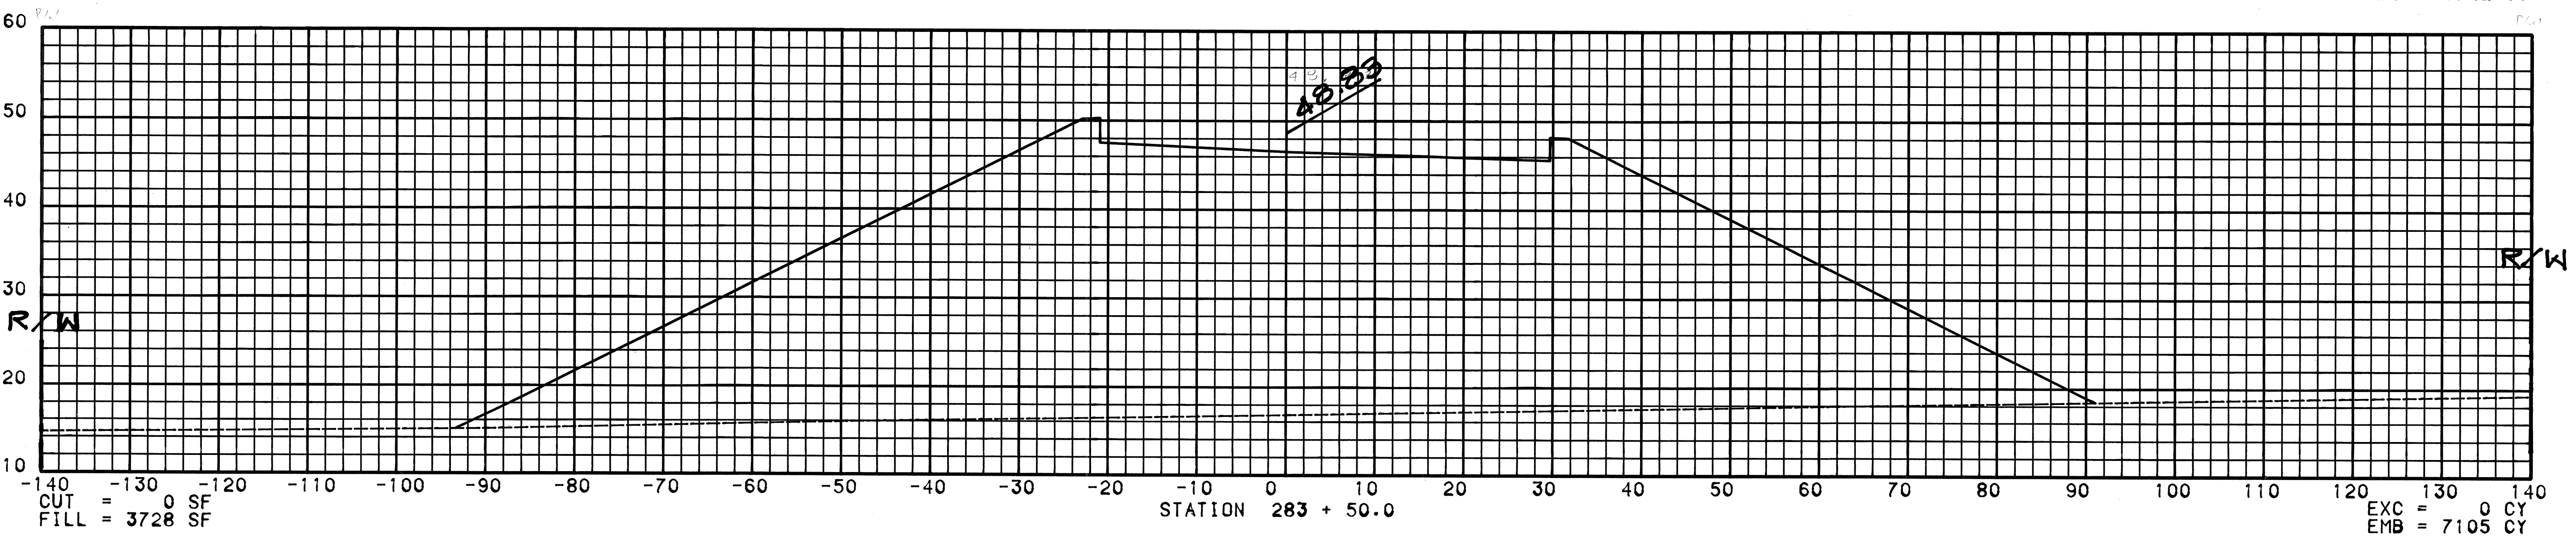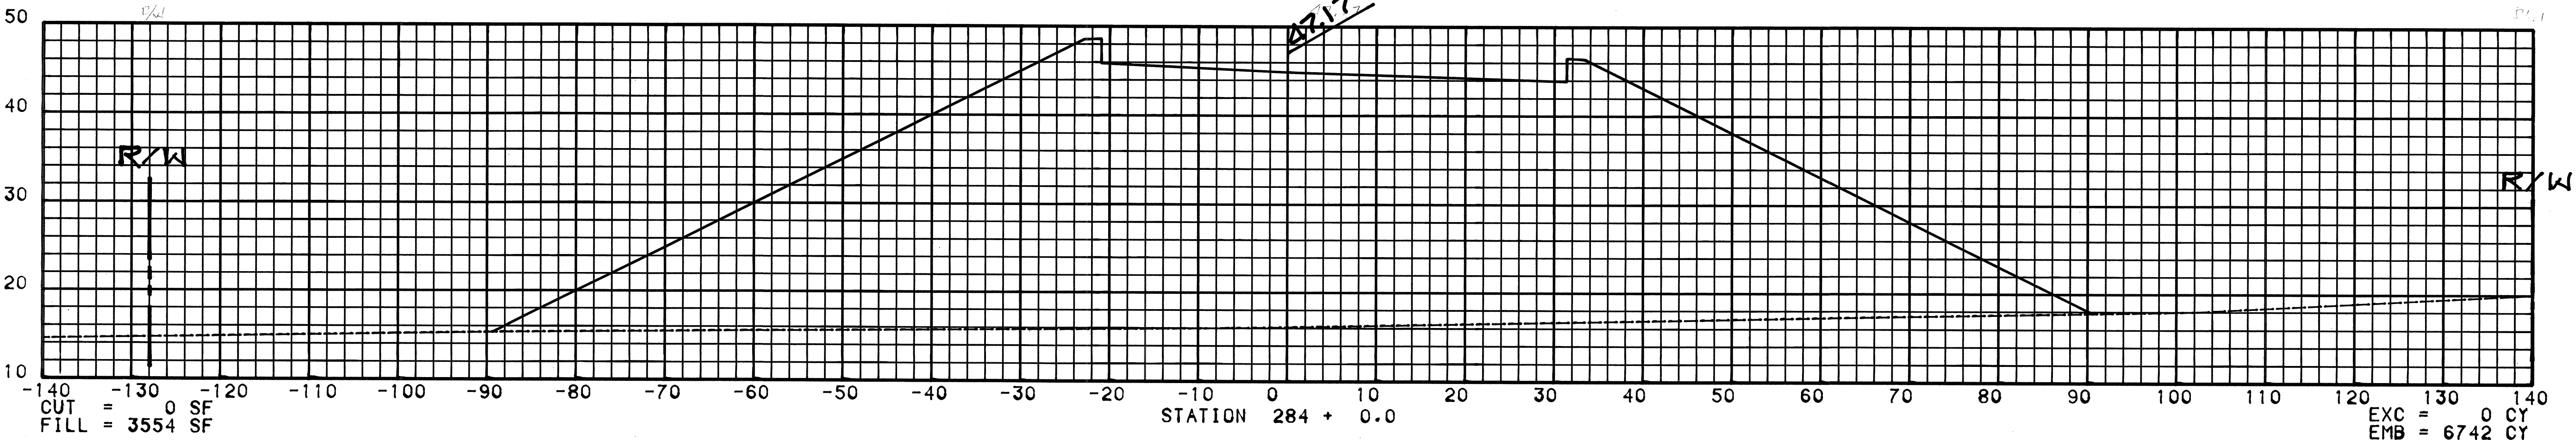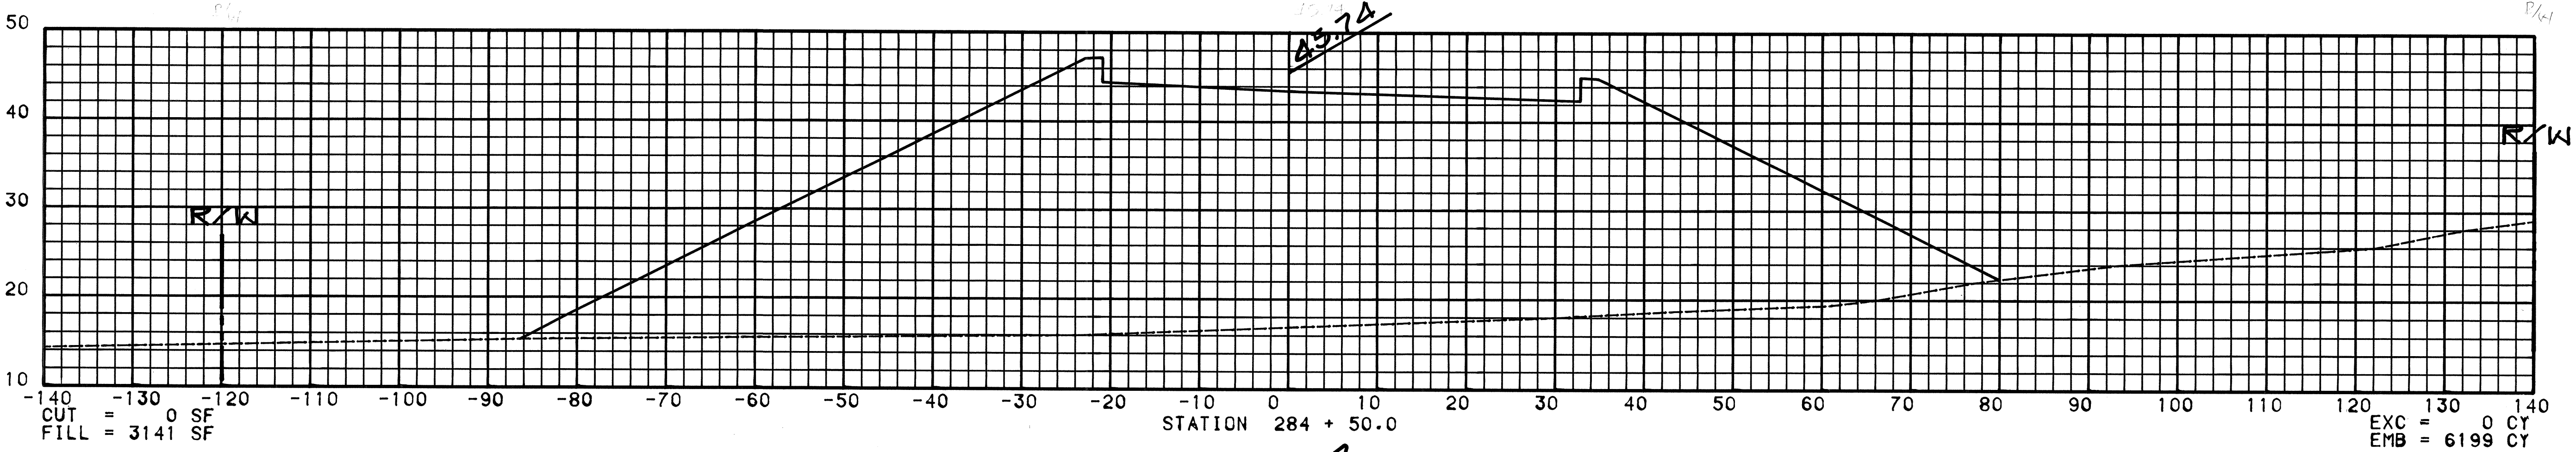

SCALE : HORIZONTAL 1 INCH = 10 FEET
VERTICAL 1 INCH = 10 FEET




ORIGINAL PLAN
SURVEY PLOTTED BY
DRAWN BY
TRACED BY
DESIGNED BY
NOTE BOOK
QUANTITIES BY
CHECKED BY
No.

FED. ROAD DIST. NO.	STATE	FED. AID PROJ. NO.	FISCAL YEAR	SHEET NO.	TOTAL SHEETS
HAWAII	HAW.	F-030-(18)	1984	155	169

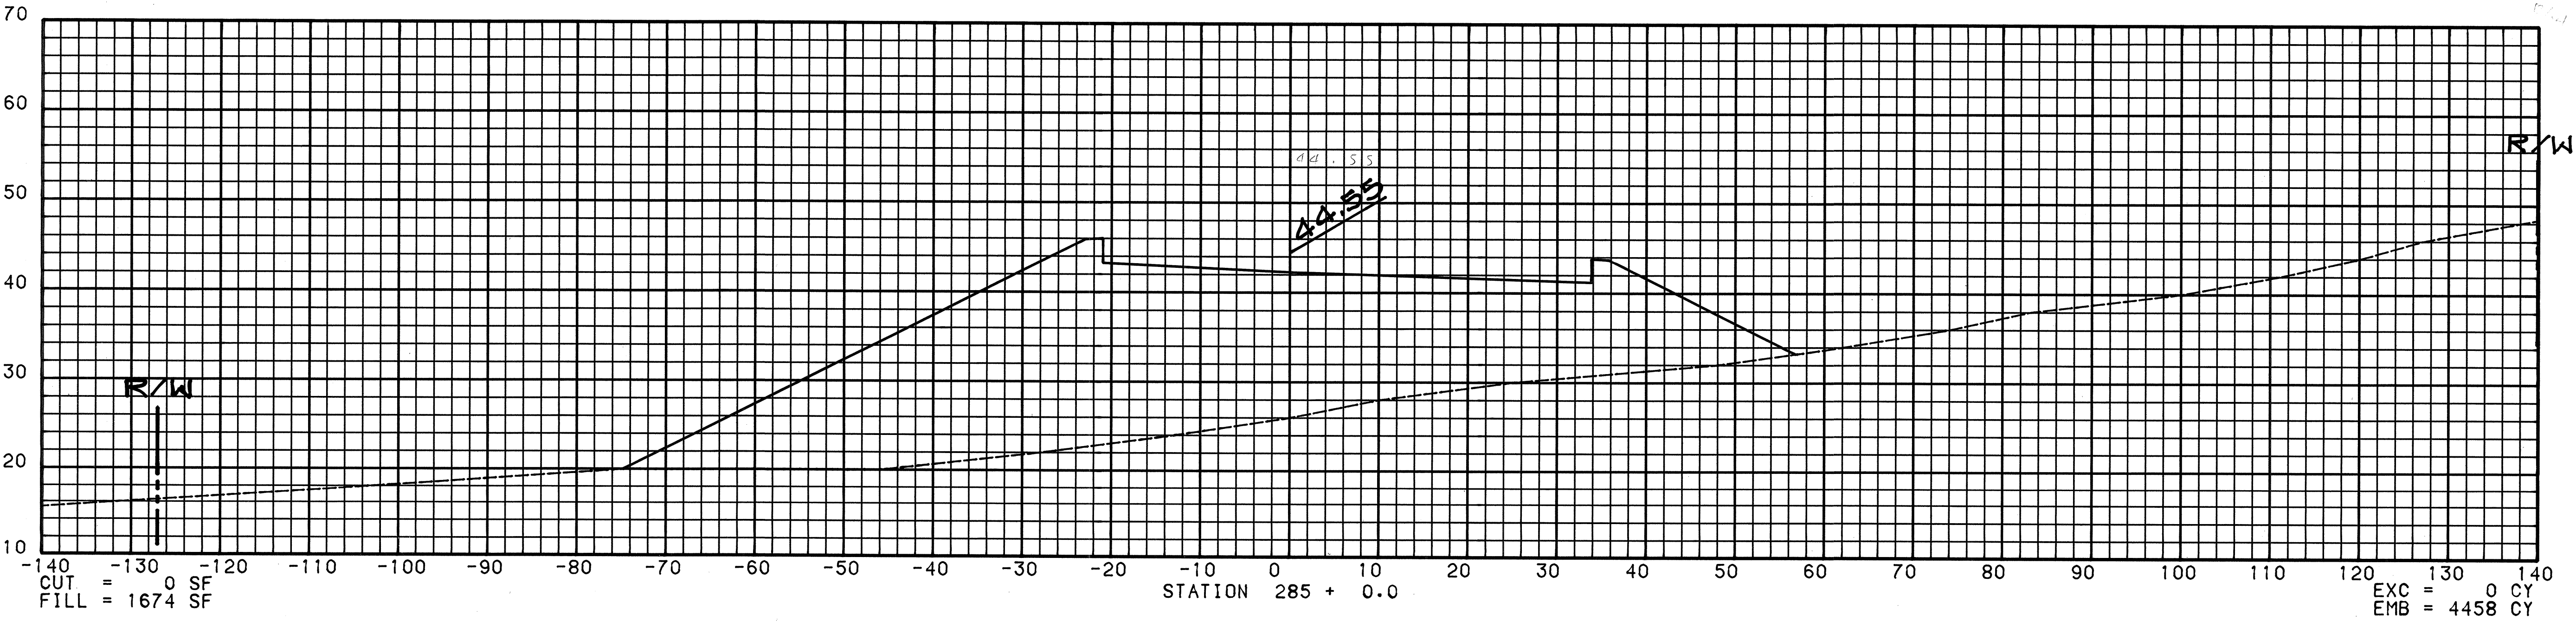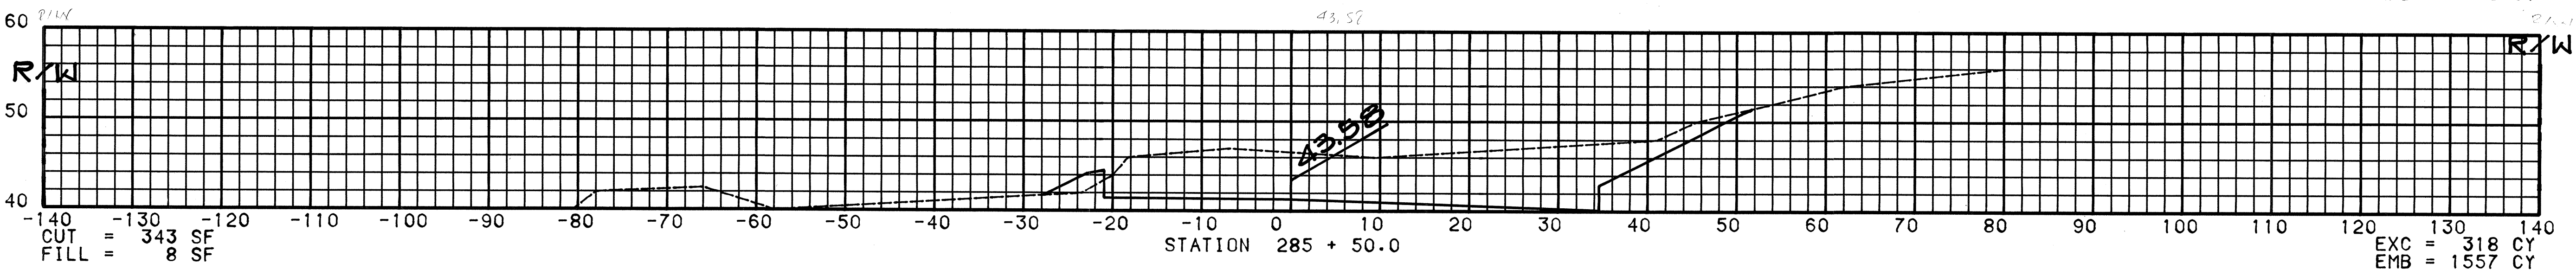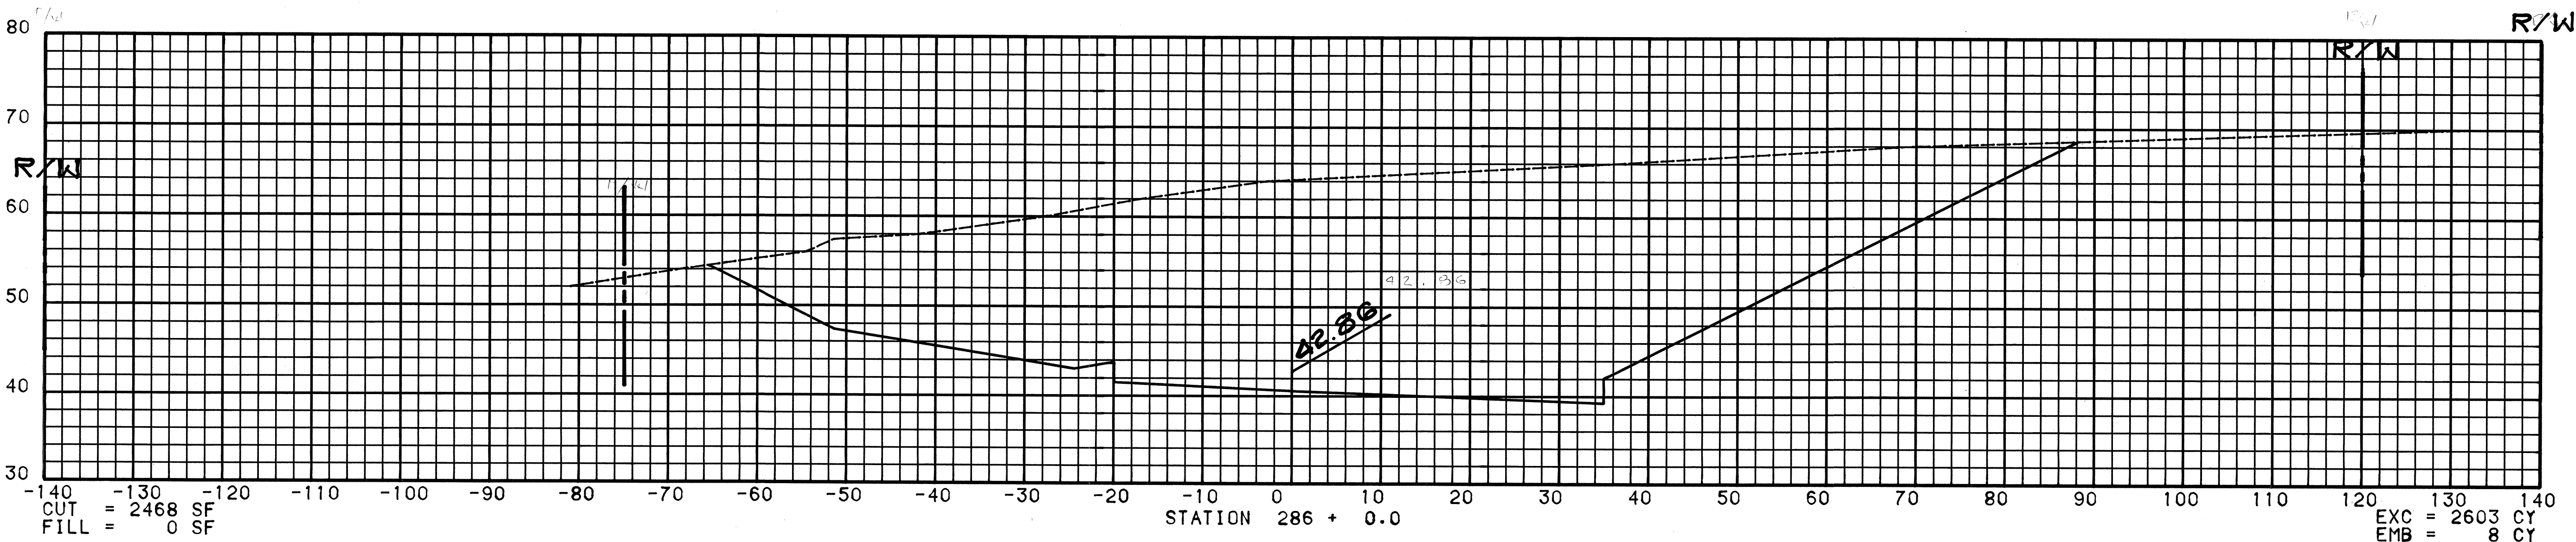




SCALE : HORIZONTAL 1 INCH = 10 FEET
 VERTICAL 1 INCH = 10 FEET

FED. ROAD DIST. NO.	STATE	FED. AID PROJ. NO.	FISCAL YEAR	SHEET NO.	TOTAL SHEETS
HAWAII	HAW.	F-030-1(18)	1984	156	169

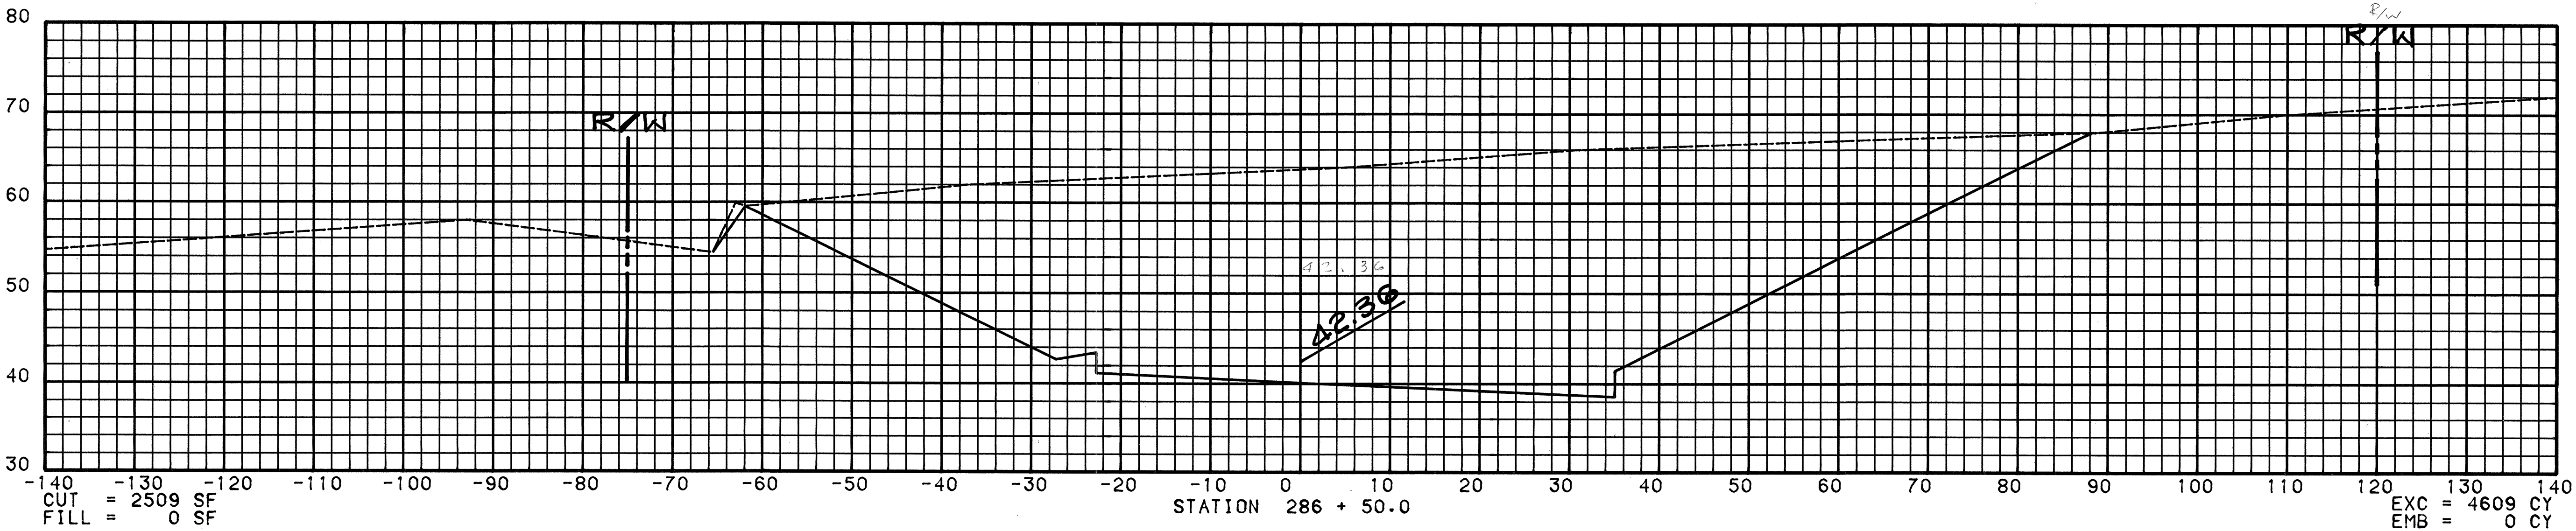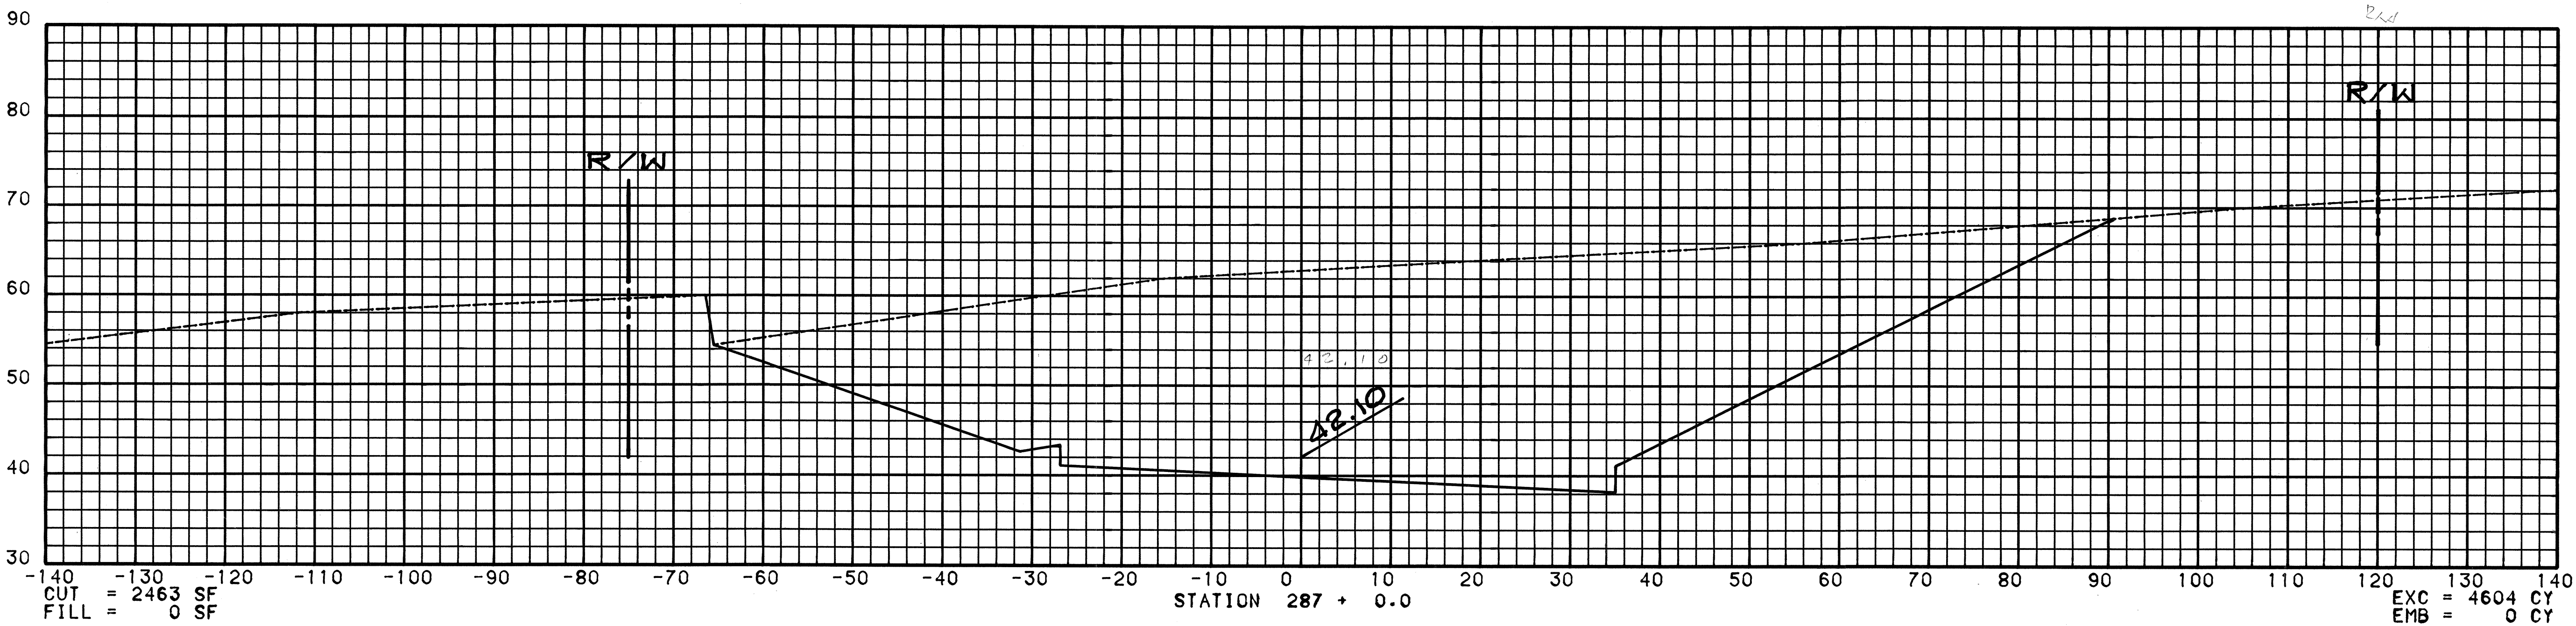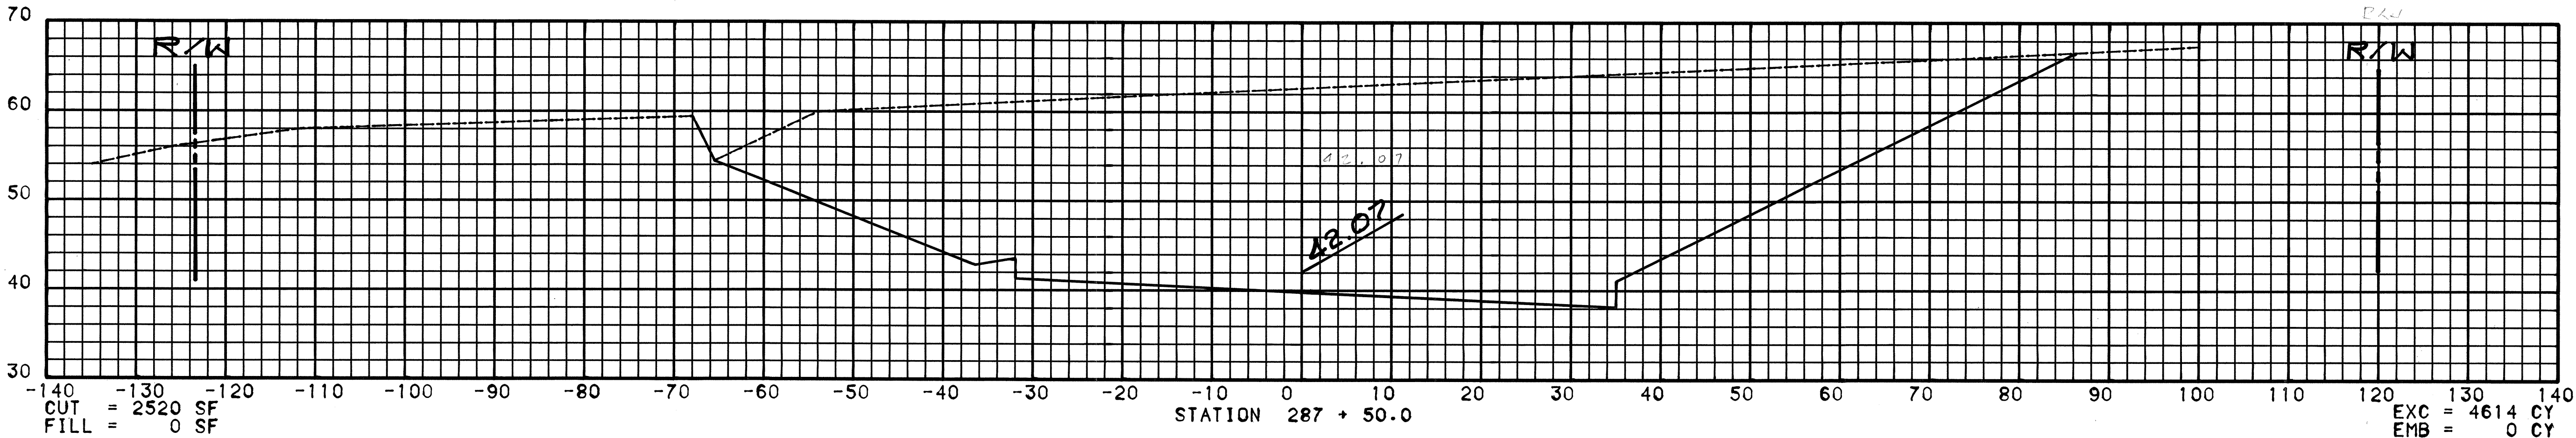




SCALE : HORIZONTAL 1 INCH = 10 FEET
 VERTICAL 1 INCH = 10 FEET

FED. ROAD DIST. NO.	STATE	FED. AID PROJ. NO.	FISCAL YEAR	SHEET NO.	TOTAL SHEETS
HAWAII	HAW.	F-030-1(18)	1984	157	169

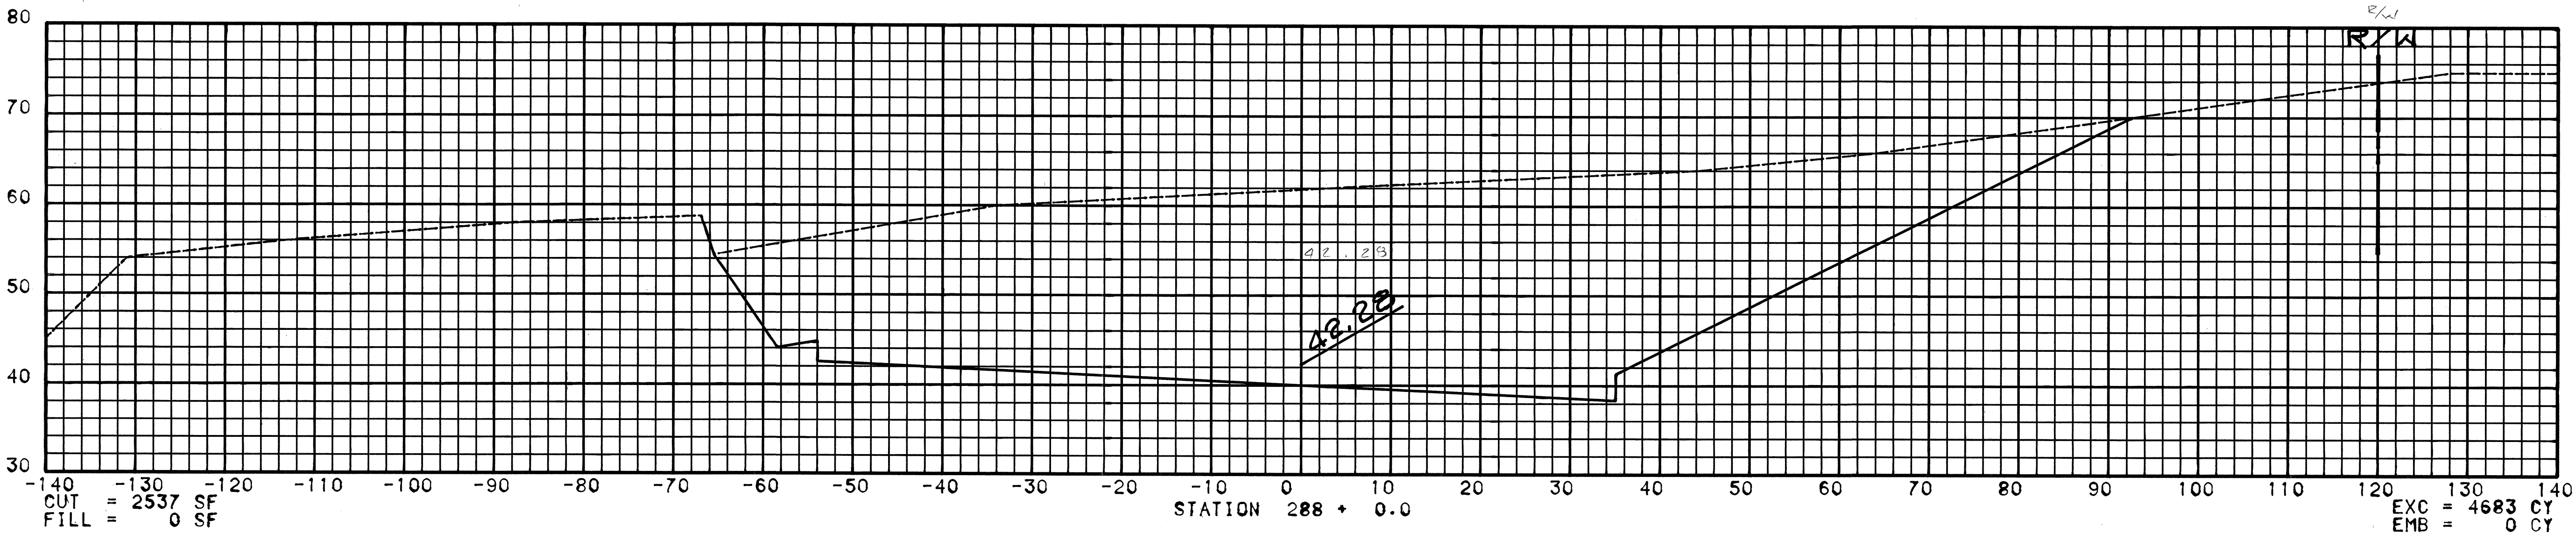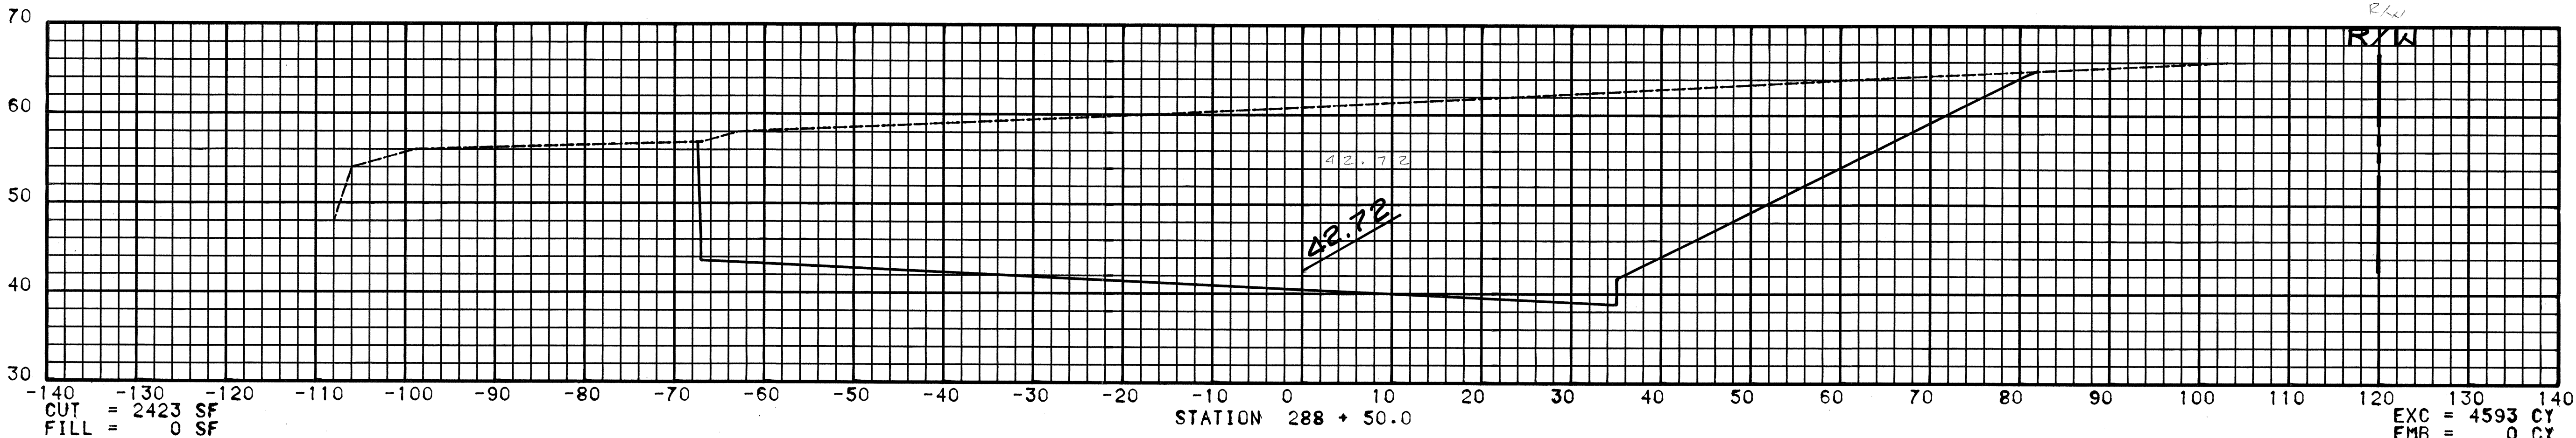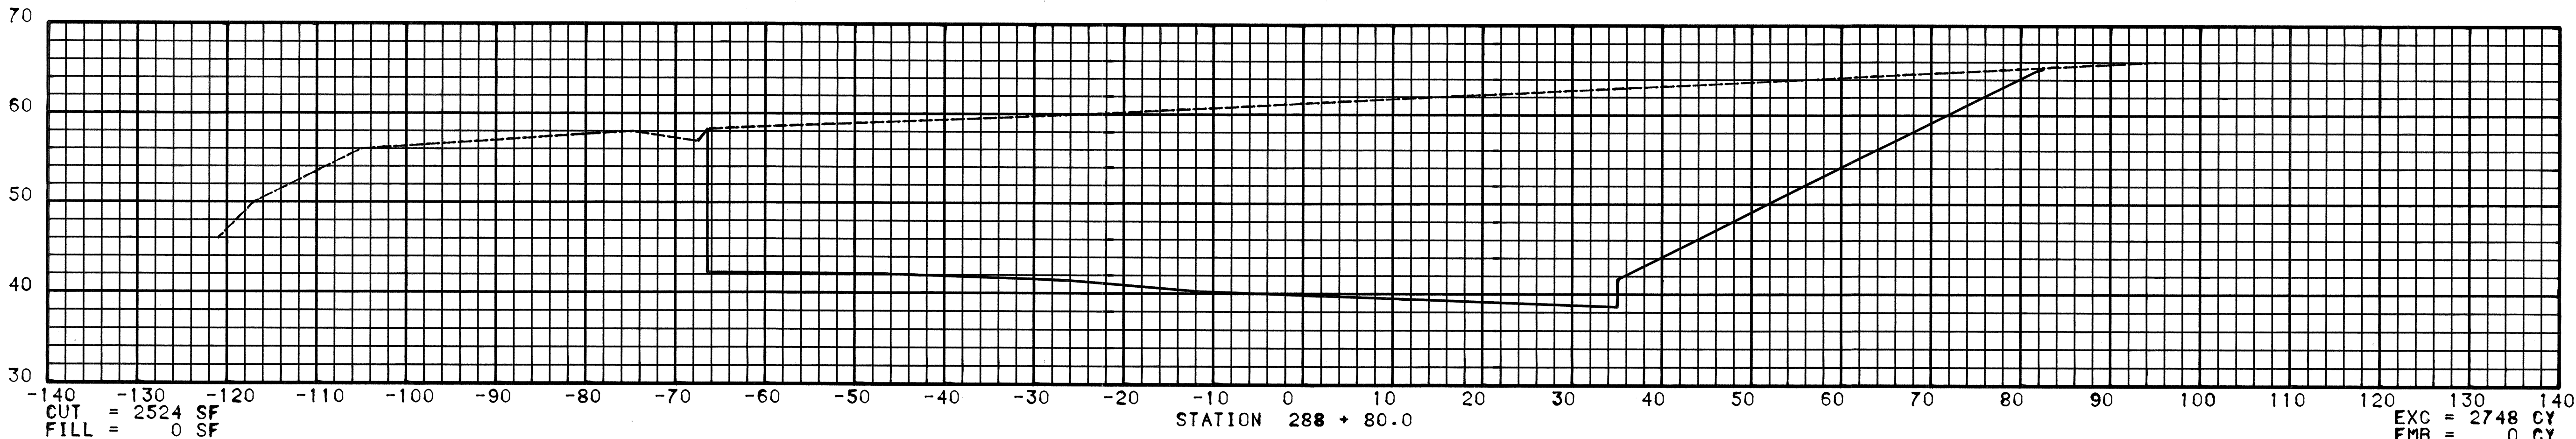



SCALE : HORIZONTAL 1 INCH = 10 FEET
VERTICAL 1 INCH = 10 FEET

FED. ROAD DIST. NO.	STATE	FED. AID PROJ. NO.	FISCAL YEAR	SHEET NO.	TOTAL SHEETS
HAWAII	HAW.	F-030-1(18)	1984	158	169

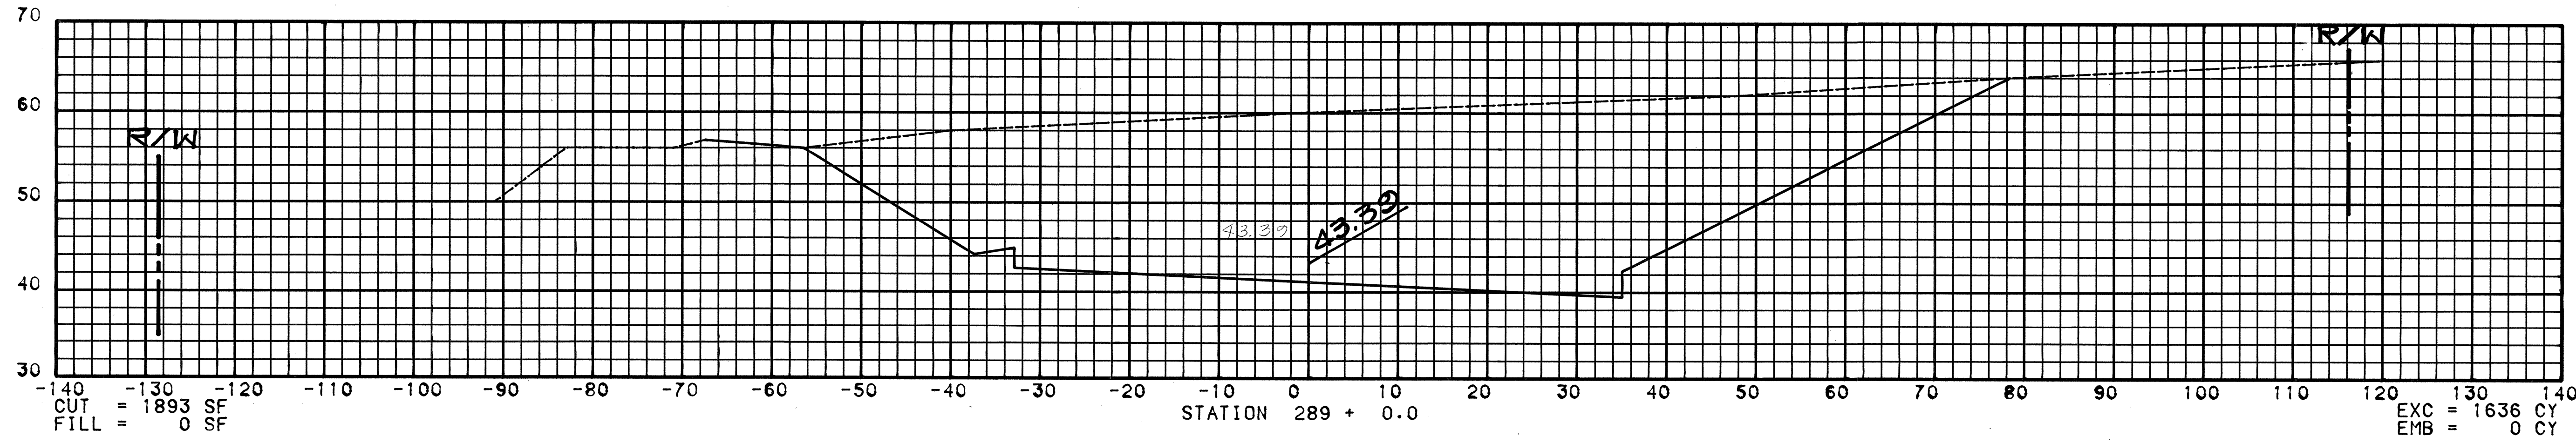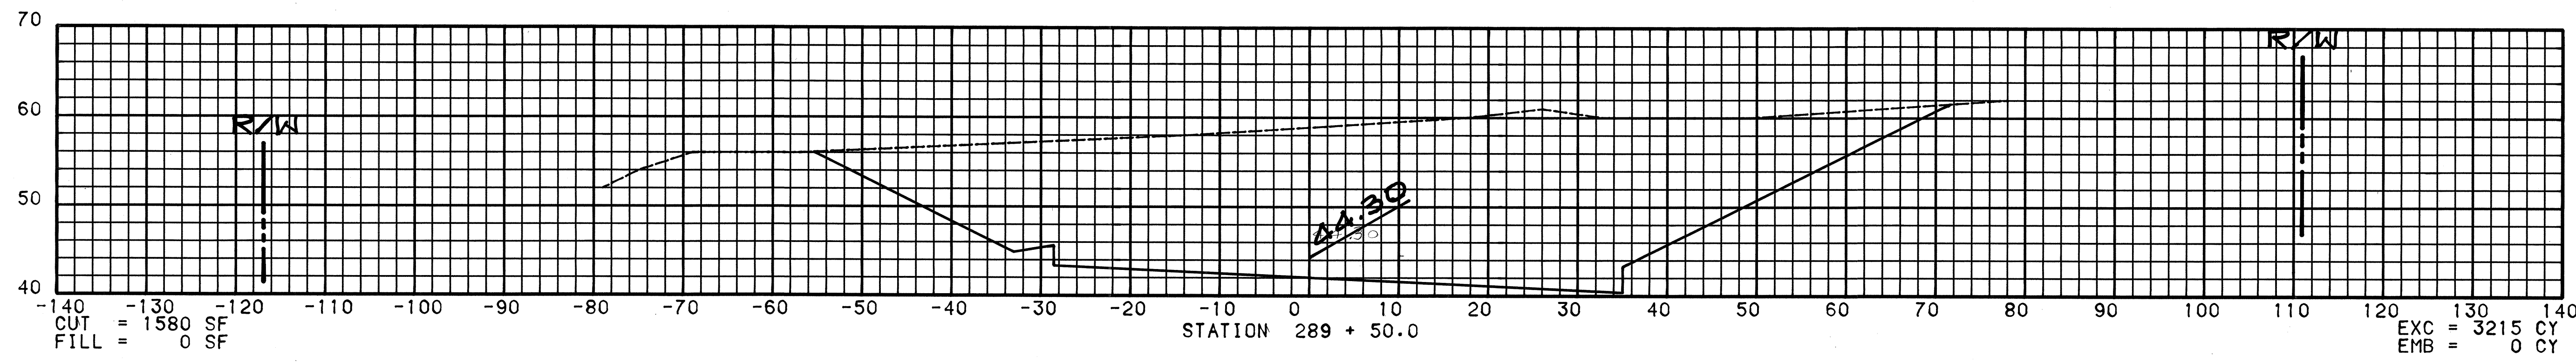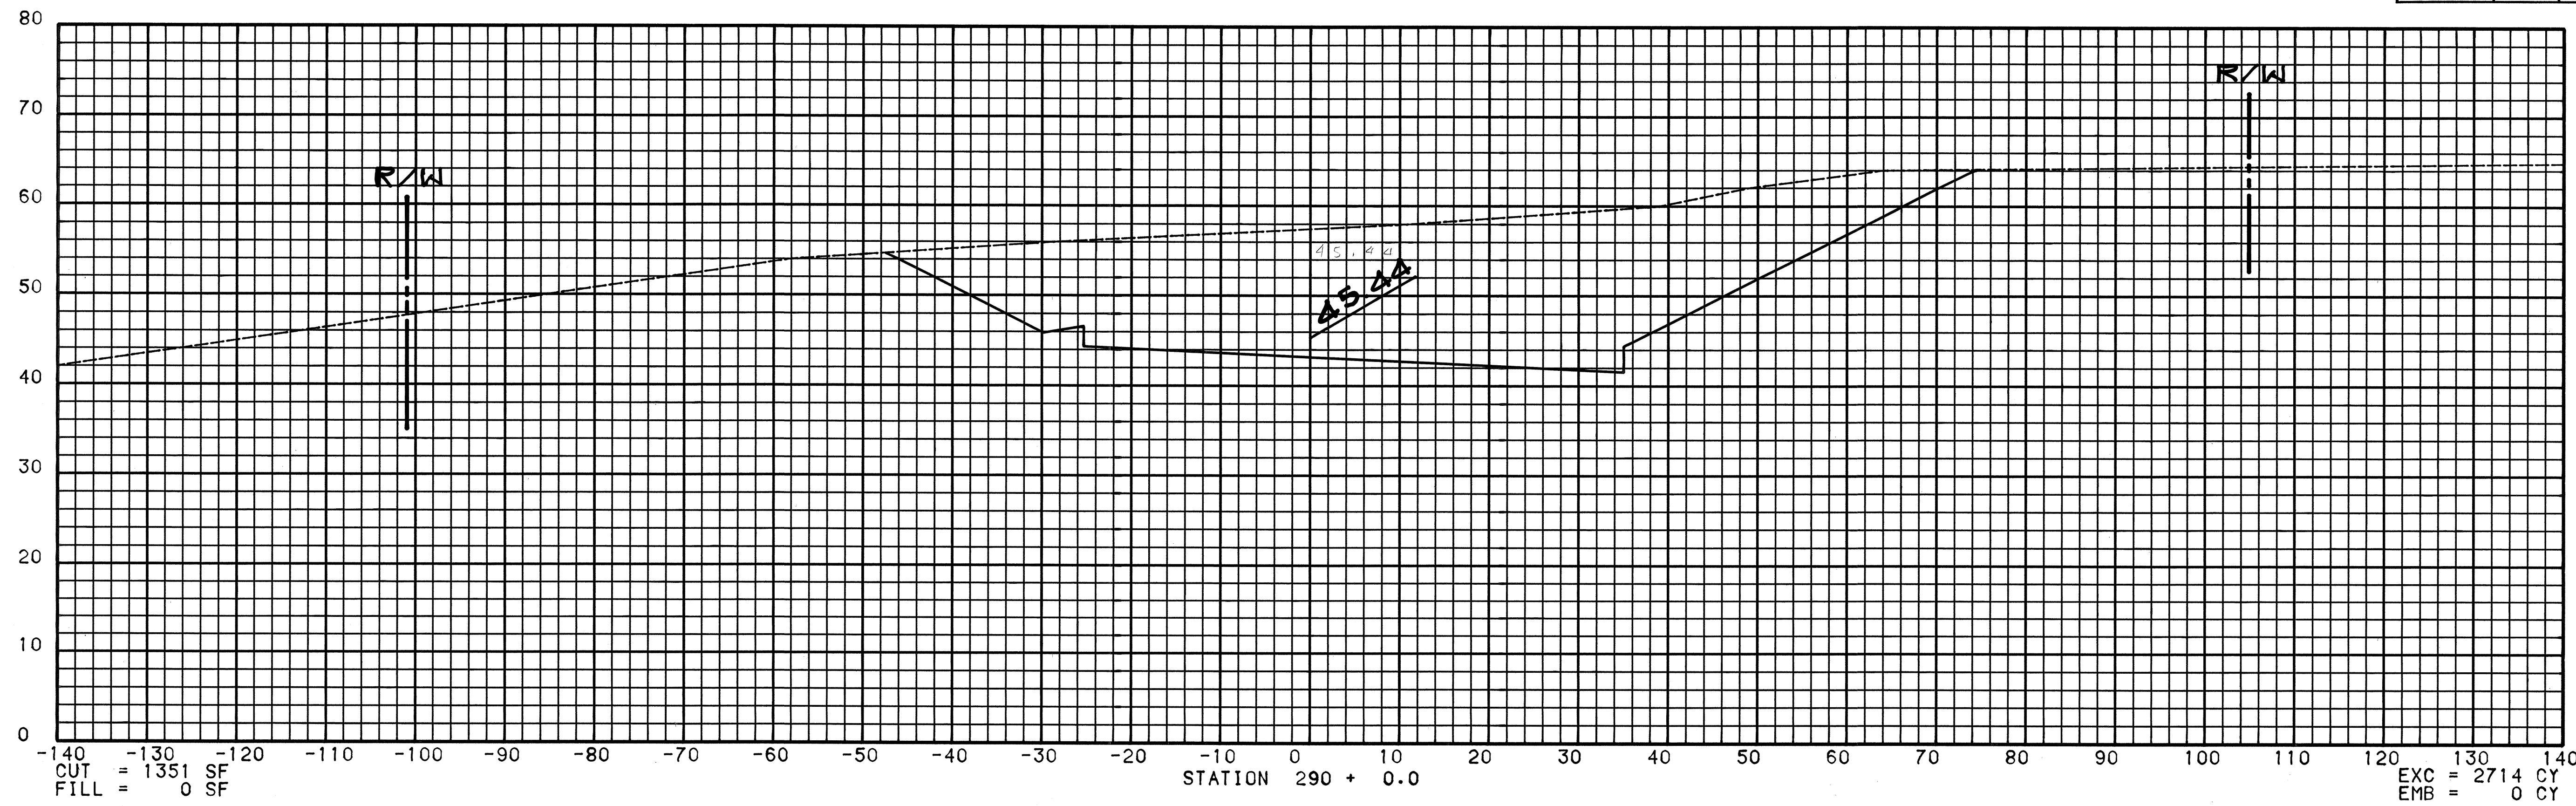

SCALE : HORIZONTAL 1 INCH = 10 FEET
 VERTICAL 1 INCH = 10 FEET




FED. ROAD DIST. NO.	STATE	FED. AID PROJ. NO.	FISCAL YEAR	SHEET NO.	TOTAL SHEETS
HAWAII	HAW.	F-030-1(18)	1984	159	169

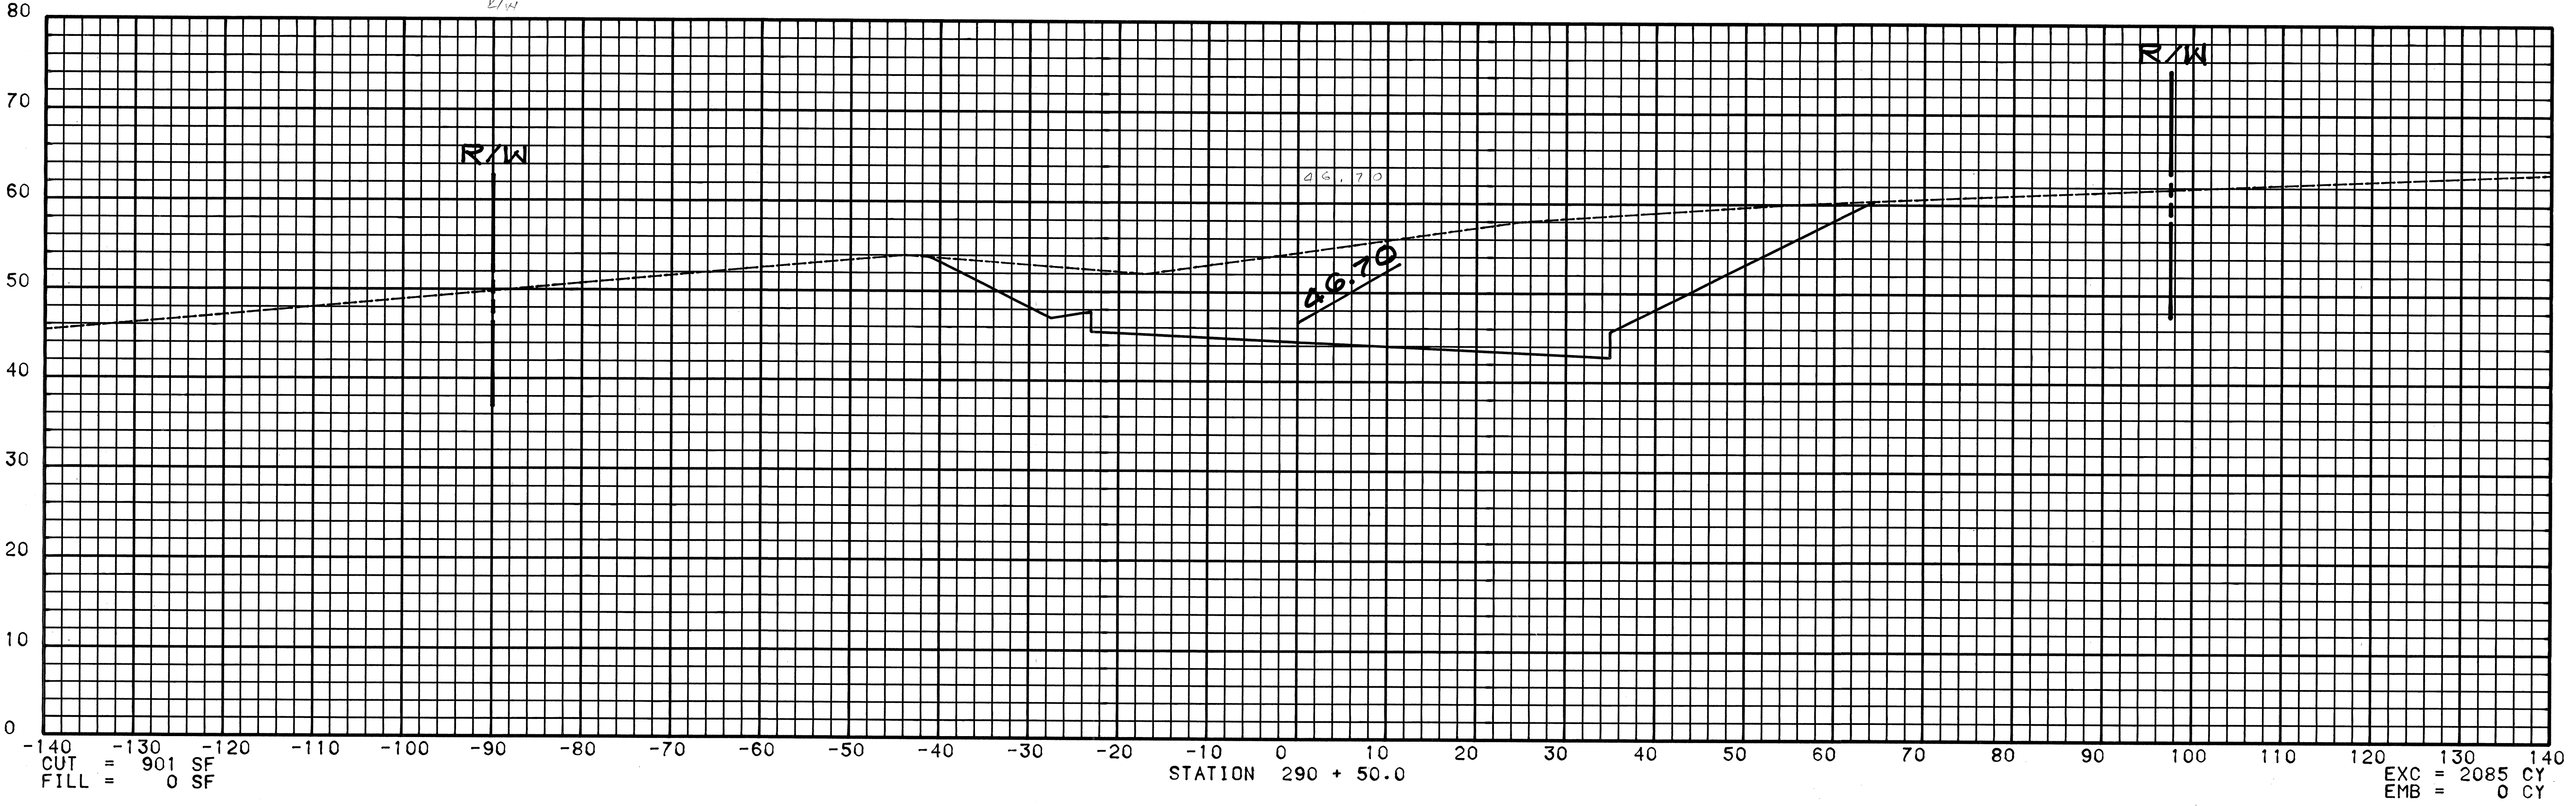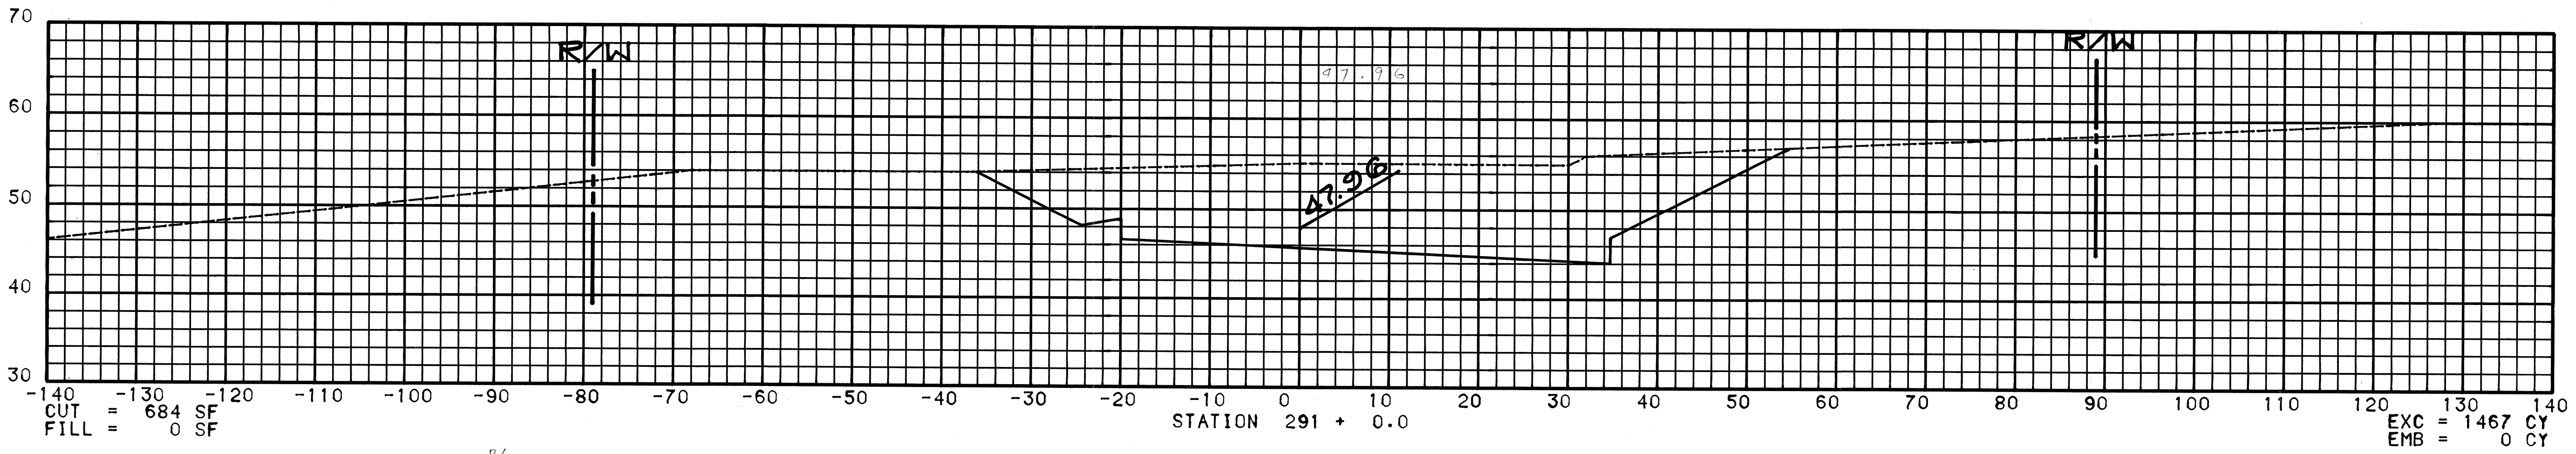

SCALE : HORIZONTAL 1 INCH = 10 FEET
VERTICAL 1 INCH = 10 FEET

ORIGINAL PLAN	SURVEY PLOTTED BY	DATE
NOTE BOOK	DRAWN BY	"
No.	DESIGNED BY	"
	CHECKED BY	"



FED. ROAD DIST. NO.	STATE	FED. AID PROJ. NO.	FISCAL YEAR	SHEET NO.	TOTAL SHEETS
HAWAII	HAW.	F-030-1(18)	1984	160	169

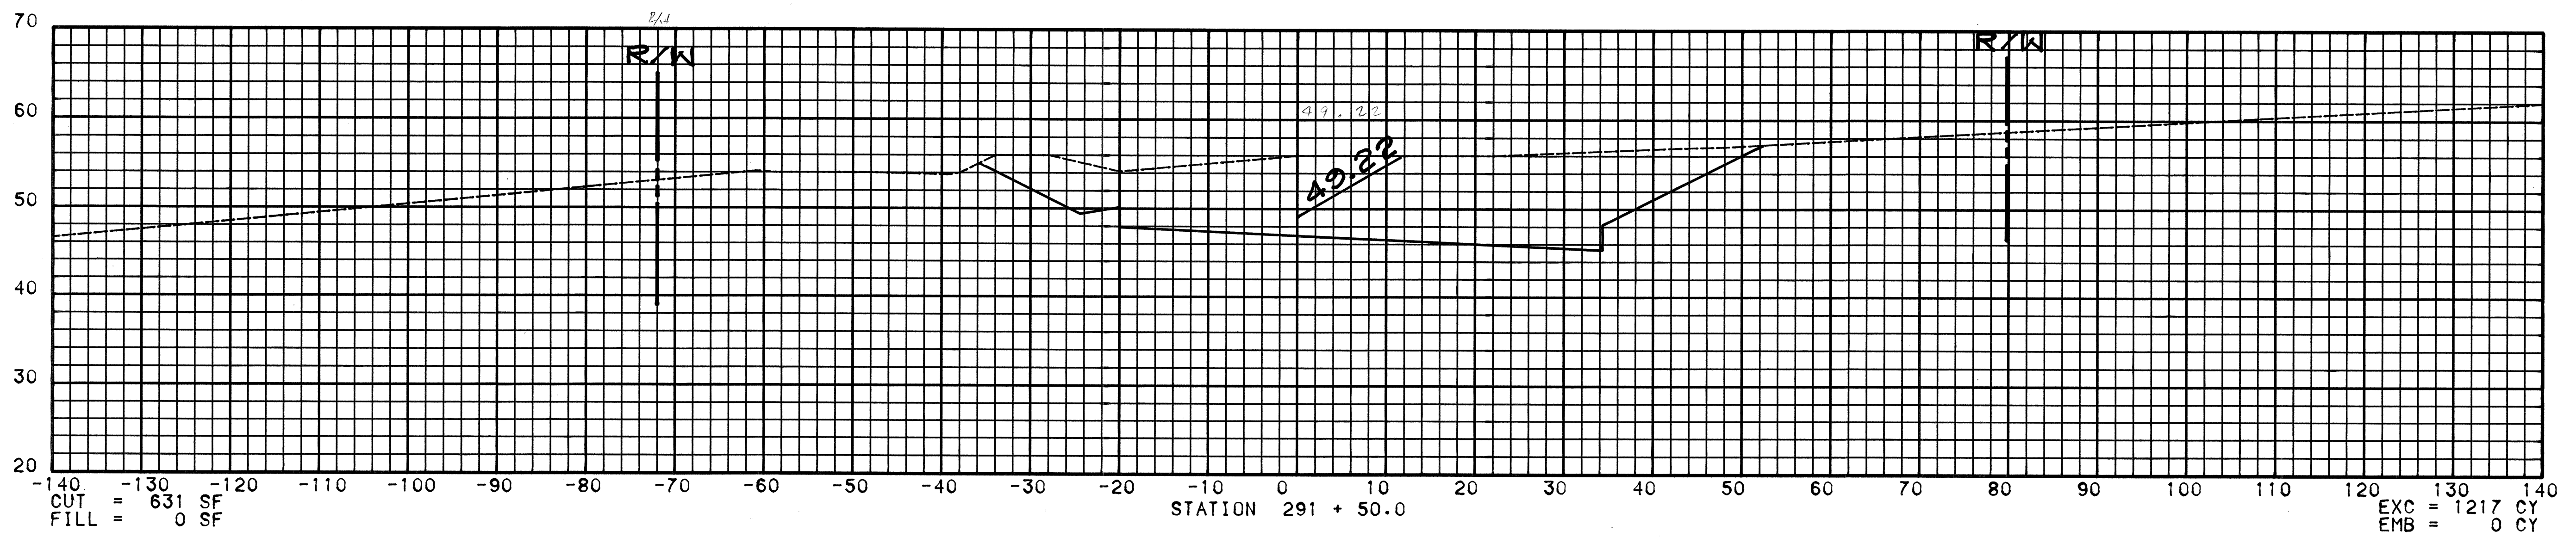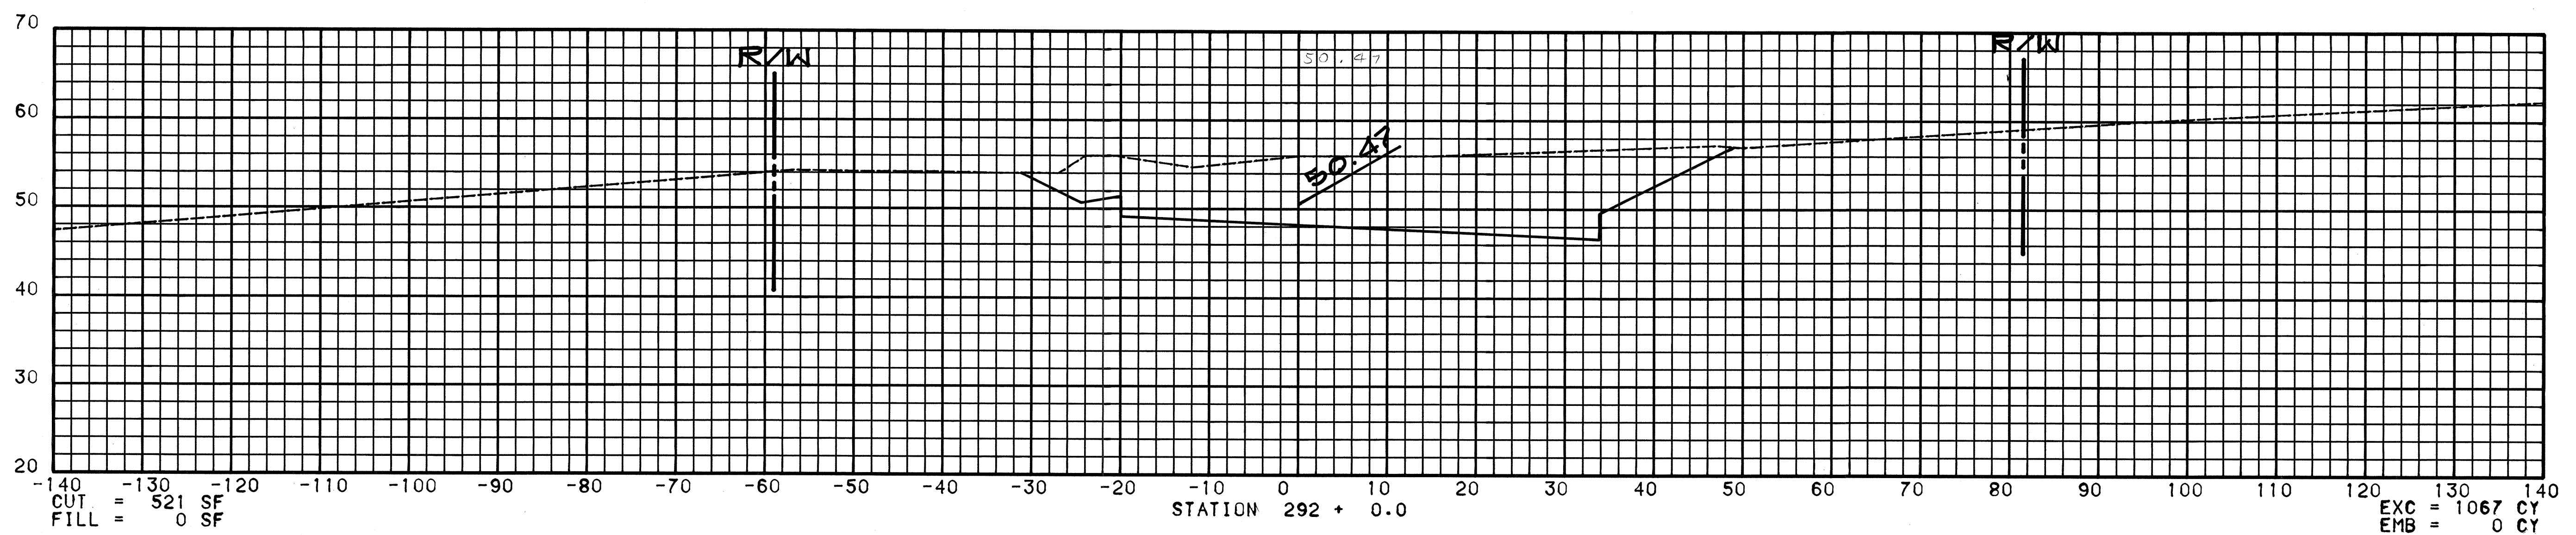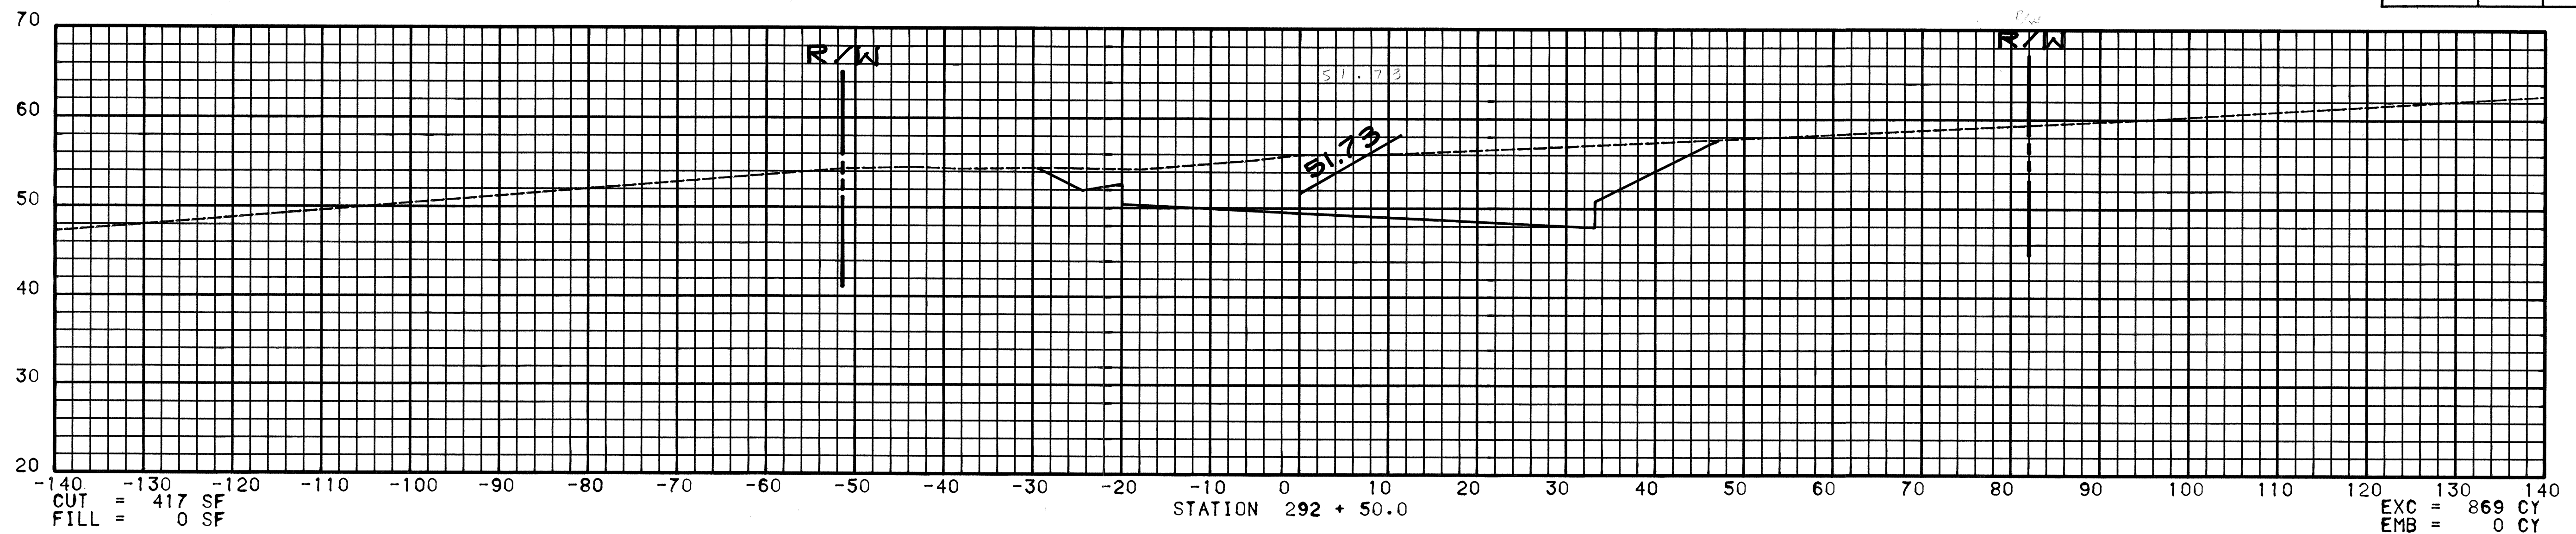

SCALE : HORIZONTAL 1 INCH = 10 FEET
VERTICAL 1 INCH = 10 FEET


ORIGINAL PLAN	SURVEY PLOTTED BY	DATE
NOTE BOOK	DRAWN BY	"
No.	TRACED BY	"
	DESIGNED BY	"
	QUANTITIES BY	"
	CHECKED BY	"

FED. ROAD DIST. NO.	STATE	FED. AID PROJ. NO.	FISCAL YEAR	SHEET NO.	TOTAL SHEETS
HAWAII	HAW.	F-030-1(18)	1984	161	169

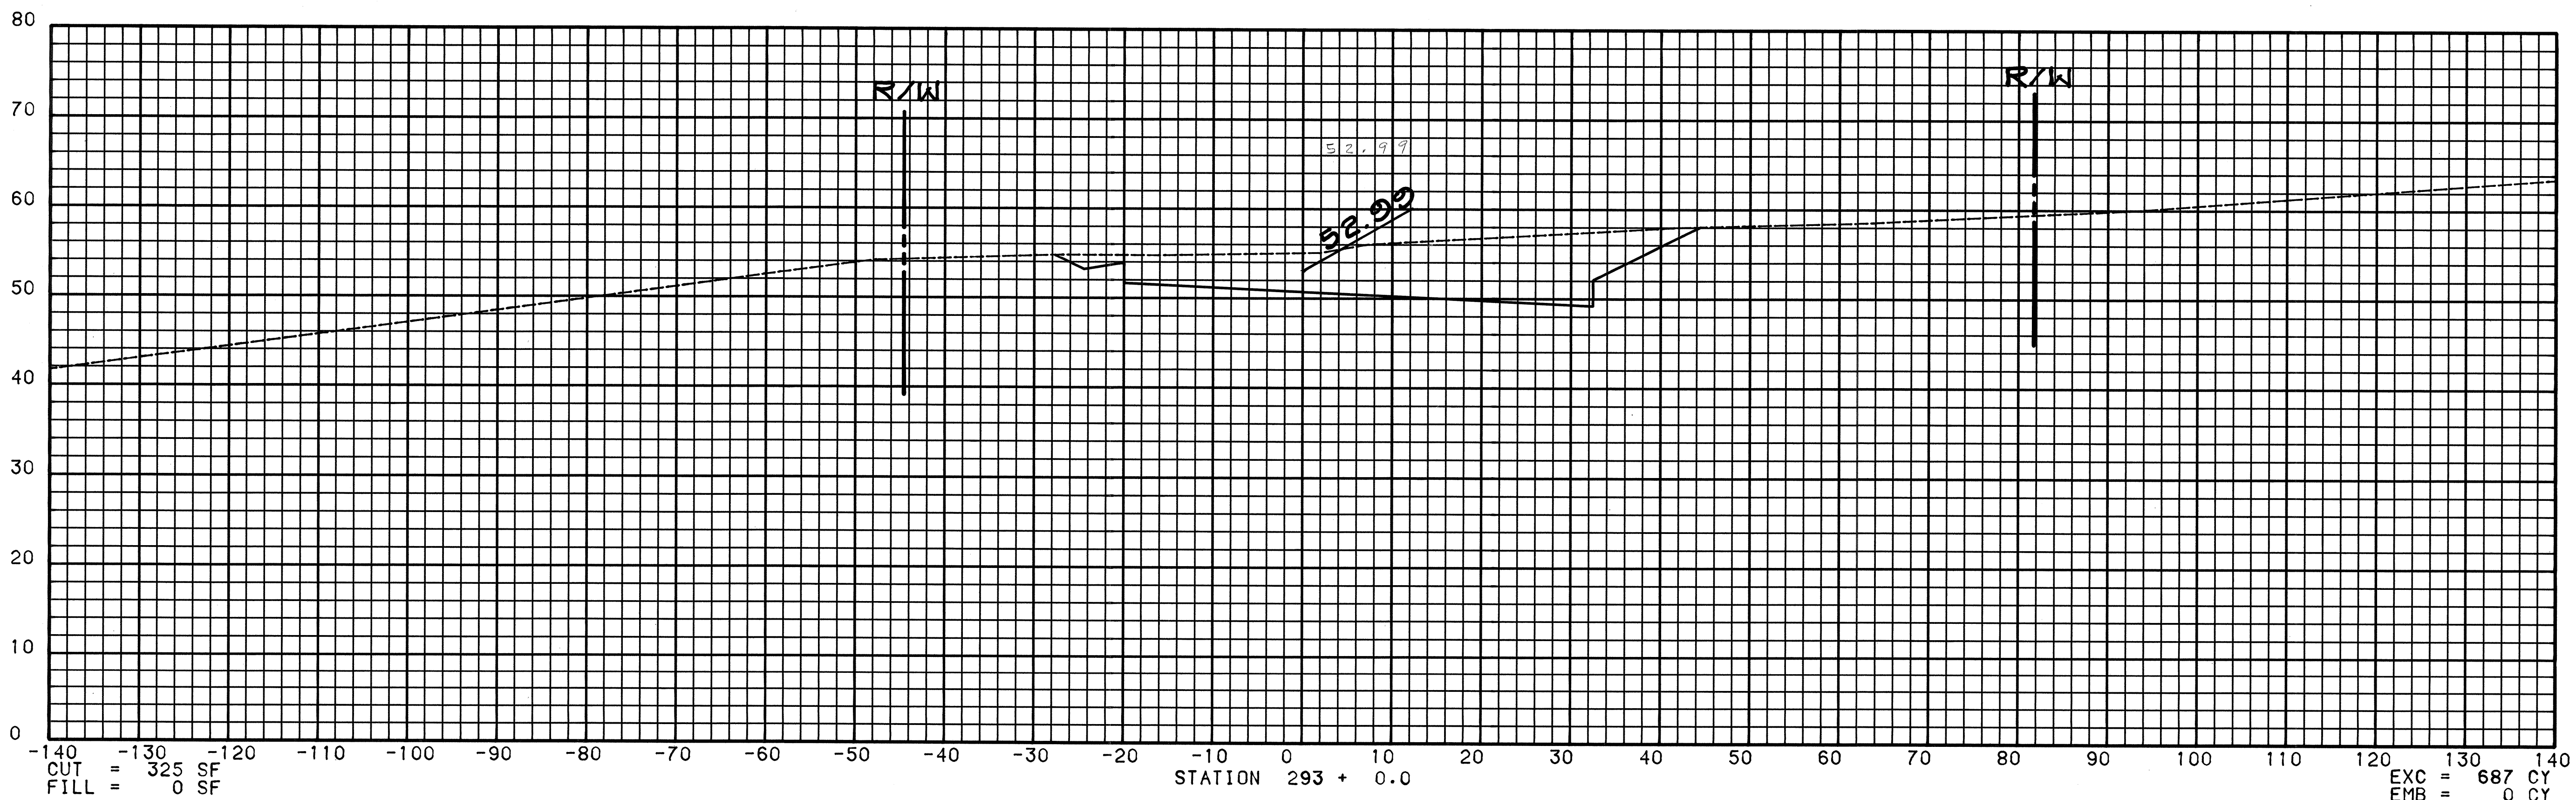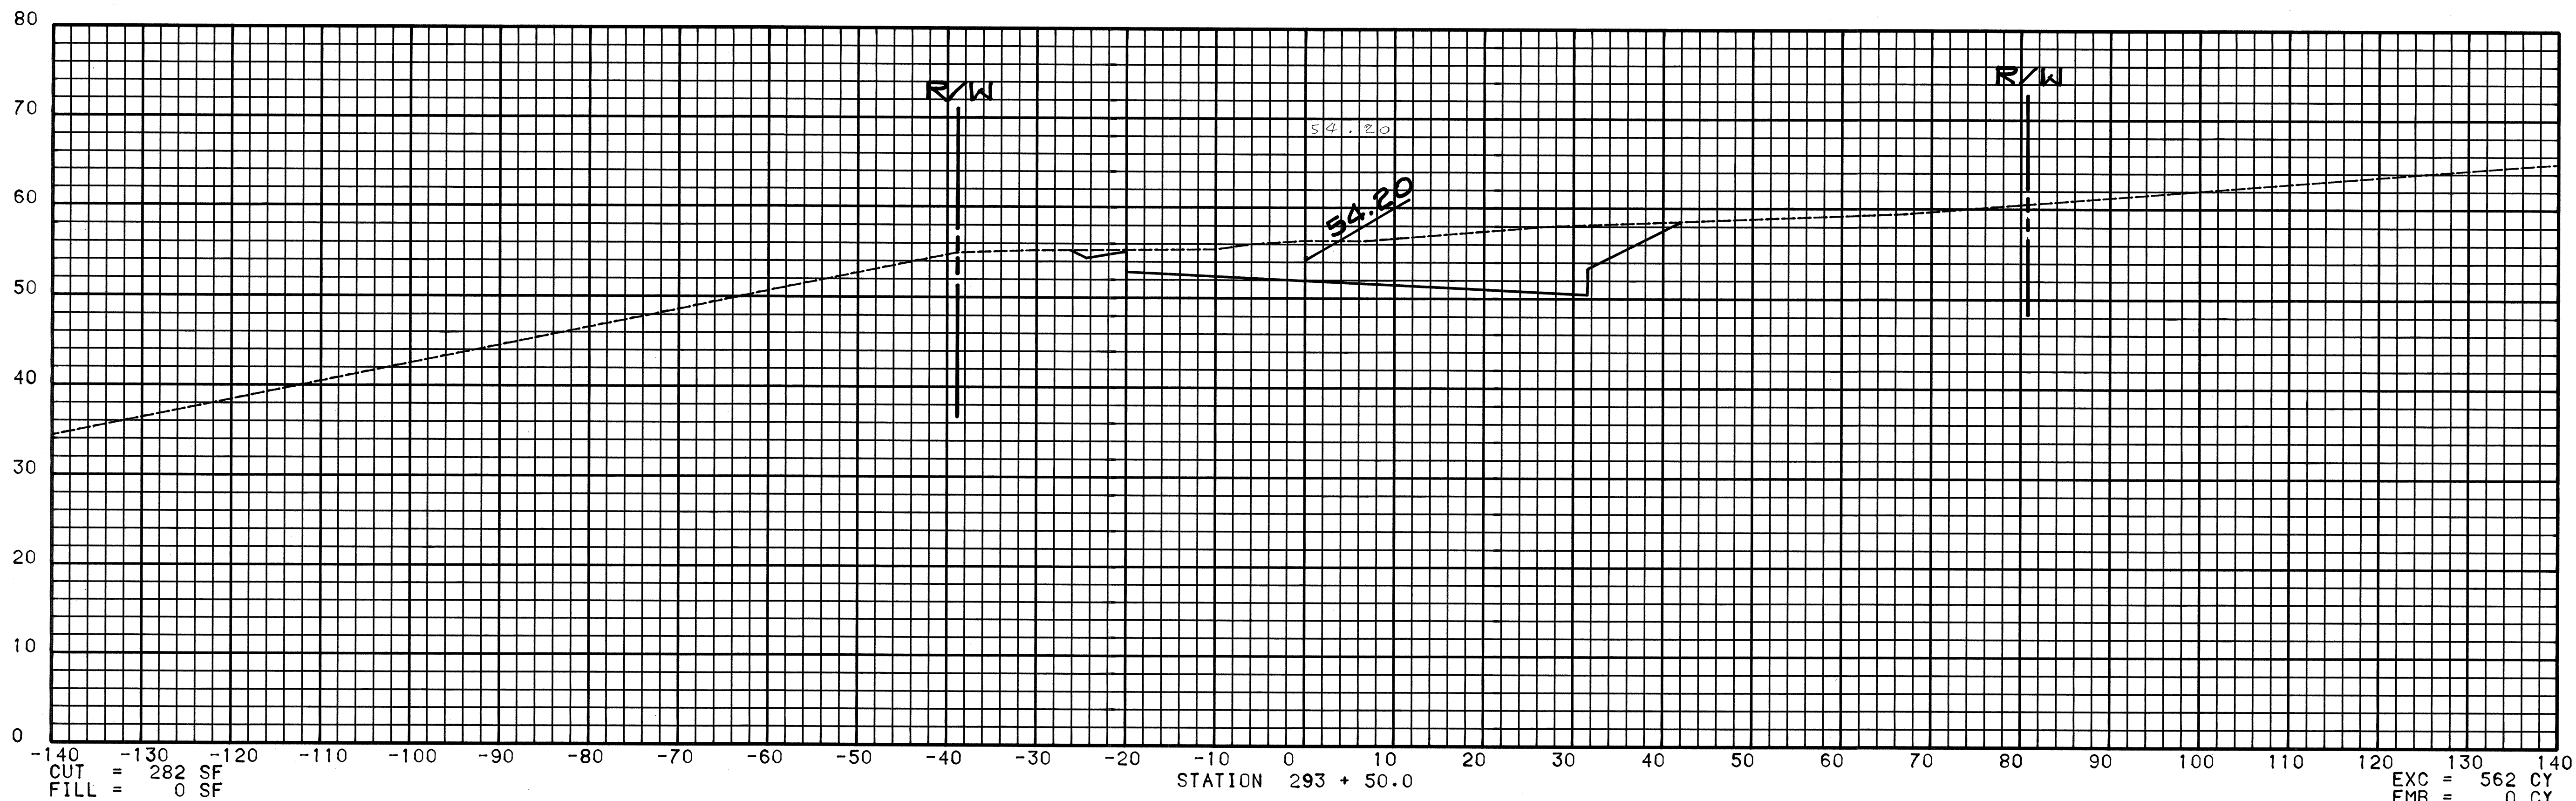

SCALE : HORIZONTAL 1 INCH = 10 FEET
VERTICAL 1 INCH = 10 FEET

FED. ROAD DIST. NO.	STATE	FED. AID PROJ. NO.	FISCAL YEAR	SHEET NO.	TOTAL SHEETS
HAWAII	HAW.	F-030-1(18)	1984	162	169

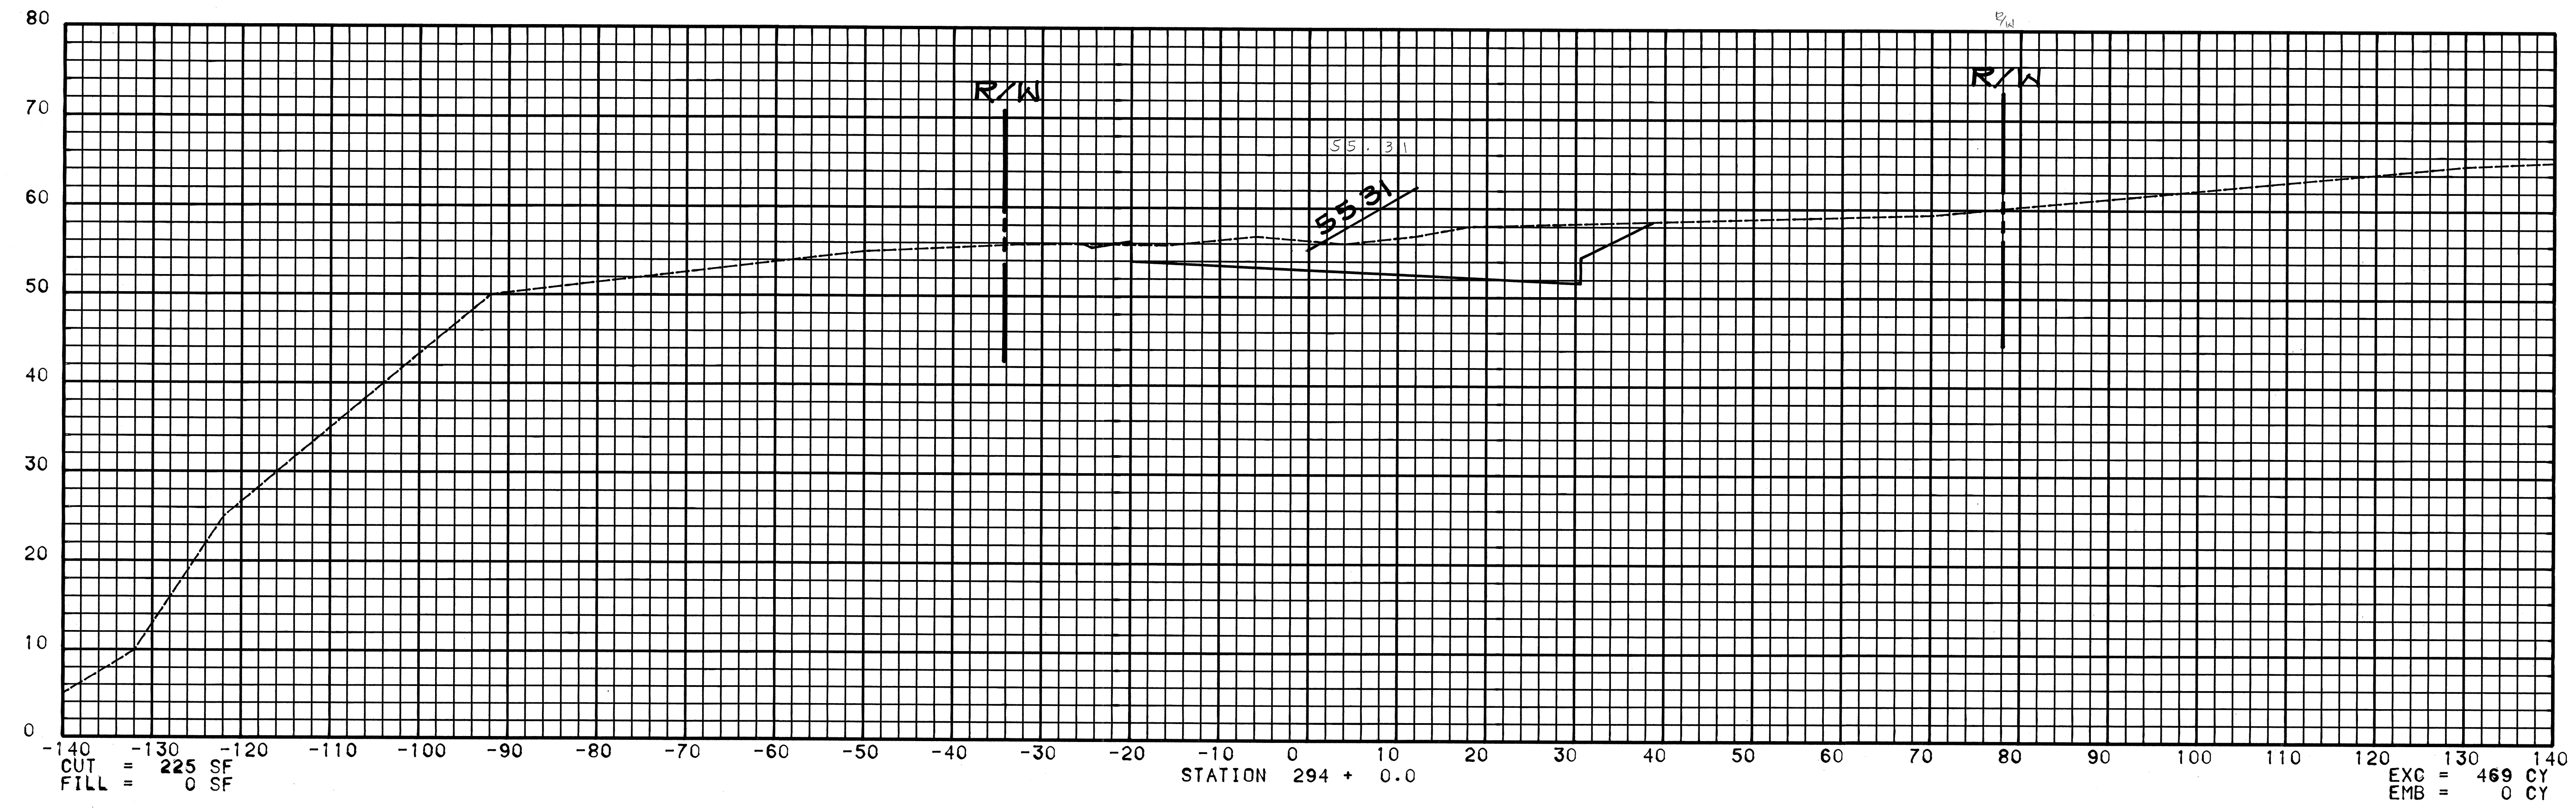


SCALE : HORIZONTAL 1 INCH = 10 FEET
 VERTICAL 1 INCH = 10 FEET

ORIGINAL PLAN	SURVEY PLOTTED BY	DATE
NOTE BOOK No.	DRAWN BY	"
	TRACED BY	"
	DESIGNED BY	"
	QUANTITIES BY	"
	CHECKED BY	"



FED. ROAD DIST. NO.	STATE	FED. AID PROJ. NO.	FISCAL YEAR	SHEET NO.	TOTAL SHEETS
HAWAII	HAW.	F-030-1(18)	1984	163	169

ORIGINAL PLAN	SURVEY PLOTTED BY	DATE
NOTE BOOK No.	DRAWN BY	"
	TRACED BY	"
	DESIGNED BY	"
	QUANTITIES BY	"
	CHECKED BY	"

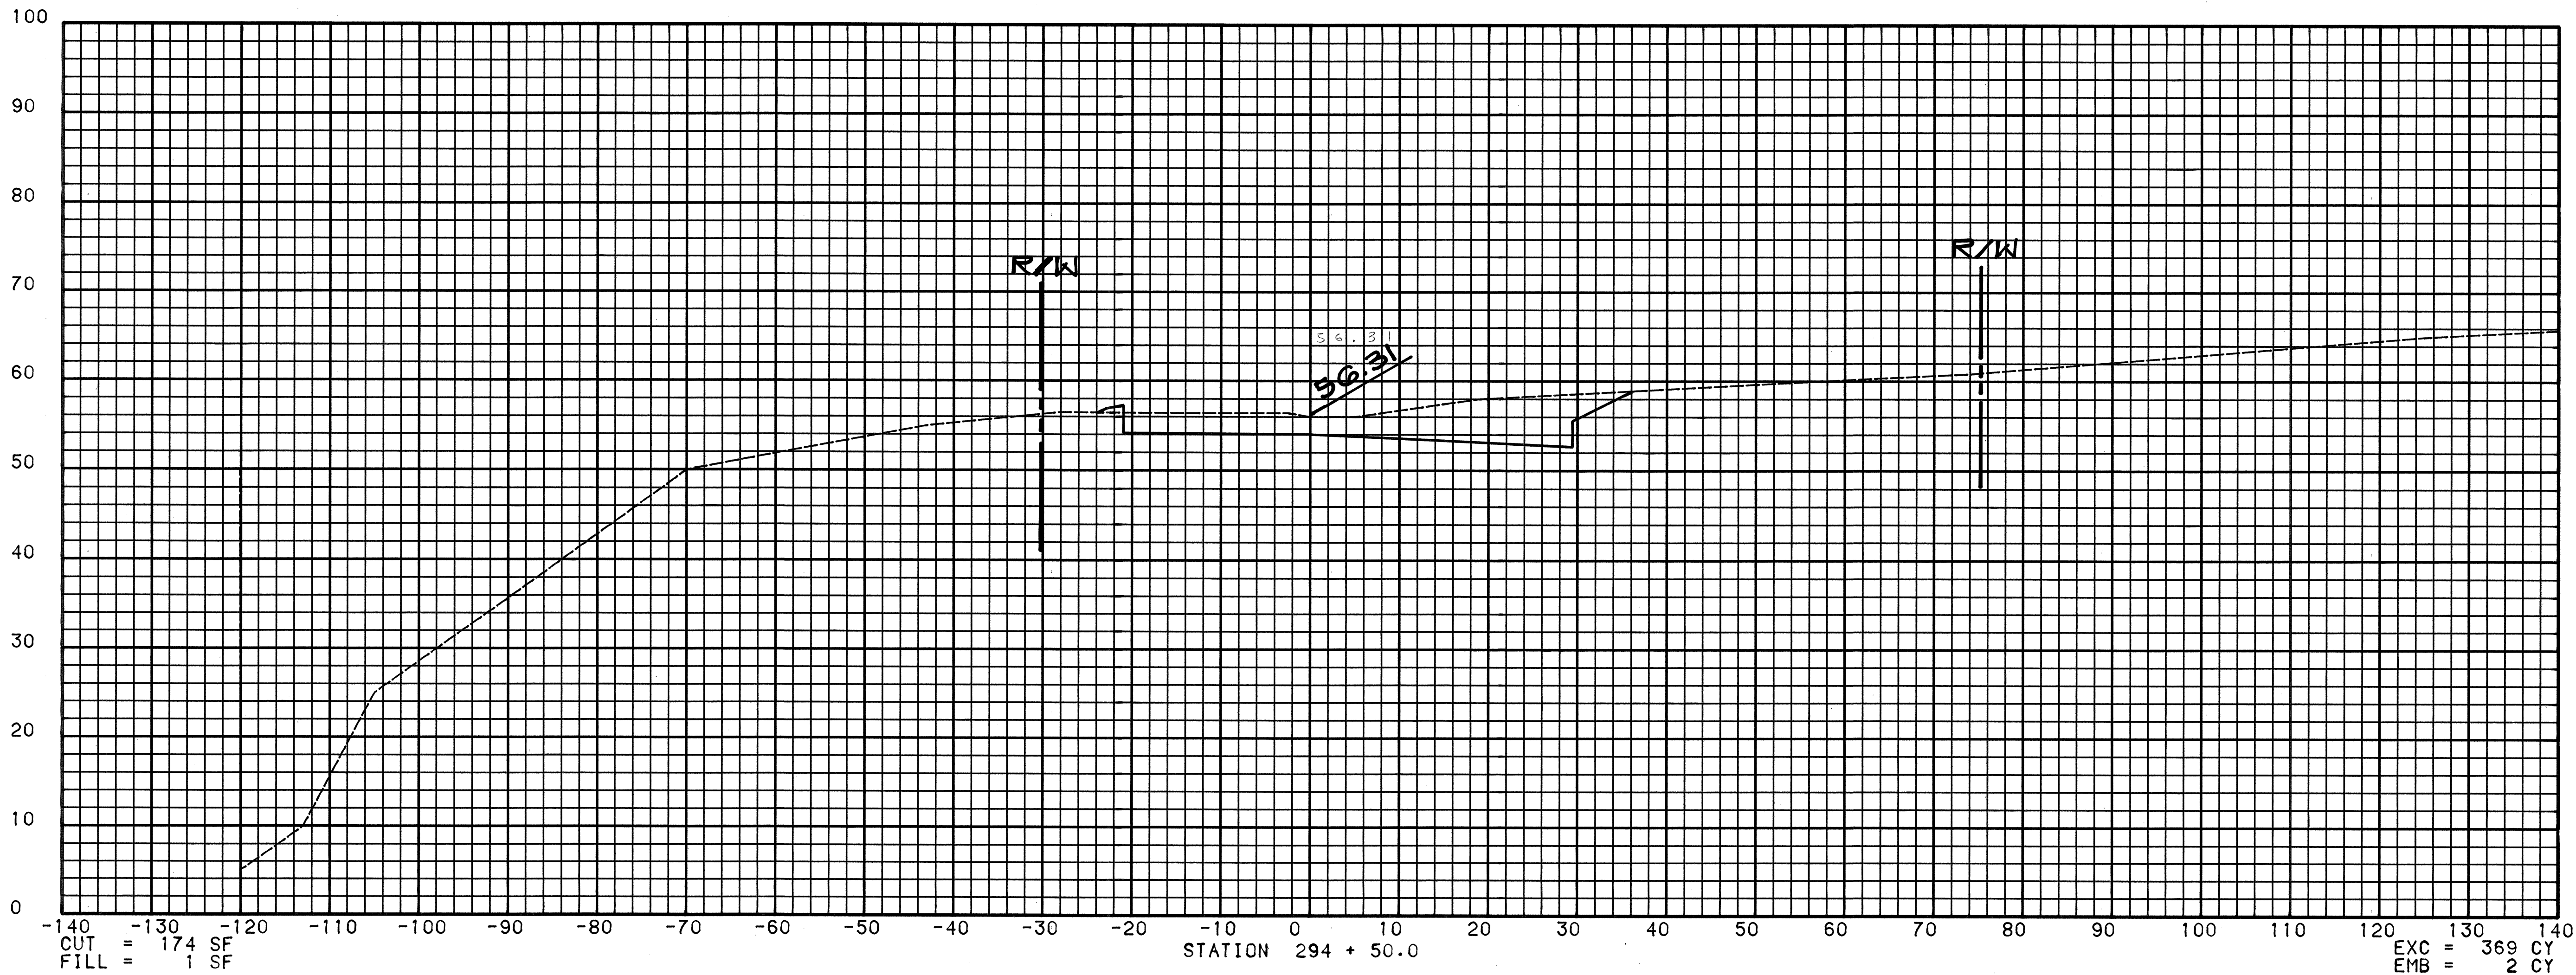



SCALE : HORIZONTAL 1 INCH = 10 FEET
VERTICAL 1 INCH = 10 FEET

FED. ROAD DIST. NO.	STATE	FED. AID PROJ. NO.	FISCAL YEAR	SHEET NO.	TOTAL SHEETS
HAWAII	HAW.	F-030-1(18)	1984	164	169

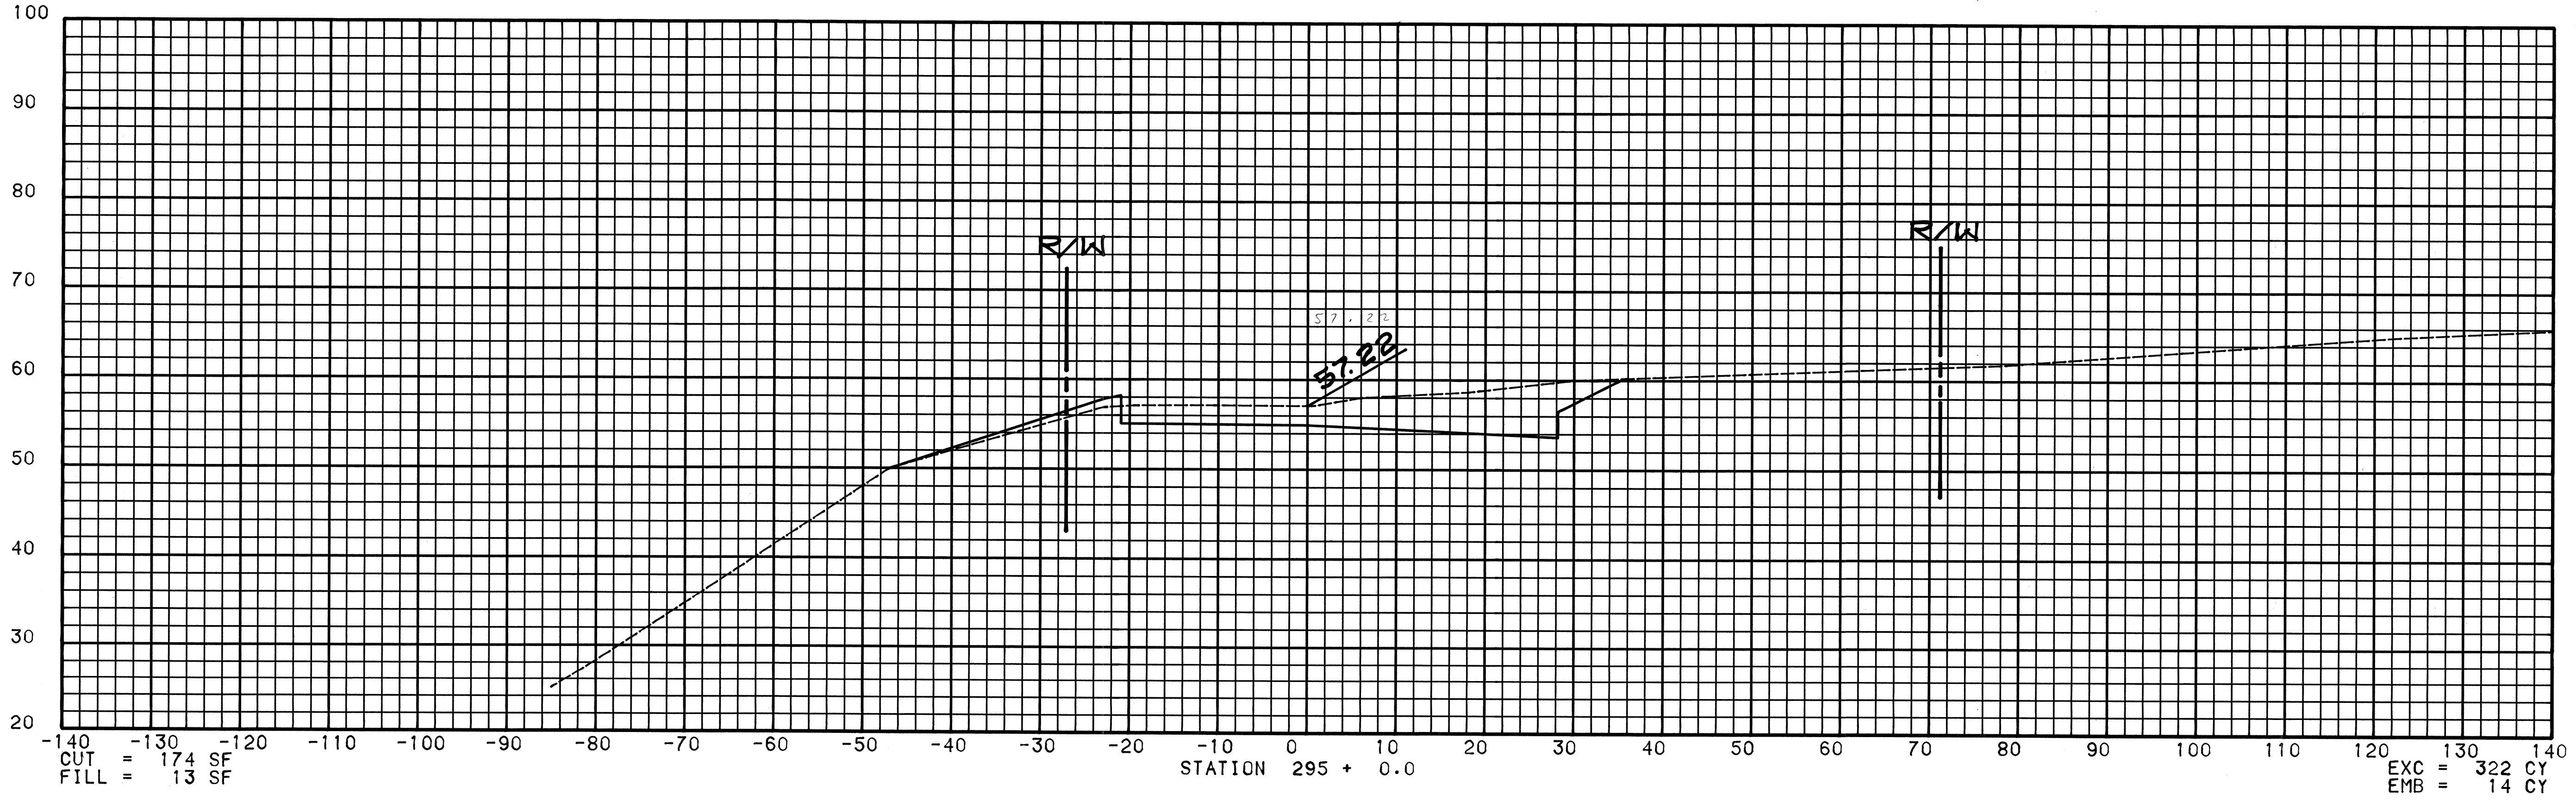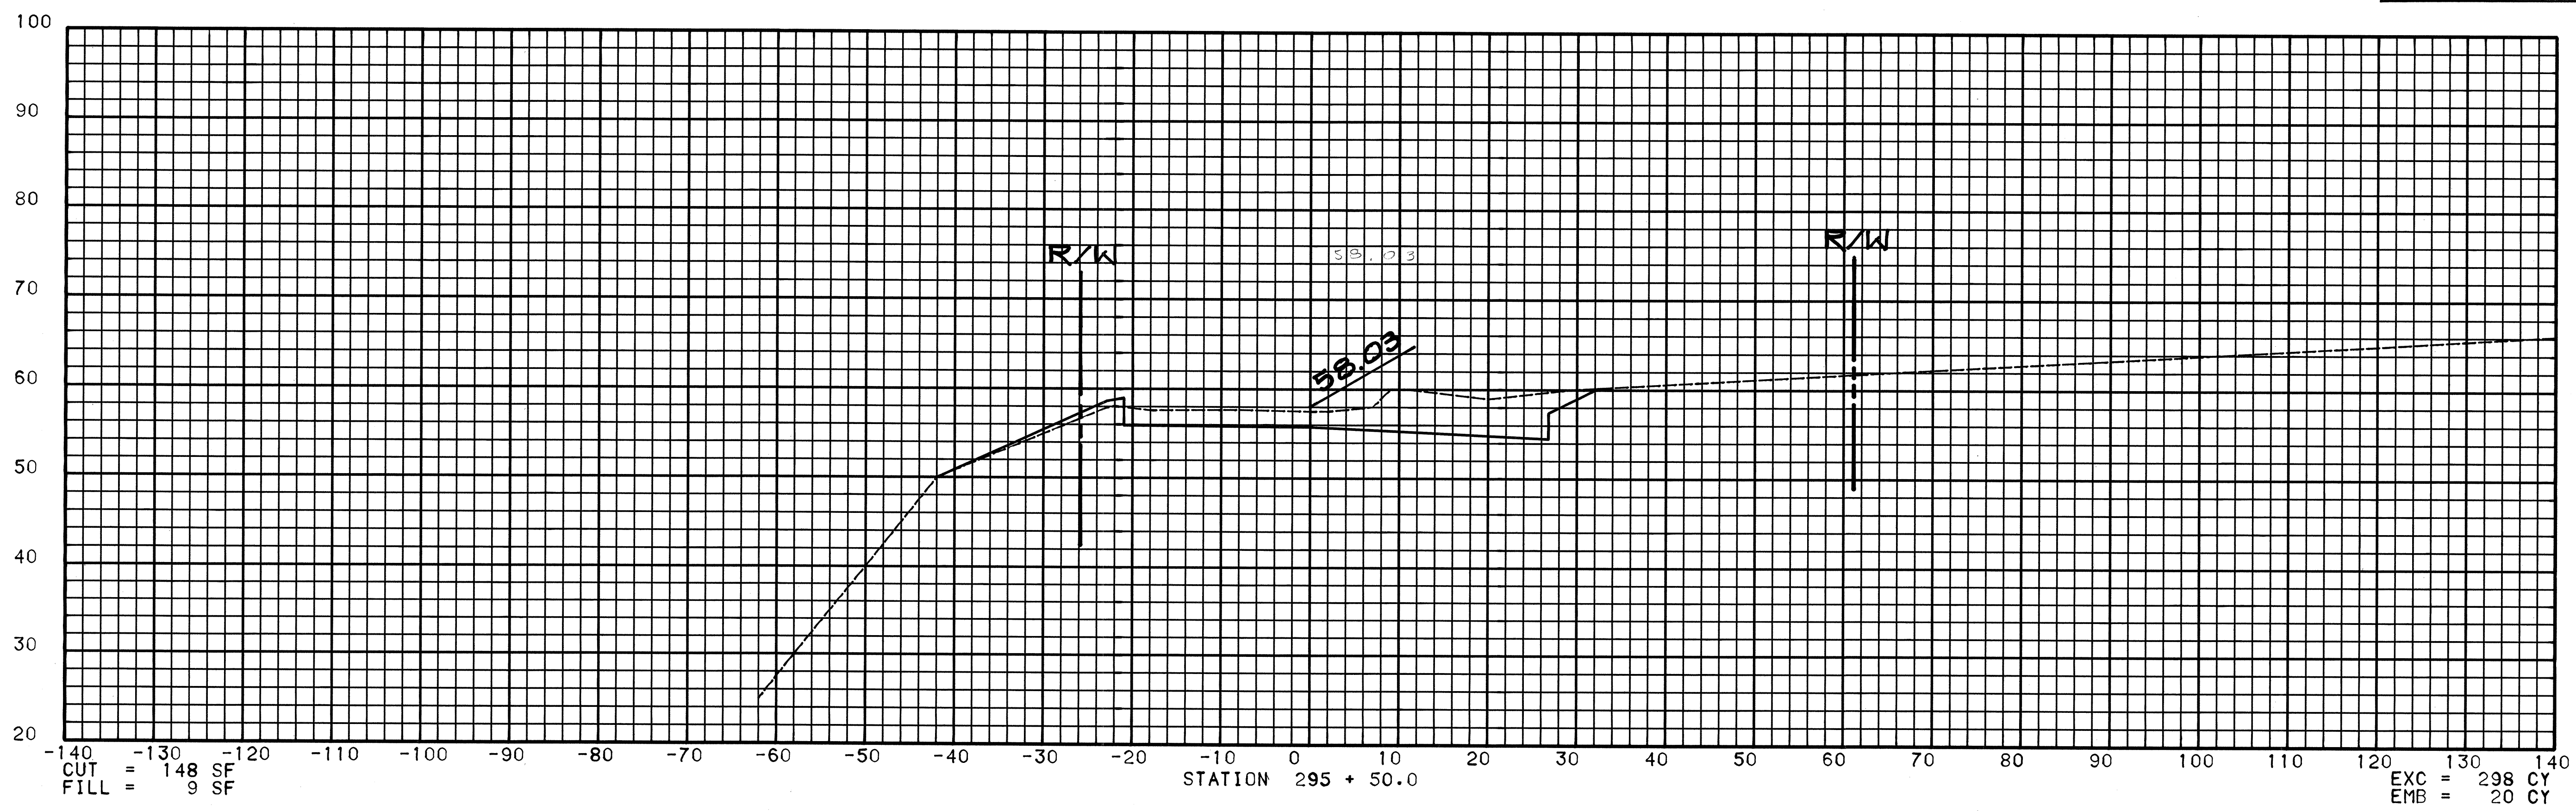


SCALE : HORIZONTAL 1 INCH = 10 FEET
VERTICAL 1 INCH = 10 FEET

FED. ROAD DIST. NO.	STATE	FED. AID PROJ. NO.	FISCAL YEAR	SHEET NO.	TOTAL SHEETS
HAWAII	HAW.	F-030-1(18)	1984	165	169








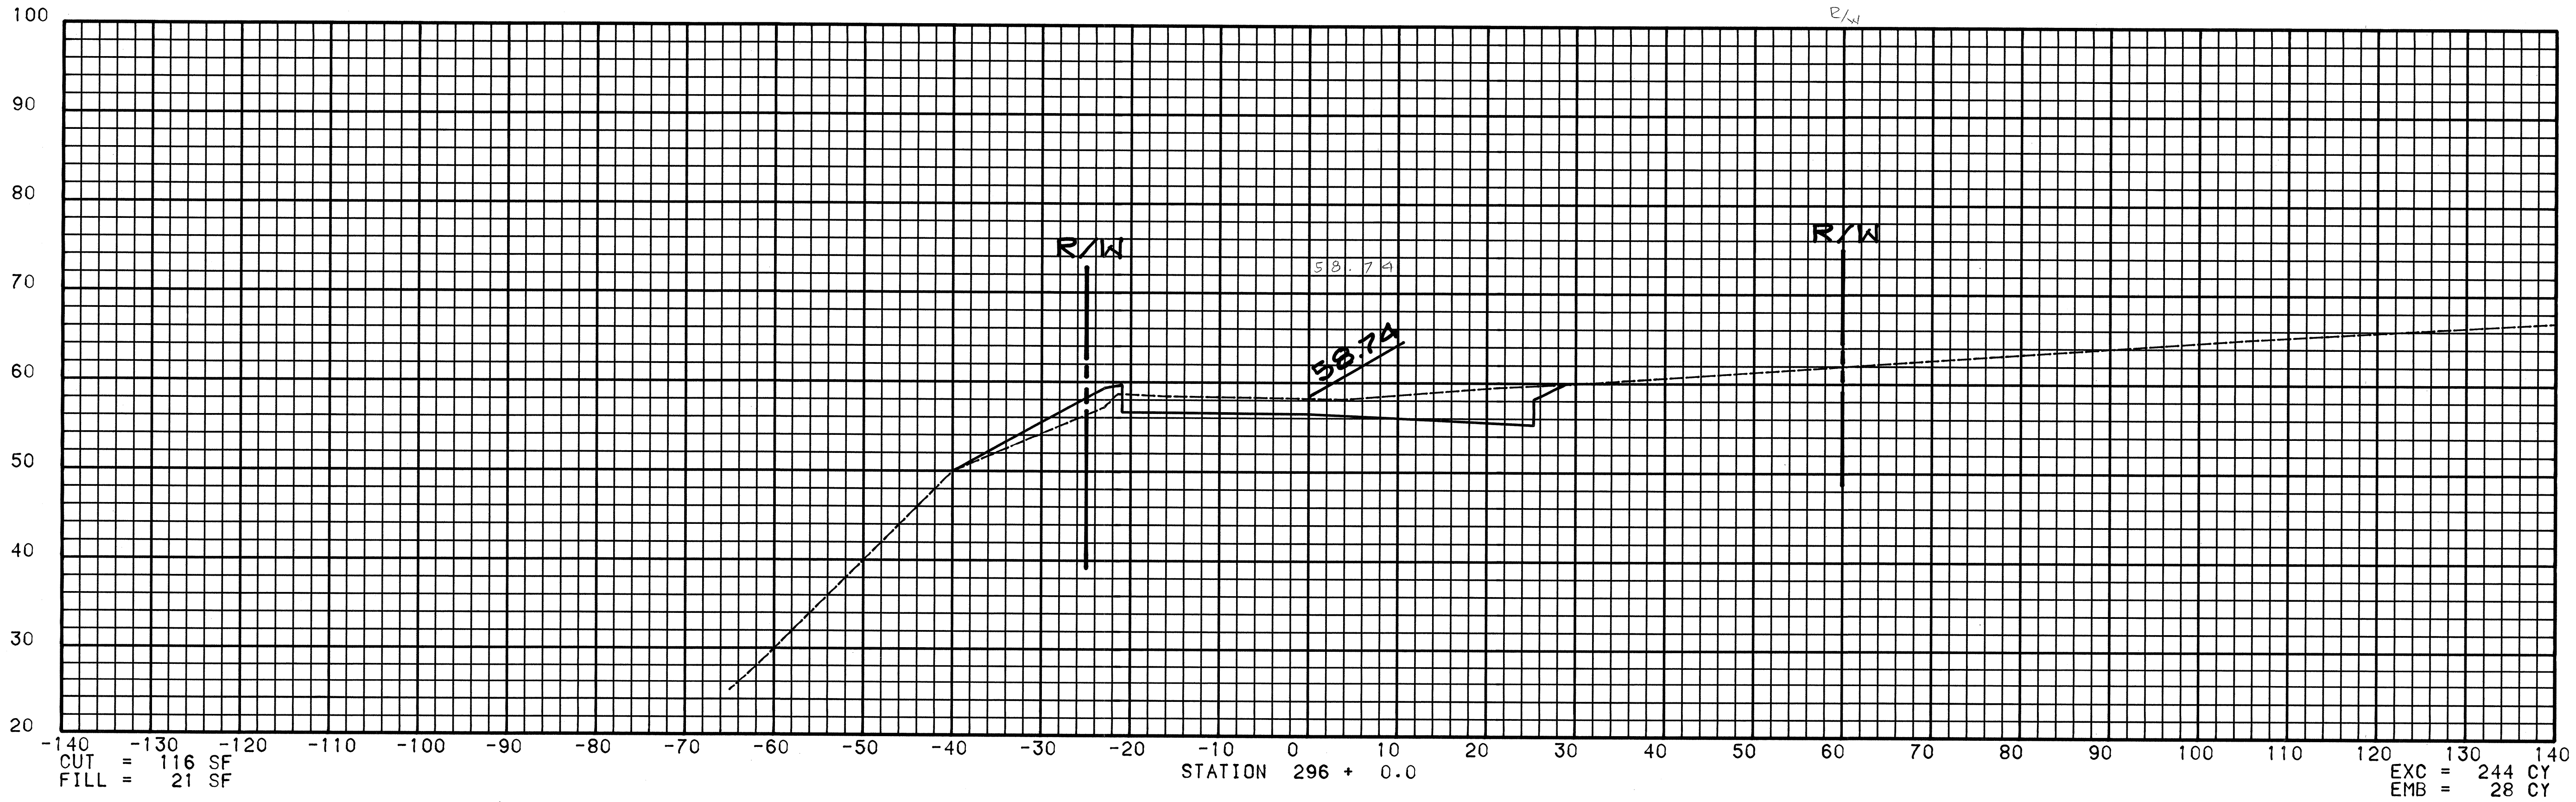
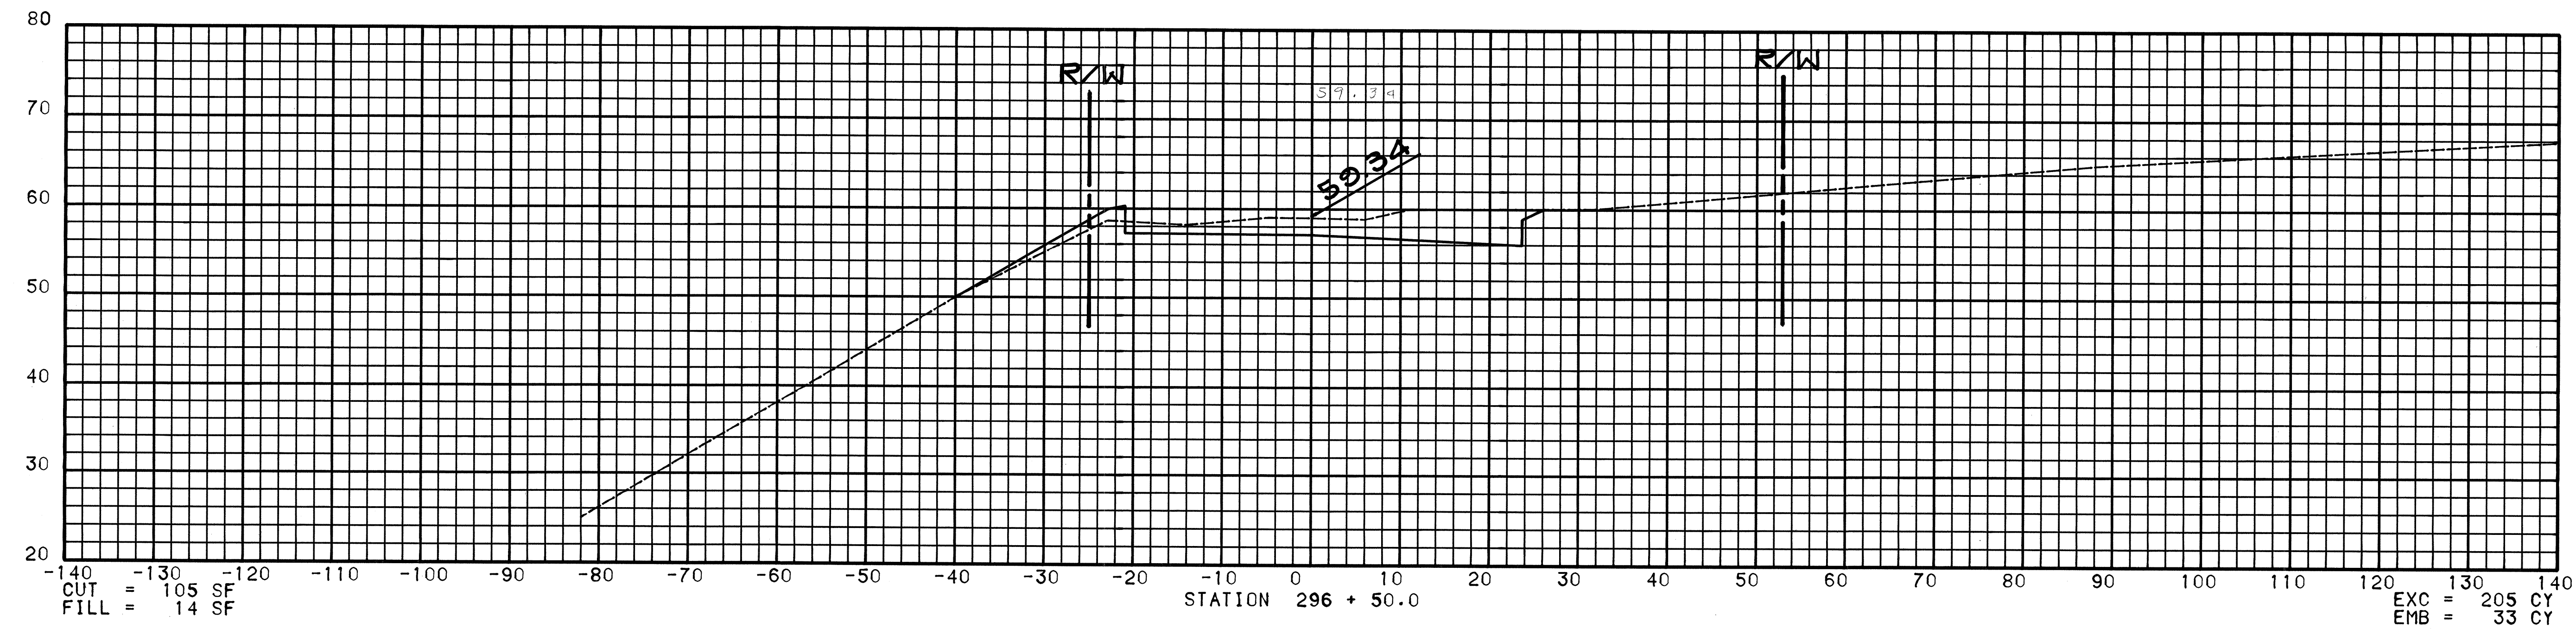


SCALE : HORIZONTAL 1 INCH = 10 FEET
VERTICAL 1 INCH = 10 FEET







FED. ROAD DIST. NO.	STATE	FED. AID PROJ. NO.	FISCAL YEAR	SHEET NO.	TOTAL SHEETS
HAWAII	HAW.	F-030-1(18)	1984	166	169






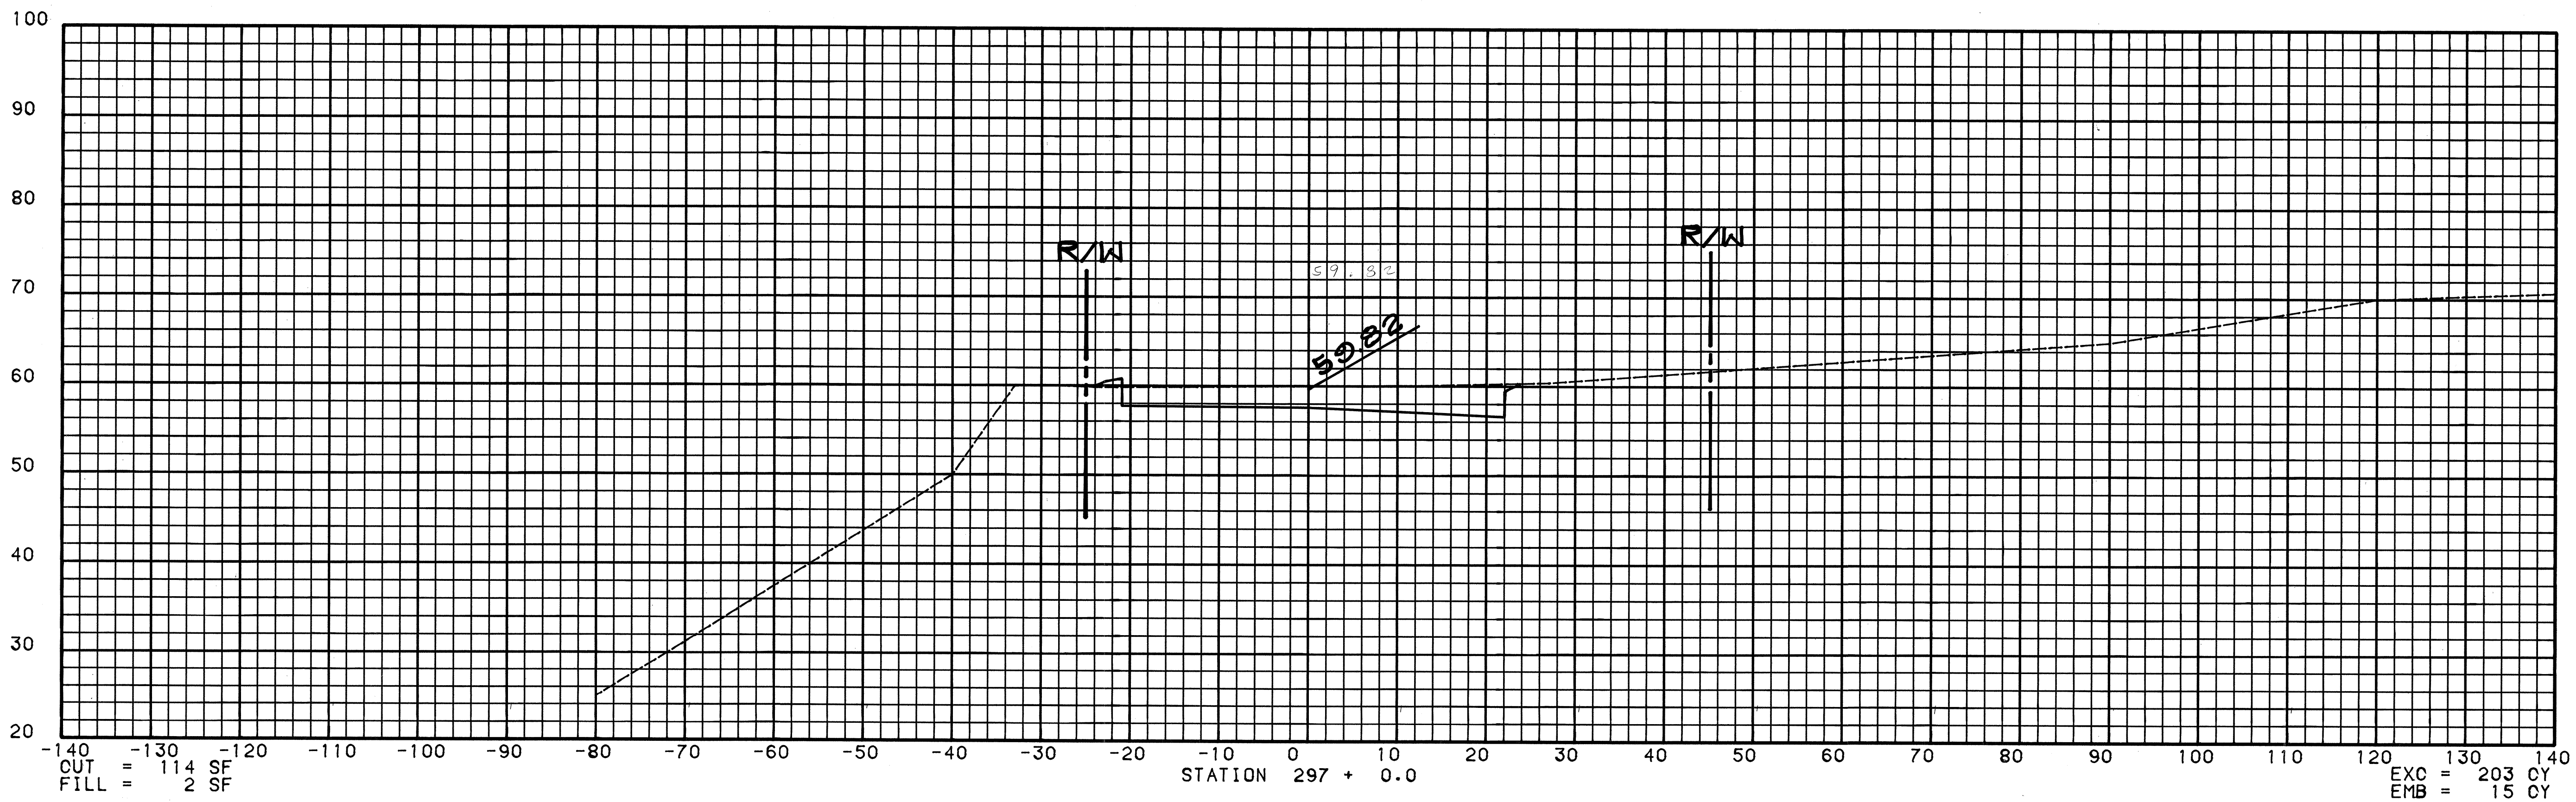


SCALE * HORIZONTAL 1 INCH = 10 FEET
 VERTICAL 1 INCH = 10 FEET

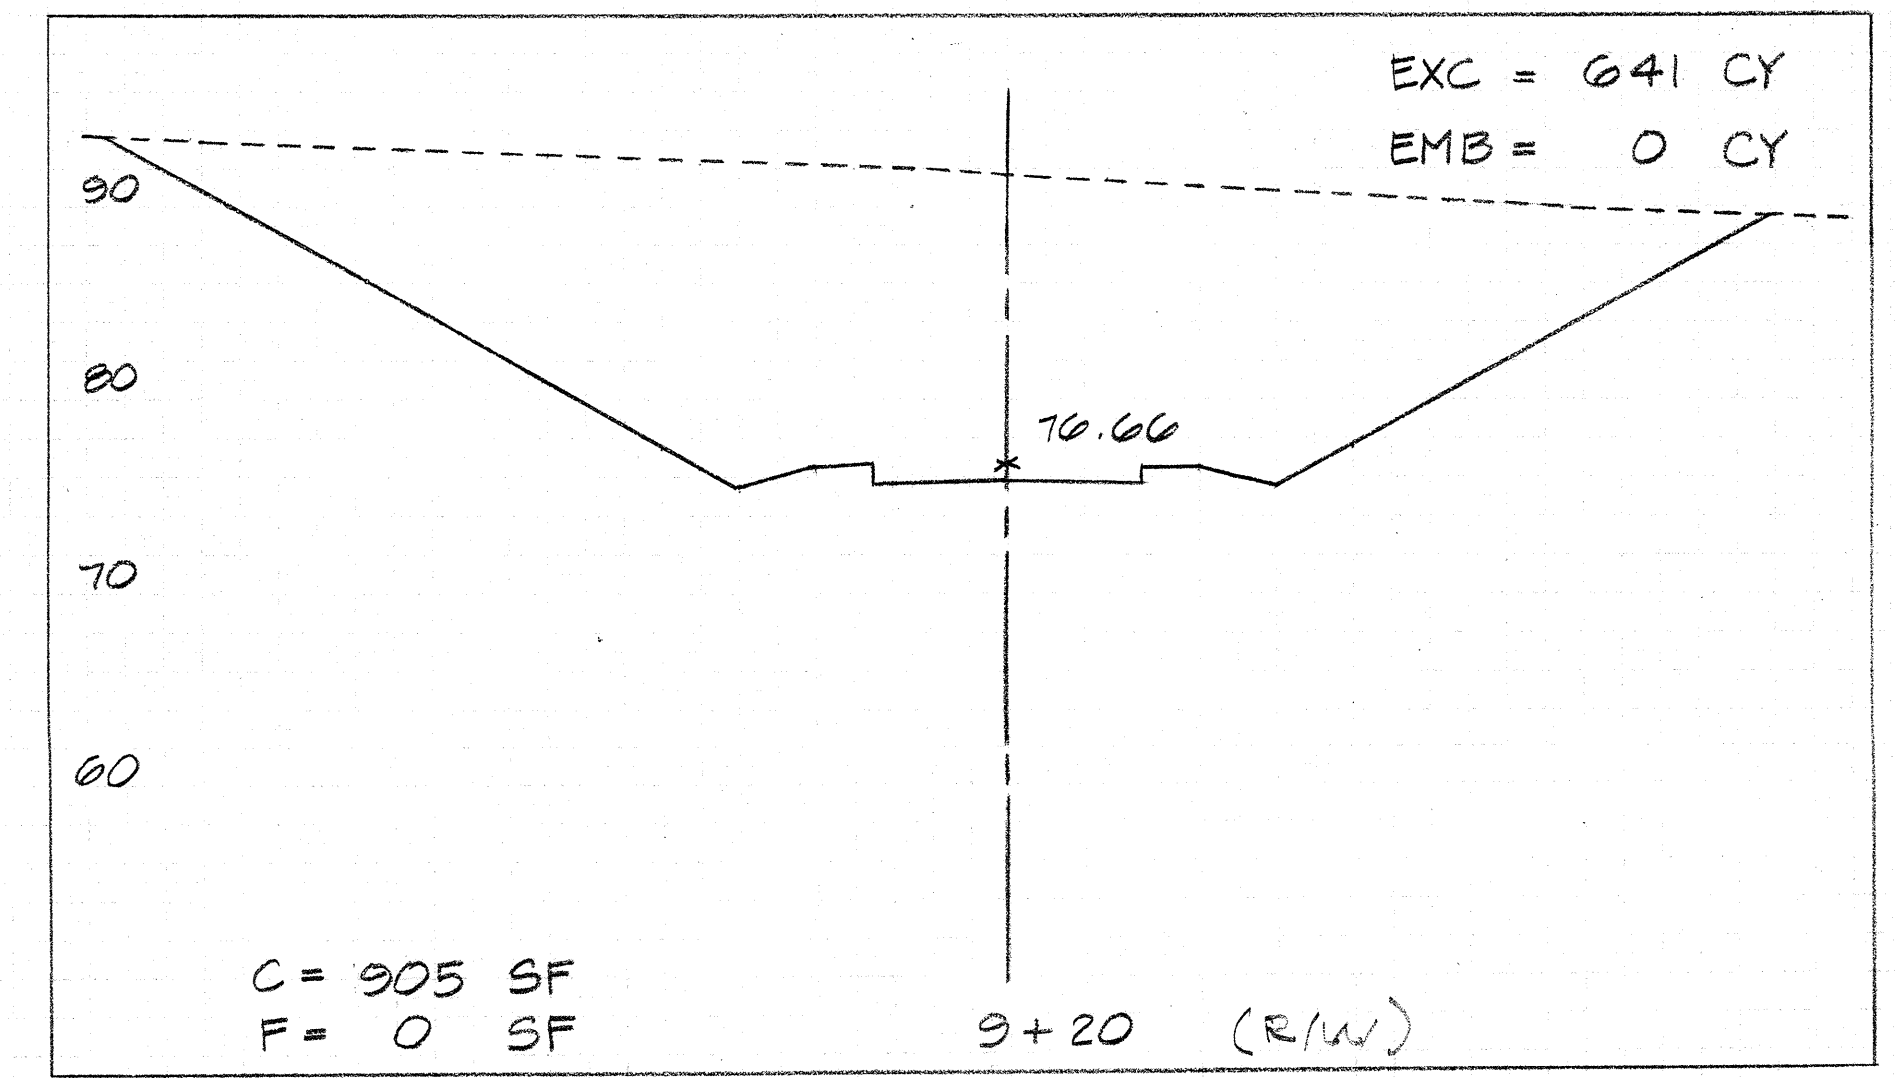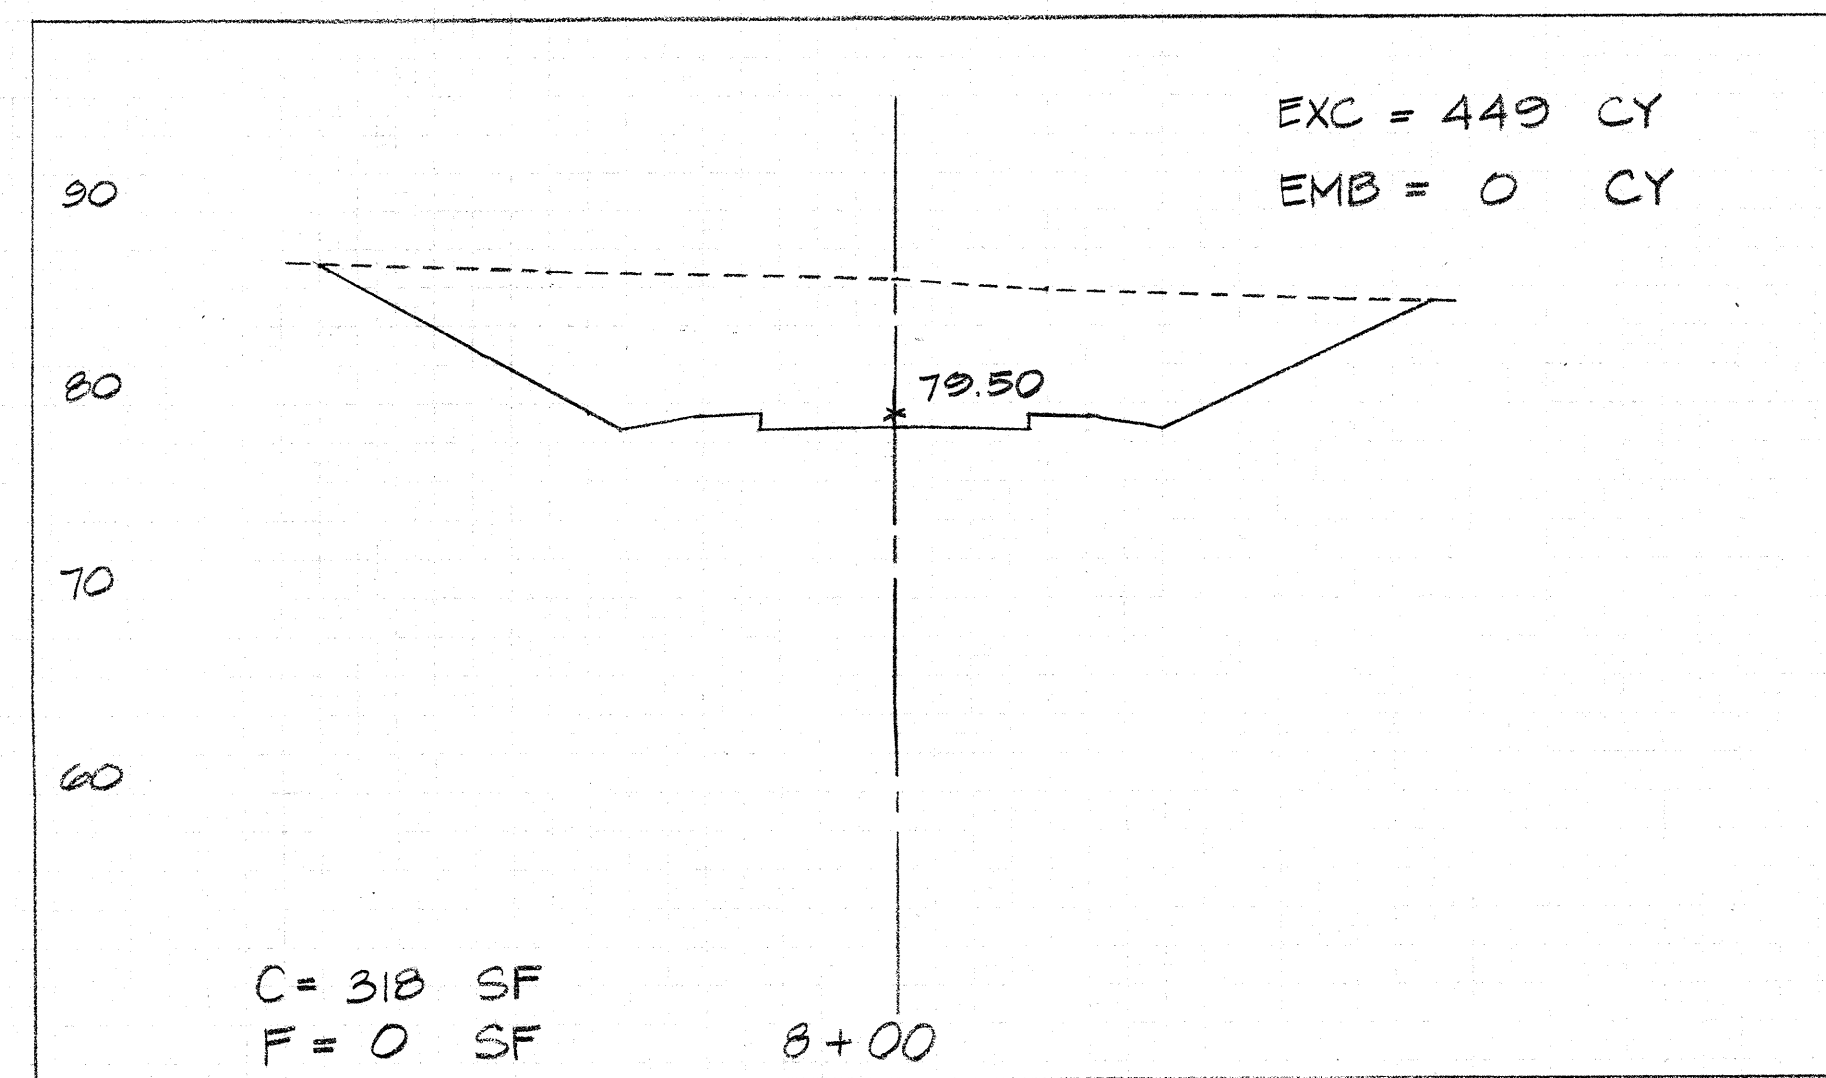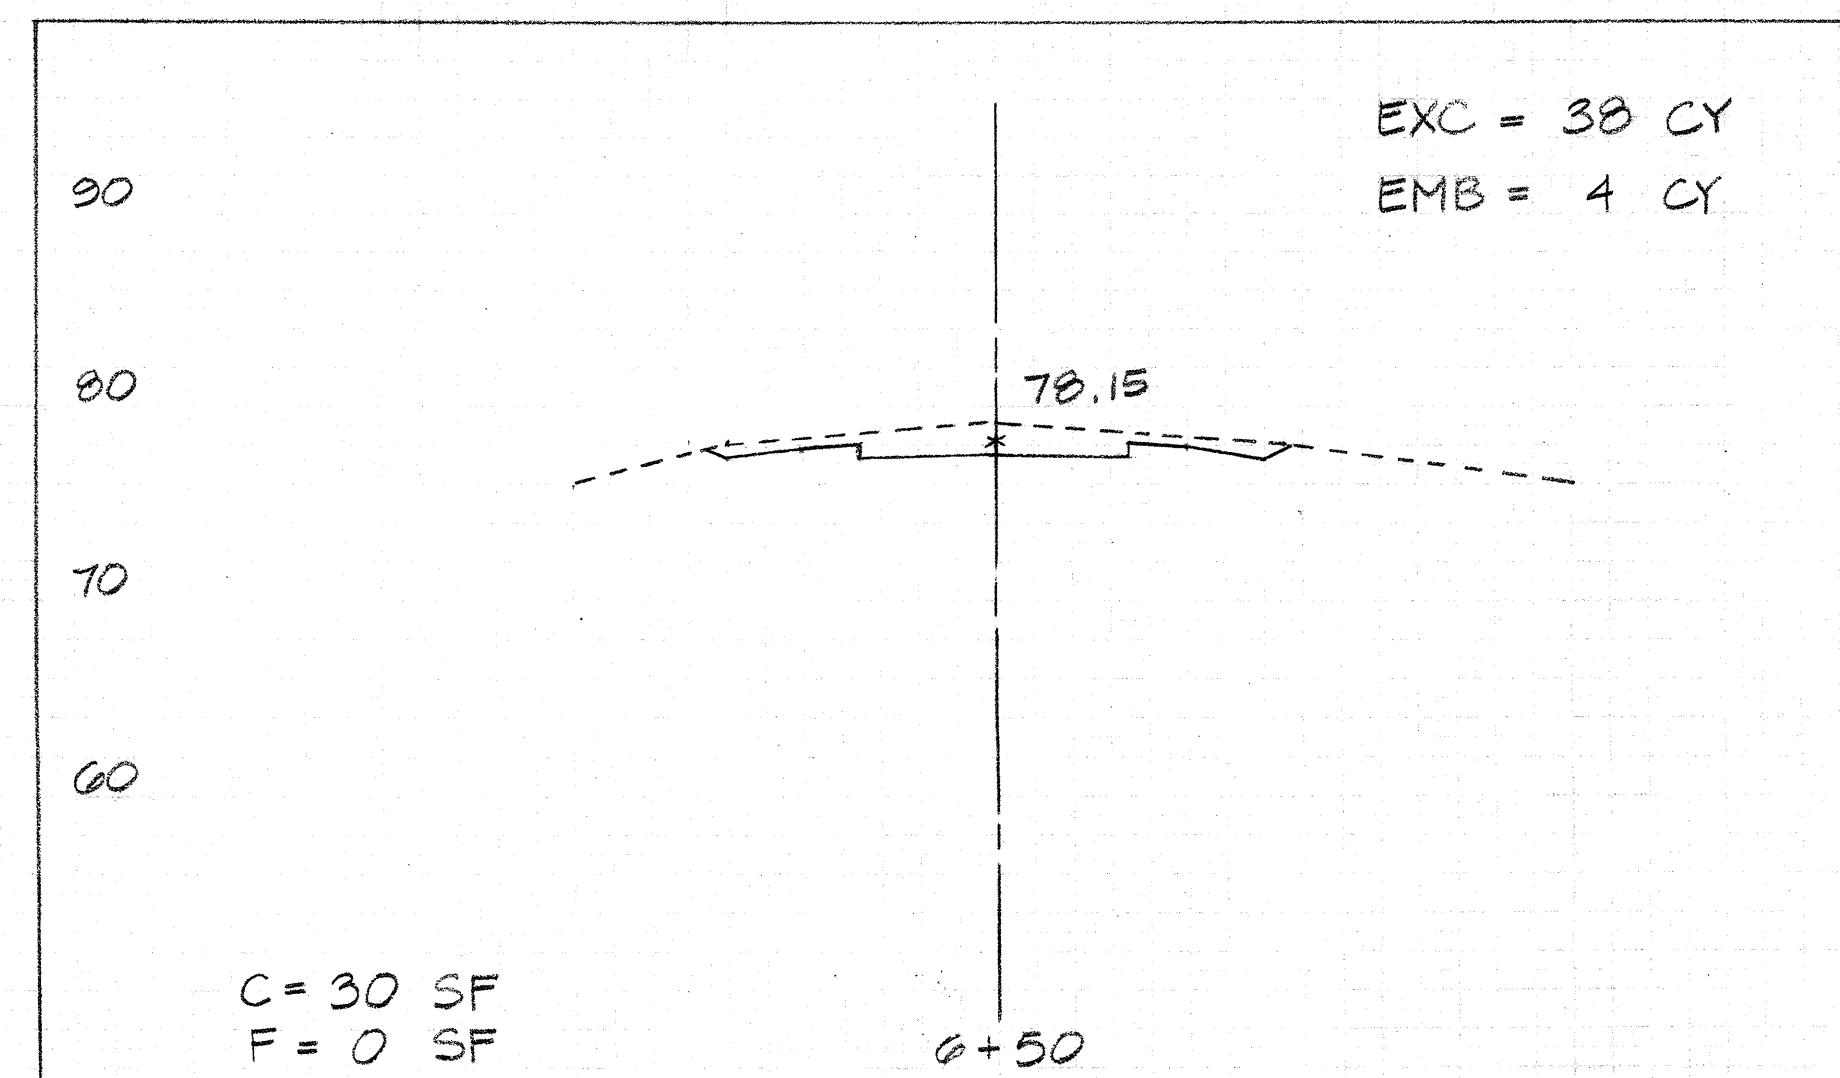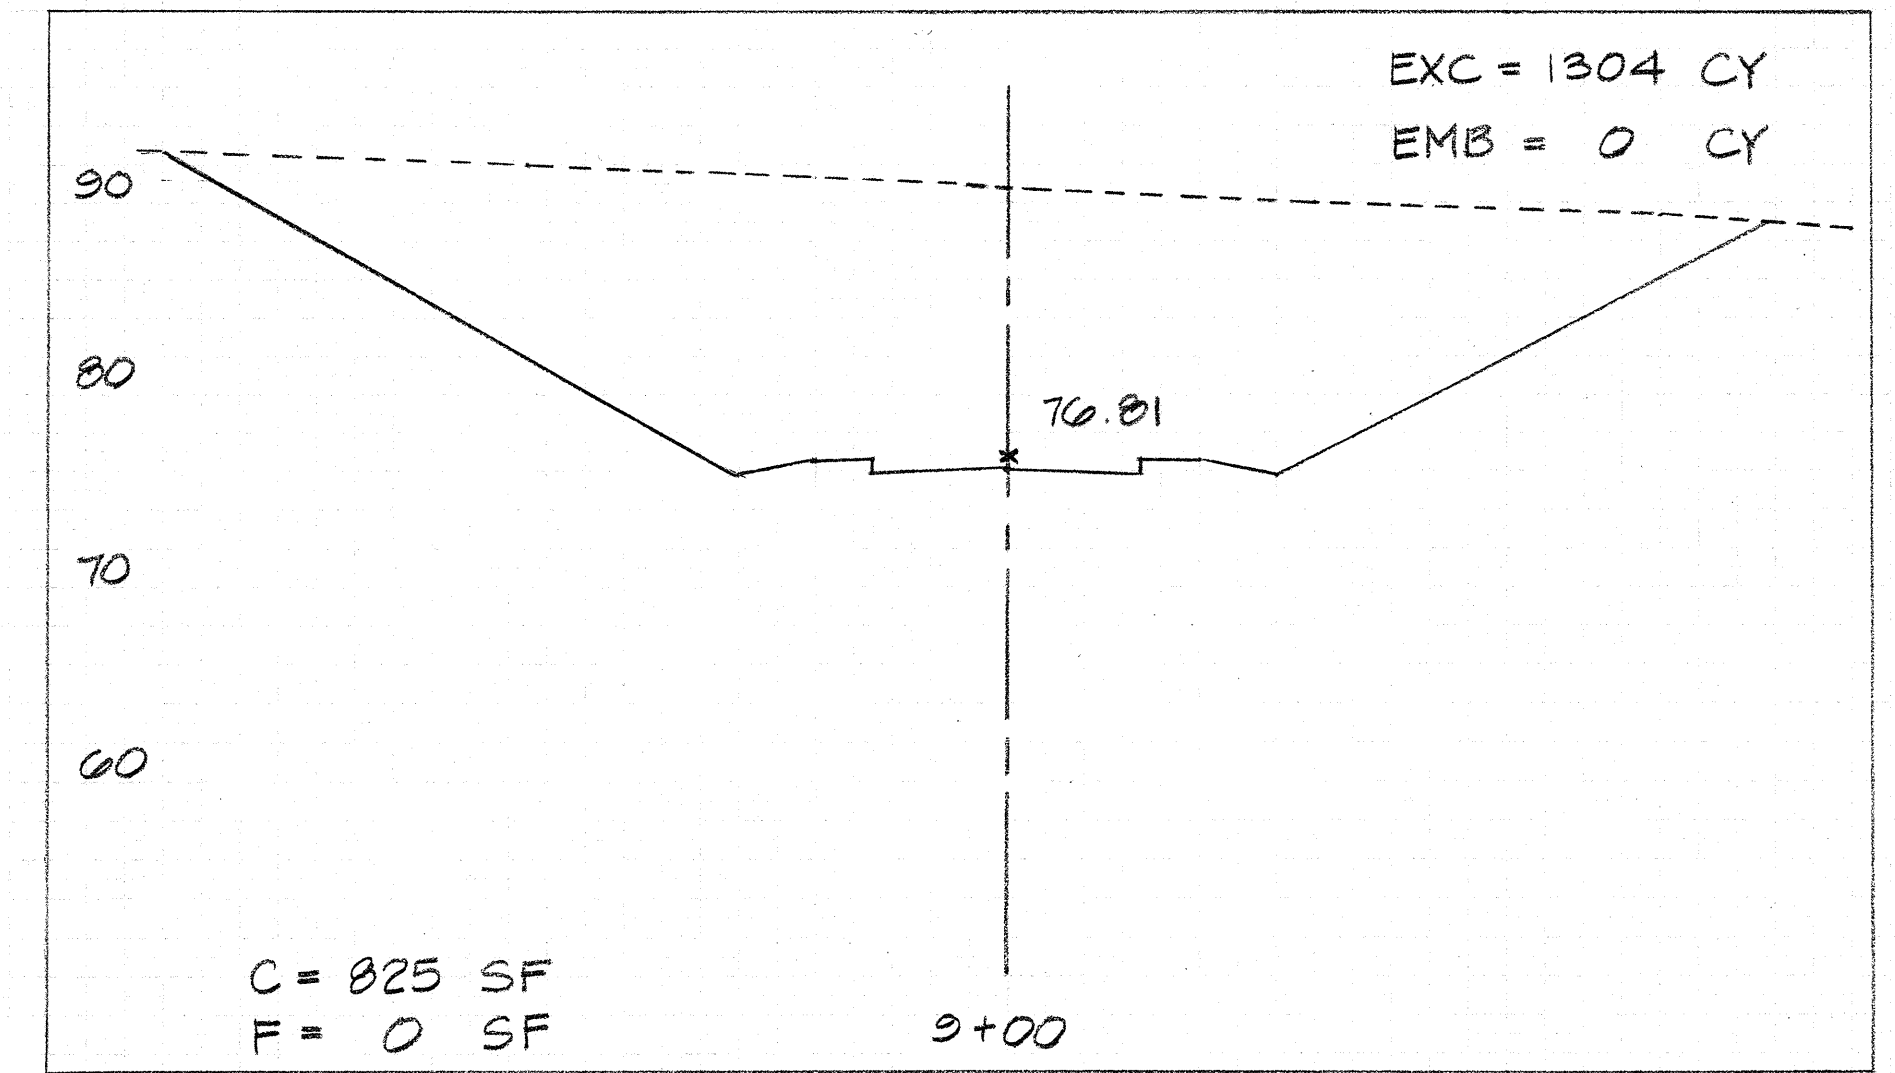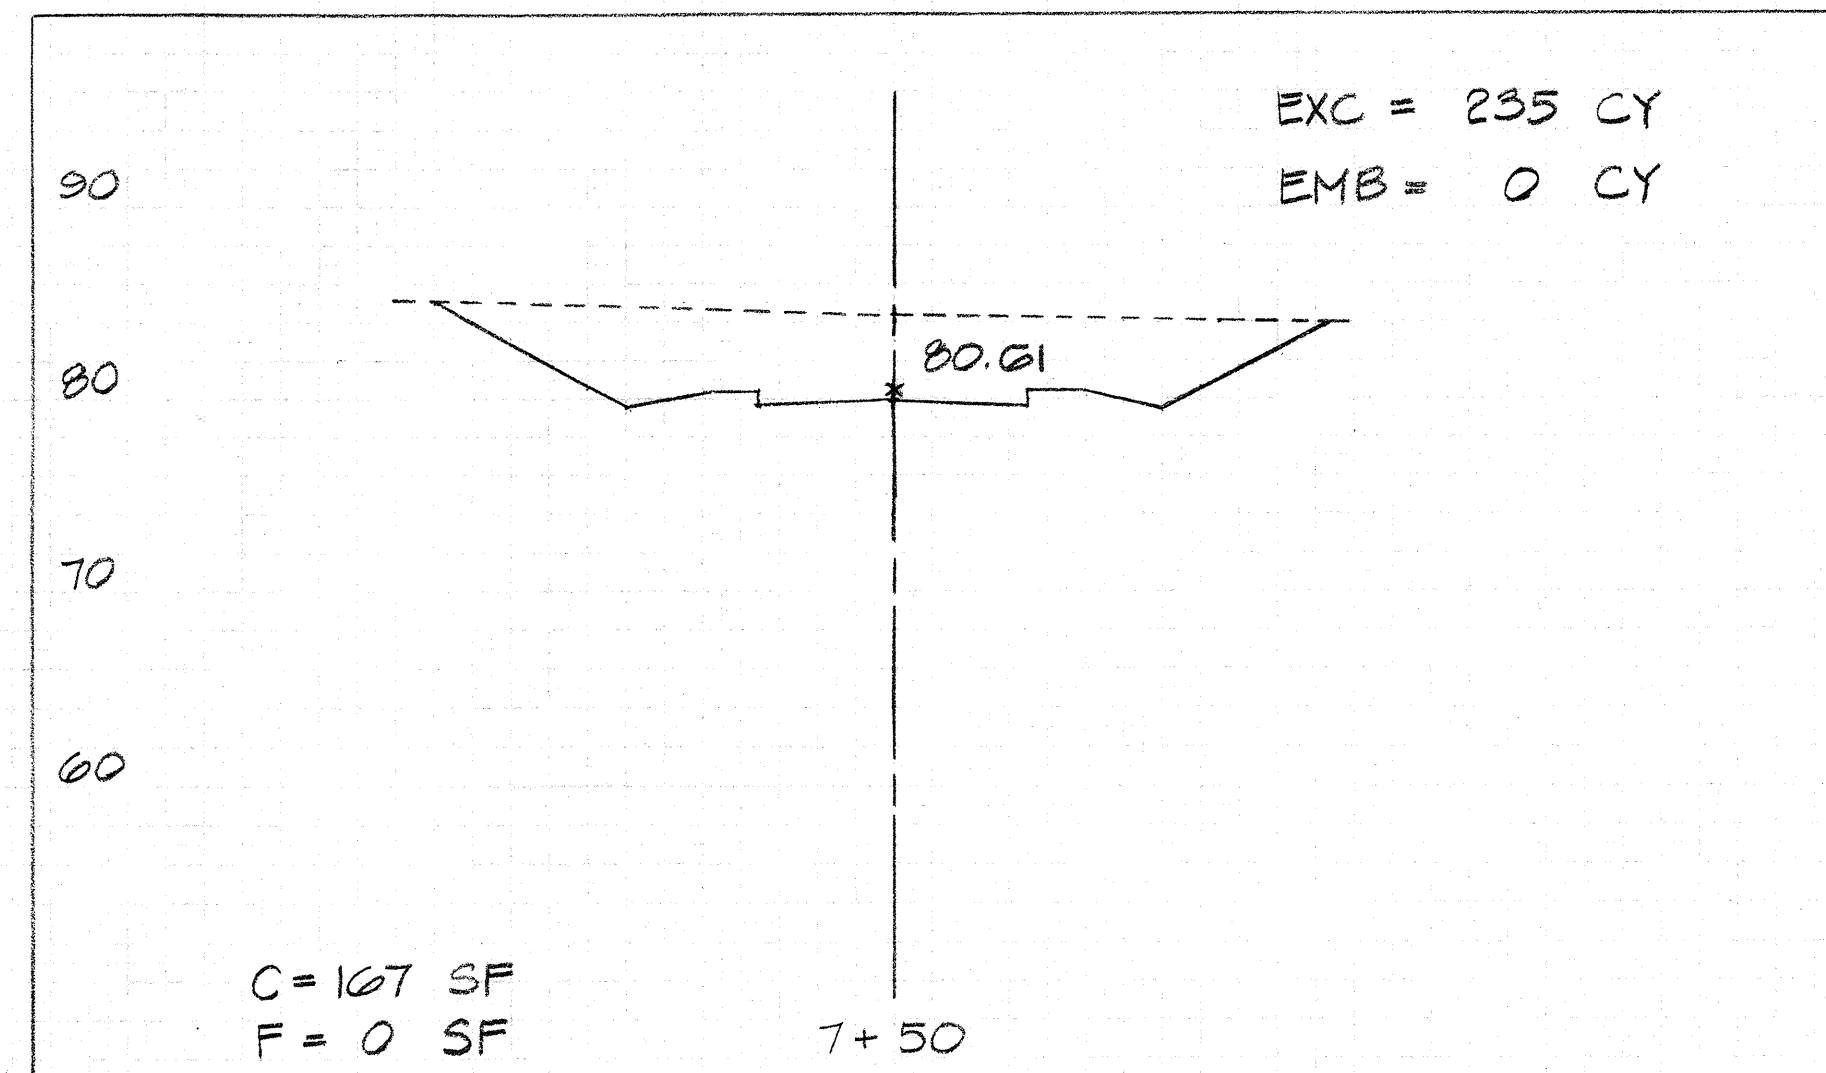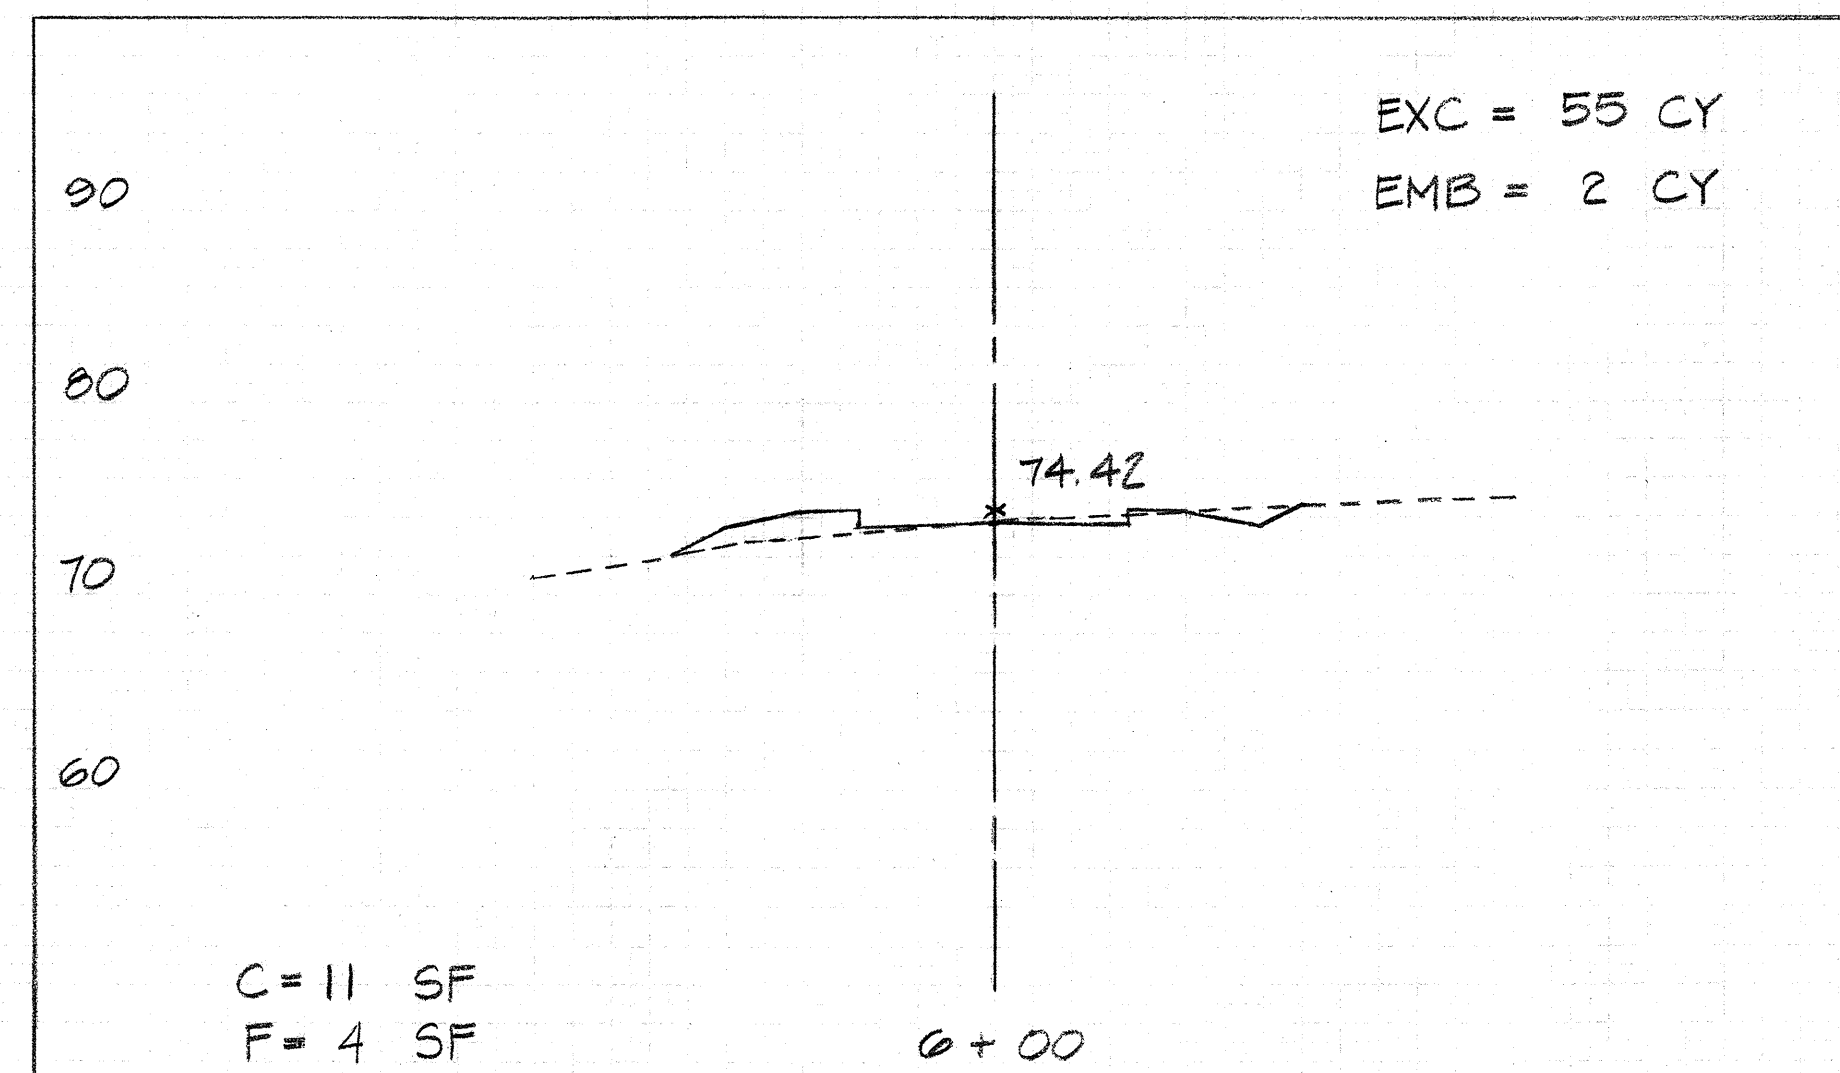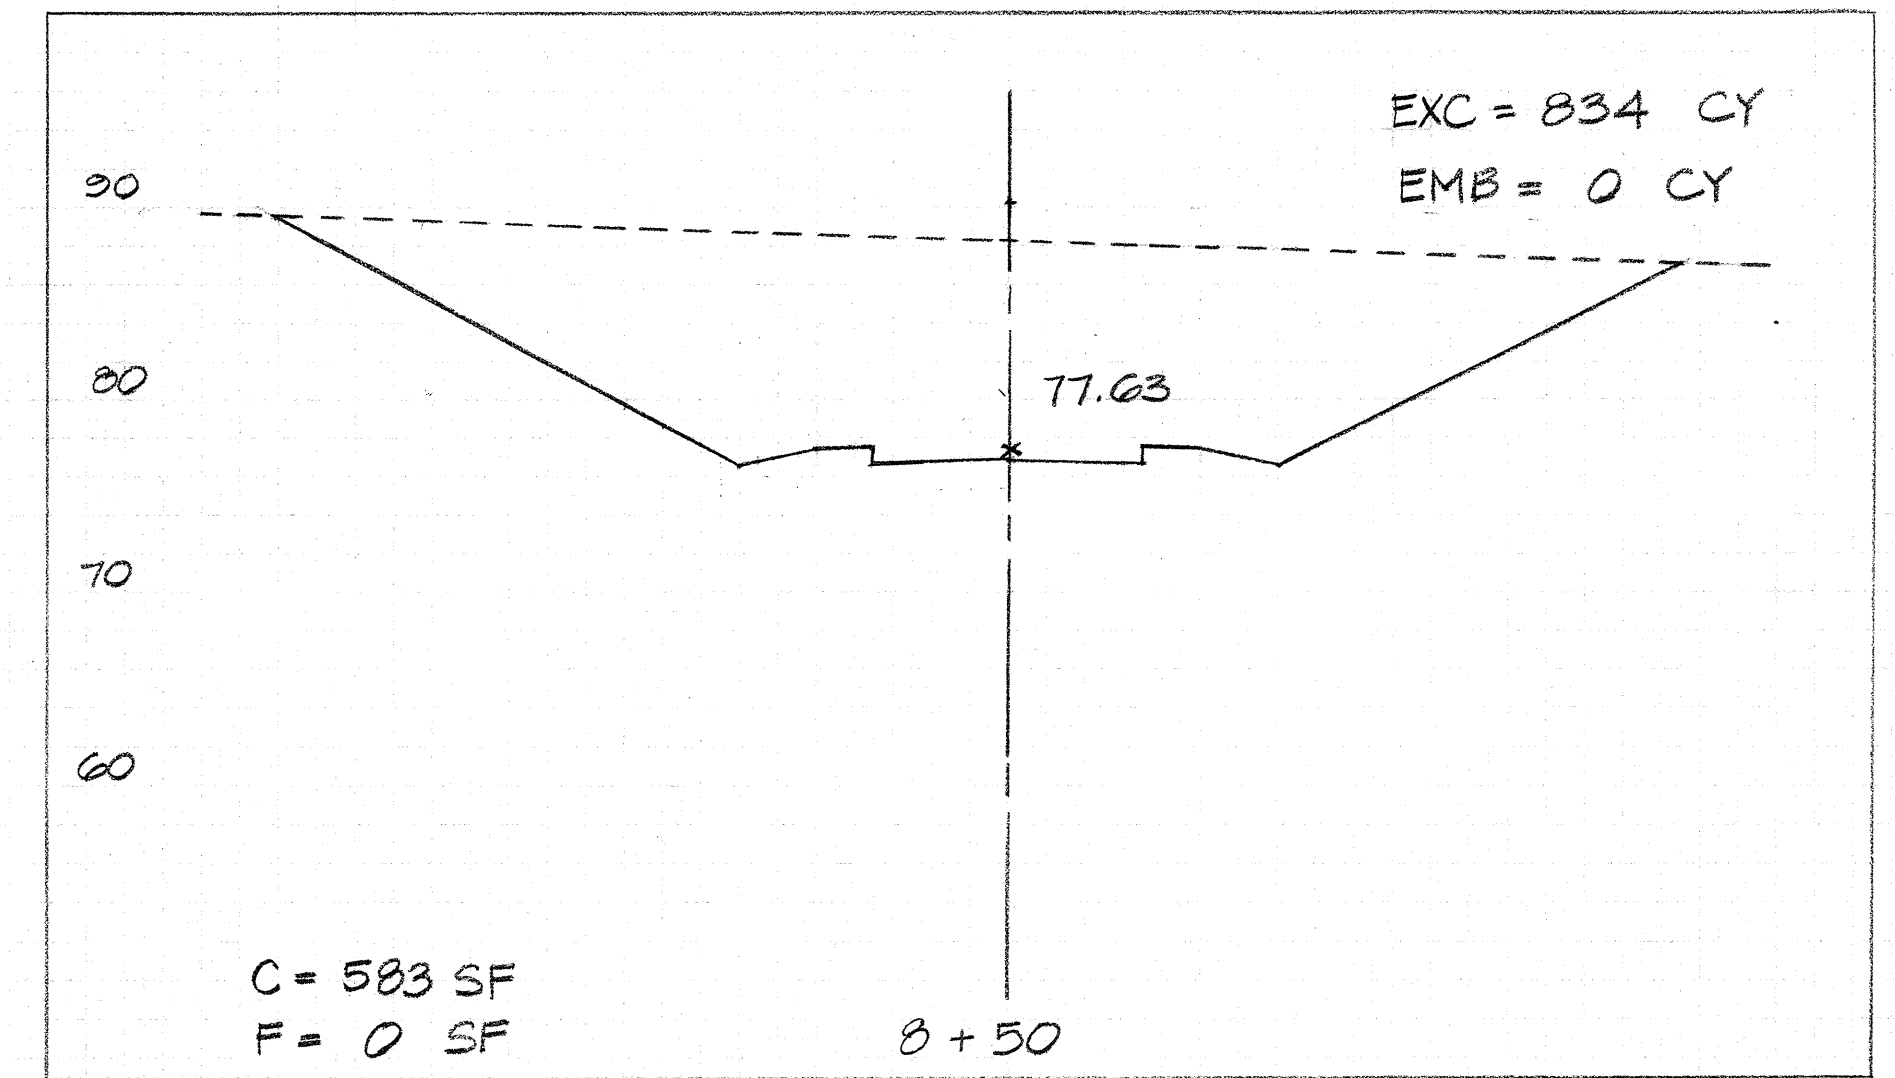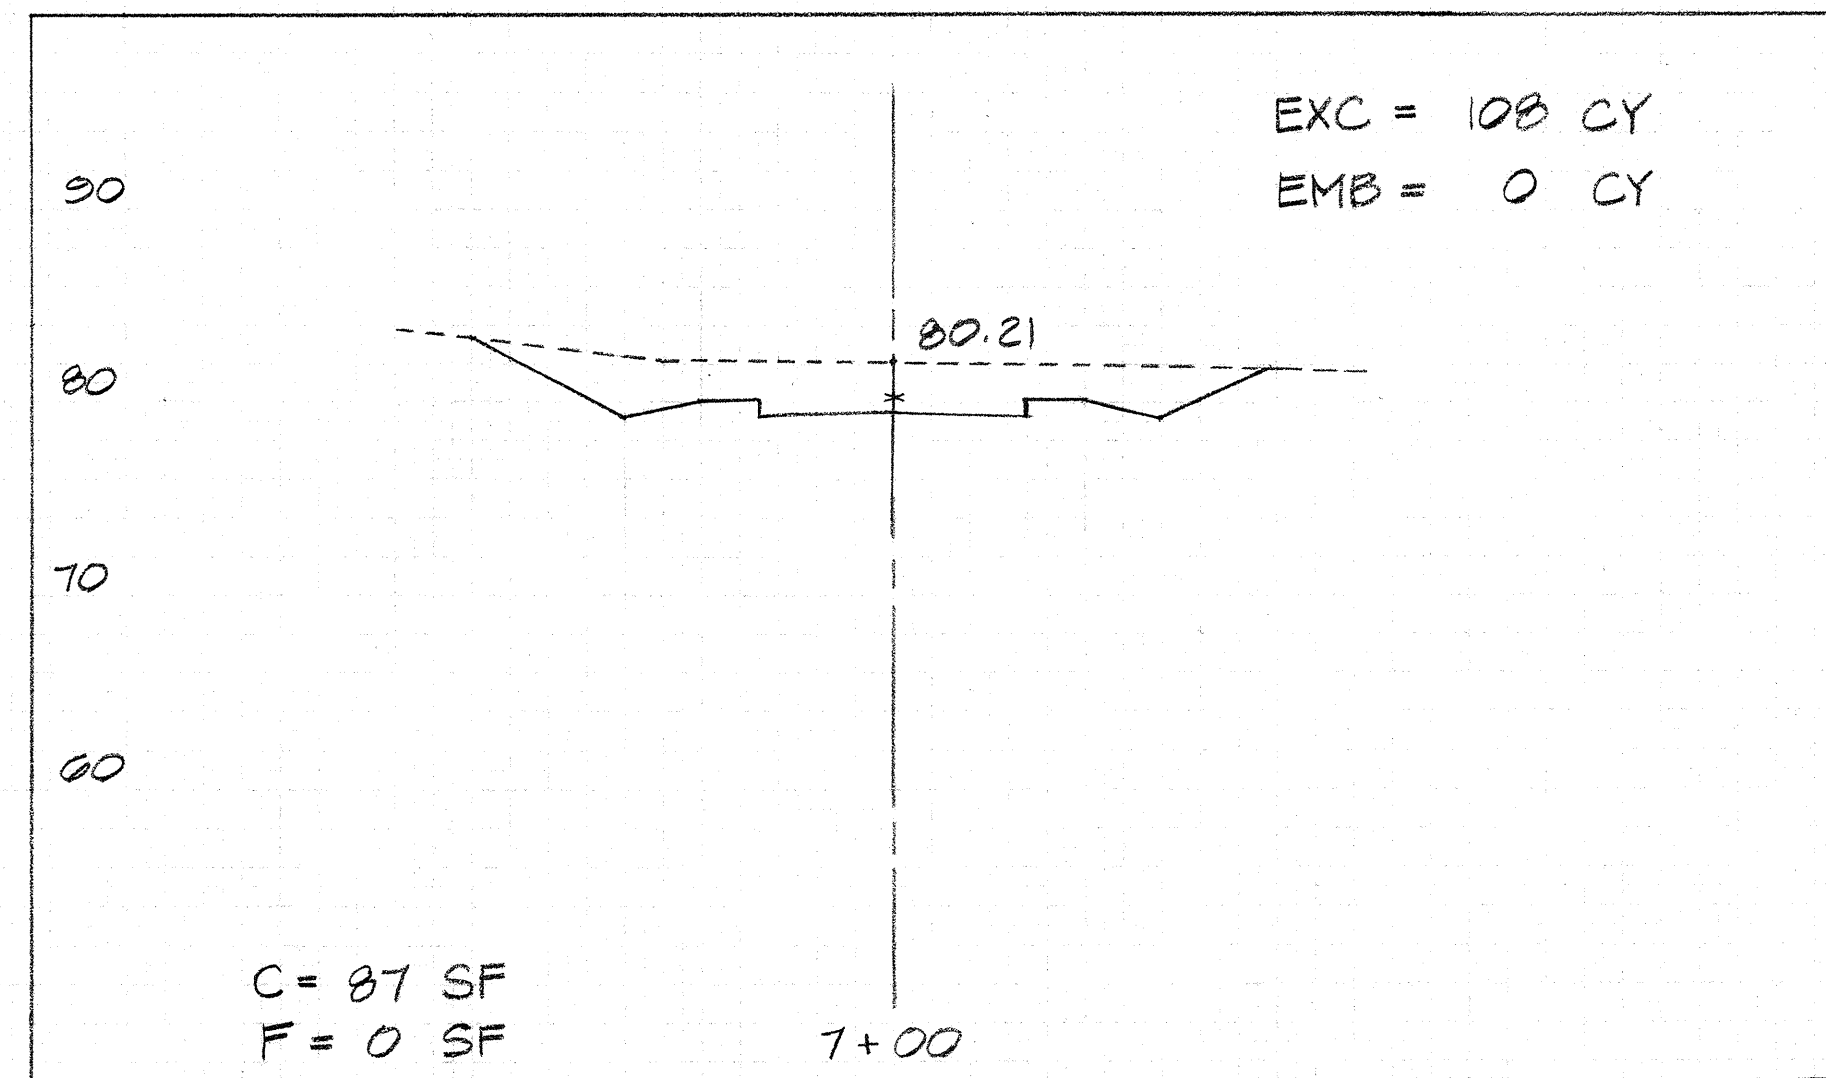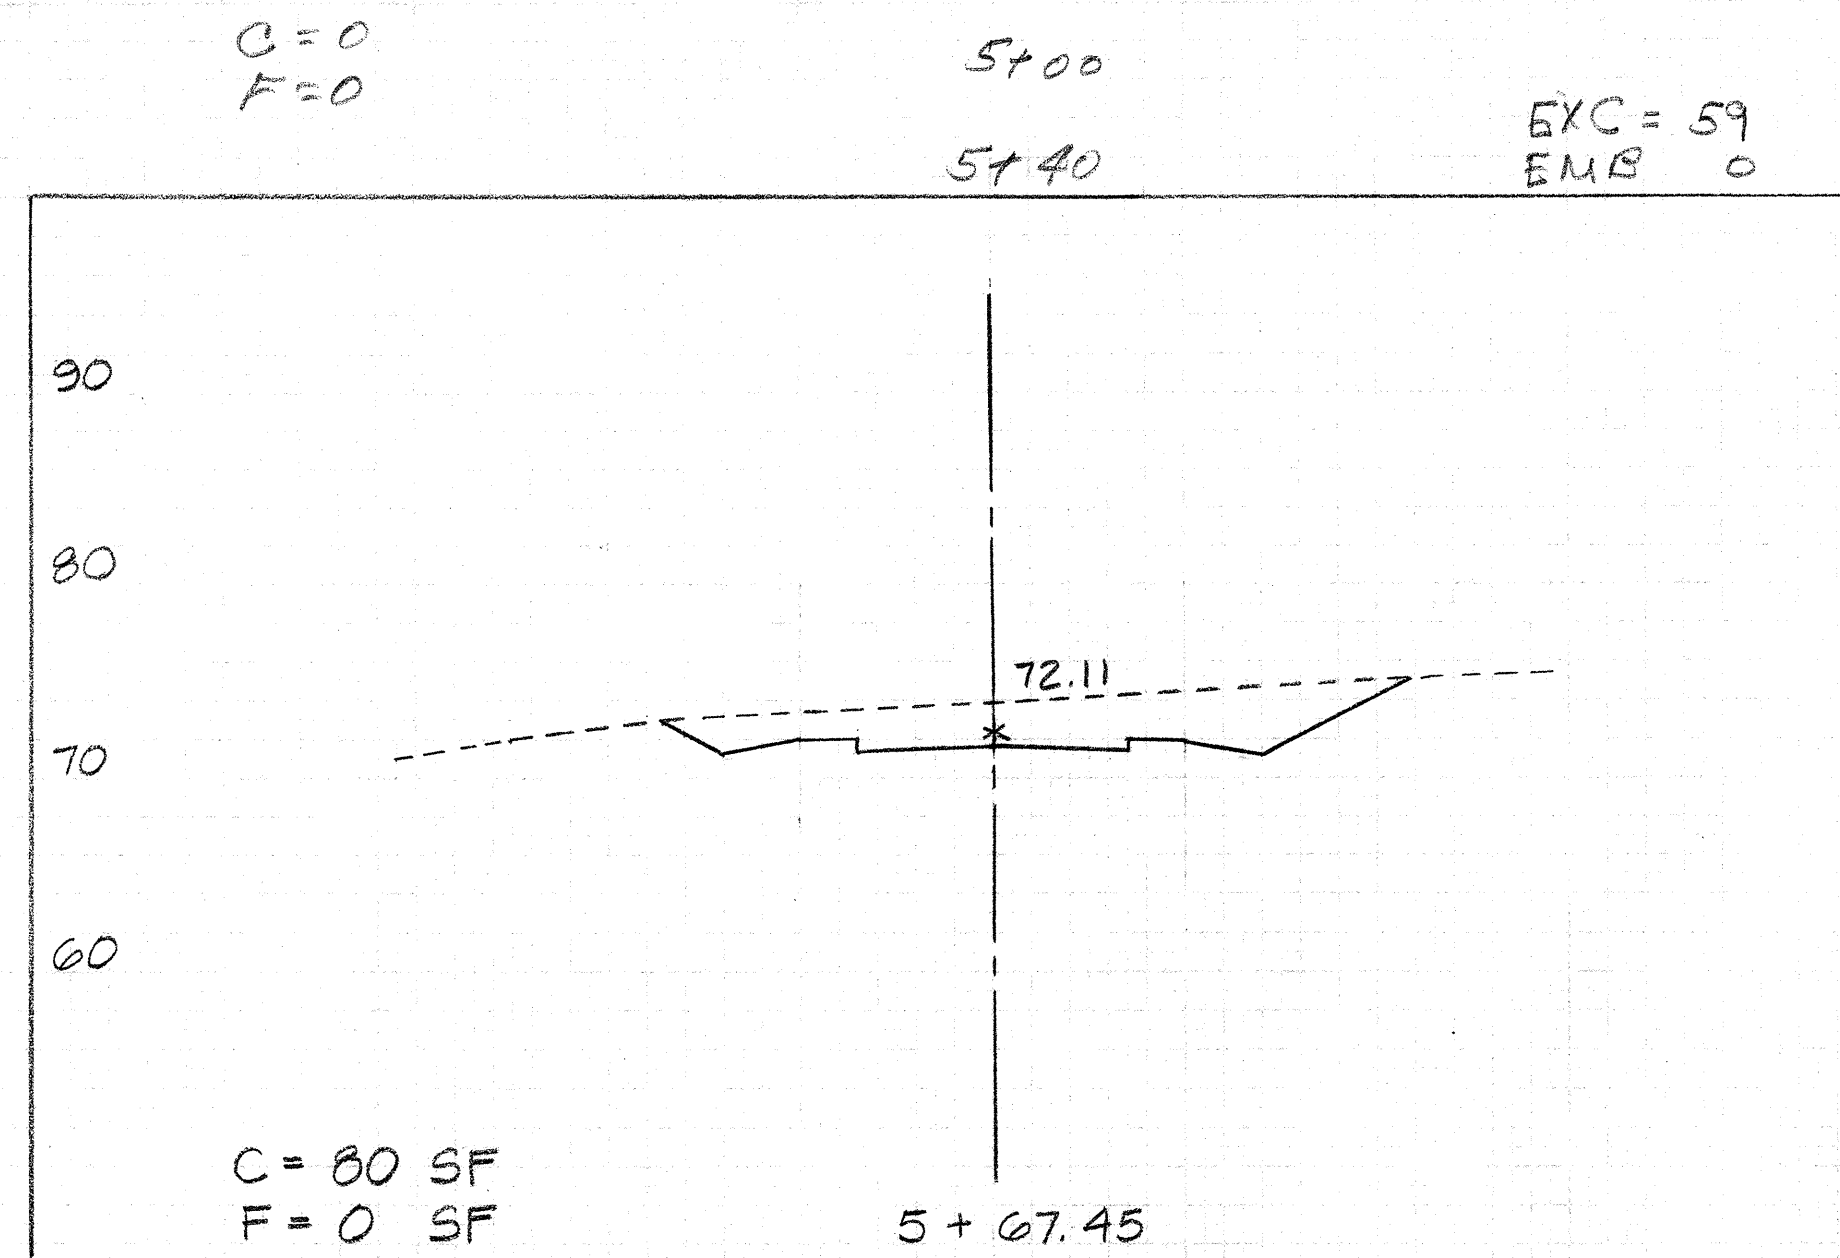

$\Sigma EXC = 3723$
 $\Sigma EMB = 4$
 Access Rd. Int. 277+50
 Lt. Side

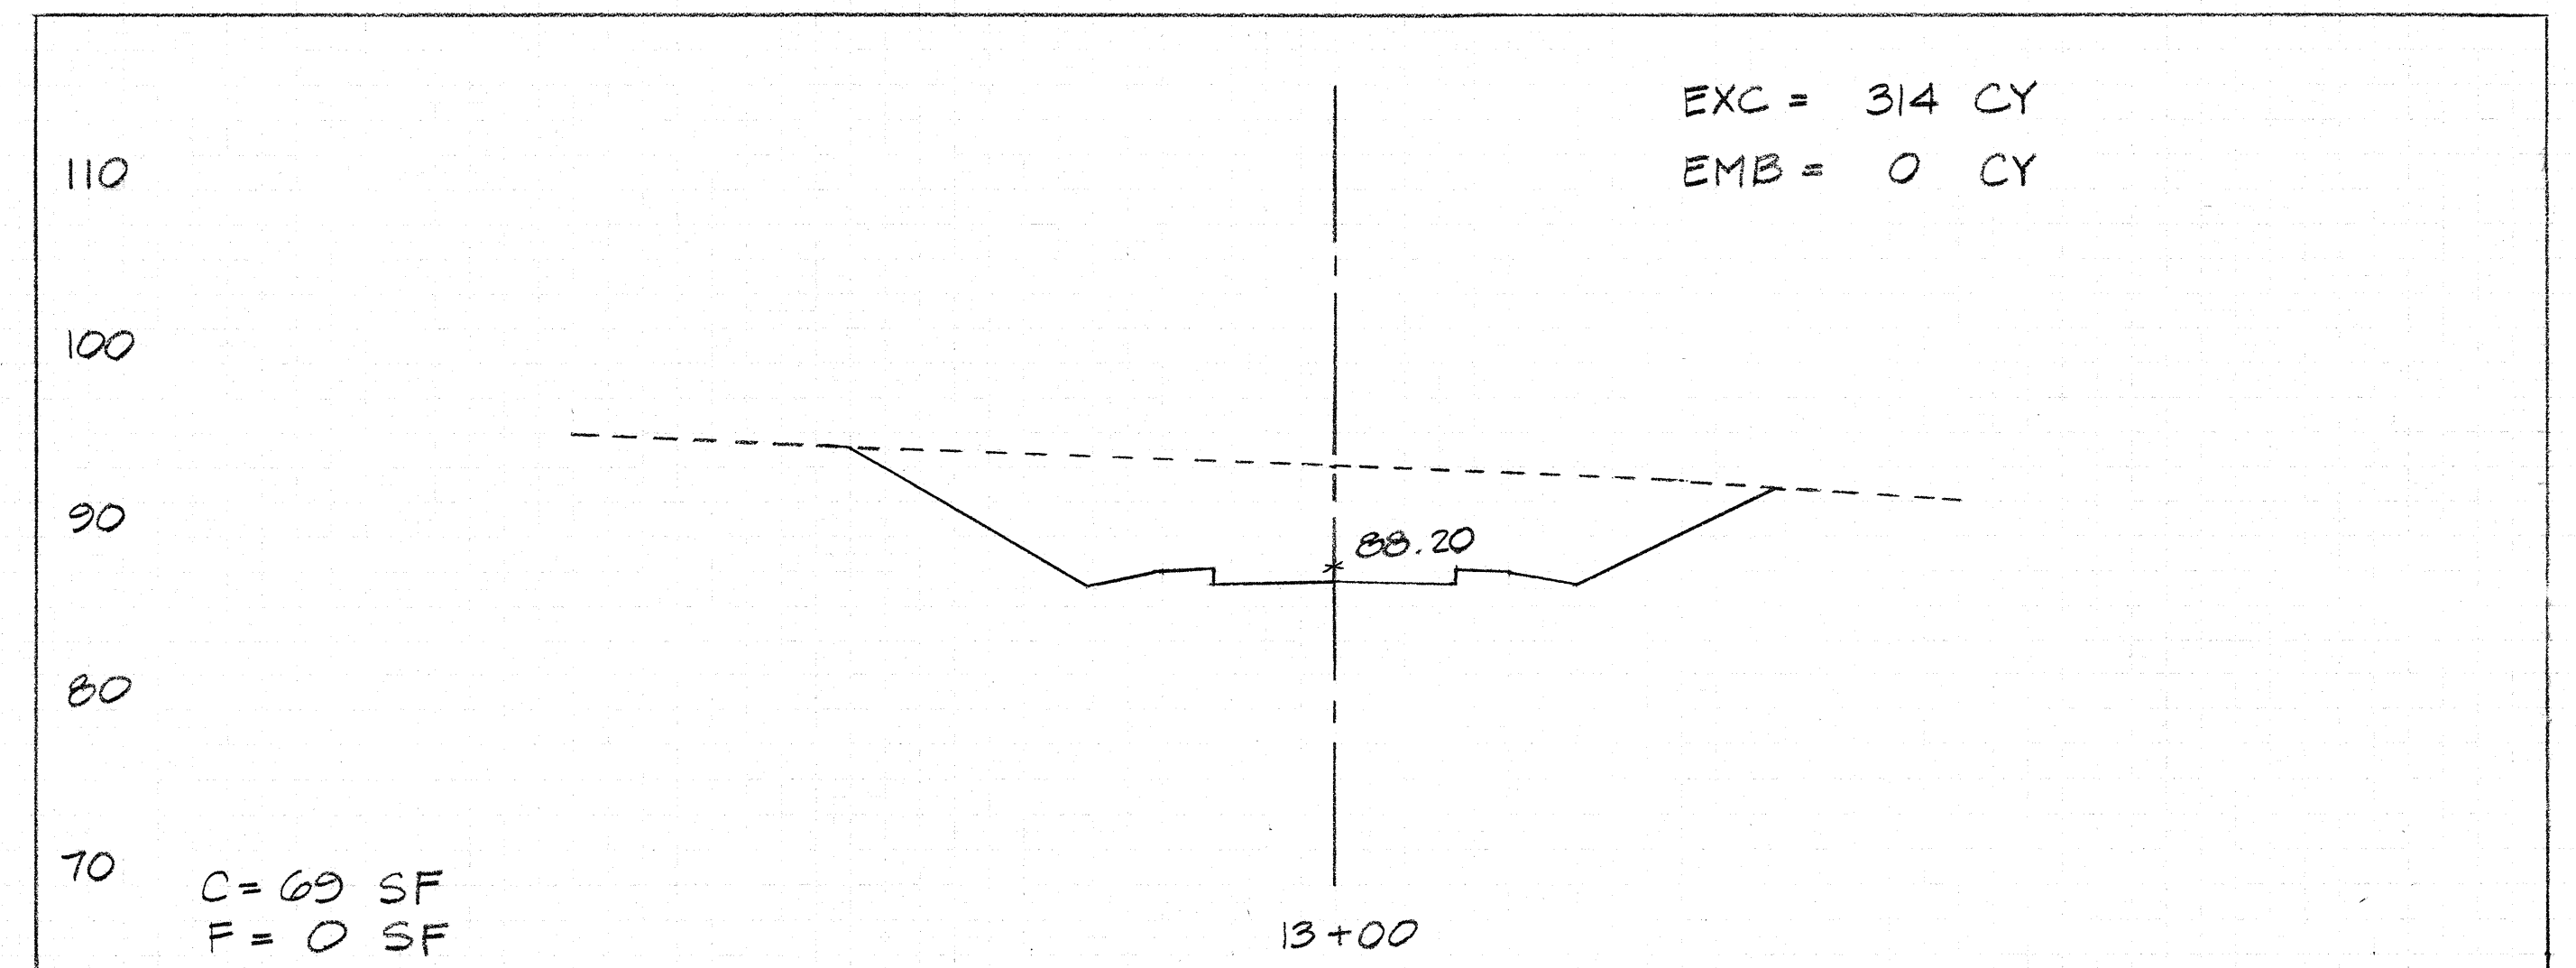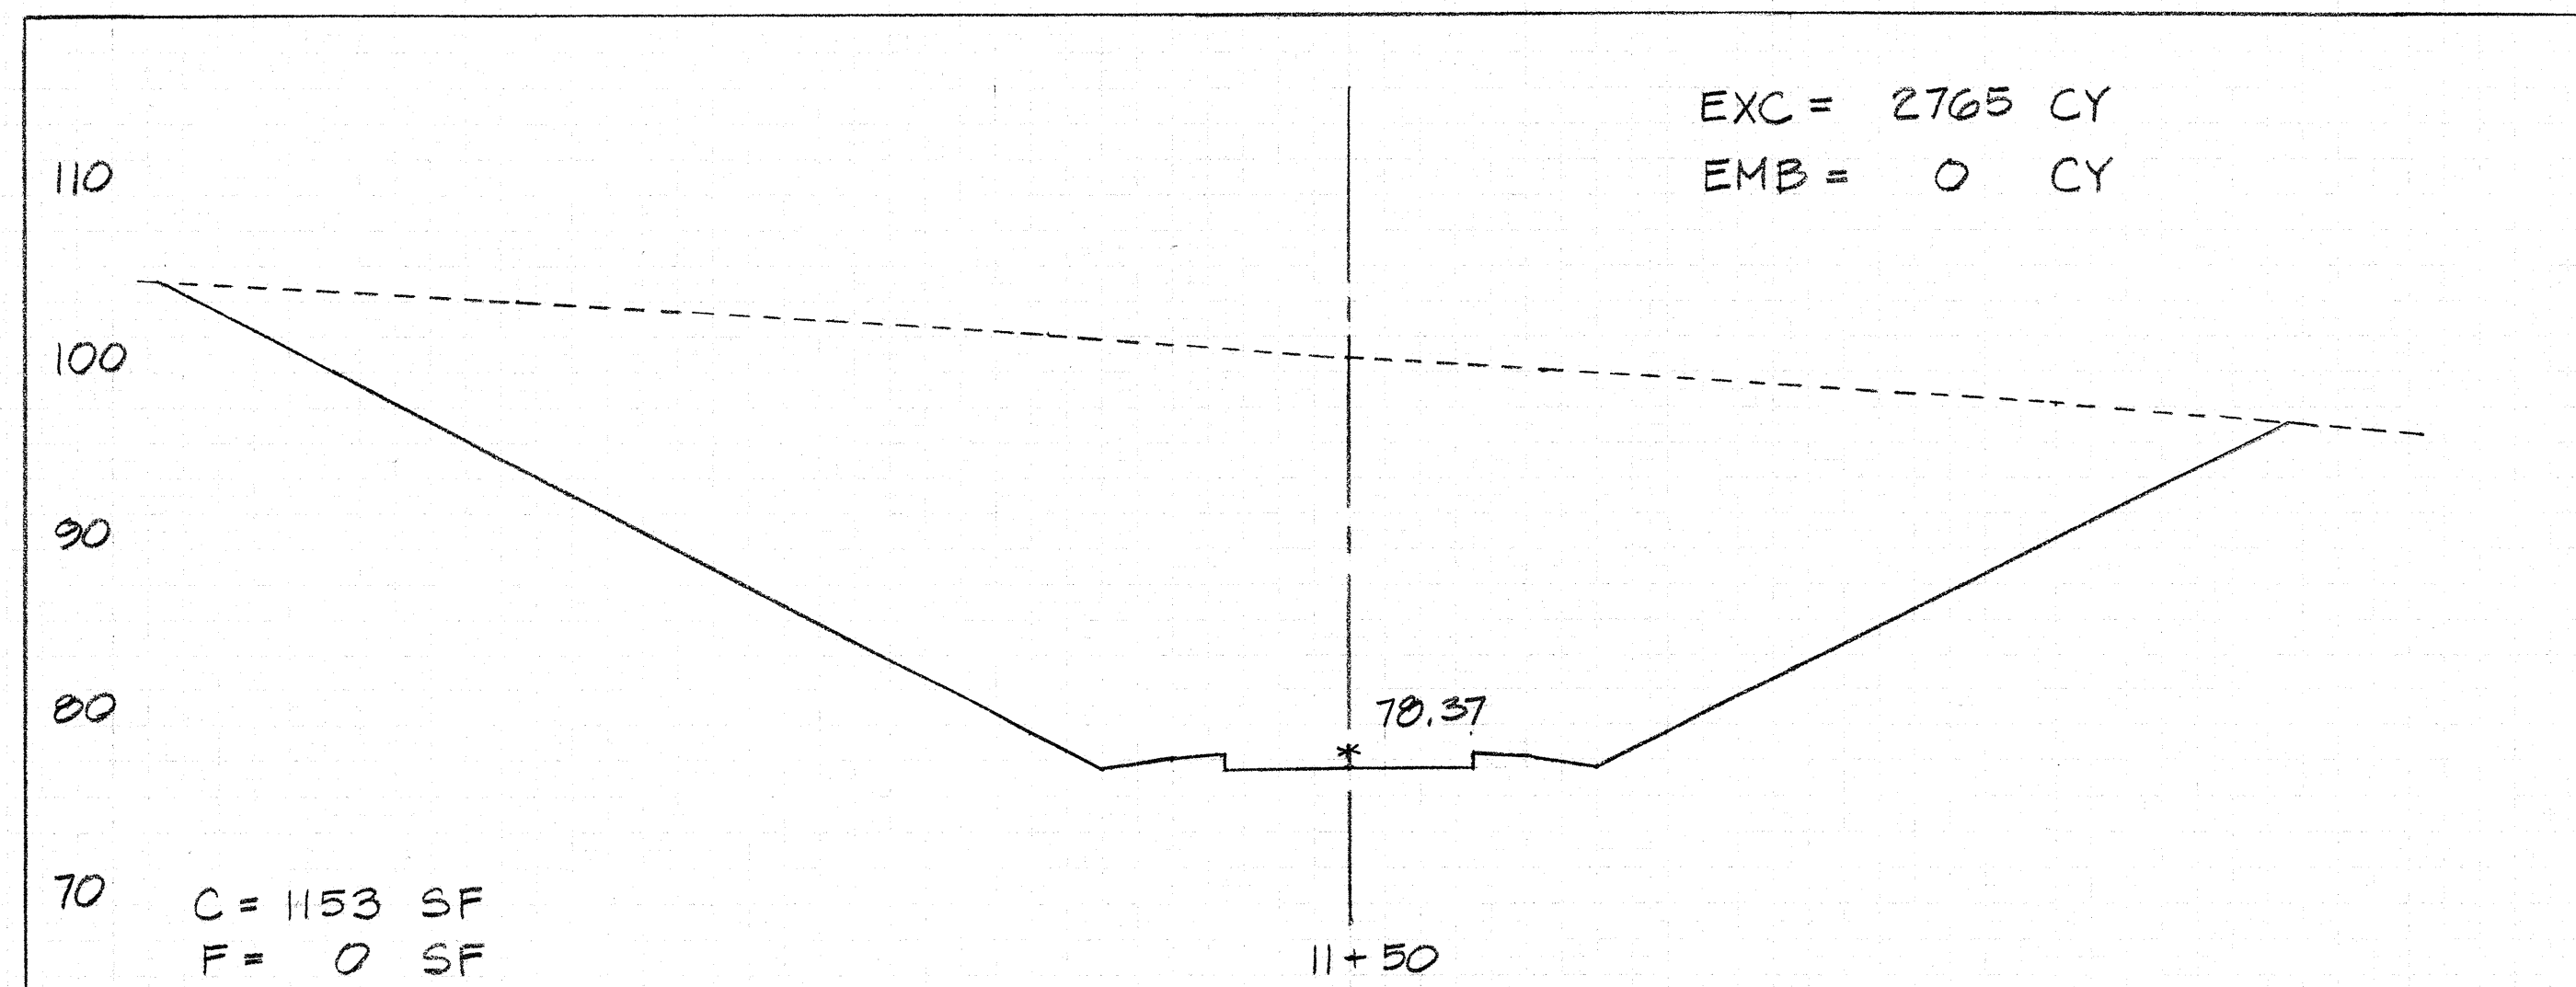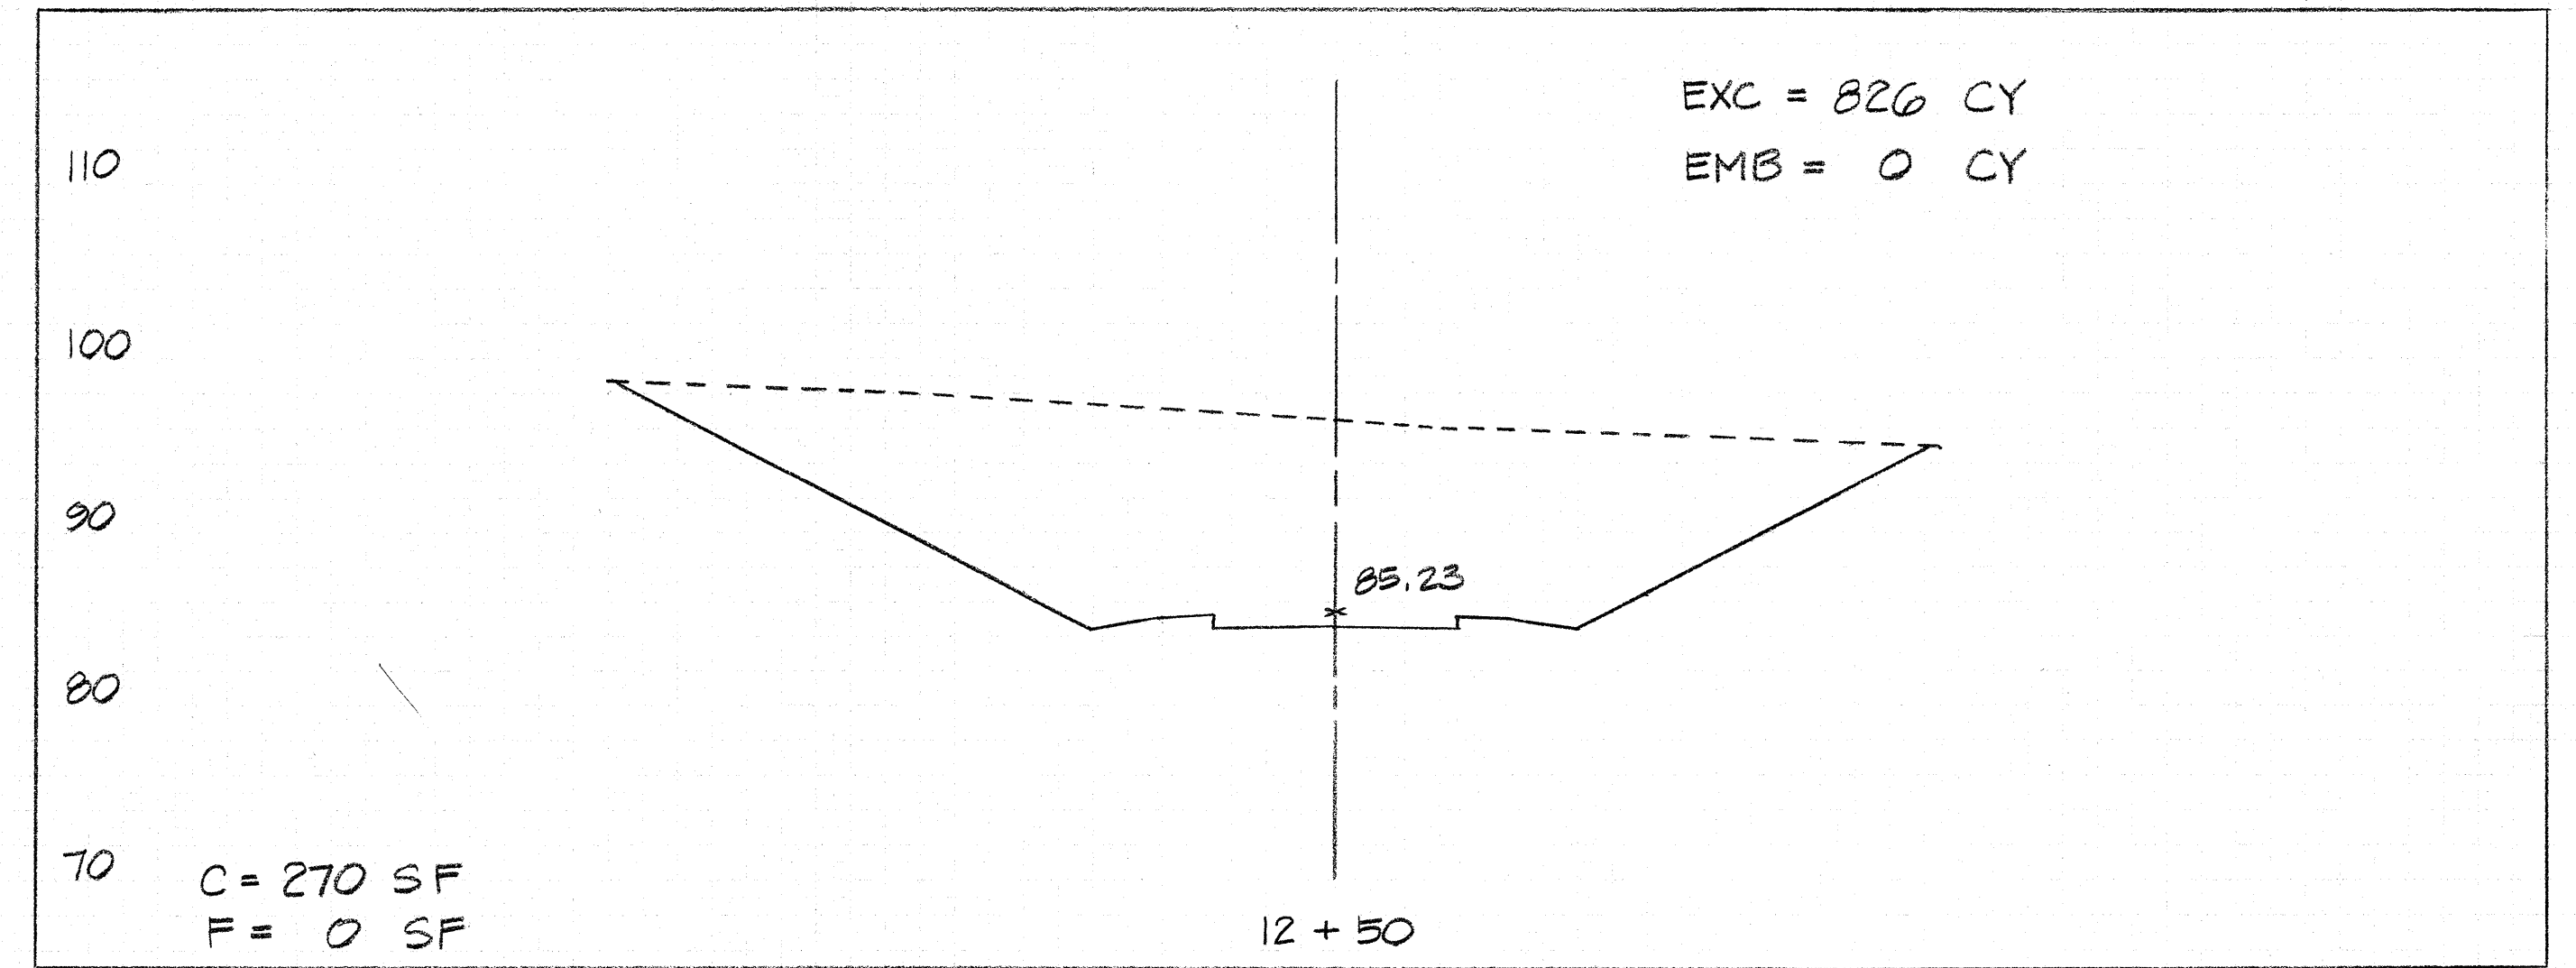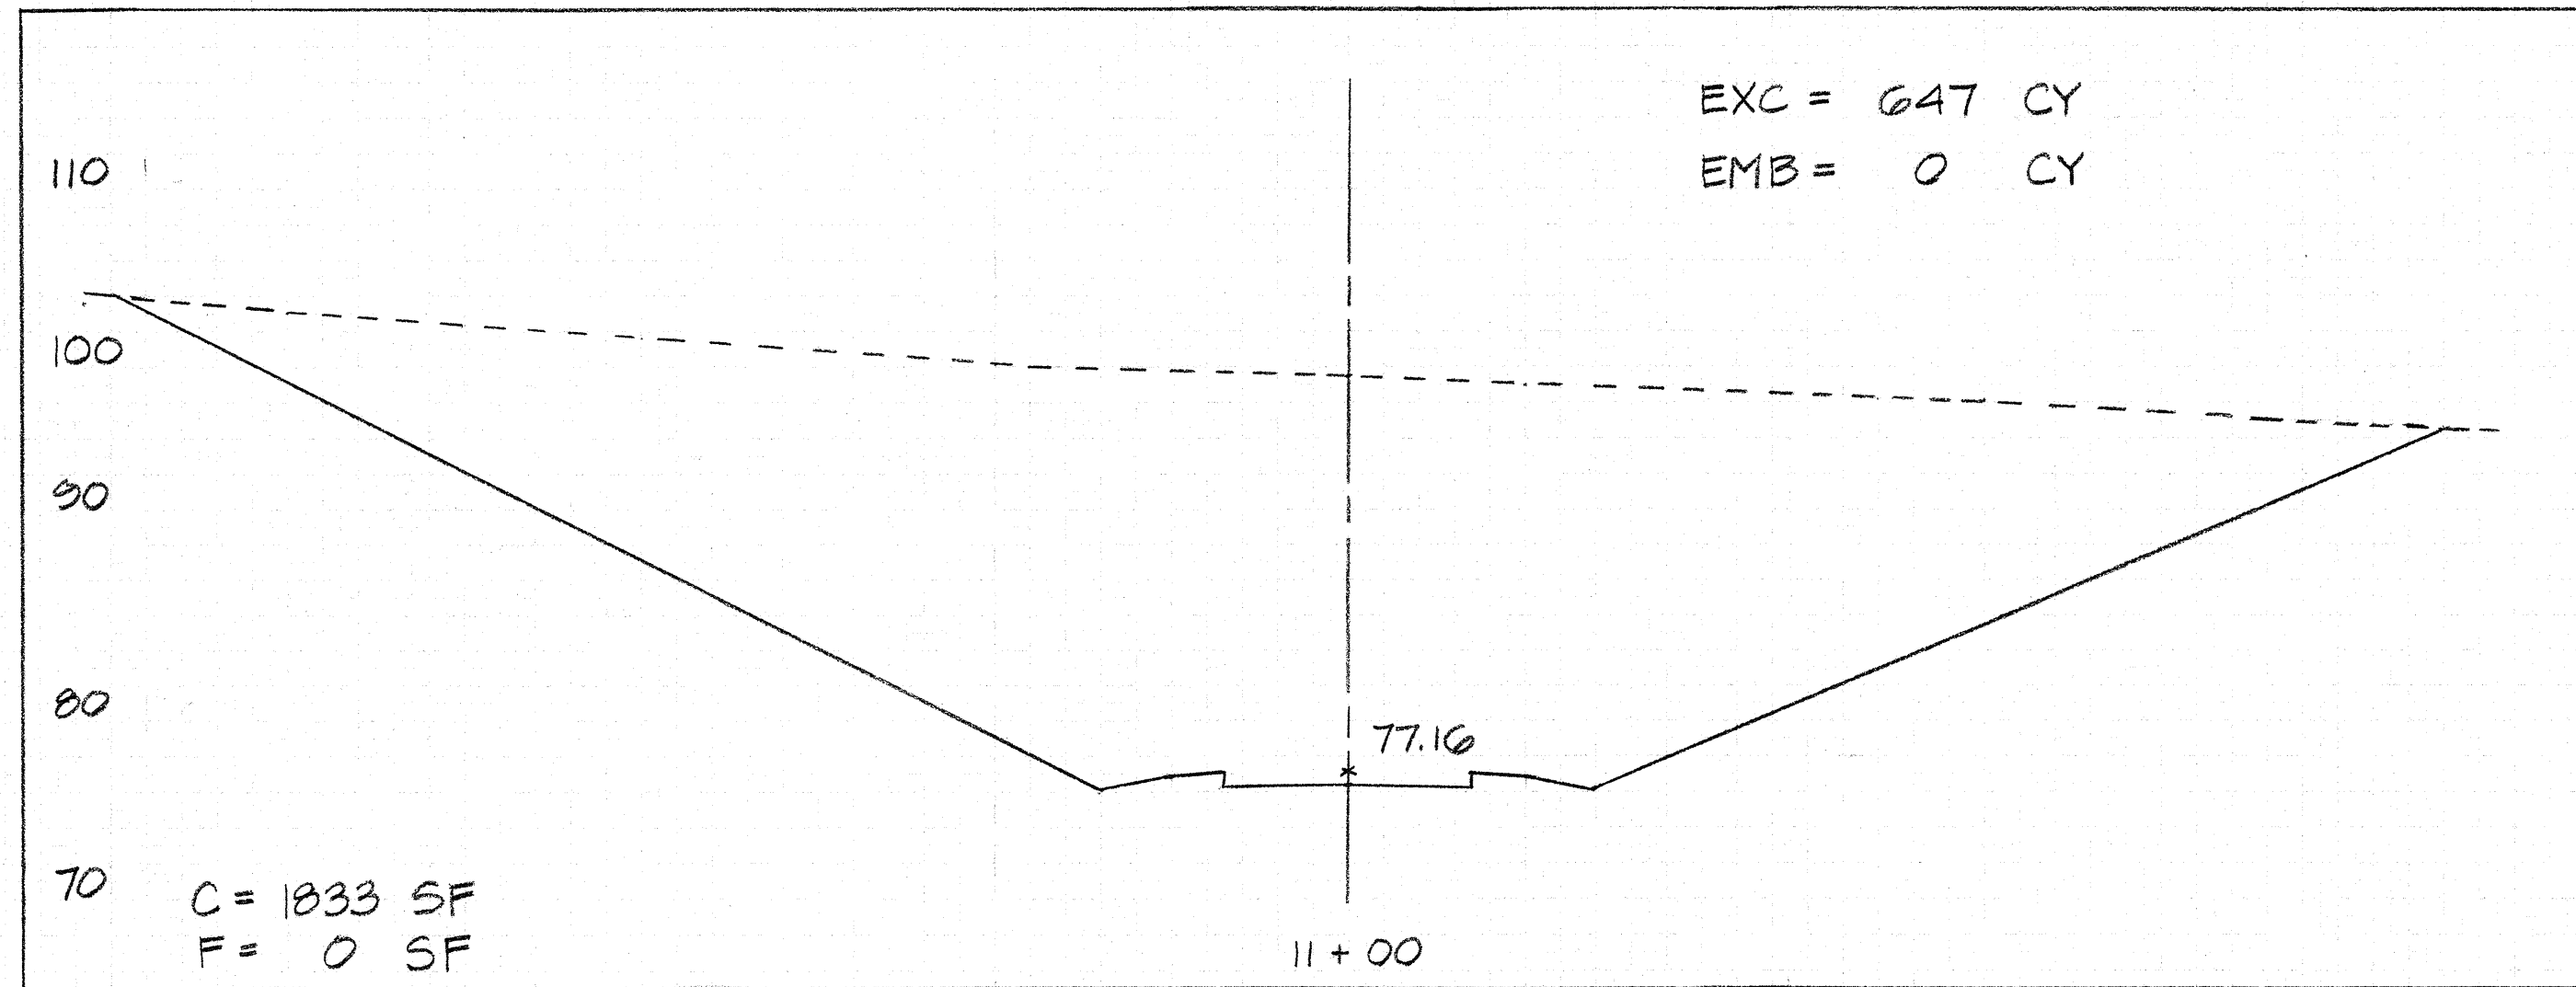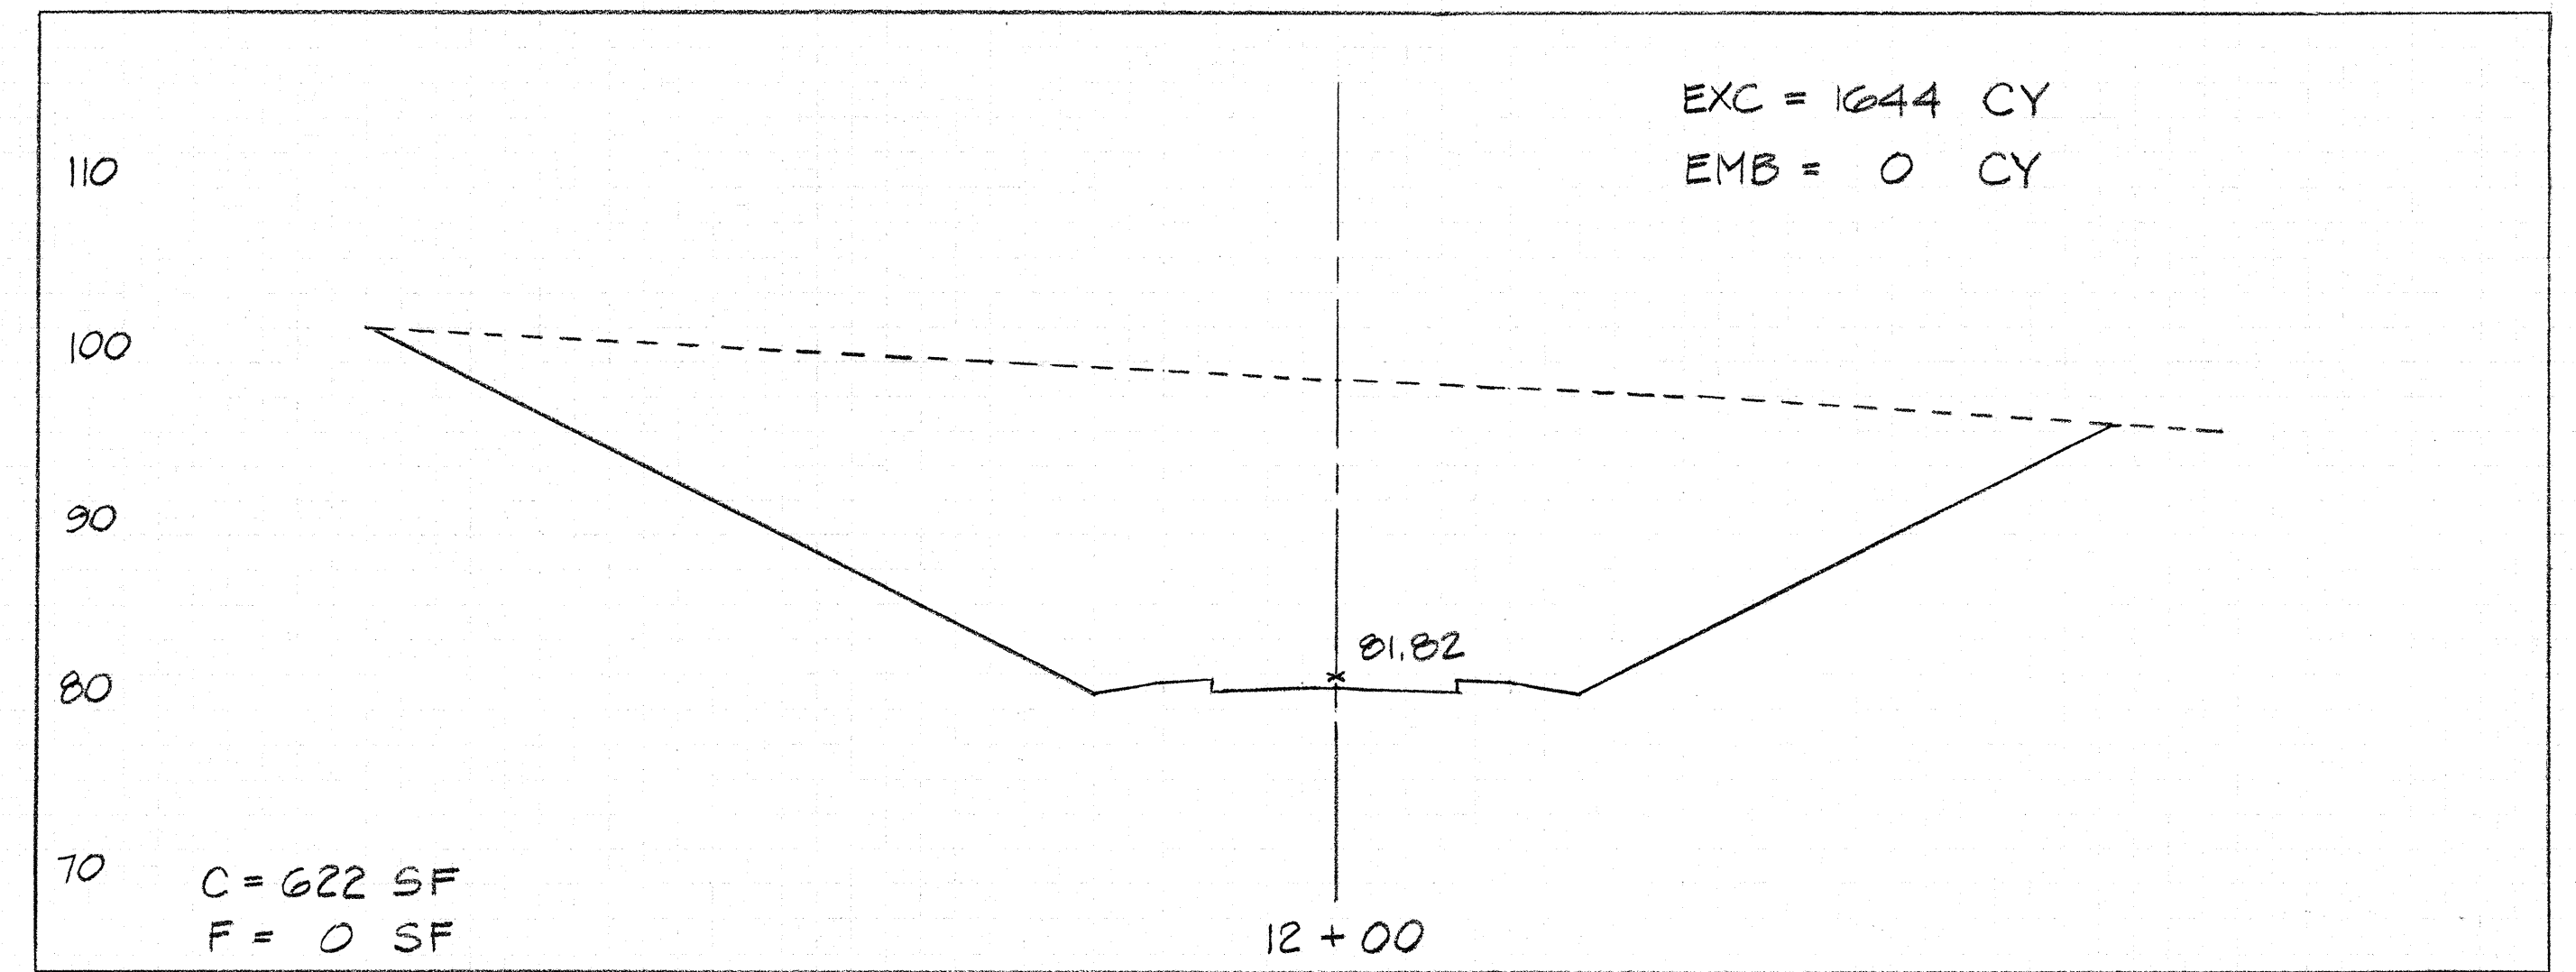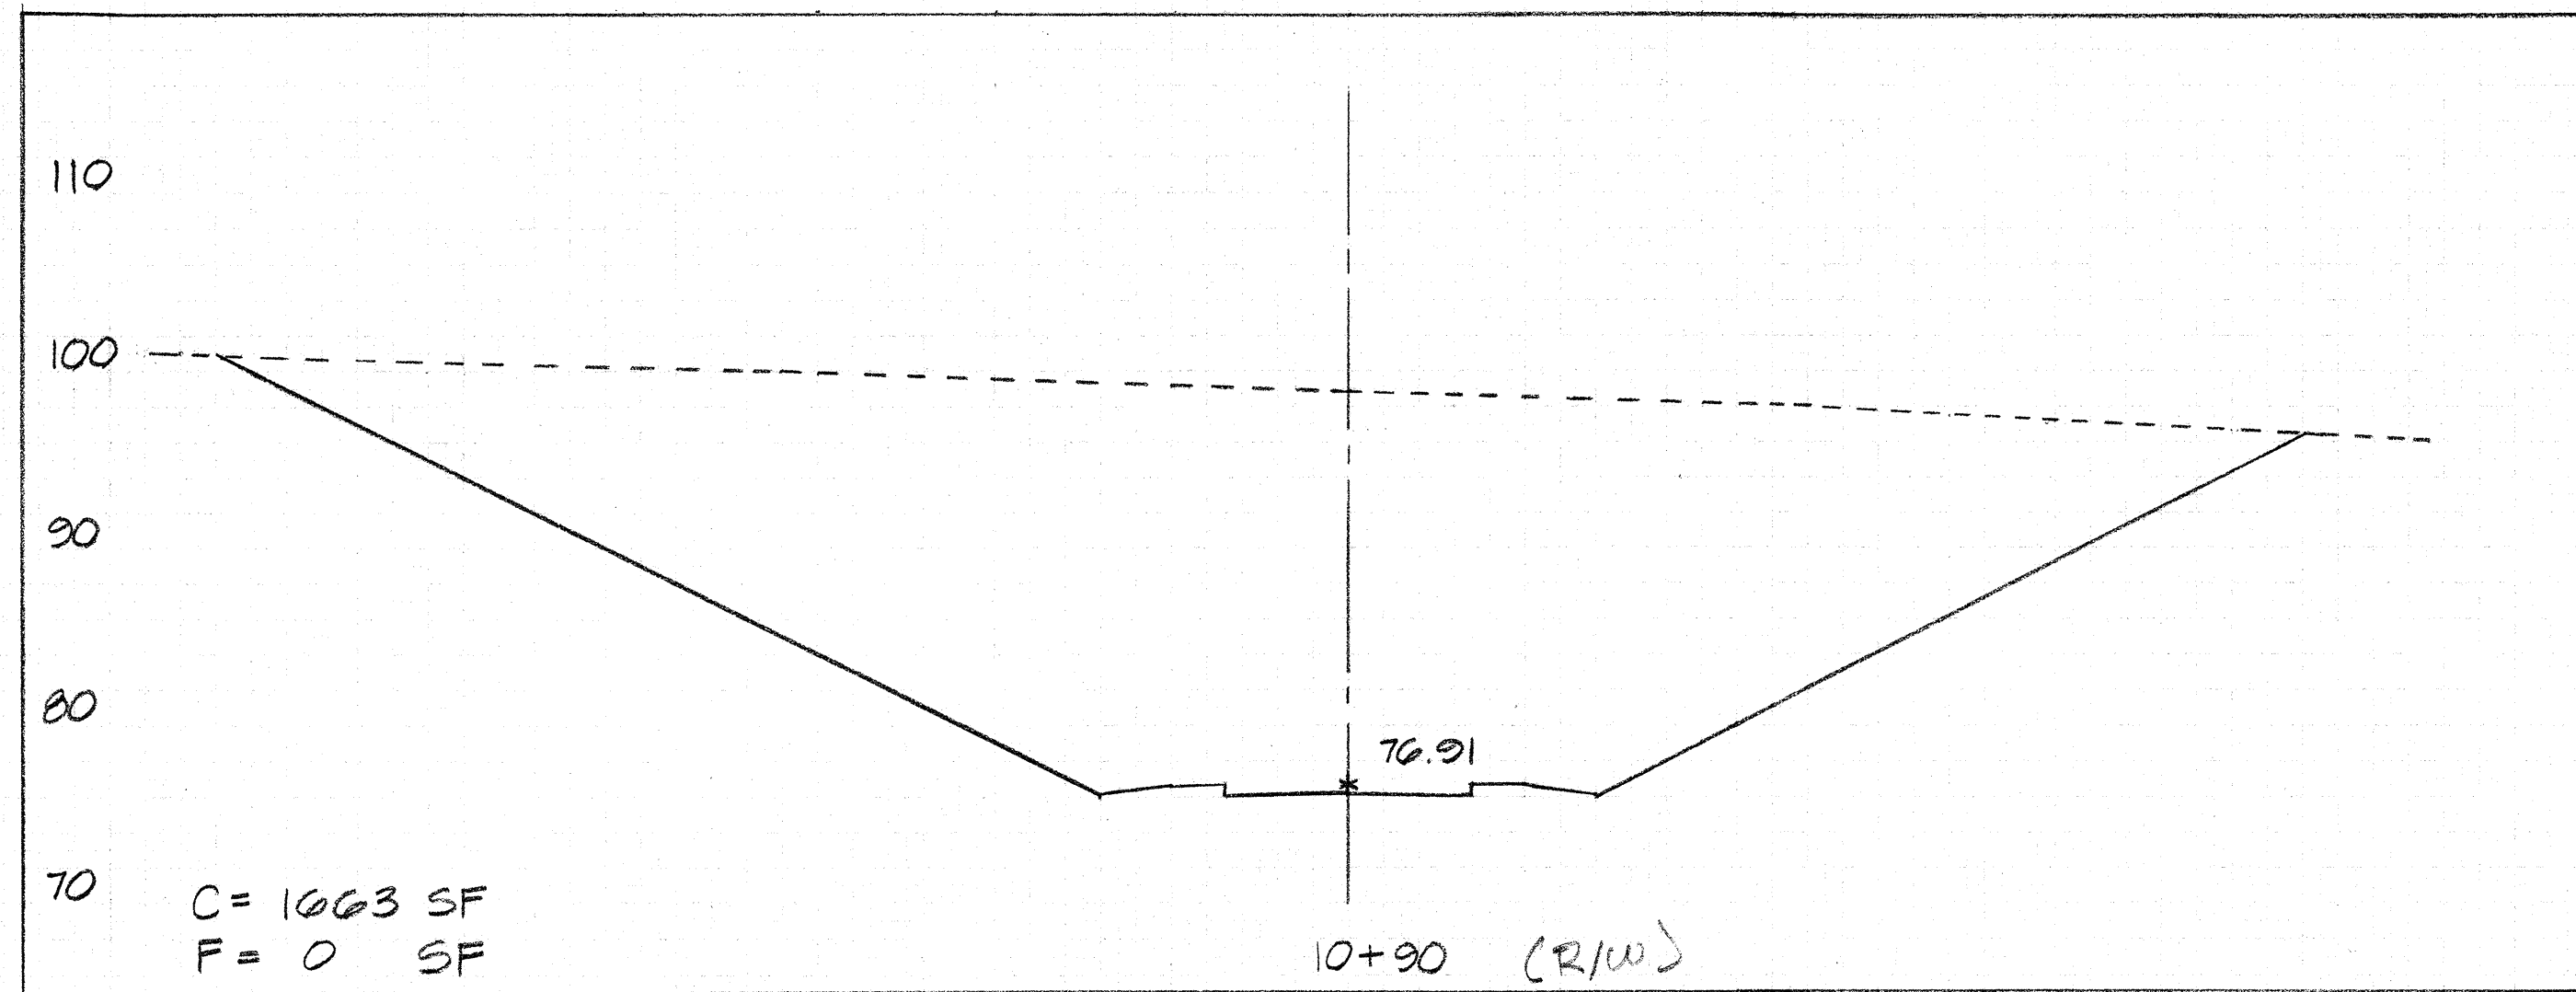

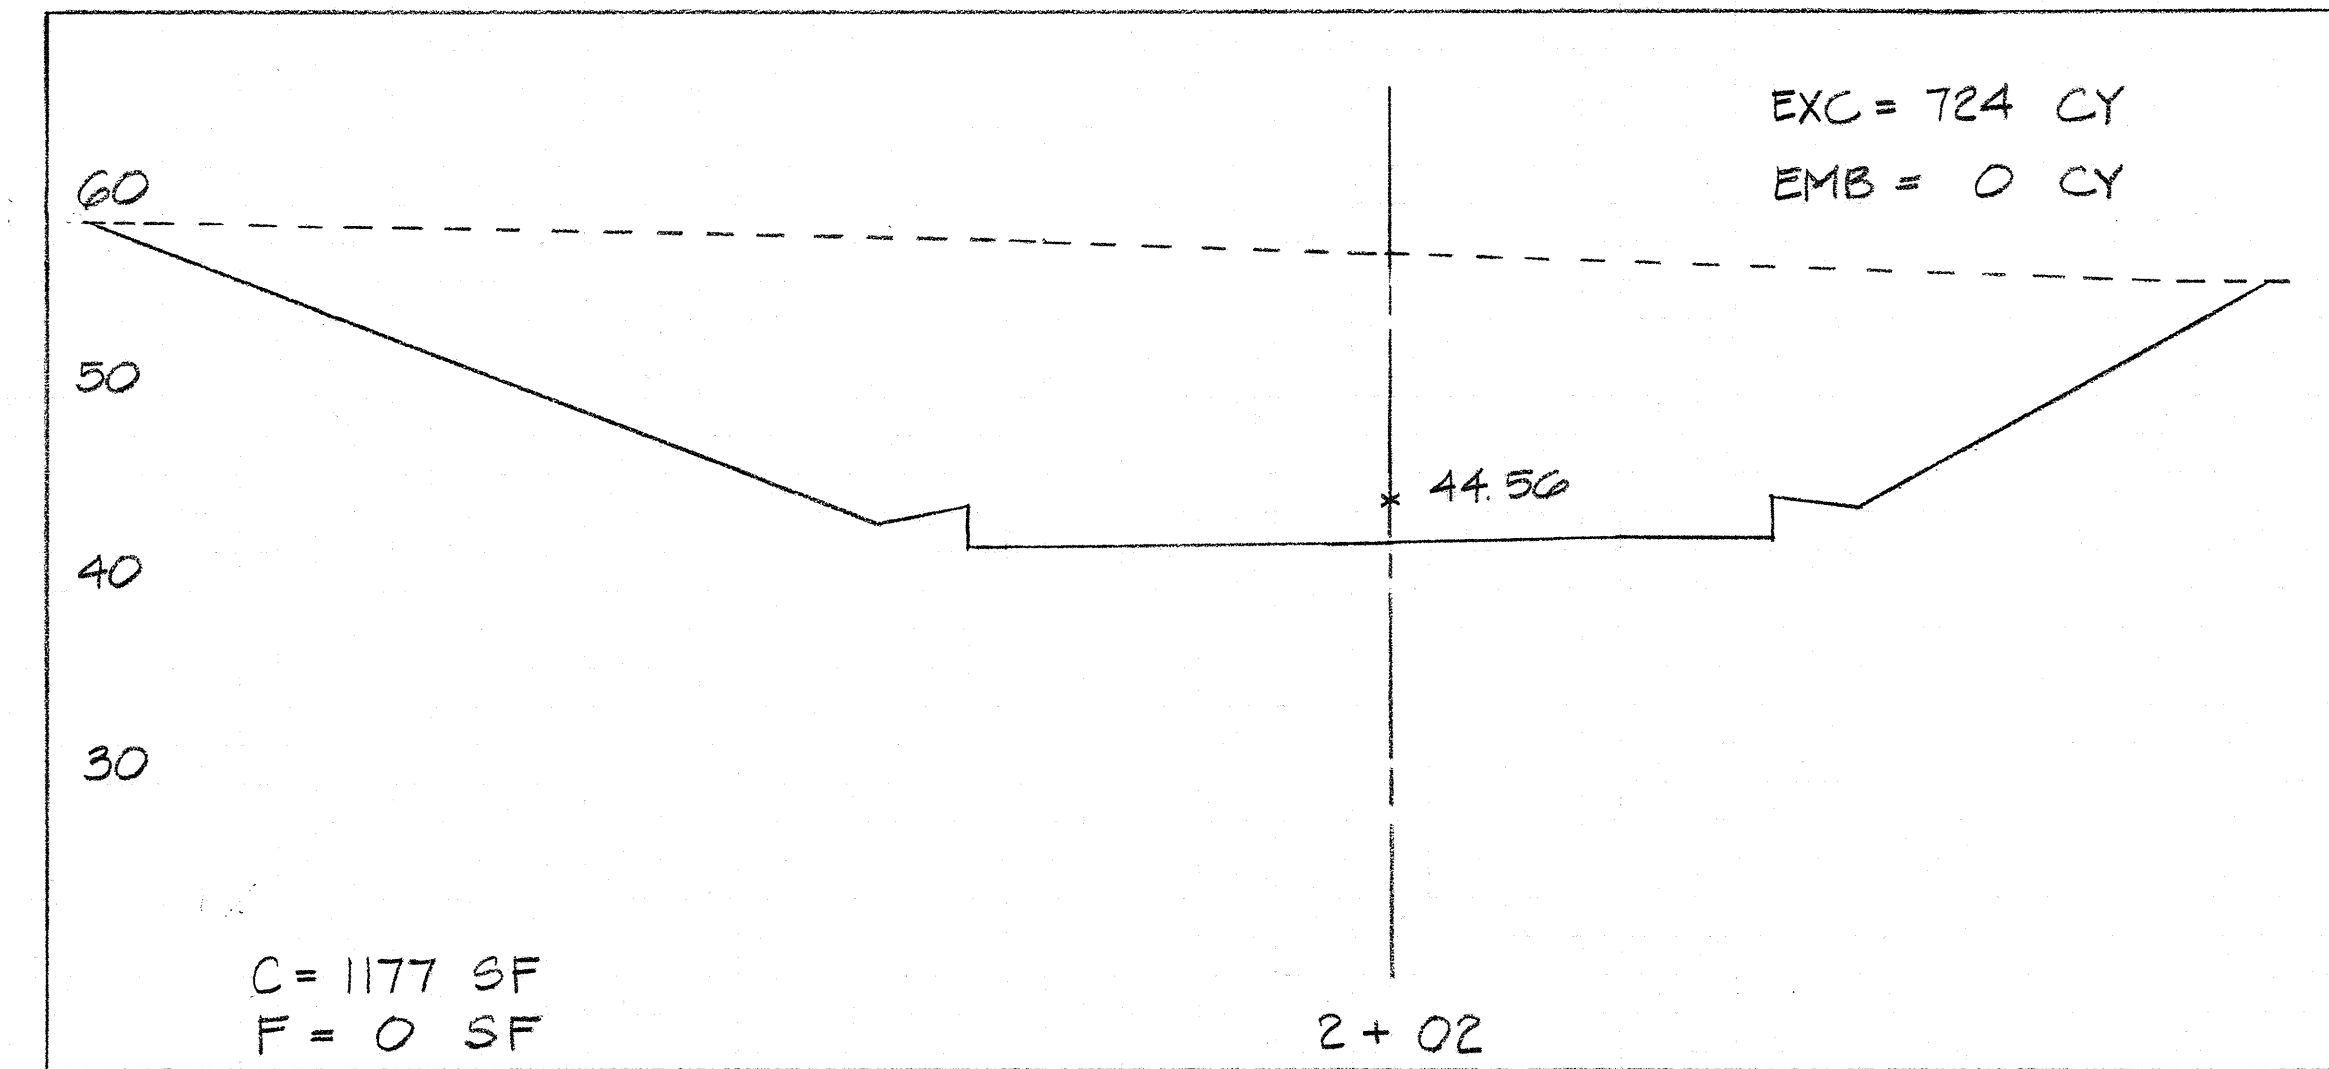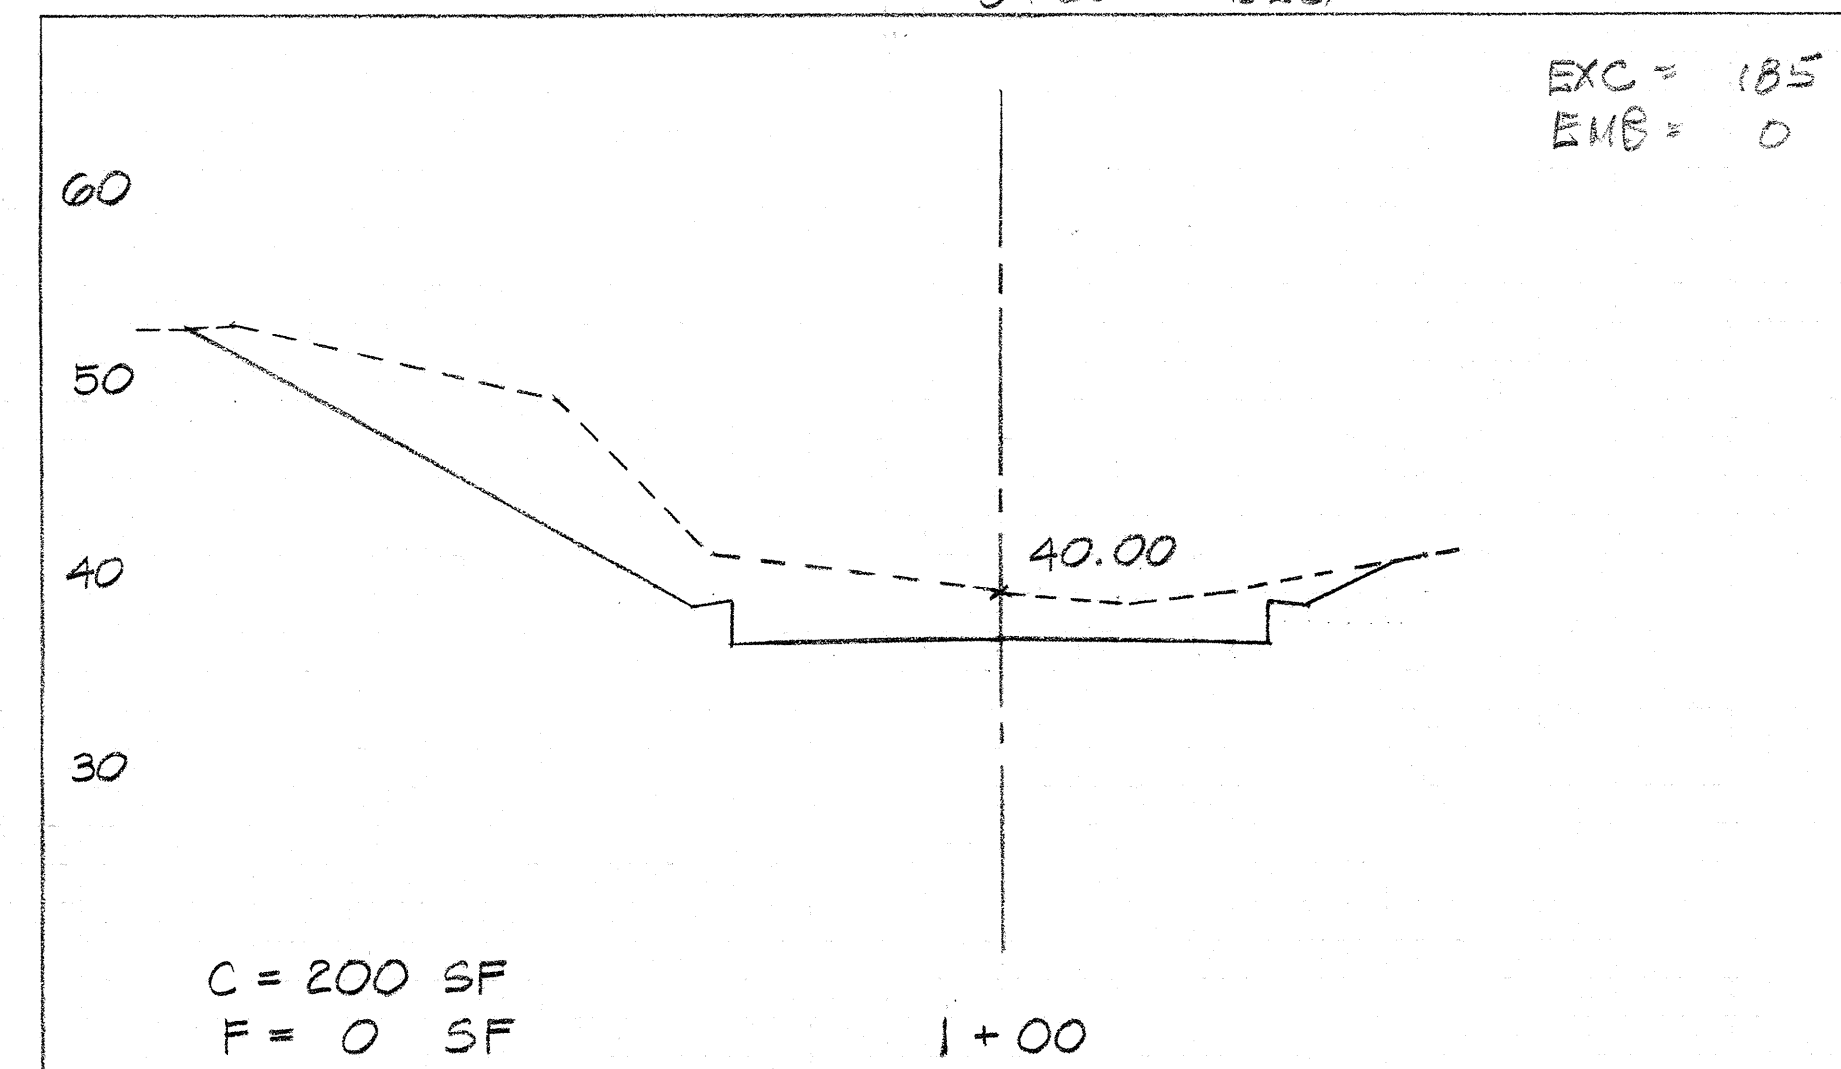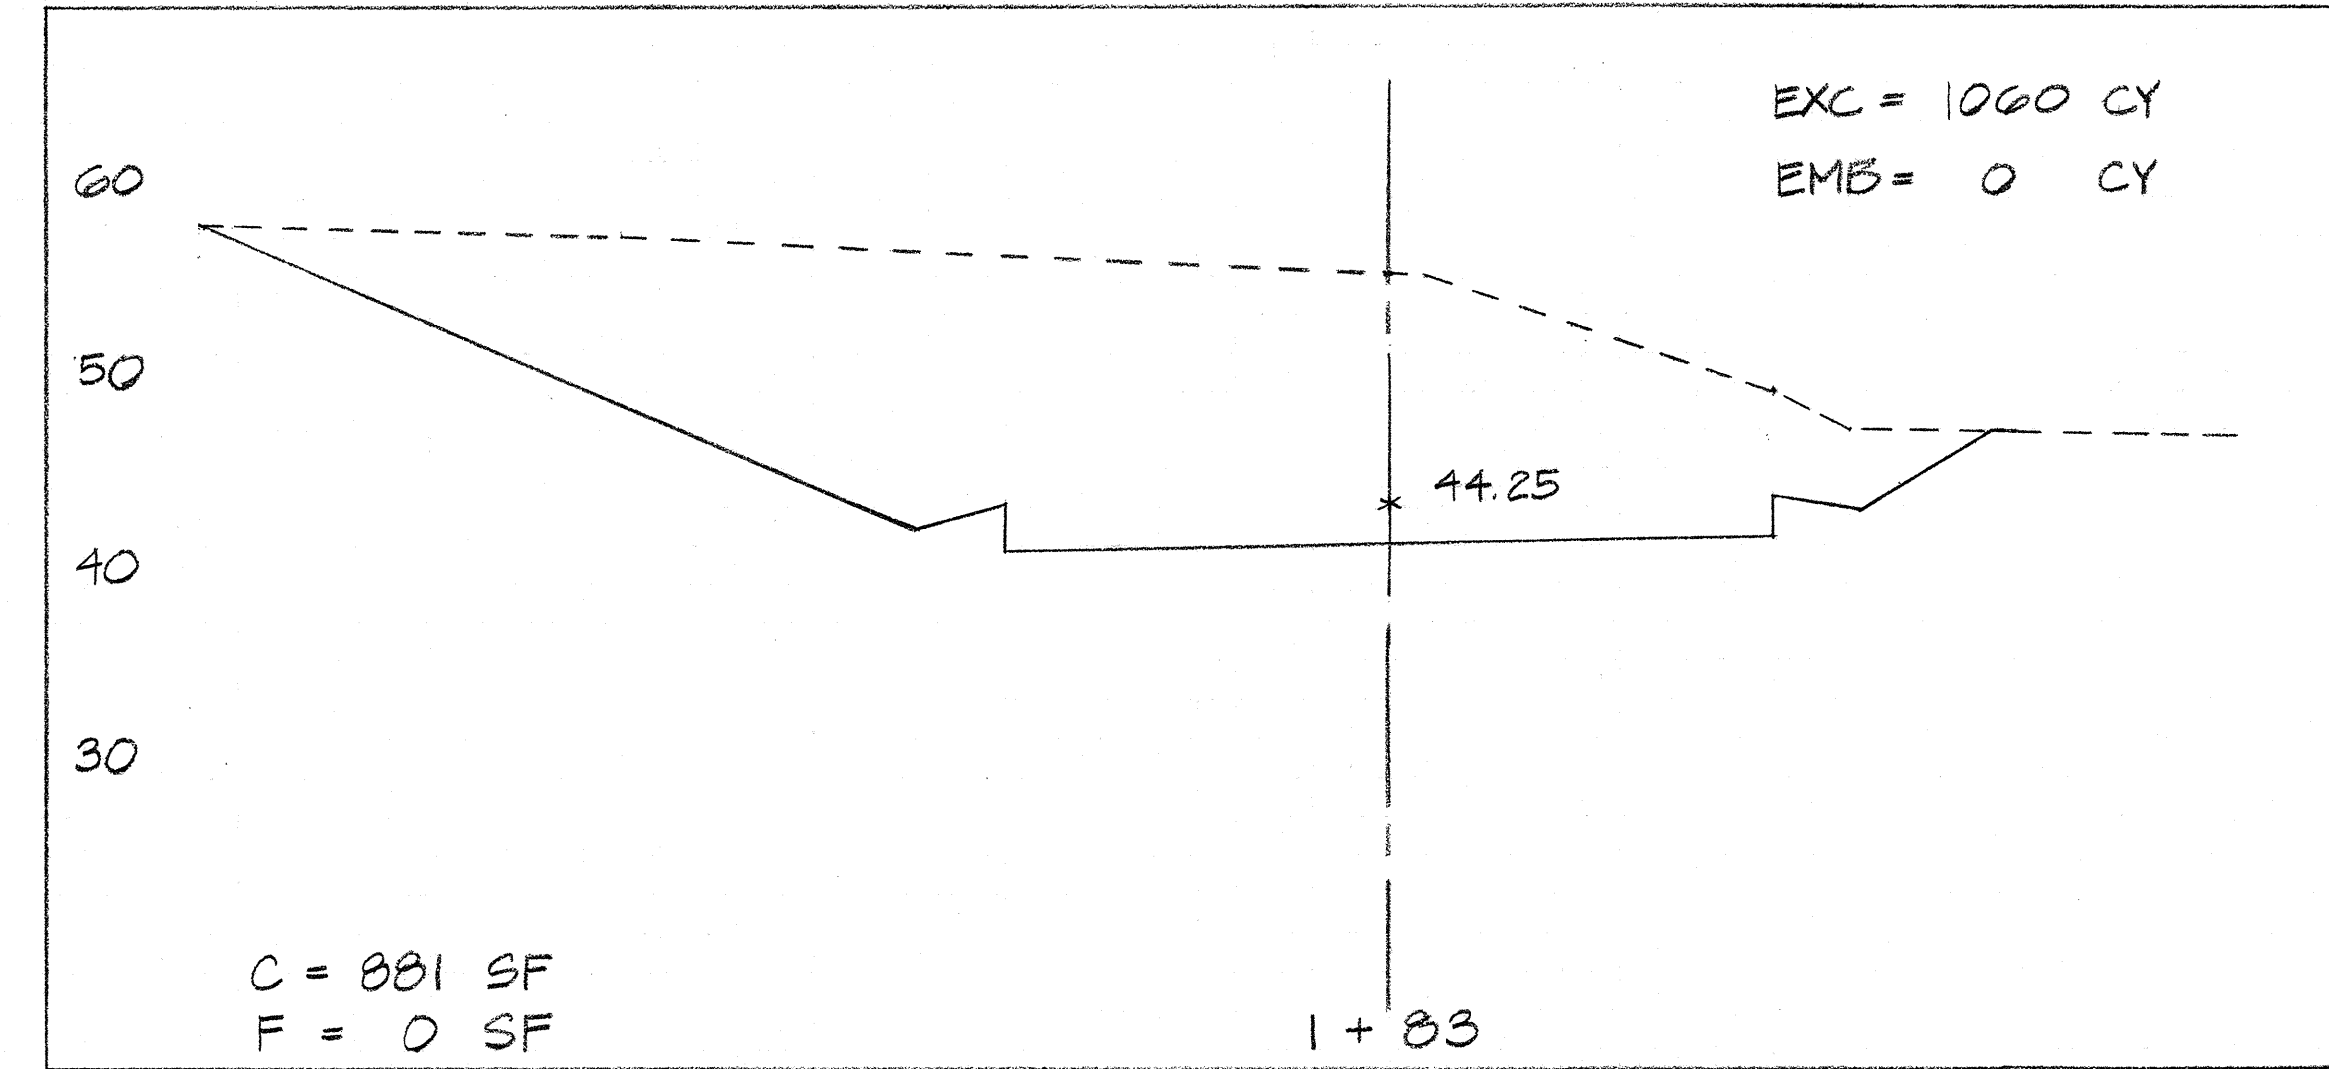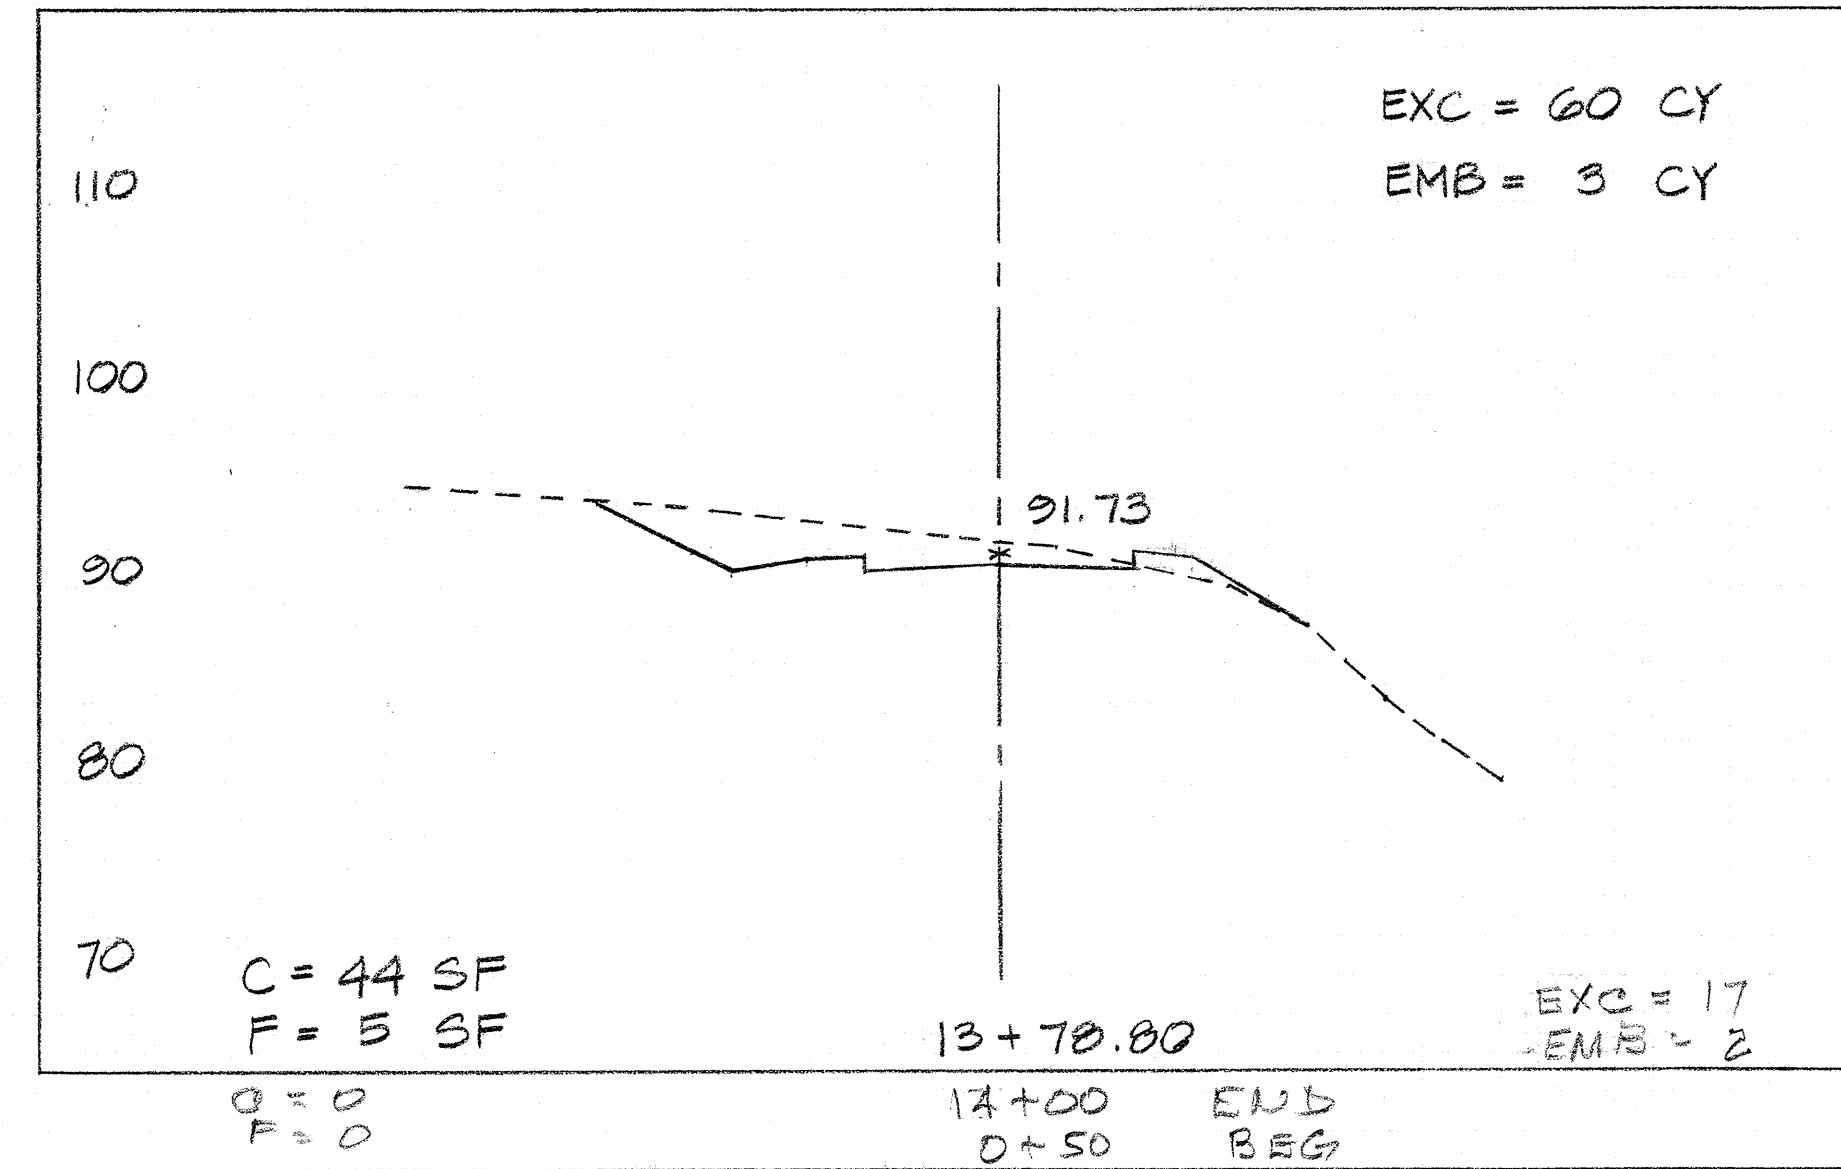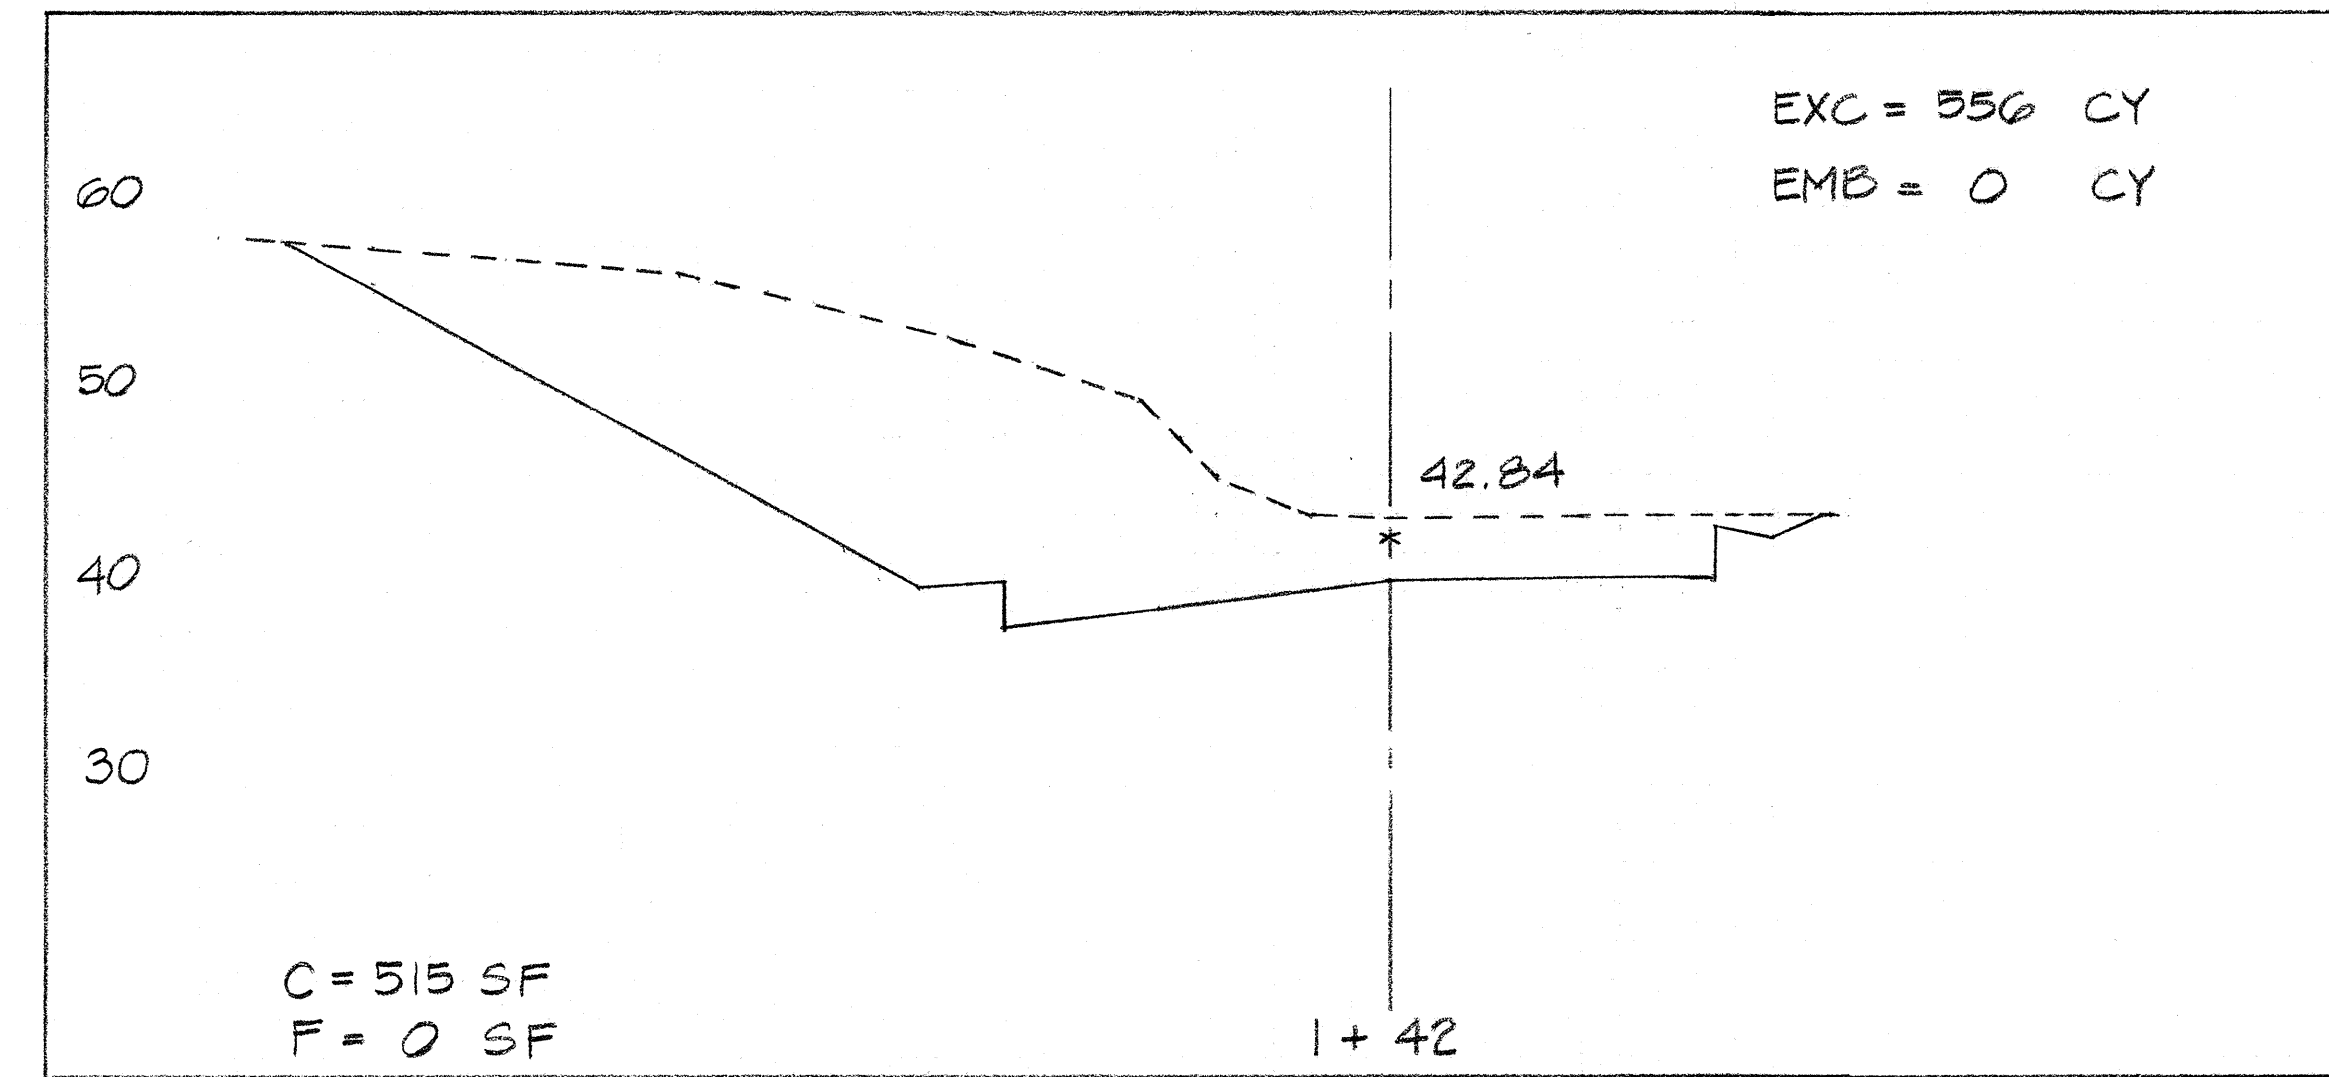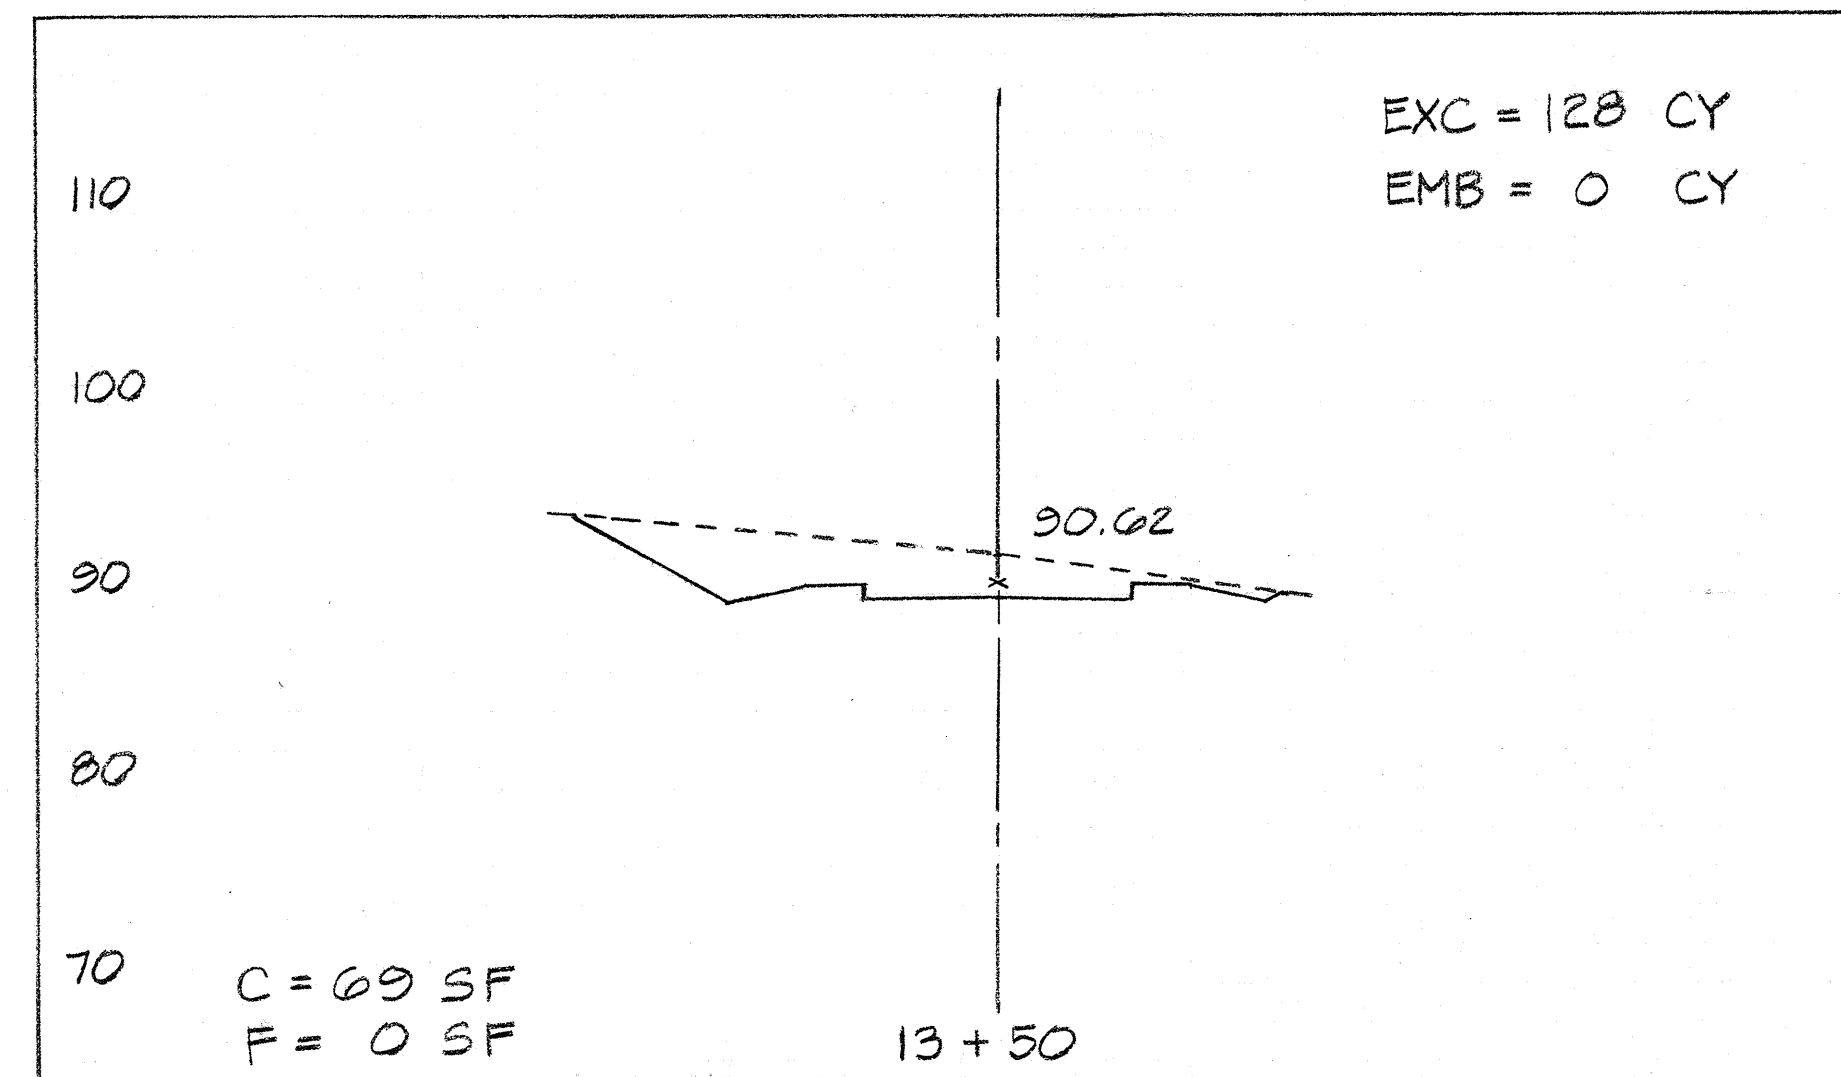

TOTAL EXC = 10,124
EMB = 7

Σ EXC = 6401
Σ EMB = 5

Σ EXC = 2525
Σ EMB = 0