

[illegible]

STATE OF HAWAII

DEPARTMENT OF TRANSPORTATION

HIGHWAYS DIVISION

"AS BUILT" PLANS OF

HONOAPIILANI HIGHWAY


GUARD RAIL AND SHOULDER IMPROVEMENTS

SECTION 30A - KAA NAPALI ROAD TO HONOKOWAI


SECTION 30B - FLEMING ROAD TO DICKENSON STREET

PROJECT NO. 30AB-02-85

FED. ROAD DIST. NO.	STATE	PROJ. NO.	FISCAL YEAR	SHEET NO.	TOTAL SHEETS
HAWAII	HAW.	30AB-02-85	1985	1	30

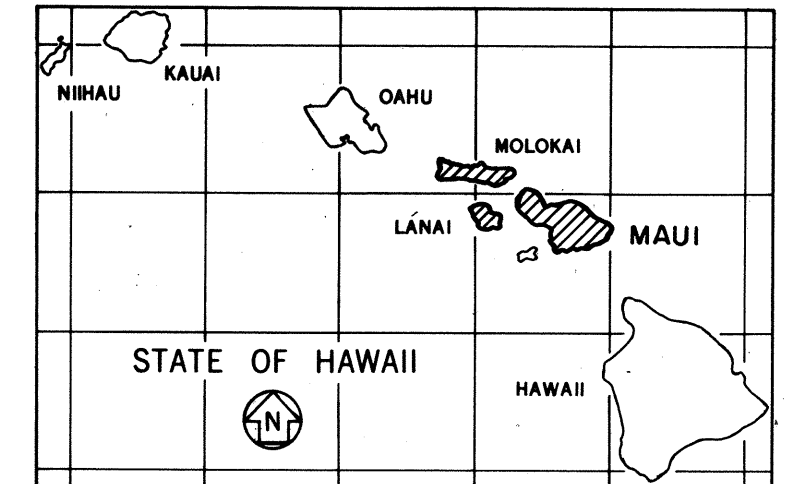FEDERAL AID PROJECTS PREVIOUSLY CONSTRUCTED
OR UNDER CONSTRUCTION

Manuel J. Silva
RESIDENT ENGINEER

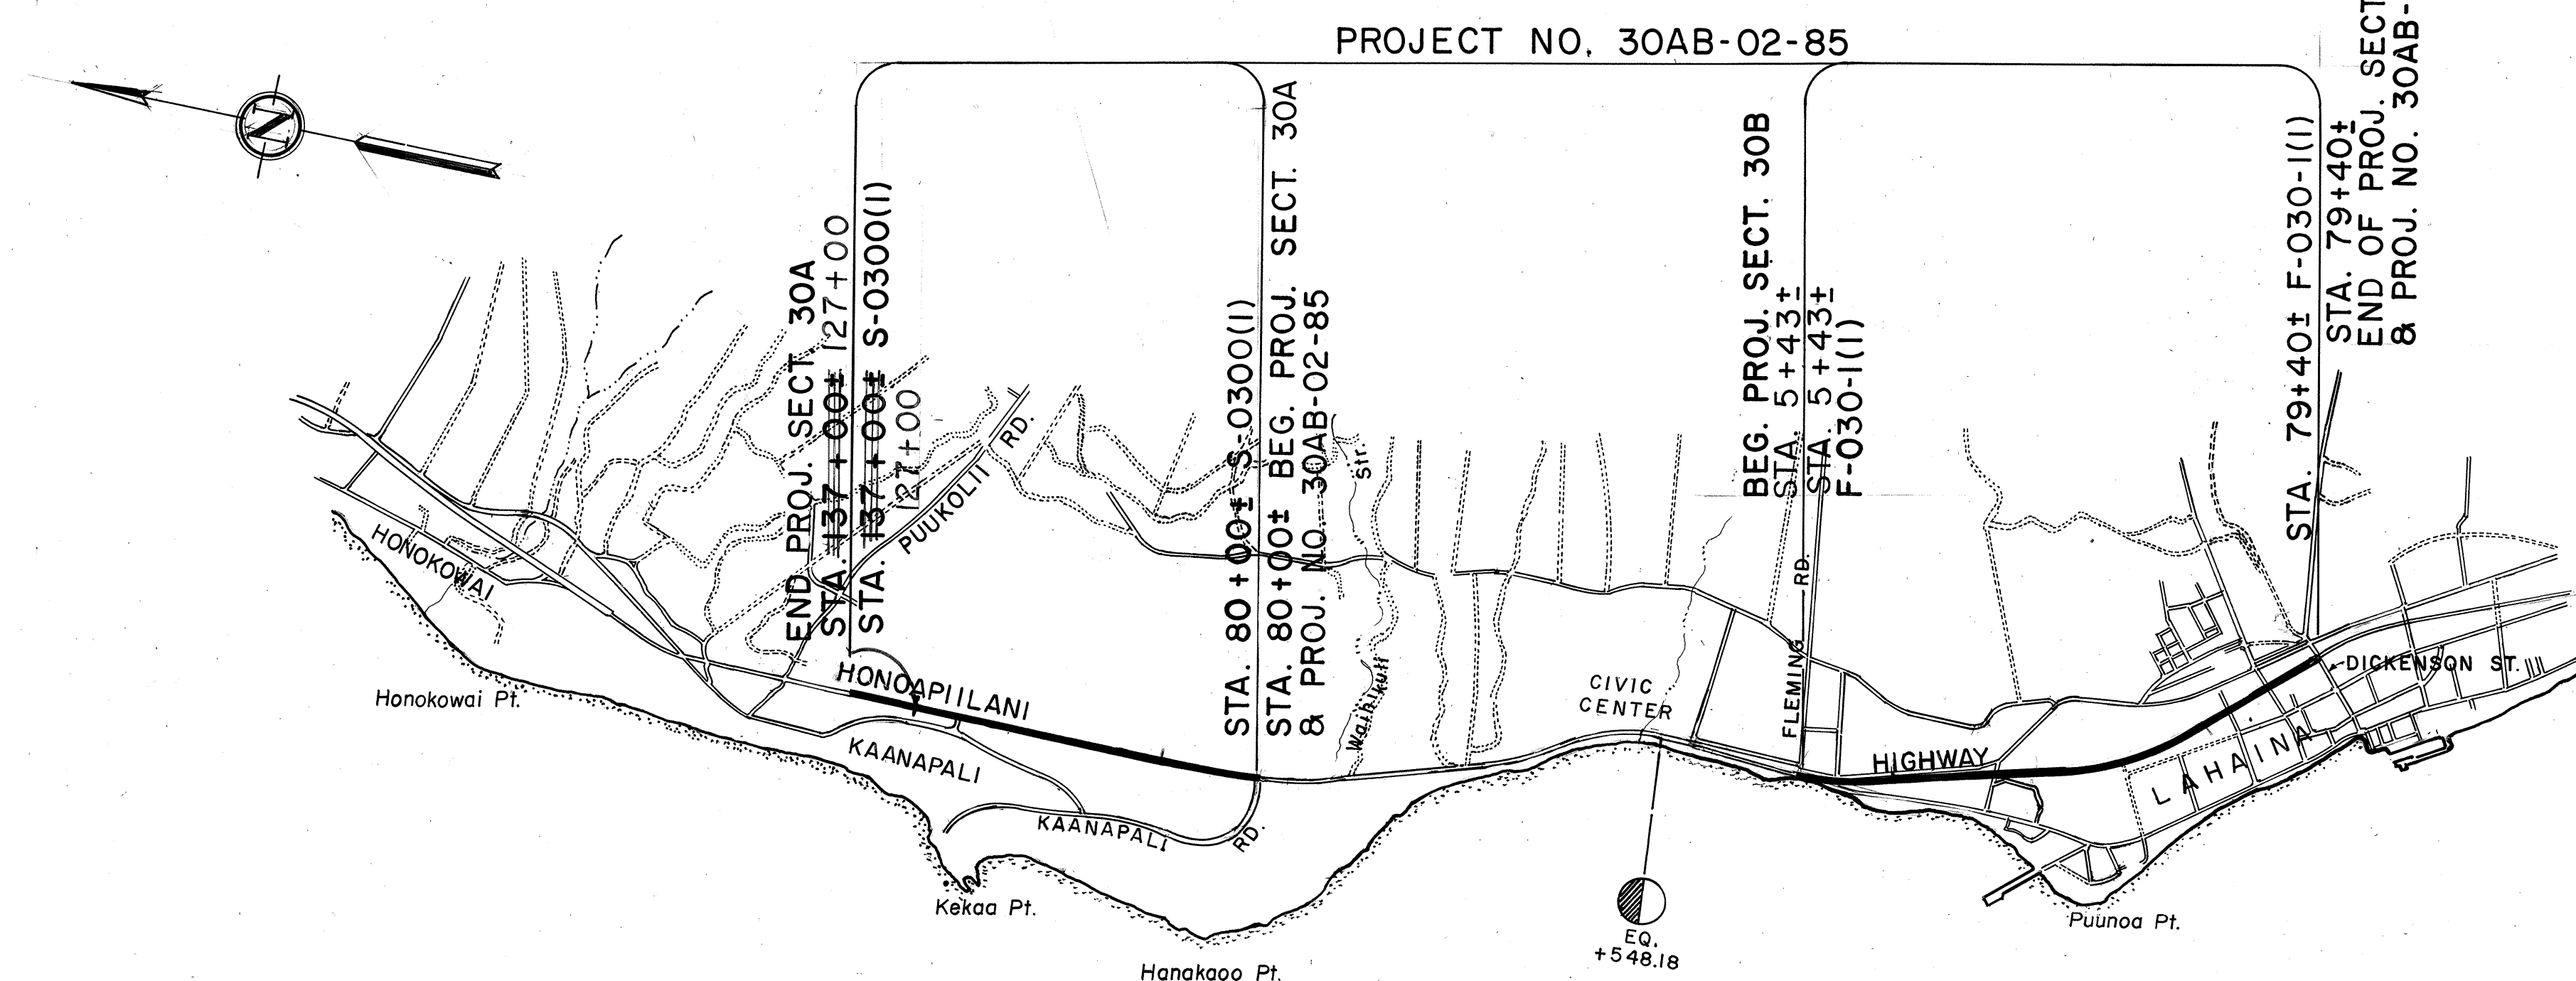

SCALE: 1" = 2000'

LENGTH OF PROJECT ~~2.480~~ ^{2.291} MILES

DEPARTMENT OF TRANSPORTATION STATE OF HAWAII	
APPROVED:	
<i>Cheryl D. Doon</i> for DIR. OF TRANSPORTATION	<i>3/1/85</i> DATE

HWY - M _____ R. SIAROT _____ 548-7537 _____ NOV. 1984
DESIGNED BY _____ P. S. & E. BY _____ PHONE _____ DATE _____