



FED. ROAD DIST. NO.	STATE	PROJ. NO.	FISCAL YEAR	SHEET NO.	TOTAL SHEETS
HAWAII	HAW.	30AC-01-87M 30A-01-87	1987	7	18

BEGIN OLOWALU SECTION
 PROJ. NO. 30AC-01-87M STA. 33+00=
 F.A.P. NO. F-30(3)
 STA. 33+00

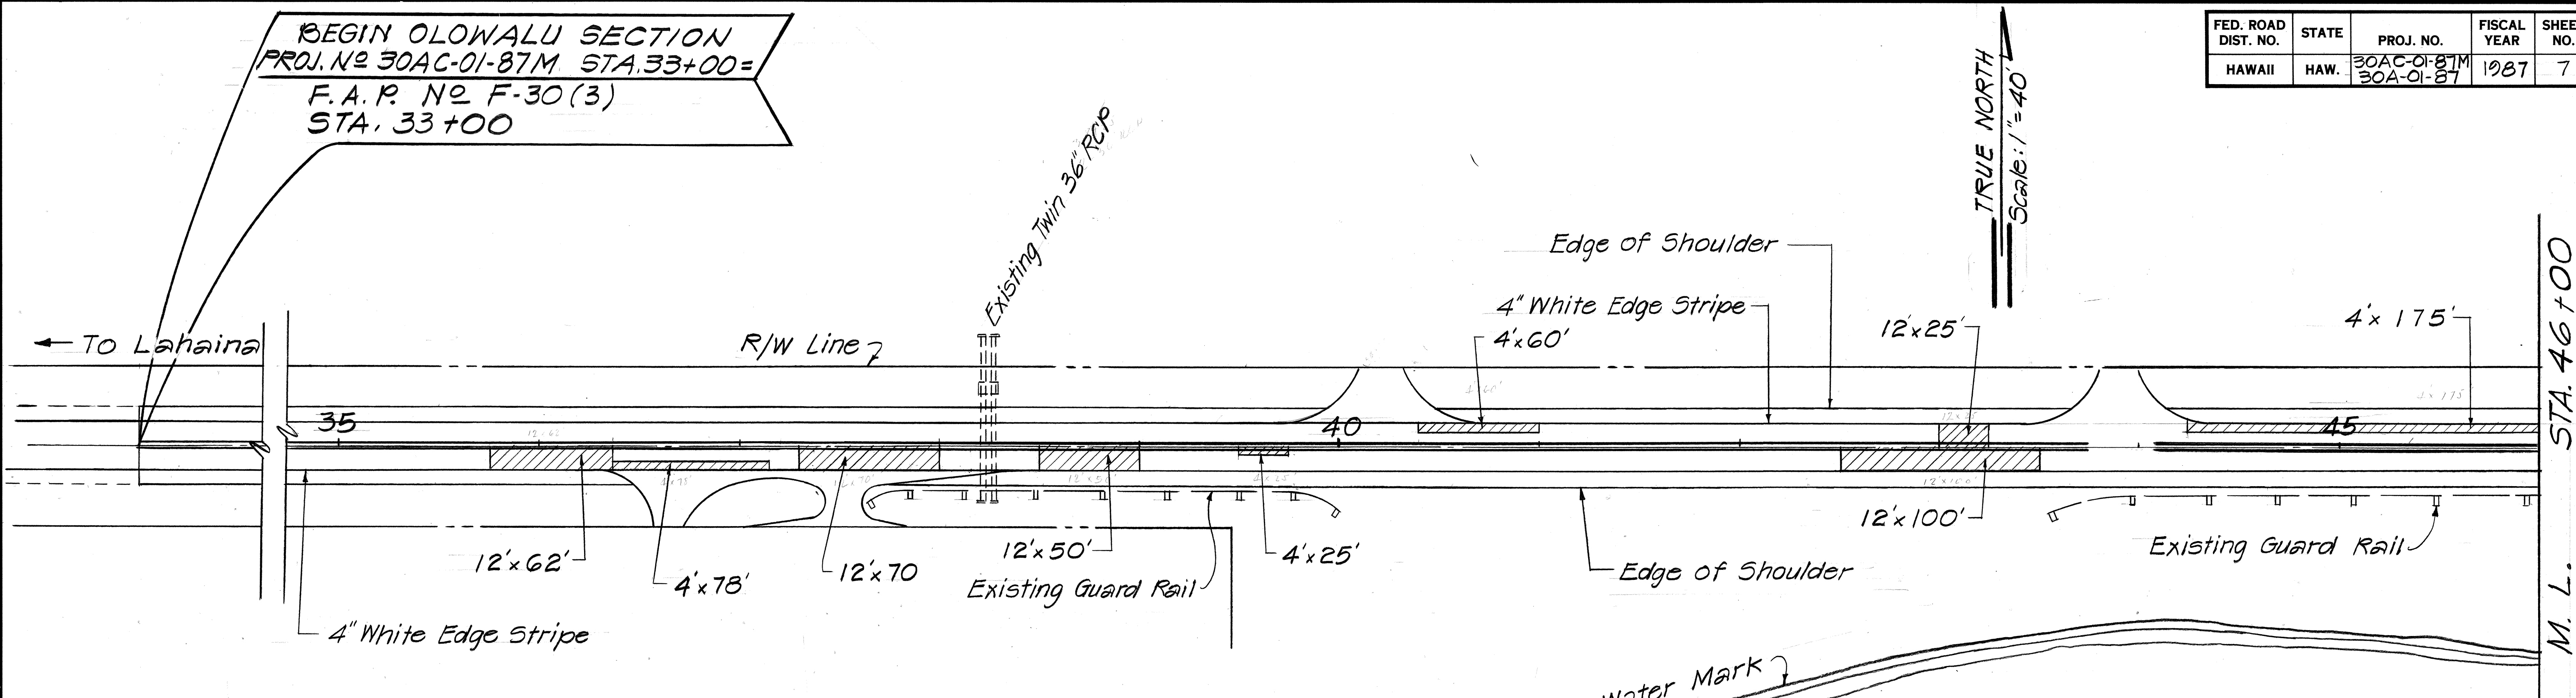


NOTE: DELETED UNDER C.C.O. #1
~~Reconstruction Area~~

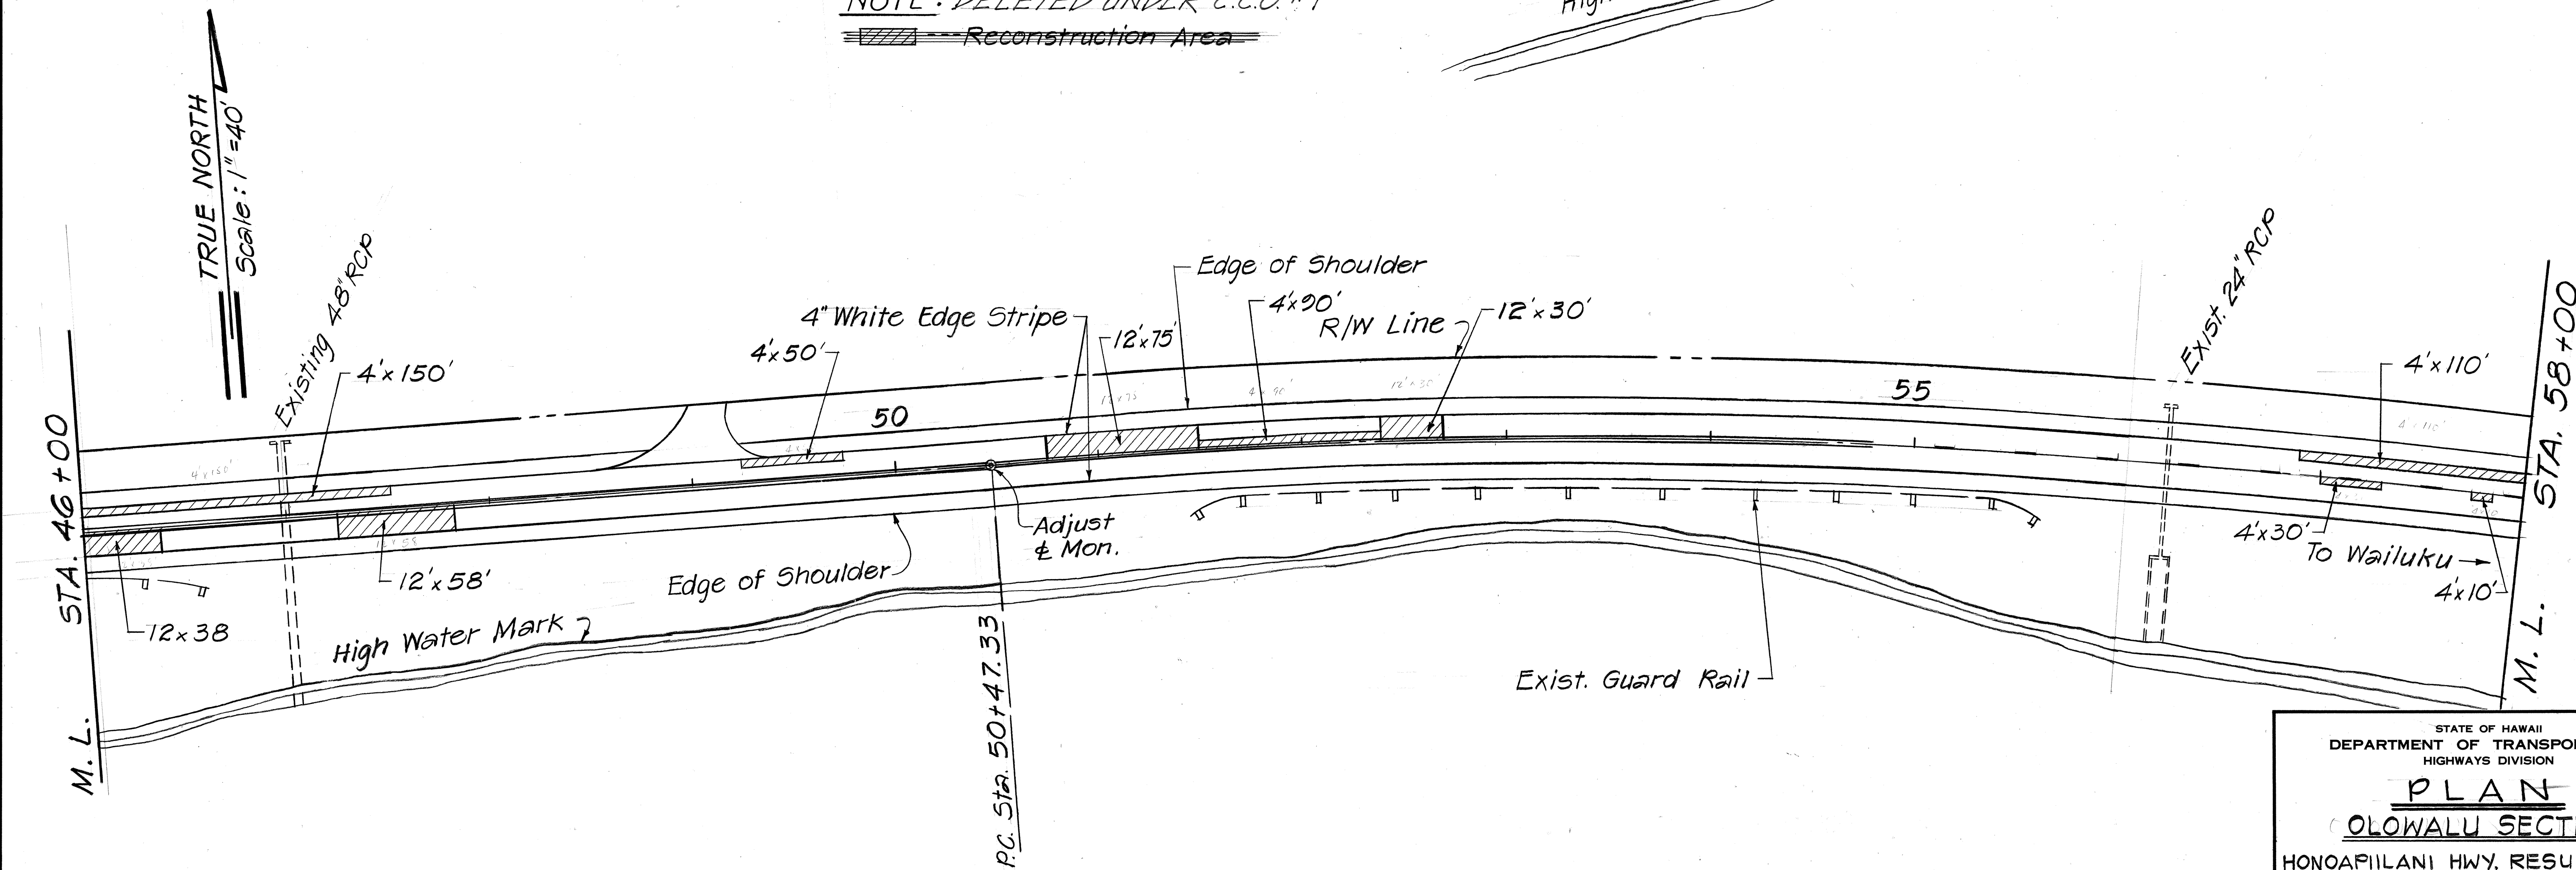


DATE	_____
SURVEY PLOTTED BY	_____
ORIGINAL PLAN	_____
DRAWN BY	_____
TRACED BY	_____
DESIGNED BY	_____
QUANTITIES BY	_____
CHECKED BY	_____
NO.	_____

STATE OF HAWAII
 DEPARTMENT OF TRANSPORTATION
 HIGHWAYS DIVISION
PLAN
OLOWALU SECTION
 HONOAPILANI HWY. RESURFACING
 AND GUARDRAIL & SHOULDER IMPR.
 PROJ. NOS. 30AC-01-87M & 30A-01-87
 SCALE: AS SHOWN DATE: MAY, 1987
 SHEET No. 1 OF 2 SHEETS

FED. ROAD DIST. NO.	STATE	PROJ. NO.	FISCAL YEAR	SHEET NO.	TOTAL SHEETS
HAWAII	HAW.	30AC-01-87M 30A-01-87	1987	8	18

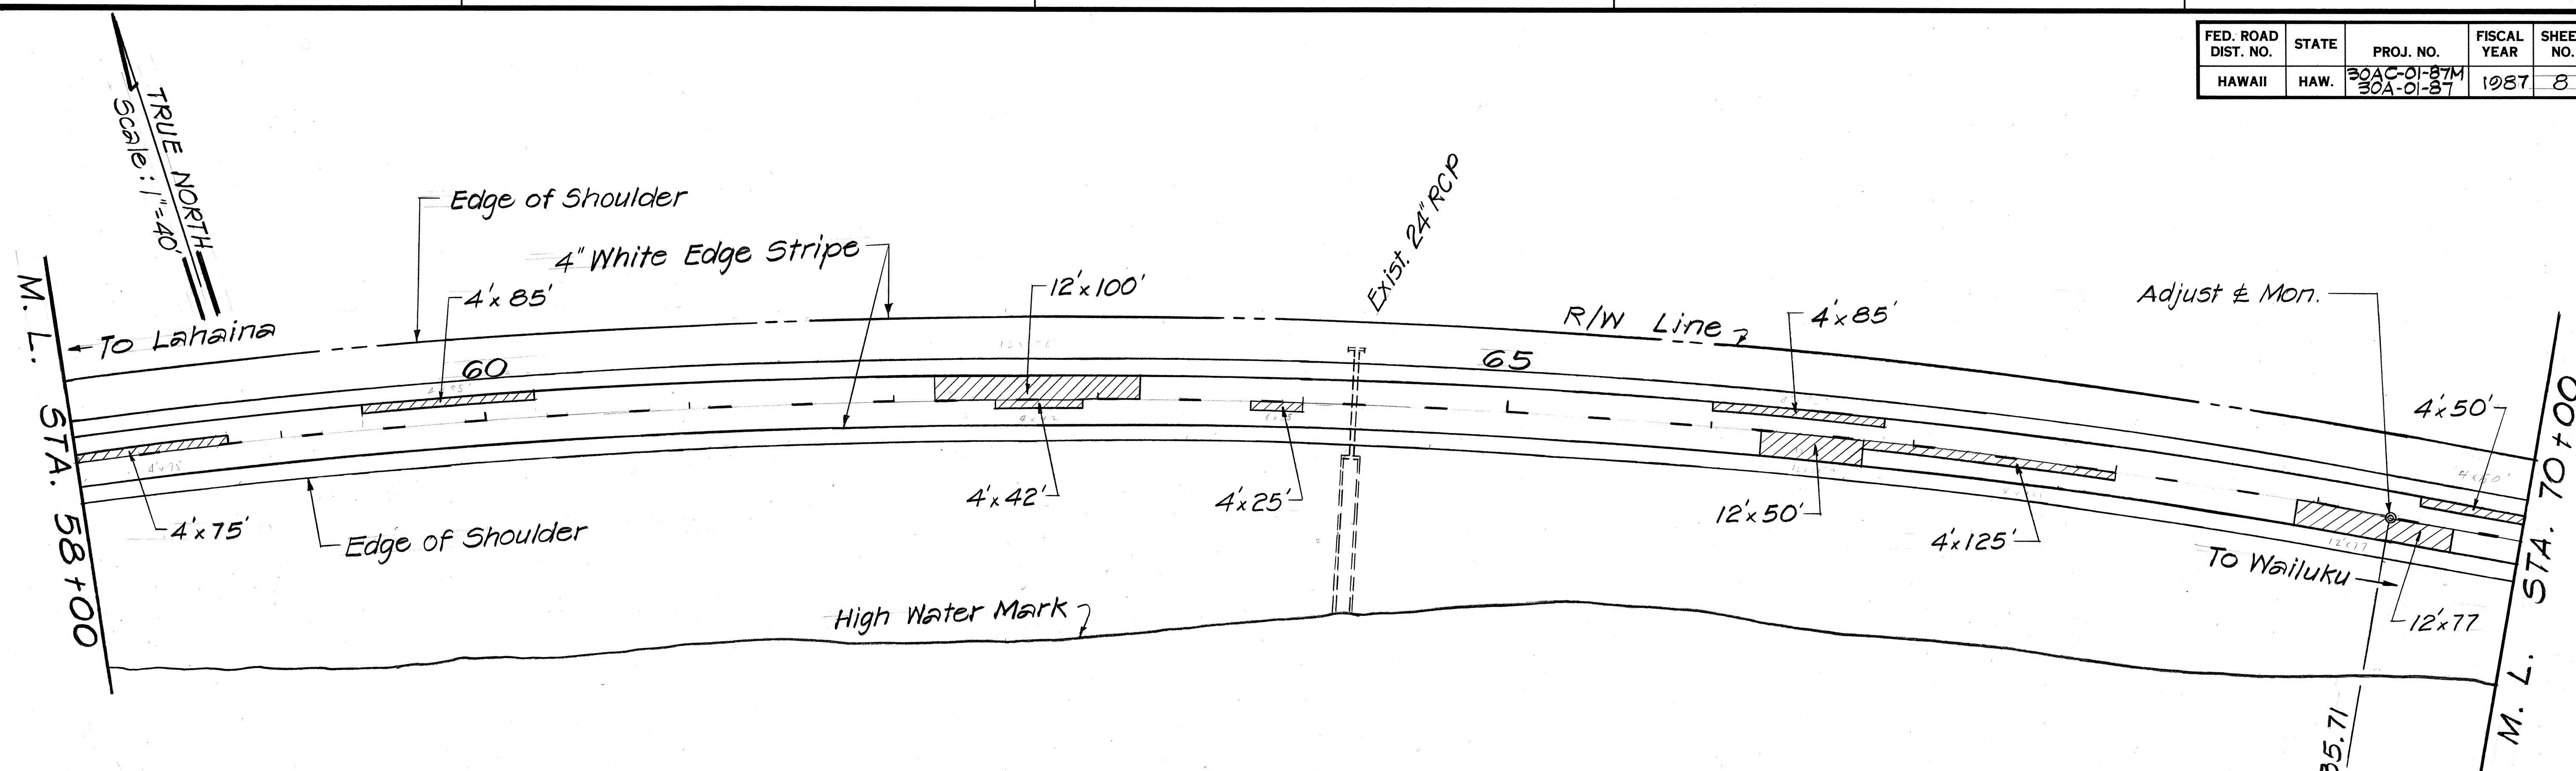

NOTE: DELETED UNDER C.C.O.#1
~~Reconstruction Areas~~

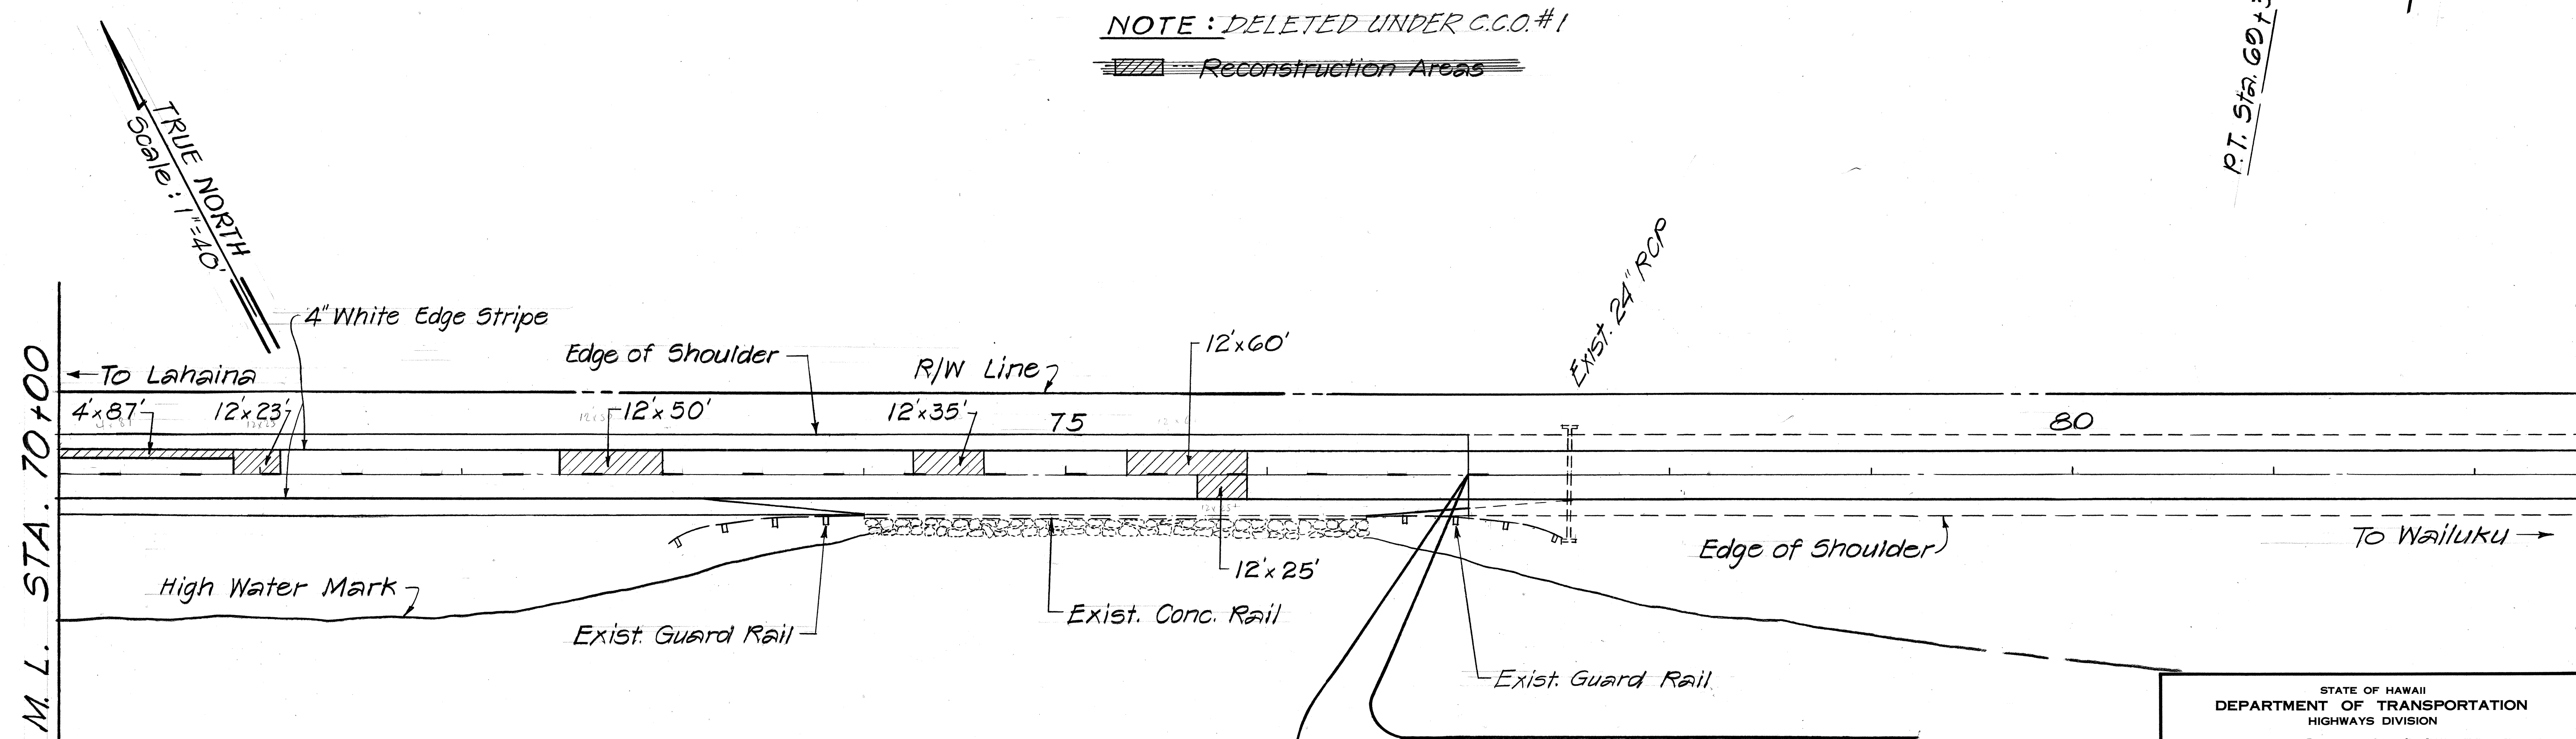

END OLOWALU SECTION
 PROJ. NO. 30AC-01-87M STA. 77+00=
 F.A.P. No. F-30(3)
 STA. 77+00

STATE OF HAWAII
 DEPARTMENT OF TRANSPORTATION
 HIGHWAYS DIVISION

PLAN
OLOWALU SECTION

HONOAPIILANI HWY. RESURFACING
 AND GUARDRAIL & SHOULDER IMPR.
 PROJ. NOS. 30AC-01-87M & 30A-01-87
 SCALE: AS SHOWN DATE: MAY 1987
 SHEET No. 2 OF 2 SHEETS

ORIGINAL PLAN	DATE
DESIGNED BY	
TRACED BY	
NOTE BOOK	
QUANTITIES BY	
CHECKED BY	