





INDEX TO DRAWINGS	
SHEET NO.	DESCRIPTION
1	TITLE SHEET
2	STANDARD PLANS SUMMARY
3-6	GENERAL NOTES, TYPICAL SECTIONS, SCHEDULES AND DETAILS
7-8	PLANS - OLOWALU SECTION
9-12	PLANS - KAA NAPALI SECTION
13	DRAINAGE DETAILS
14-18	SIGNING AND PAVEMENT MARKING LEGEND, NOTES, PLANS AND DETAILS
19	ROADWAY PLAN FOR KAA NAPALI RESURFACING EXTENS. C.C.O. NO. 7

① 13R S-1 IS SUPPLEMENT SHEET TO THE CONTRACT PLANS. TOTAL = 20

STATE OF HAWAII
DEPARTMENT OF TRANSPORTATION
HIGHWAYS DIVISION
HONOLULU, HAWAII
"AS BUILT"
PLANS FOR
HONOAPIILANI HIGHWAY RESURFACING
VICINITY OF OLOWALU AND KAA NAPALI
PROJECT NO. 30AC - 01 - 87M
AND
HONOAPIILANI HIGHWAY
GUARDRAIL AND SHOULDER IMPROVEMENTS
KEKAA DRIVE TOWARDS HONOKOWAI
PROJECT NO. 30A - 01 - 87

DISTRICT OF LAHAINA
ISLAND OF MAUI

FED. ROAD DIST. NO.	STATE	PROJ. NO.	FISCAL YEAR	SHEET NO.	TOTAL SHEETS
HAWAII	HAW.	30AC-01-87M 30A-01-87	1987	1	18

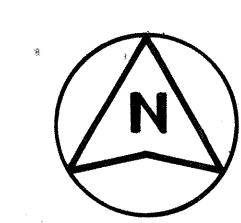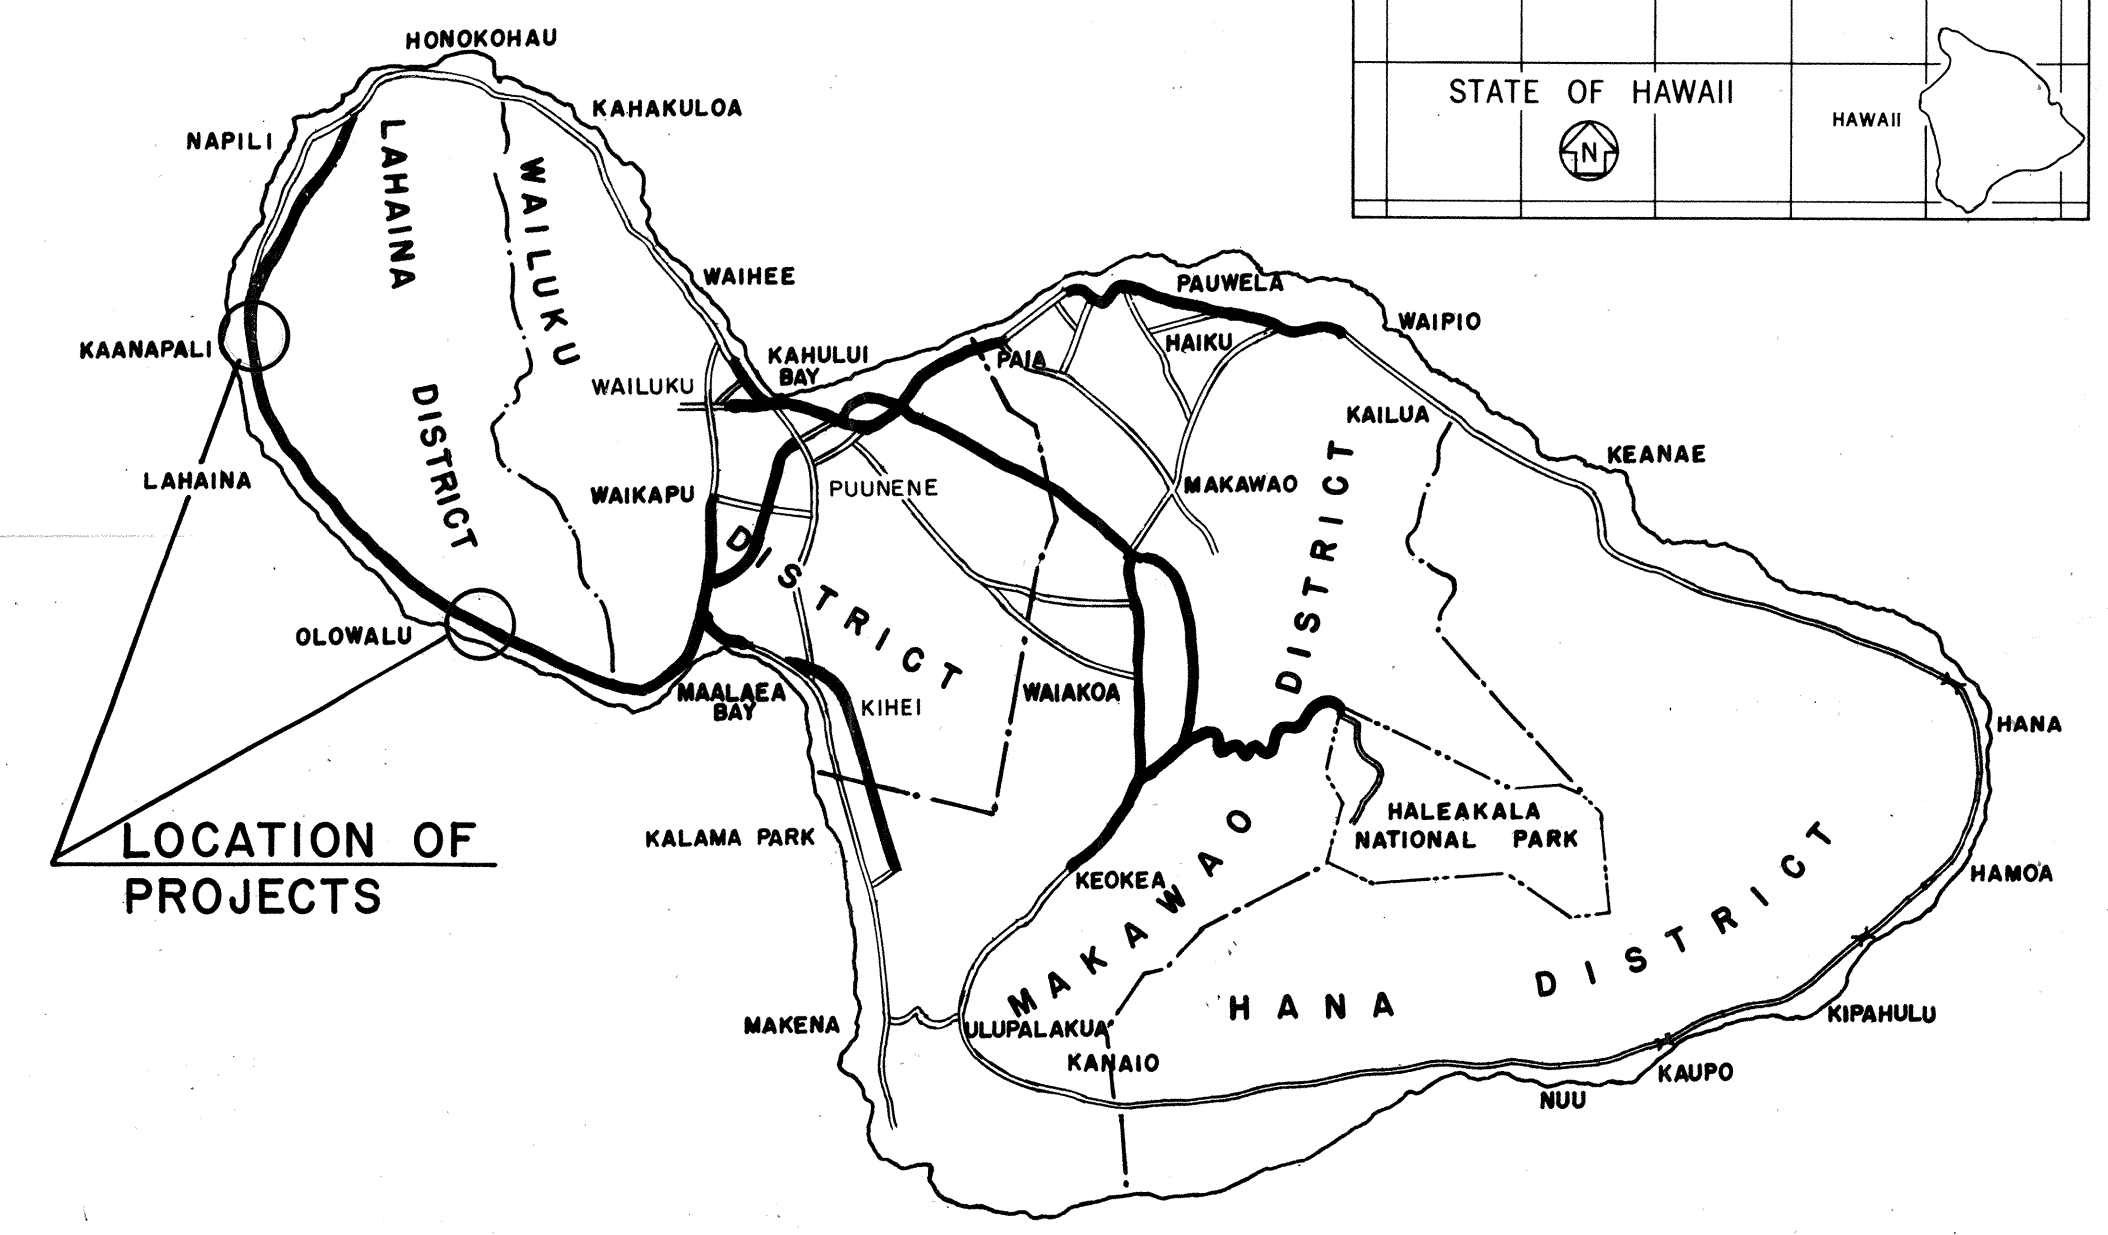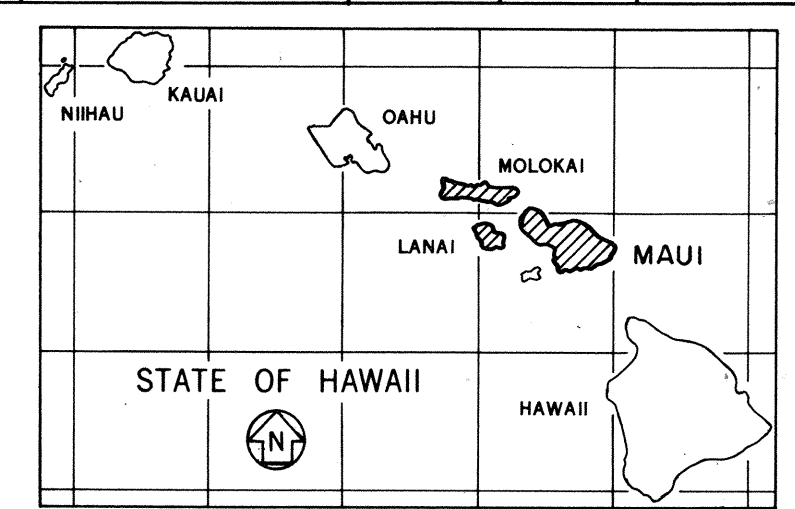
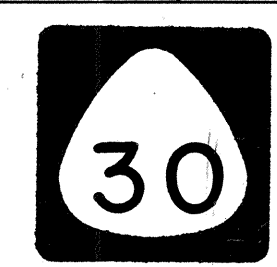


5 0 5 10
SCALE IN MILES

— FEDERAL AID PROJECTS PREVIOUSLY CONSTRUCTED OR UNDER CONSTRUCTION

CHANGES MADE DURING CONSTRUCTION HAVE BEEN INCORPORATED ON THESE PLANS EXCEPT CHANGES IN THE ORIGINAL THEORETICAL QUANTITIES. FOR ACTUAL QUANTITIES, REFER TO PROJECT LEDGER AND/OR COMPUTATION BOOK.

RESIDENT ENGINEER 4/7/89
DATE

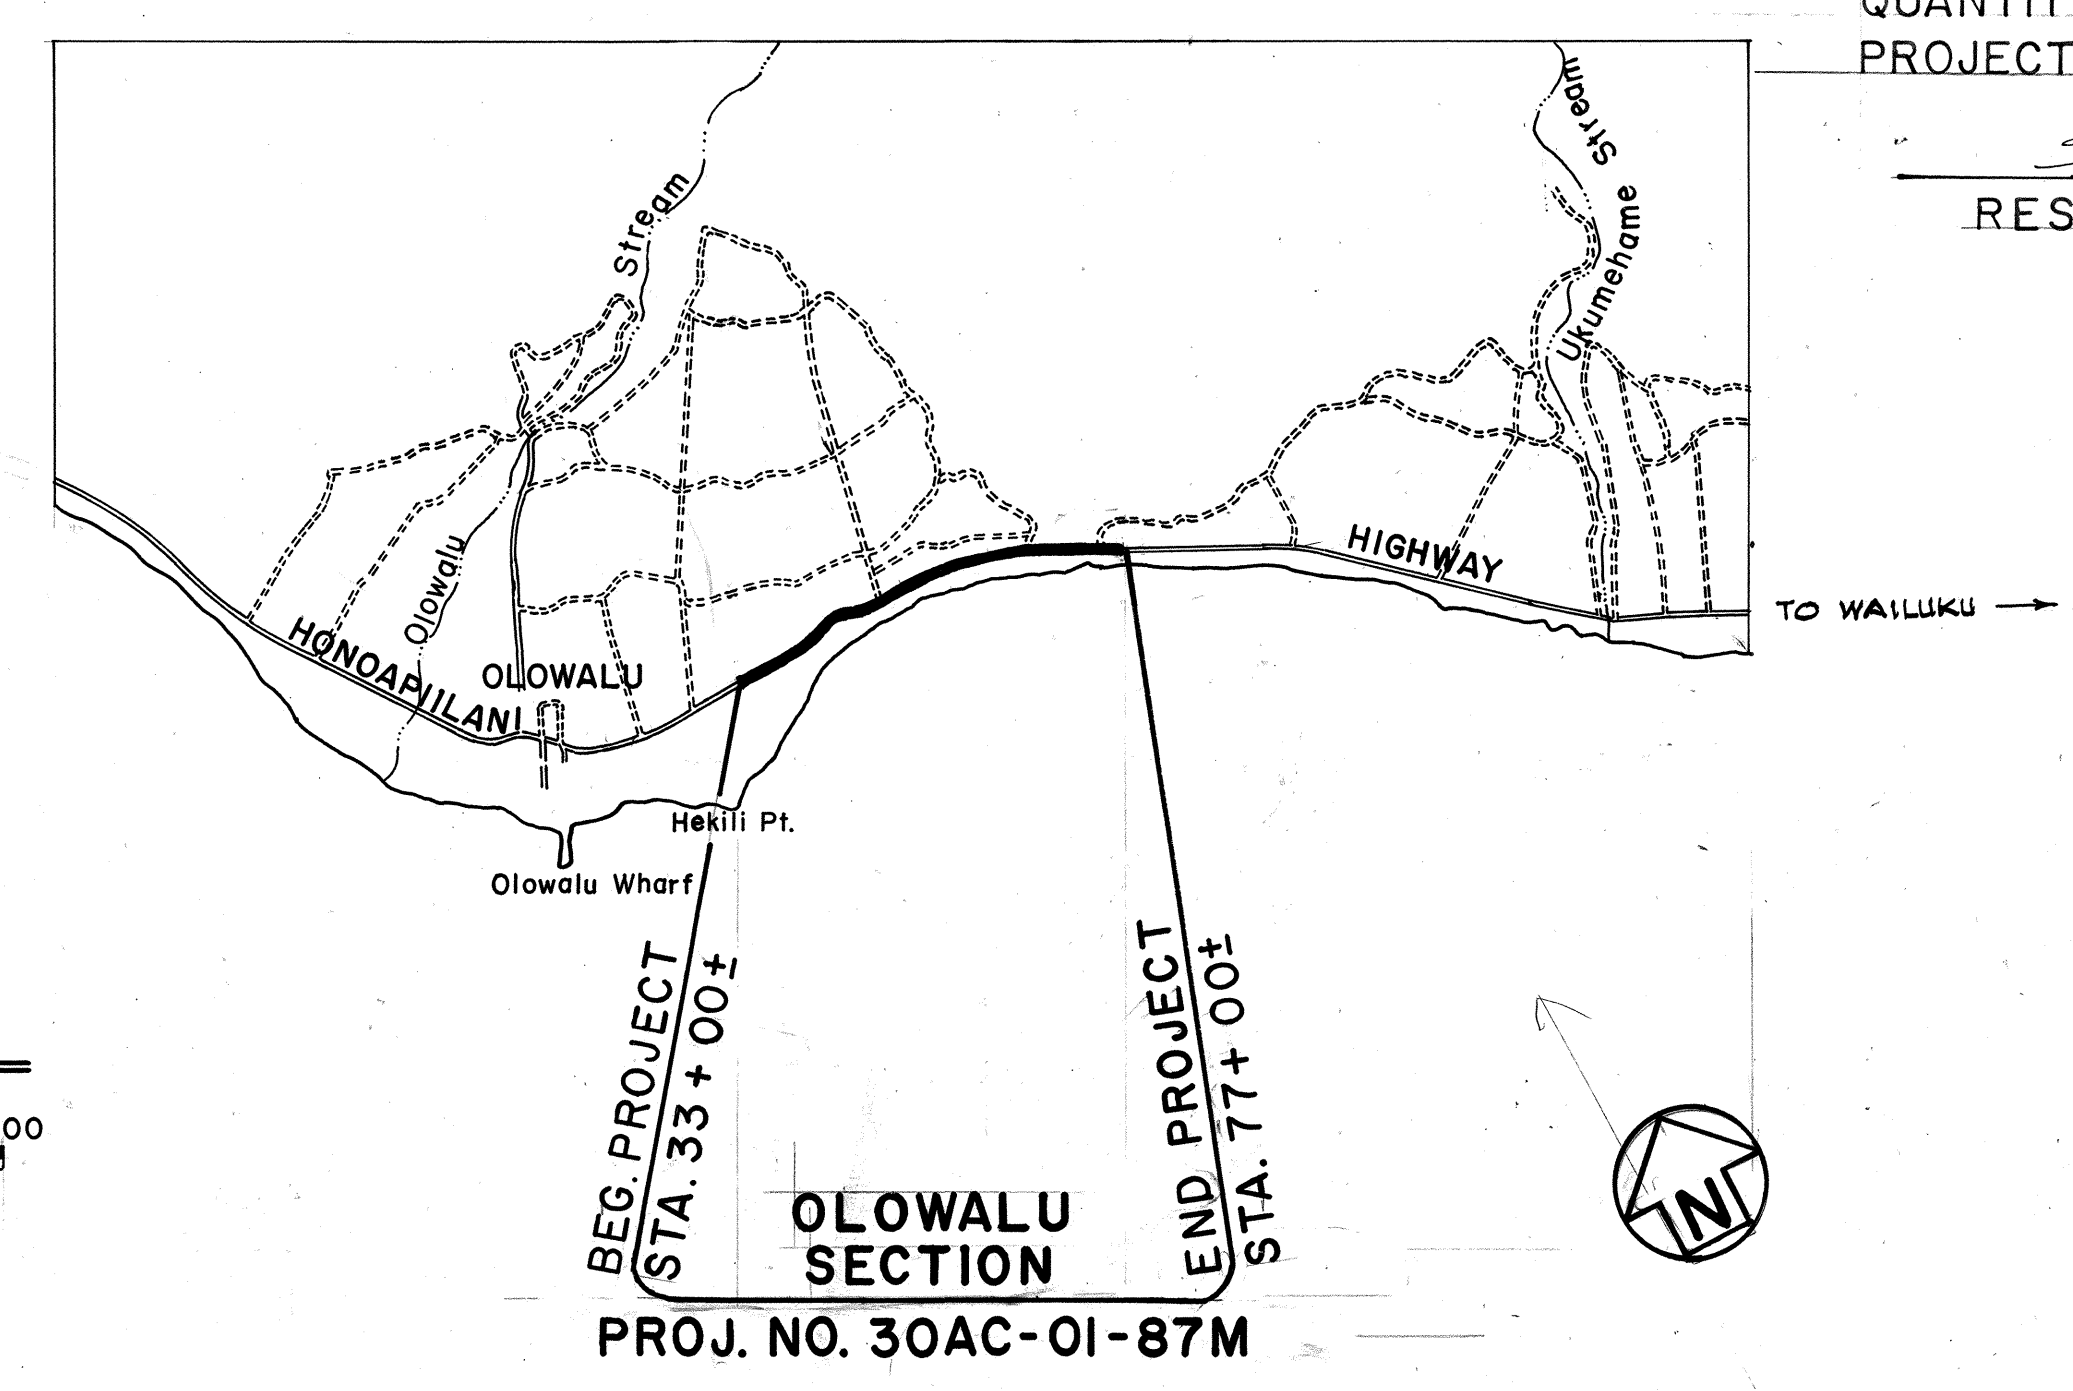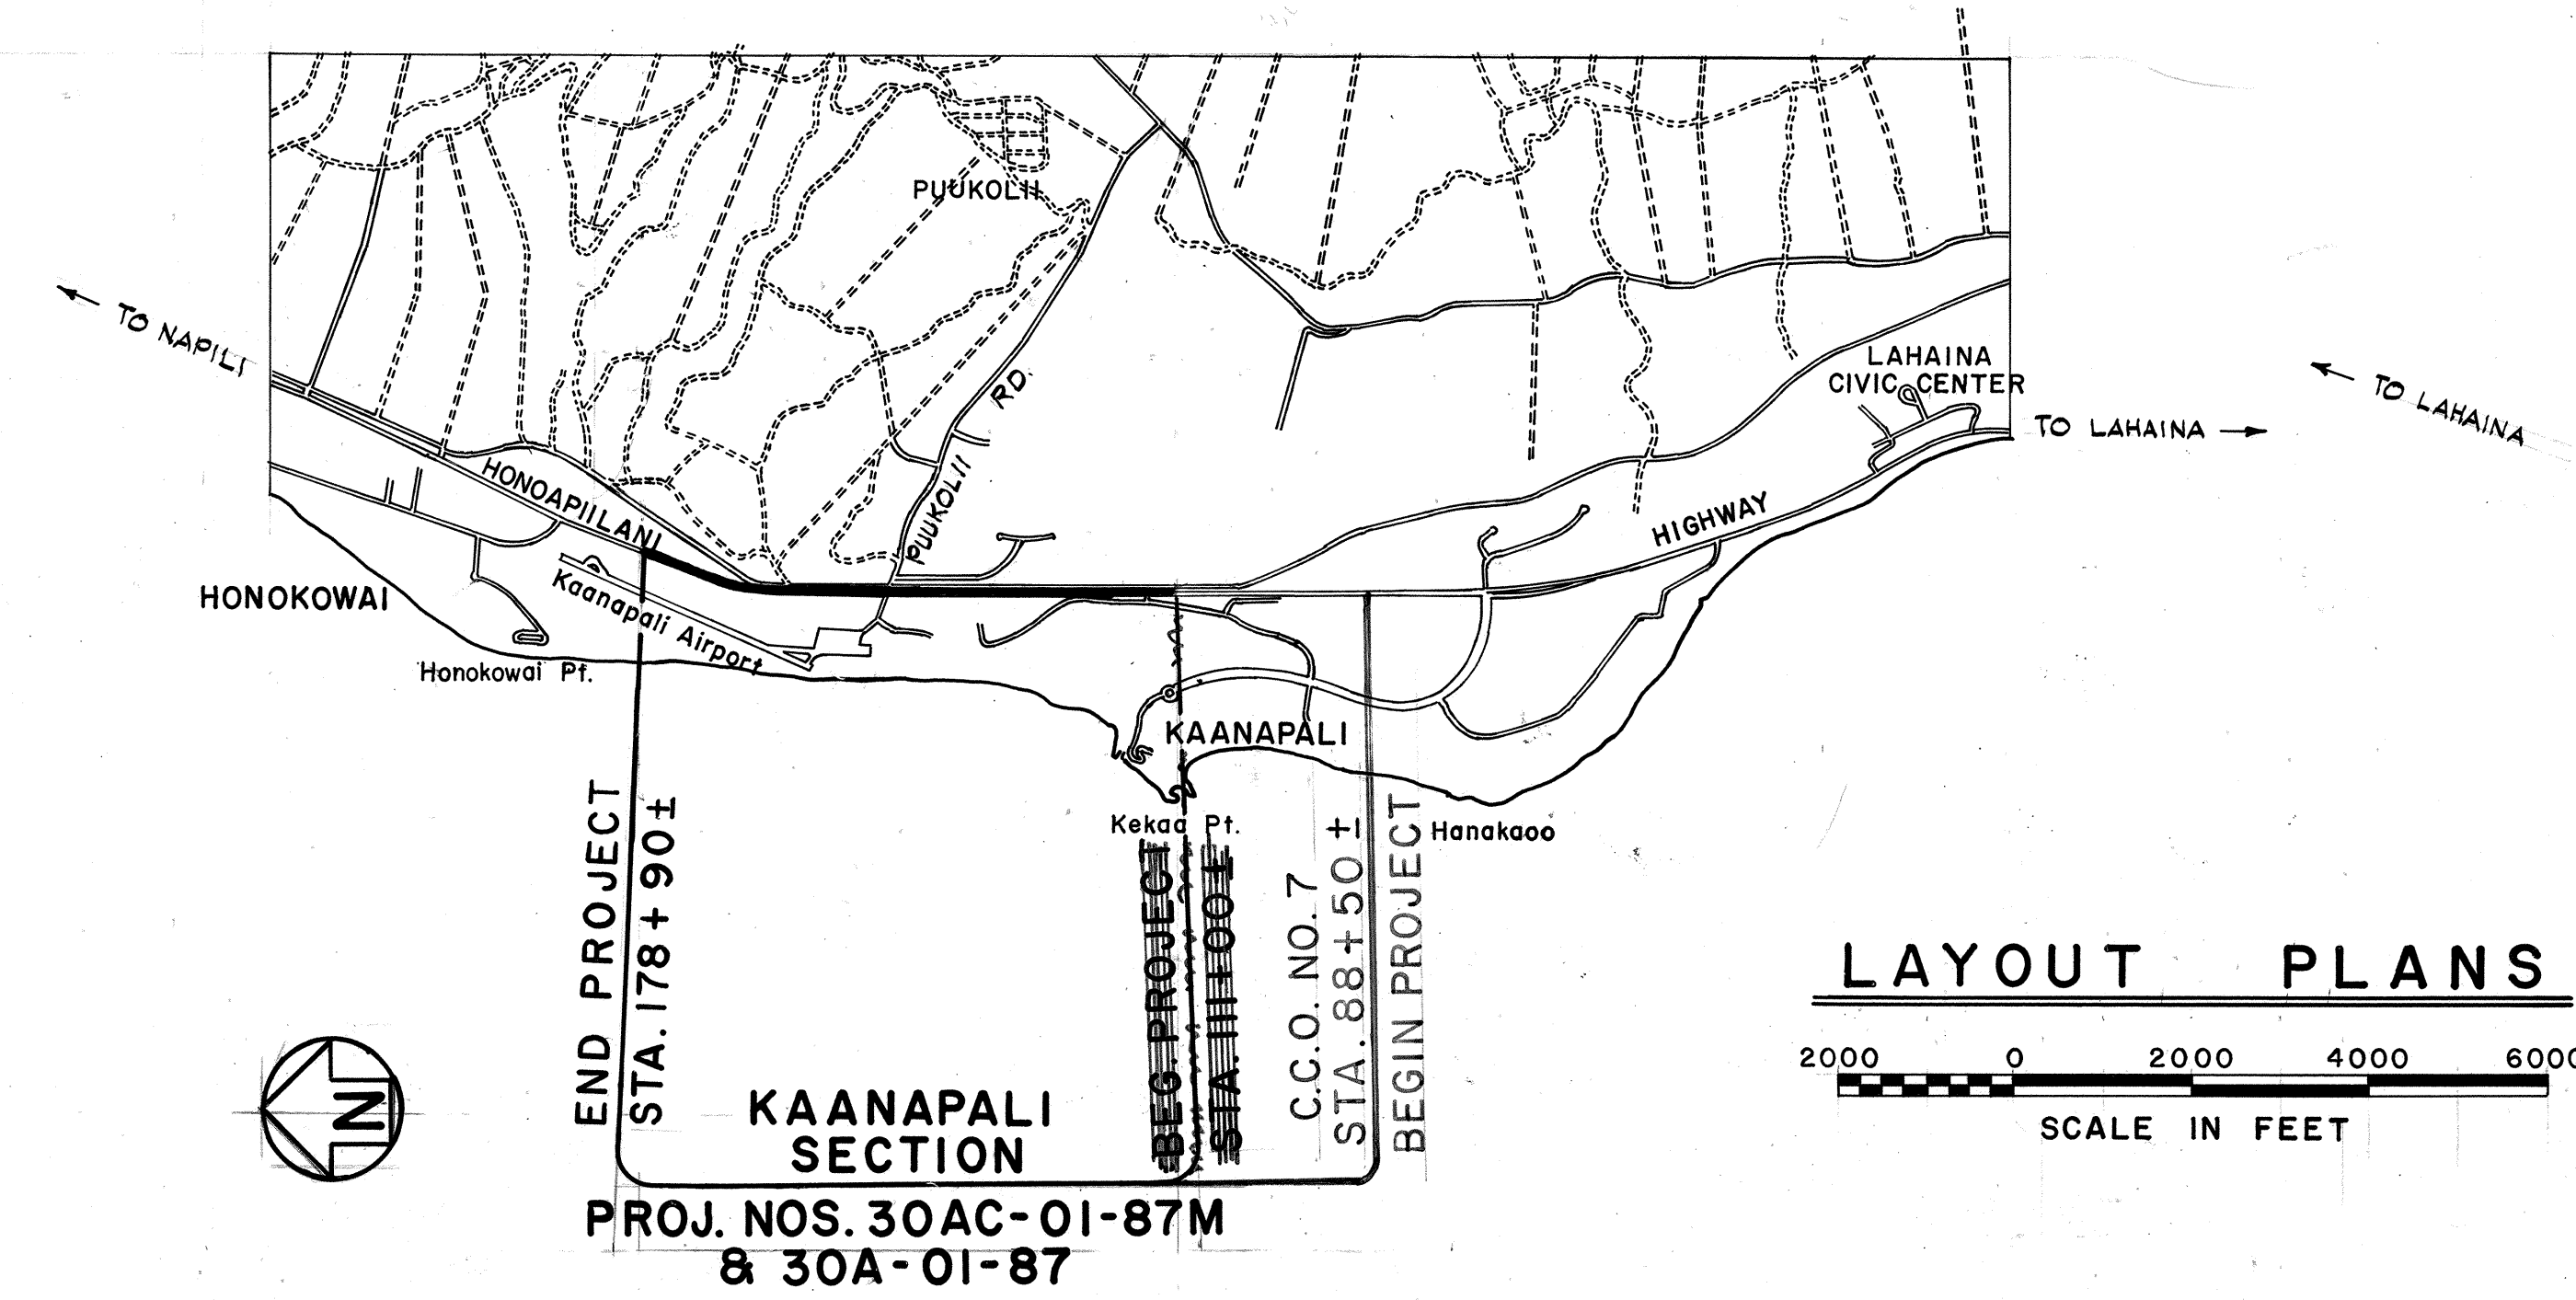

DEPARTMENT OF TRANSPORTATION
STATE OF HAWAII
APPROVED:
DIR. OF TRANSPORTATION 5/29/87
DATE

ROY NAGASAKO 548-2456 MAY 1987
DESIGNED BY P. S. & E. BY PHONE

DD-A-2-1