


FED. ROAD DIST. NO.	STATE	PROJ. NO.	FISCAL YEAR	SHEET NO.	TOTAL SHEETS
HAWAII	HAW.	30C-02-88	1988	4	10

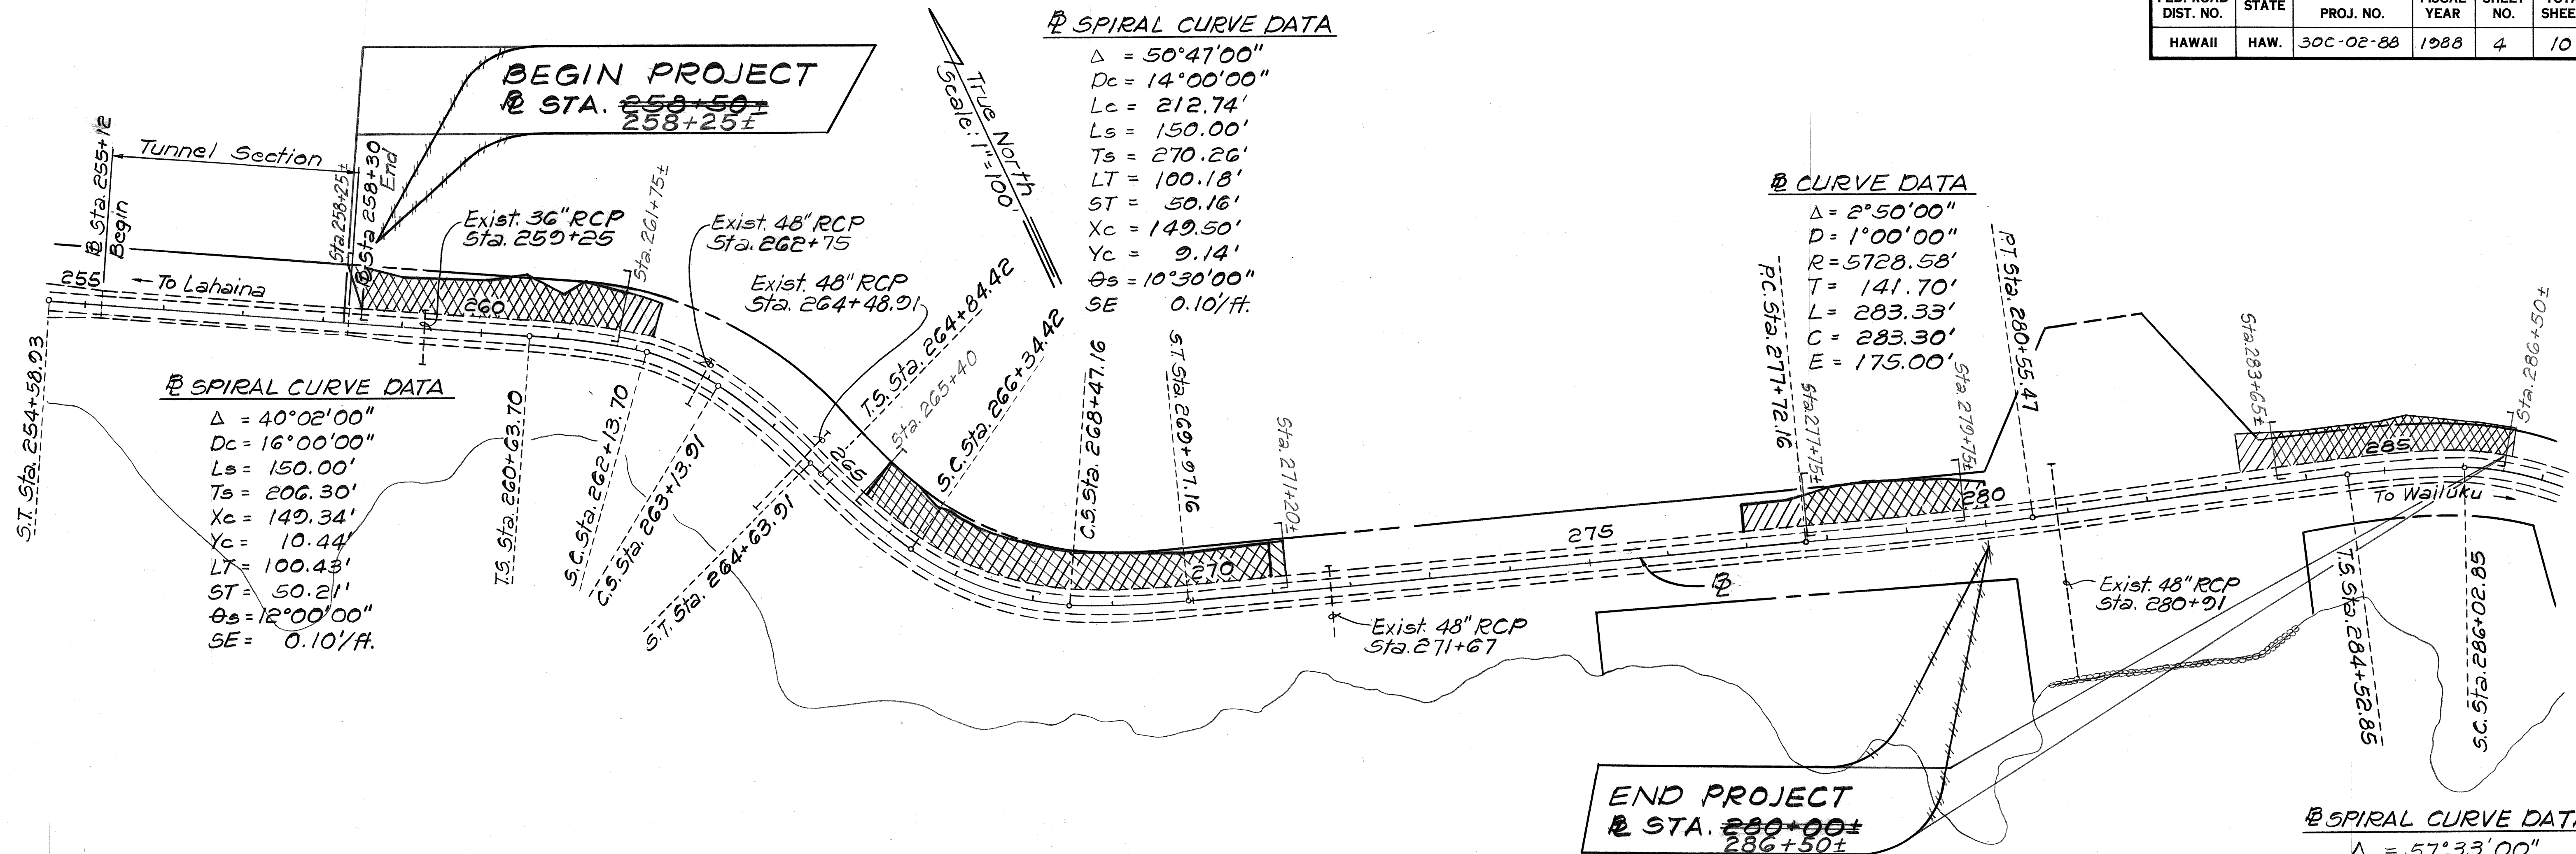

GENERAL NOTES:

1. The project begins at the northeast side of the tunnel, proceeds southeasterly and ends 0.4 mile east of the tunnel. Improvements consist of placing rockfall protection netting along the slopes of Honoapiilani Highway.
2. The exact limits of the rockfall protection netting and locations of the rock bolts shall be determined in the field by the Engineer.
3. The Contractor's attention is directed to Subsection 107.13 "Public Convenience And Safety" and to Section 645- "Traffic Control of the Special Provisions.
4. At the end of each day's work, the Contractor shall remove all equipment and other obstructions to permit free and safe passage of public traffic as direct by the Engineer.
5. The Contractor shall install 3/4"x1'-0" long rods into the rock slope to anchor the bottom of the netting as shown on the plans and as directed by the engineer. The anchor rods shall have a closed loop on one end. The rods shall be completely driven into the slope until only the loop is exposed. The netting shall be attached to the anchor rods with 9 gauge tie wire tied to the loop and bottom wire rope. This work shall be considered incidental to Rockfall Protection Netting and no payment will be made.

DATE	_____
SURVEY PLOTTED BY	_____
DRAWN BY	_____
DESIGNED BY	_____
QUANTITIES BY	_____
CHECKED BY	_____
ORIGINAL PLAN	_____
NOTE BOOK	_____
NO.	_____

6/6/88	Additional Rockfall Protection Area and added Gen. Note #5.
DATE	REVISION

STATE OF HAWAII
DEPARTMENT OF TRANSPORTATION
HIGHWAYS DIVISION

PLAN AND GENERAL NOTES

HONOAPIILANI HIGHWAY
Rockfall Protection along Pali Section Ph. II
Proj. No. 30C-02-88
Scale: As Noted Date: April, 1988

SHEET NO. 1 OF 4 SHEETS