


New 2 1/2" A.C. Pav't. Mix No. V

Top of Exist. A.C. Pav't.

Fill Exist. Pav't. Depression with a layer of Leveling Course of A.C. Pav't. Mix No. V

Not to Scale

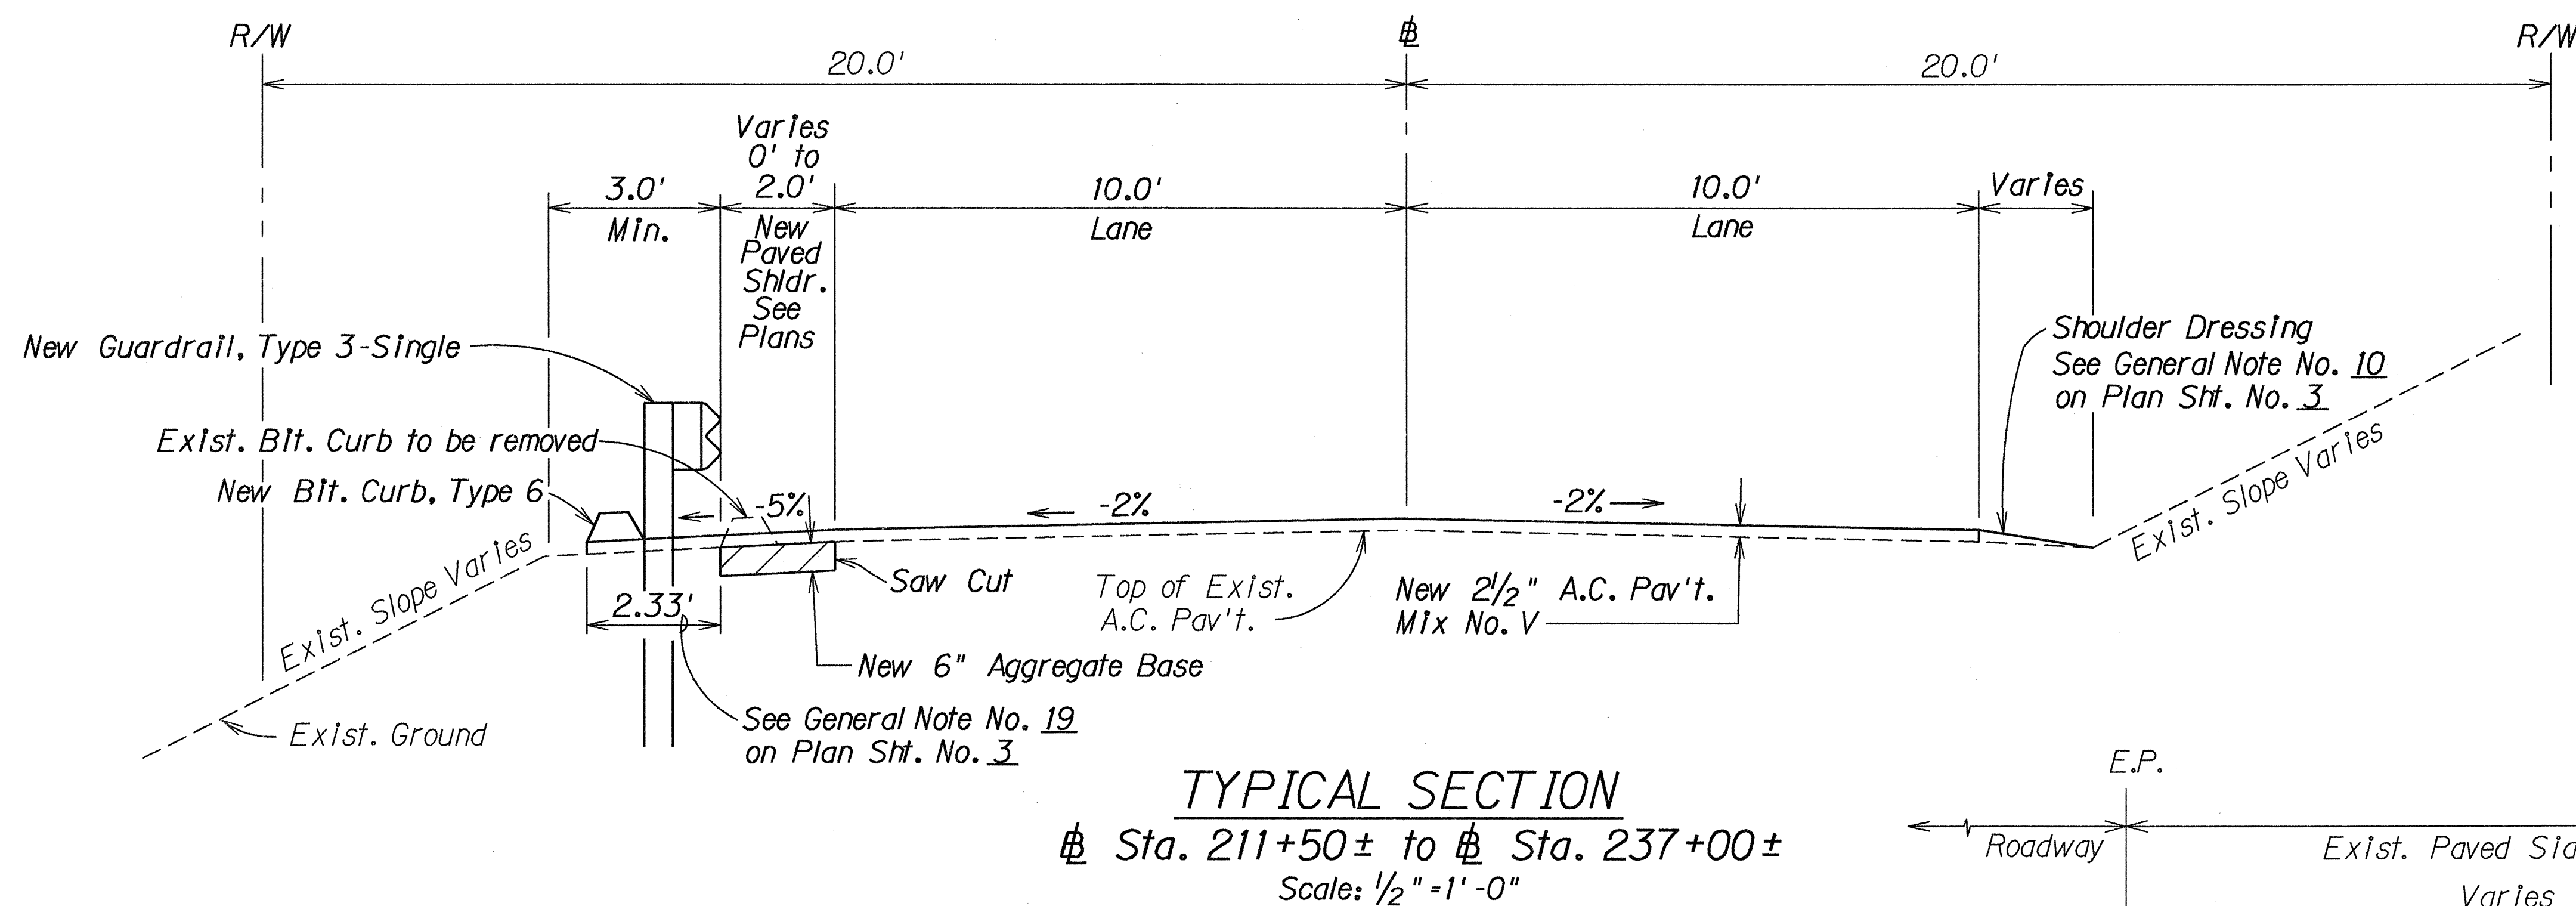

Not to Scale

Scale: As Shown Date: May, 1991
SHEET No. 1 OF 1 SHEETS