

INDEX TO DRAWINGS	
SHEET NO.	DESCRIPTION
1	TITLE SHEET
2 - 5	LAYOUT PLANS
6	STANDARD PLANS SUMMARY
7	GENERAL NOTES AND DETAILS
A Service And in the leading of the Annual of Body of County and County State of the County of the County and Annual State of the County of th	
	•
ź	

STATE OF HAWAII

DEPARTMENT OF TRANSPORTATION

HIGHWAYS DIVISION HONOLULU, HAWAII

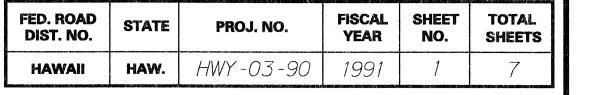

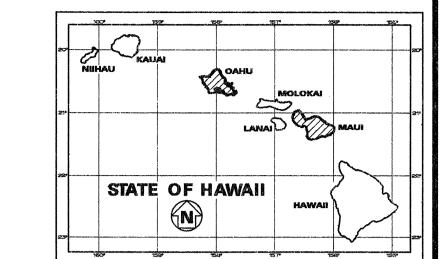

PLANS FOR

EMERGENCY TELEPHONES VARIOUS LOCATIONS, STATEWIDE

PROJECT NO. HWY-03-90

DISTRICTS OF EWA, WAIANAE, & KOOLAUPOKO
ISLAND OF OAHU

DISTRICT OF WAILUKU

ISLAND OF MAUI

ROUTE NOS.

H3

76

93

30

FOR MILE POST DATA REFER TO PLAN SHEET NOS. 2 - 5

HWY - T J. B. FRONDA
DESIGNED BY P. S. & E. BY

DEPARTMENT OF TRANSPORTATION STATE OF HAWAII

APPROVED:

Show 1/3/9/
DIR. OF TRANSPORTATION DATE