


FED. ROAD DIST. NO.	STATE	FED. AID PROJ. NO.	FISCAL YEAR	SHEET NO.	TOTAL SHEETS
HAWAII	HAW.	HES-STP-030-1(20)	1992	9	12

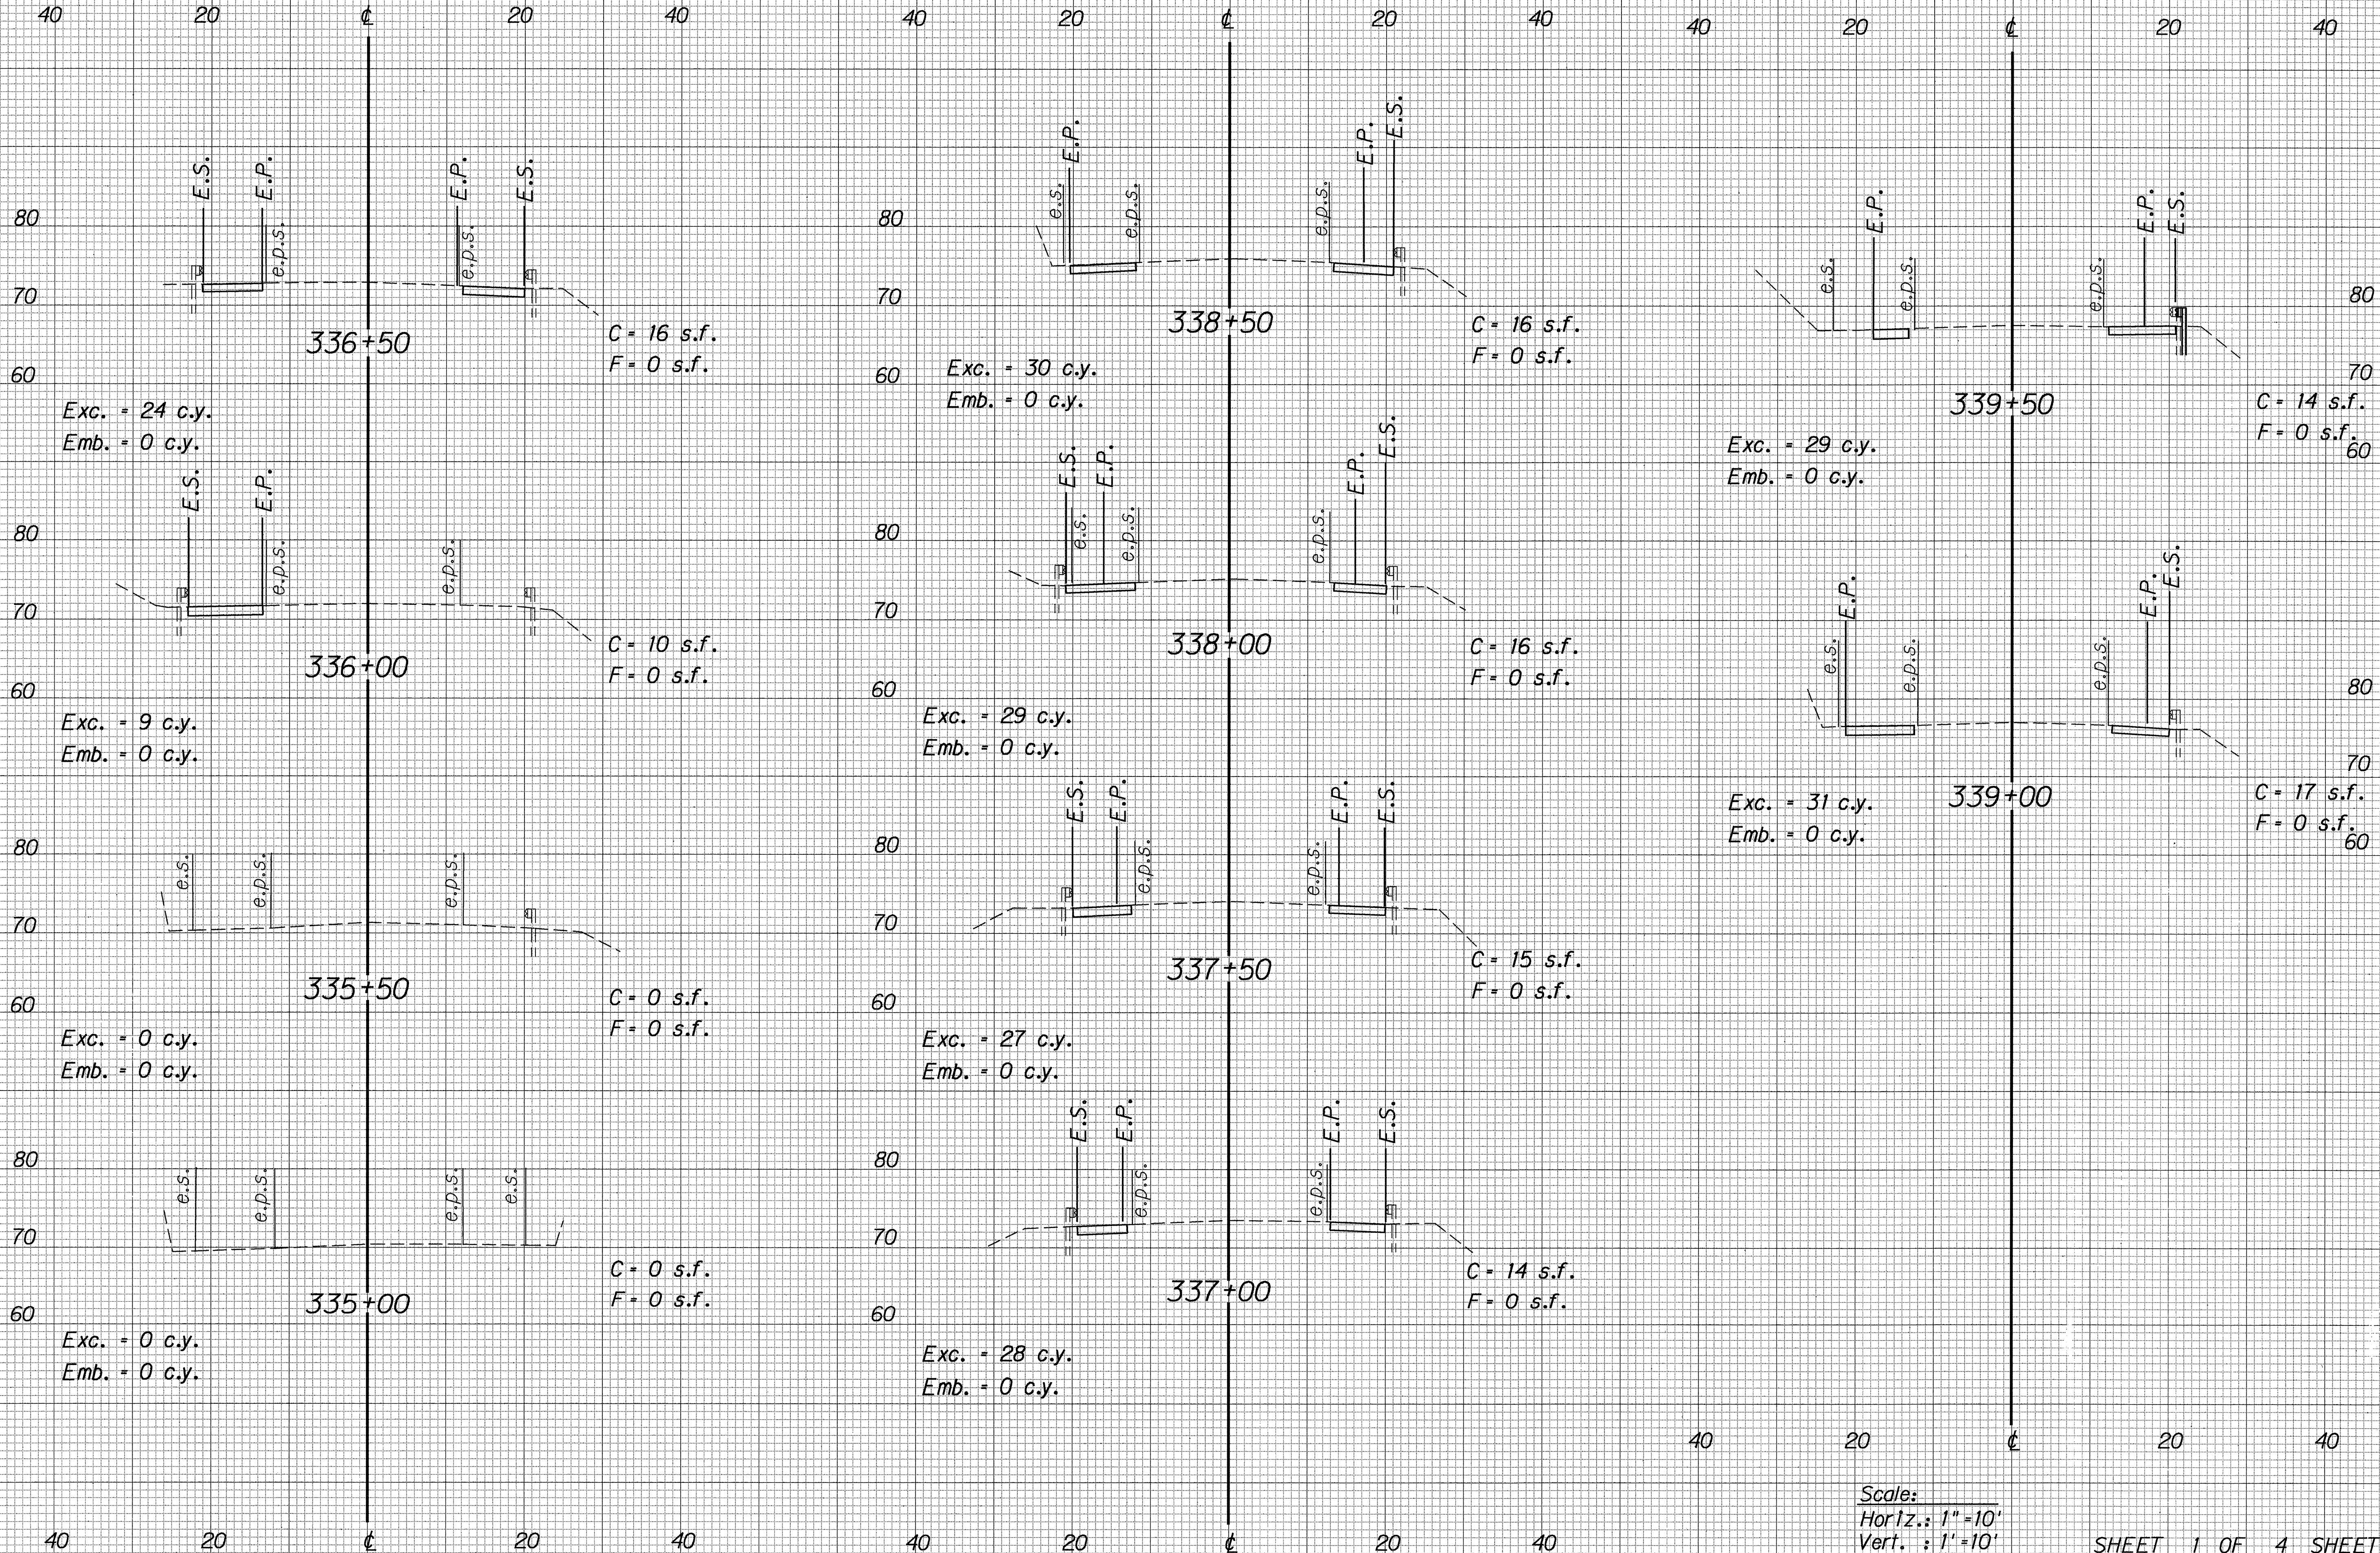


ORIGINAL PLAN	DATE
DESIGNED BY	
CHECKED BY	
NOTED BY	
QUANTITIES BY	
BY	

Scale:
Horiz.: 1"=10'
Vert.: 1"=10'

SHEET 1 OF 4 SHEETS

FED. ROAD DIST. NO.	STATE	FED. AID PROJ. NO.	FISCAL YEAR	SHEET NO.	TOTAL SHEETS
HAWAII	HAW.	HES-STP-030-1(20)	1992	10	12


SURVEY PLOTTED BY	DATE
DESIGNED BY	
NOTED BY	
CHECKED BY	
5/20/92	

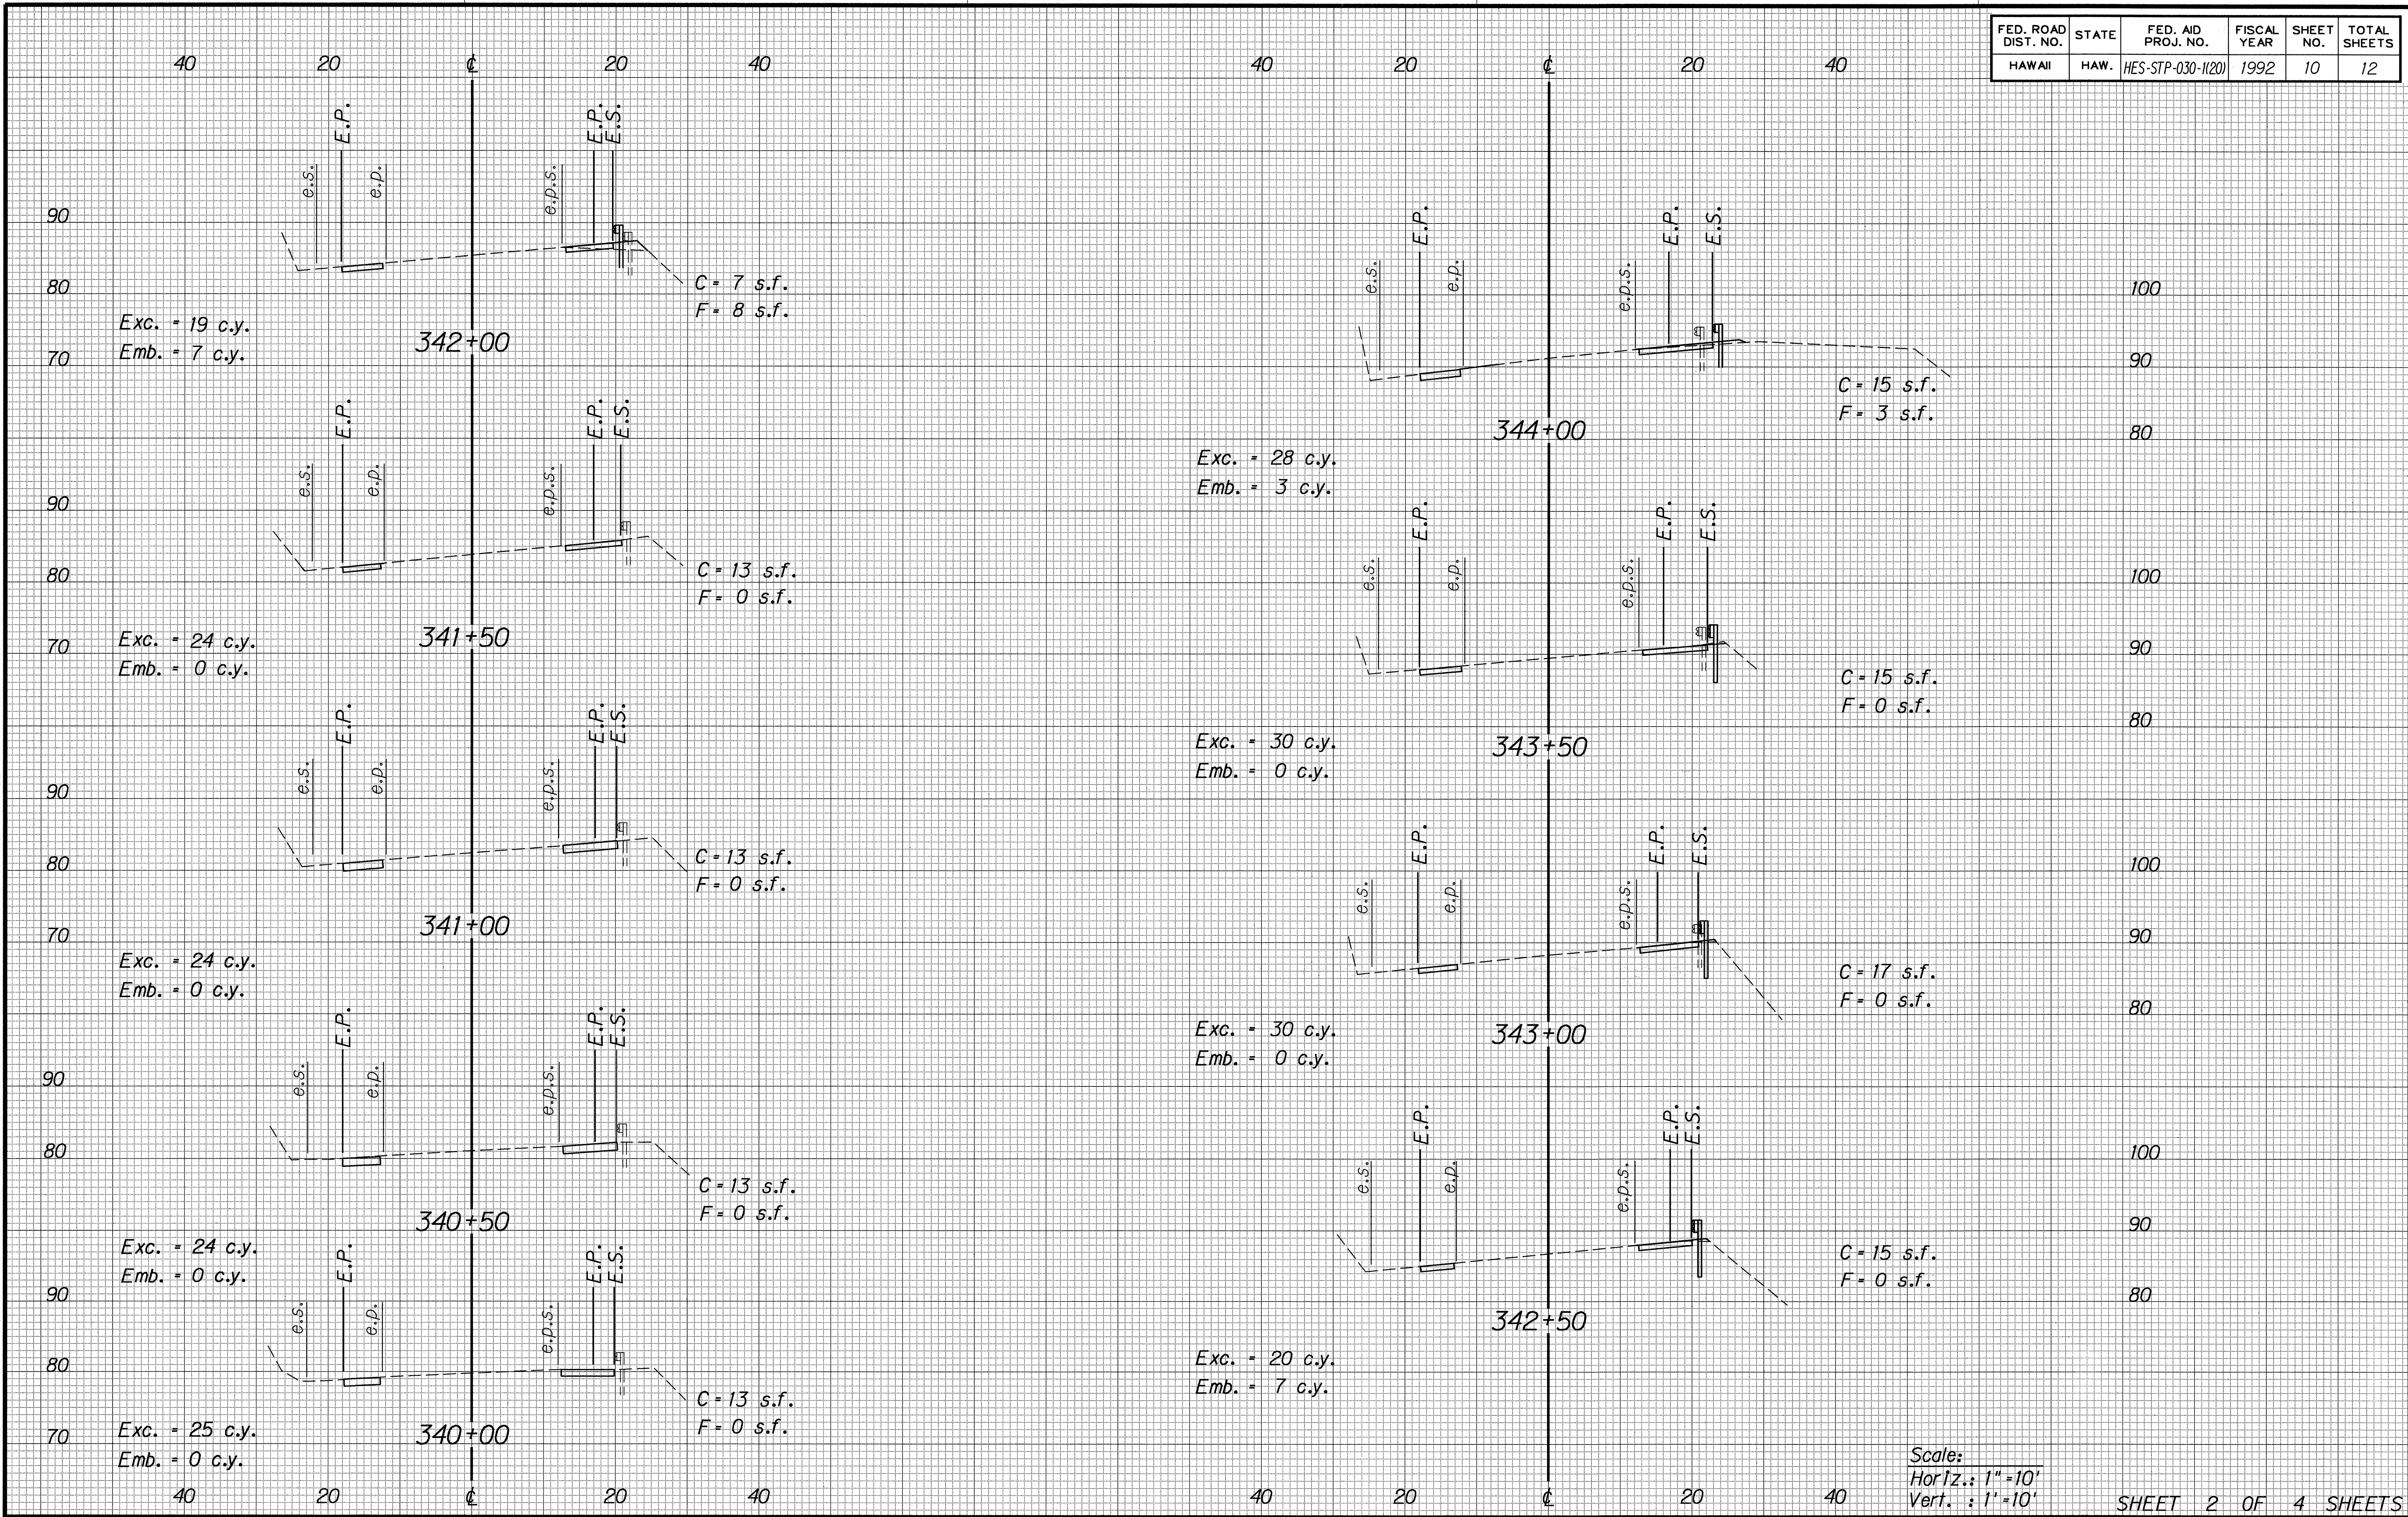

ORIGINAL
PLAN
DESIGNED BY
NOTED BOOK
QUANTITIES BY
CHECKED BY

SURVEY PLOTTED BY
DATE


FED. ROAD DIST. NO.	STATE	FED. AID PROJ. NO.	FISCAL YEAR	SHEET NO.	TOTAL SHEETS
HAWAII	HAW.	HES-STP-030-1(20)	1992	11	12

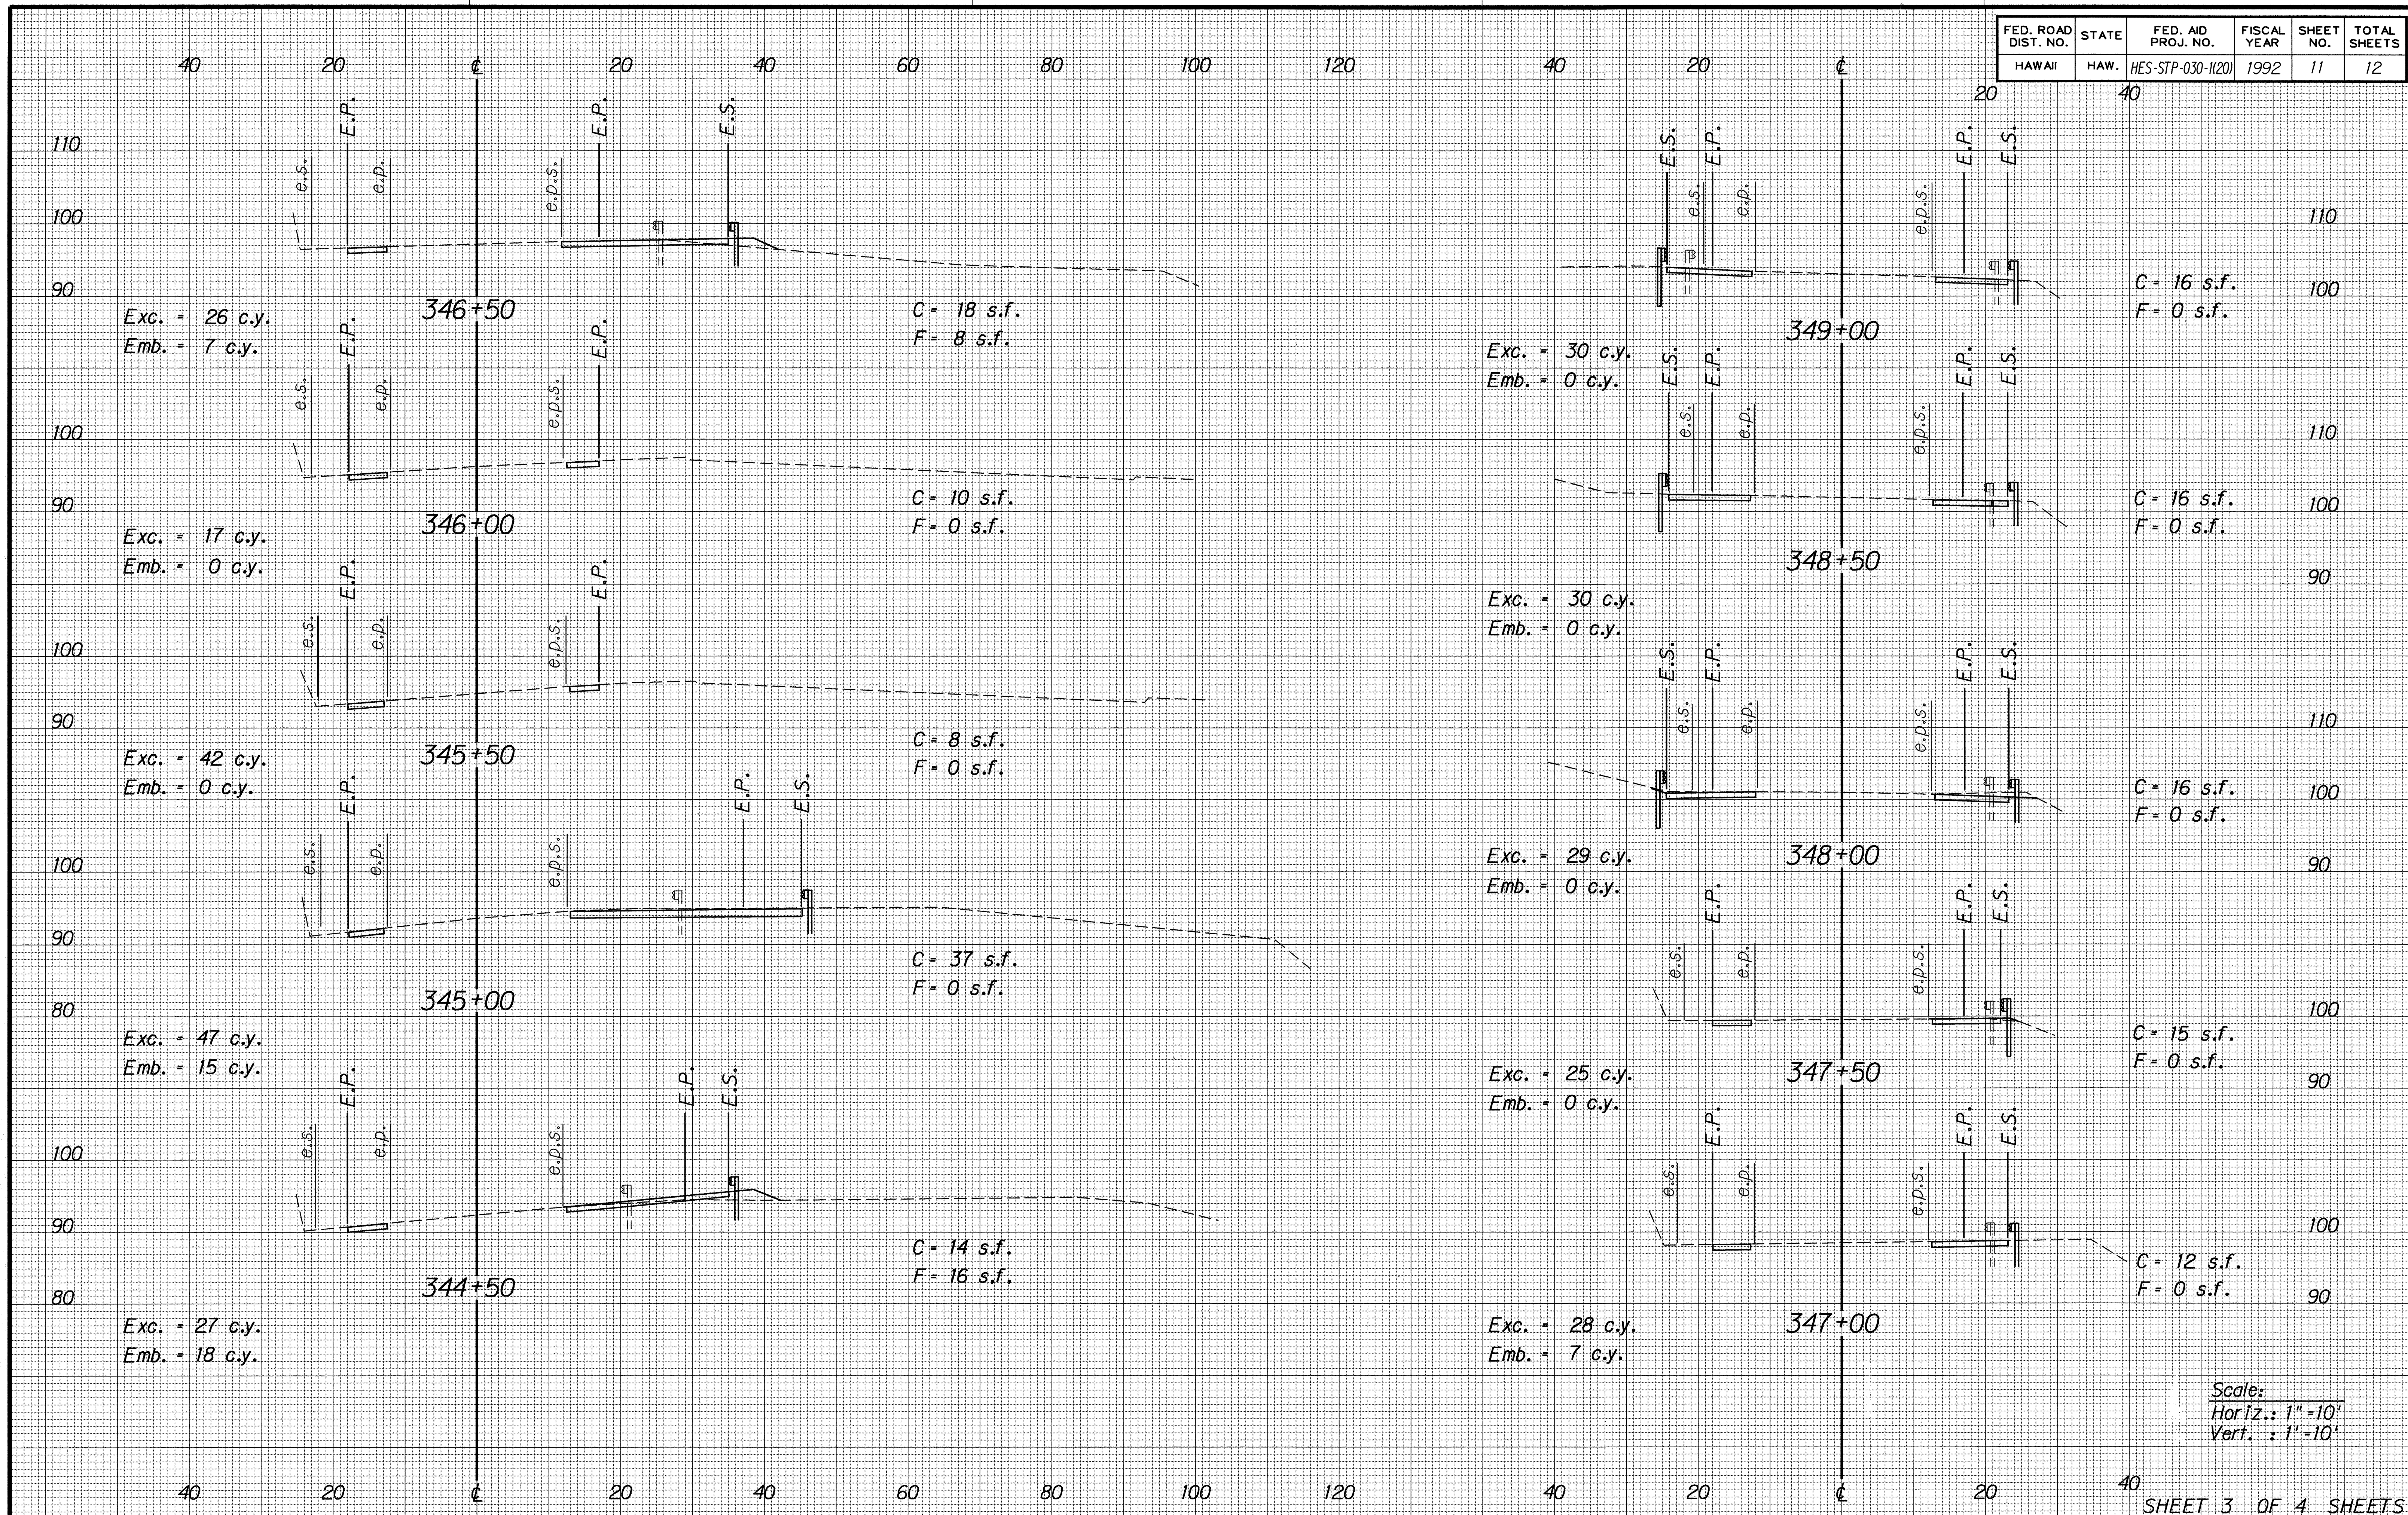

ORIGINAL PLAN	SURVEY PLOTTED BY	DATE
NOTES BOOK	DESIGNED BY	
QUANTITIES BY	CHECKED BY	
5/10/00		

5/10/00

FED. ROAD DIST. NO.	STATE	FED. AID PROJ. NO.	FISCAL YEAR	SHEET NO.	TOTAL SHEETS
HAWAII	HAW.	HES-STP-030-11(20)	1992	12	12

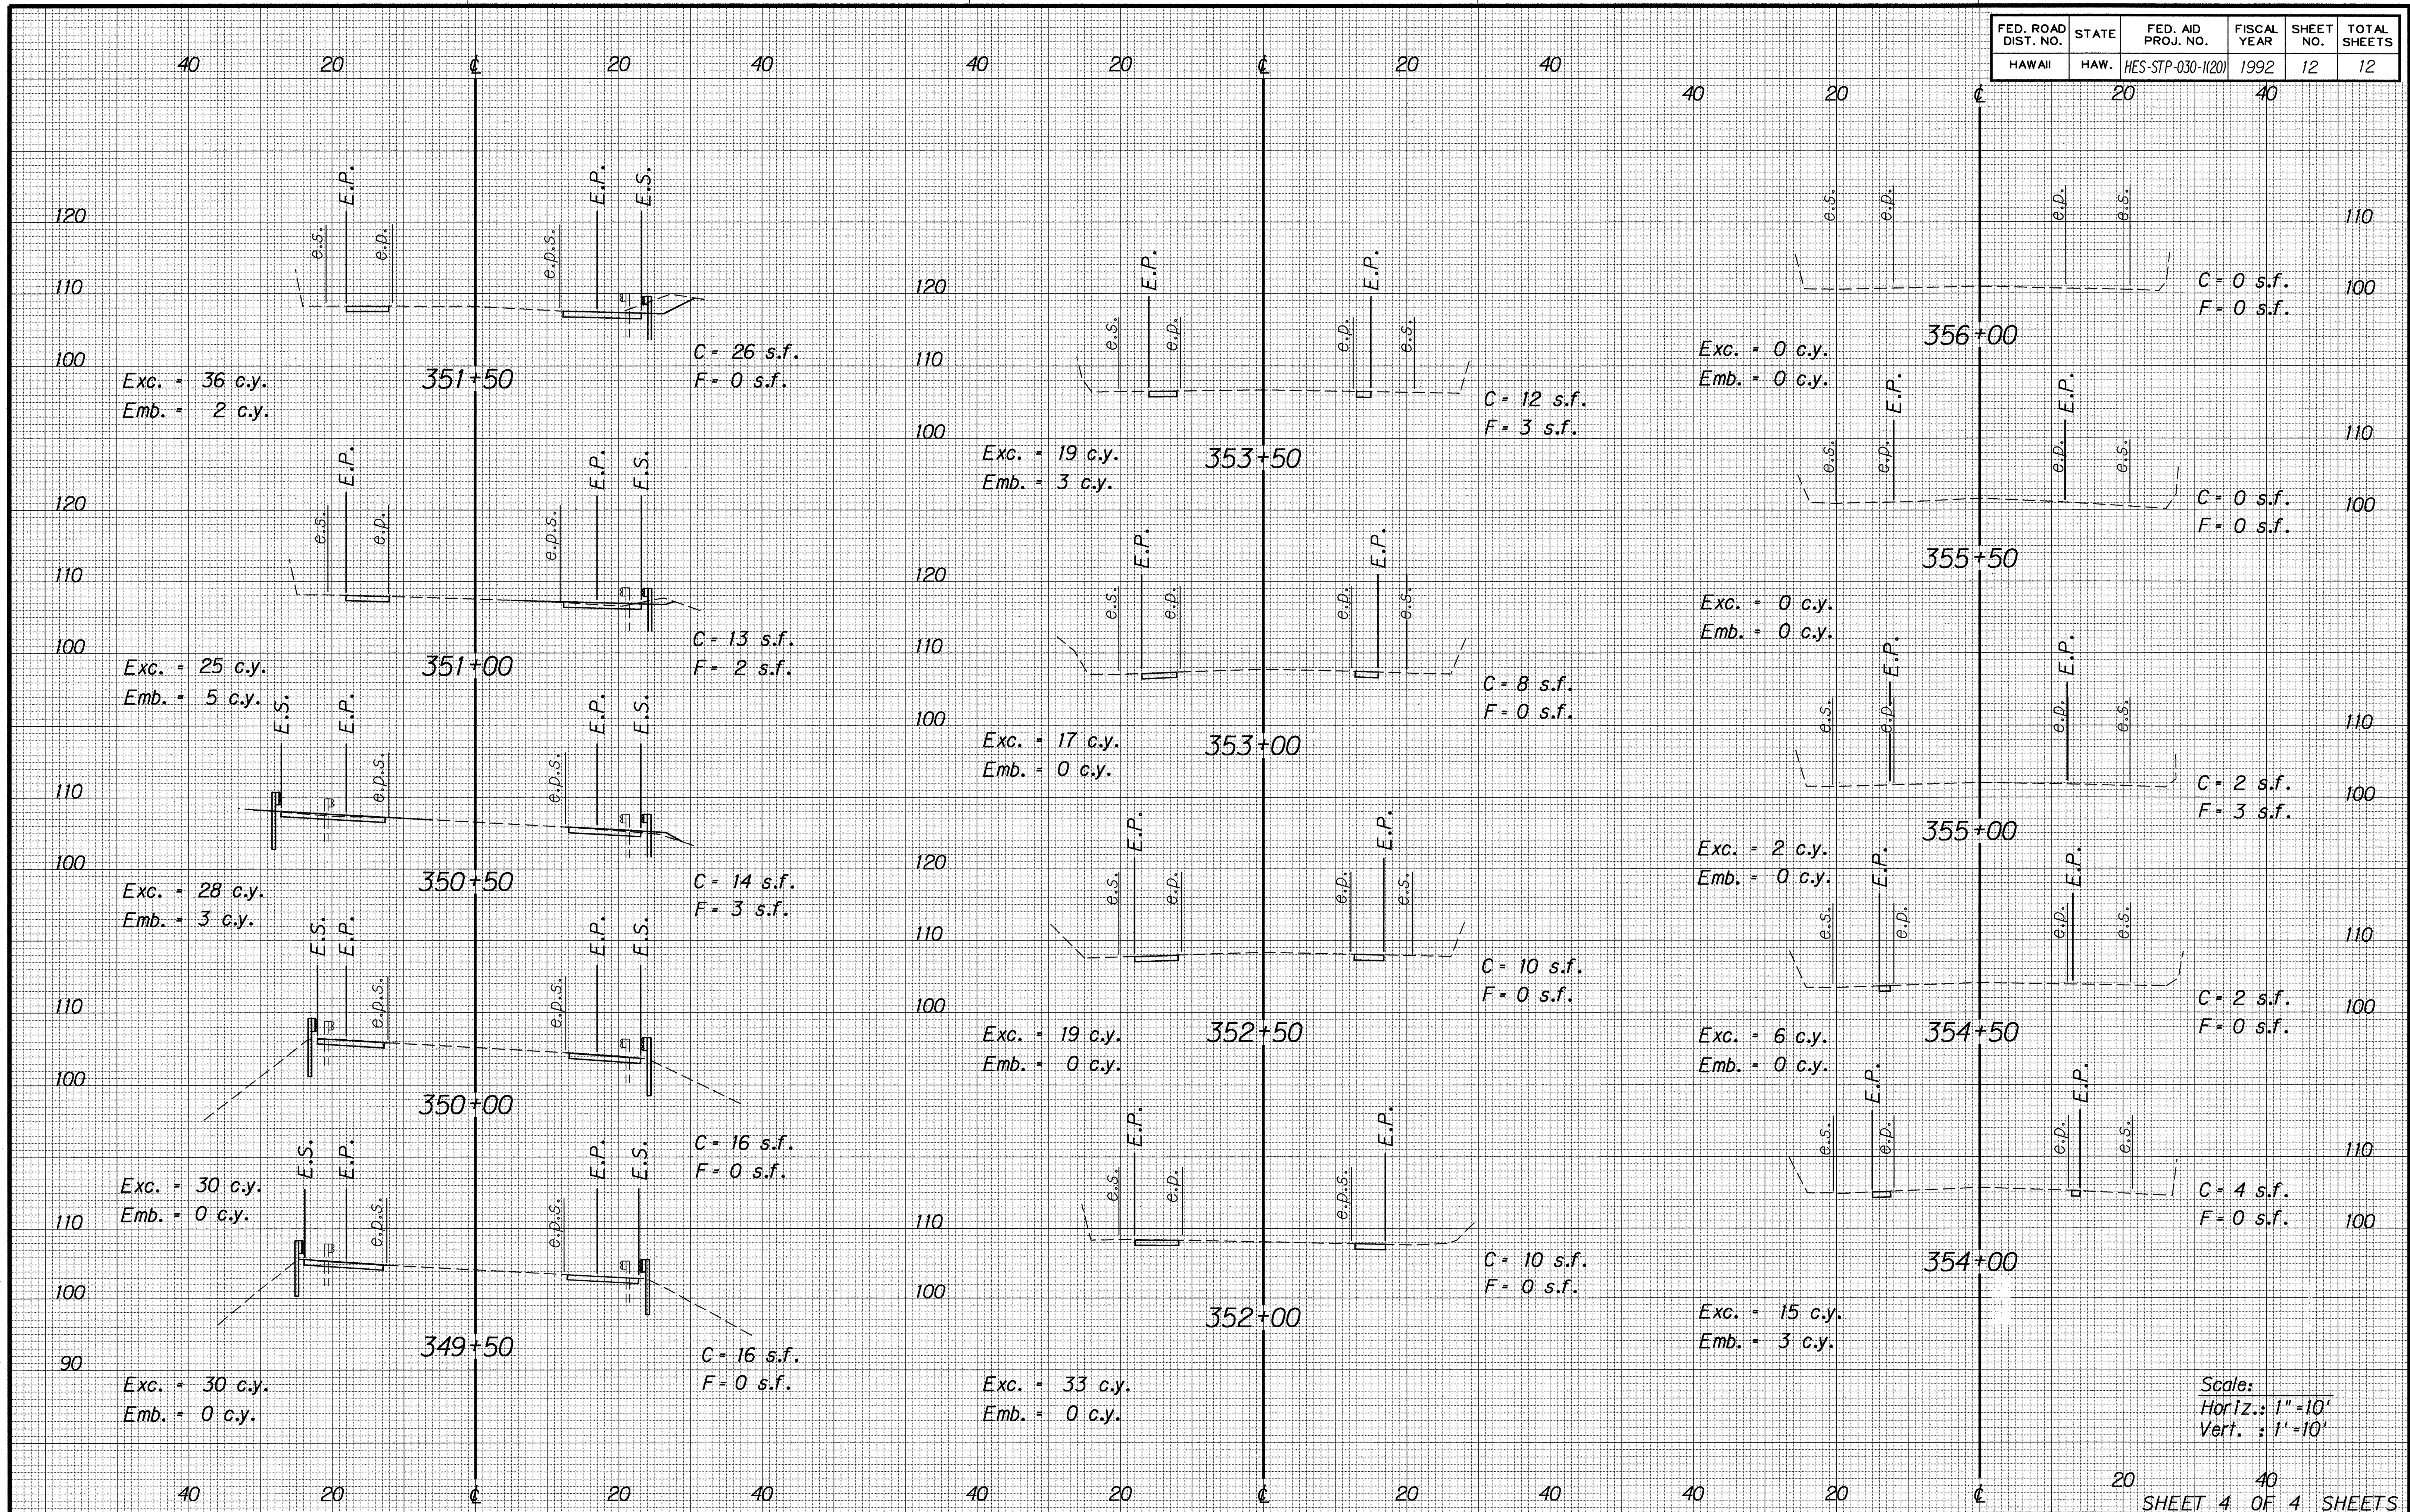

Scale:
Horiz.: 1"=10'
Vert.: 1"=10'