

STATE OF HAWAII

DEPARTMENT OF TRANSPORTATION

HIGHWAYS DIVISION

HONOLULU, HAWAII

PLANS FOR




HONOAPIILANI HIGHWAY RESURFACING

PUAMANA TO OLOWALU

FED. AID PROJECT NO. STP-030-1(21)


DISTRICT OF LAHAINA

ISLAND OF MAUI

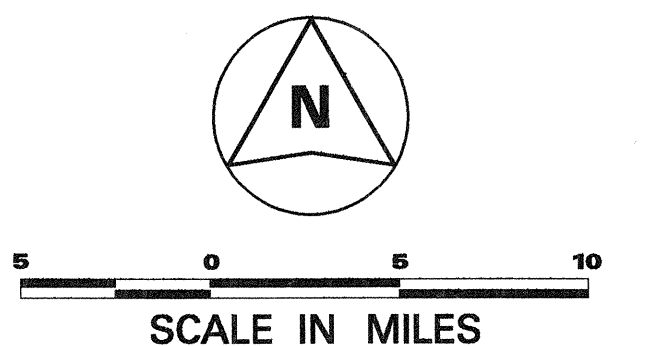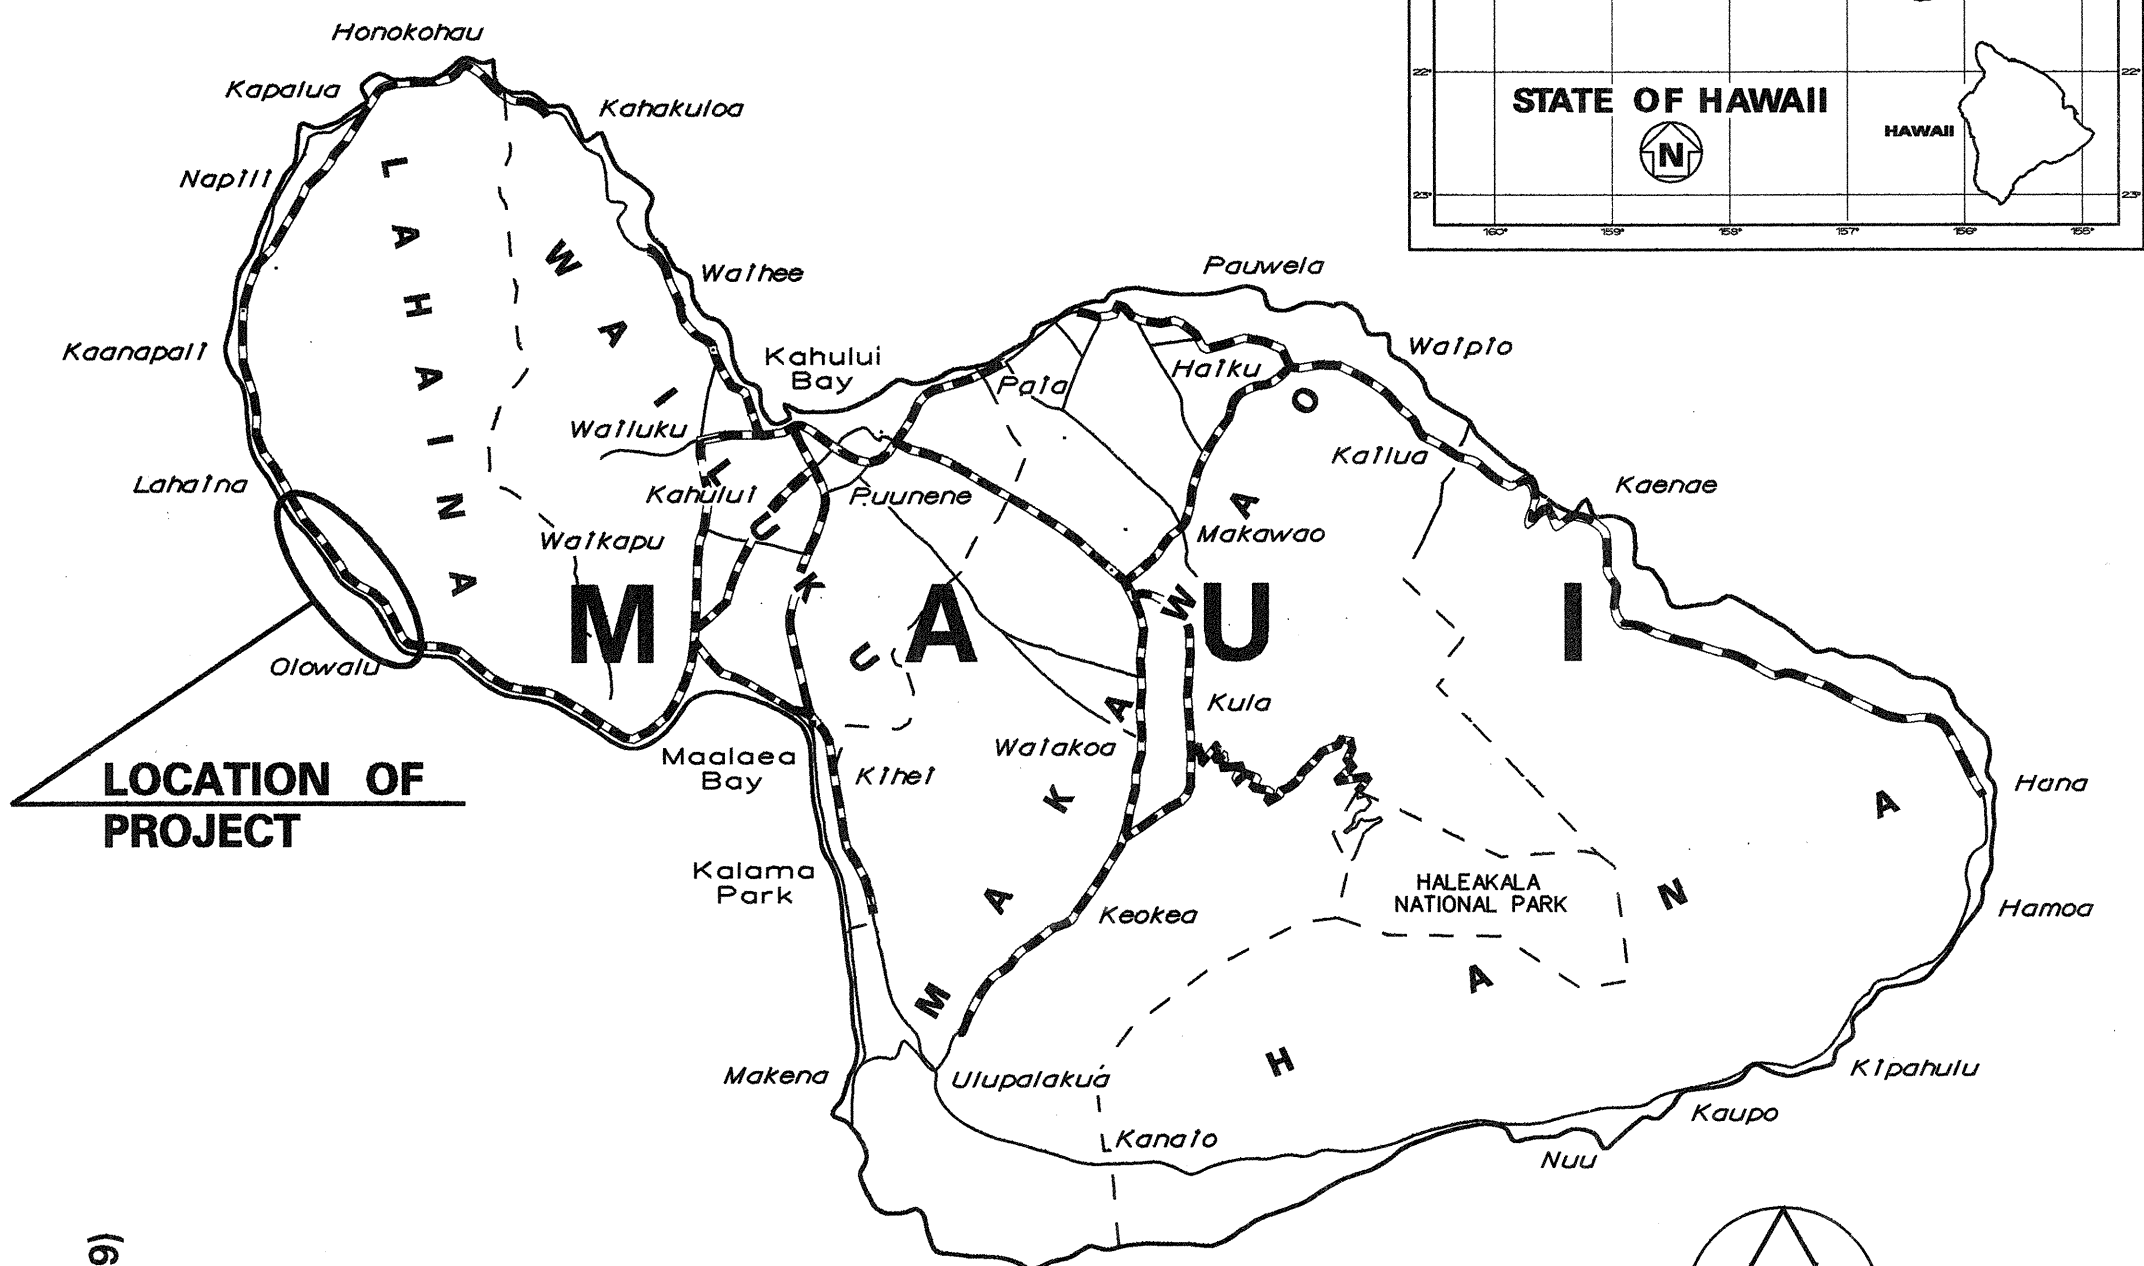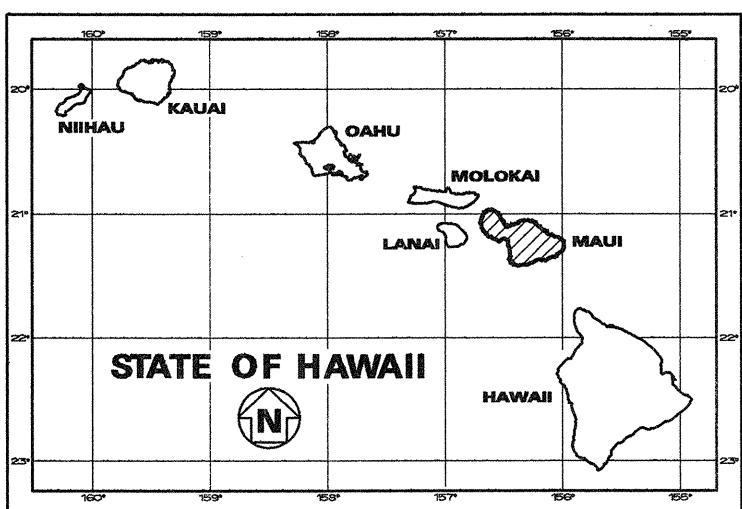


MILE POST 19.37 TO MILE POST 14.62

ADT (1993)	23,300
ADT (2003)	34,300
V	50 M.P.H.

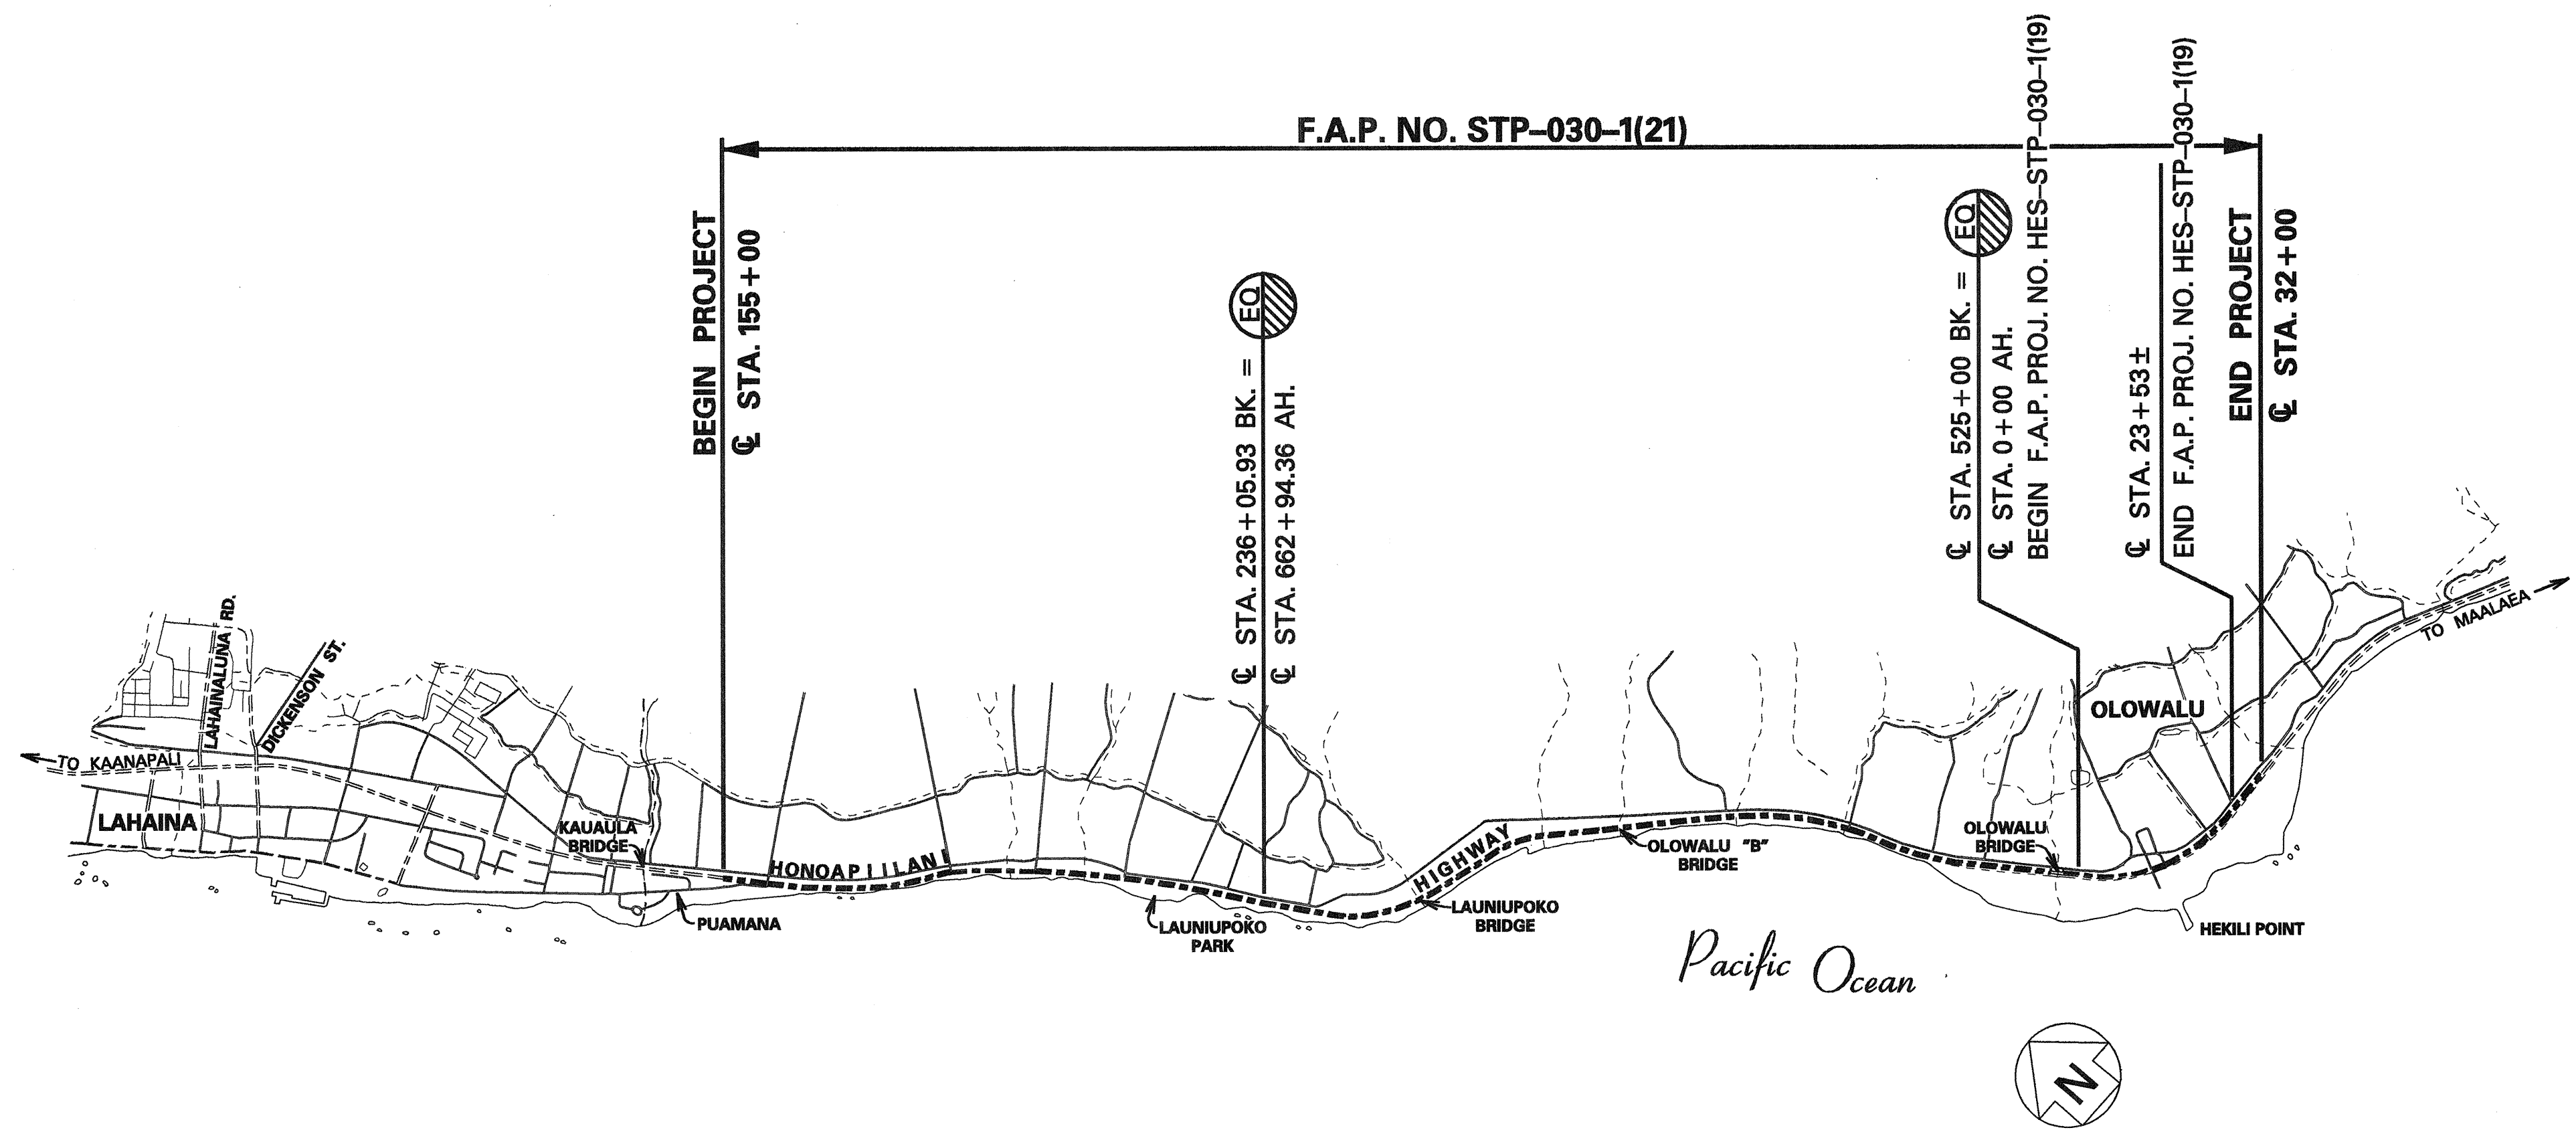

LENGTH OF PROJECT4.75 MILES

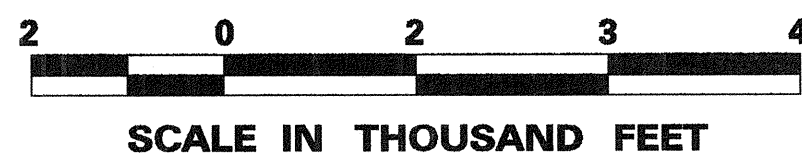

DEPARTMENT OF TRANSPORTATION STATE OF HAWAII	
APPROVED: 	
for DIR. OF TRANSPORTATION	5/21/93 DATE