




ORIGINAL
PLAN
SURVEY PLOTTED BY
DRAWN BY C. P. P. P.
NOTED BY C. P. P. P.
DESIGNED BY C. P. P. P.
CHECKED BY C. P. P. P.
DATE: Mar. 1994

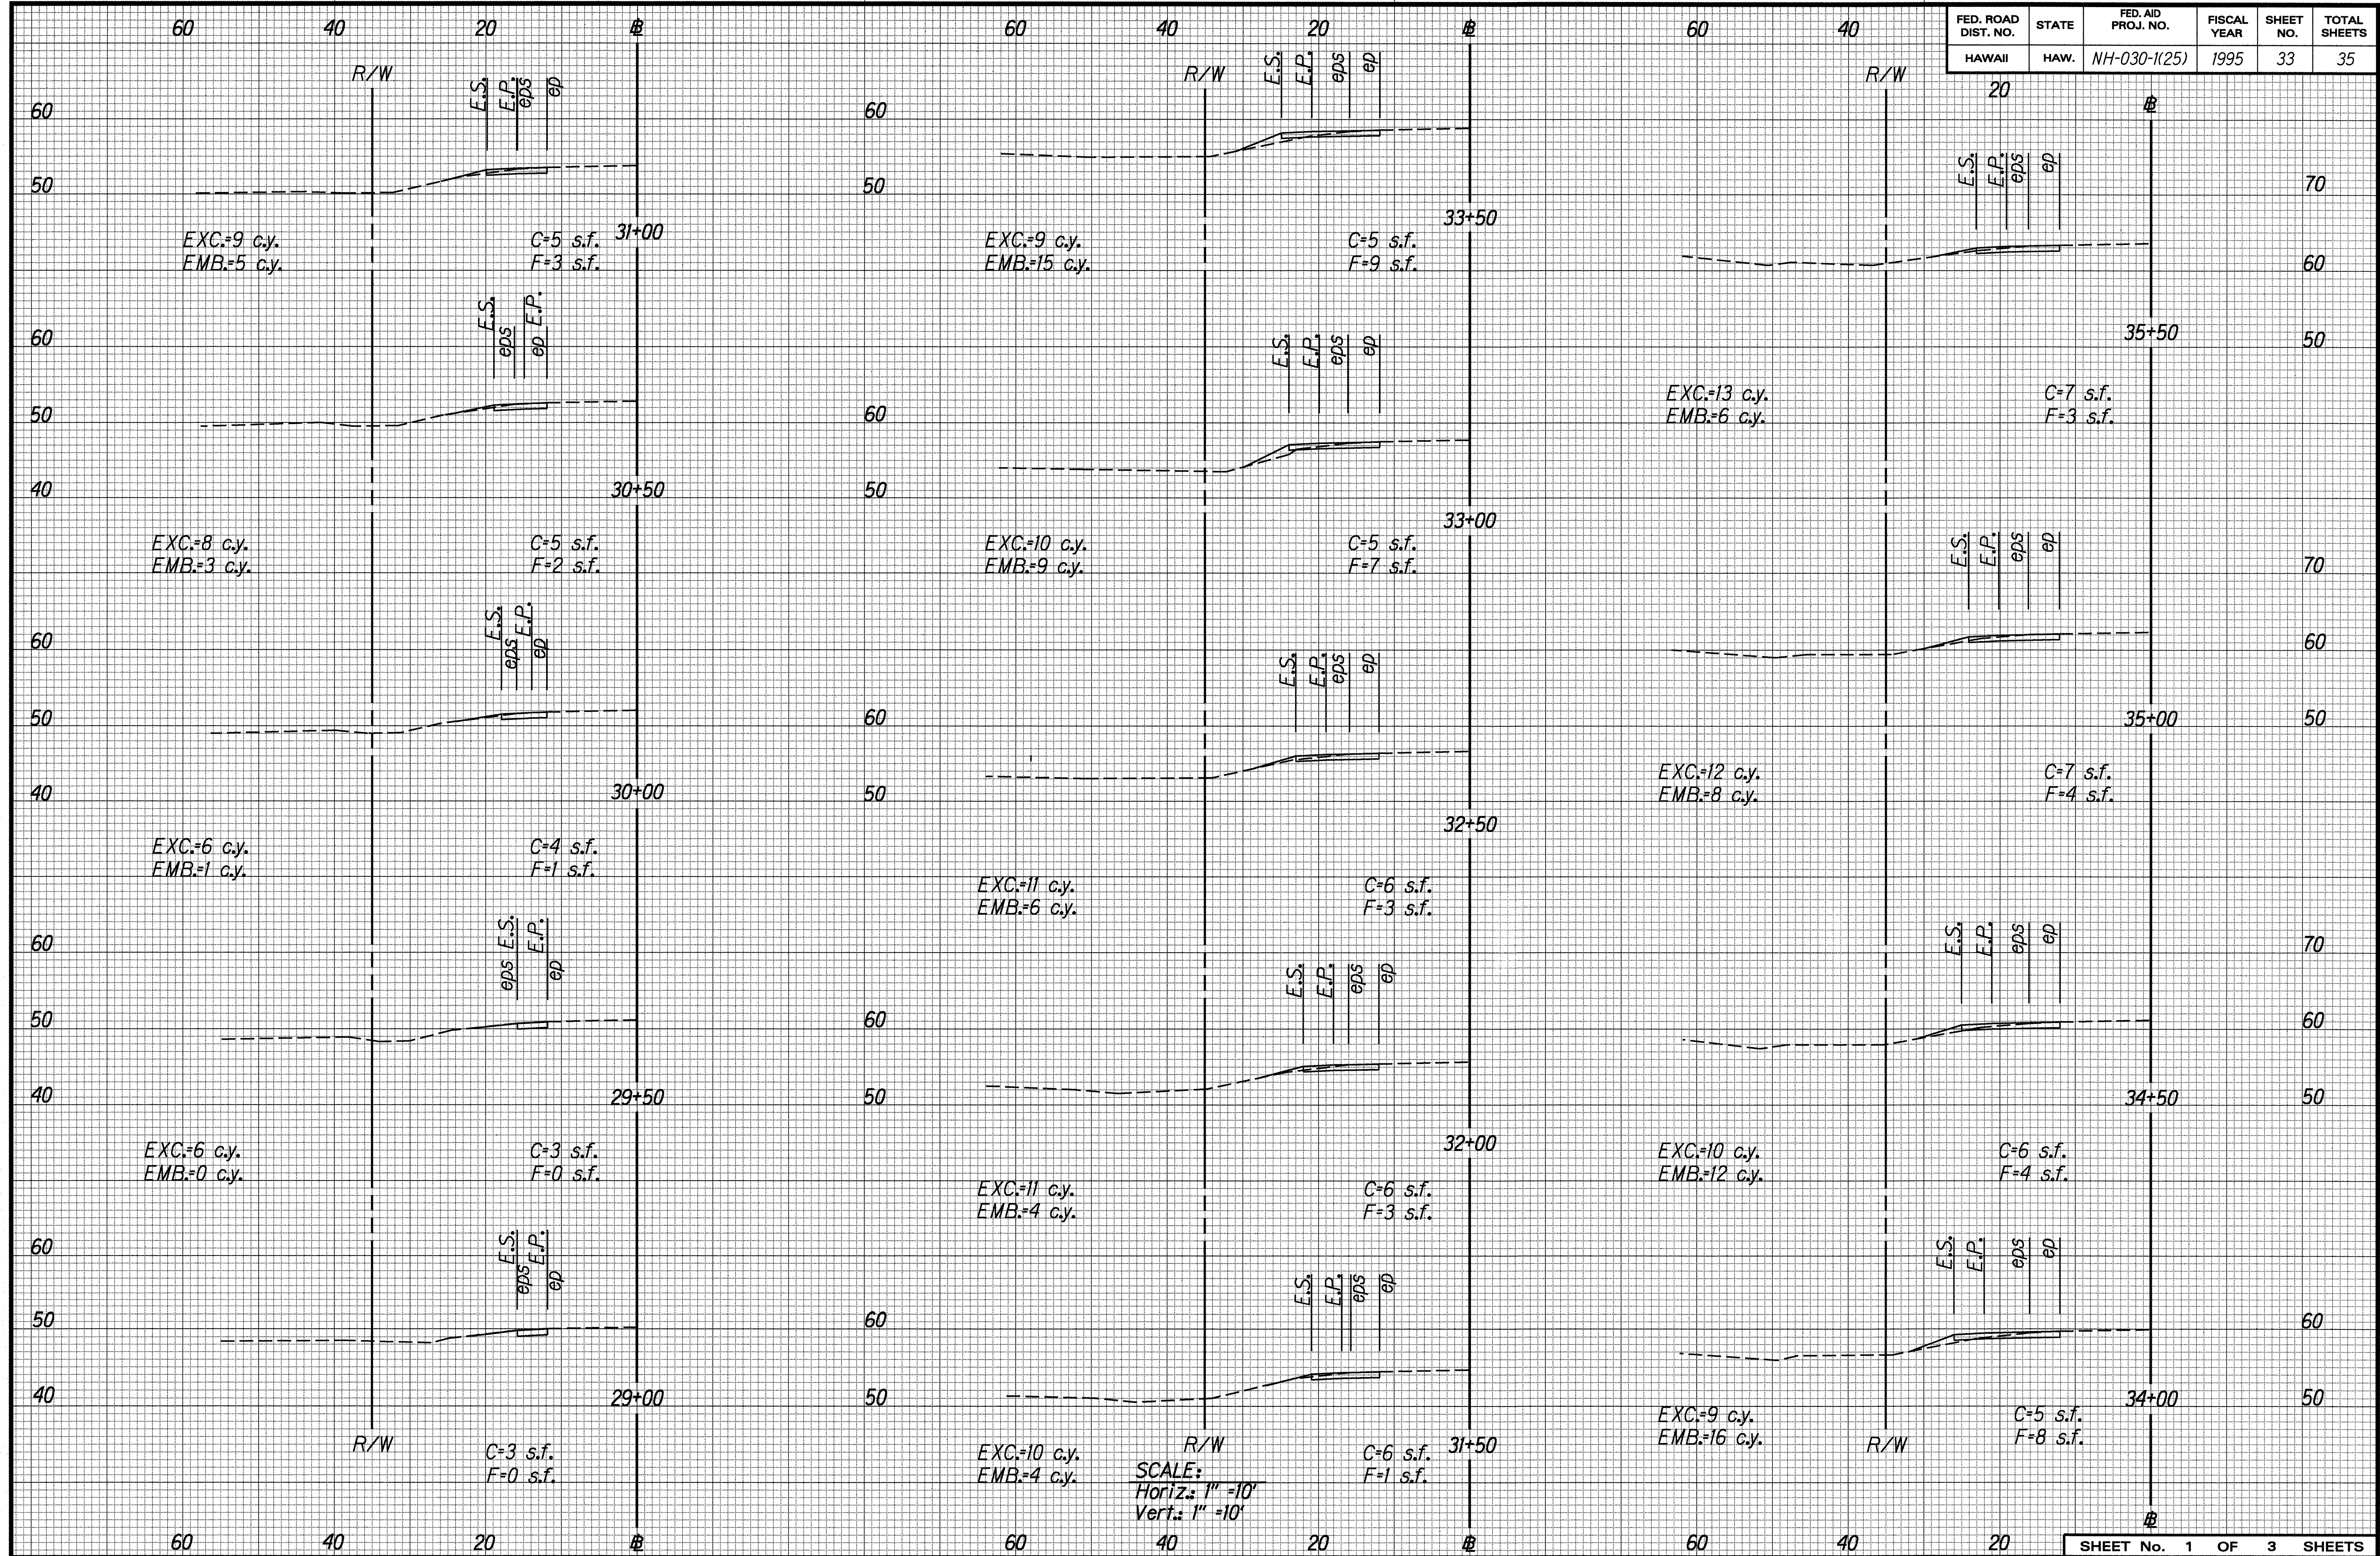

ORIGINAL
PLAN
DATE
MAY 1994
SURVEY PLOTTED BY
DRAFTER BY C. Pagan
NOTE BOOK
DESIGNED BY G. Pagan
CHECKED BY
S. Thomas

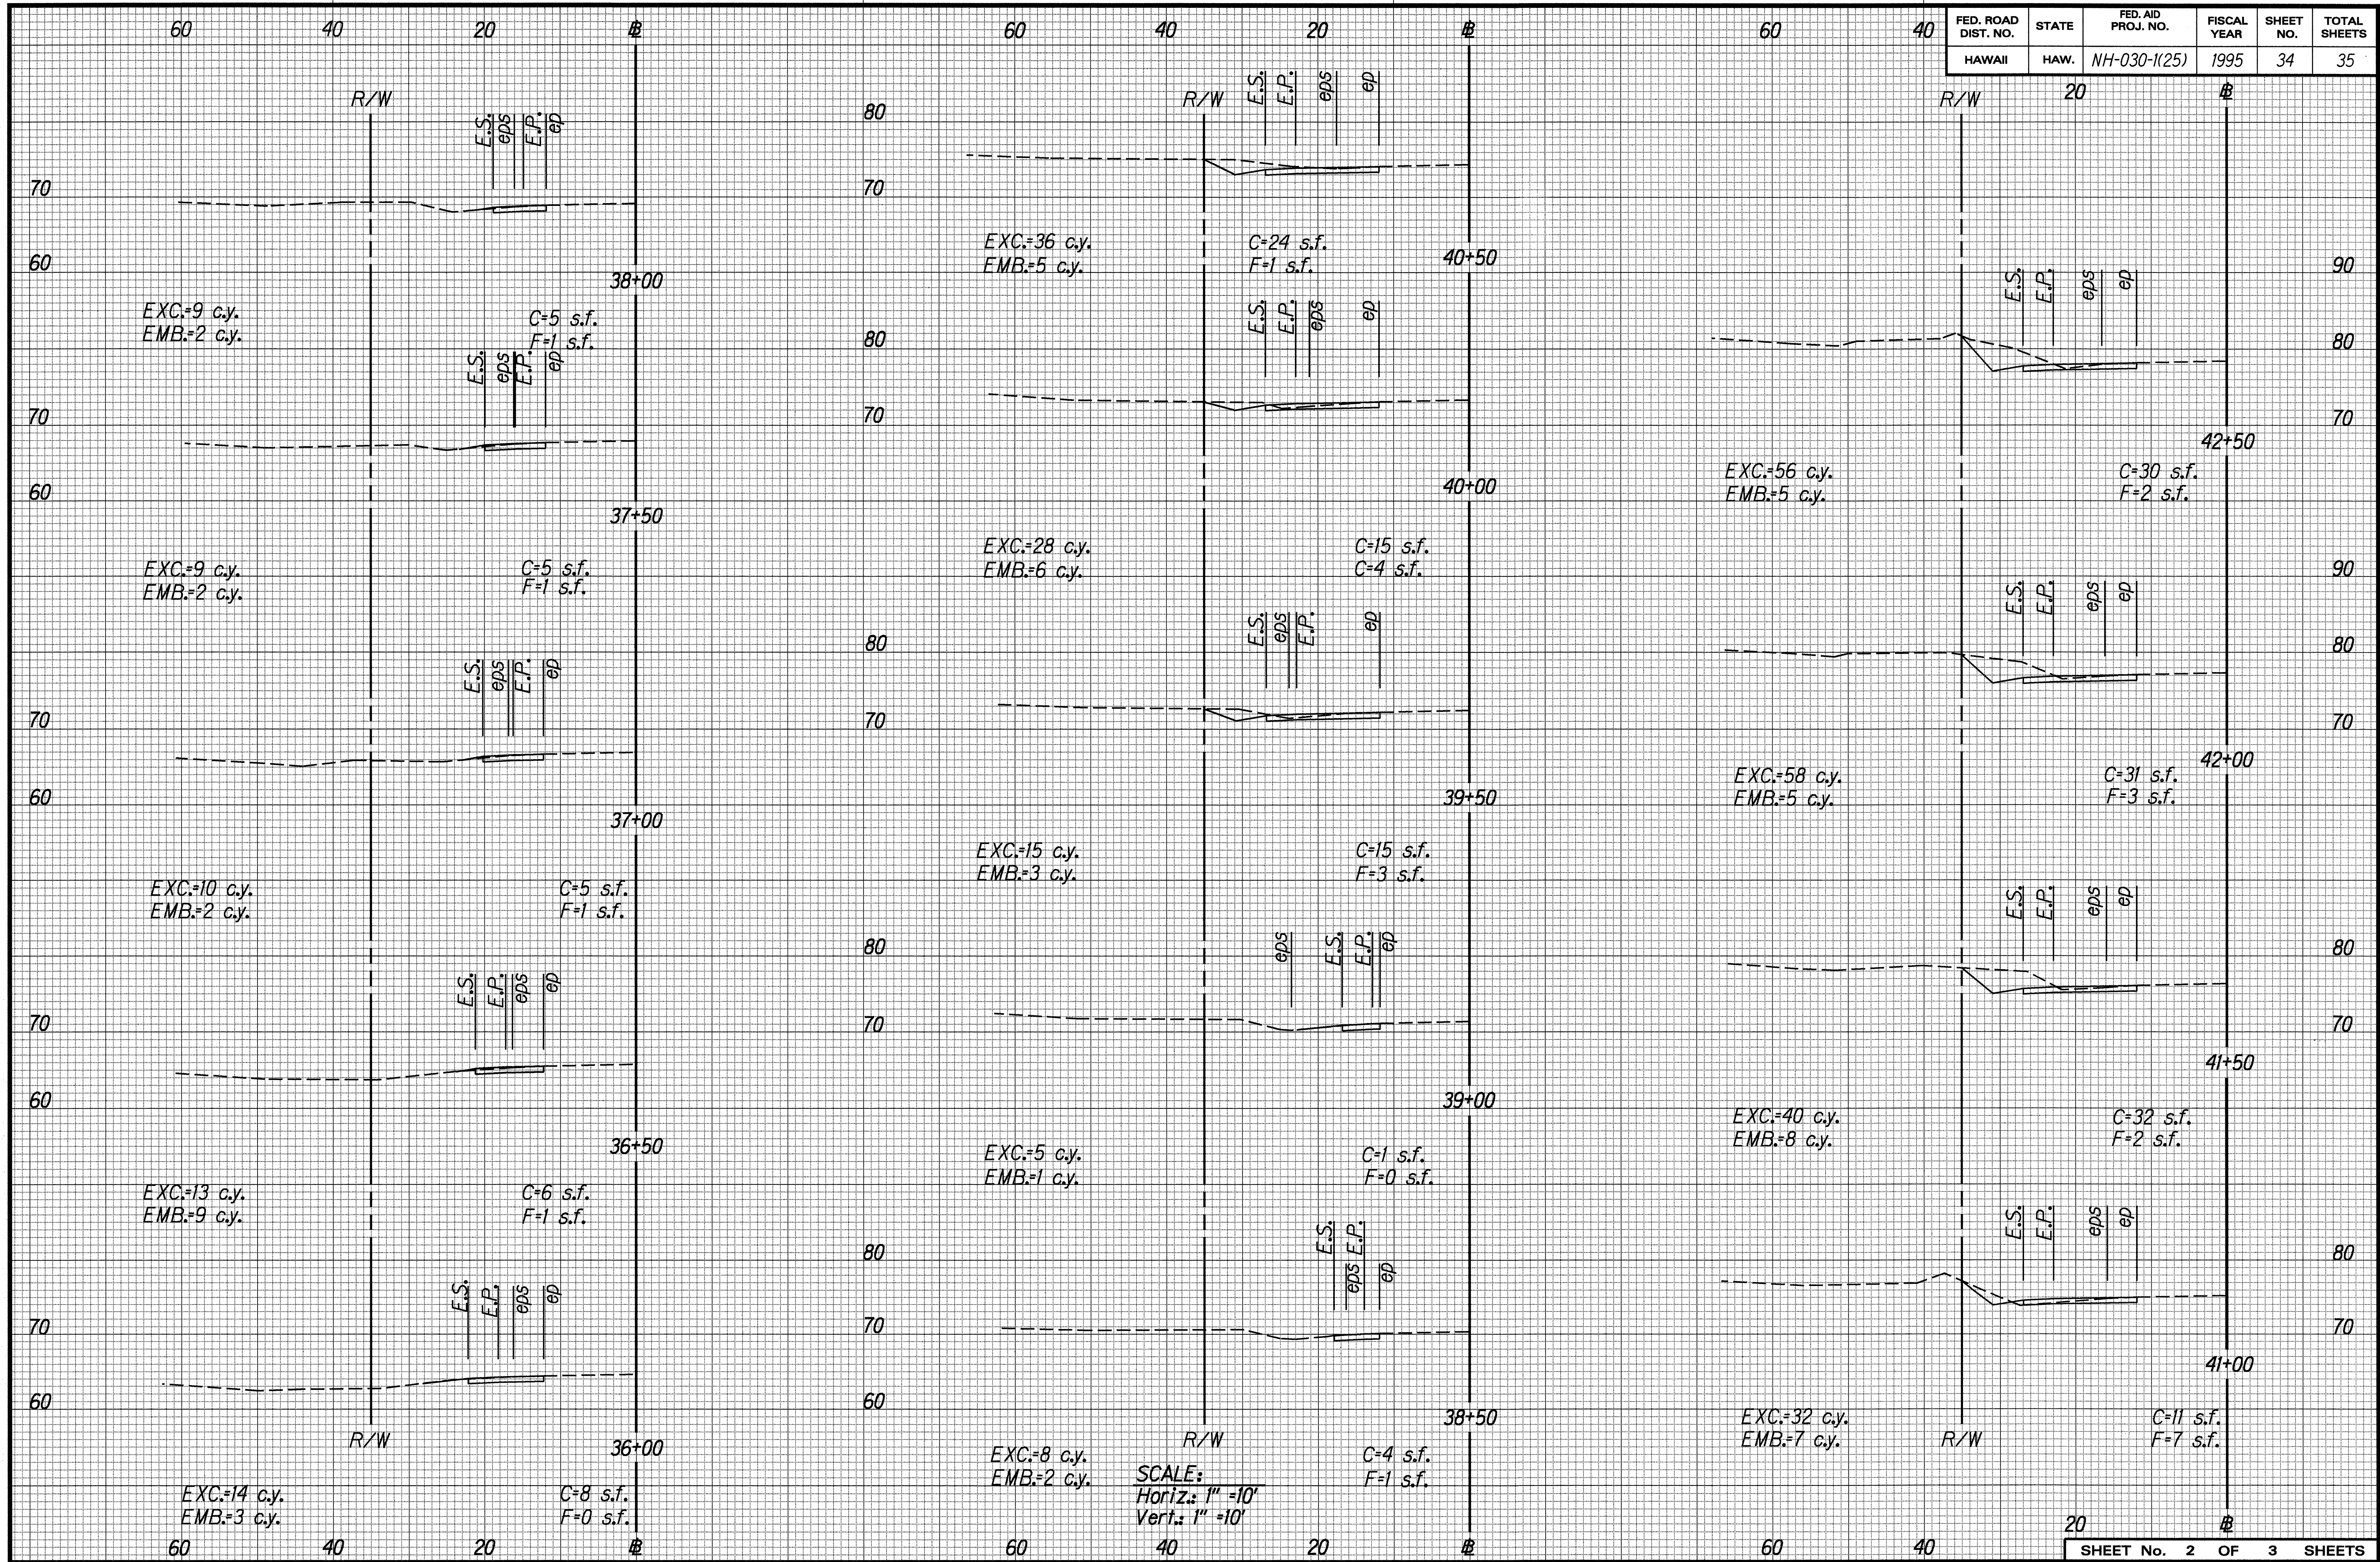

FED. ROAD DIST. NO.	STATE	FED. AID PROJ. NO.	FISCAL YEAR	SHEET NO.	TOTAL SHEETS
HAWAII	HAW.	NH-030-1(25)	1995	35	35

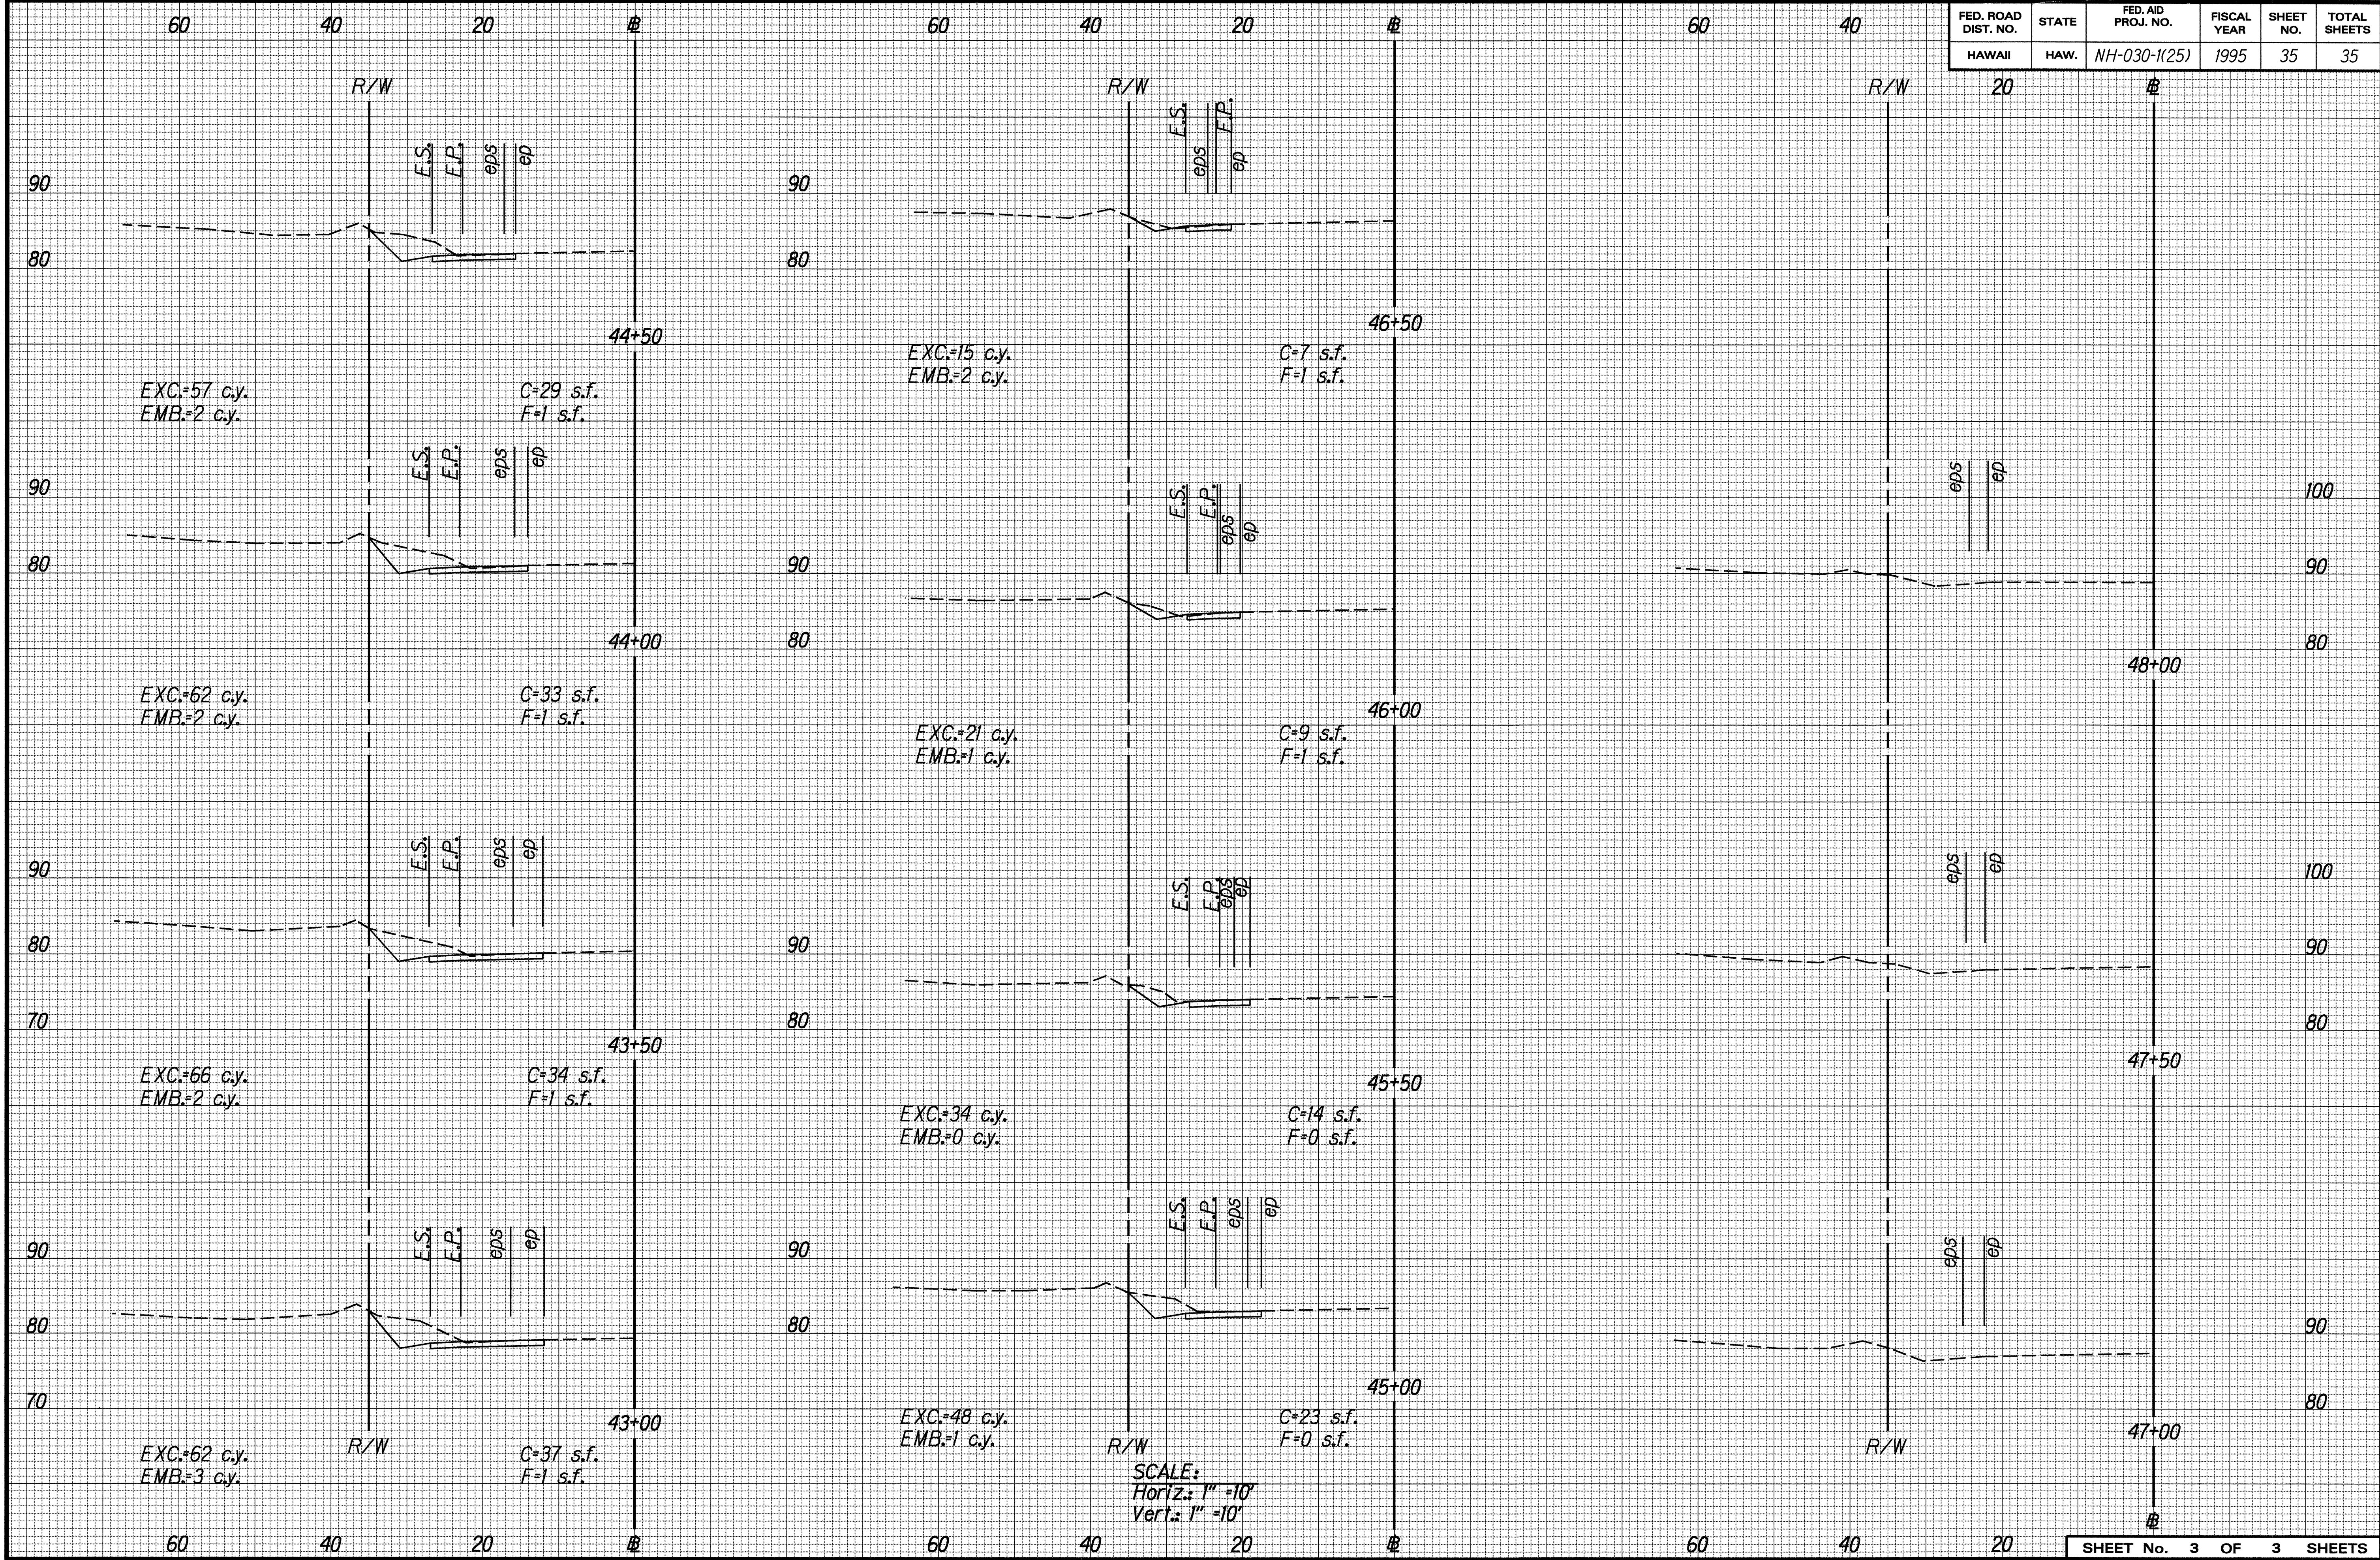

ORIGINAL PLAN
SURVEY PLATTED BY
DRAWN BY C. Engala
NOTED BY C. Engala
DESIGNED BY C. Engala
CHECKED BY C. Engala
DATE: Mar. 1994