	INDEX TO DRAWINGS
SHEET NO.	DESCRIPTION
1	TITLE SHEET
2	STANDARD PLANS SUMMARY
3	GENERAL NOTES AND LEGEND
4 – 5	TYPICAL SECTION AND DETAILS
6 – 9	GUARDRAIL DETAILS
10 – 17	ROADWAY PLANS
18 – 25	SIGNING & PAVEMENT MARKING
	PLANS
26	MISCELLANEOUS SUMMARIES

STATE OF HAWAII

DEPARTMENT OF TRANSPORTATION


HIGHWAYS DIVISION HONOLULU, HAWAII

"AS-BUILT"
PLANS FOR

KAHEKILI HIGHWAY RESURFACING PAPANAHOA SECTION

DISTRICTS OF WAILUKU AND LAHAINA
ISLAND OF MAUI

PROJECT NO. 30A-01-95M

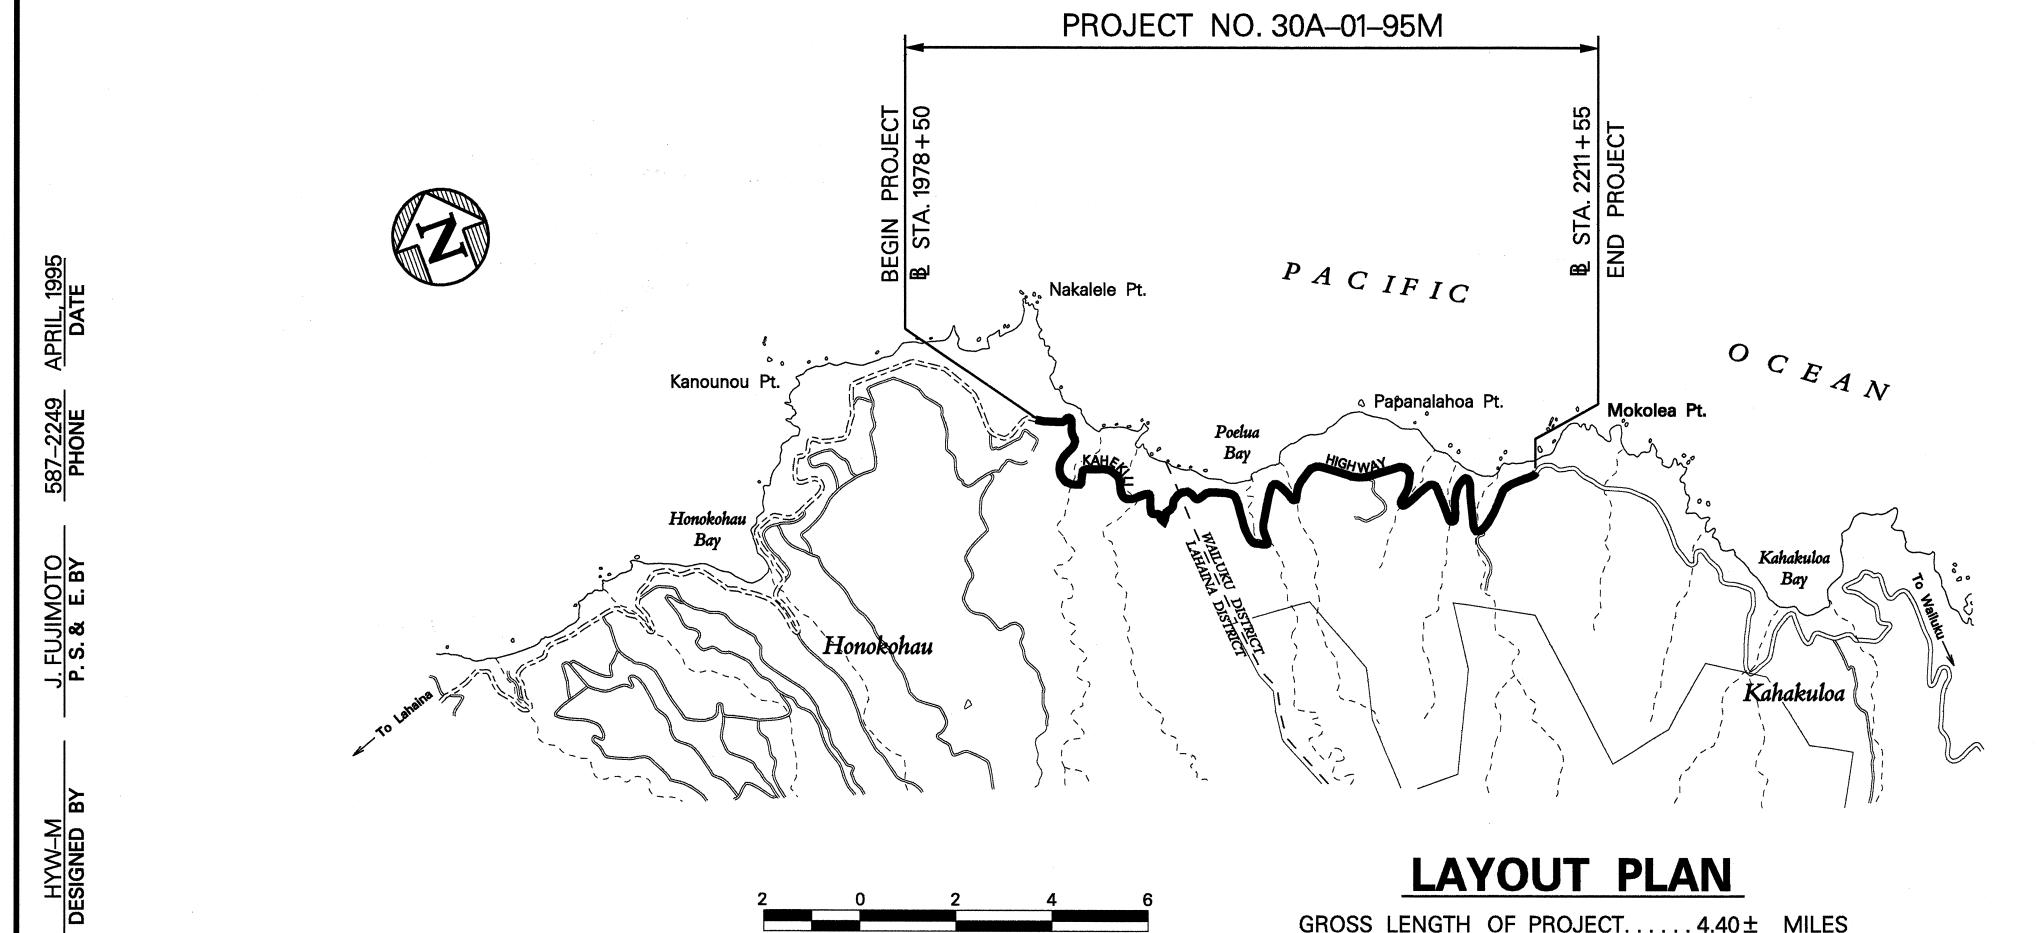

SCALE IN THOUSAND FEET

FED. ROAD DIST. NO.

PROJ. NO.

FEDERAL AID PROJECTS PREVIOUSLY CONSTRUCTED OR UNDER CONSTRUCTION

ROUTE 30 MILE POST $37.29 \pm$ TO MILE POST $41.67 \pm$

CHANGES MADE DURING CONSTRUCTION HAVE BEEN INCORPORATED ON THESE PLANS EXCEPT CHANGES IN THE ORIGINAL THEORETICAL QUANTITIES. FOR ACTUAL QUANTITIES, REFER TO PROJECT LEDGER AND/OR COMPUTATION BOOK.

RESIDENT ENGINEER

9-22-97 DATE

GROSS LENGTH OF PROJECT.....4.40 ± MILES NET LENGTH OF PROJECT.....4.40 ± MILES

DEPARTMENT OF TRANSPORTATION STATE OF HAWAII

APPROVED:

DIR. OF TRANSPORTATION