



FED. ROAD DIST. NO.	STATE	FED. AID PROJ. NO.	FISCAL YEAR	SHEET NO.	TOTAL SHEETS
HAWAII	HAW.	NH-030-1(26)	1996	8	20

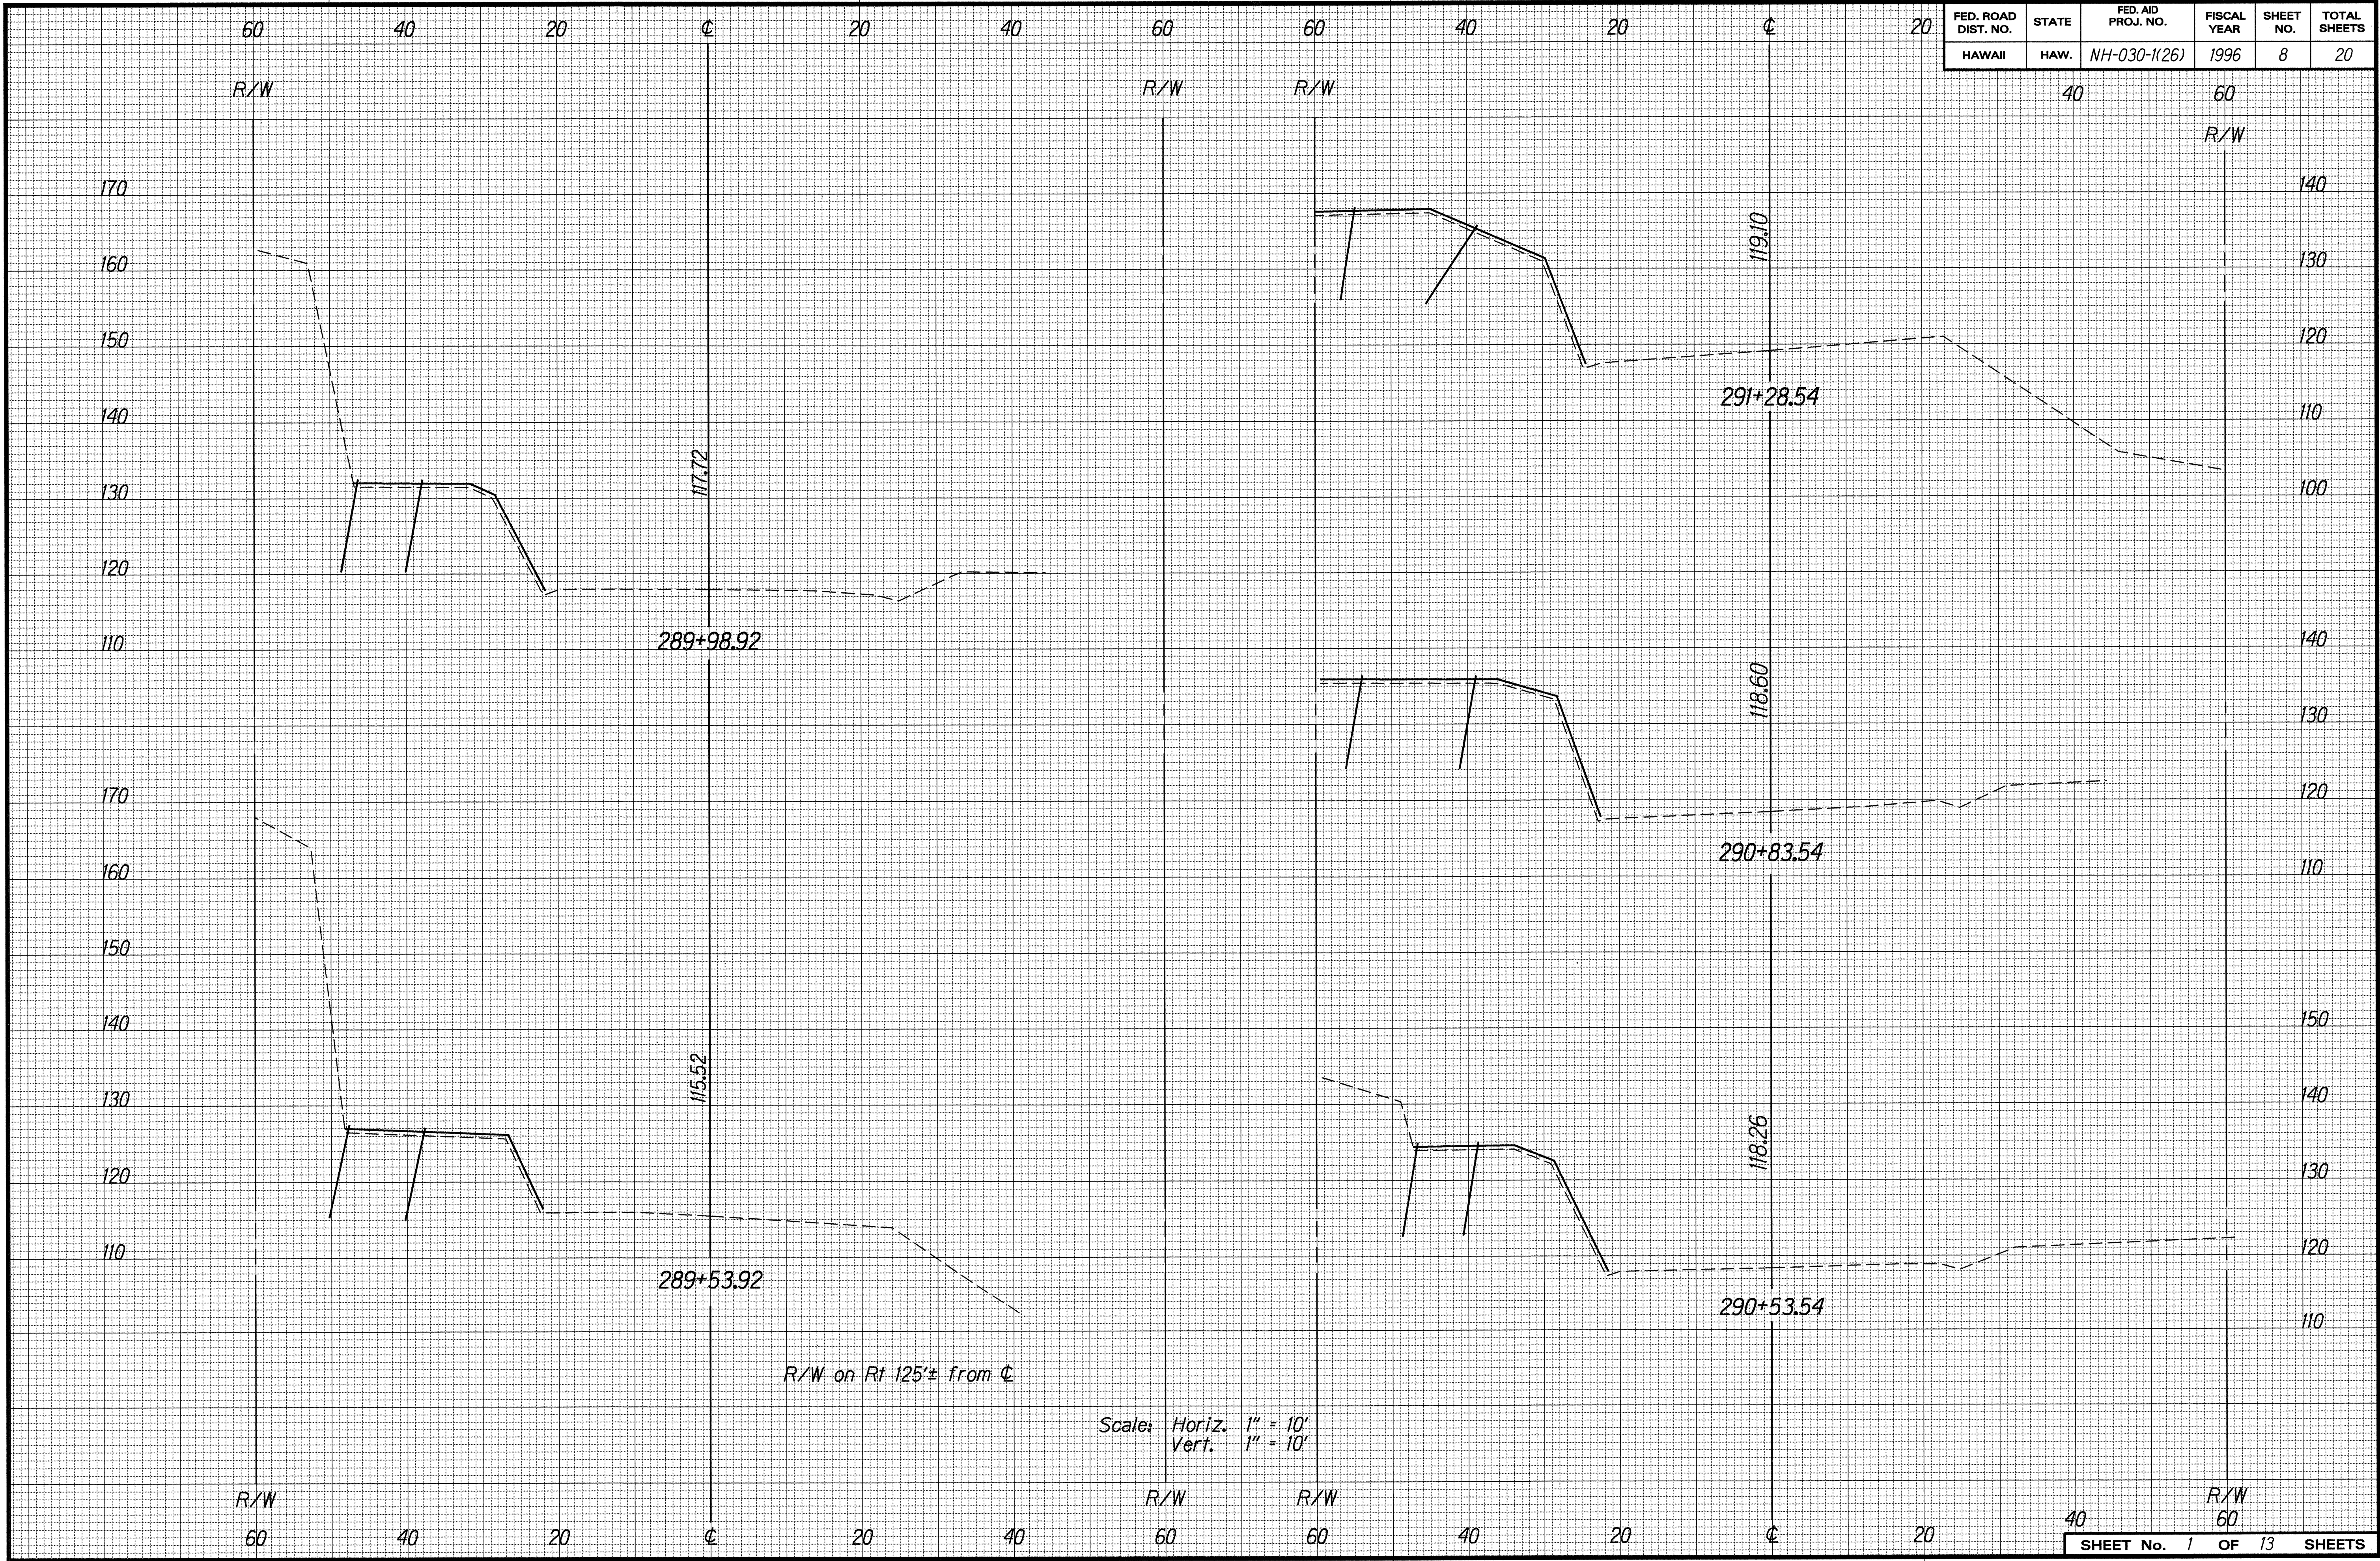


ORIGINAL PLAN
 SURVEY PLOTTED BY
 DRAWN BY K. Lomahila
 TRACED BY R. Takasui/D. Taniuchi
 NOTE BOOK
 QUANTITIES BY
 CHECKED BY

FED. ROAD DIST. NO.	STATE	FED. AID PROJ. NO.	FISCAL YEAR	SHEET NO.	TOTAL SHEETS
HAWAII	HAW.	NH-030-1(26)	1996	9	20

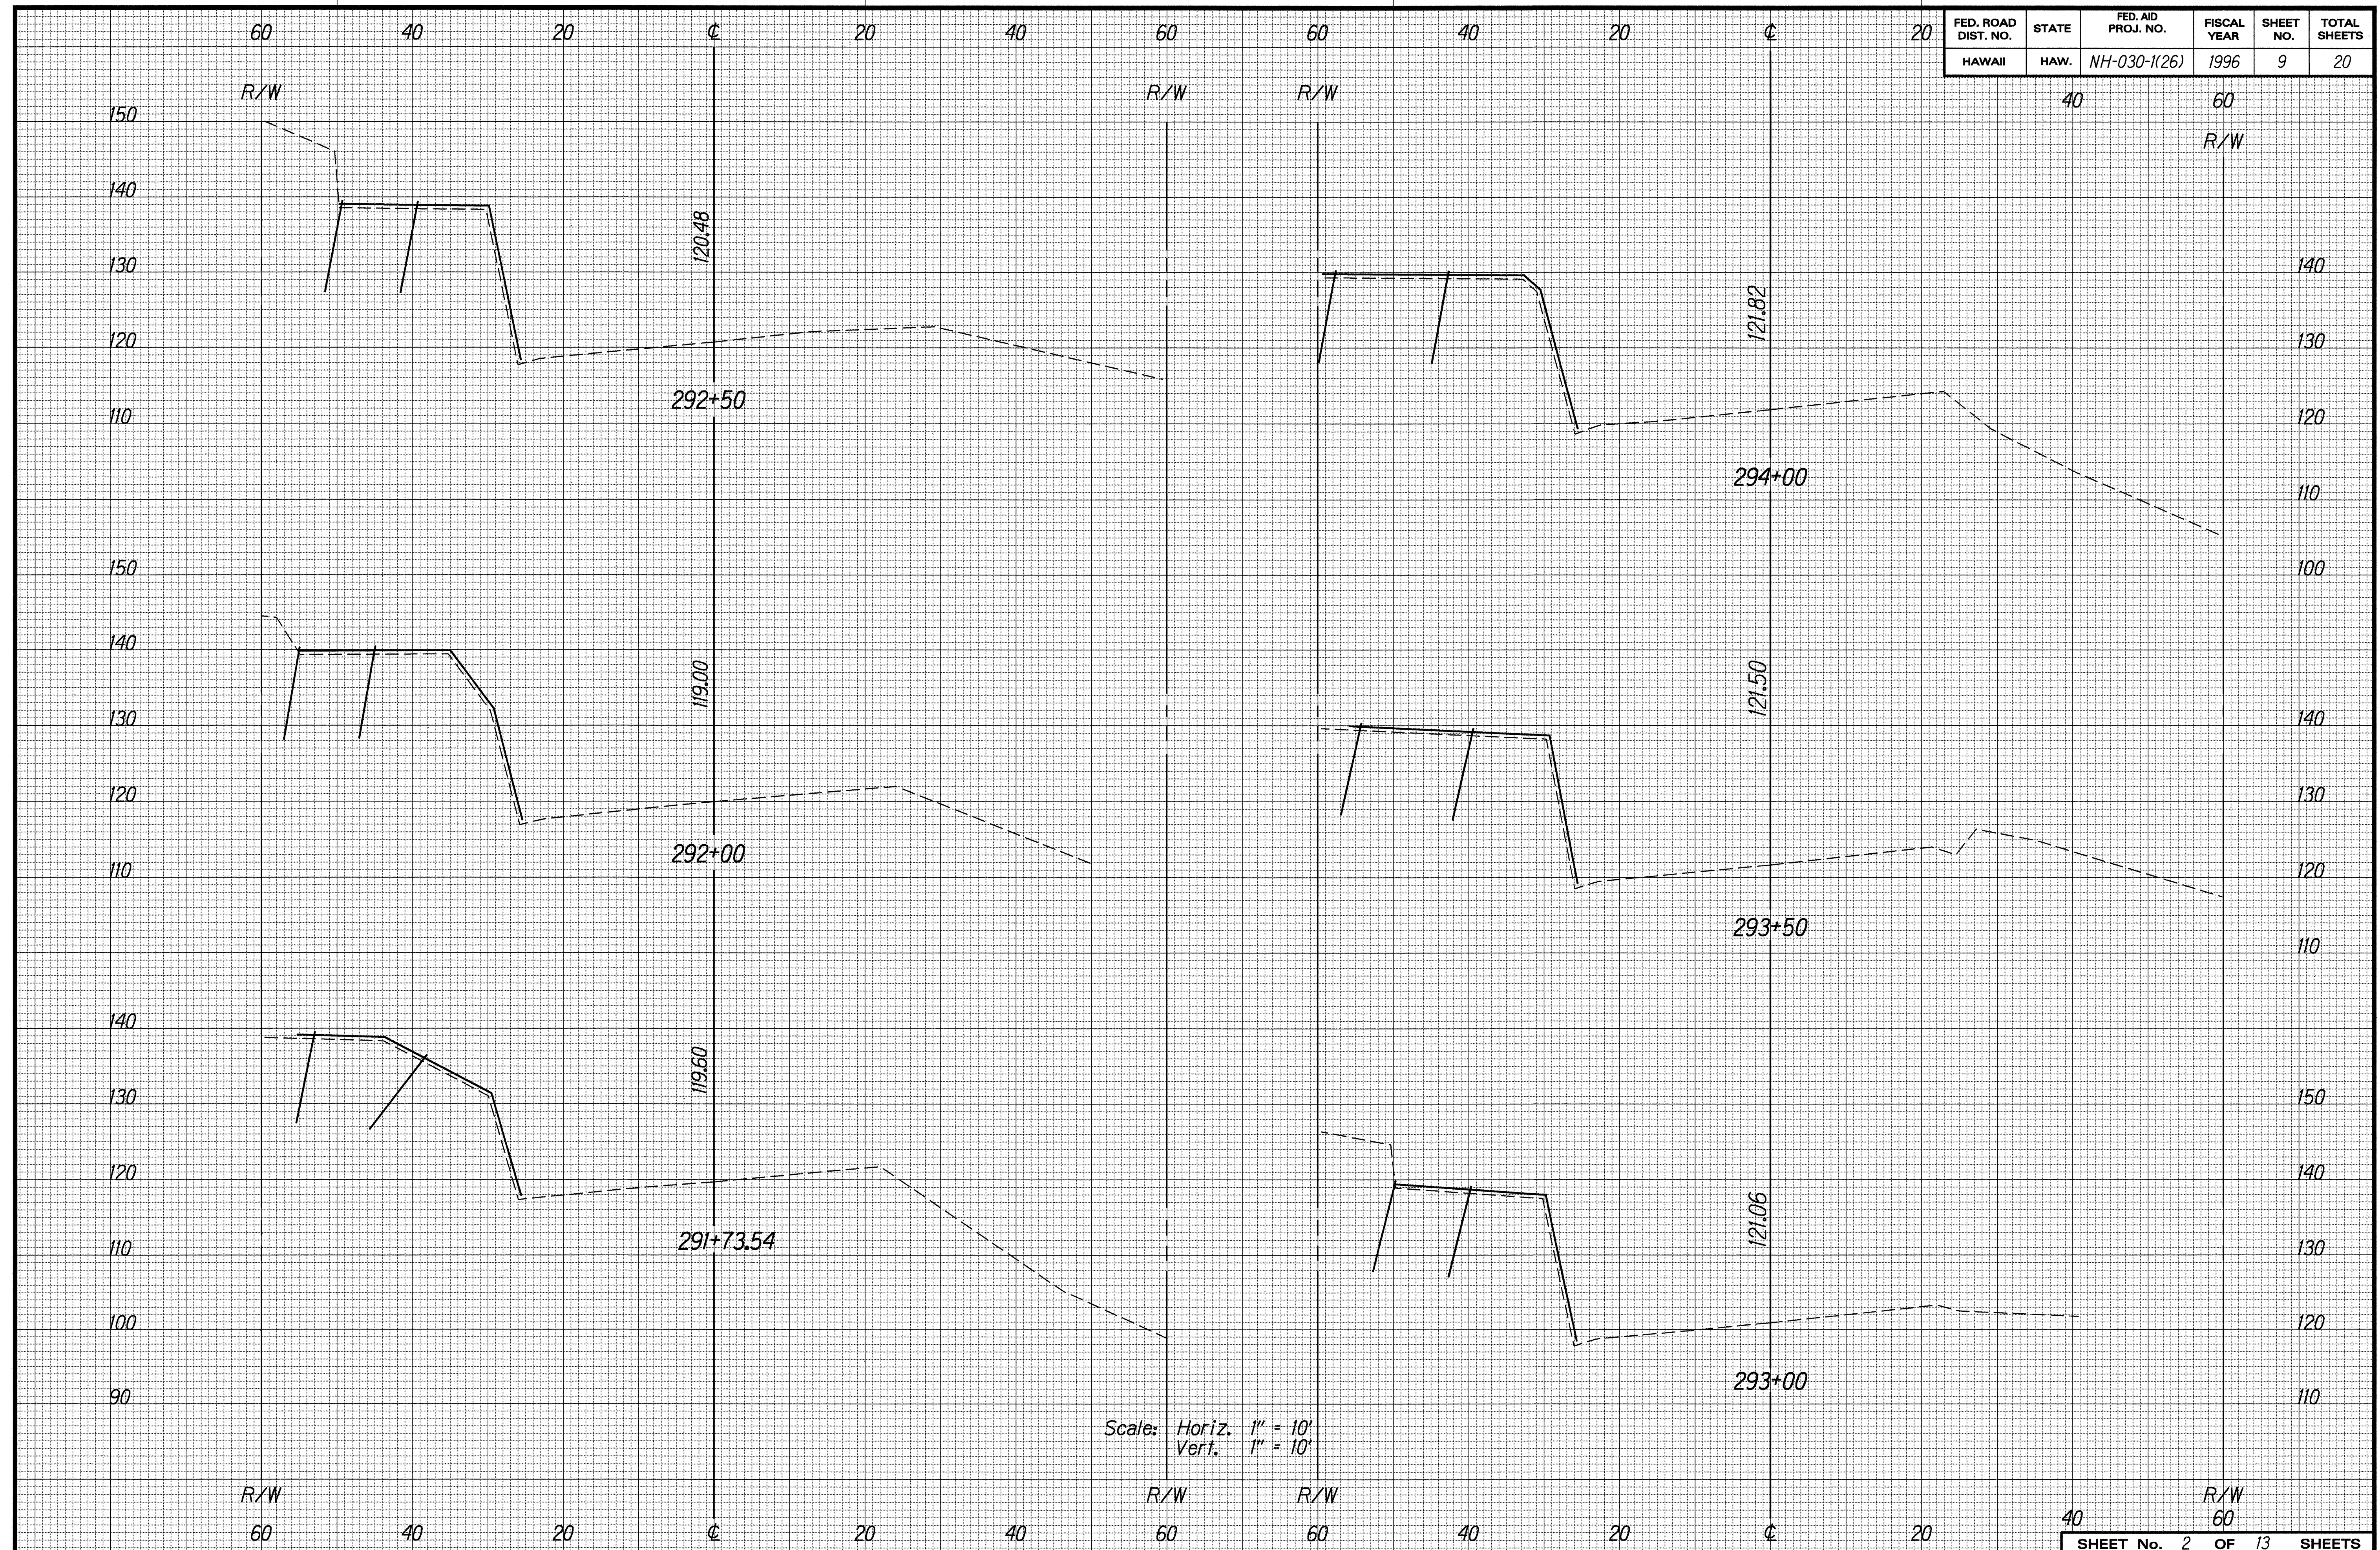


ORIGINAL PLAN	SURVEY PLOTTED BY	DATE
	DRAWN BY <i>K. Tan-Hinda</i>	<i>13/29/86</i>
	DESIGNED BY	
	TRACED BY <i>P. Takeasu/D. Taniguchi</i>	
	QUANTITIES BY	
	CHECKED BY	

FED. ROAD DIST. NO.	STATE	FED. AID PROJ. NO.	FISCAL YEAR	SHEET NO.	TOTAL SHEETS
HAWAII	HAW.	NH-030-1(26)	1996	10	20

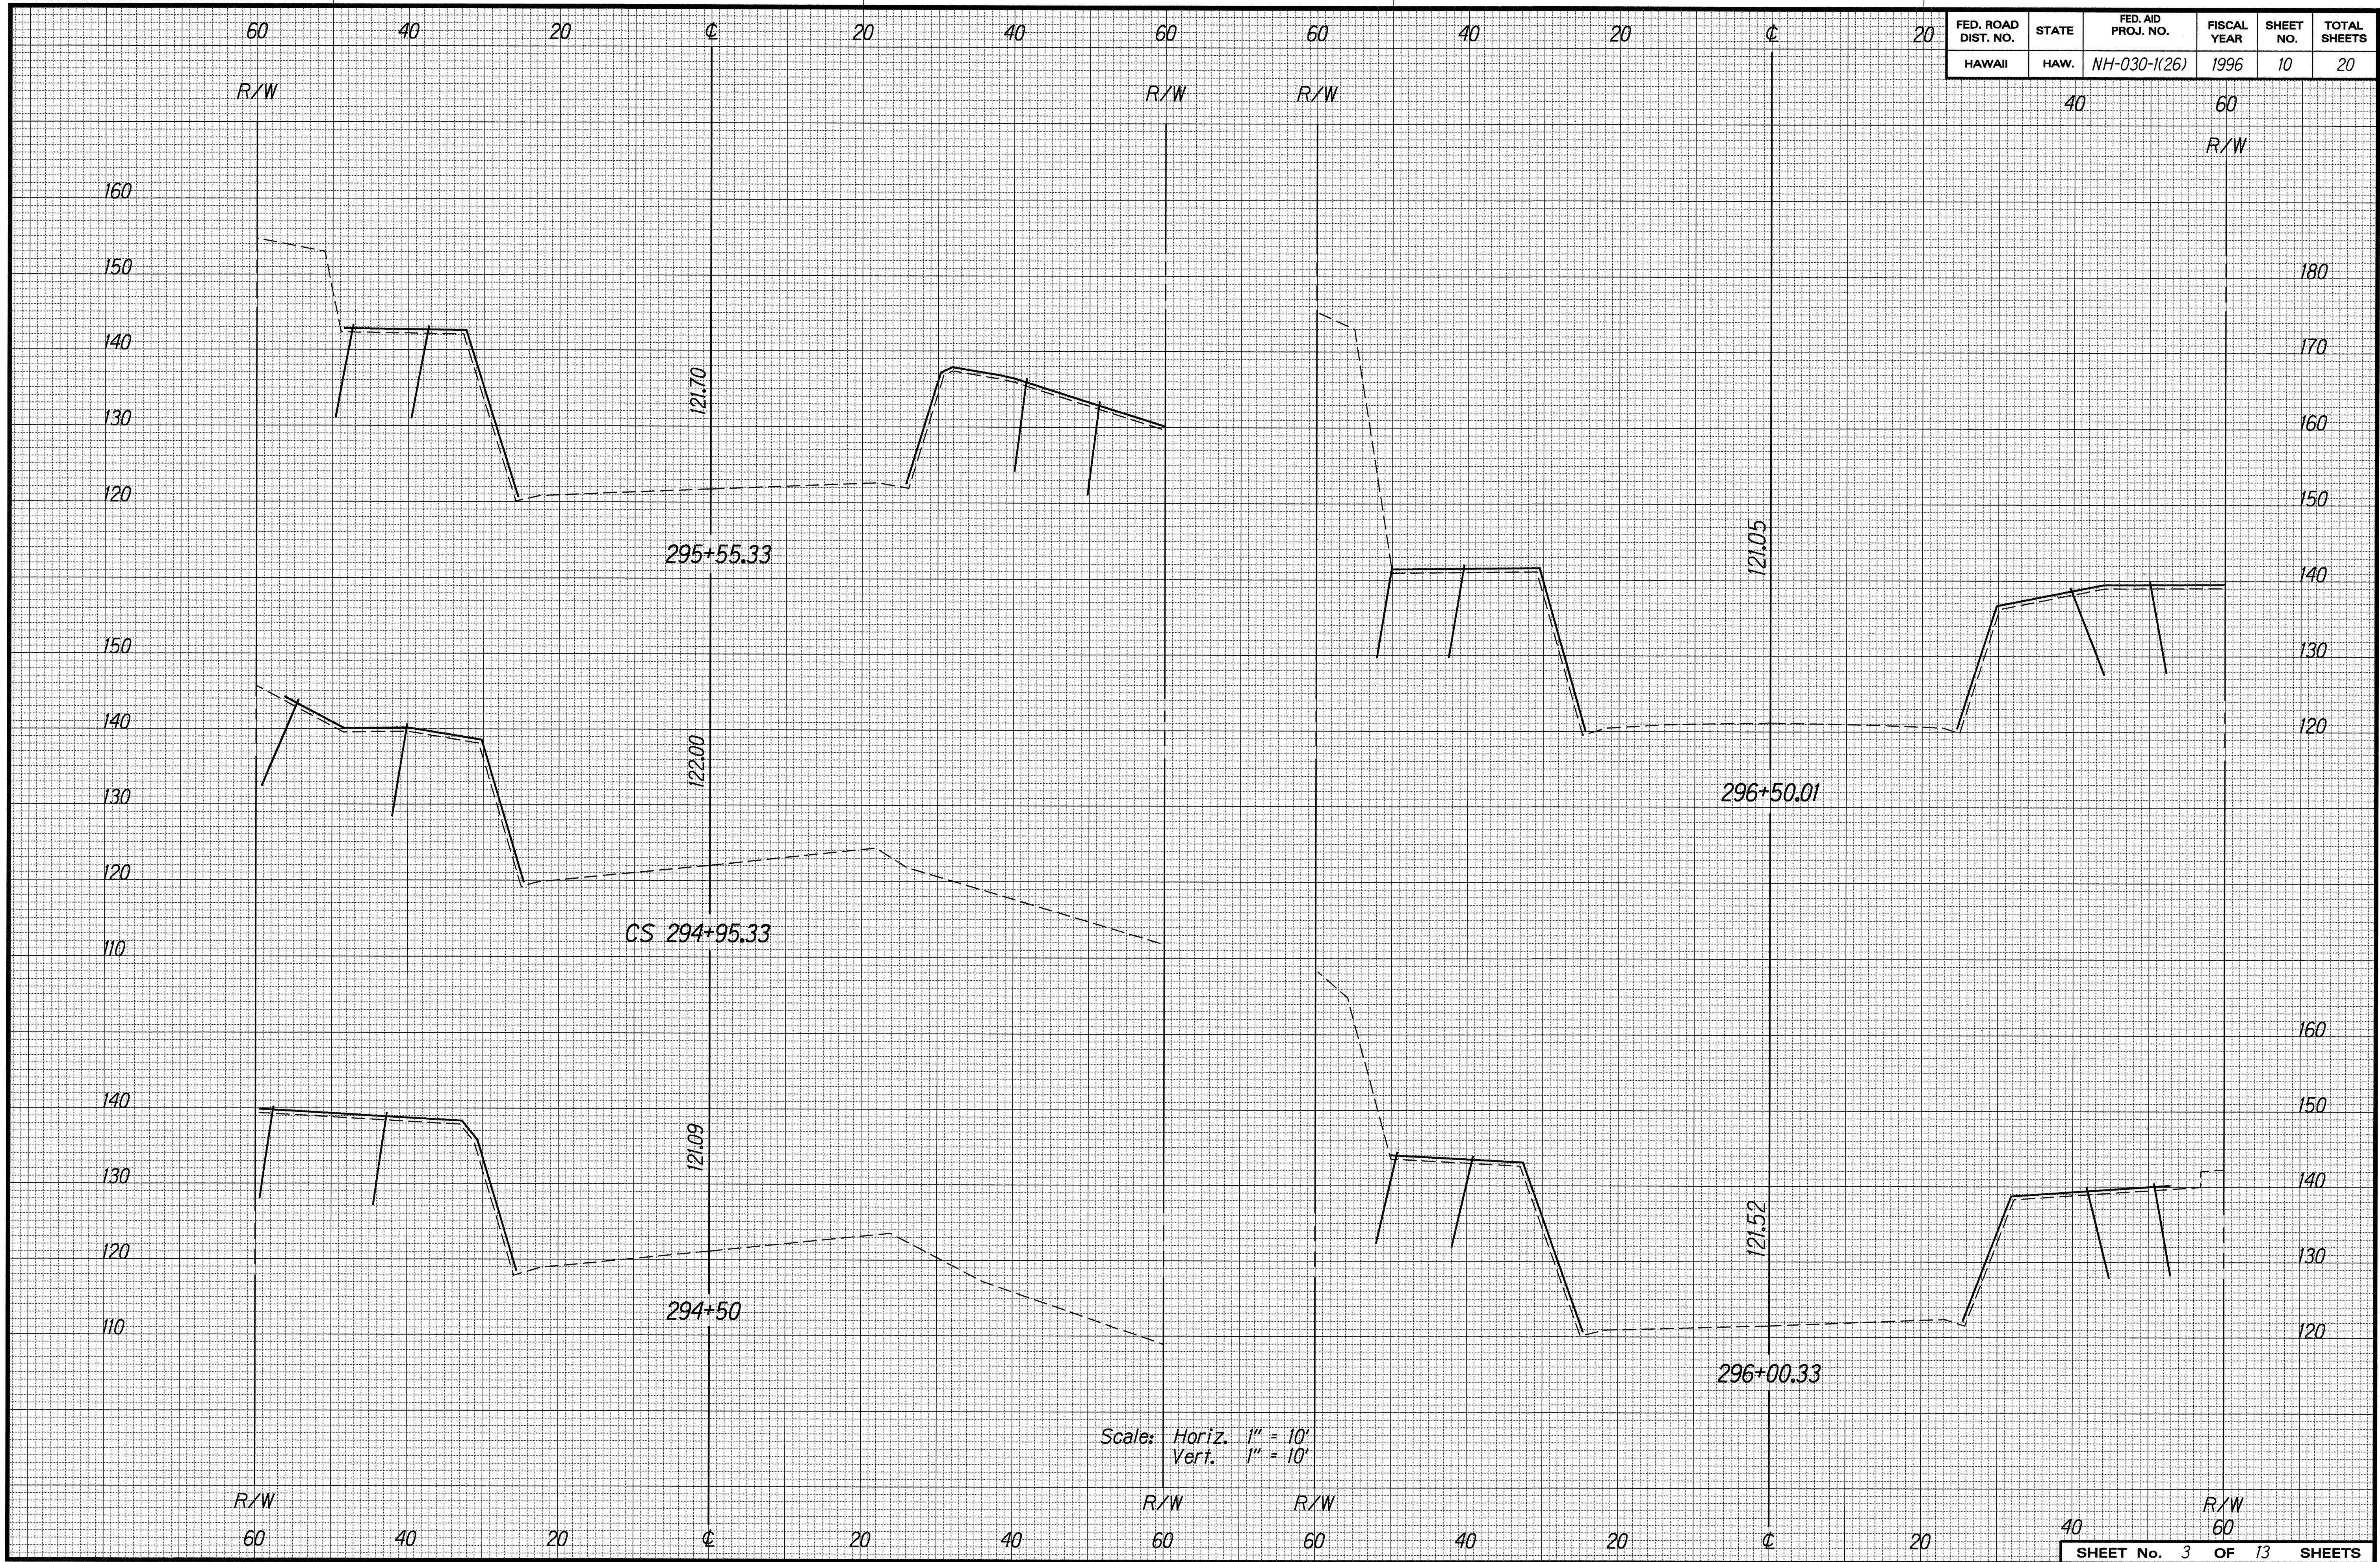


FED. ROAD DIST. NO.	STATE	FED. AID PROJ. NO.	FISCAL YEAR	SHEET NO.	TOTAL SHEETS
HAWAII	HAW.	NH-030-1(26)	1996	11	20

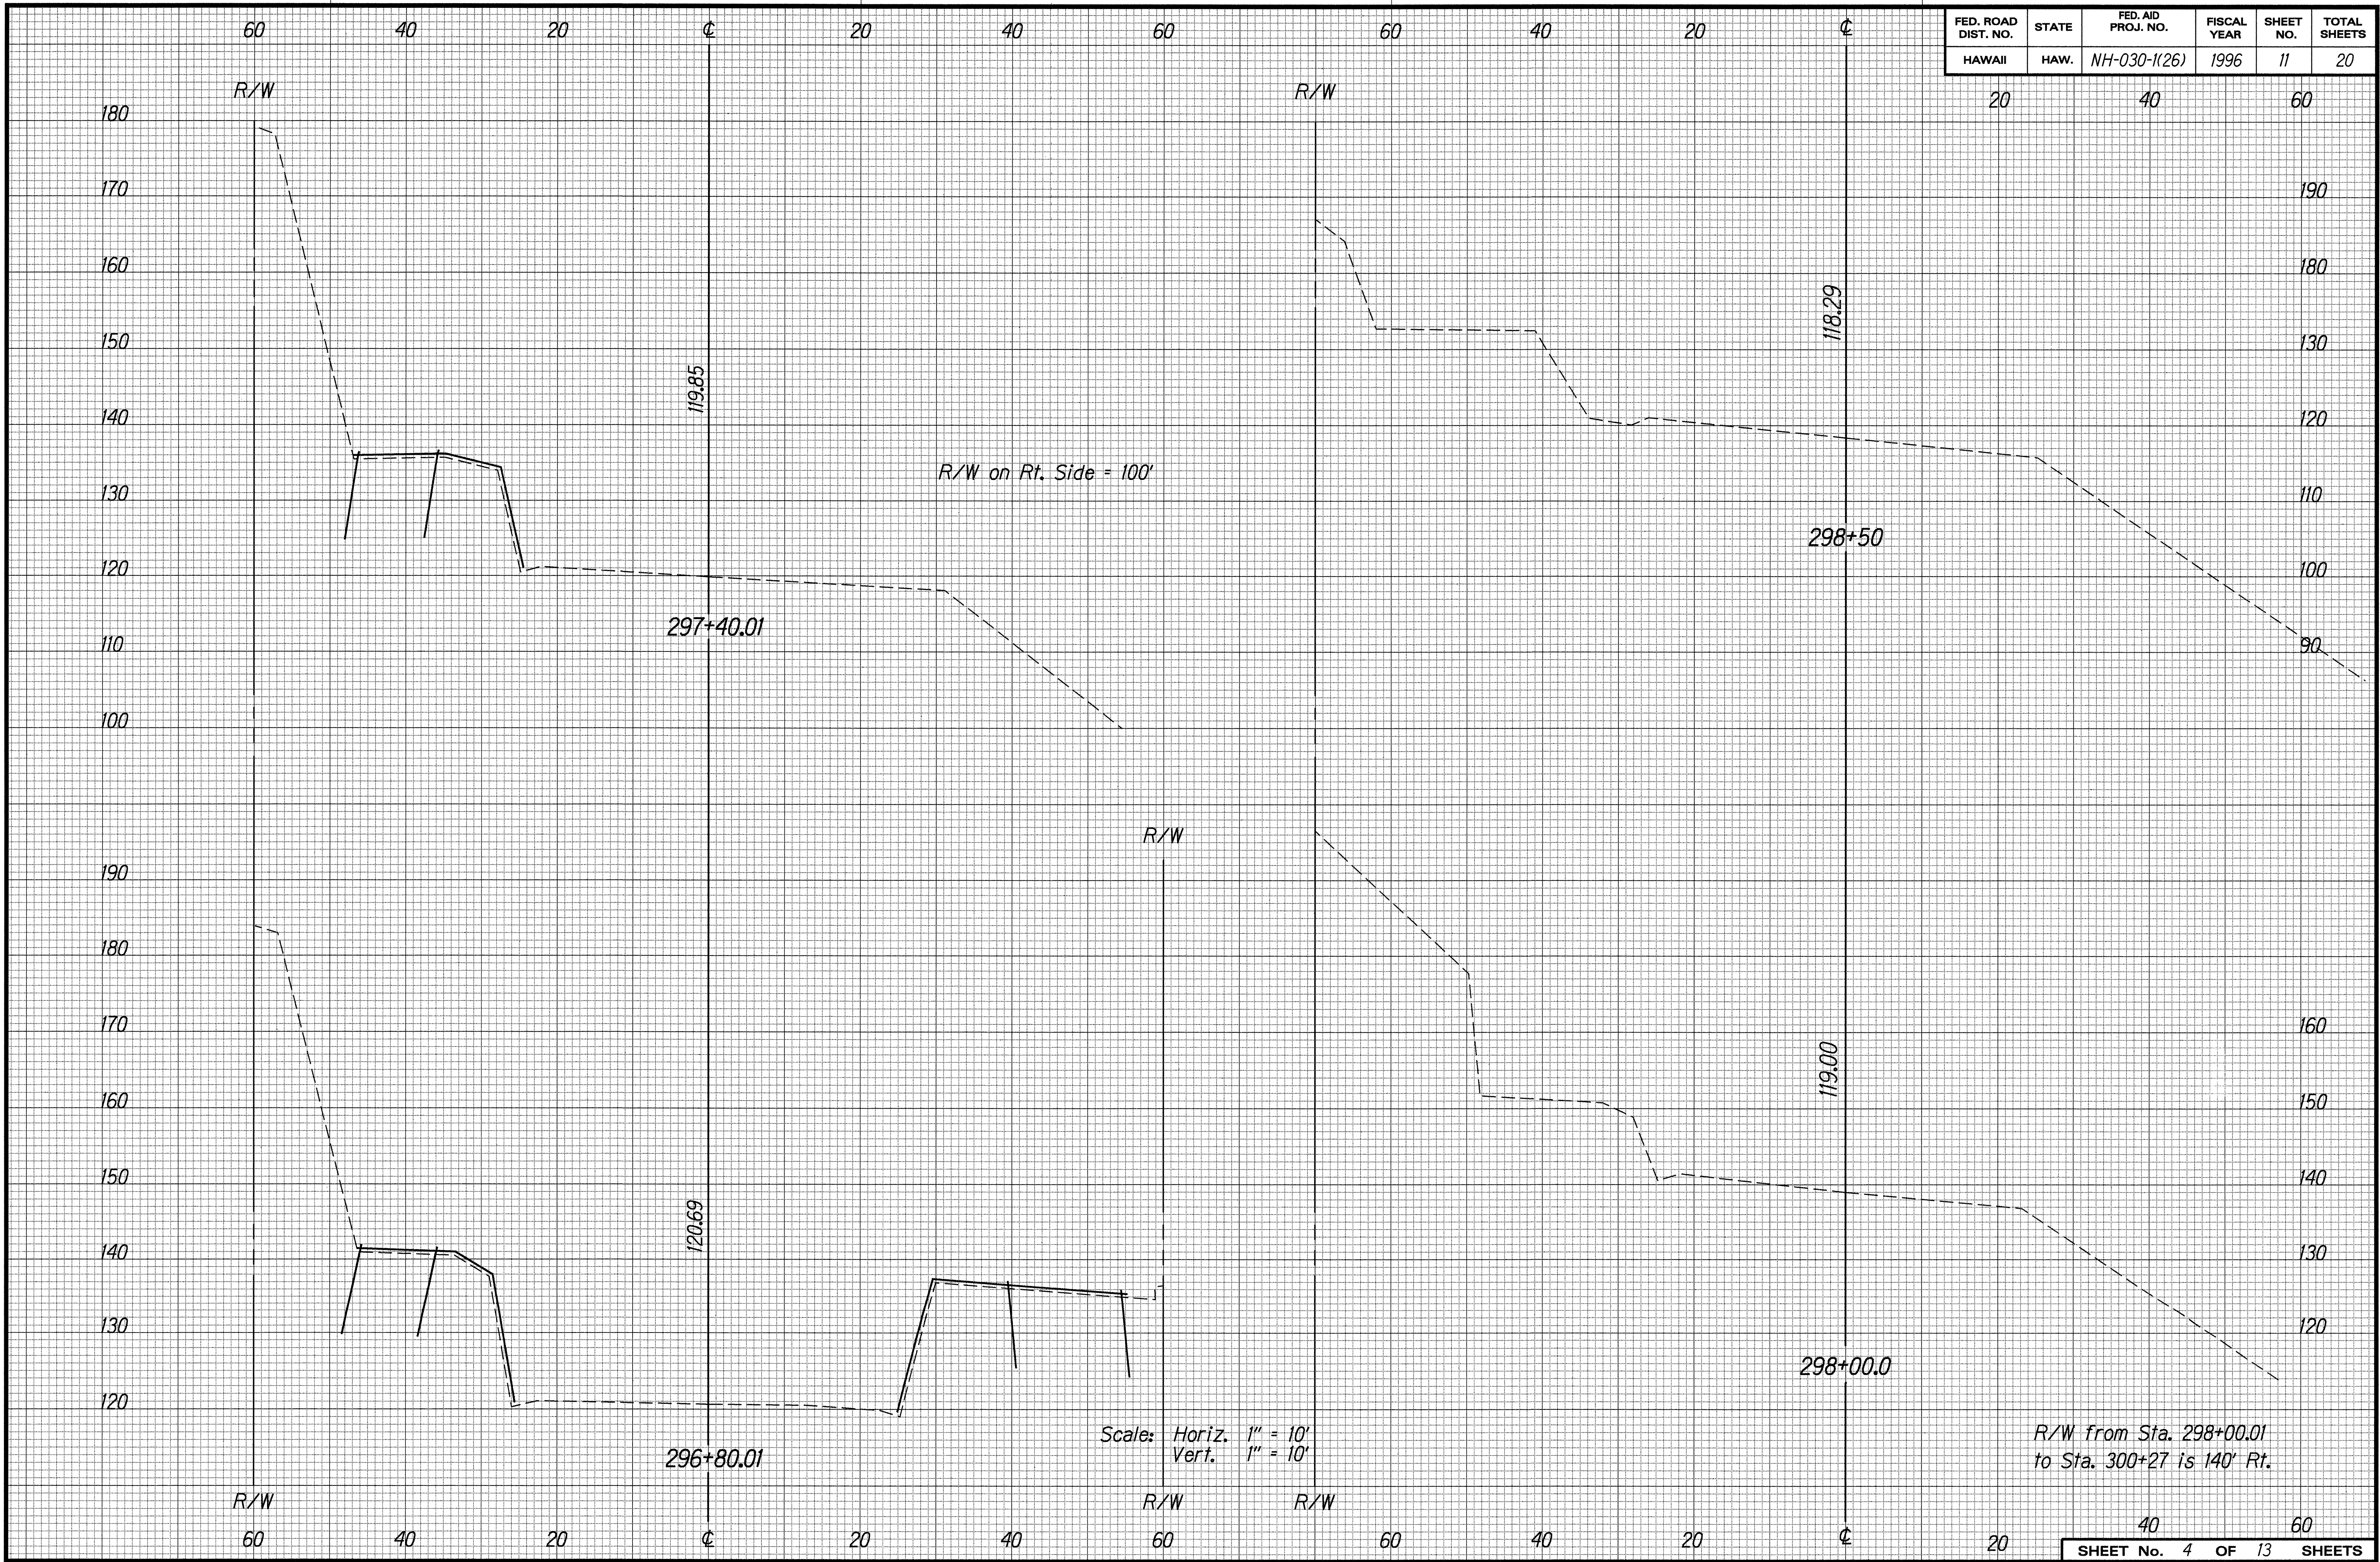


ORIGINAL PLAN	SURVEY PLOTTED BY	DATE
NOTE BOOK	DRAWN BY K. Tomihata	13/23/96
ddk	DESIGNED BY B. Takasu/D. Taniguchi	
Handwritten	CHECKED BY	

FED. ROAD DIST. NO.	STATE	FED. AID PROJ. NO.	FISCAL YEAR	SHEET NO.	TOTAL SHEETS
HAWAII	HAW.	NH-030-1(26)	1996	12	20

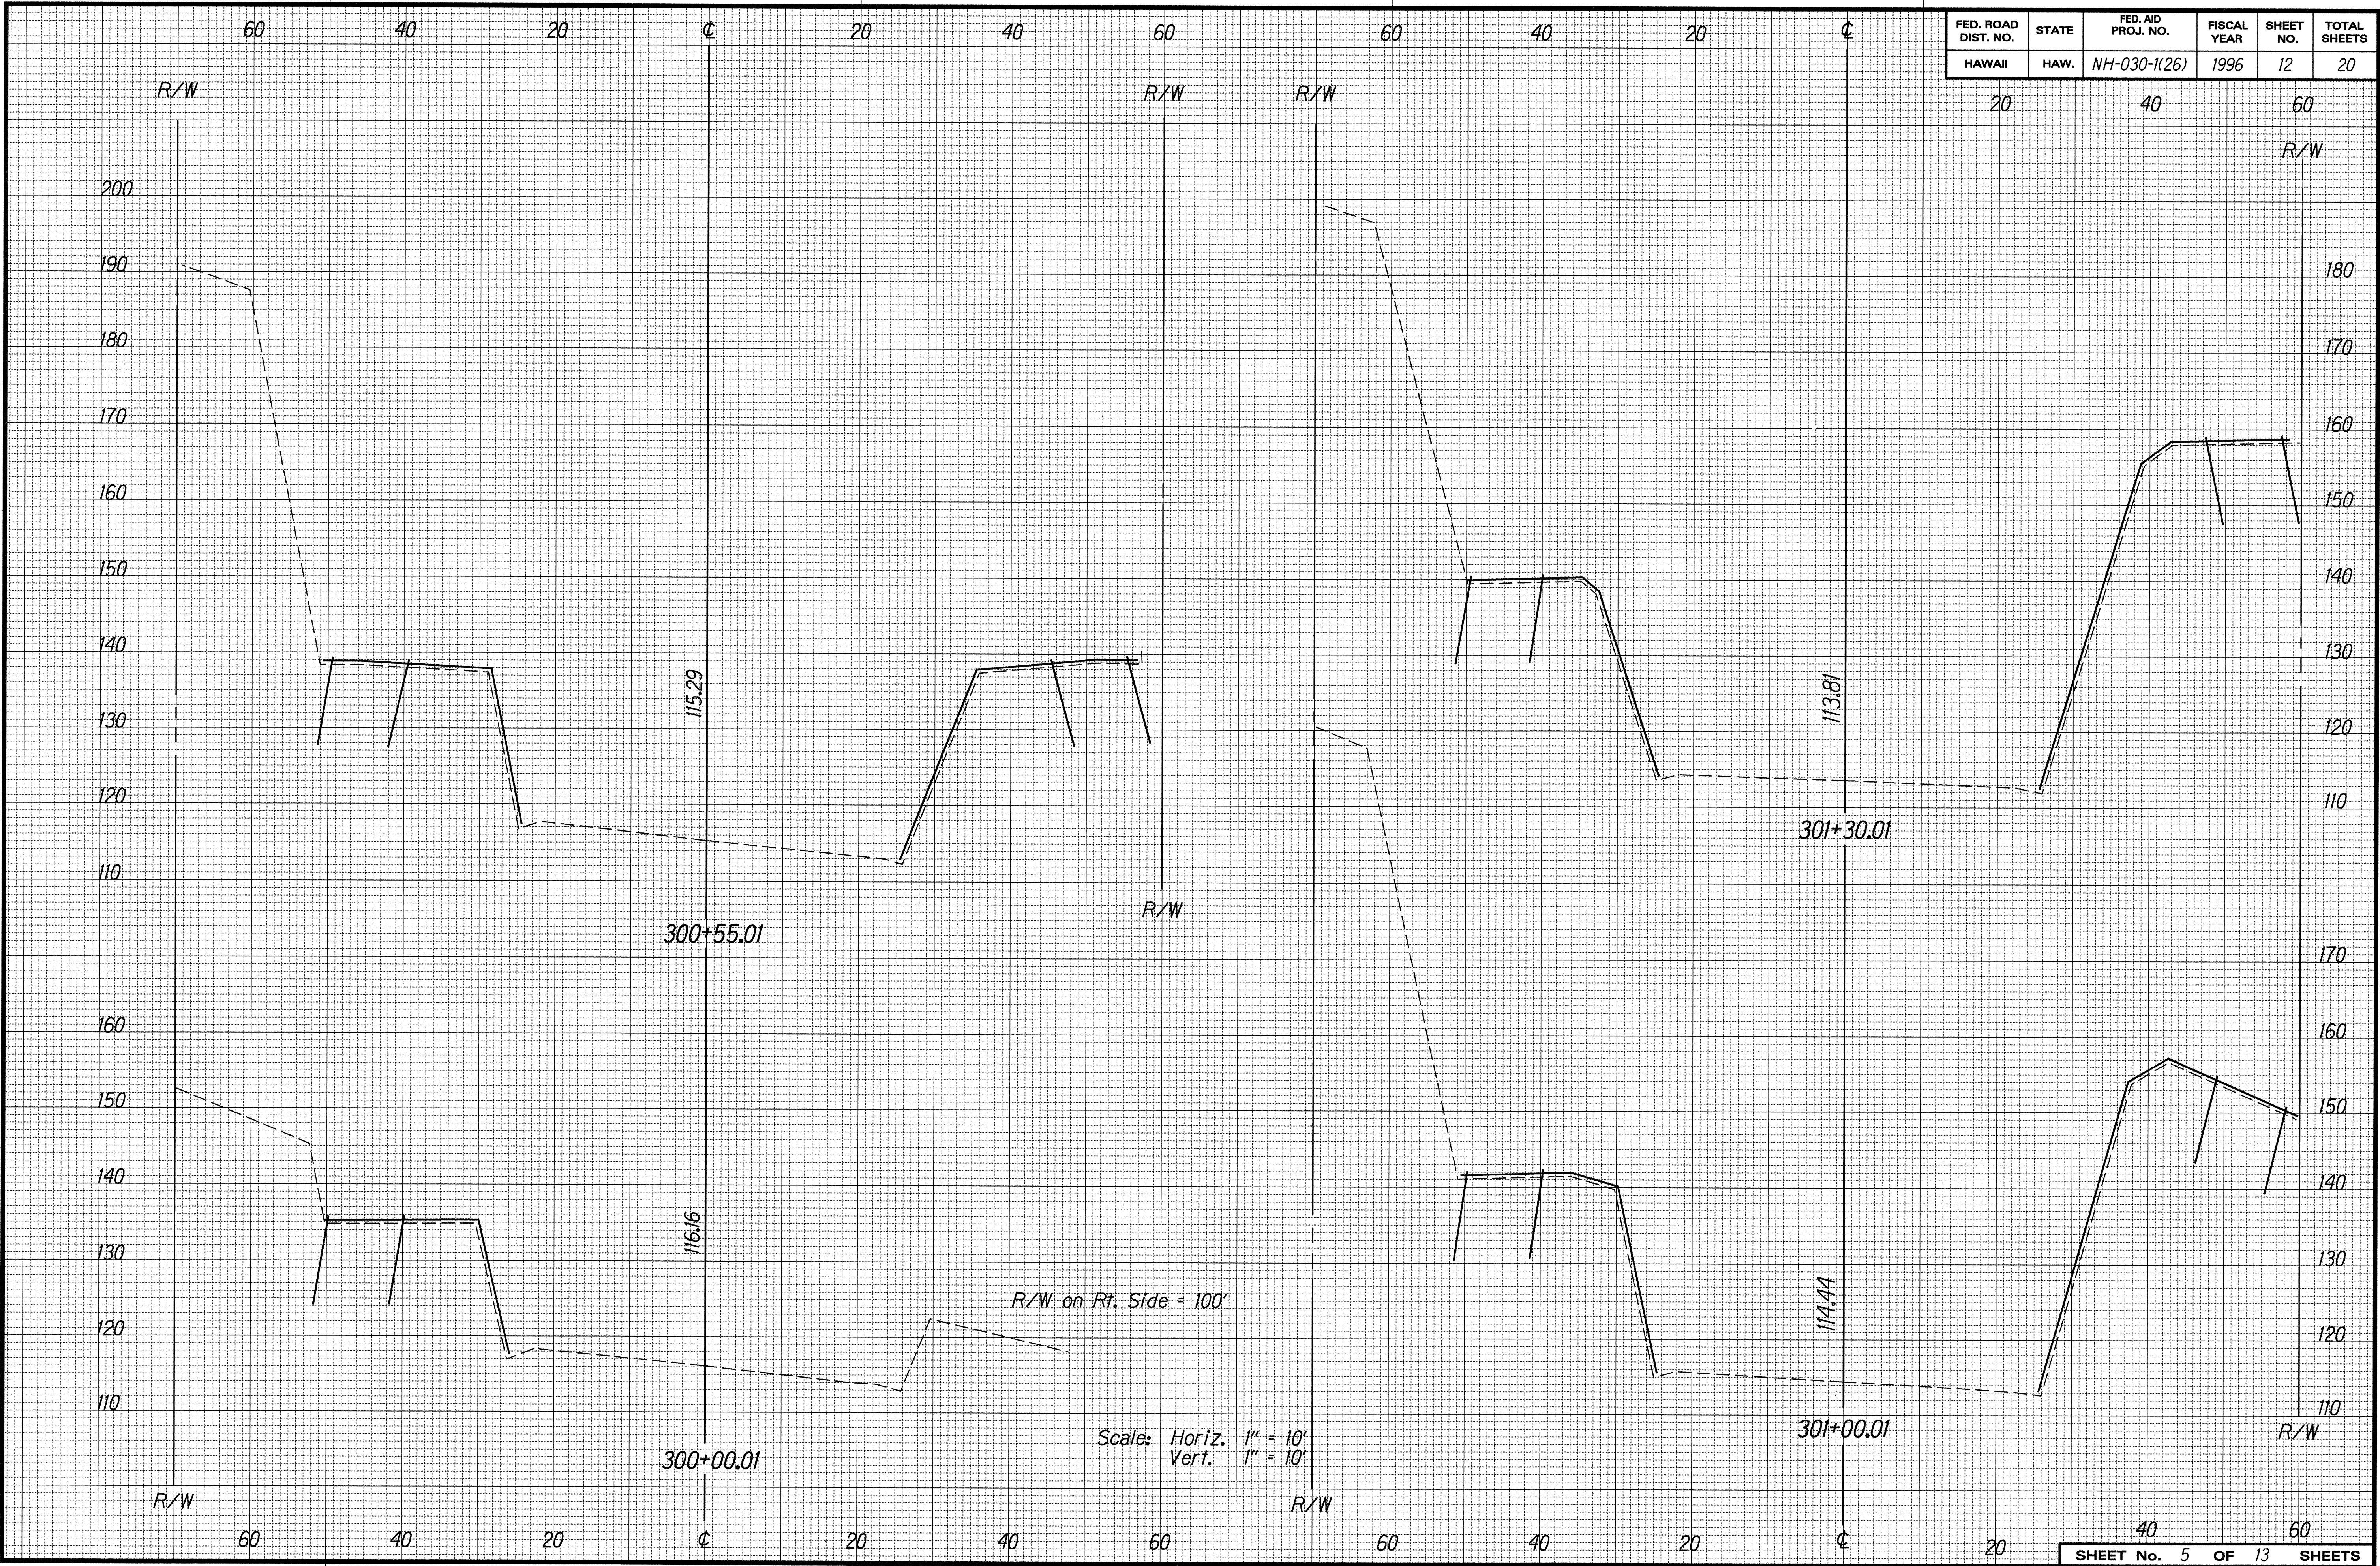


FED. ROAD DIST. NO.	STATE	FED. AID PROJ. NO.	FISCAL YEAR	SHEET NO.	TOTAL SHEETS
HAWAII	HAW.	NH-030-1(26)	1995	13	20

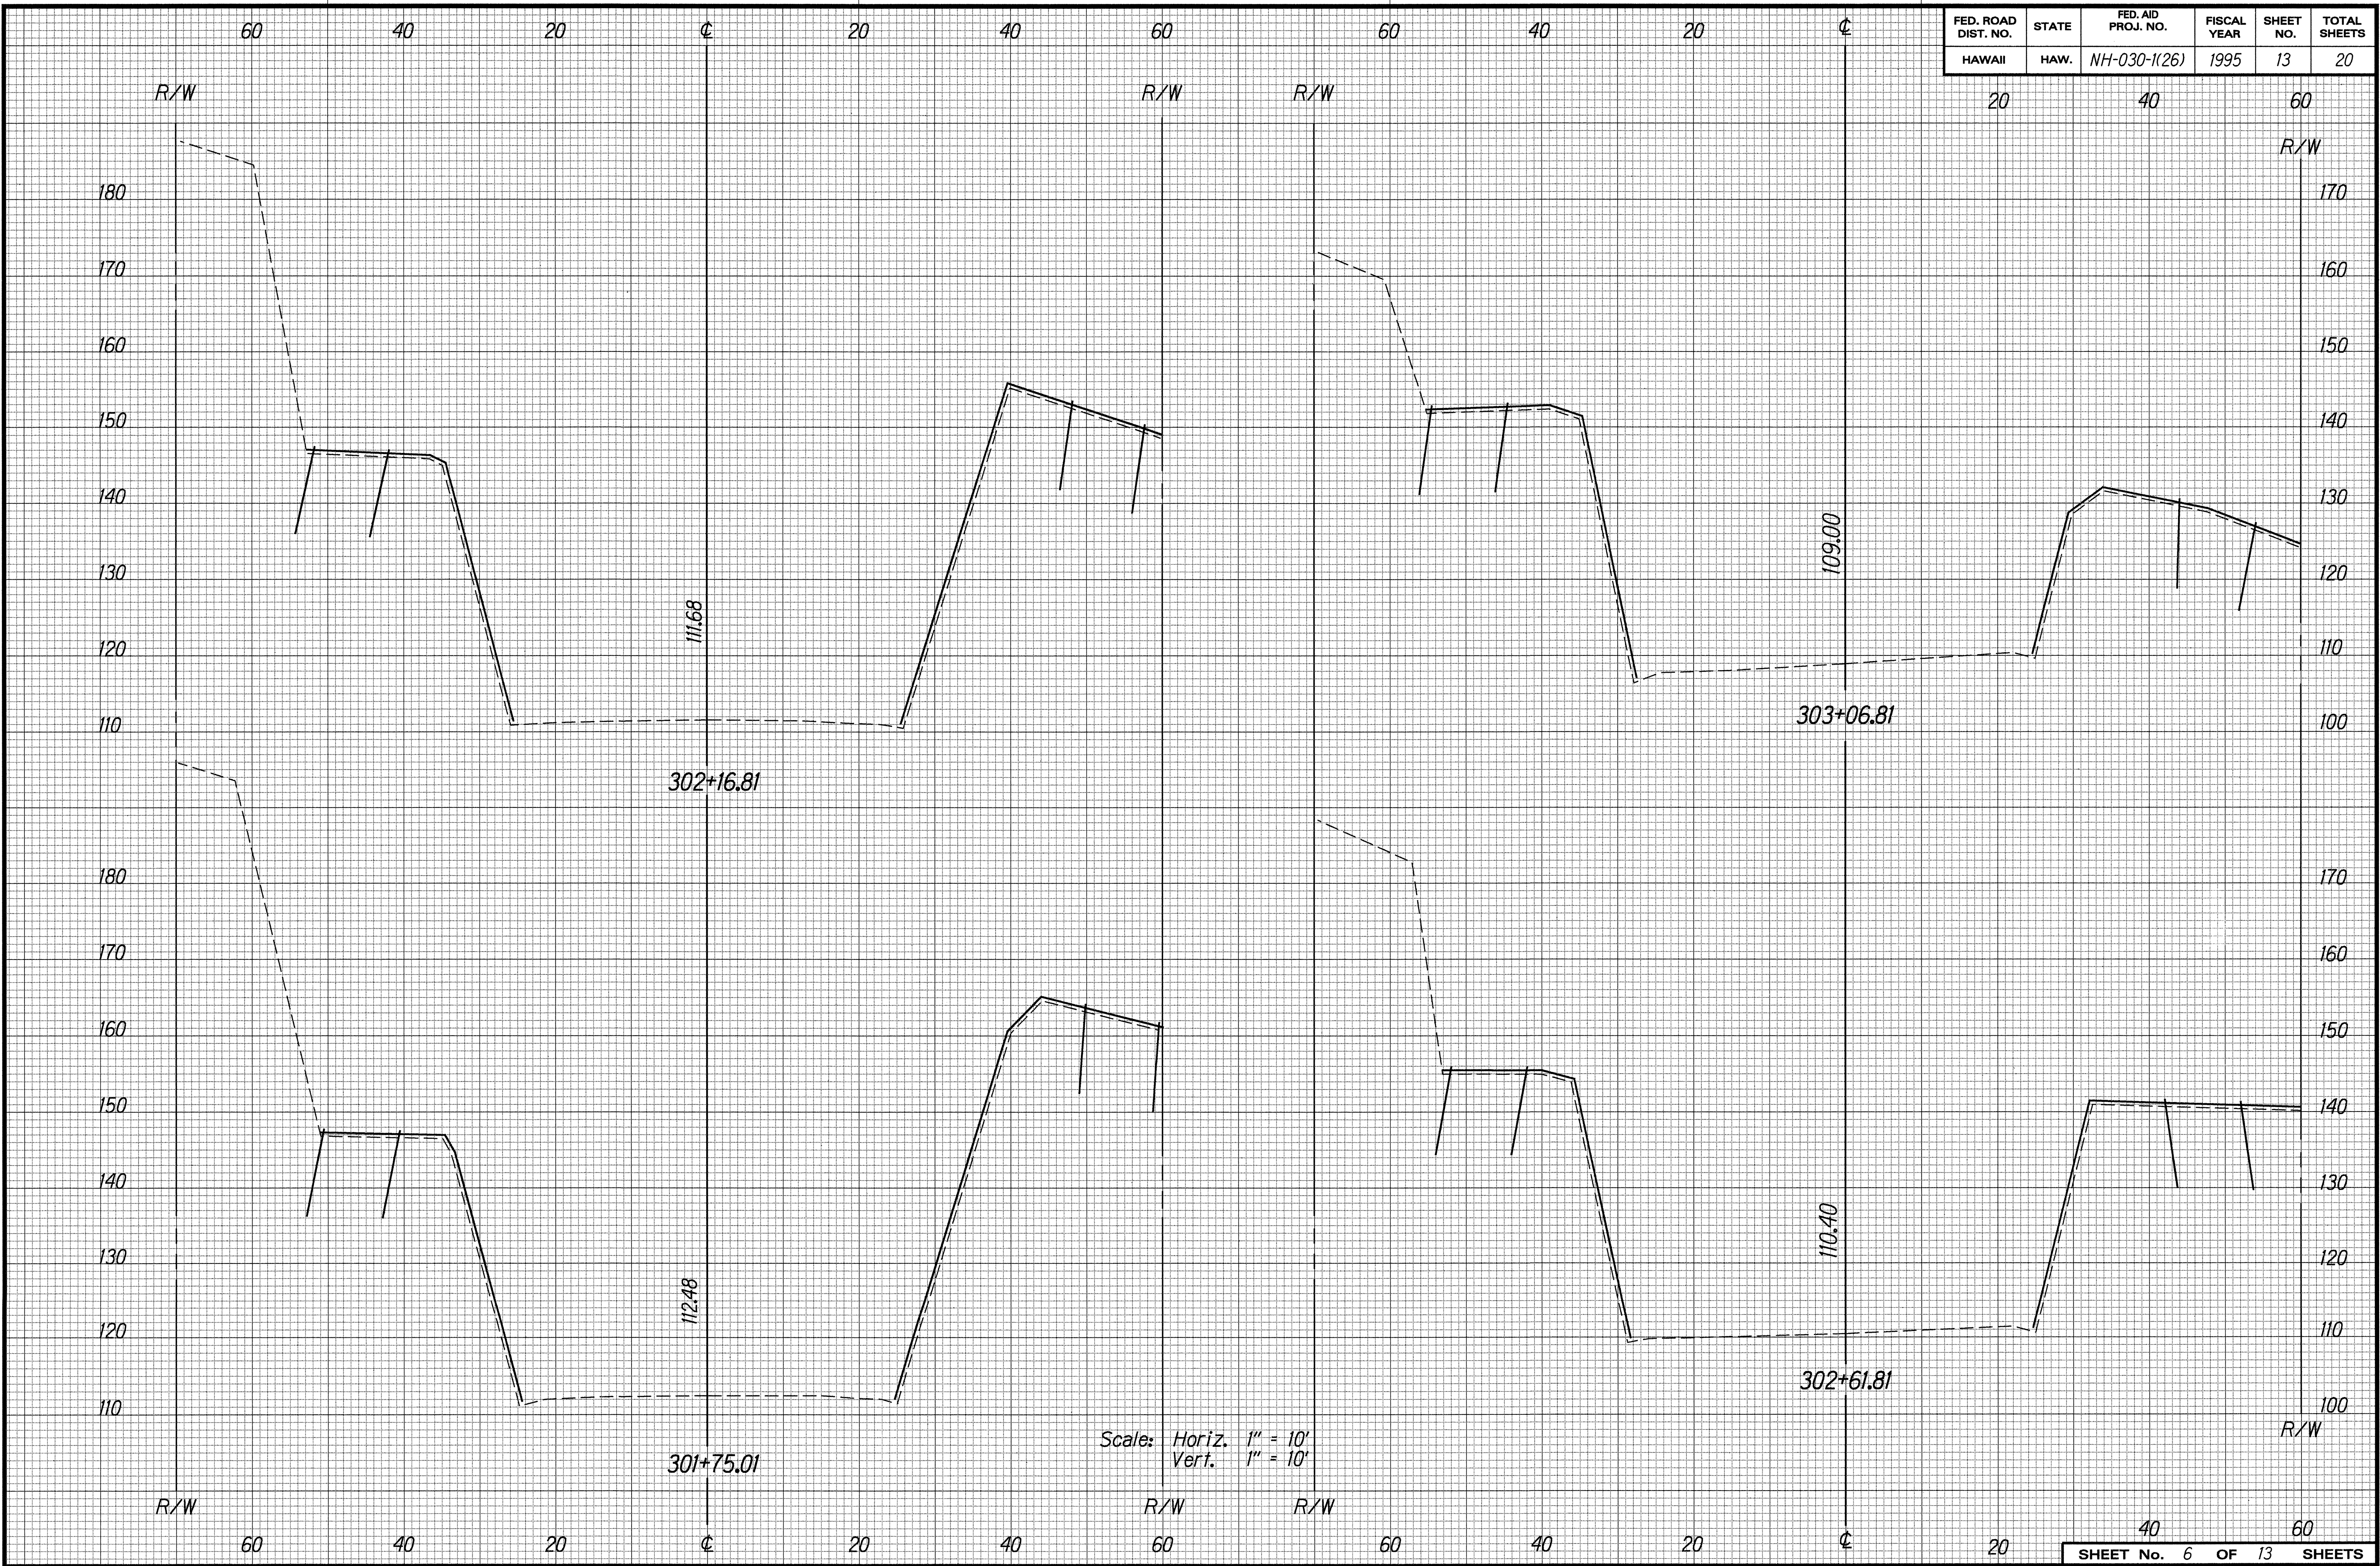


SURVEY PLOTTED BY: DATE: 12/29/98
 DRAWN BY: K. Tomihata
 DESIGNED BY: R. Takasu/D. Taitai
 CHECKED BY: 6/2/01
 8/20/05/6/01

FED. ROAD DIST. NO.	STATE	FED. AID PROJ. NO.	FISCAL YEAR	SHEET NO.	TOTAL SHEETS
HAWAII	HAW.	NH-030-1(26)	1996	14	20

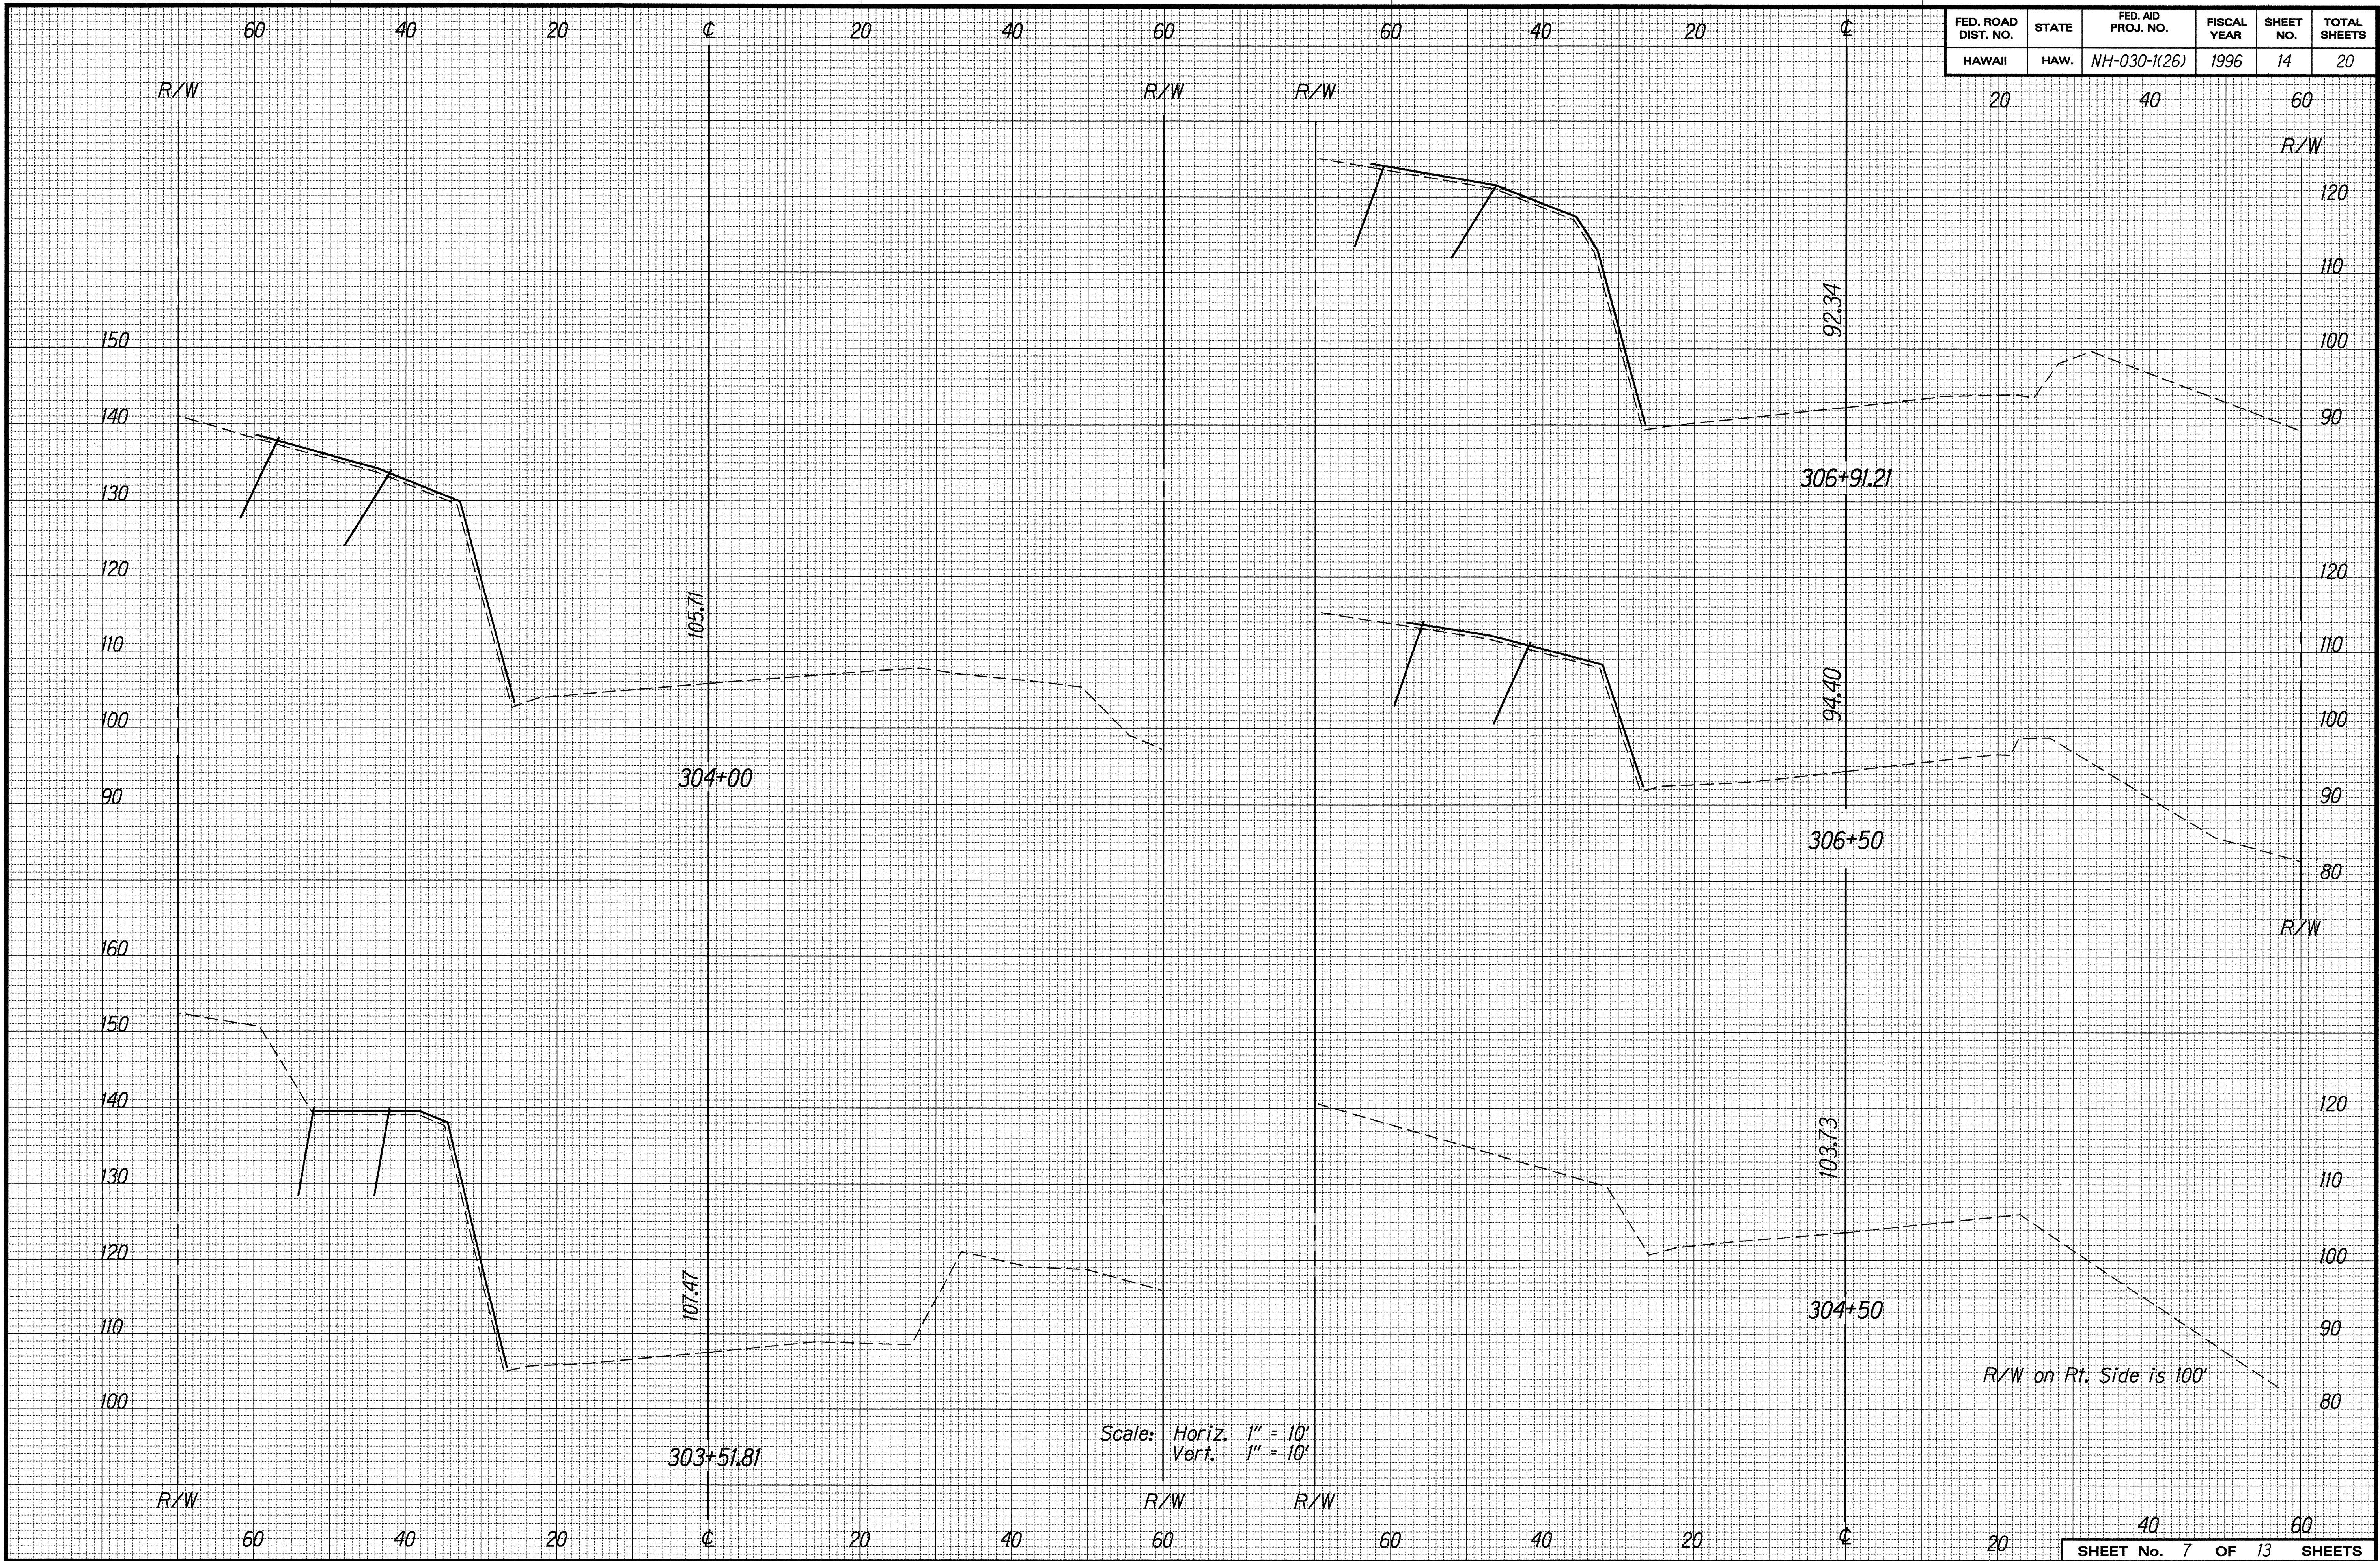


ORIGINAL PLAN	SURVEY PLOTTED BY	DATE
NOTE BOOK	DRAWN BY	13/29/96
0624	DESIGNED BY	
	CHECKED BY	

FED. ROAD DIST. NO.	STATE	FED. AID PROJ. NO.	FISCAL YEAR	SHEET NO.	TOTAL SHEETS
HAWAII	HAW.	NH-030-1(26)	1996	15	20

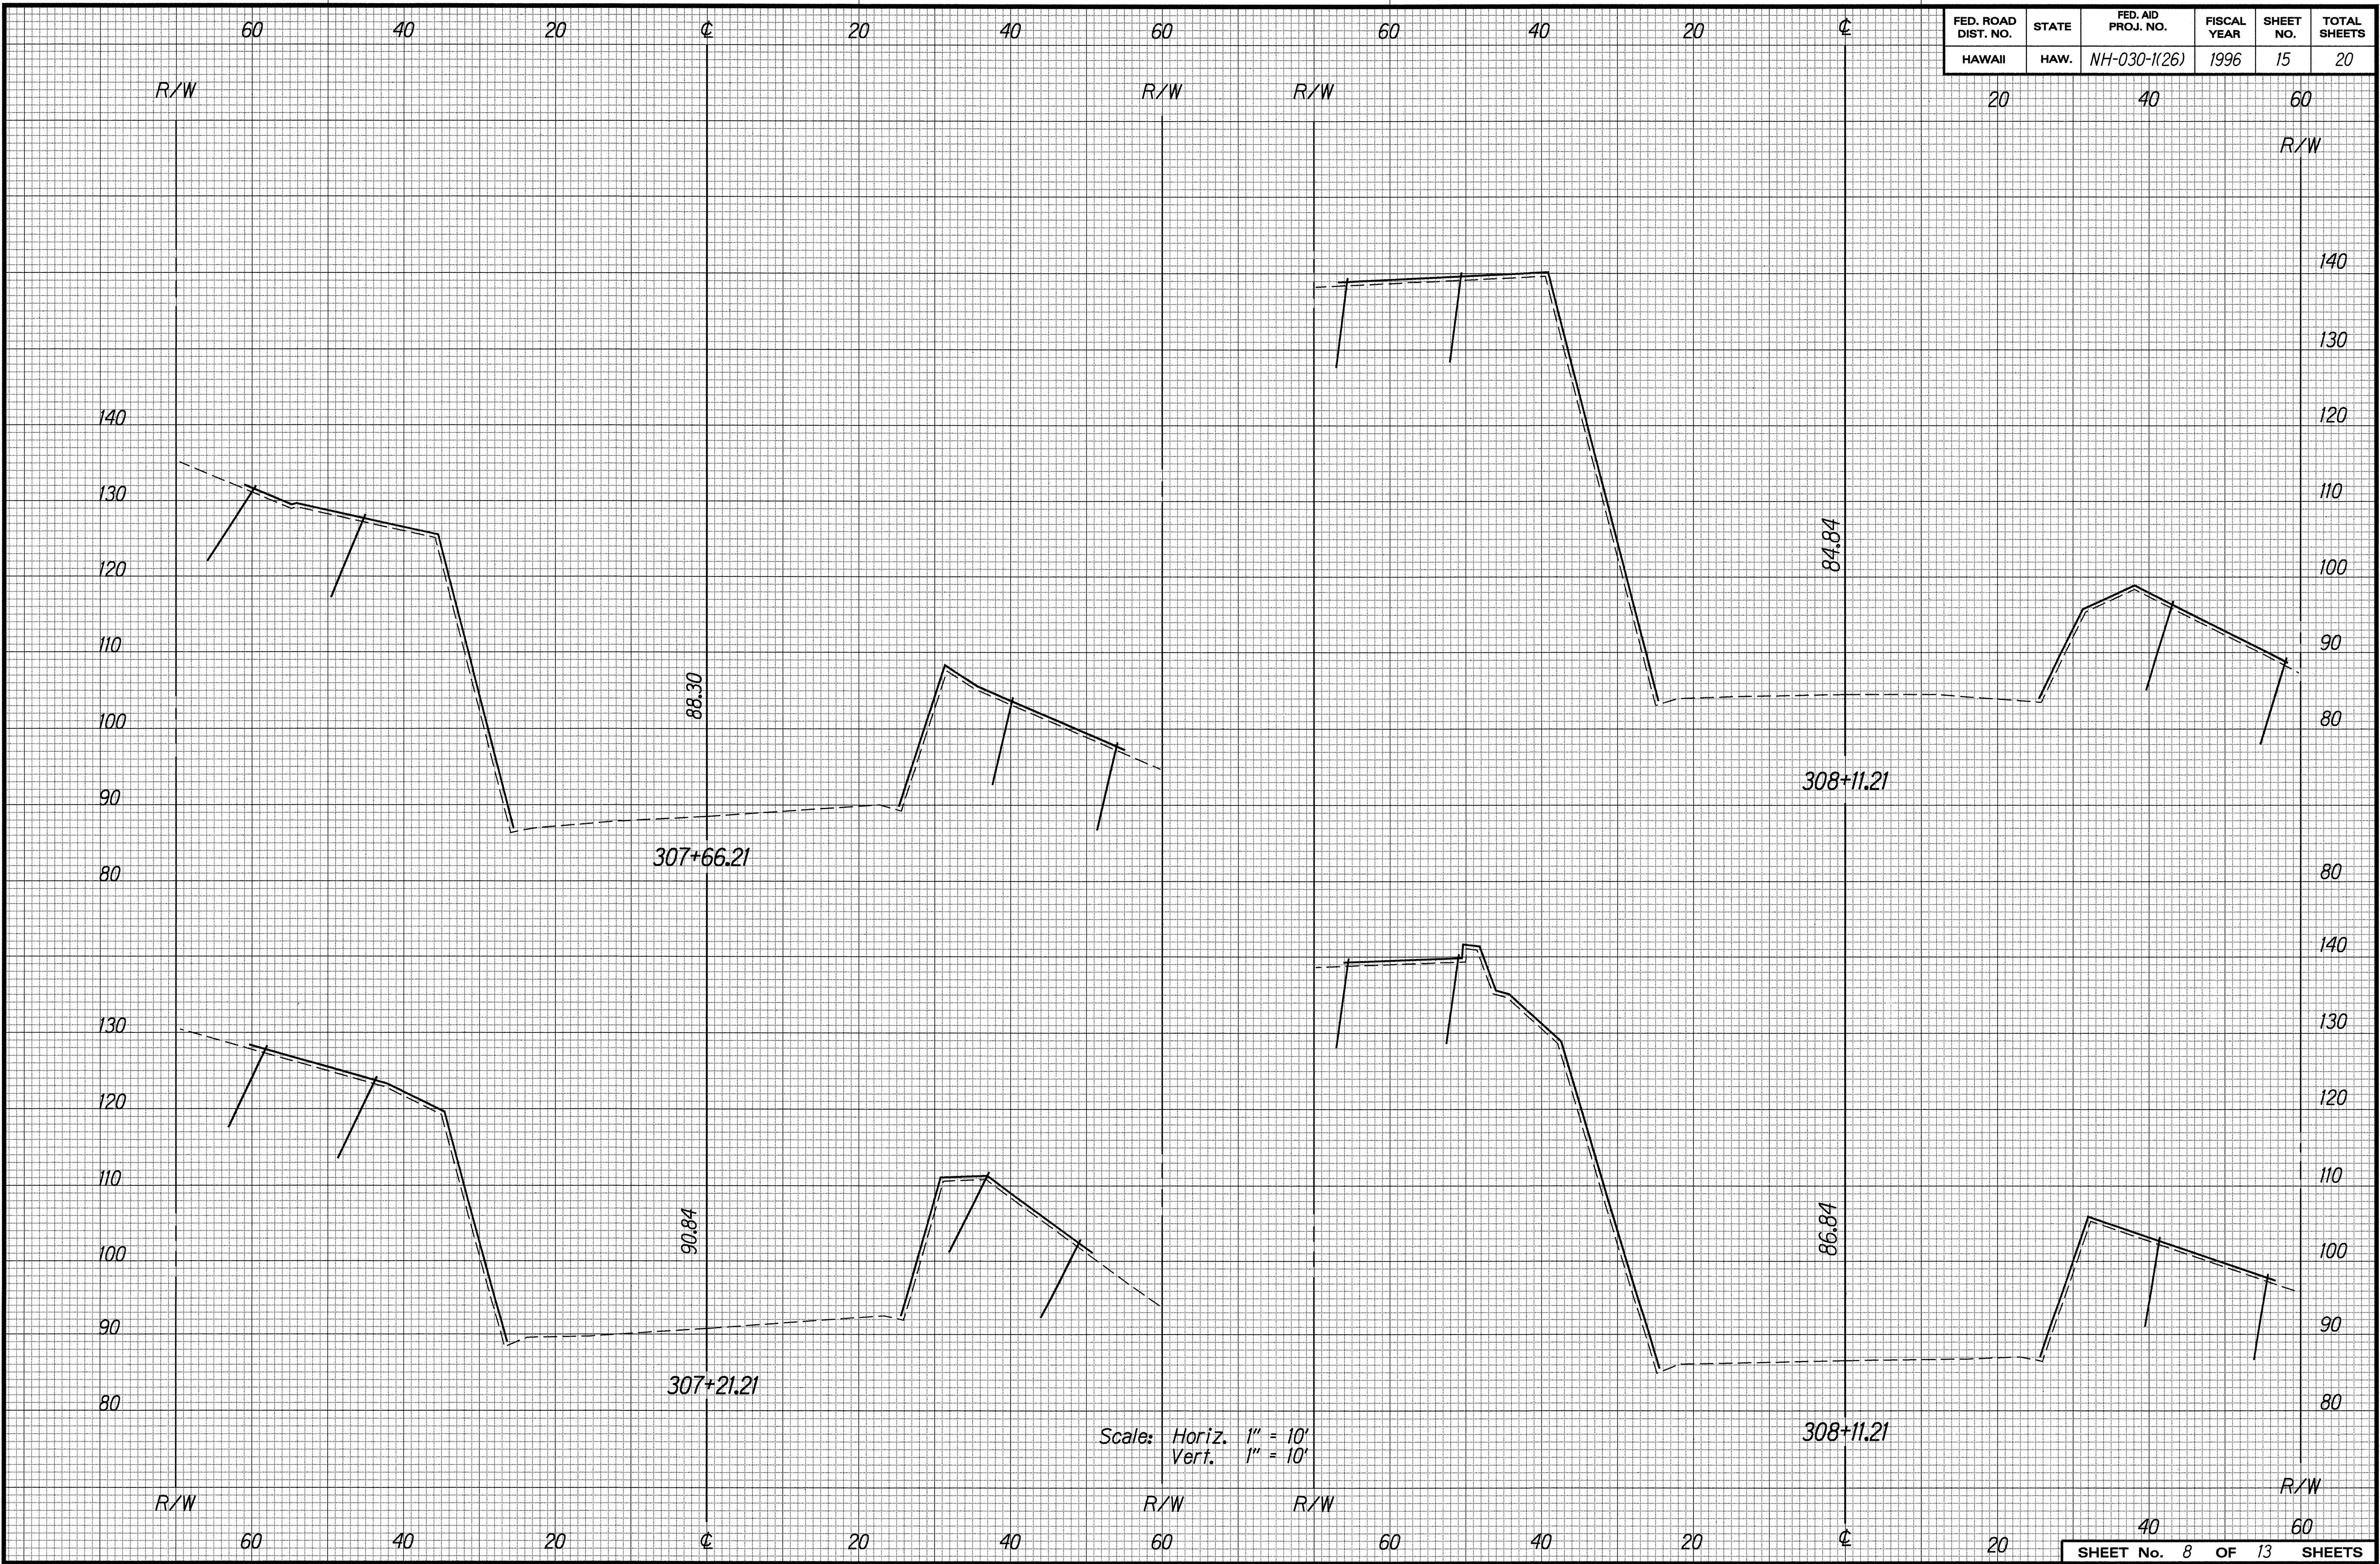


FED. ROAD DIST. NO.	STATE	FED. AID PROJ. NO.	FISCAL YEAR	SHEET NO.	TOTAL SHEETS
HAWAII	HAW.	NH-030-1(26)	1996	16	20

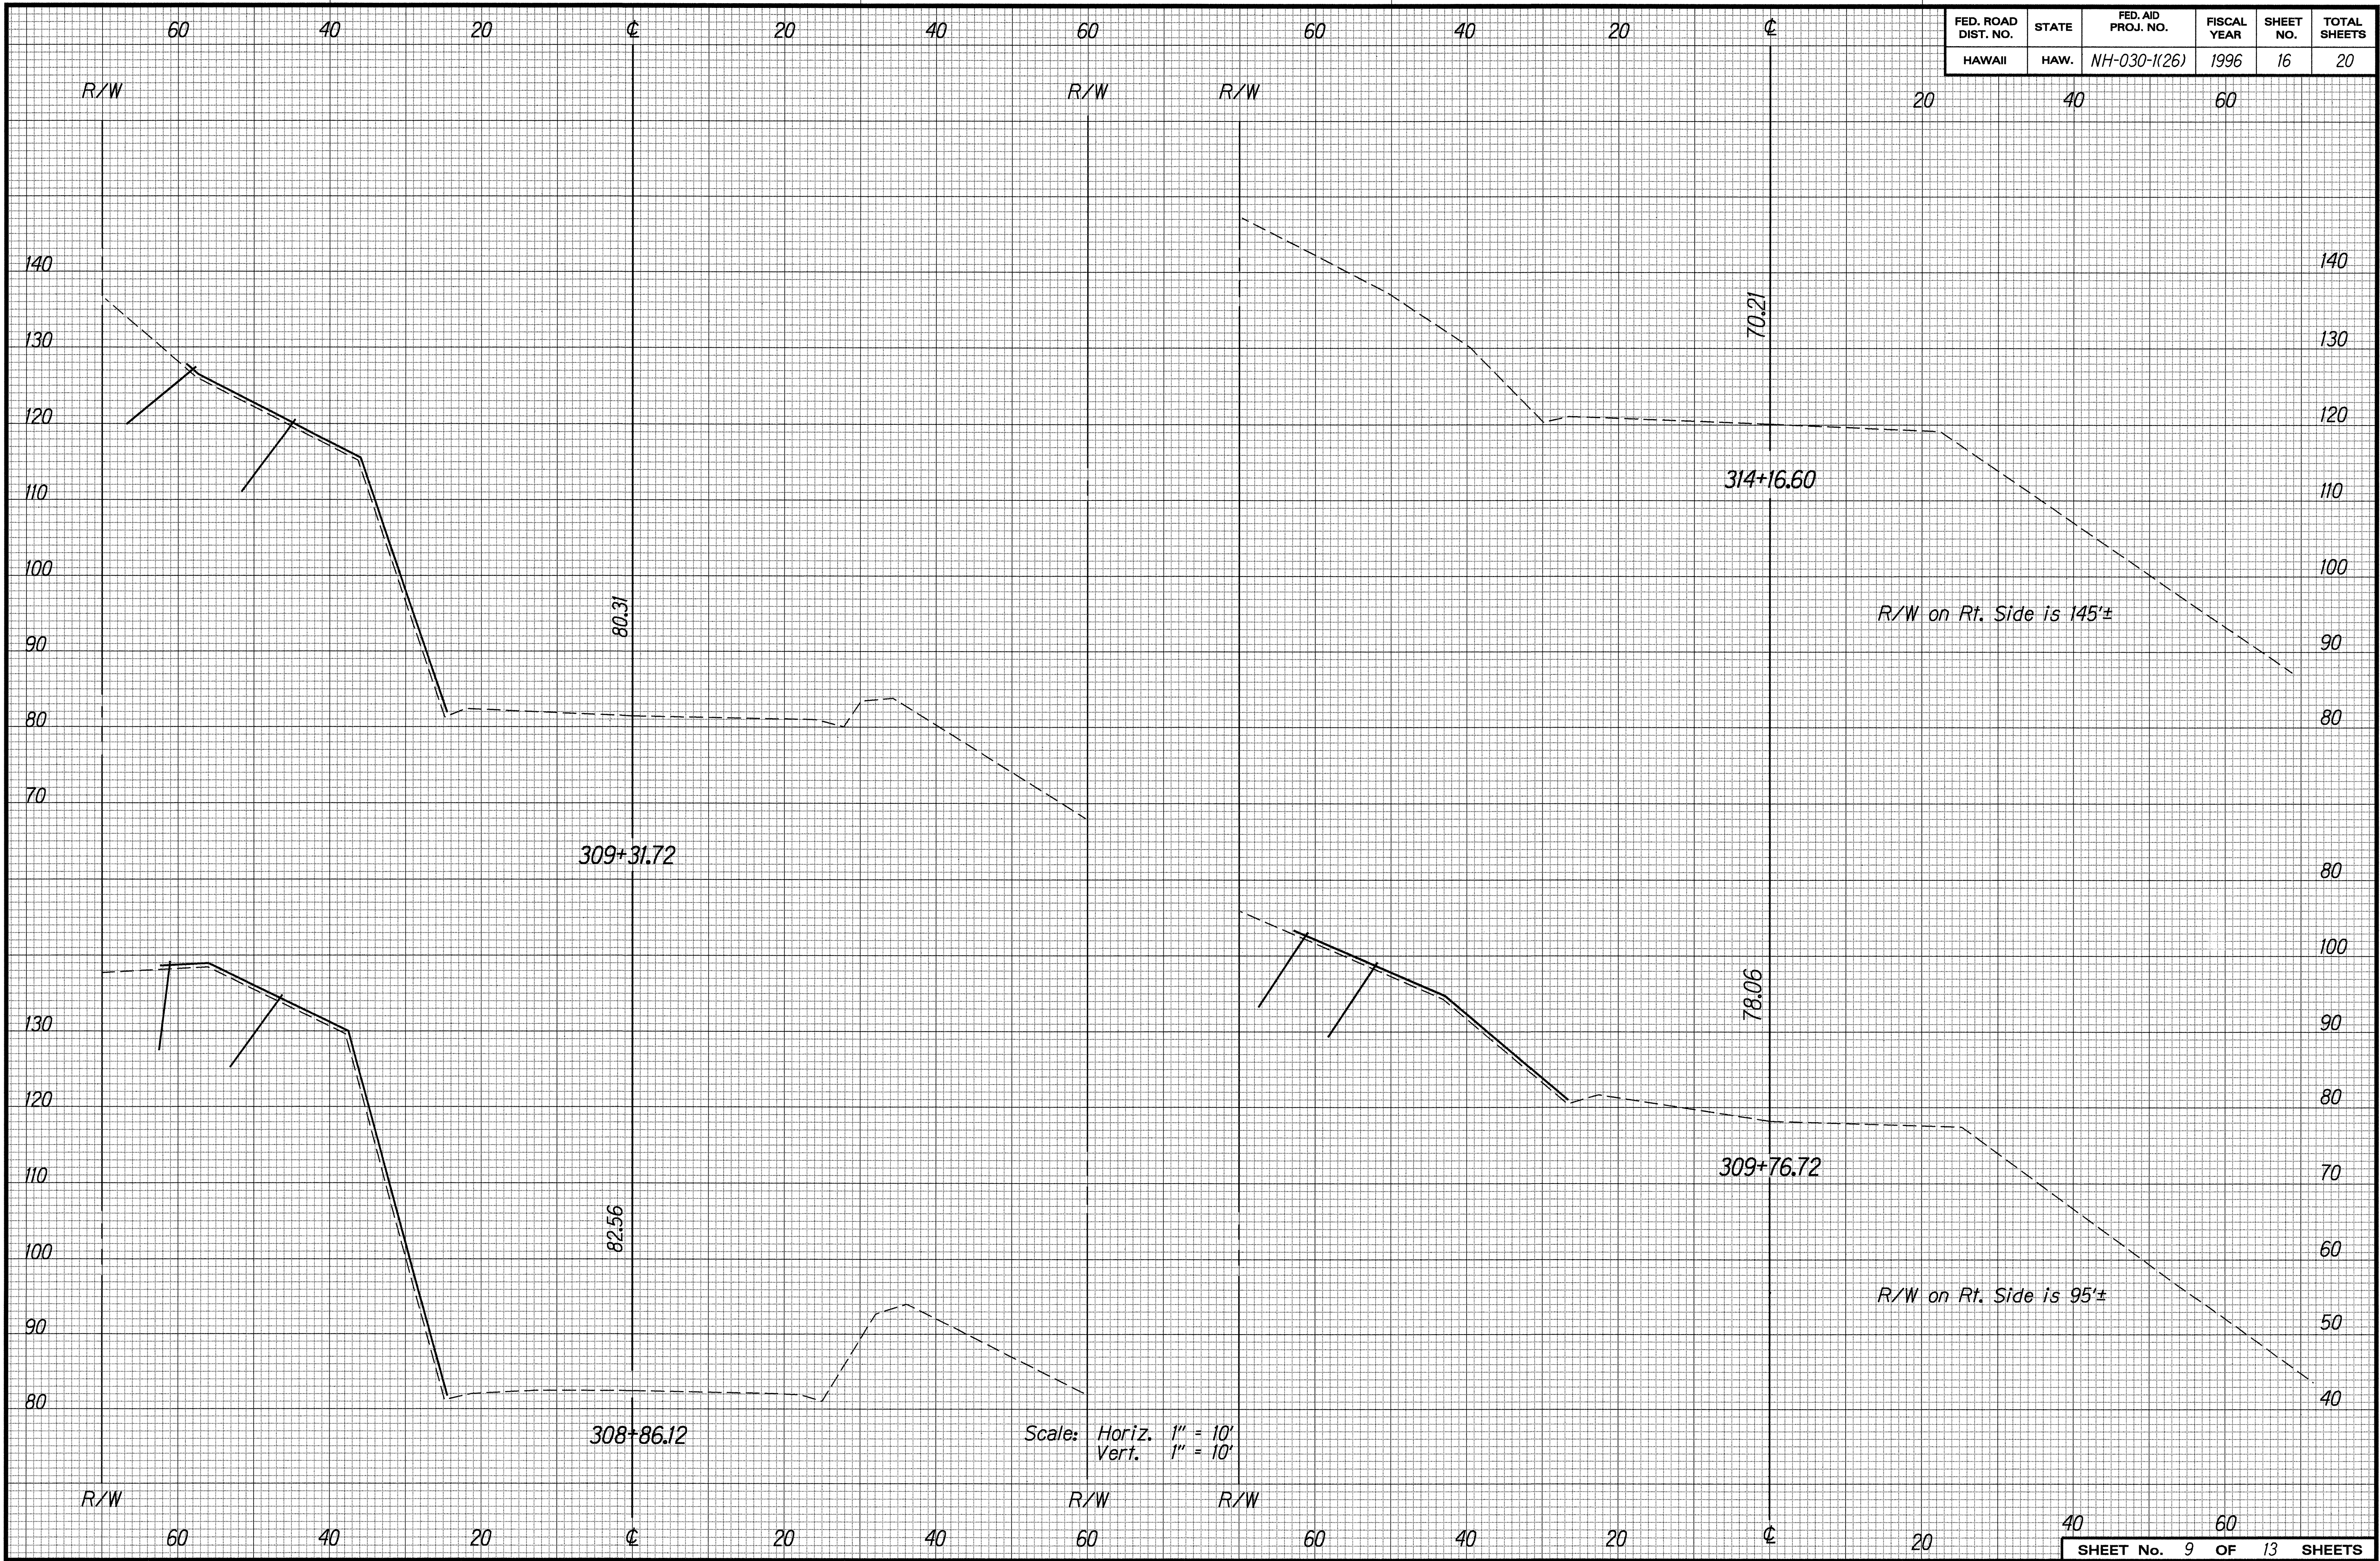


ORIGINAL PLAN	SURVEY PLOTTED BY	DATE
NOTE BOOK	DRAWN BY K. Imamura	12/29/96
DESIGNED BY R. Takasuda	CHECKED BY	
0024		

20 40 60

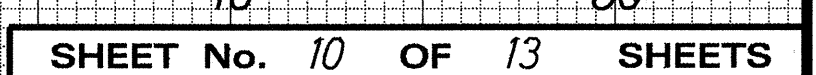


ORIGINAL PLAN	SURVEY PLOTTED BY _____	DATE _____
NOTE BOOK	DRAWN BY <i>K. Lanchina</i>	<i>13/29/93</i>
<i>ddk</i>	TRACED BY _____	•
<i>4/20/93</i>	DESIGNED BY <i>R. Takaesu/D. Taniguchi</i>	•
	QUANTITIES BY _____	•
	CHECKED BY _____	•

FED. ROAD DIST. NO.	STATE	FED. AID PROJ. NO.	FISCAL YEAR	SHEET NO.	TOTAL SHEETS
HAWAII	HAW.	NH-030-1(26)	1996	18	20

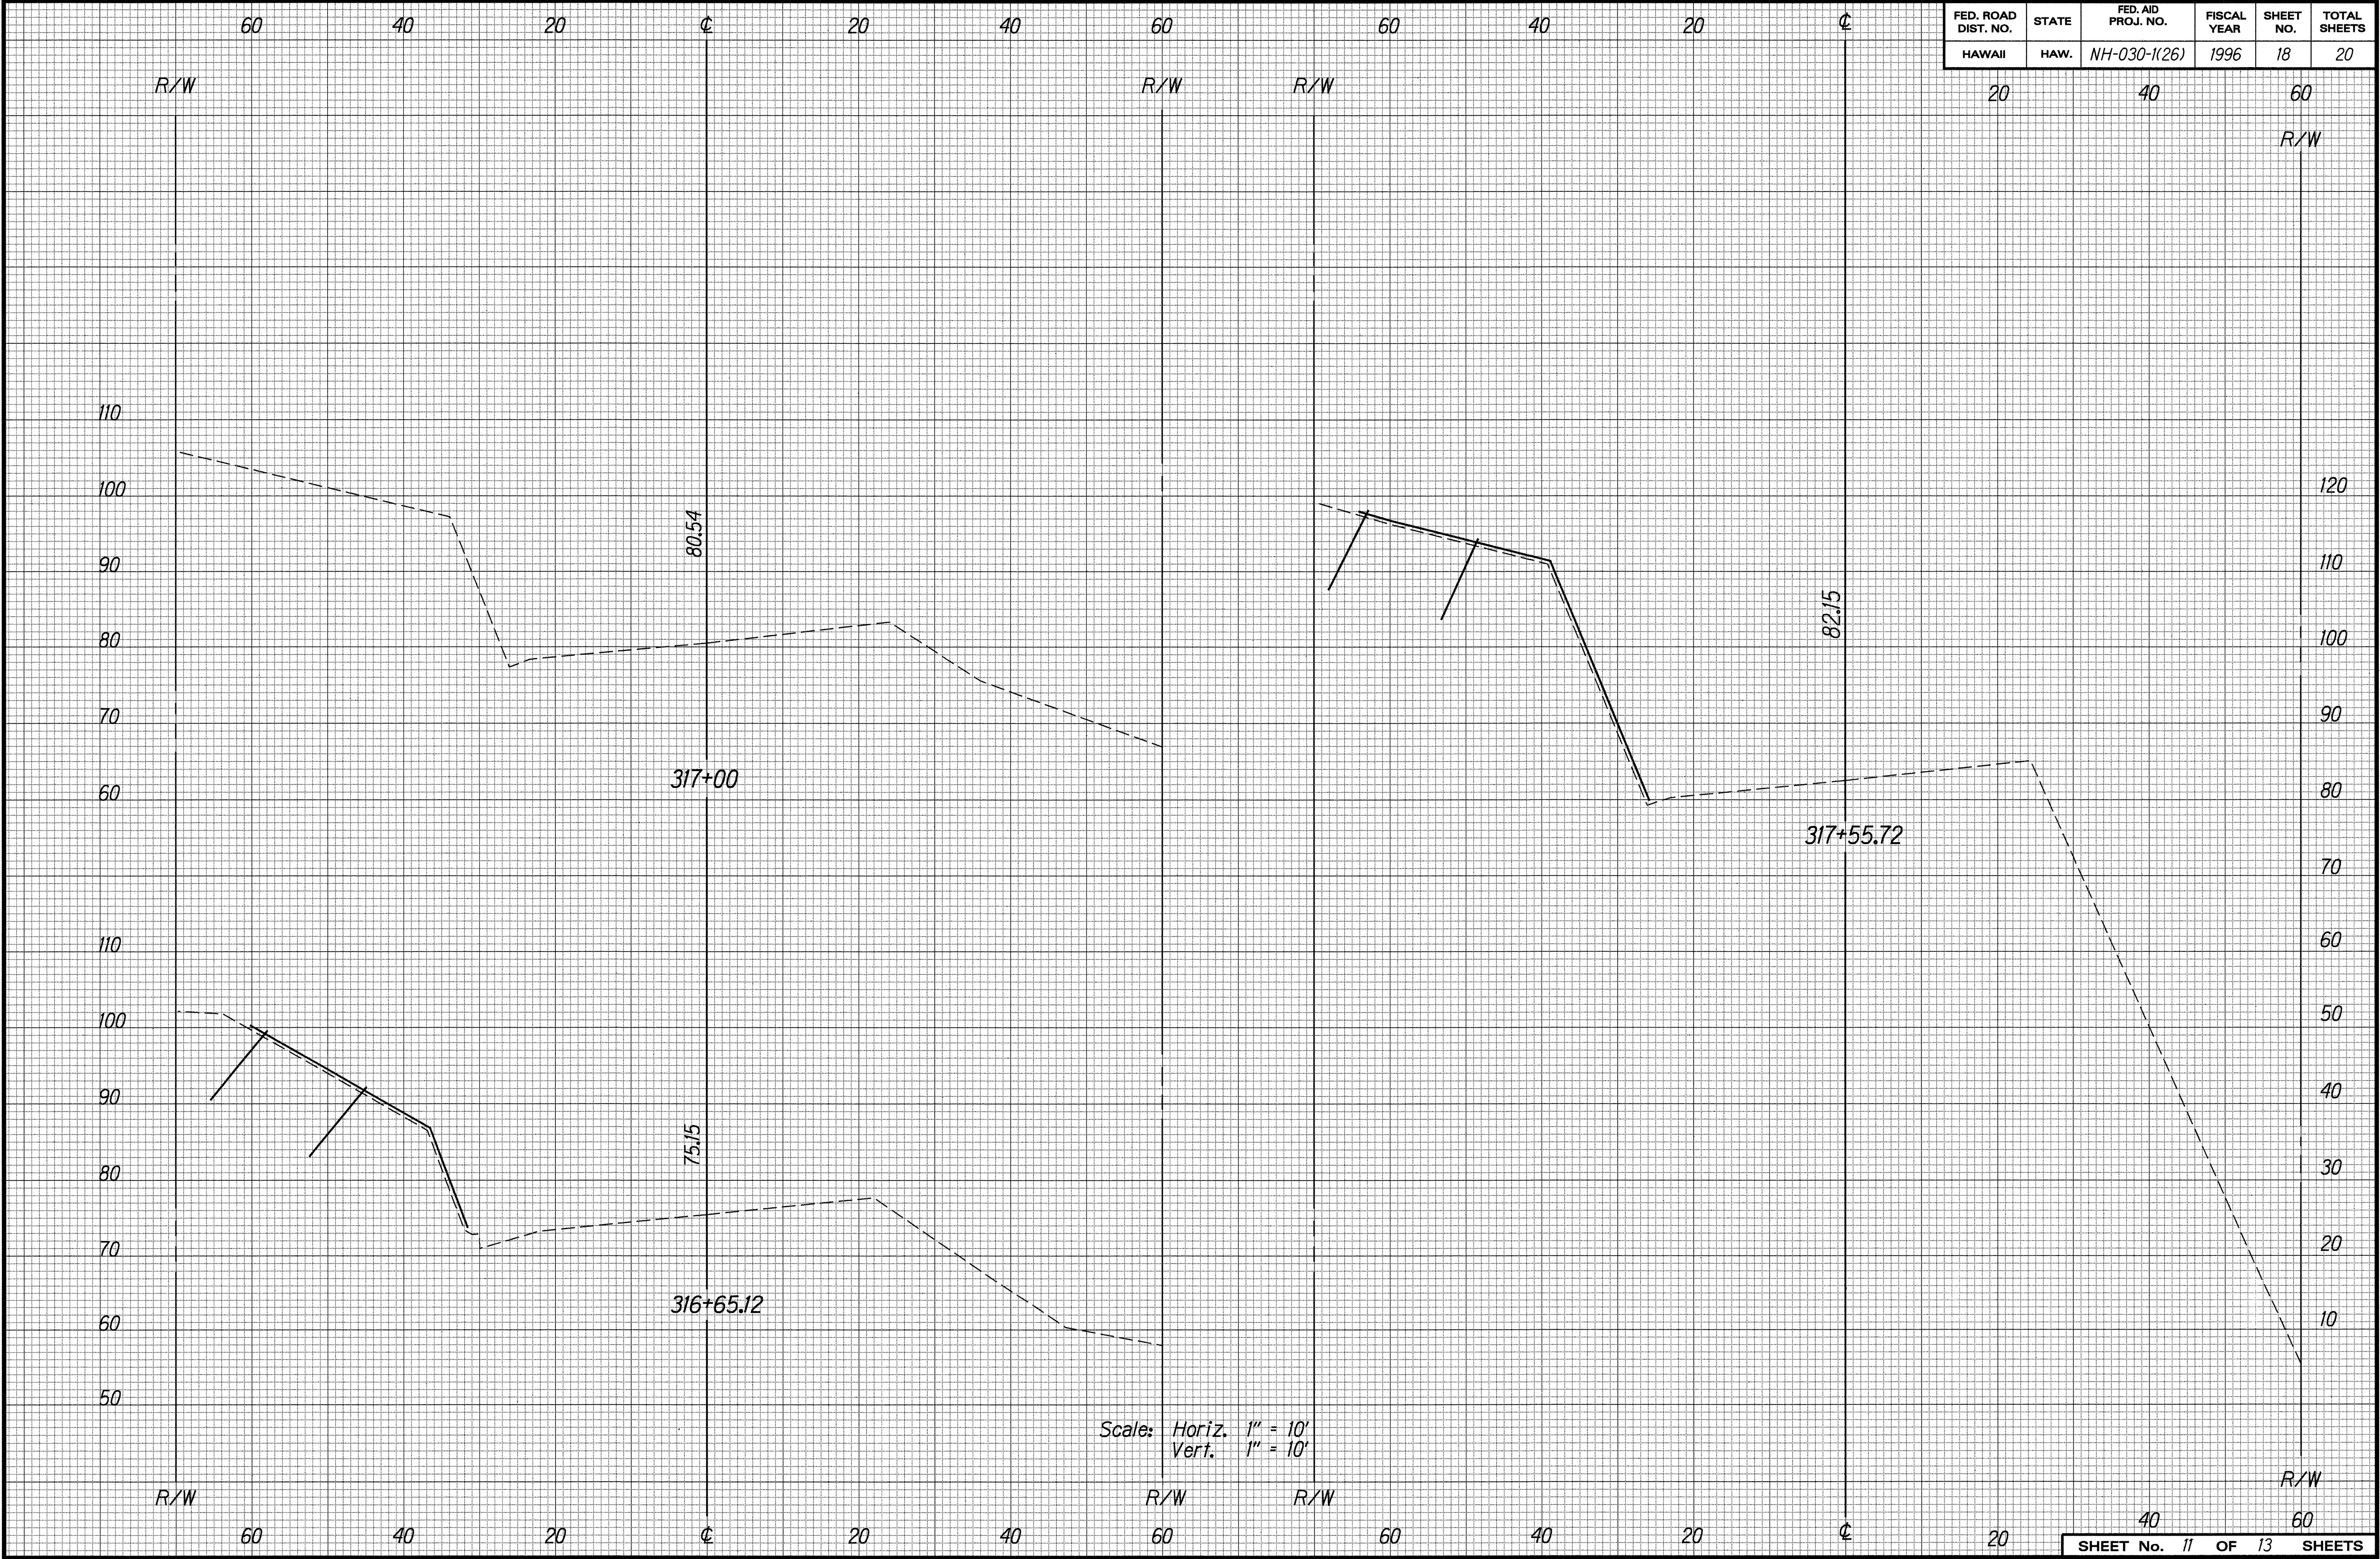


ORIGINAL PLAN
DATE 1/3/20/20
SURVEY PLOTTED BY
DRAWN BY K. Tomihata
DESIGNED BY R. Takasaka
CHECKED BY
NOTE BOOK 0024
0024

FED. ROAD DIST. NO.	STATE	FED. AID PROJ. NO.	FISCAL YEAR	SHEET NO.	TOTAL SHEETS
HAWAII	HAW.	NH-030-1(26)	1996	19	20

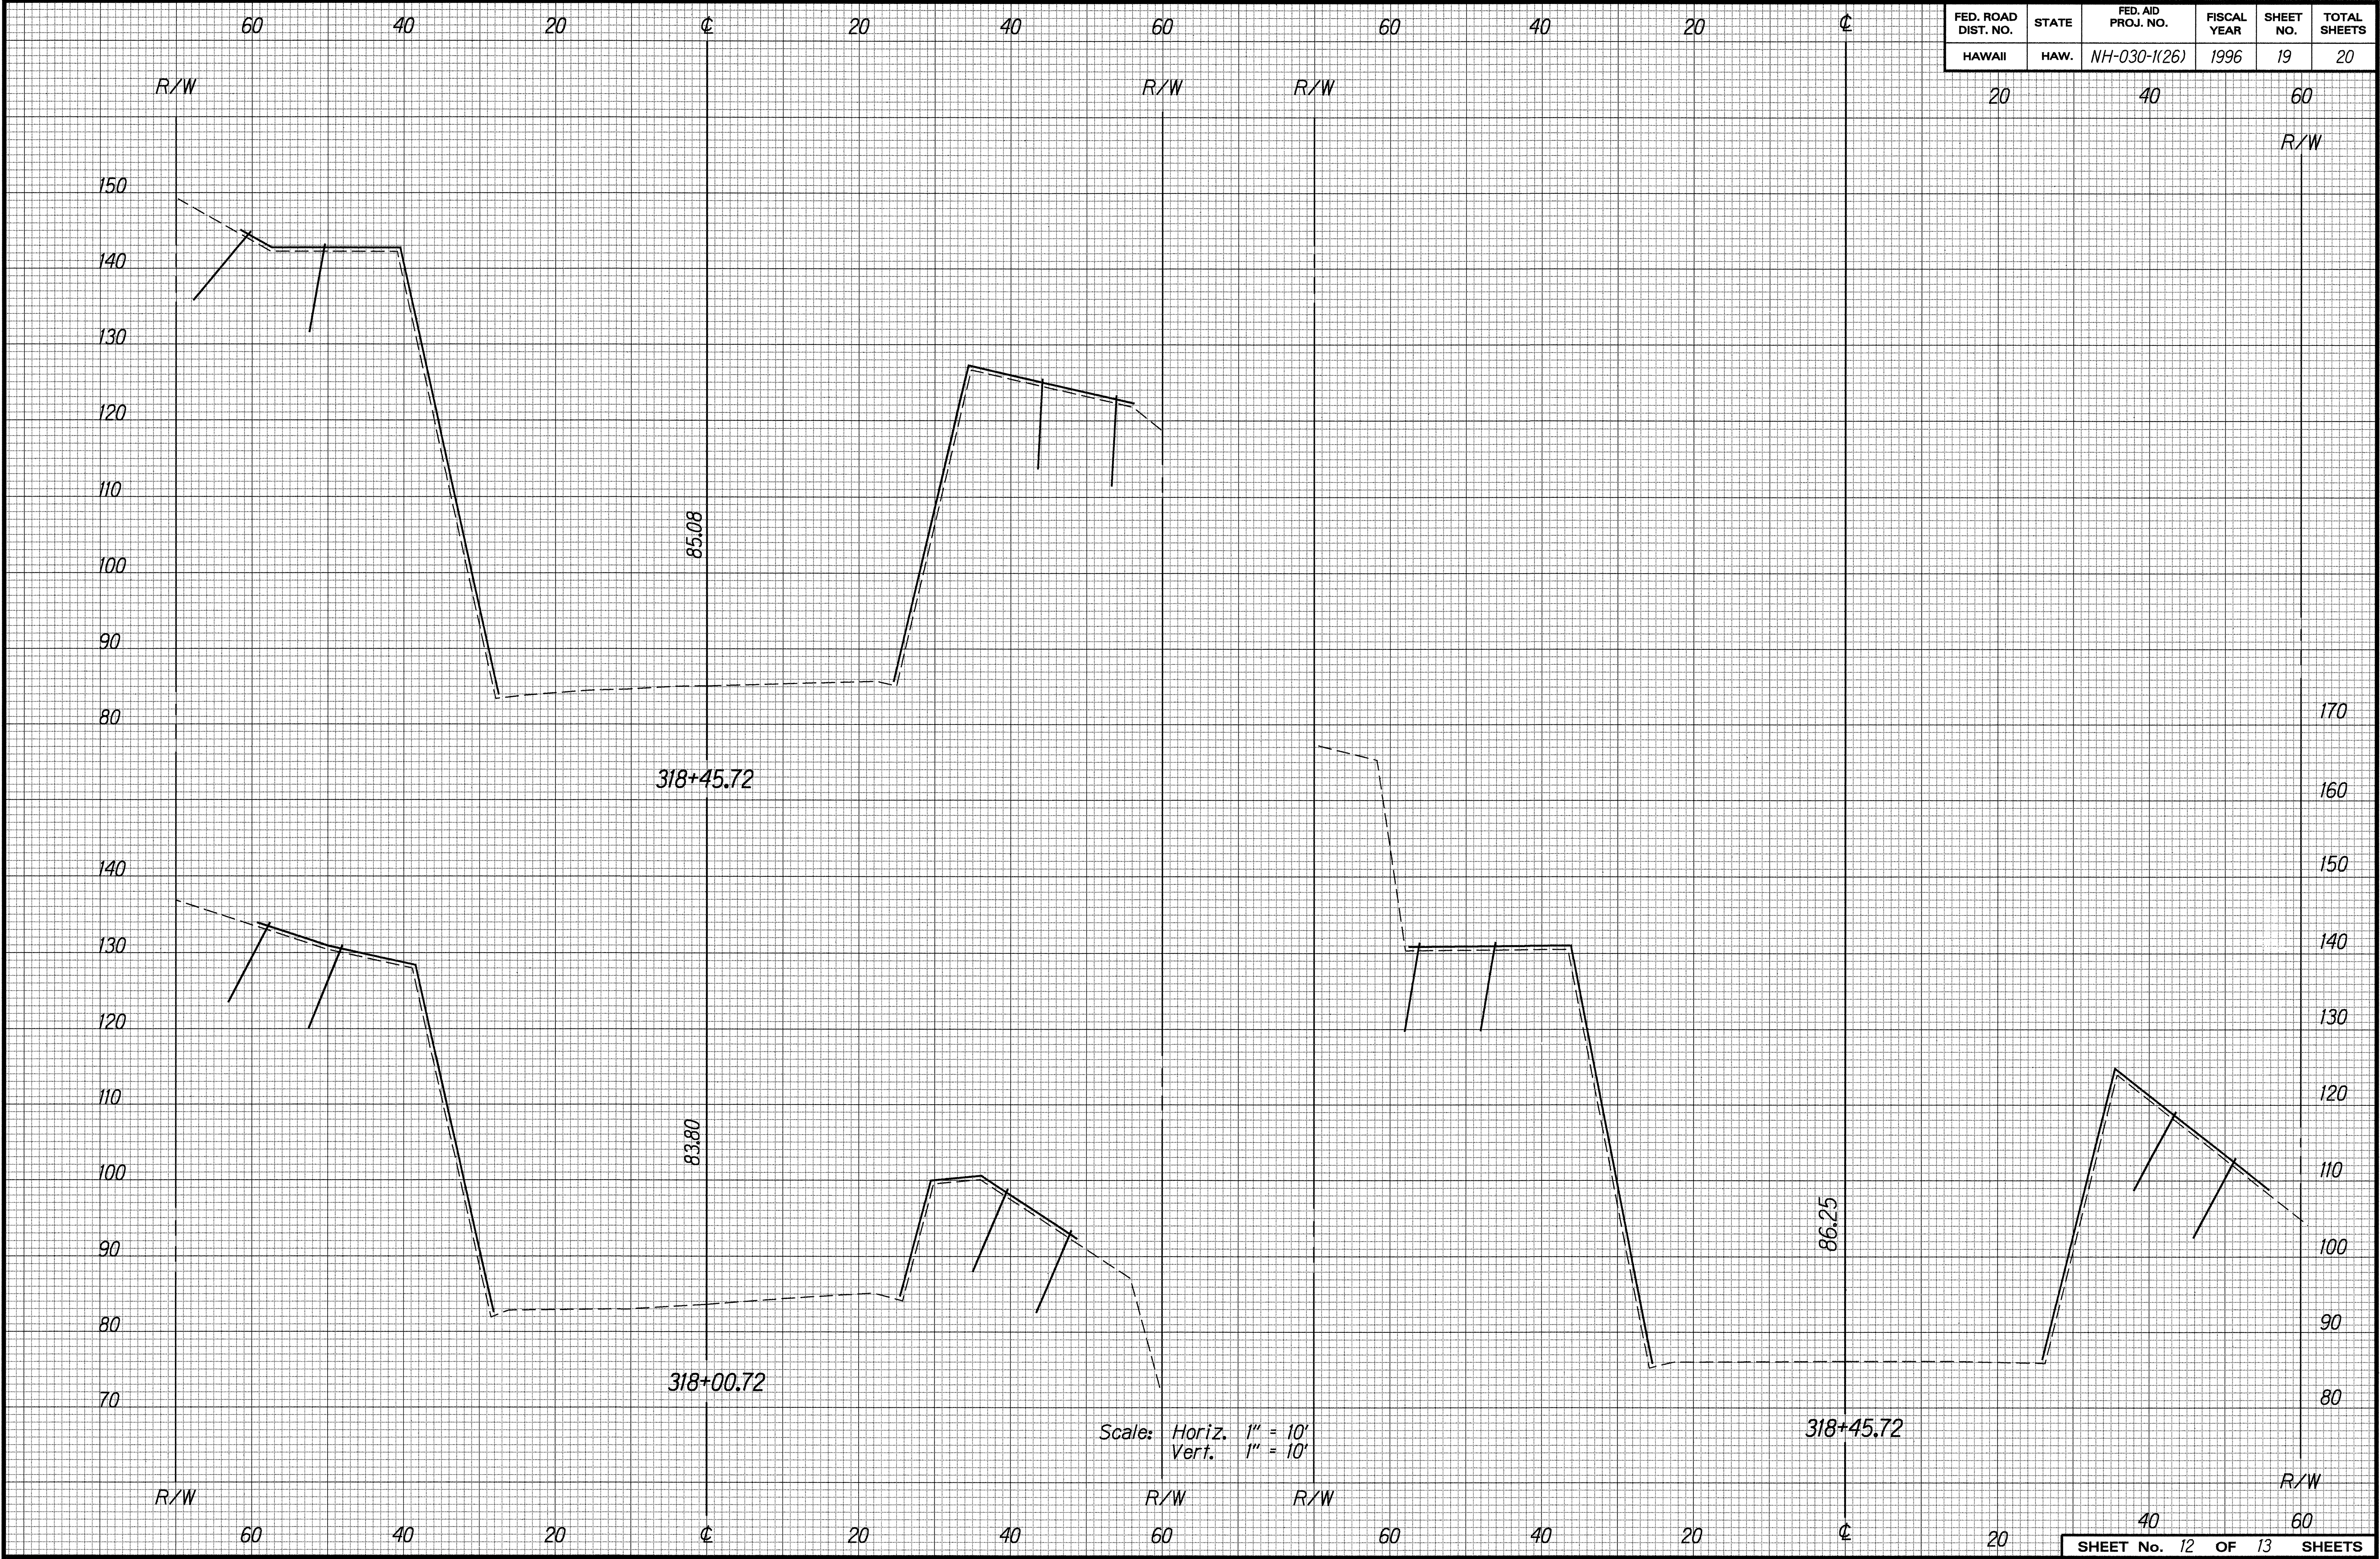

ORIGINAL PLAN
DATE: 12/29/96
DESIGNED BY: R. Takasaka, T. Taniguchi
CHECKED BY: [Signature]
NOTE: [Text]

20 40 60

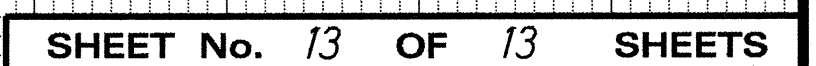

ORIGINAL PLAN	SURVEY PLOTTED BY	DATE
NOTE BOOK	DRAWN BY	
didkt	TRACED BY	
Shandesi Jag	DESIGNED BY	
	QUANTITIES BY	
	CHECKED BY	
		13/09/98