

INDEX TO DRAWINGS	
SHEET NO.	DESCRIPTION
1	TITLE SHEET
2	STANDARD PLANS SUMMARY
3	GENERAL NOTES AND LEGEND
4 - 5	ROCKFALL PROTECTION DETAILS
6 - 7	ROADWAY PLANS
8 - 20	CROSS SECTIONS

STATE OF HAWAII

DEPARTMENT OF TRANSPORTATION

HIGHWAYS DIVISION

HONOLULU, HAWAII

"AS-BUILT"

PLANS FOR

HONOAPIILANI HIGHWAY




ROCKFALL PROTECTION ALONG PALI SECTION, PHASE III

FEDERAL AID PROJECT NO. NH-030-1(26)

DISTRICT OF LAHAINA

ISLAND OF MAUI

FED. ROAD DIST. NO.	STATE	FED. AID PROJ. NO.	FISCAL YEAR	SHEET NO.	TOTAL SHEETS
HAWAII	HAW.	NH-030-1(26)	1996	1	20

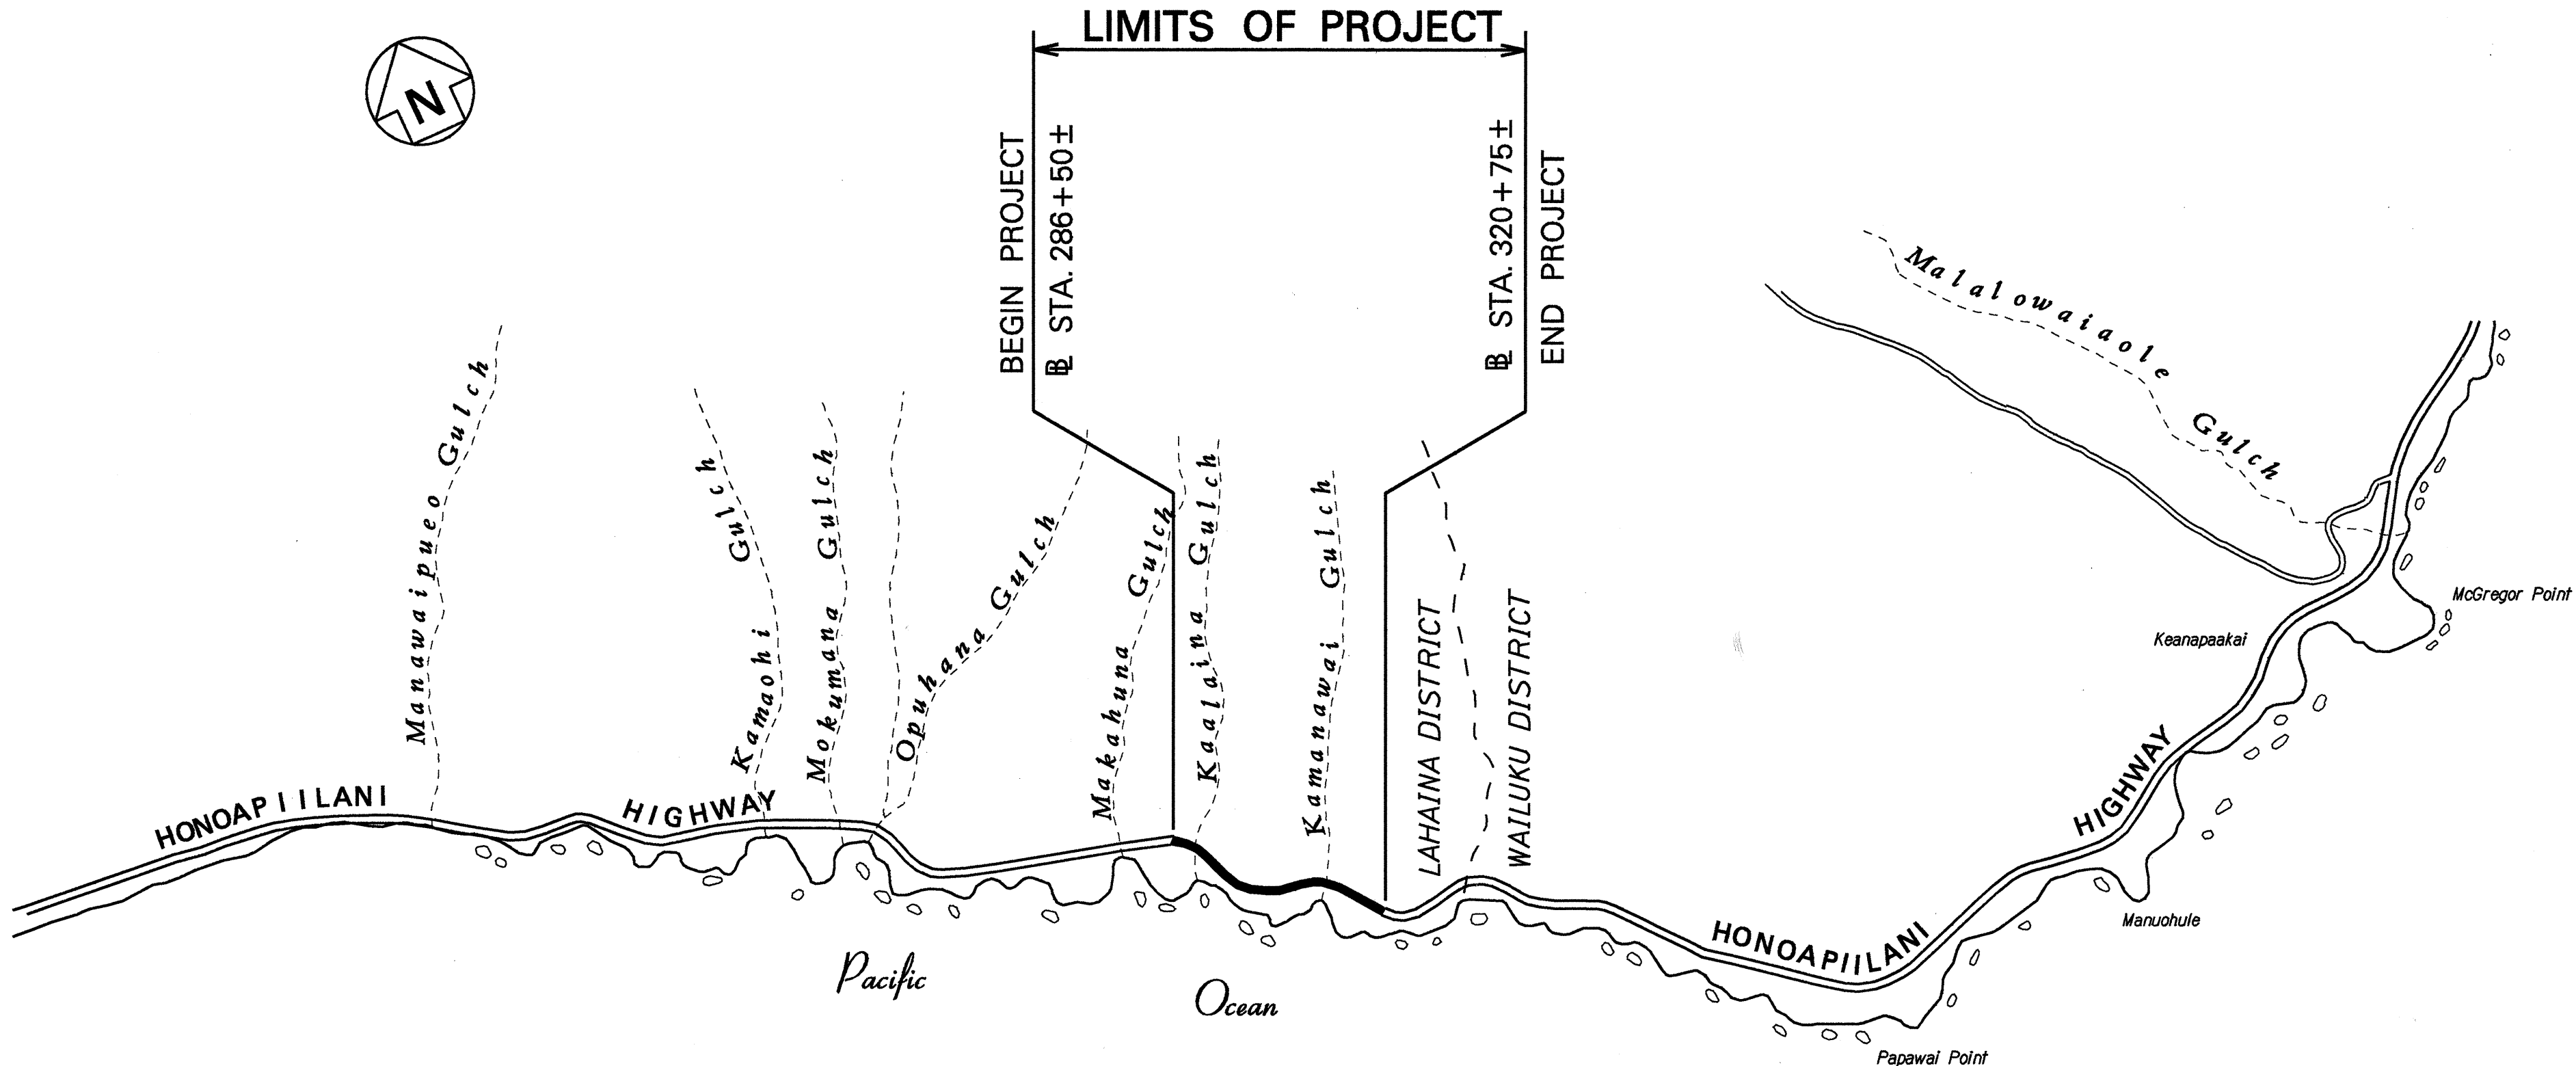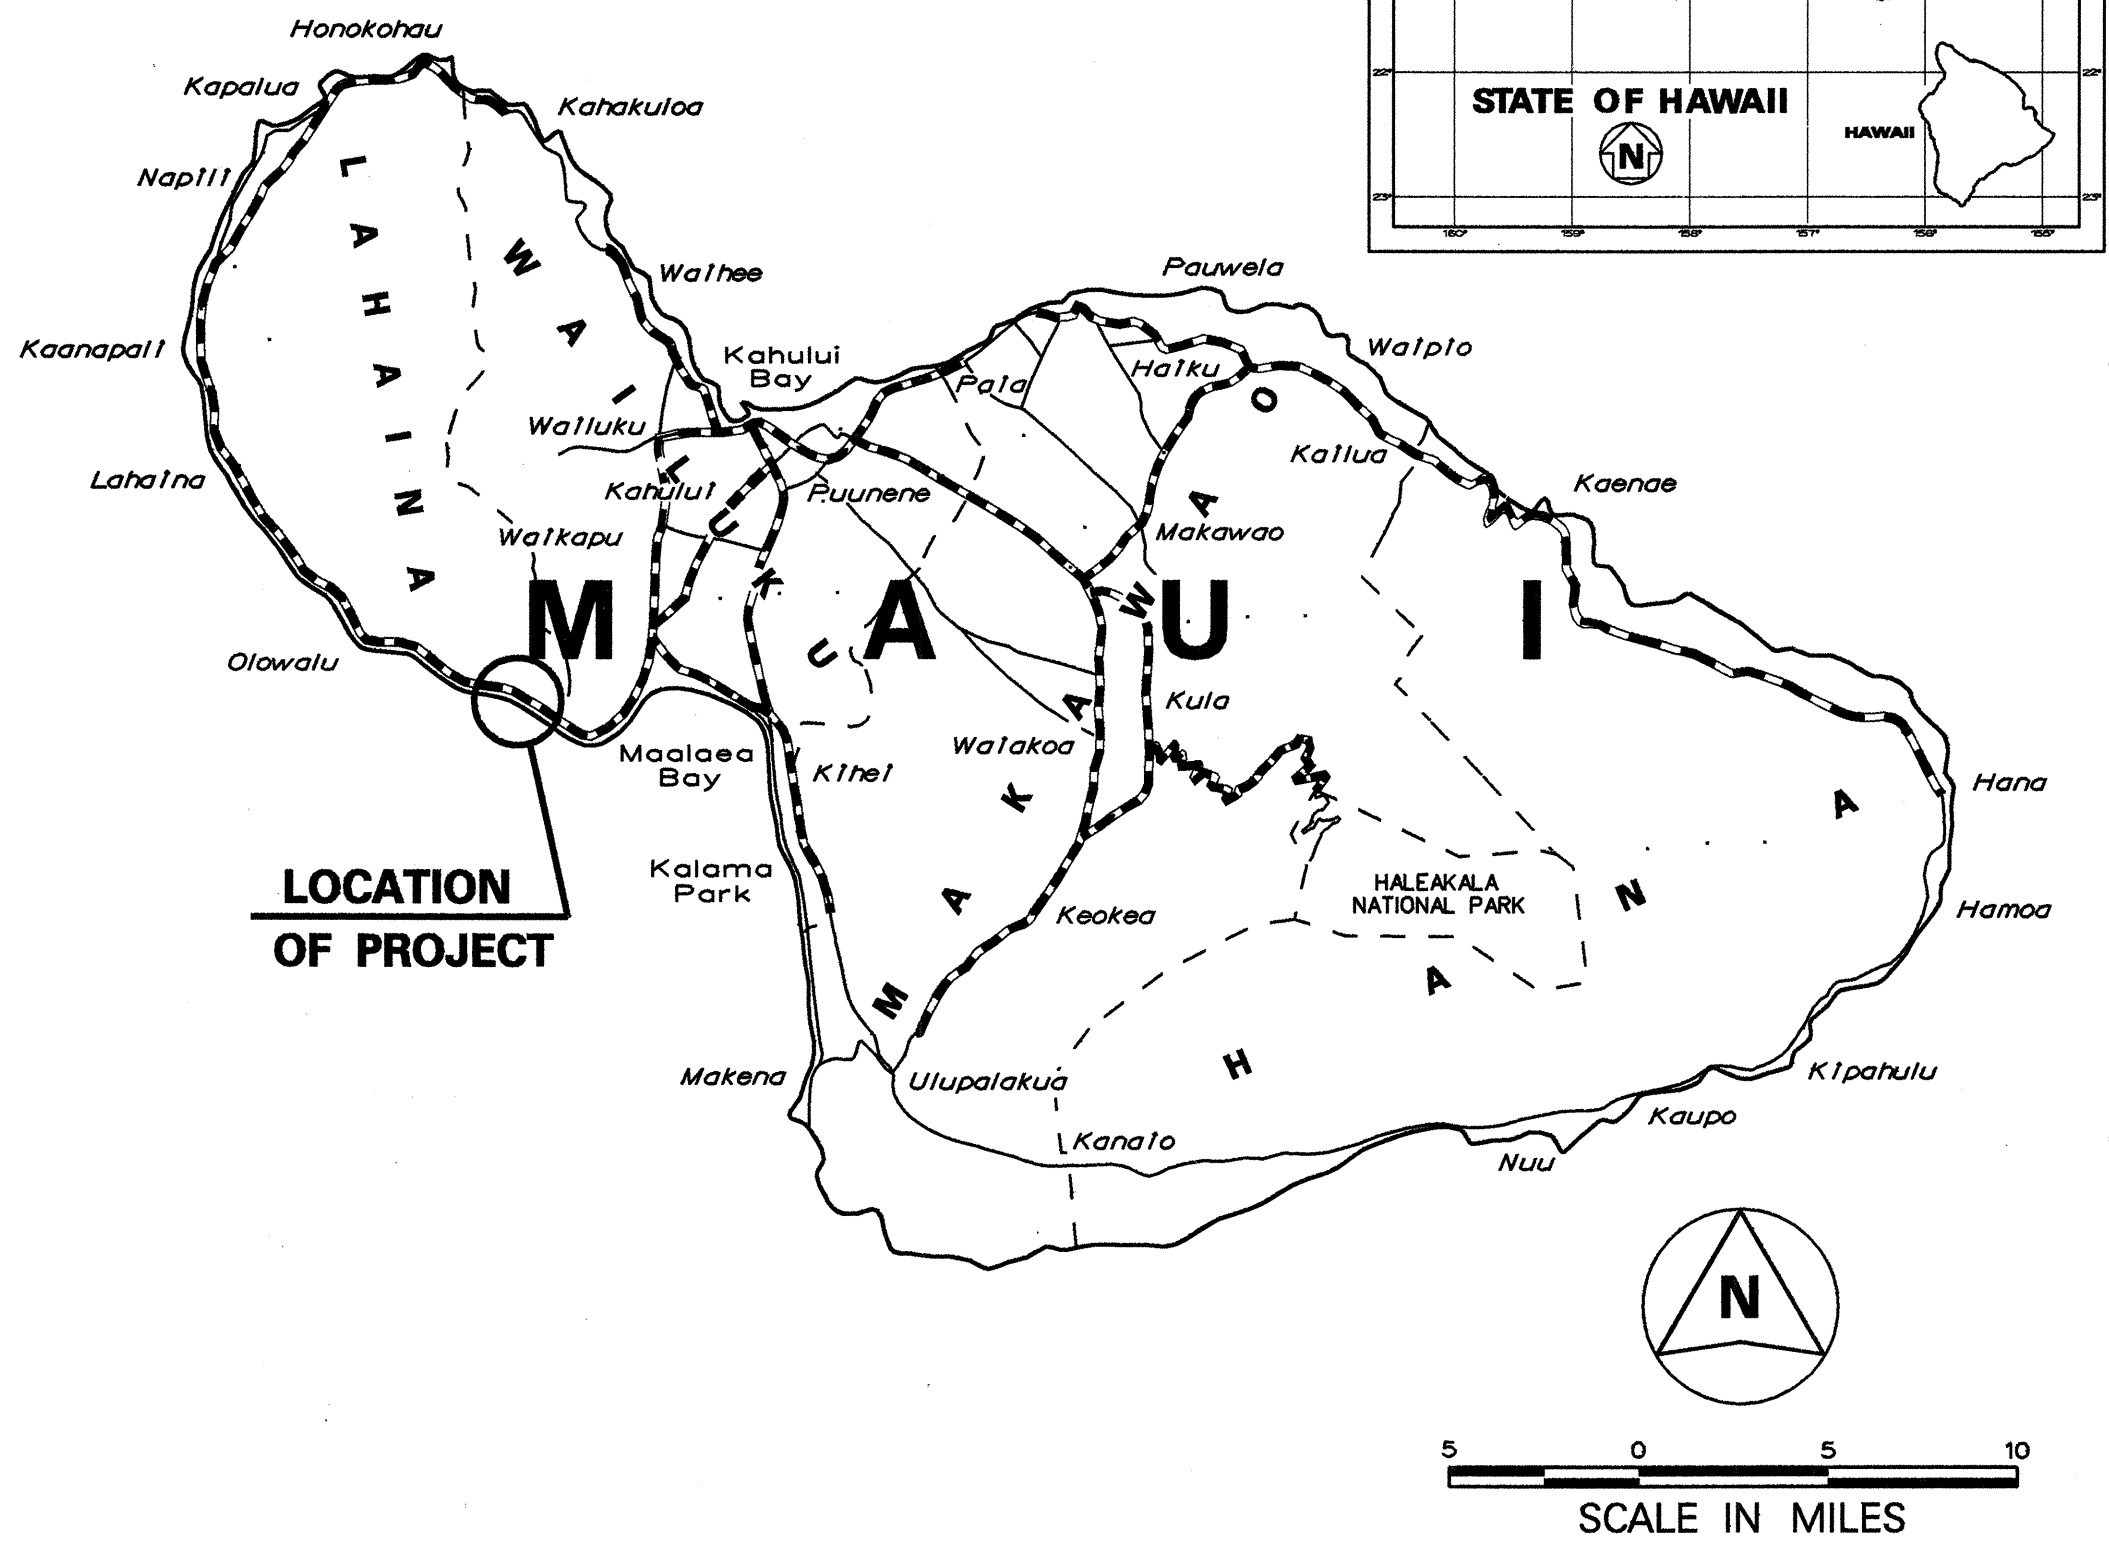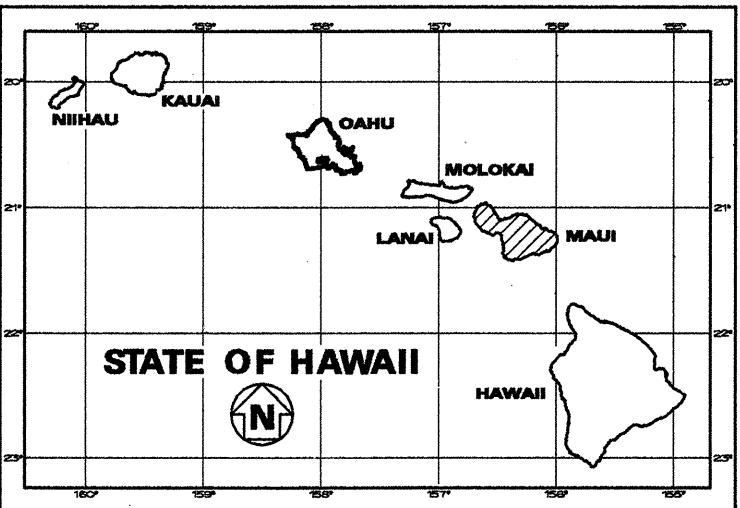

FEDERAL AID PROJECTS PREVIOUSLY CONSTRUCTED OR UNDER CONSTRUCTION
 MILE POST 9.22 TO MILE POST 10.80

DESIGN DESIGNATION	
CURRENT ADT.....	22,900
DESIGN ADT.....	25,760
DHV.....	2,190
D.....	55/45
T ₂₄	4.5 %
V.....	45 M.P.H.

CHANGES MADE DURING CONSTRUCTION HAVE BEEN ADDED TO THESE PLANS. FOR CHANGES IN ORIGINAL QUANTITIES, SEE PROJECT LEDGER AND/OR COMPUTATION BOOK.

RESIDENT ENGINEER *SP* 11/17/98.
 DATE

DEPARTMENT OF TRANSPORTATION
 STATE OF HAWAII
 APPROVED: *Dir. of Transportation* 5/15/96
 DIR. OF TRANSPORTATION DATE

DESIGN UNIT "E"
 DESIGNED BY J. FUJIMOTO
 P.S. & E. BY 587-2249
 PHONE MAY, 1996
 DATE

LOCATION PLAN
 GROSS LENGTH OF PROJECT.....1.58 MILES
 NET LENGTH OF PROJECT.....0.85 MILES
 SCALE IN THOUSAND FEET