



FED. ROAD DIST. NO.	STATE	PROJ. NO.	FISCAL YEAR	SHEET NO.	TOTAL SHEETS
HAWAII	HAW.	30ABC-01-97M	1997	17	51

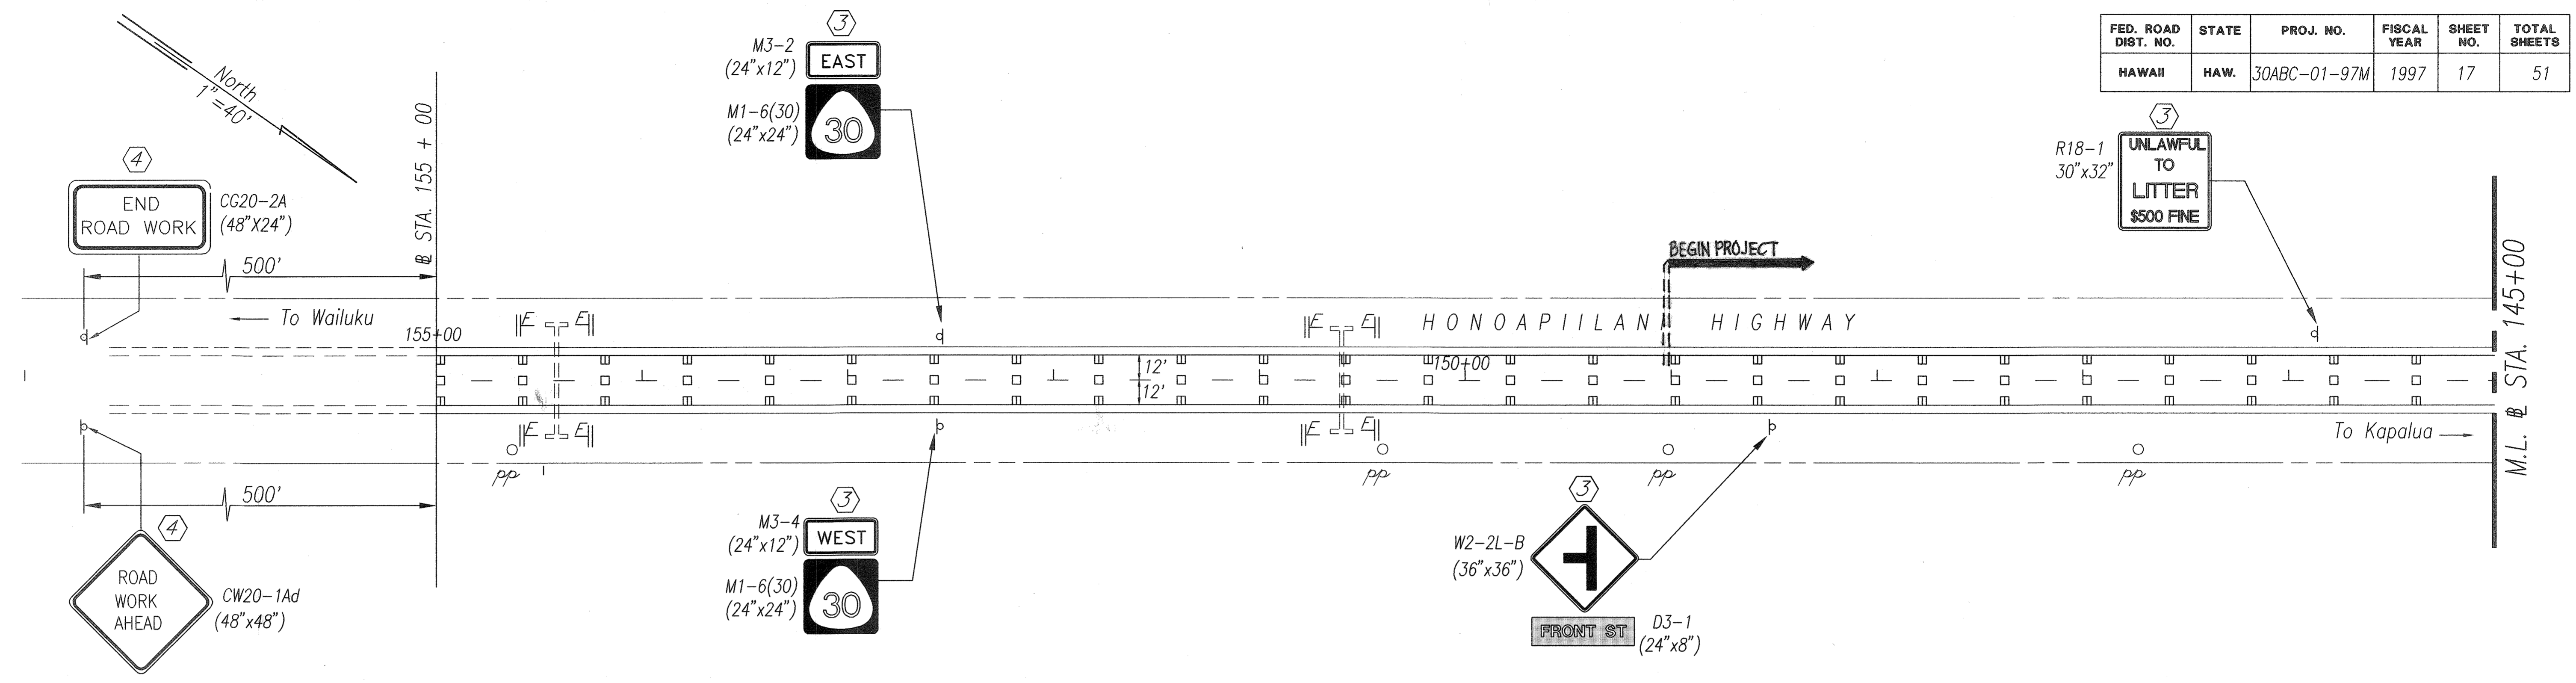

LEGEND FOR SIGNS

- ① Exist. Sign(s) & Post(s) to remain.
- ② Remove Exist. Sign(s) & Post(s).
- ③ Remove Exist. Sign(s) & Post(s). Install New Sign(s) & Post(s).
- ④ Install New Sign(s) & Post(s).

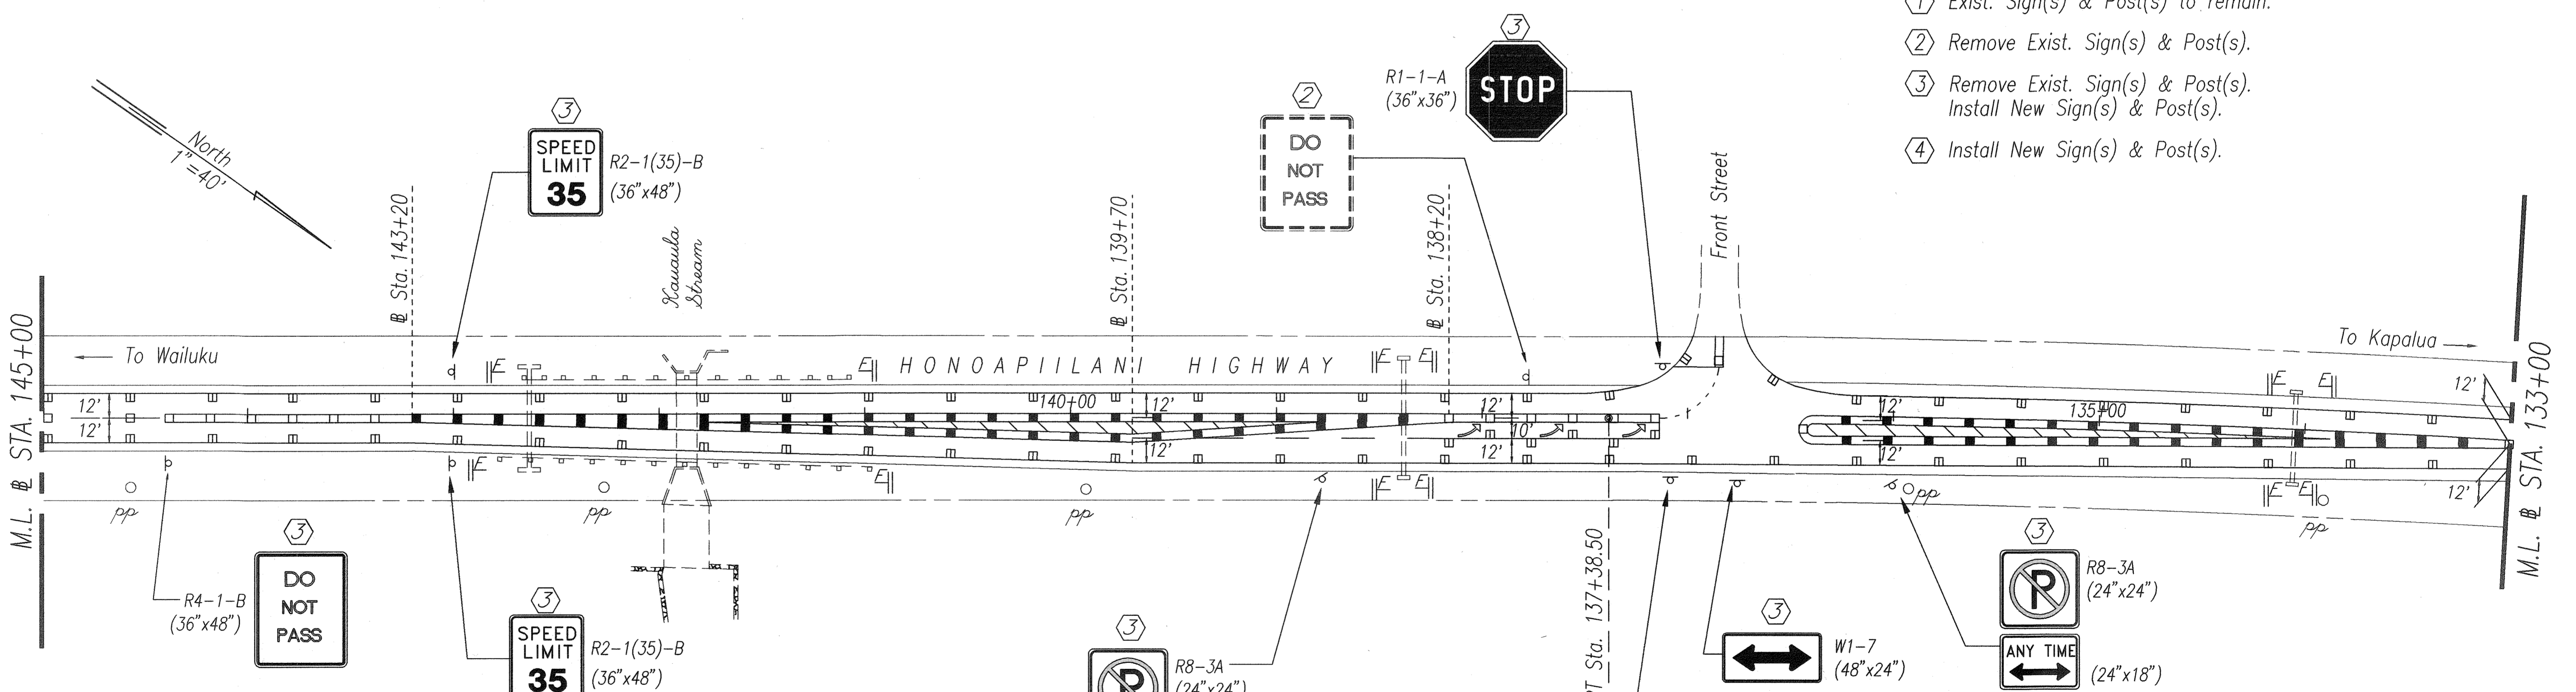

SURVEY PLOTTED BY	DATE
DRAWN BY	
TRACED BY	
QUANTITIES BY	
CHECKED BY	
ORIGINAL PLAN NO.	

THIS WORK WAS DONE BY ME OR UNDER MY SUPERVISION

Paul T. Taniguchi

STATE OF HAWAII
DEPARTMENT OF TRANSPORTATION
HIGHWAYS DIVISION

SIGNING AND PAVEMENT

MARKING PLANS


HONOAPIILANI HIGHWAY RESURFACING
Puamana to Kaanapali
Project No. 30ABC-01-97M

SCALE: 1" = 40' DATE: April, 1997


SHEET NO. 1 OF 11 SHEETS

"AS-BUILT"

FED. ROAD DIST. NO.	STATE	PROJ. NO.	FISCAL YEAR	SHEET NO.	TOTAL SHEETS
HAWAII	HAW.	30ABC-01-97M	1997	18	51

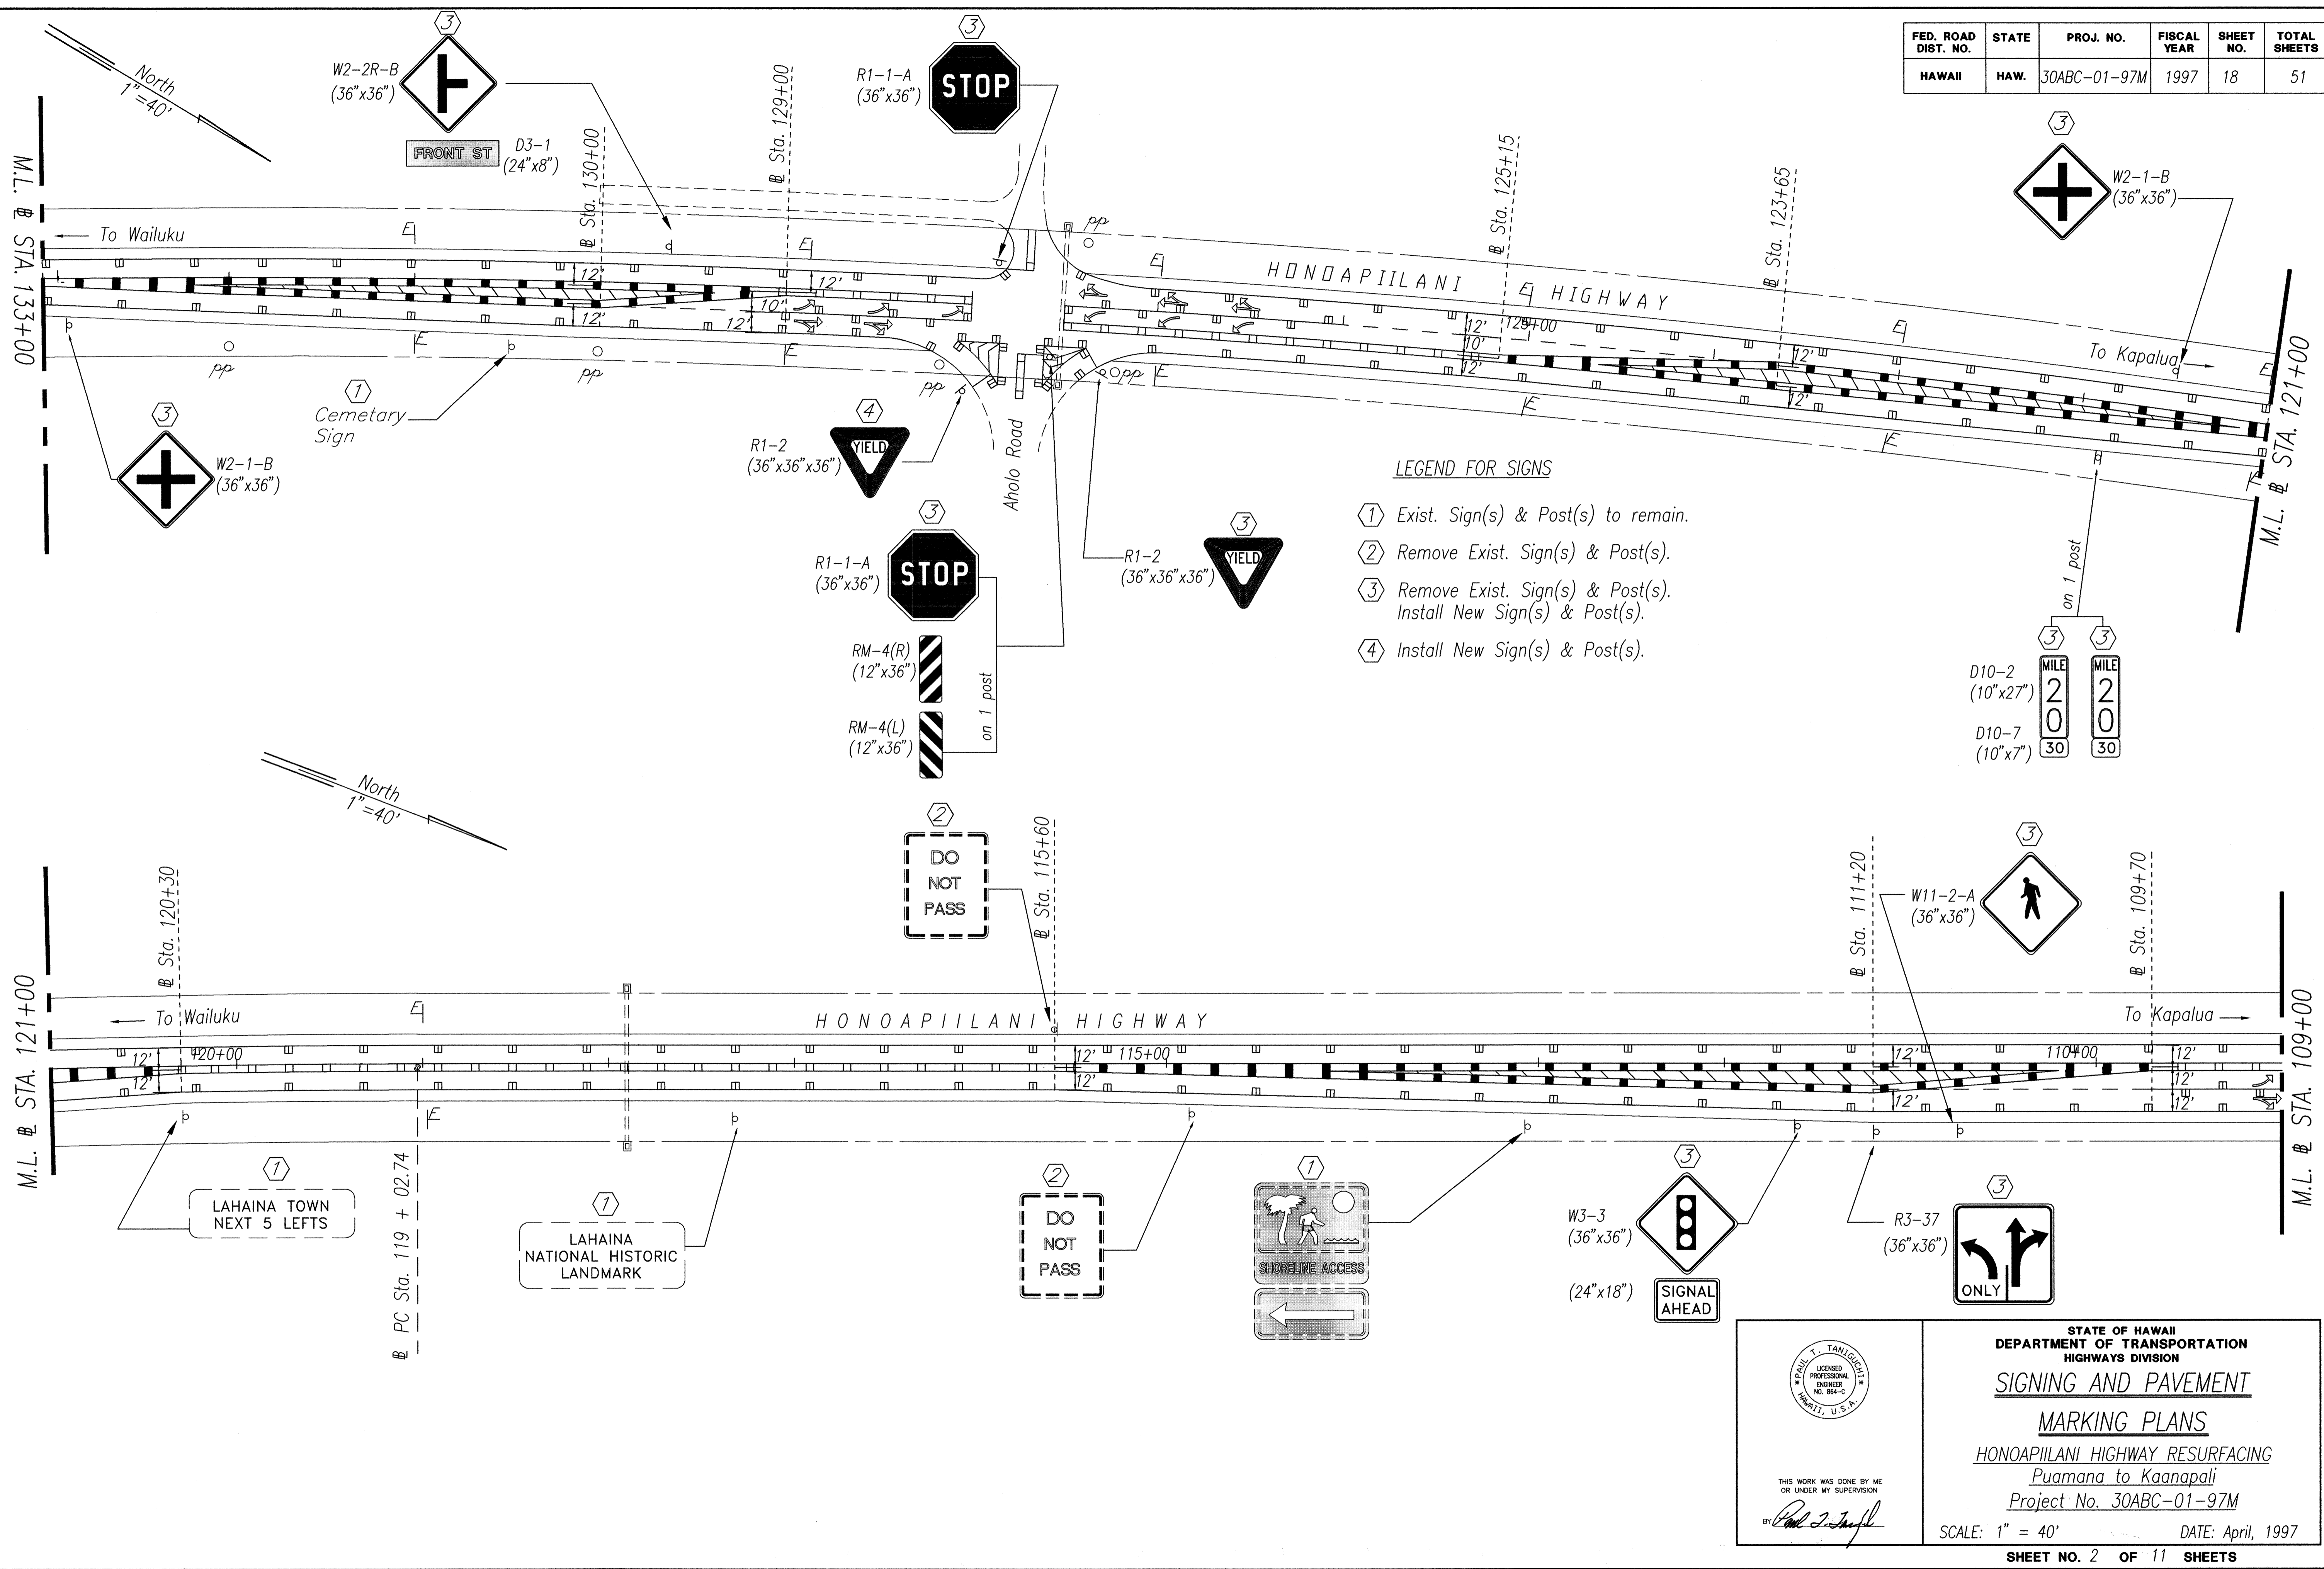


DATE	_____
SURVEY PLOTTED BY	_____
DESIGNED BY	_____
QUANTITIES BY	_____
CHECKED BY	_____
NO.	_____

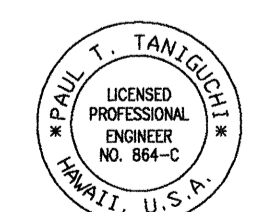
 THIS WORK WAS DONE BY ME OR UNDER MY SUPERVISION
 BY *Paul T. Taniguchi*

STATE OF HAWAII
 DEPARTMENT OF TRANSPORTATION
 HIGHWAYS DIVISION
SIGNING AND PAVEMENT
MARKING PLANS
 HONOAPIILANI HIGHWAY RESURFACING
 Puamana to Kaanapali
 Project No. 30ABC-01-97M
 SCALE: 1" = 40' DATE: April, 1997

FED. ROAD DIST. NO.	STATE	PROJ. NO.	FISCAL YEAR	SHEET NO.	TOTAL SHEETS
HAWAII	HAW.	30ABC-01-97M	1997	19	51

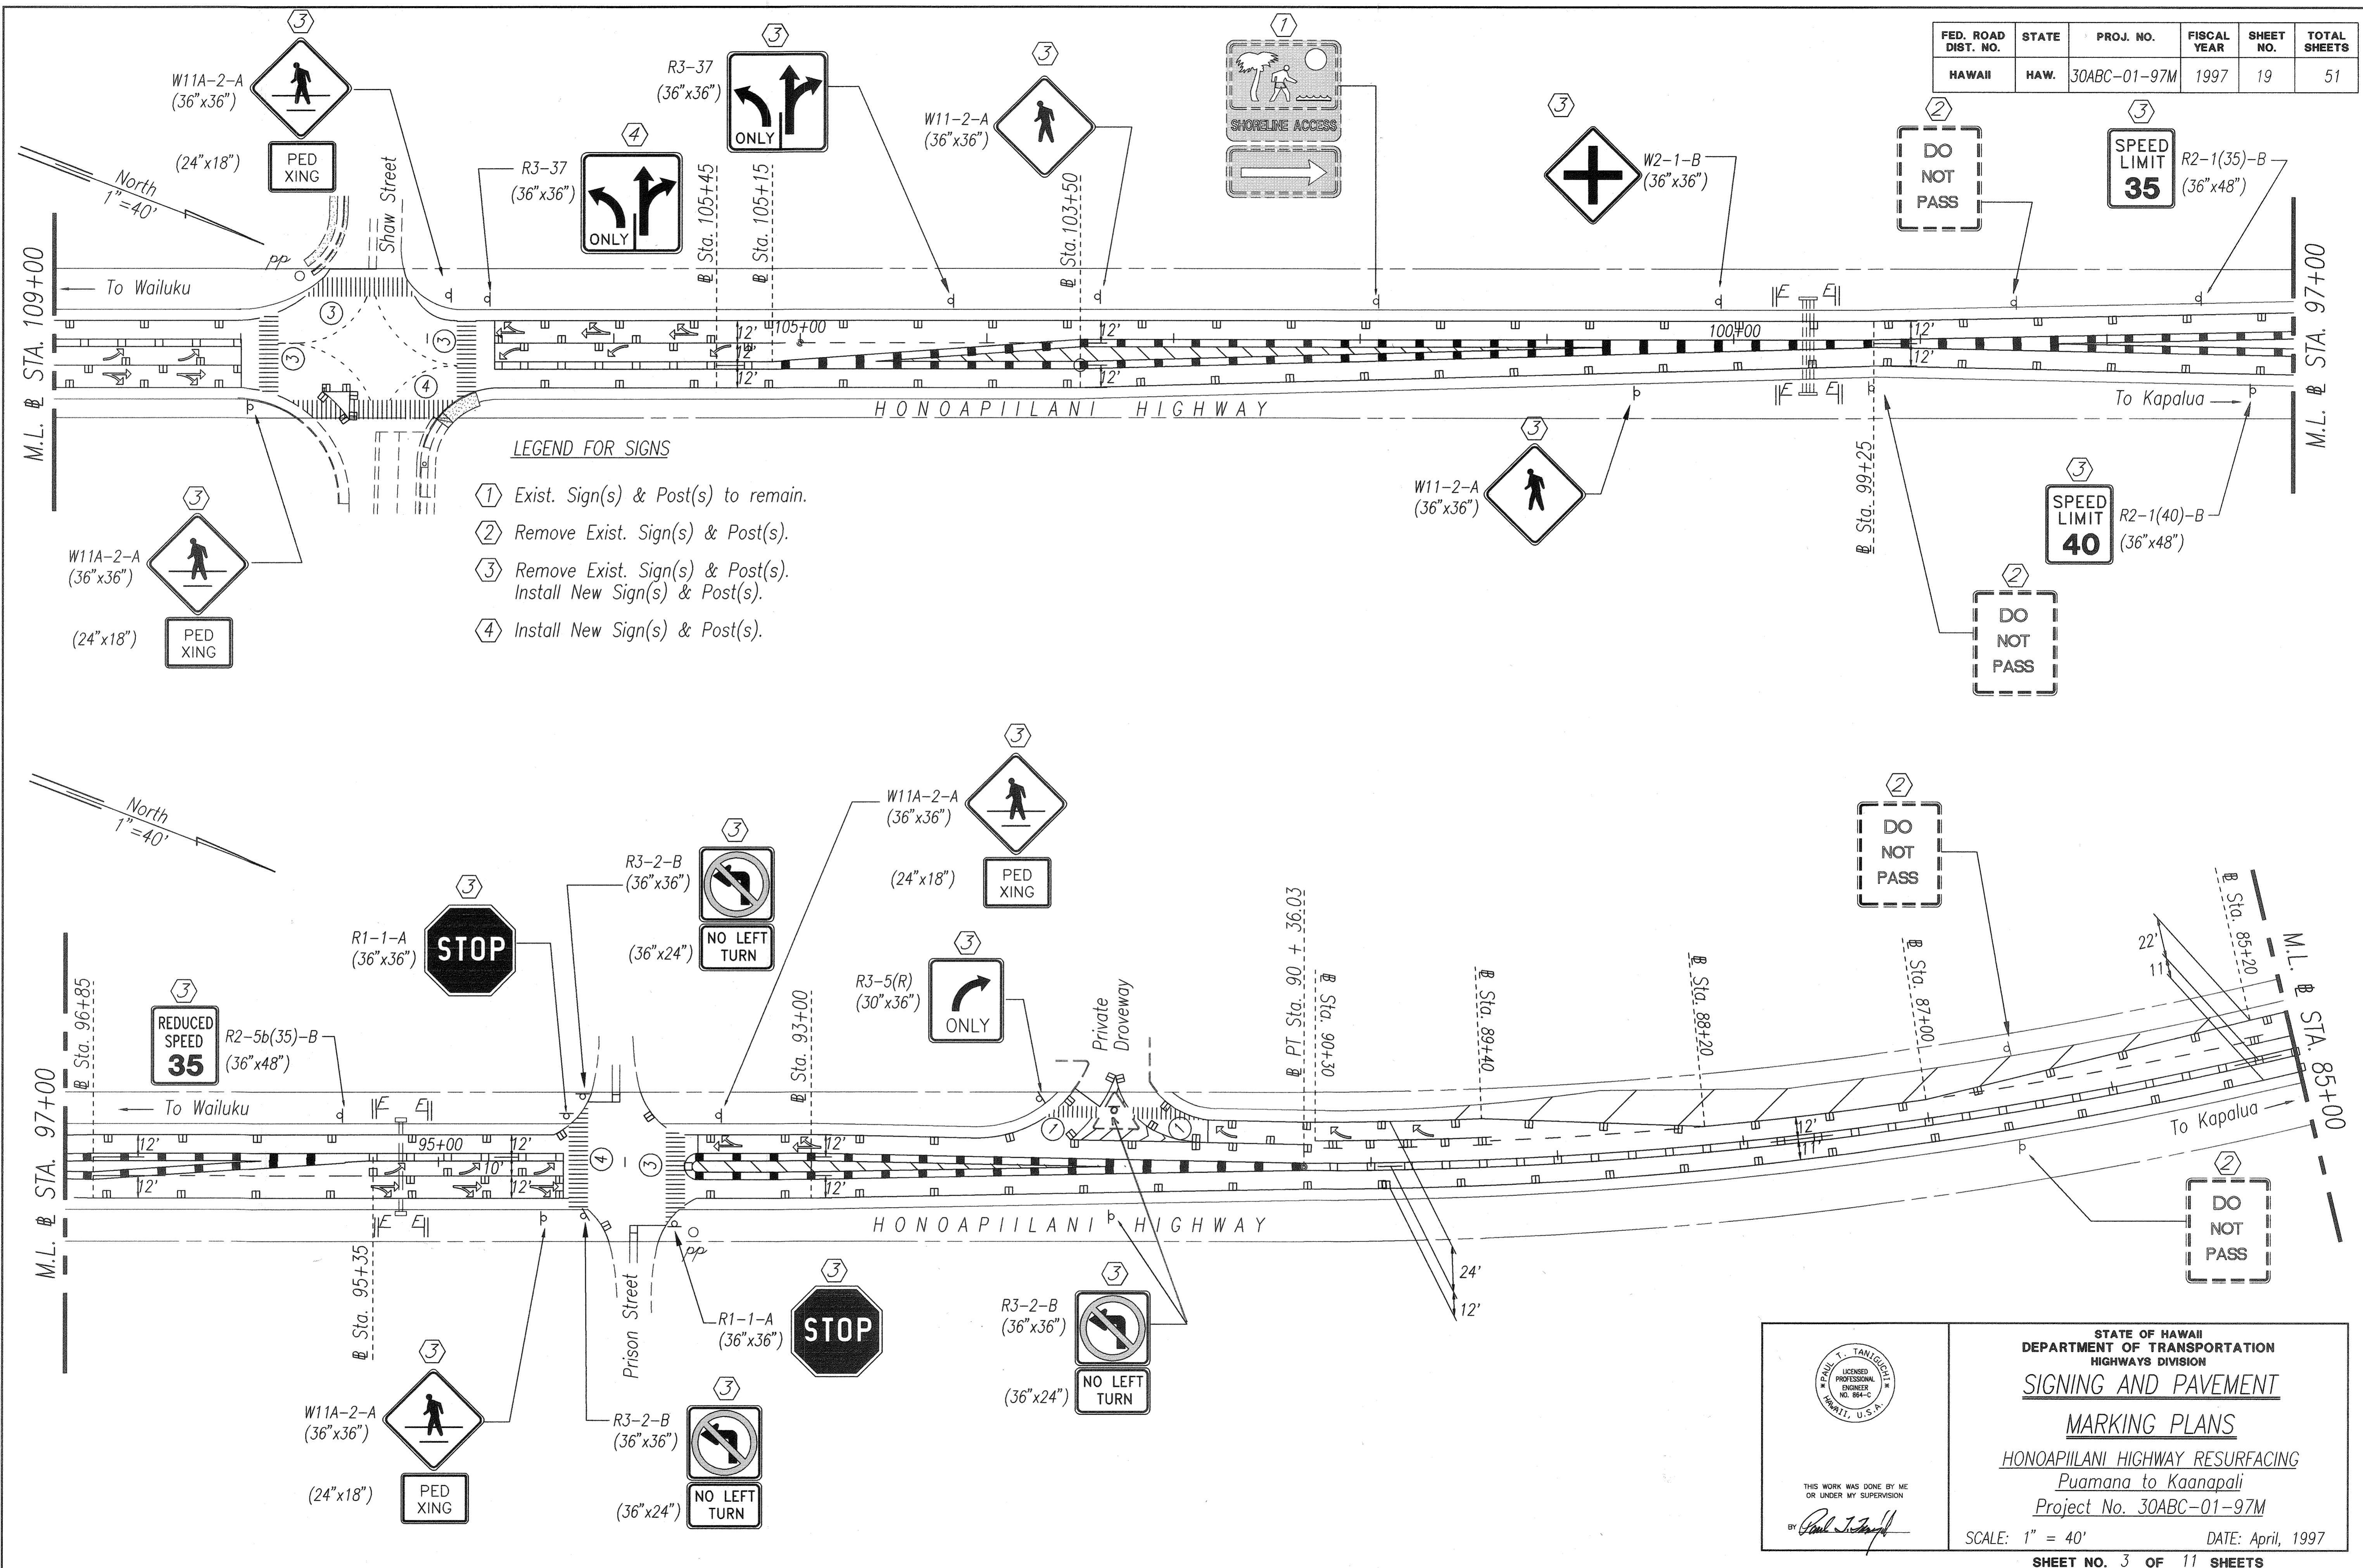

SURVEY PLOTTED BY	DATE
DRAWN BY	
TRACED BY	
QUANTITIES BY	
CHECKED BY	
ORIGINAL PLAN NO.	
NOTE BOOK NO.	

THIS WORK WAS DONE BY ME OR UNDER MY SUPERVISION

Paul T. Taniguchi

STATE OF HAWAII
DEPARTMENT OF TRANSPORTATION
HIGHWAYS DIVISION

SIGNING AND PAVEMENT


MARKING PLANS

HONOAPIILANI HIGHWAY RESURFACING
Puamana to Kaanapali
Project No. 30ABC-01-97M

SCALE: 1" = 40' DATE: April, 1997

SHEET NO. 3 OF 11 SHEETS

FED. ROAD DIST. NO.	STATE	PROJ. NO.	FISCAL YEAR	SHEET NO.	TOTAL SHEETS
HAWAII	HAW.	30ABC-01-97M	1997	19	51

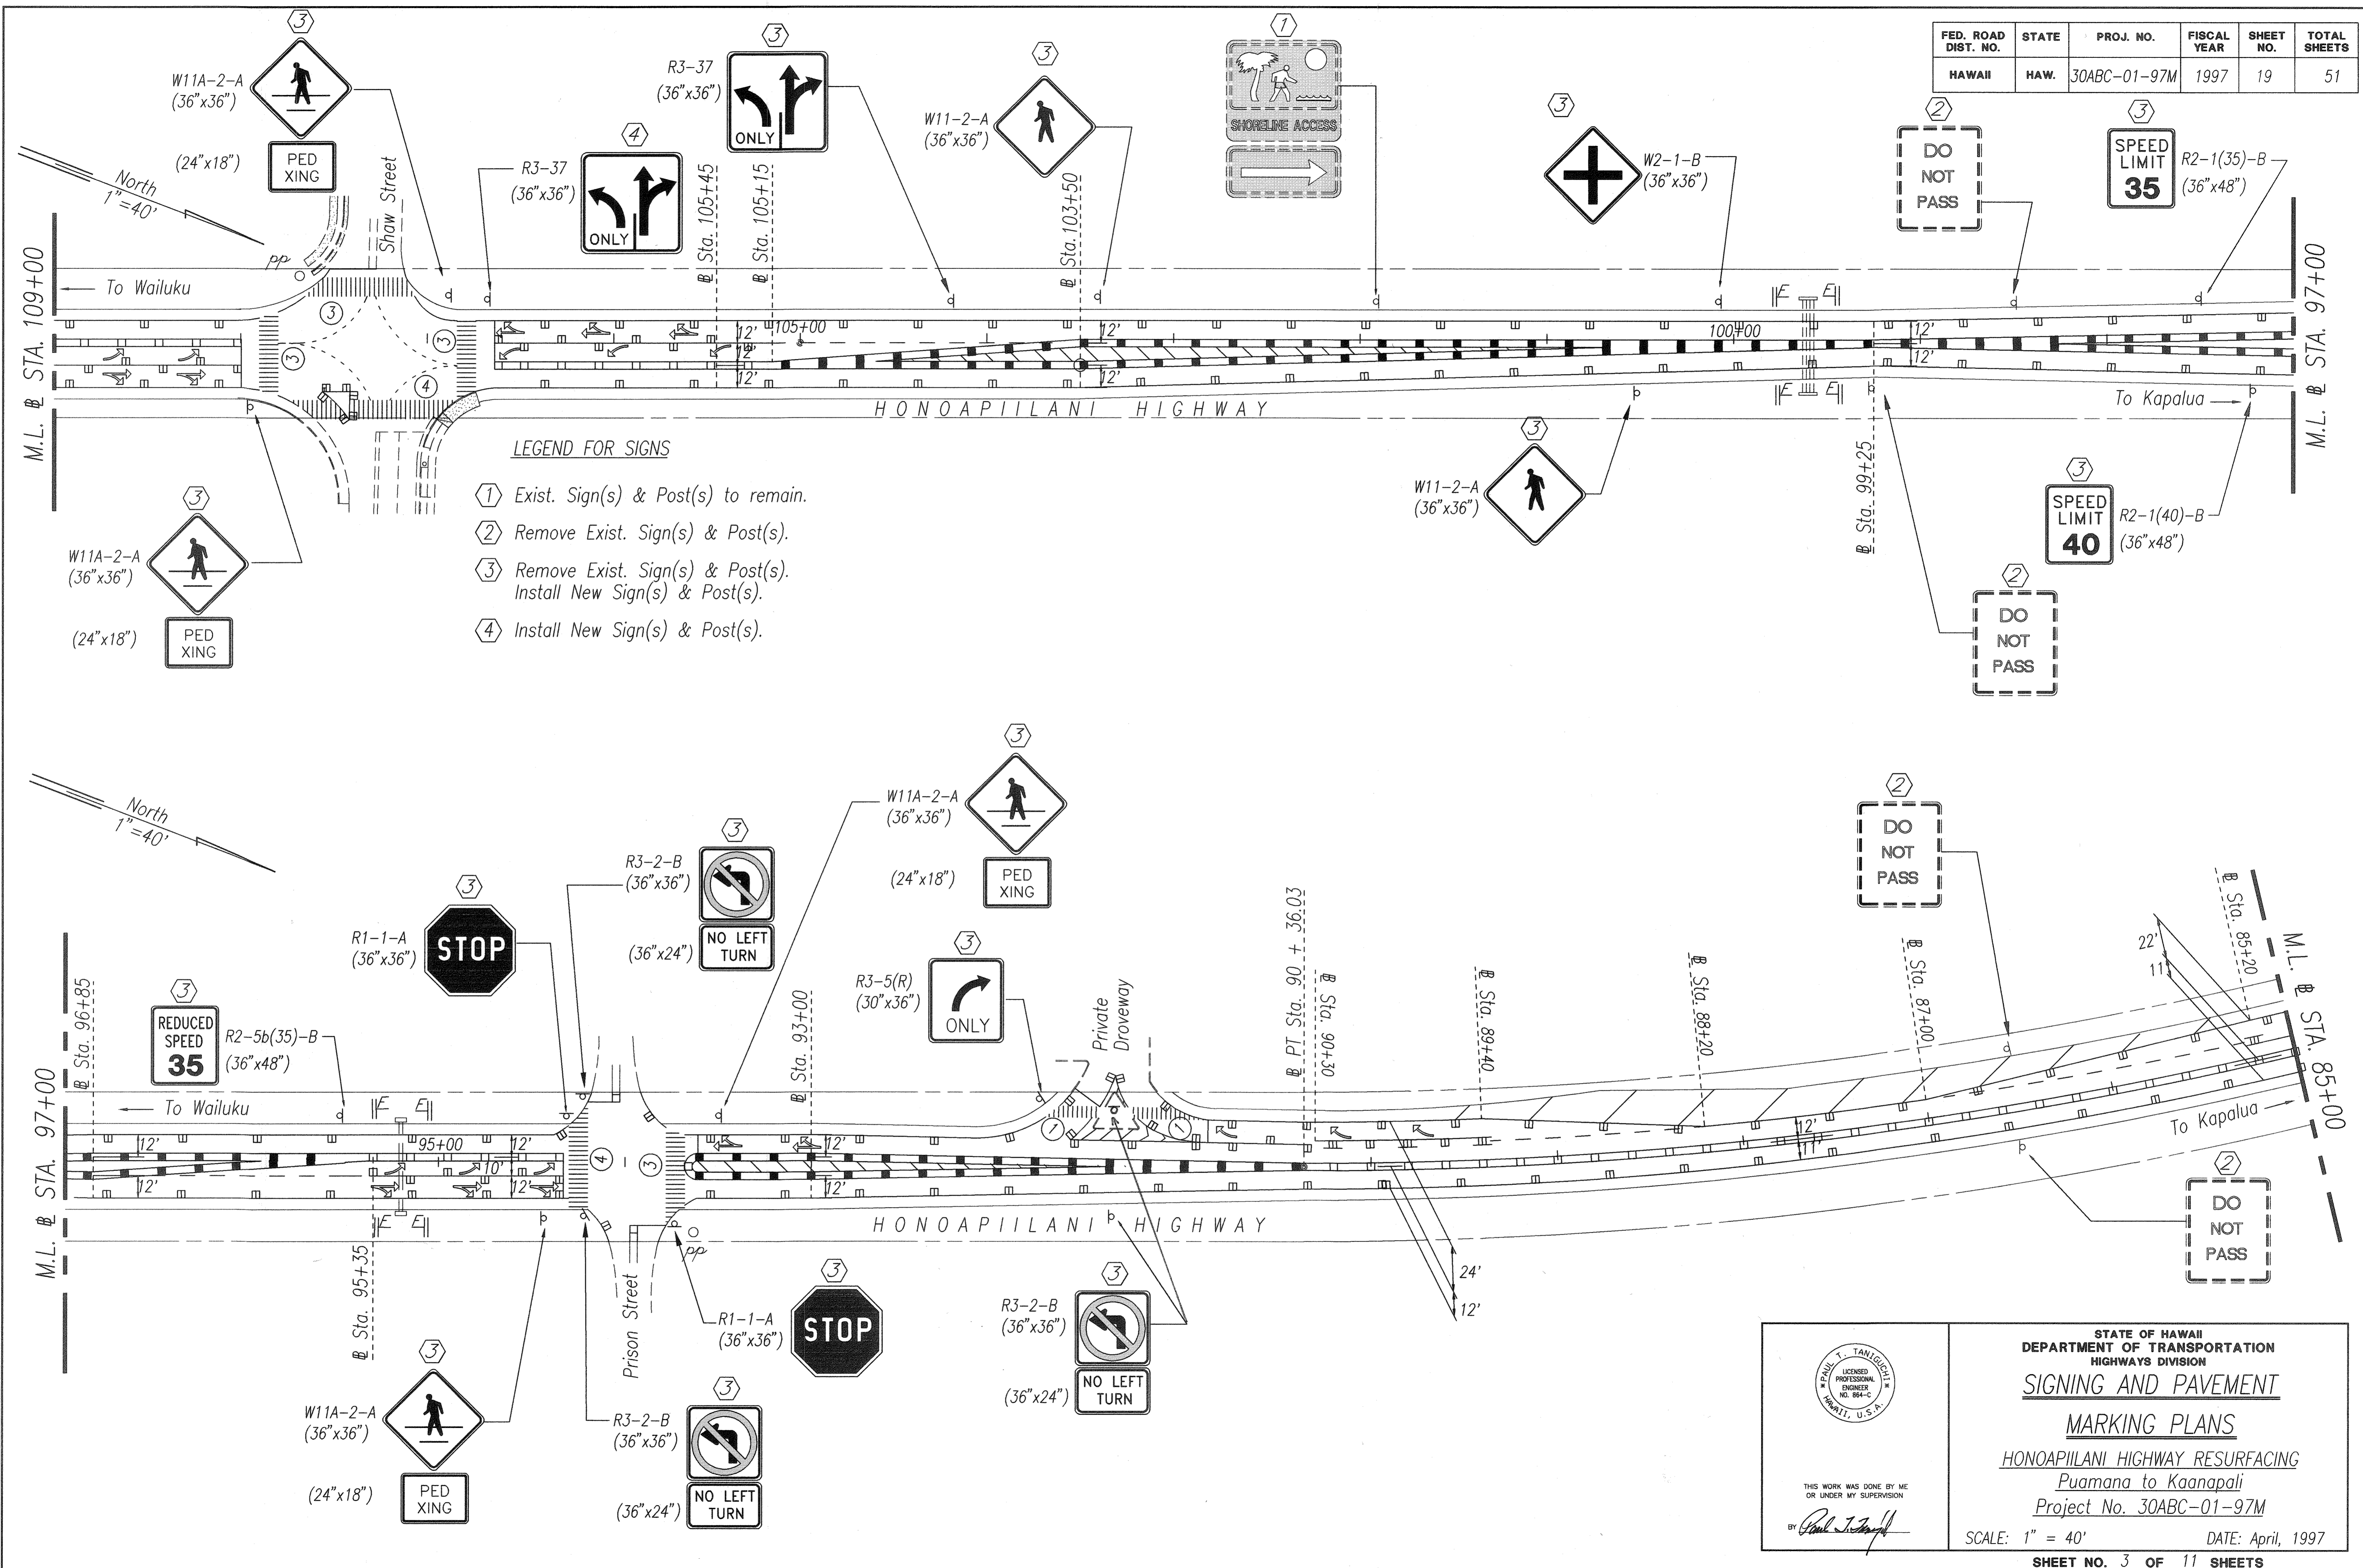

SURVEY PLOTTED BY	DATE
DRAWN BY	
TRACED BY	
QUANTITIES BY	
CHECKED BY	
ORIGINAL PLAN	
NOTE BOOK	
NO.	

THIS WORK WAS DONE BY ME OR UNDER MY SUPERVISION

Paul T. Taniguchi

STATE OF HAWAII
DEPARTMENT OF TRANSPORTATION
HIGHWAYS DIVISION

SIGNING AND PAVEMENT


MARKING PLANS

HONOAPIILANI HIGHWAY RESURFACING
Puamana to Kaanapali
Project No. 30ABC-01-97M

SCALE: 1" = 40' DATE: April, 1997


SHEET NO. 3 OF 11 SHEETS

FED. ROAD DIST. NO.	STATE	PROJ. NO.	FISCAL YEAR	SHEET NO.	TOTAL SHEETS
HAWAII	HAW.	30ABC-01-97M	1997	20	51

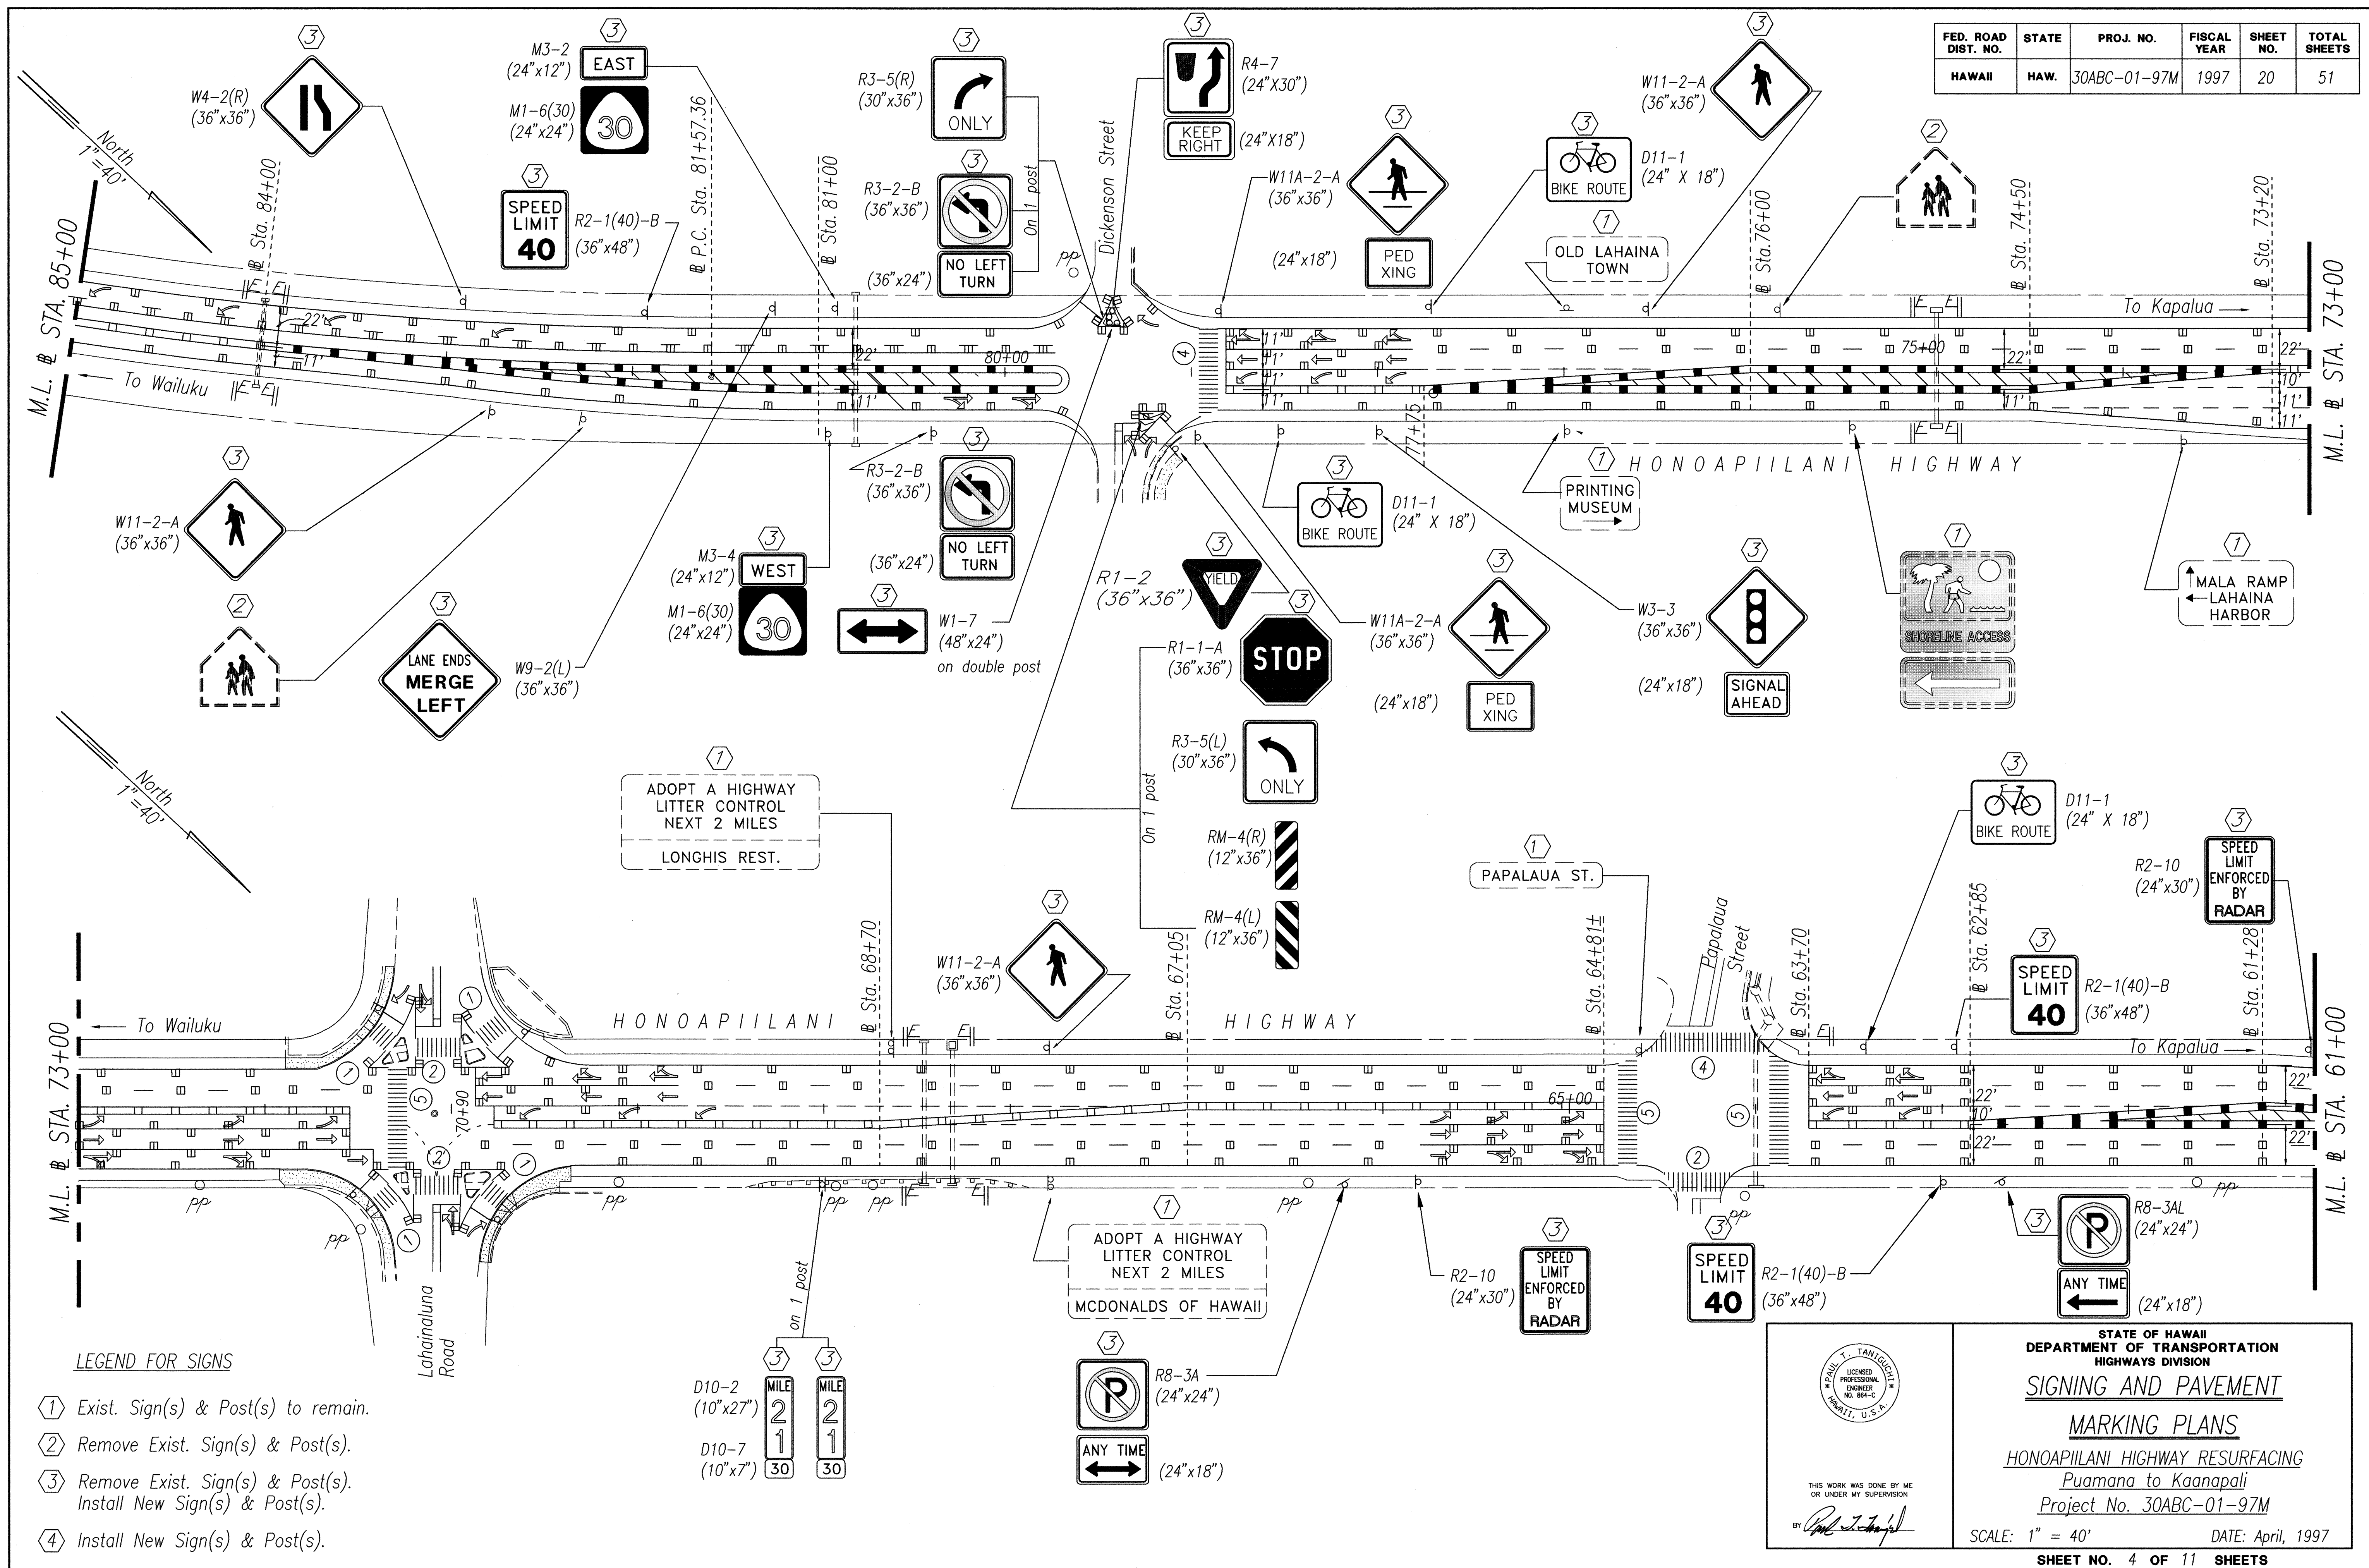

LEGEND FOR SIGNS

- ① Exist. Sign(s) & Post(s) to remain.
- ② Remove Exist. Sign(s) & Post(s).
- ③ Remove Exist. Sign(s) & Post(s). Install New Sign(s) & Post(s).
- ④ Install New Sign(s) & Post(s).

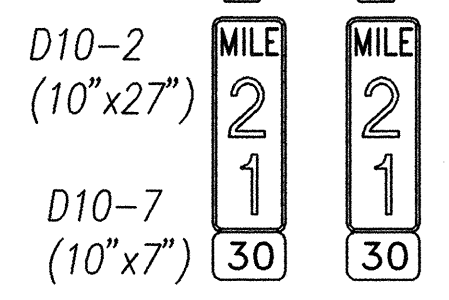


SURVEY PLOTTED BY	DATE
DESIGNED BY	
TRACED BY	
NOTE BOOK	
DESIGNED BY	
QUANTITIES BY	
CHECKED BY	
NO.	

THIS WORK WAS DONE BY ME OR UNDER MY SUPERVISION


STATE OF HAWAII
 DEPARTMENT OF TRANSPORTATION
 HIGHWAYS DIVISION
SIGNING AND PAVEMENT MARKING PLANS
 HONOAPIILANI HIGHWAY RESURFACING
 Puamana to Kaanapali
 Project No. 30ABC-01-97M
 SCALE: 1" = 40' DATE: April, 1997
 SHEET NO. 4 OF 11 SHEETS

FED. ROAD DIST. NO.	STATE	PROJ. NO.	FISCAL YEAR	SHEET NO.	TOTAL SHEETS
HAWAII	HAW.	30ABC-01-97M	1997	21	51

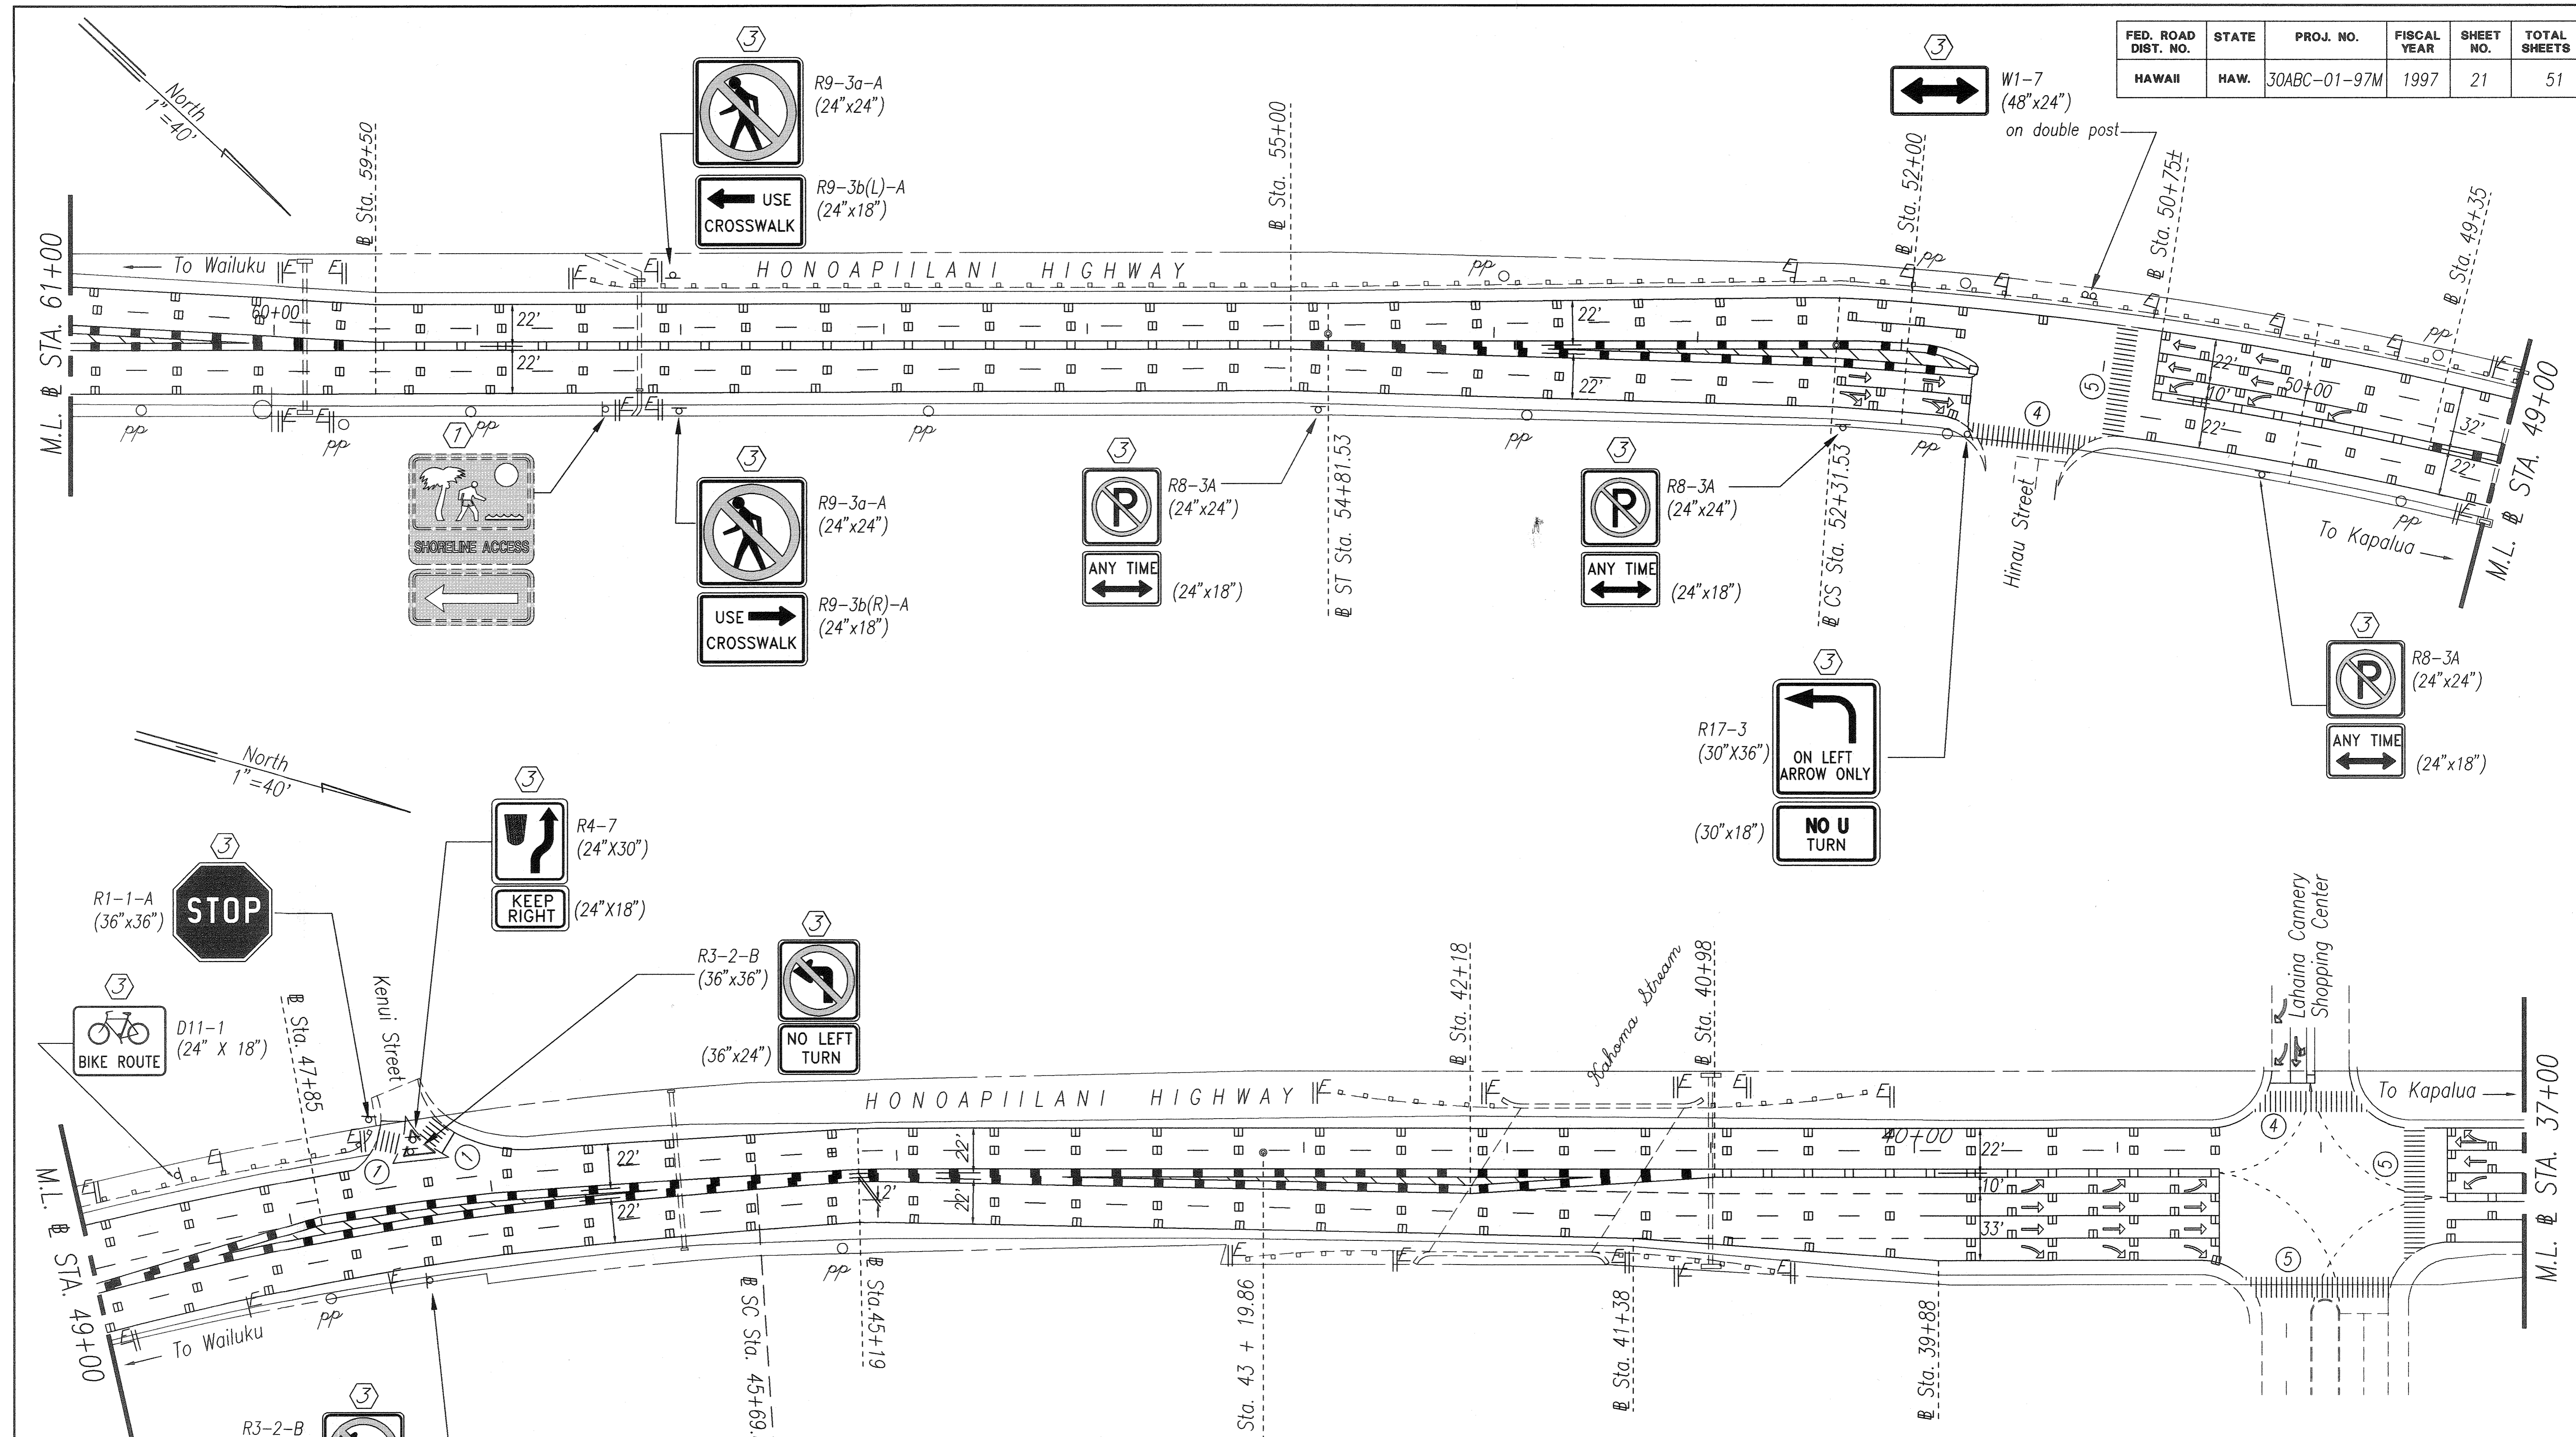

LEGEND FOR SIGNS

- ① Exist. Sign(s) & Post(s) to remain.
- ② Remove Exist. Sign(s) & Post(s).
- ③ Remove Exist. Sign(s) & Post(s). Install New Sign(s) & Post(s).
- ④ Install New Sign(s) & Post(s).

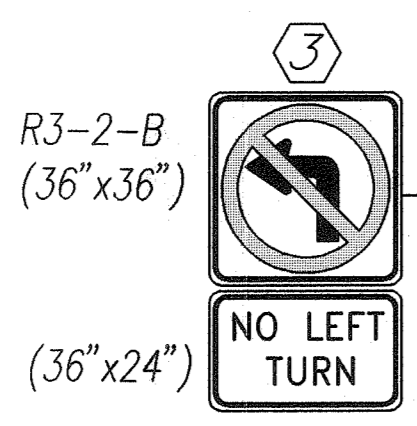

SURVEY PLOTTED BY	DATE
DRAWN BY	
DESIGNED BY	
QUANTITIES BY	
CHECKED BY	
ORIGINAL PLAN NO.	
NOTE BOOK NO.	


STATE OF HAWAII
 DEPARTMENT OF TRANSPORTATION
 HIGHWAYS DIVISION
SIGNING AND PAVEMENT MARKING PLANS
 HONOAPIILANI HIGHWAY RESURFACING
 Puamana to Kaanapali
 Project No. 30ABC-01-97M
 SCALE: 1" = 40' DATE: April, 1997
 SHEET NO. 5 OF 11 SHEETS



THIS WORK WAS DONE BY ME OR UNDER MY SUPERVISION
 BY Paul J. Tamiguchi

"AS-BUILT"


FED. ROAD DIST. NO.	STATE	PROJ. NO.	FISCAL YEAR	SHEET NO.	TOTAL SHEETS
HAWAII	HAW.	30ABC-01-97M	1997	22	51

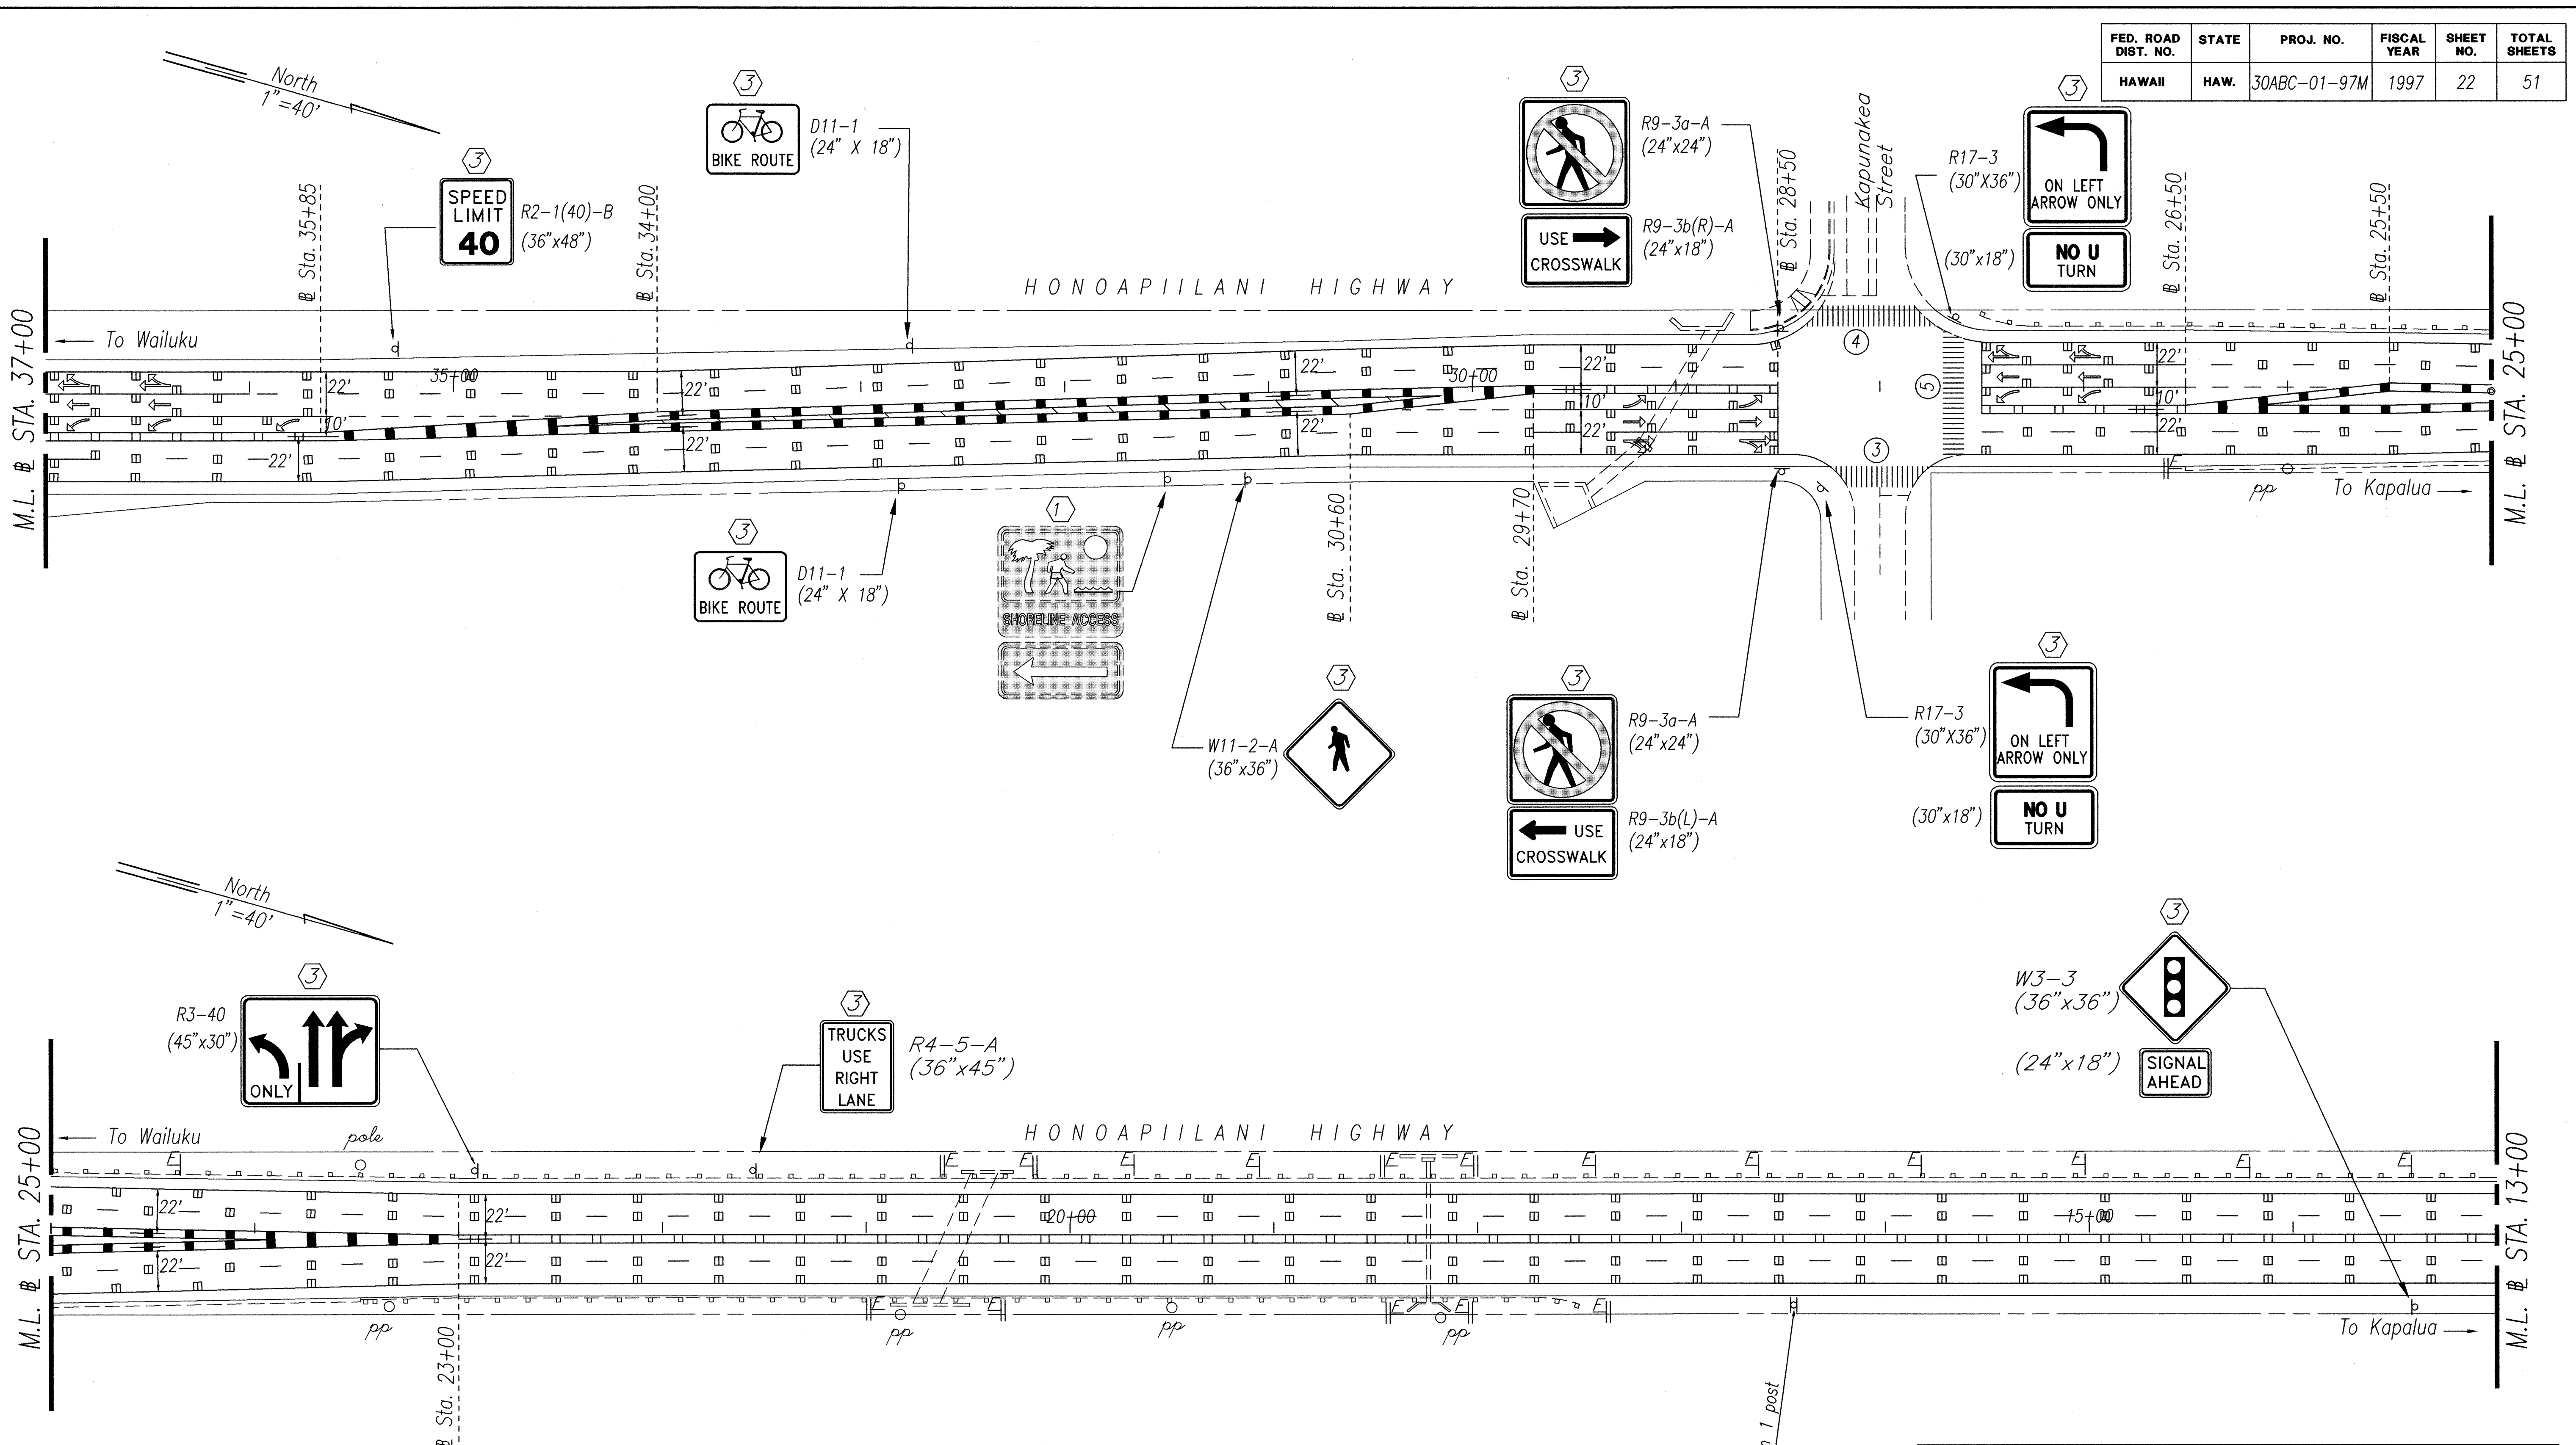


ORIGINAL PLAN	DATE
SURVEY PLOTTED BY	
DESIGNED BY	
QUANTITIES BY	
CHECKED BY	
NO.	

LEGEND FOR SIGNS


- ① Exist. Sign(s) & Post(s) to remain.
- ② Remove Exist. Sign(s) & Post(s).
- ③ Remove Exist. Sign(s) & Post(s). Install New Sign(s) & Post(s).
- ④ Install New Sign(s) & Post(s).

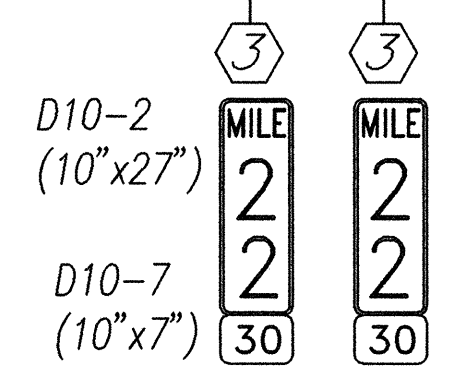

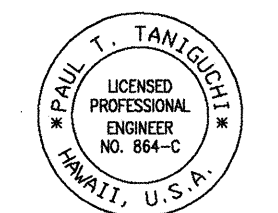
 THIS WORK WAS DONE BY ME OR UNDER MY SUPERVISION
 BY *Paul L. Taniguchi*


STATE OF HAWAII
 DEPARTMENT OF TRANSPORTATION
 HIGHWAYS DIVISION
SIGNING AND PAVEMENT
MARKING PLANS
 HONOAPIILANI HIGHWAY RESURFACING
 Puamana to Kaanapali
 Project No. 30ABC-01-97M
 SCALE: 1" = 40' DATE: April, 1997
 SHEET NO. 6 OF 11 SHEETS

FED. ROAD DIST. NO.	STATE	PROJ. NO.	FISCAL YEAR	SHEET NO.	TOTAL SHEETS
HAWAII	HAW.	30ABC-01-97M	1997	23	51

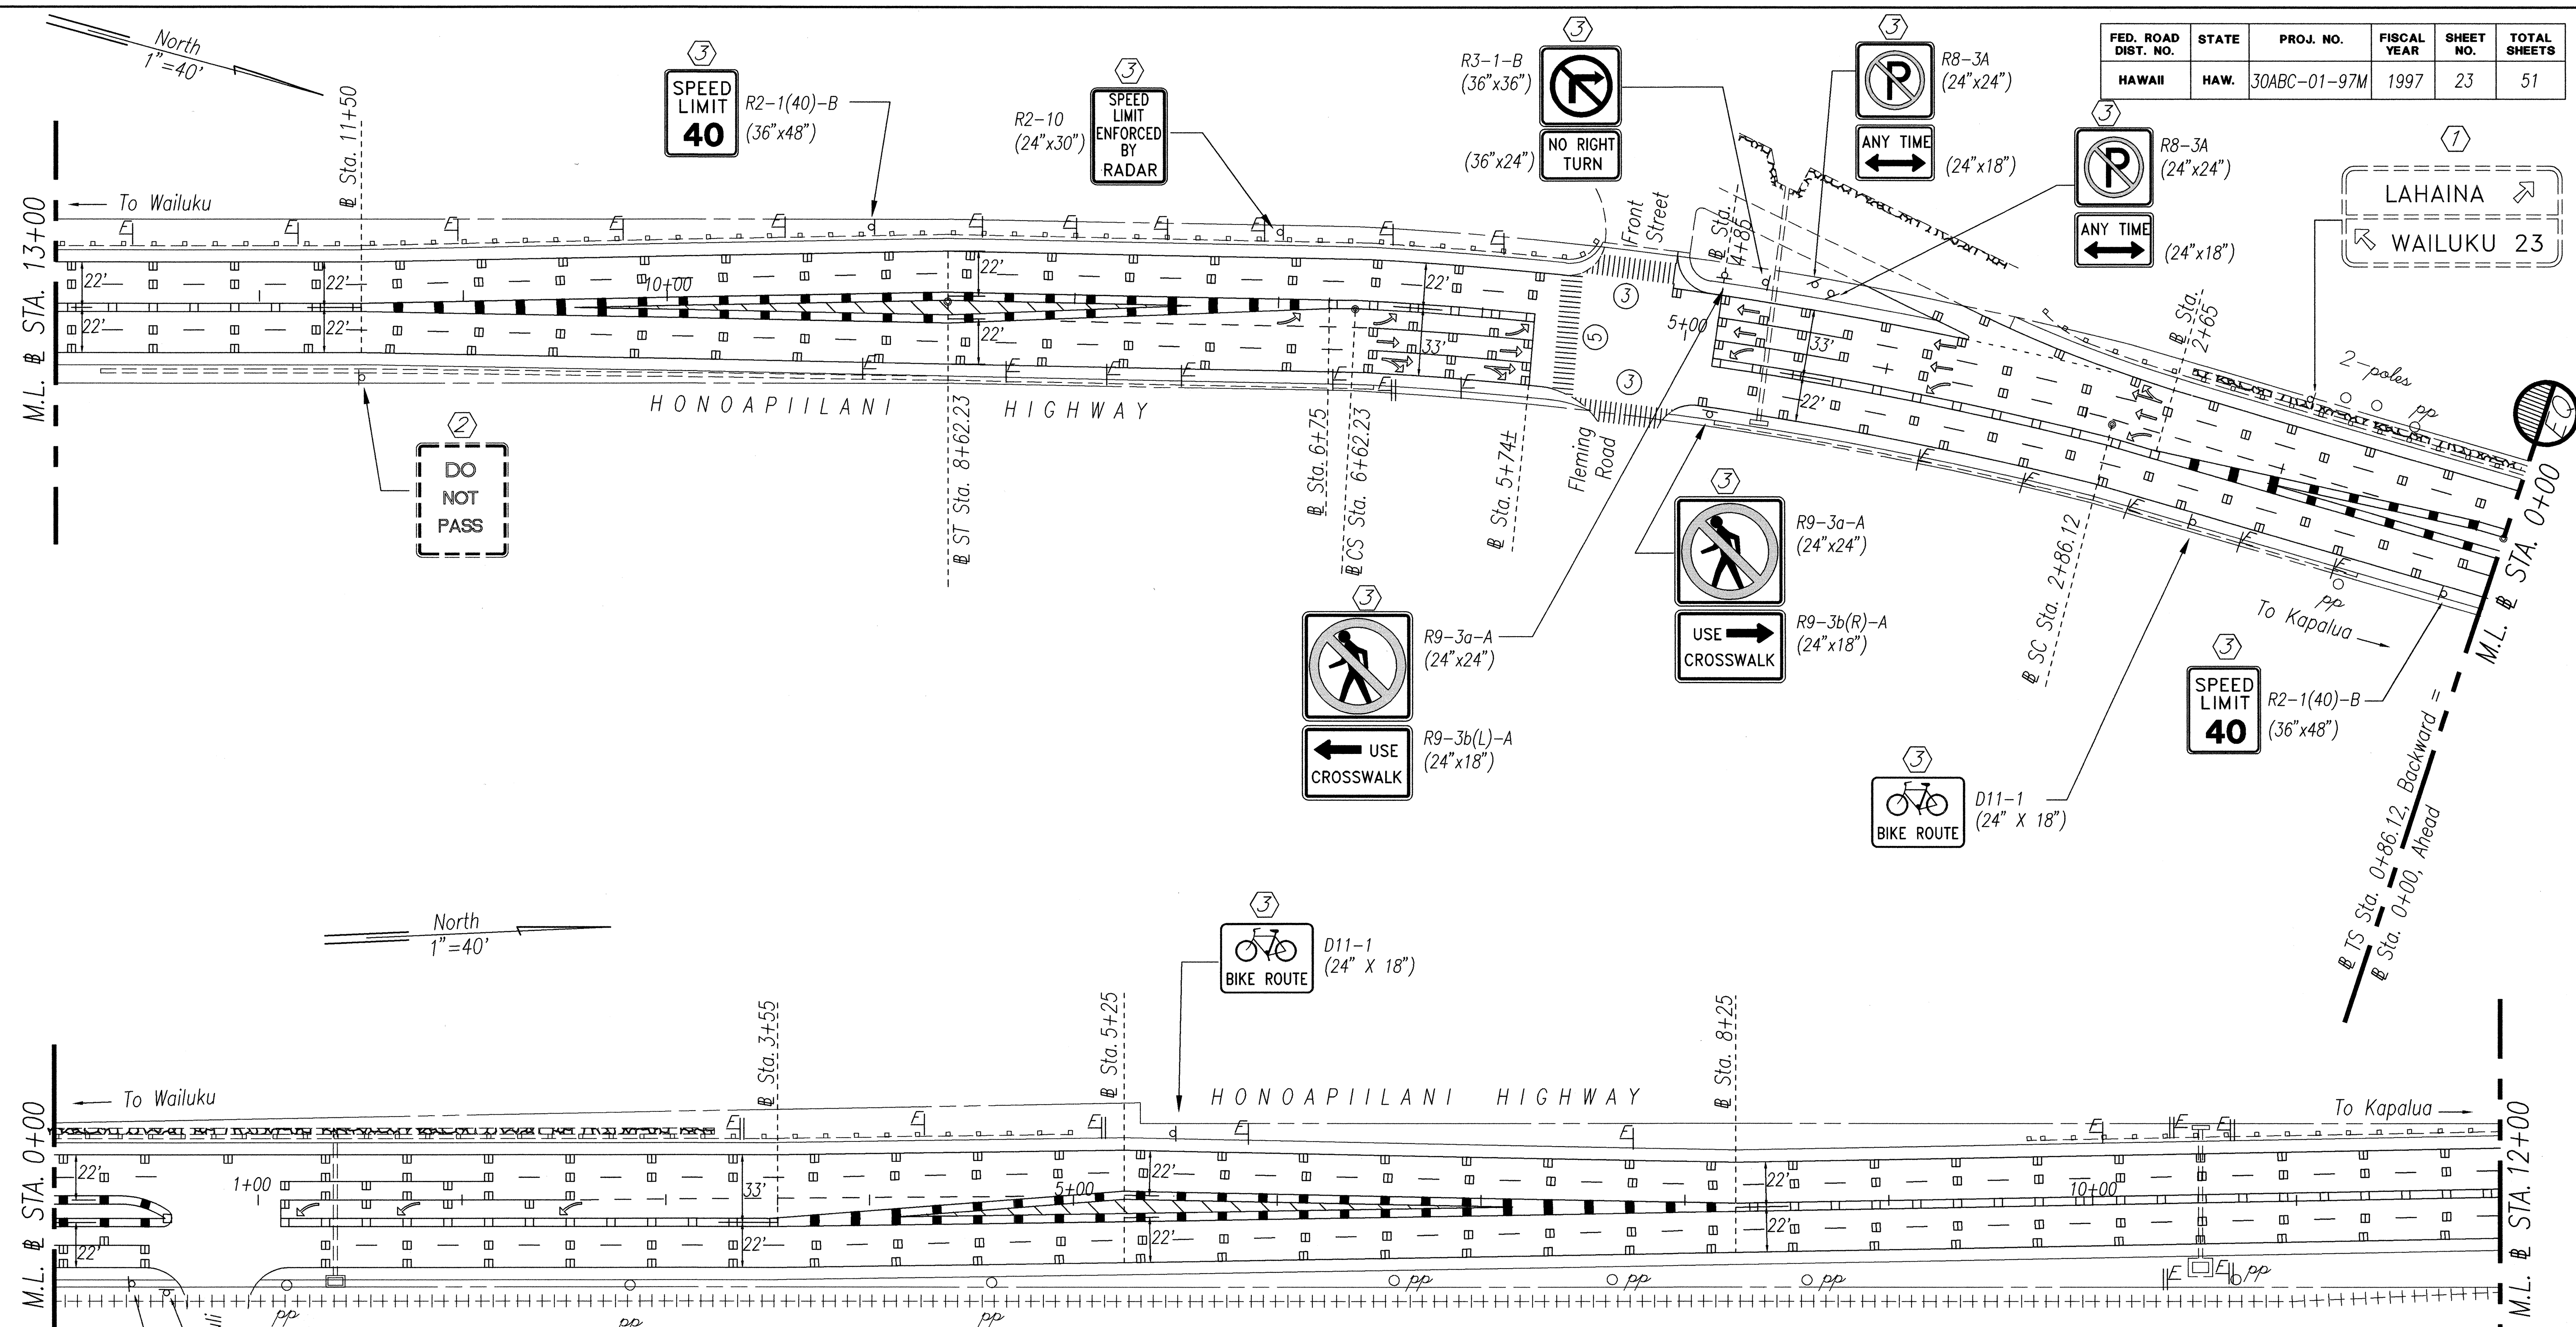

North
1"=40'

ORIGINAL PLAN NO. _____
 SURVEY PLOTTED BY _____ DATE _____
 DESIGNED BY _____
 CHECKED BY _____

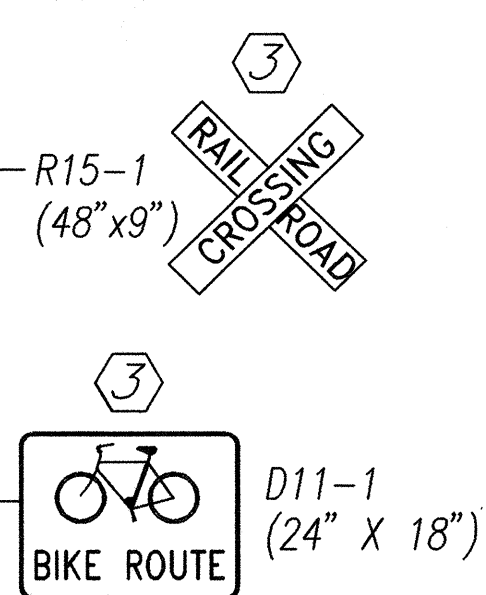


- LEGEND FOR SIGNS**
- ① Exist. Sign(s) & Post(s) to remain.
 - ② Remove Exist. Sign(s) & Post(s).
 - ③ Remove Exist. Sign(s) & Post(s). Install New Sign(s) & Post(s).
 - ④ Install New Sign(s) & Post(s).

THIS WORK WAS DONE BY ME OR UNDER MY SUPERVISION
Paul J. Smith

STATE OF HAWAII
 DEPARTMENT OF TRANSPORTATION
 HIGHWAYS DIVISION
SIGNING AND PAVEMENT
MARKING PLANS
 HONOAPIILANI HIGHWAY RESURFACING
 Puamana to Kaanapali
 Project No. 30ABC-01-97M
 SCALE: 1" = 40' DATE: April, 1997
 SHEET NO. 7 OF 11 SHEETS

FED. ROAD DIST. NO.	STATE	PROJ. NO.	FISCAL YEAR	SHEET NO.	TOTAL SHEETS
HAWAII	HAW.	30ABC-01-97M	1997	24	51

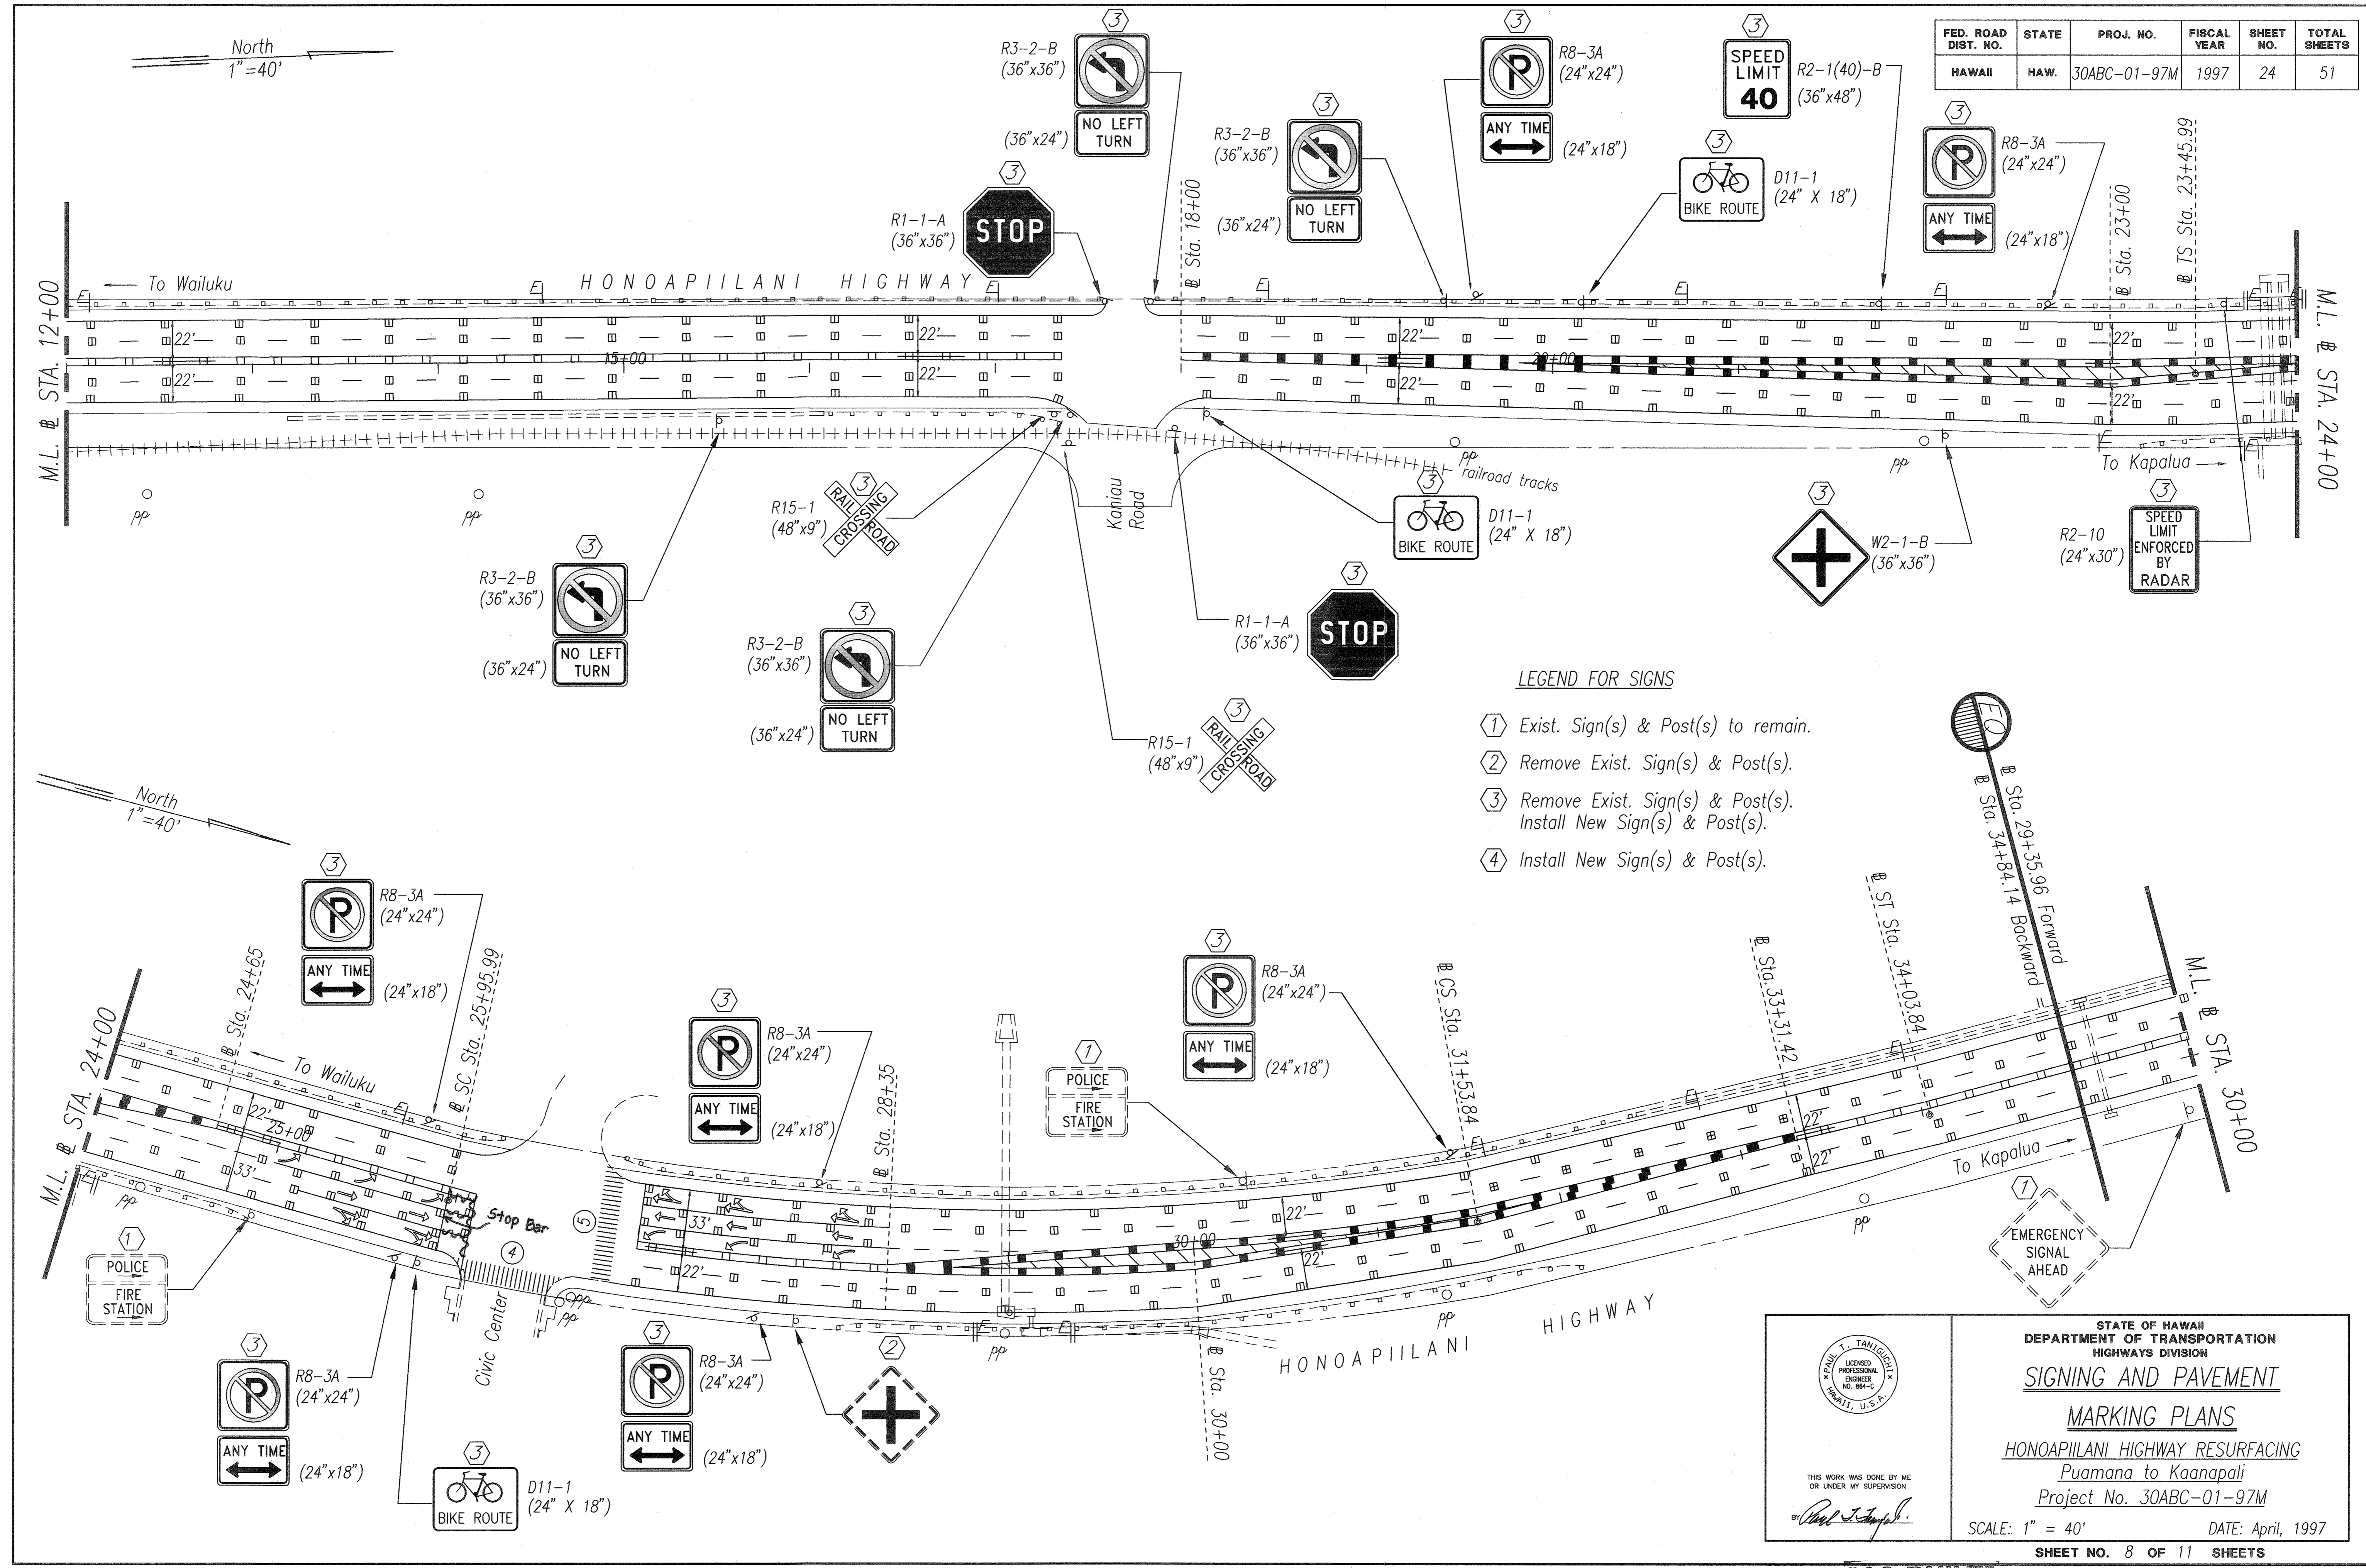

SURVEY PLOTTED BY	DATE
DRAWN BY	
DESIGNED BY	
QUANTITIES BY	
CHECKED BY	
ORIGINAL PLAN	
NOTE BOOK	
NO.	

THIS WORK WAS DONE BY ME OR UNDER MY SUPERVISION

Paul J. Campbell

STATE OF HAWAII
DEPARTMENT OF TRANSPORTATION
HIGHWAYS DIVISION

SIGNING AND PAVEMENT


MARKING PLANS

HONOAPIILANI HIGHWAY RESURFACING
Puamana to Kaanapali
Project No. 30ABC-01-97M

SCALE: 1" = 40' DATE: April, 1997

SHEET NO. 8 OF 11 SHEETS


FED. ROAD DIST. NO.	STATE	PROJ. NO.	FISCAL YEAR	SHEET NO.	TOTAL SHEETS
HAWAII	HAW.	30ABC-01-97M	1997	25	51

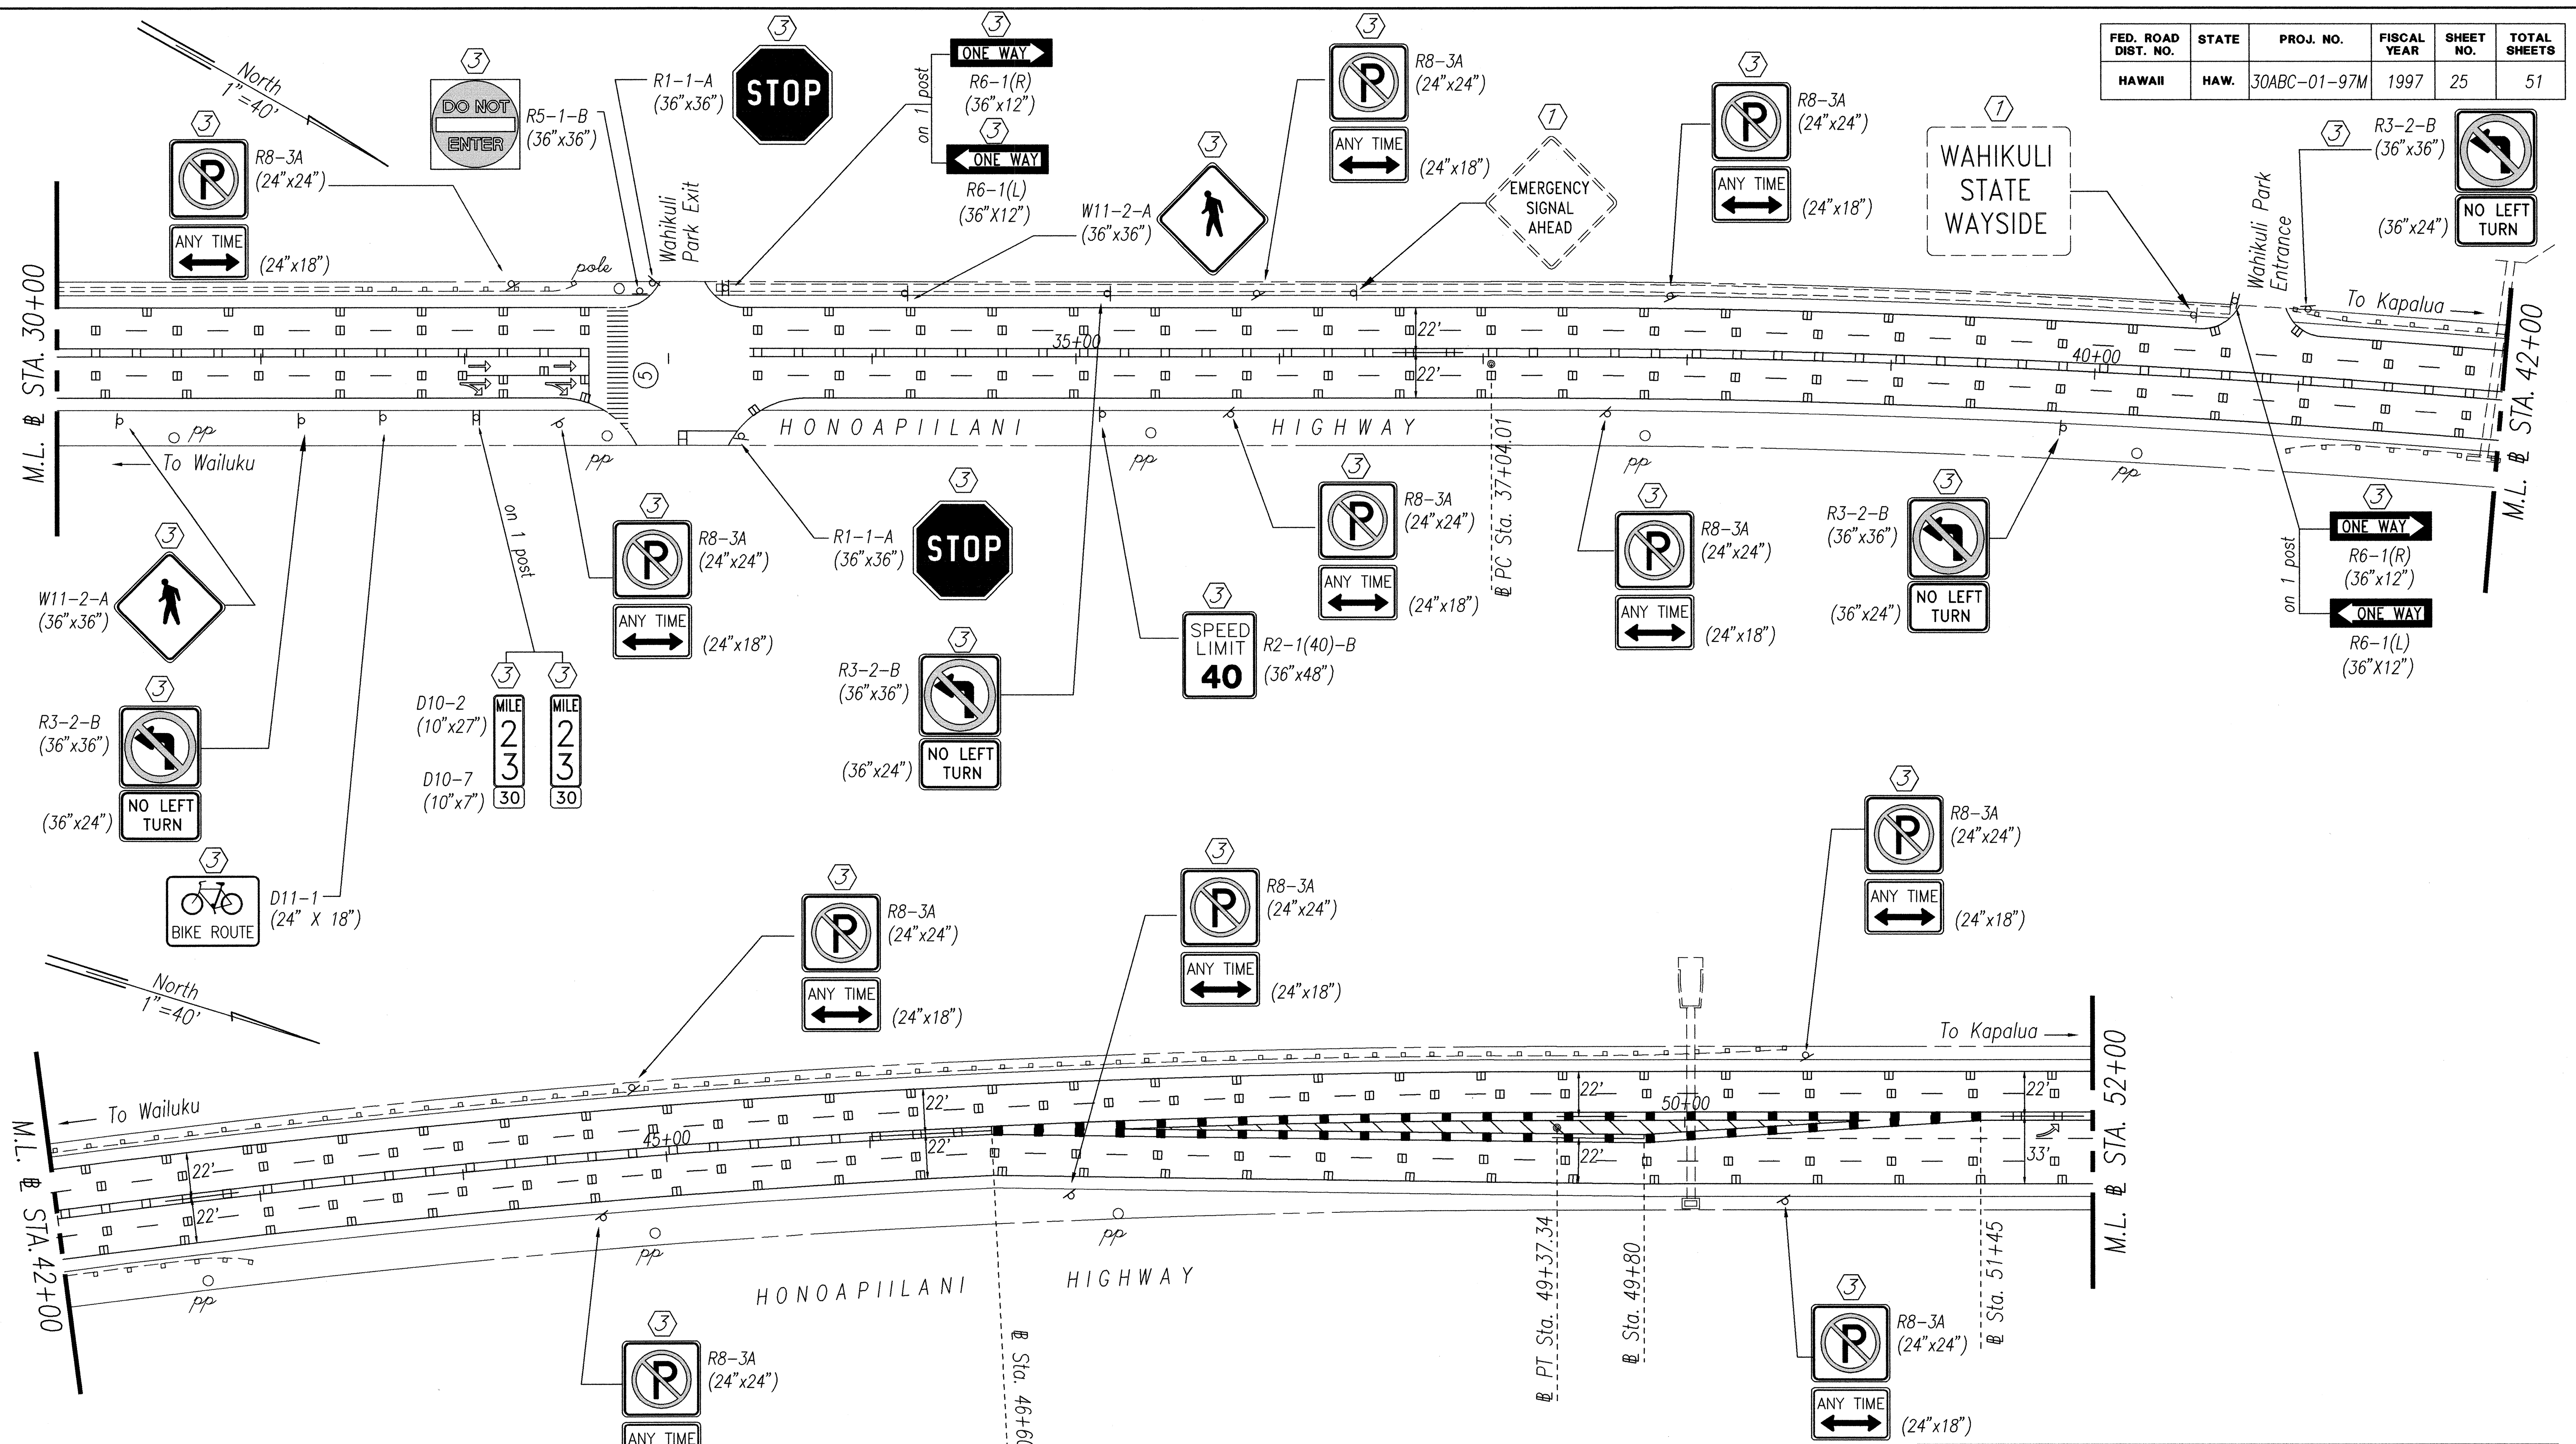

LEGEND FOR SIGNS


- ① Exist. Sign(s) & Post(s) to remain.
- ② Remove Exist. Sign(s) & Post(s).
- ③ Remove Exist. Sign(s) & Post(s).
Install New Sign(s) & Post(s).
- ④ Install New Sign(s) & Post(s).

SURVEY PLOTTED BY	DATE
DESIGNED BY	
TRACED BY	
NOTE BOOK	
QUANTITIES BY	
CHECKED BY	
NO.	

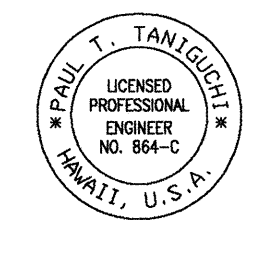
 THIS WORK WAS DONE BY ME
 OR UNDER MY SUPERVISION
 BY *Paul T. Taniguchi*


STATE OF HAWAII
 DEPARTMENT OF TRANSPORTATION
 HIGHWAYS DIVISION
SIGNING AND PAVEMENT
MARKING PLANS
 HONOAPIILANI HIGHWAY RESURFACING
 Puamana to Kaanapali
 Project No. 30ABC-01-97M
 SCALE: 1" = 40' DATE: April, 1997
 SHEET NO. 9 OF 11 SHEETS

FED. ROAD DIST. NO.	STATE	PROJ. NO.	FISCAL YEAR	SHEET NO.	TOTAL SHEETS
HAWAII	HAW.	30ABC-01-97M	1997	26	51

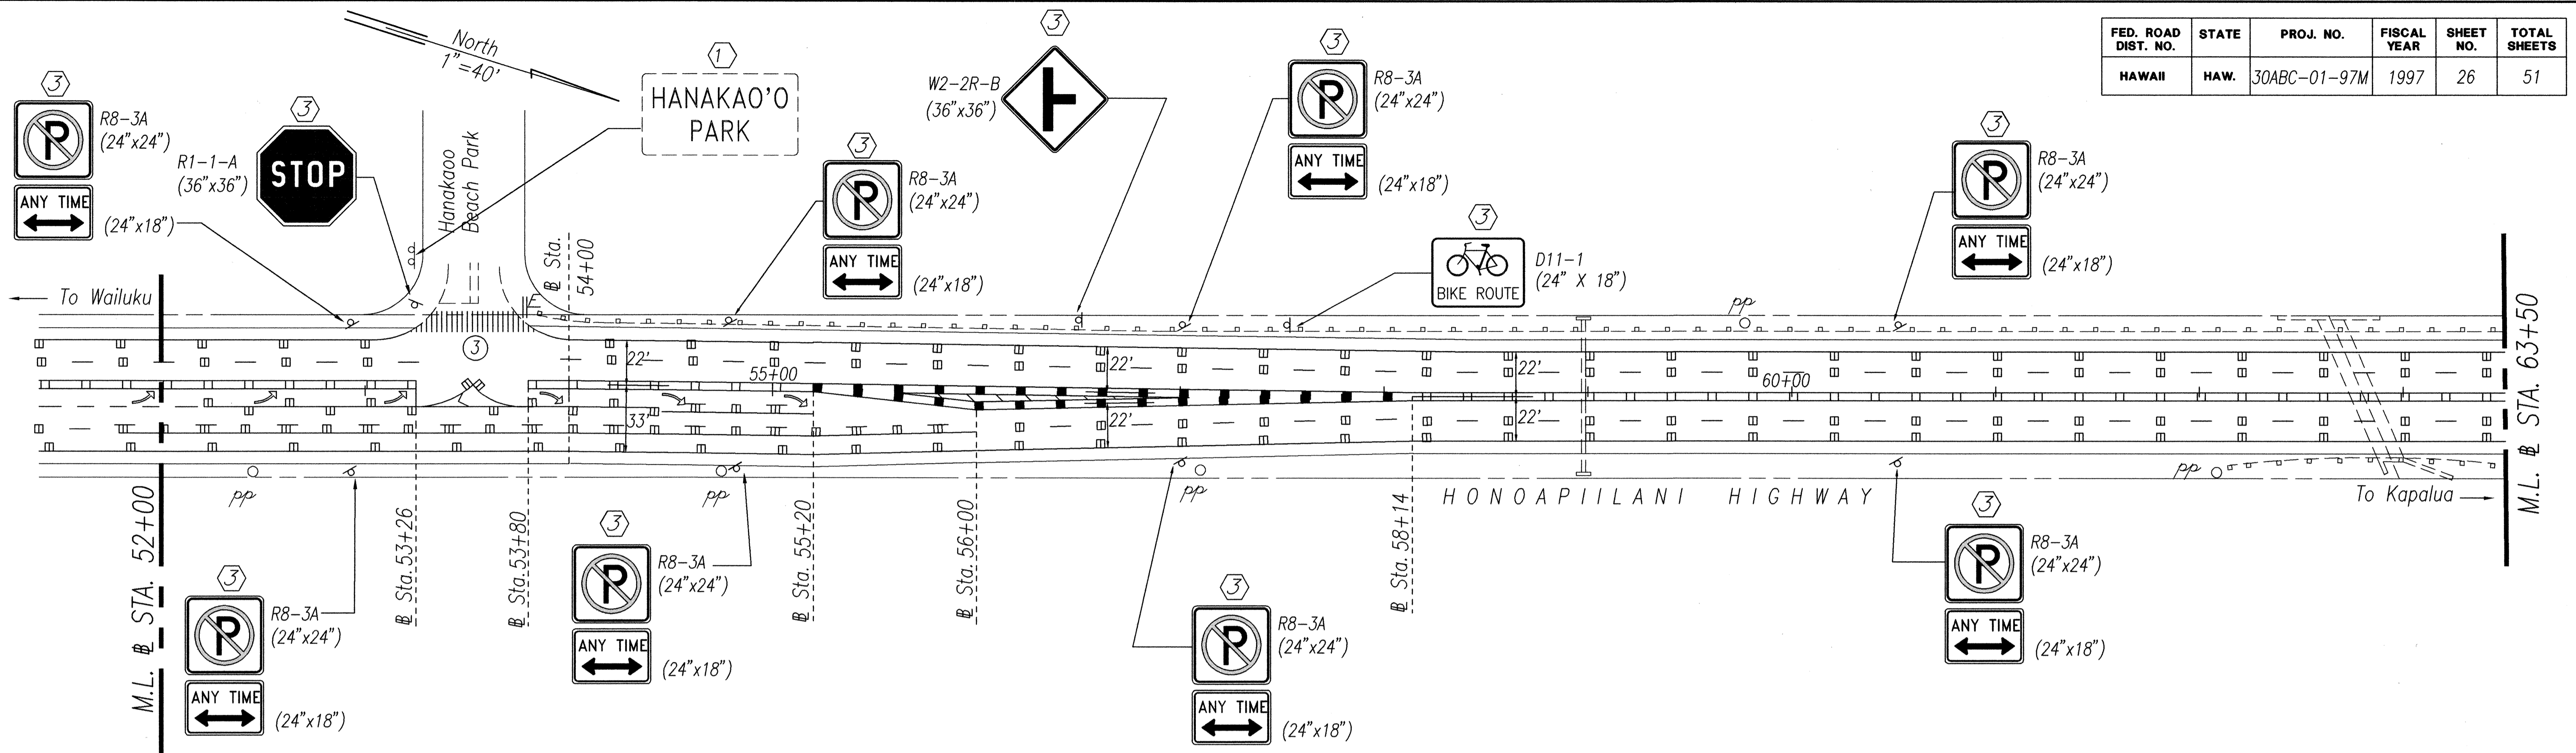

LEGEND FOR SIGNS

- ① Exist. Sign(s) & Post(s) to remain.
- ② Remove Exist. Sign(s) & Post(s).
- ③ Remove Exist. Sign(s) & Post(s).
Install New Sign(s) & Post(s).
- ④ Install New Sign(s) & Post(s).

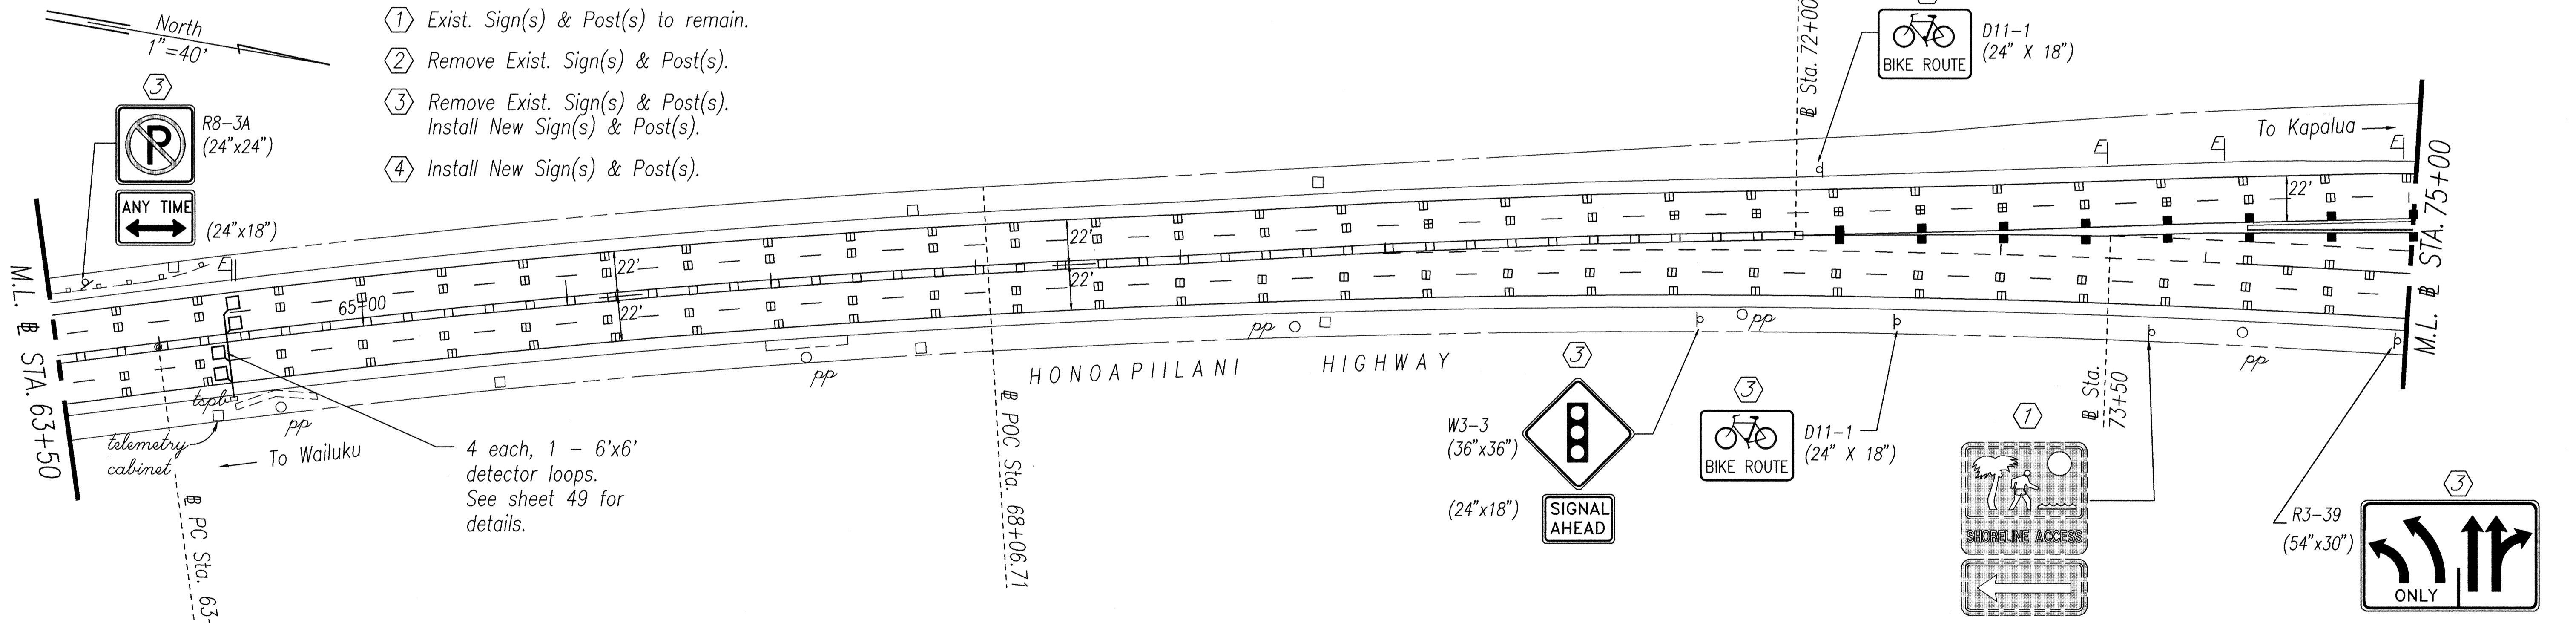

SURVEY PLOTTED BY	DATE
DESIGNED BY	
NOTED BY	
CHECKED BY	
ORIGINAL PLAN NO.	

THIS WORK WAS DONE BY ME OR UNDER MY SUPERVISION
BY *Paul T. Taniguchi*

STATE OF HAWAII
DEPARTMENT OF TRANSPORTATION
HIGHWAYS DIVISION

SIGNING AND PAVEMENT


MARKING PLANS

HONOAPILANI HIGHWAY RESURFACING
Puamana to Kaanapali
Project No. 30ABC-01-97M

SCALE: 1" = 40' DATE: April, 1997

SHEET NO. 10 OF 11 SHEETS

FED. ROAD DIST. NO.	STATE	PROJ. NO.	FISCAL YEAR	SHEET NO.	TOTAL SHEETS
HAWAII	HAW.	30ABC-01-97M	1997	27	51

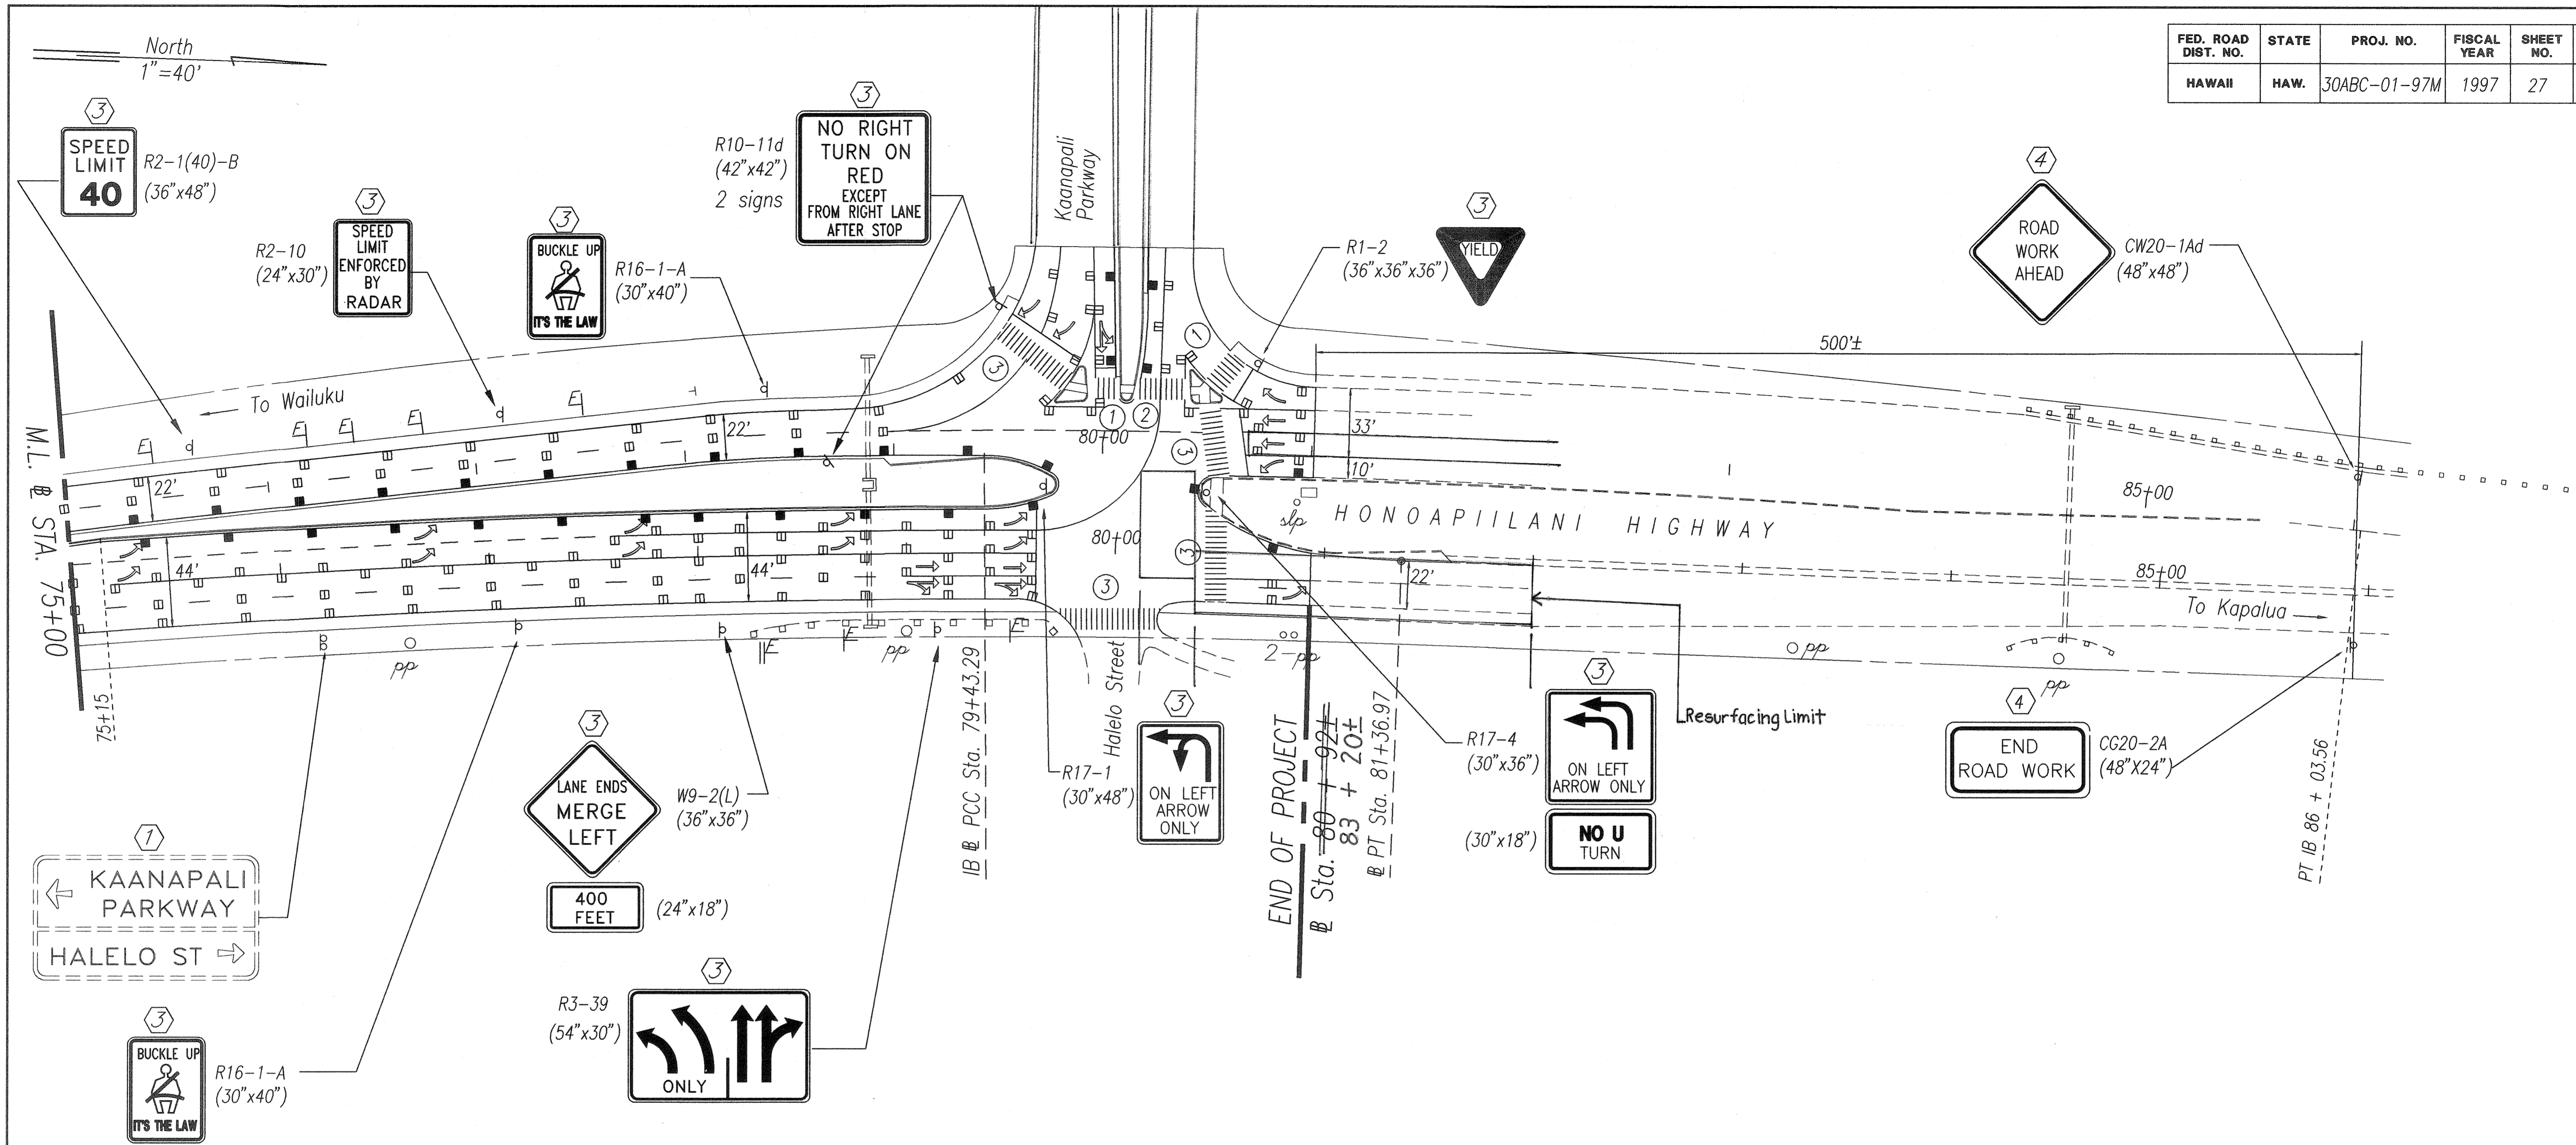

LEGEND FOR SIGNS

- ① Exist. Sign(s) & Post(s) to remain.
- ② Remove Exist. Sign(s) & Post(s).
- ③ Remove Exist. Sign(s) & Post(s).
Install New Sign(s) & Post(s).
- ④ Install New Sign(s) & Post(s).

SURVEY PLOTTED BY	DATE
DRAWN BY	
DESIGNED BY	
QUANTITIES BY	
CHECKED BY	
ORIGINAL PLAN NO.	

THIS WORK WAS DONE BY ME OR UNDER MY SUPERVISION

Paul T. Tamelcort

STATE OF HAWAII
DEPARTMENT OF TRANSPORTATION
HIGHWAYS DIVISION

SIGNING AND PAVEMENT

MARKING PLANS

HONOAPIILANI HIGHWAY RESURFACING
Puumana to Kaanapali
Project No. 30ABC-01-97M

SCALE: 1" = 40' DATE: April, 1997

SHEET NO. 11 OF 11 SHEETS