
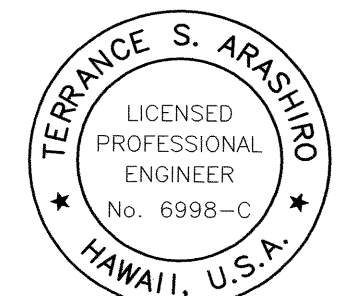


FED. ROAD DIST. NO.	STATE	FED. AID PROJ. NO.	FISCAL YEAR	SHEET NO.	TOTAL SHEETS
HAWAII	HAW.	NH-030-1(38)	2010	43	213

True North
Scale: 1"=300'

BEGIN PROJECT
F.A.P. No. NH-030-1(38)
Sta. 296+00

END PROJECT
F.A.P. No. NH-030-1(38)
Sta. 386+78

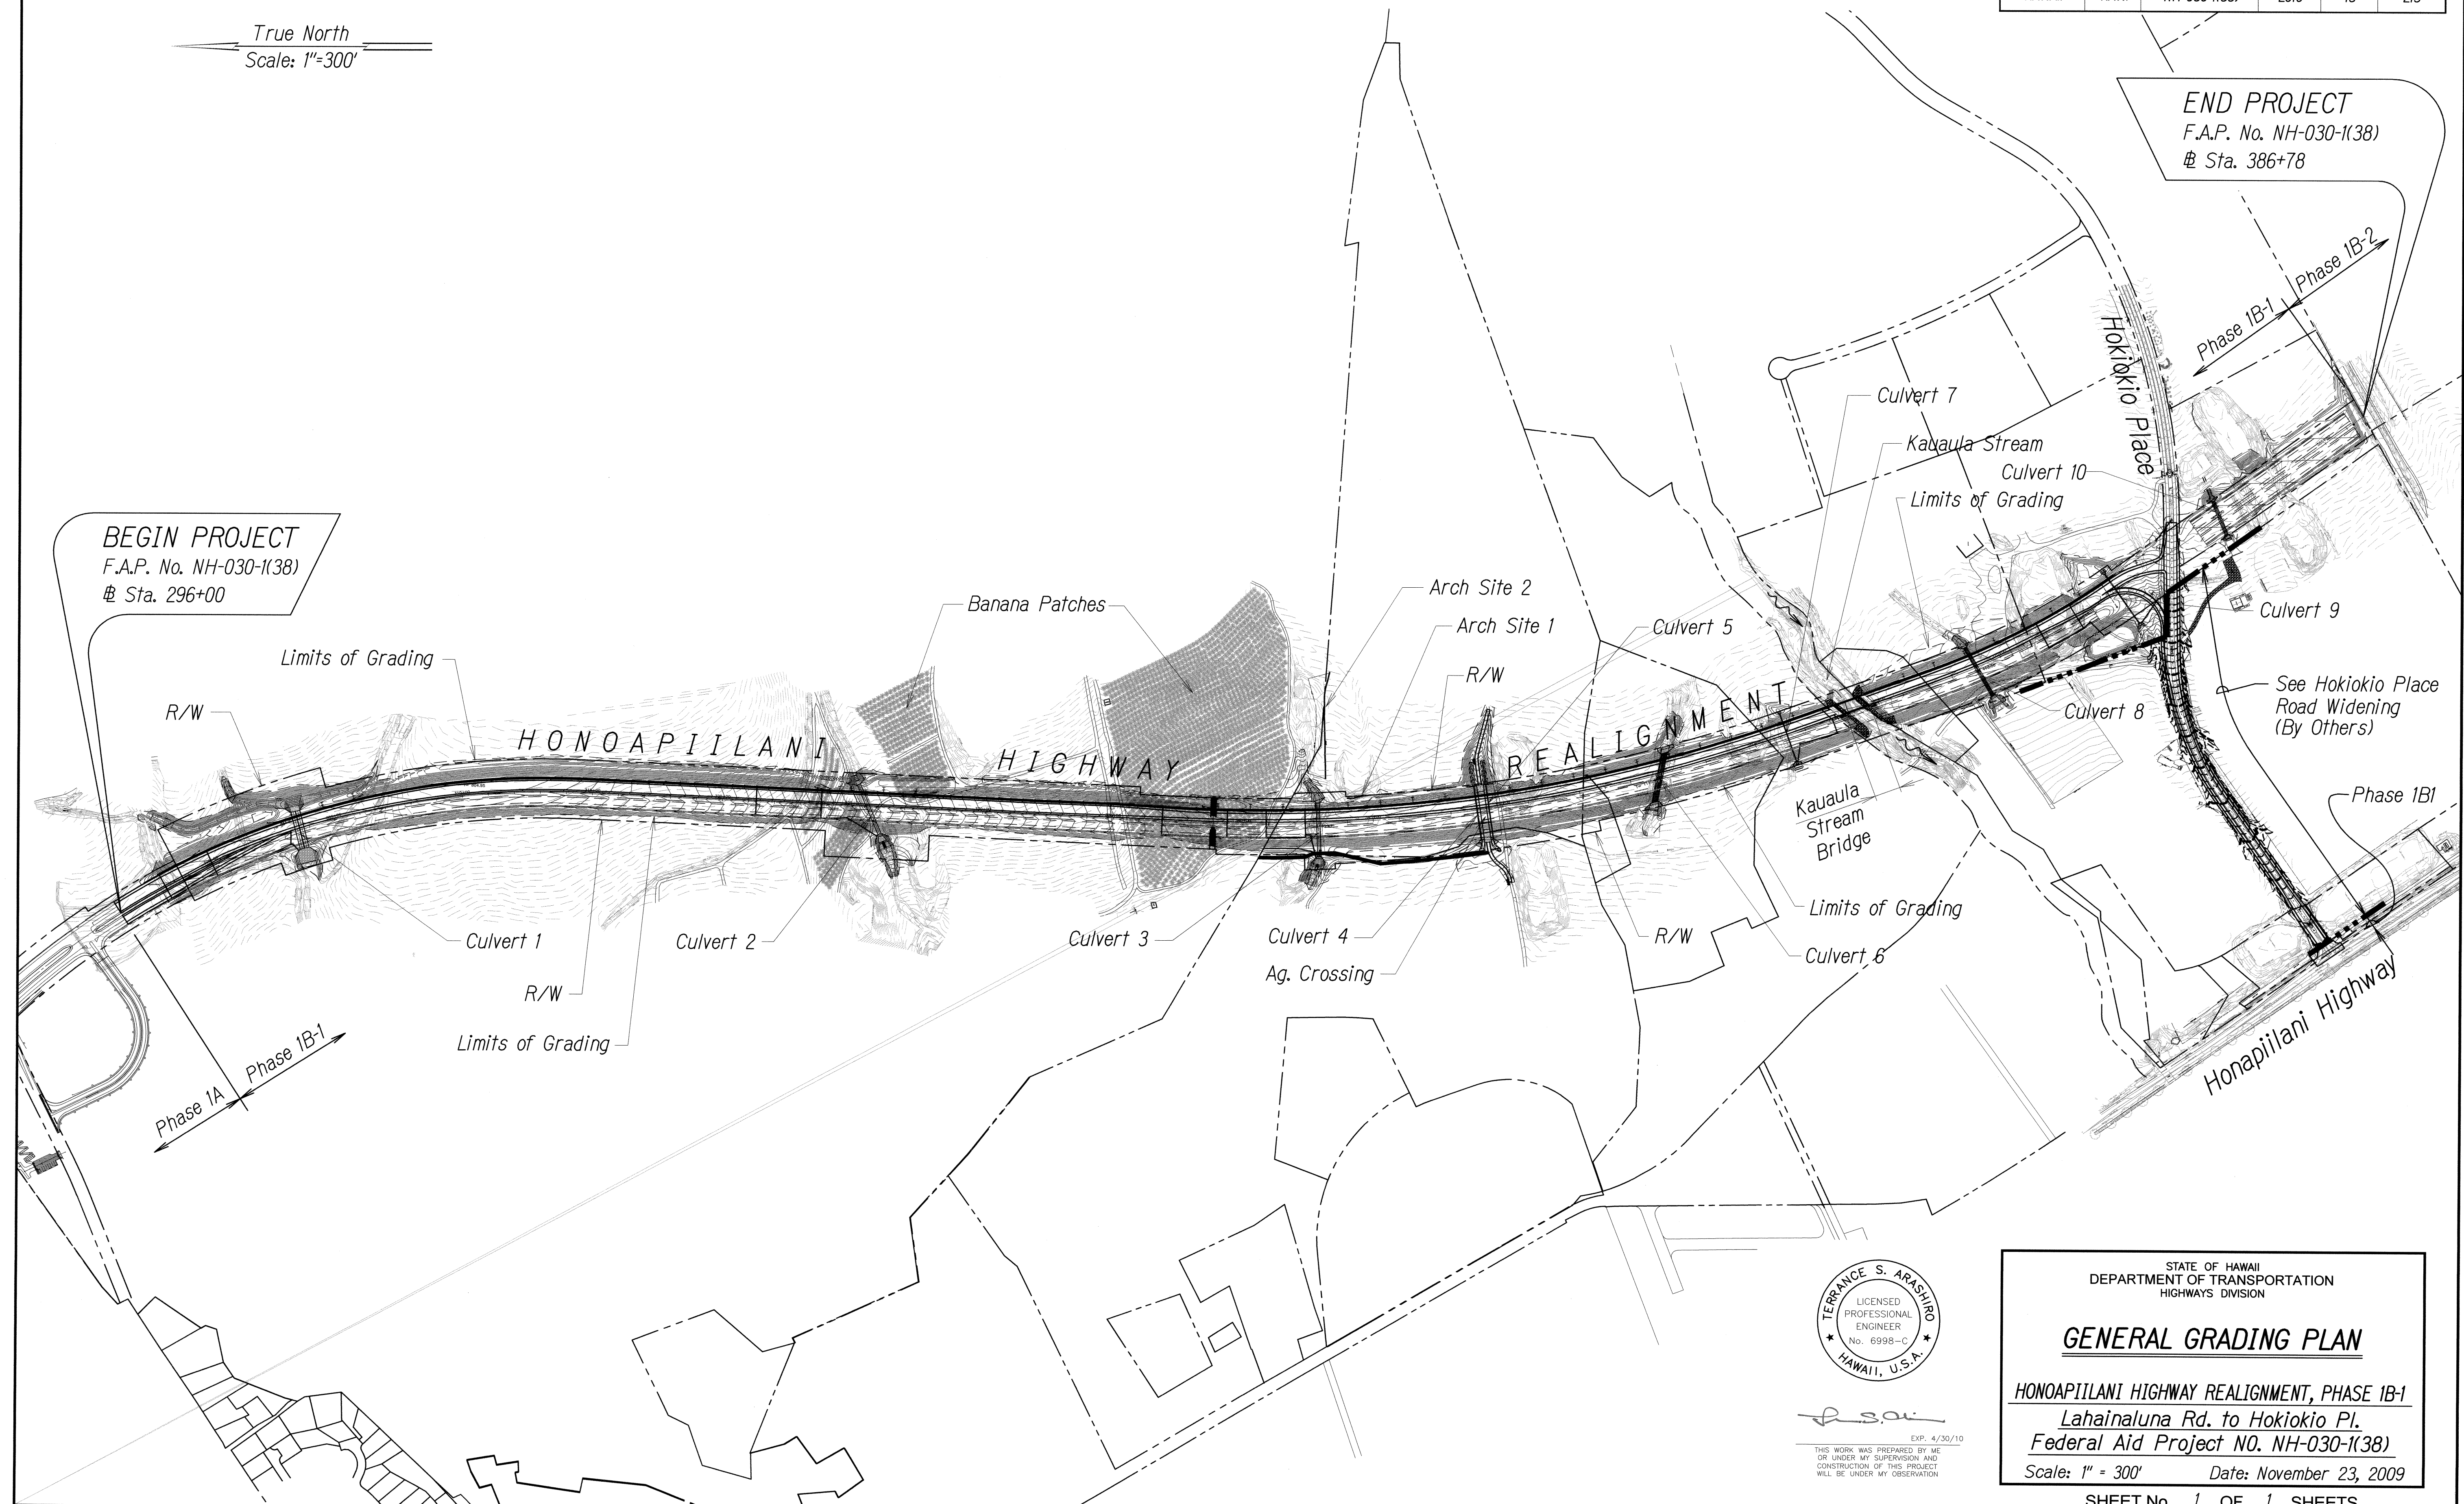

EXP. 4/30/10

THIS WORK WAS PREPARED BY ME OR UNDER MY SUPERVISION AND CONSTRUCTION OF THIS PROJECT WILL BE UNDER MY OBSERVATION

STATE OF HAWAII
DEPARTMENT OF TRANSPORTATION
HIGHWAYS DIVISION

GENERAL GRADING PLAN

HONOAPIILANI HIGHWAY REALIGNMENT, PHASE 1B-1
Lahainaluna Rd. to Hokiokio Pl.
Federal Aid Project NO. NH-030-1(38)

Scale: 1" = 300' Date: November 23, 2009

SHEET No. 1 OF 1 SHEETS