



FED. ROAD DIST. NO.	STATE	FED. AID PROJ. NO.	FISCAL YEAR	SHEET NO.	TOTAL SHEETS
HAWAII	HAW.	NH-030-1(38)	2010	31	213

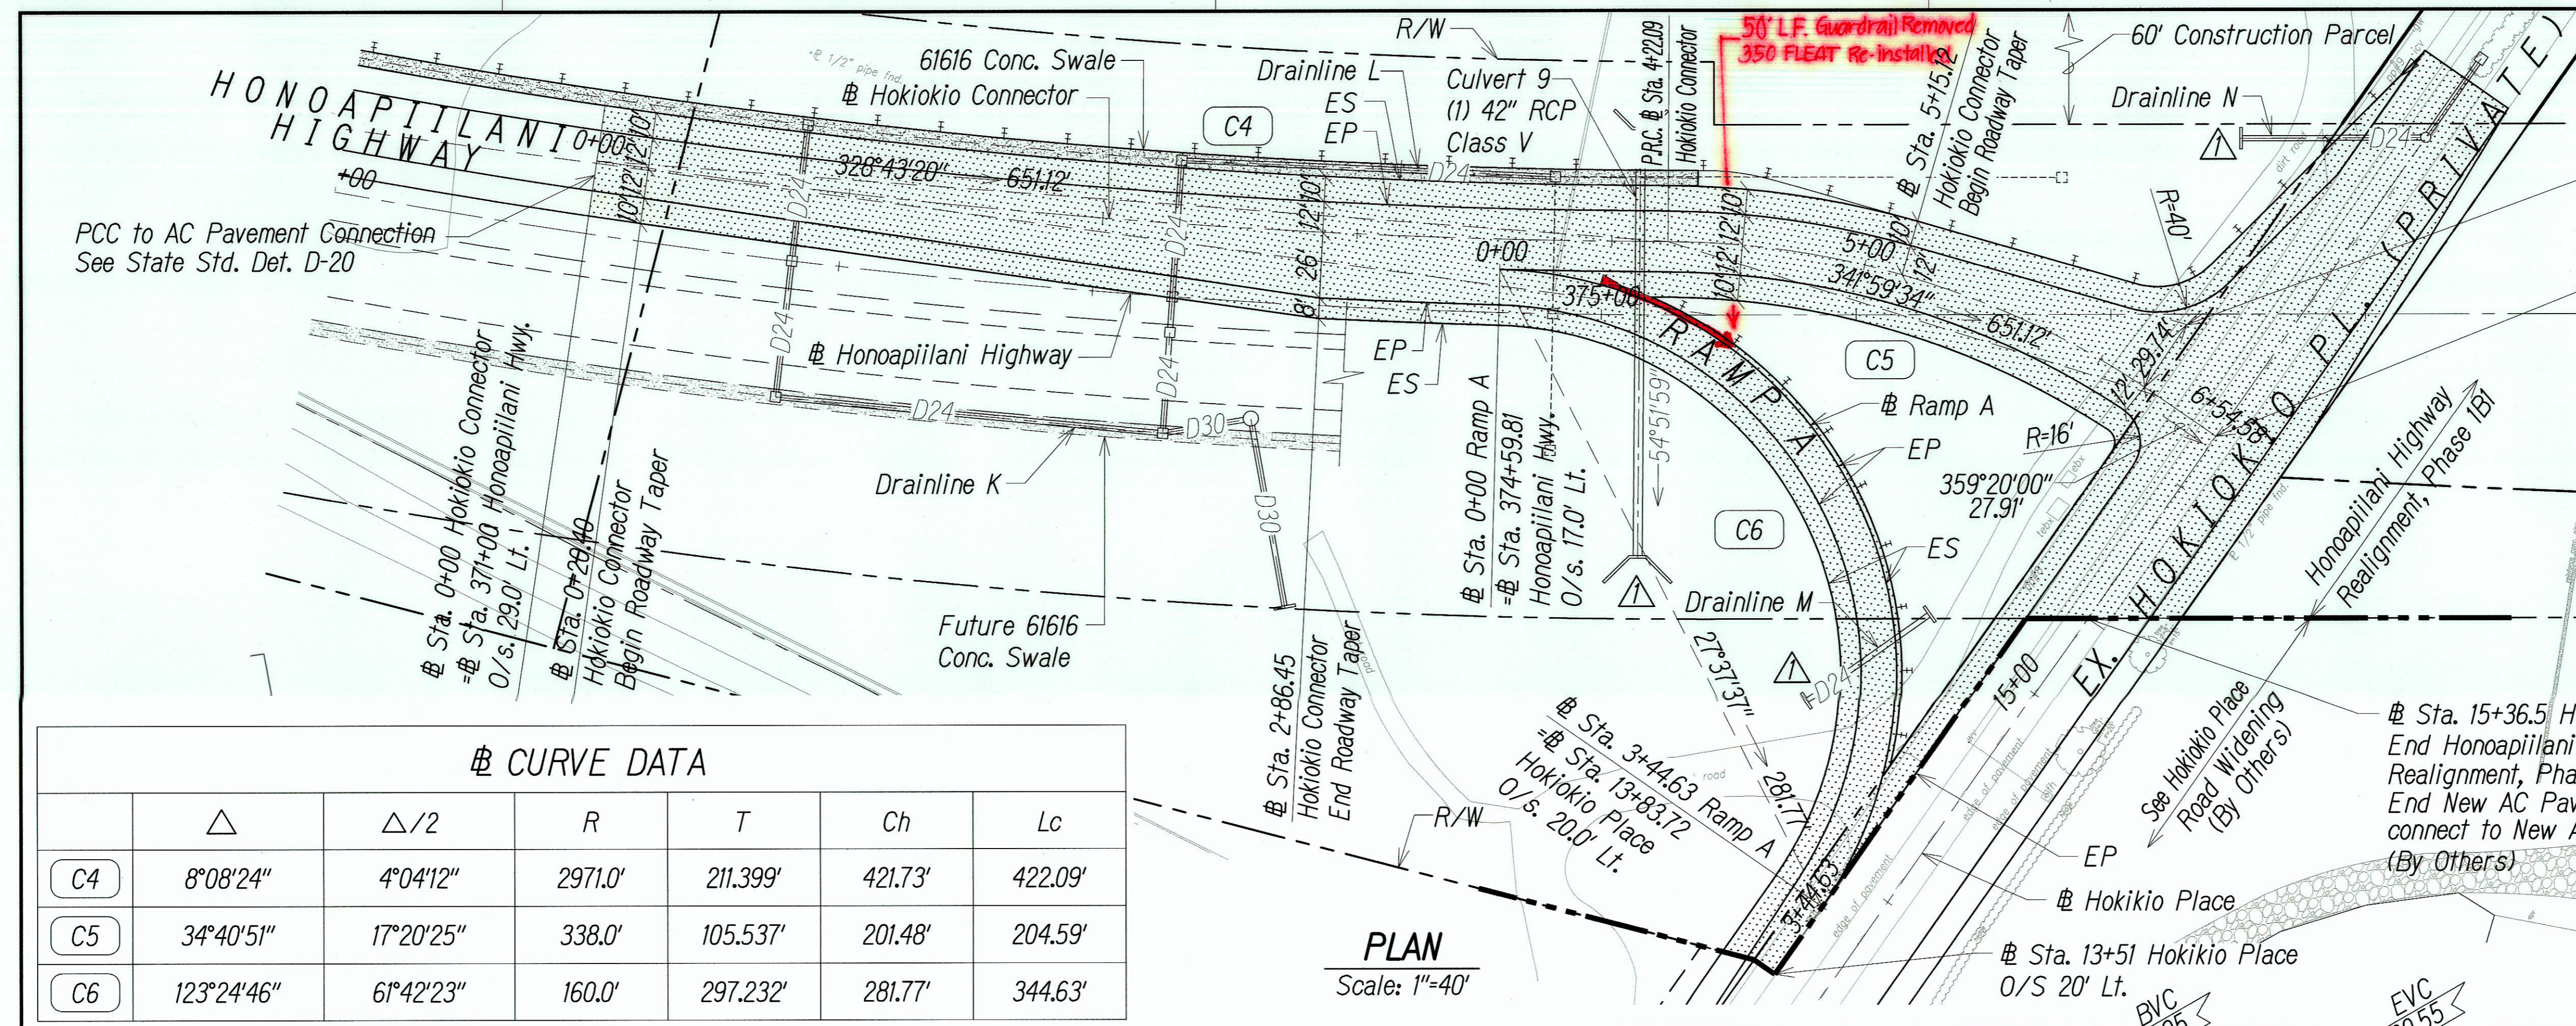

CURVE DATA						
	Δ	$\Delta/2$	R	T	Ch	Lc
C4	8°08'24"	4°04'12"	2971.0'	211.399'	421.73'	422.09'
C5	34°40'51"	17°20'25"	338.0'	105.537'	201.48'	204.59'
C6	123°24'46"	61°42'23"	160.0'	297.232'	281.77'	344.63'

PLAN
Scale: 1"=40'

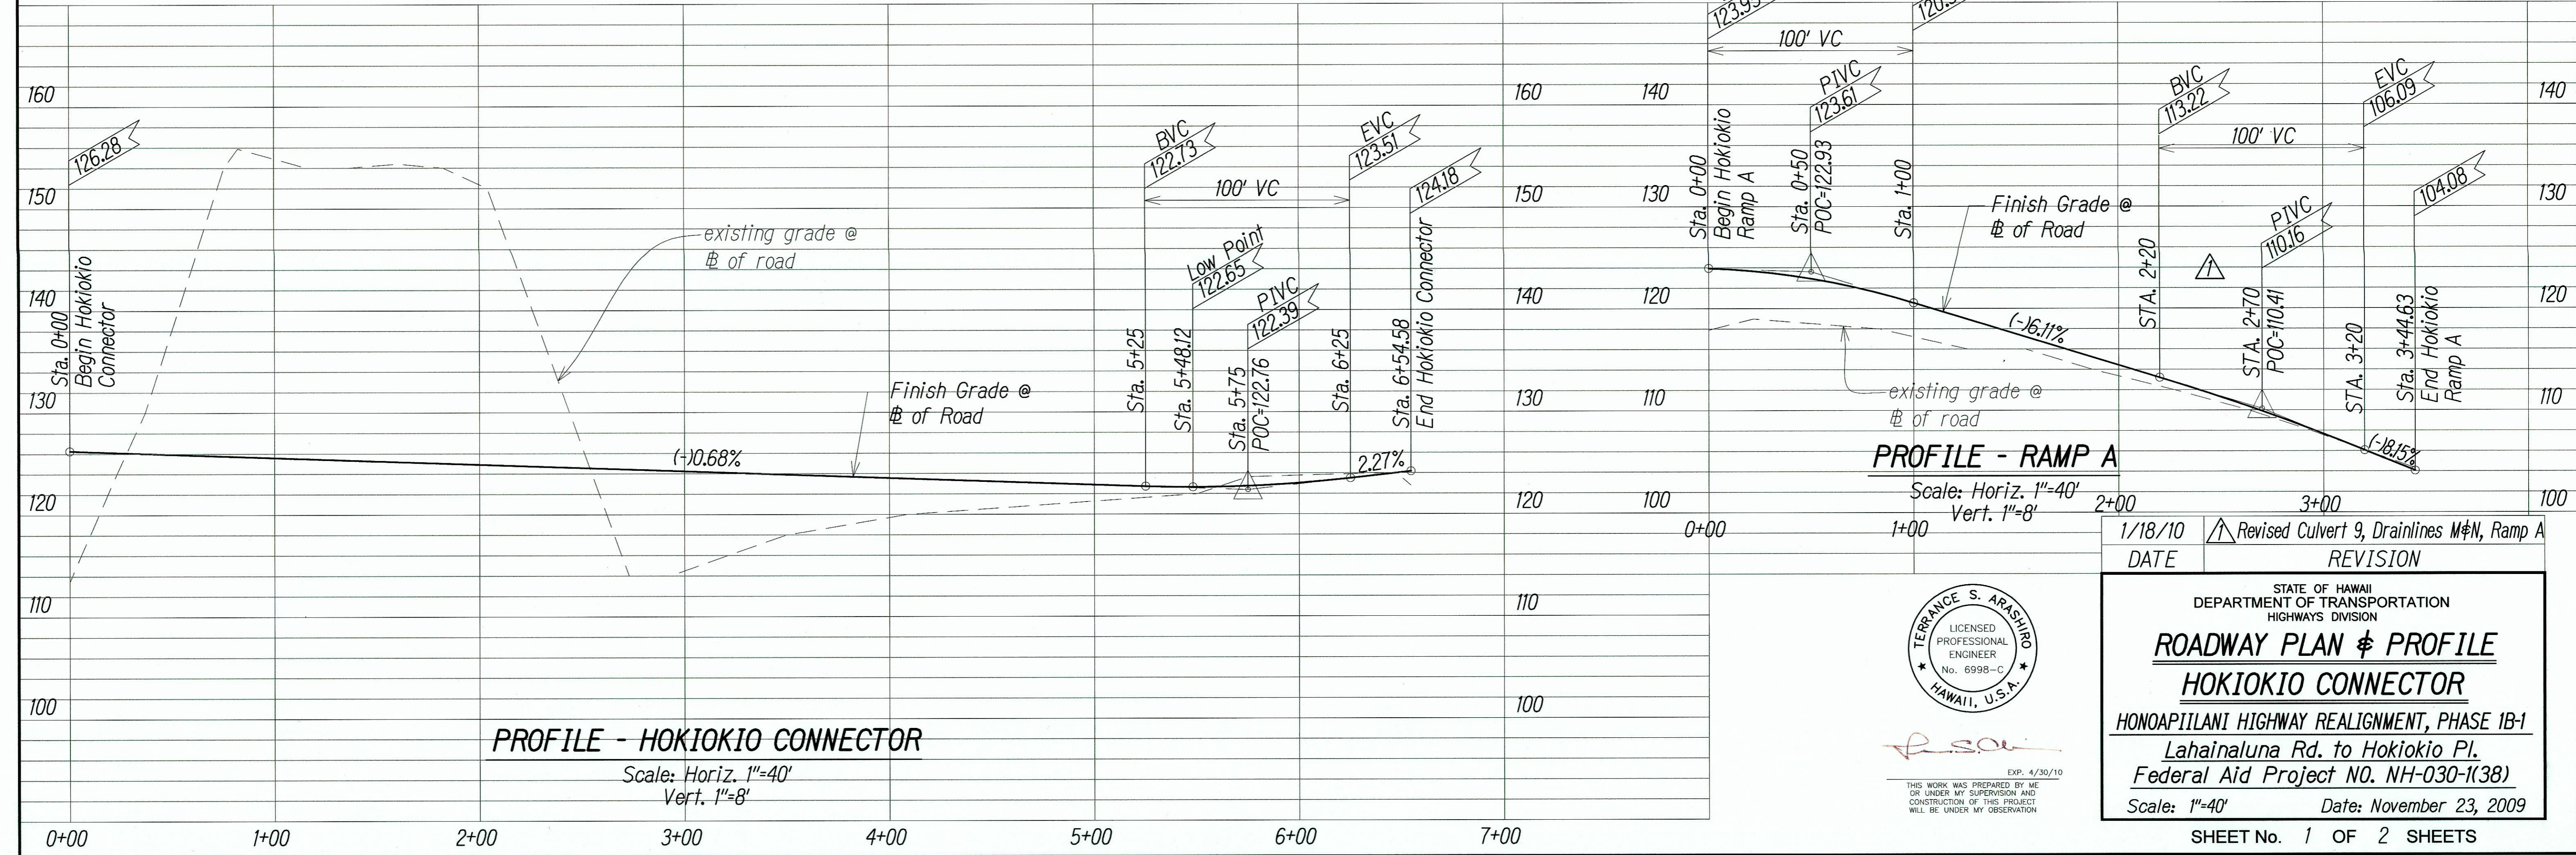

PROFILE - HOKIOKIO CONNECTOR
Scale: Horiz. 1"=40'
Vert. 1"=8'

PROFILE - RAMP A
Scale: Horiz. 1"=40'
Vert. 1"=8'

1/18/10	Revised Culvert 9, Drainlines M&N, Ramp A
DATE	REVISION



STATE OF HAWAII
DEPARTMENT OF TRANSPORTATION
HIGHWAYS DIVISION

ROADWAY PLAN & PROFILE
HOKIOKIO CONNECTOR


HONOAPIILANI HIGHWAY REALIGNMENT, PHASE 1B-1
Lahainaluna Rd. to Hokiokio Pl.
Federal Aid Project NO. NH-030-1(38)

Scale: 1"=40' Date: November 23, 2009

"AS-BUILT"


ADD. 31

FED. ROAD DIST. NO.	STATE	FED. AID PROJ. NO.	FISCAL YEAR	SHEET NO.	TOTAL SHEETS
HAWAII	HAW.	NH-030-1(38)	2010	C.O. ADD. 32	213

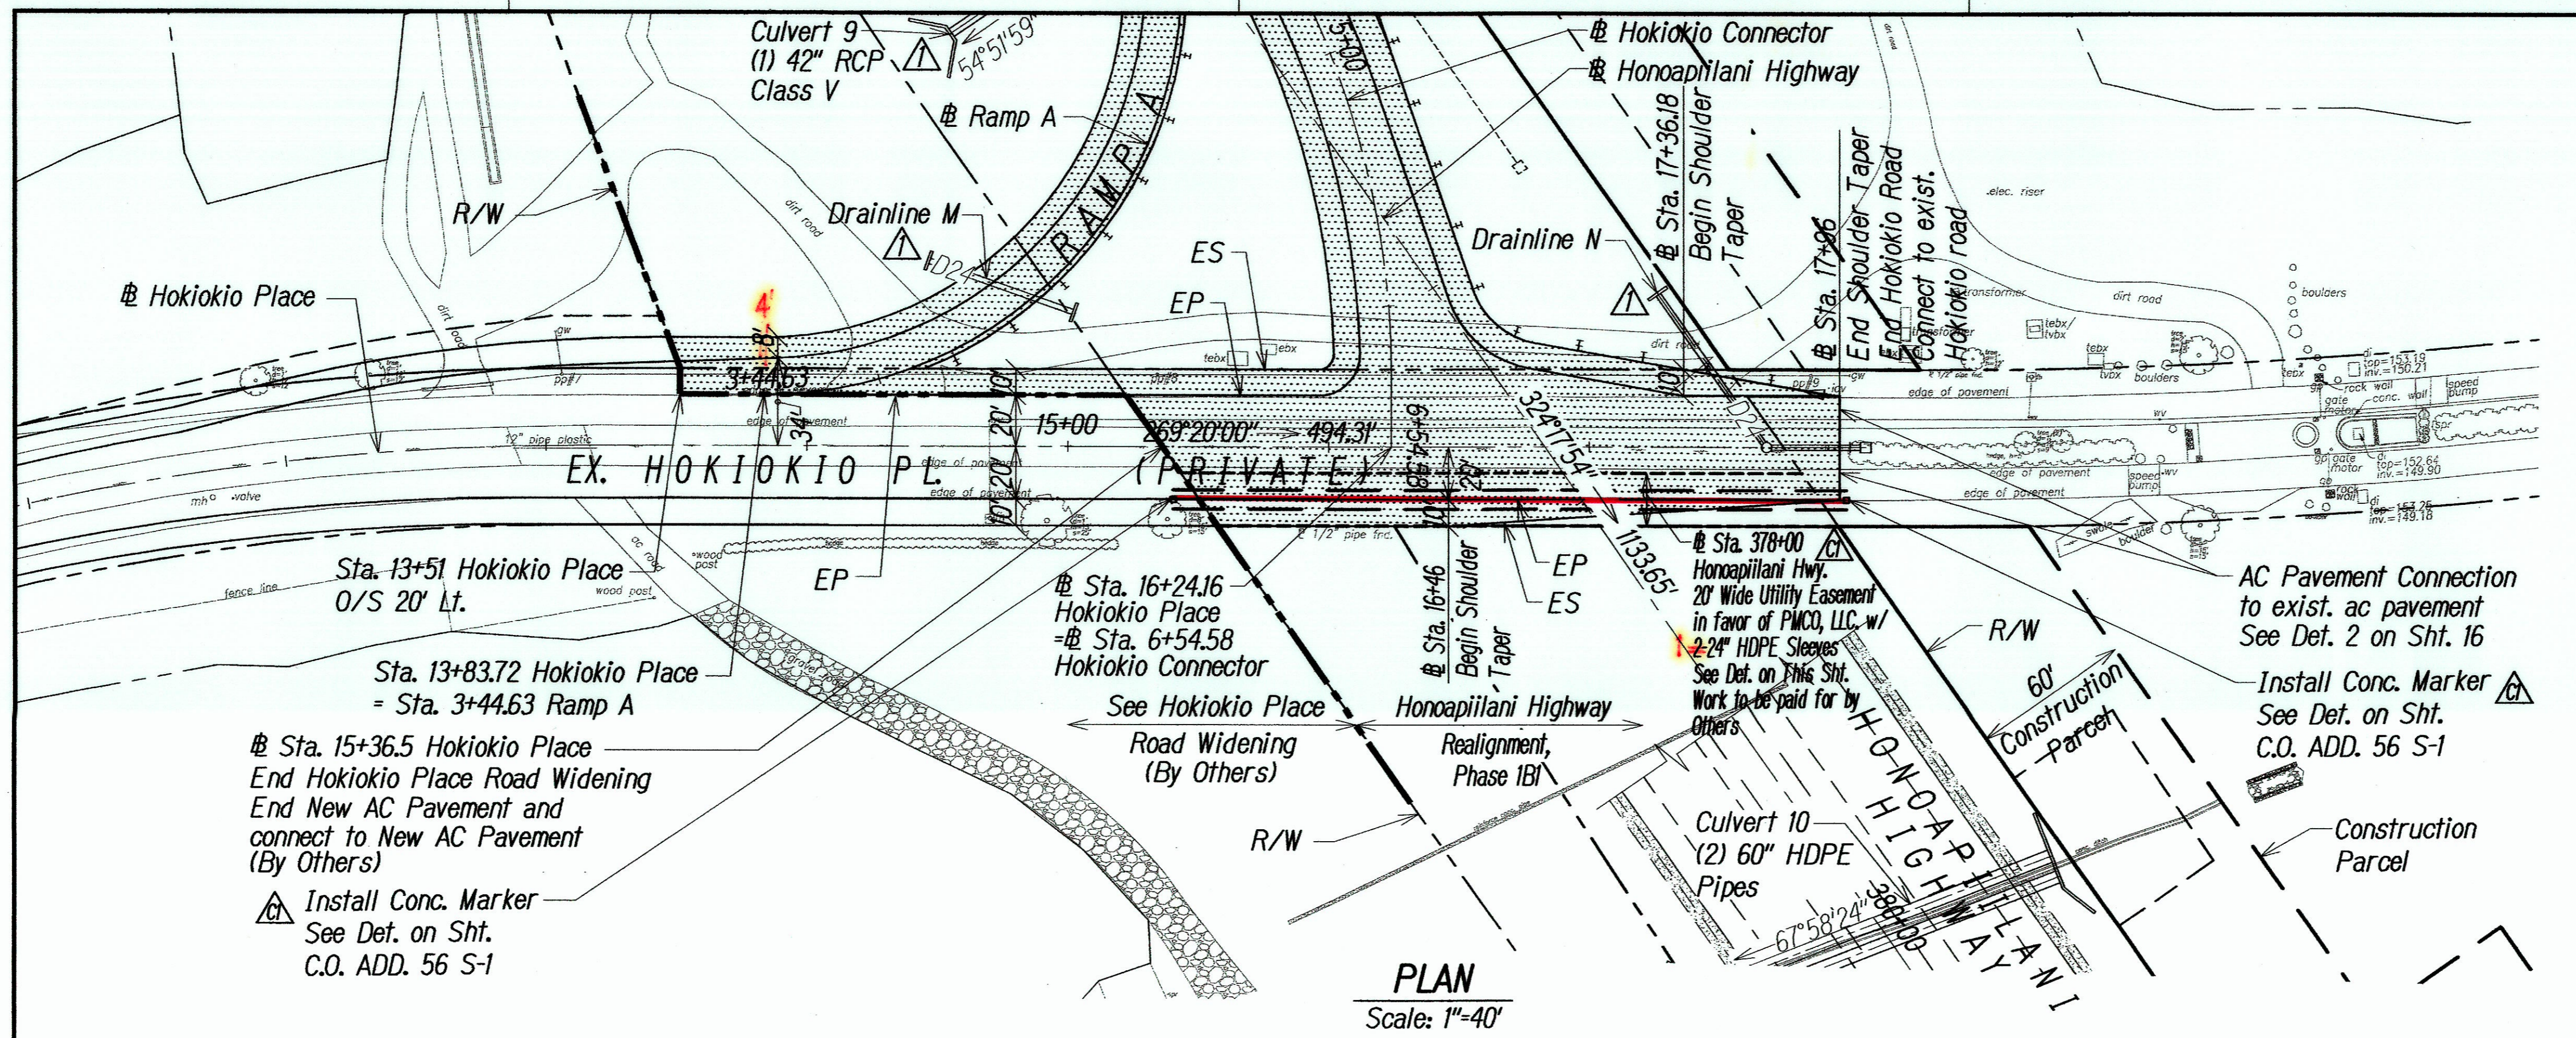

True North
Scale: 1"=40'

Legend:
 AC Pavement

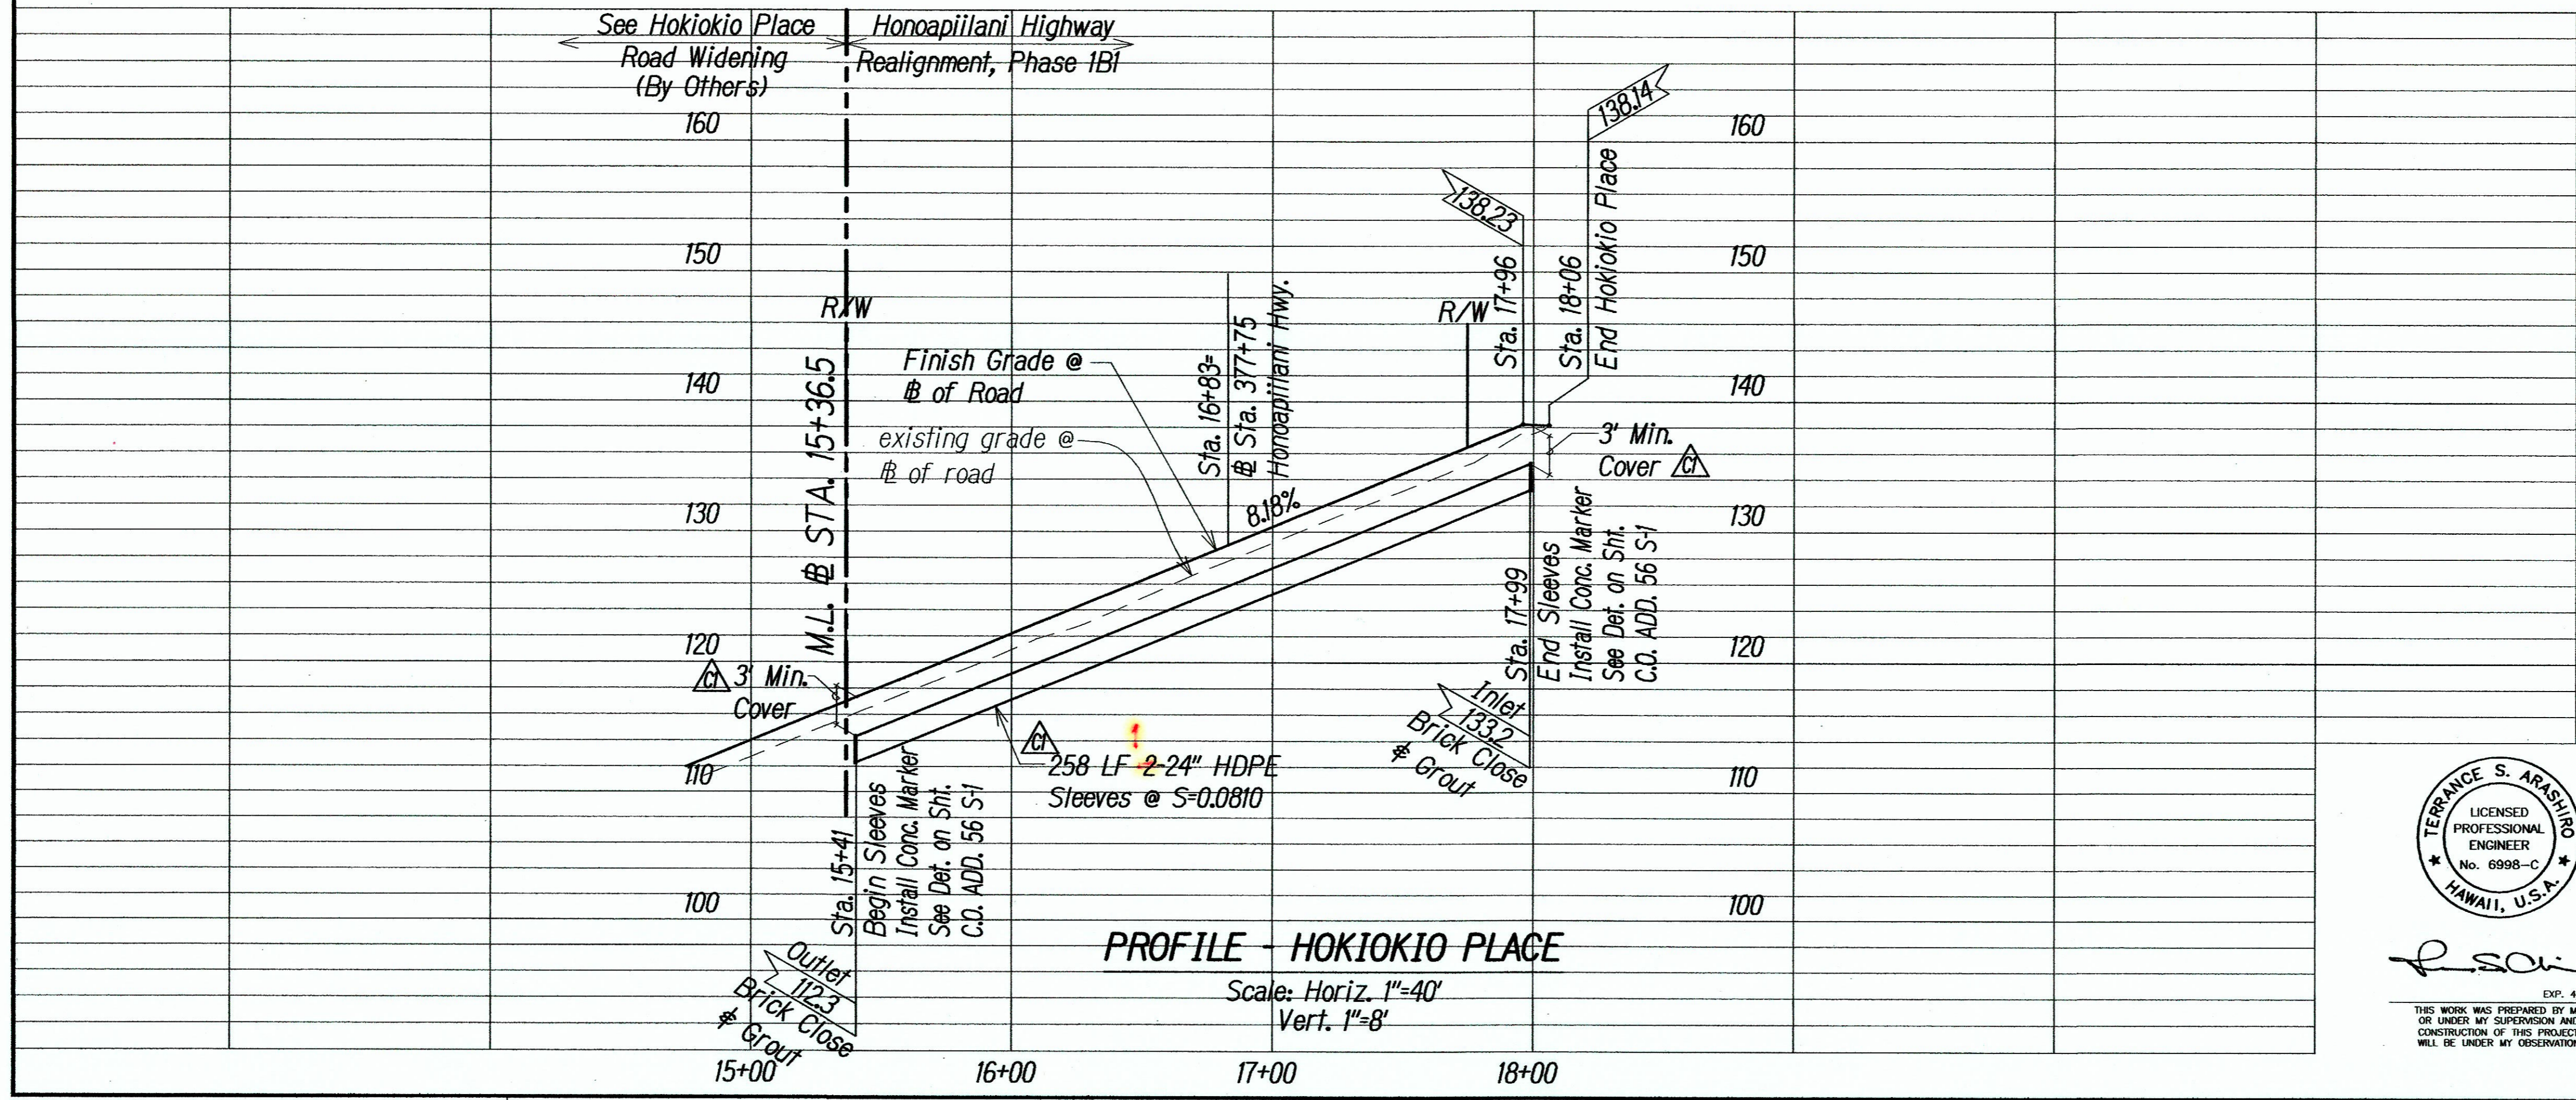

DATE	REVISION
6/15/11	Added Easement w/ Sleeves
1/18/10	Revised Culvert 9 & Drainlines M&N



T.S.A.
 EXP. 4/30/12
 THIS WORK WAS PREPARED BY ME OR UNDER MY SUPERVISION AND CONSTRUCTION OF THIS PROJECT WILL BE UNDER MY OBSERVATION

STATE OF HAWAII
 DEPARTMENT OF TRANSPORTATION
 HIGHWAYS DIVISION

ROADWAY PLAN & PROFILE
HOKIOKIO CONNECTOR
 HONOAPIILANI HIGHWAY REALIGNMENT, PHASE 1B-1
 Lahainaluna Rd. to Hokiokio Pl.
 Federal Aid Project NO. NH-030-1(38)

Scale: 1"=40' Date: November 23, 2009

"AS-BUILT"

SHEET No. 2 OF 2 SHEETS
C.O. ADD. 32