
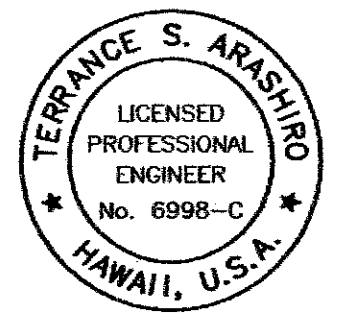
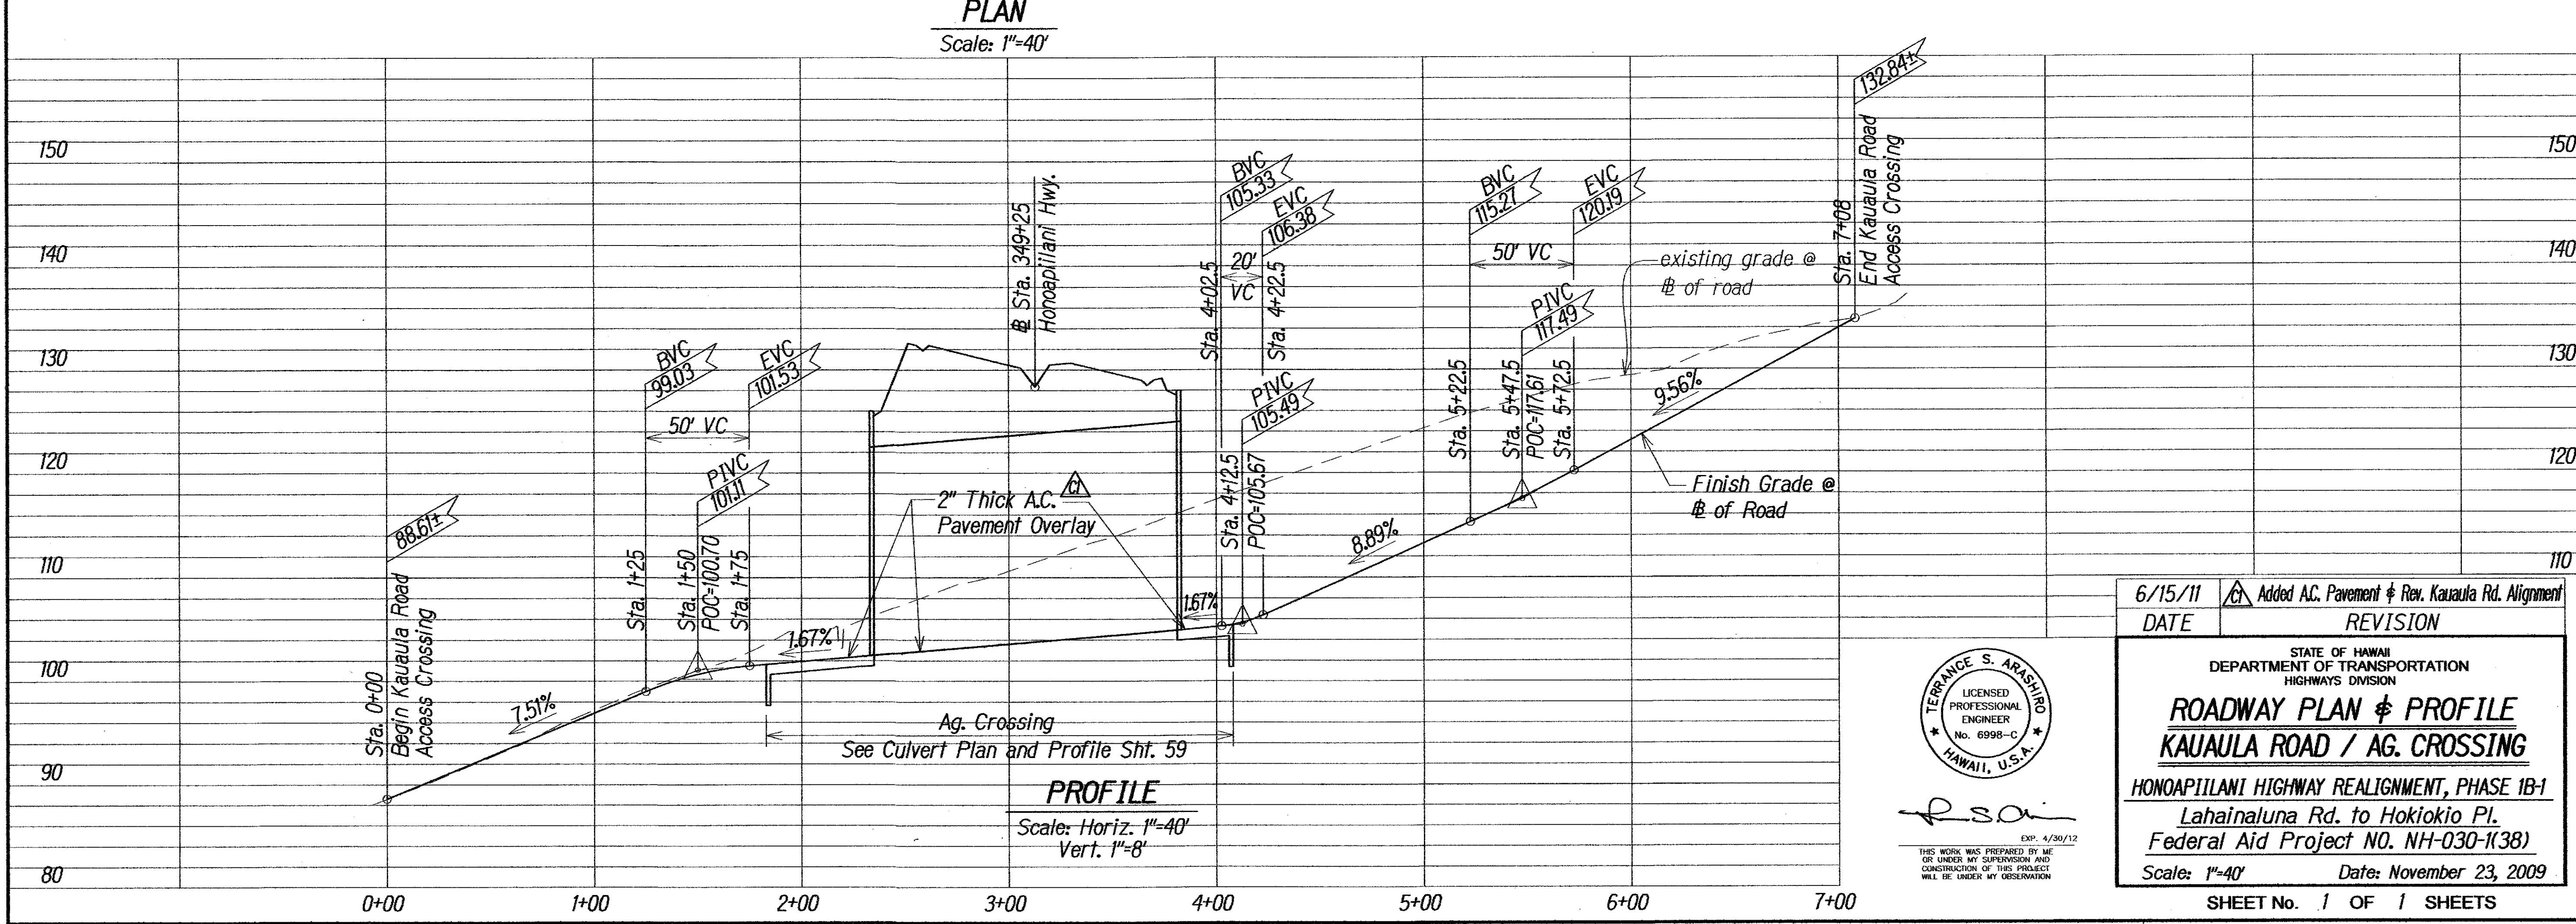


FED. ROAD DIST. NO.	STATE	FED. AID PROJ. NO.	FISCAL YEAR	SHEET NO.	TOTAL SHEETS
HAWAII	HAW.	NH-030-1(38)	2010	C.O. 33	213

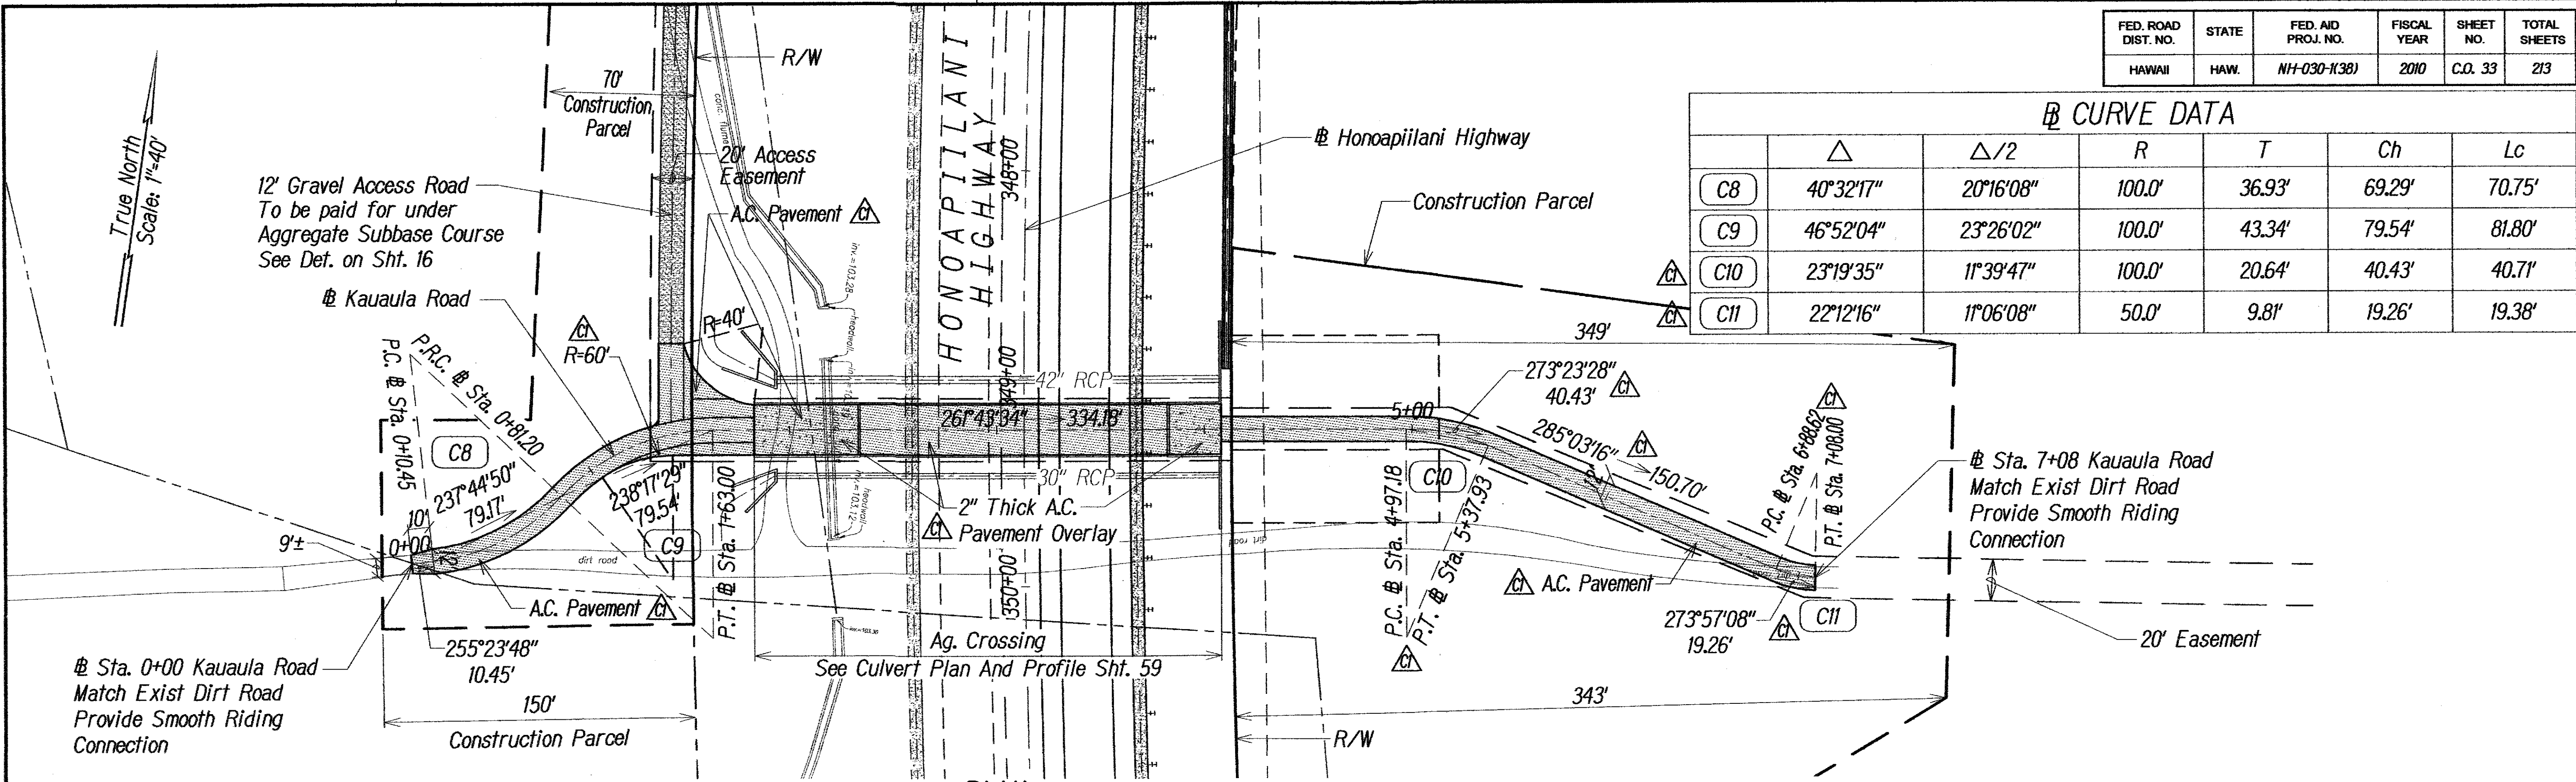

6/15/11
DATE

Added AC. Pavement & Rev. Kauaula Rd. Alignment
REVISION

STATE OF HAWAII
DEPARTMENT OF TRANSPORTATION
HIGHWAYS DIVISION
ROADWAY PLAN & PROFILE
KAUAAULA ROAD / AG. CROSSING
HONOAPIILANI HIGHWAY REALIGNMENT, PHASE 1B-1
Lahainaluna Rd. to Hokiokio Pl.
Federal Aid Project NO. NH-030-1(38)
Scale: 1"=40' Date: November 23, 2009

SHEET No. 1 OF 1 SHEETS