



FED. ROAD DIST. NO.	STATE	FED. AID PROJ. NO.	FISCAL YEAR	SHEET NO.	TOTAL SHEETS
HAWAII	HAW.	BR-NH-030-1(24)	2000	24	139

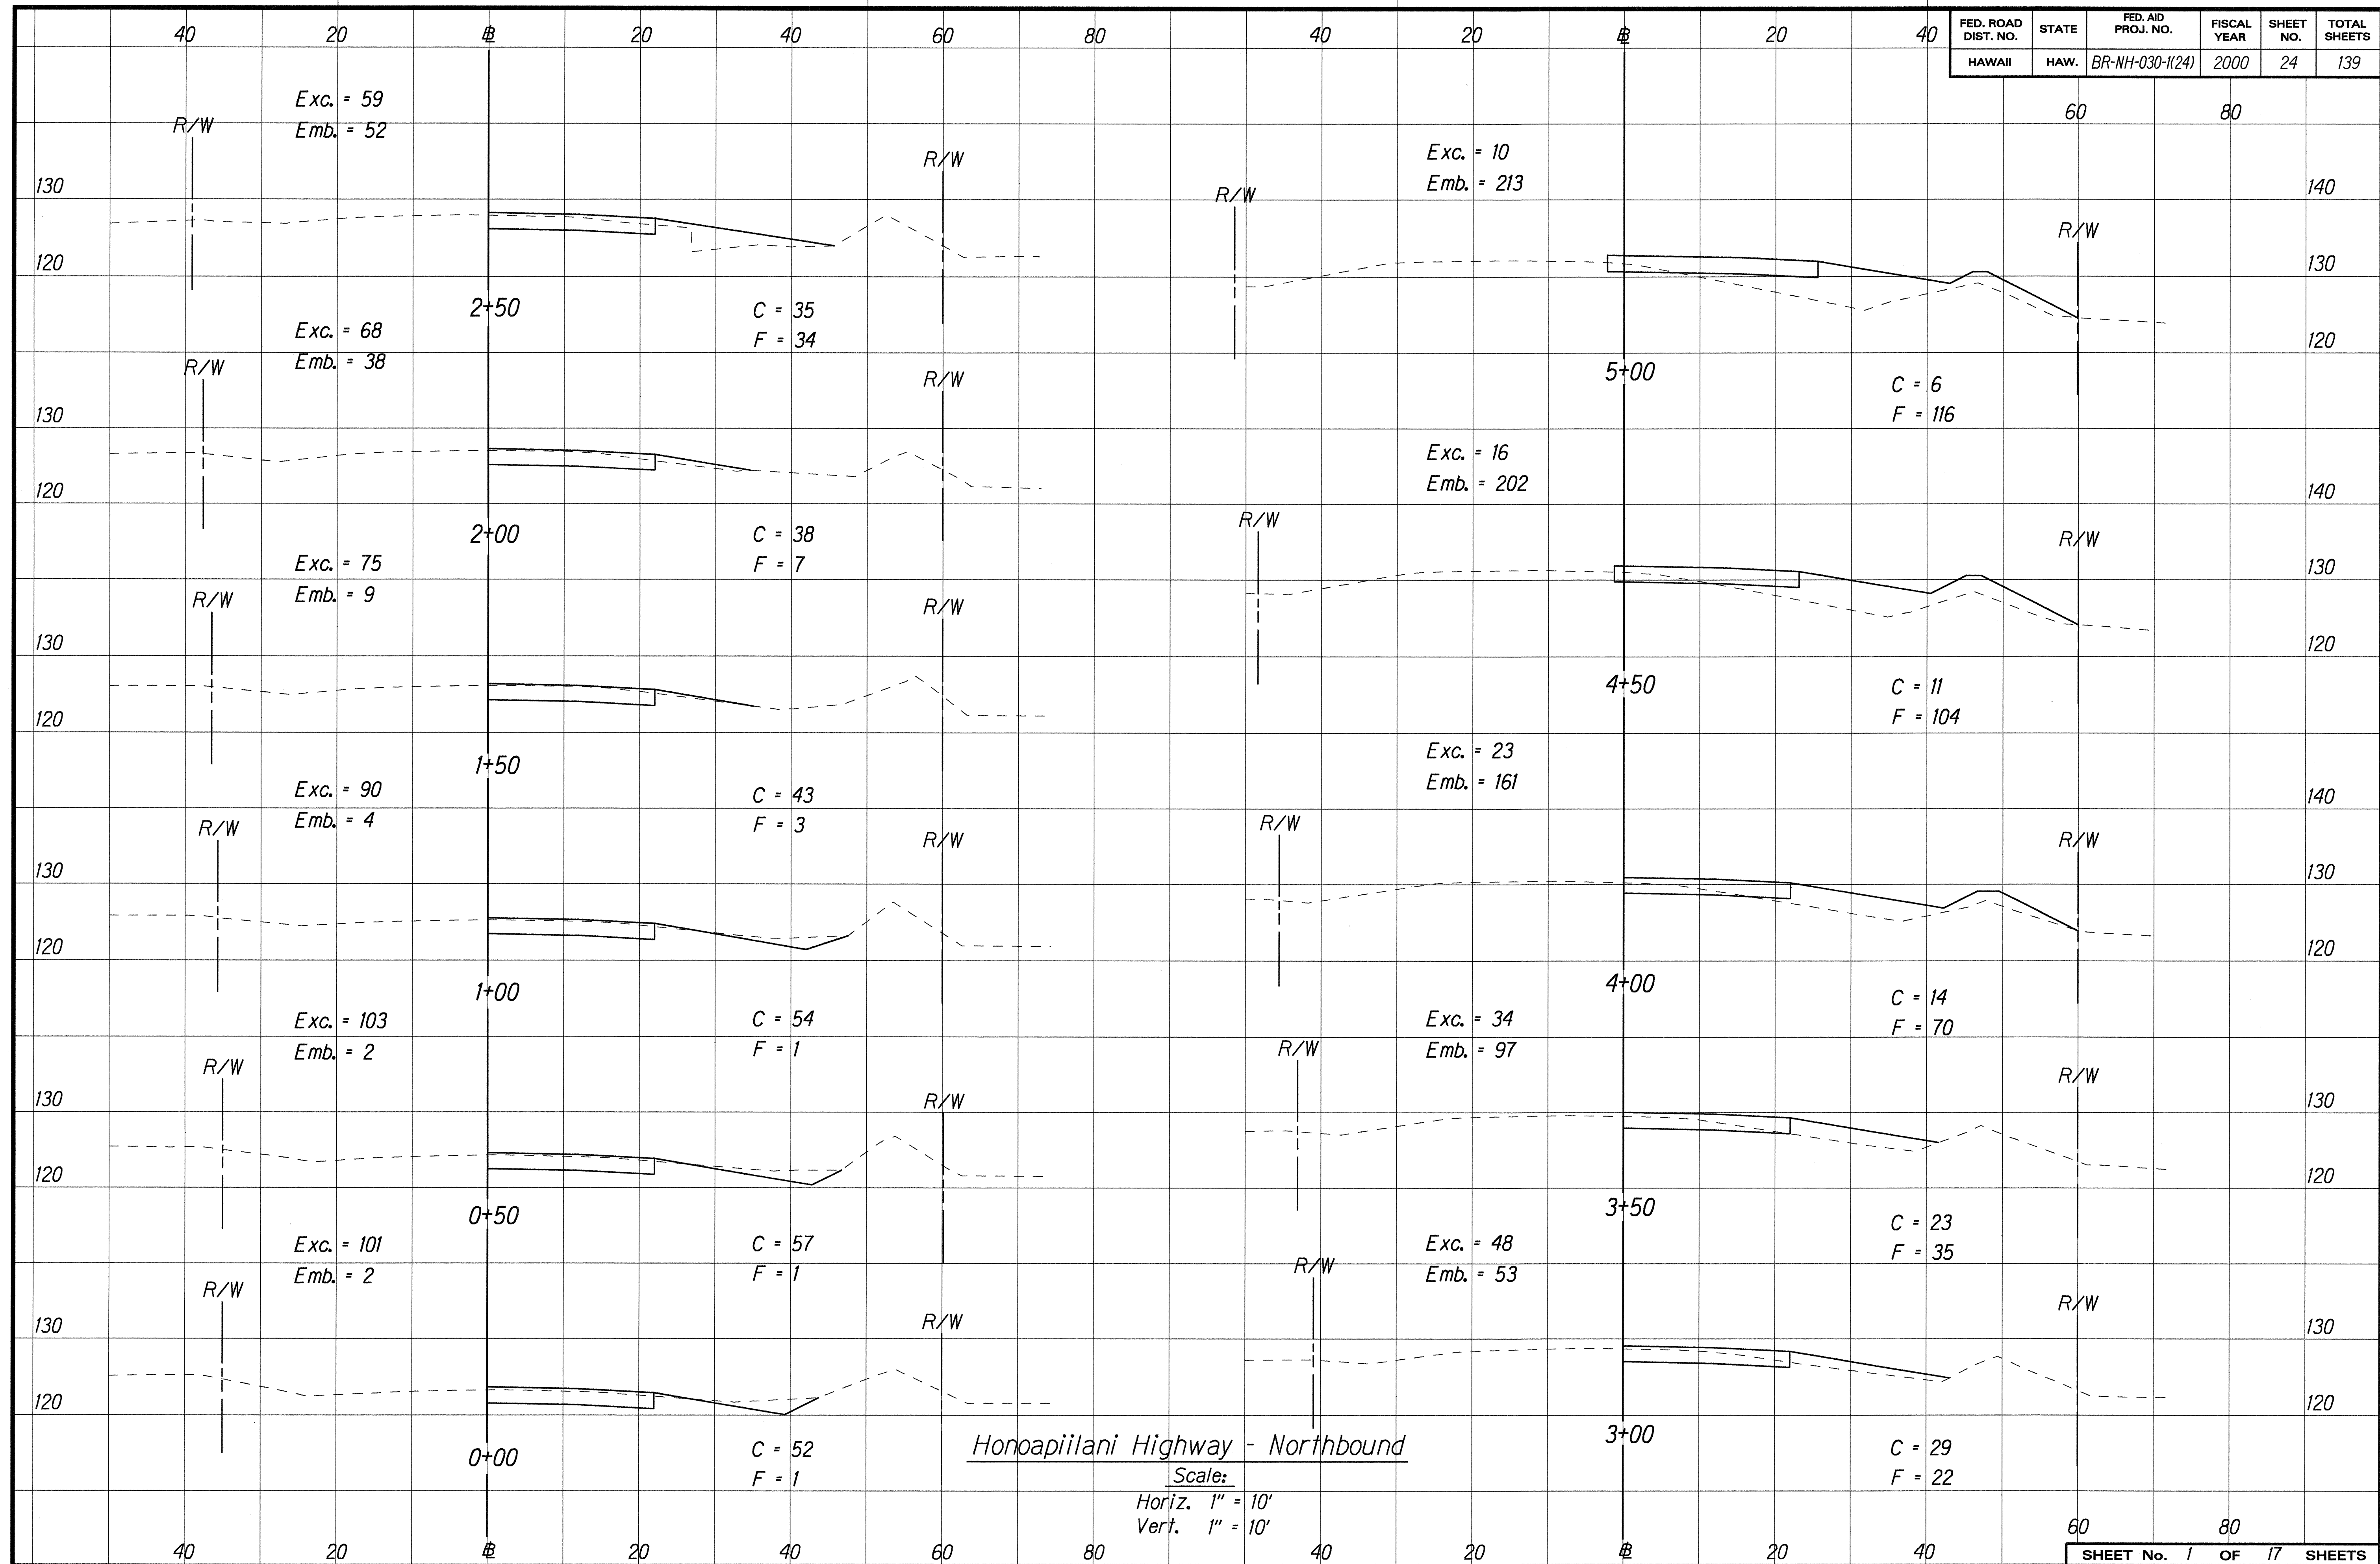


ORIGINAL PLAN
 SURVEY PLOTTED BY
 DRAWN BY K. Tanaka
 DESIGNED BY R. Hironaka
 CHECKED BY N. Hironaka

FED. ROAD DIST. NO.	STATE	FED. AID PROJ. NO.	FISCAL YEAR	SHEET NO.	TOTAL SHEETS
HAWAII	HAW.	BR-NH-030-1(24)	2000	25	139

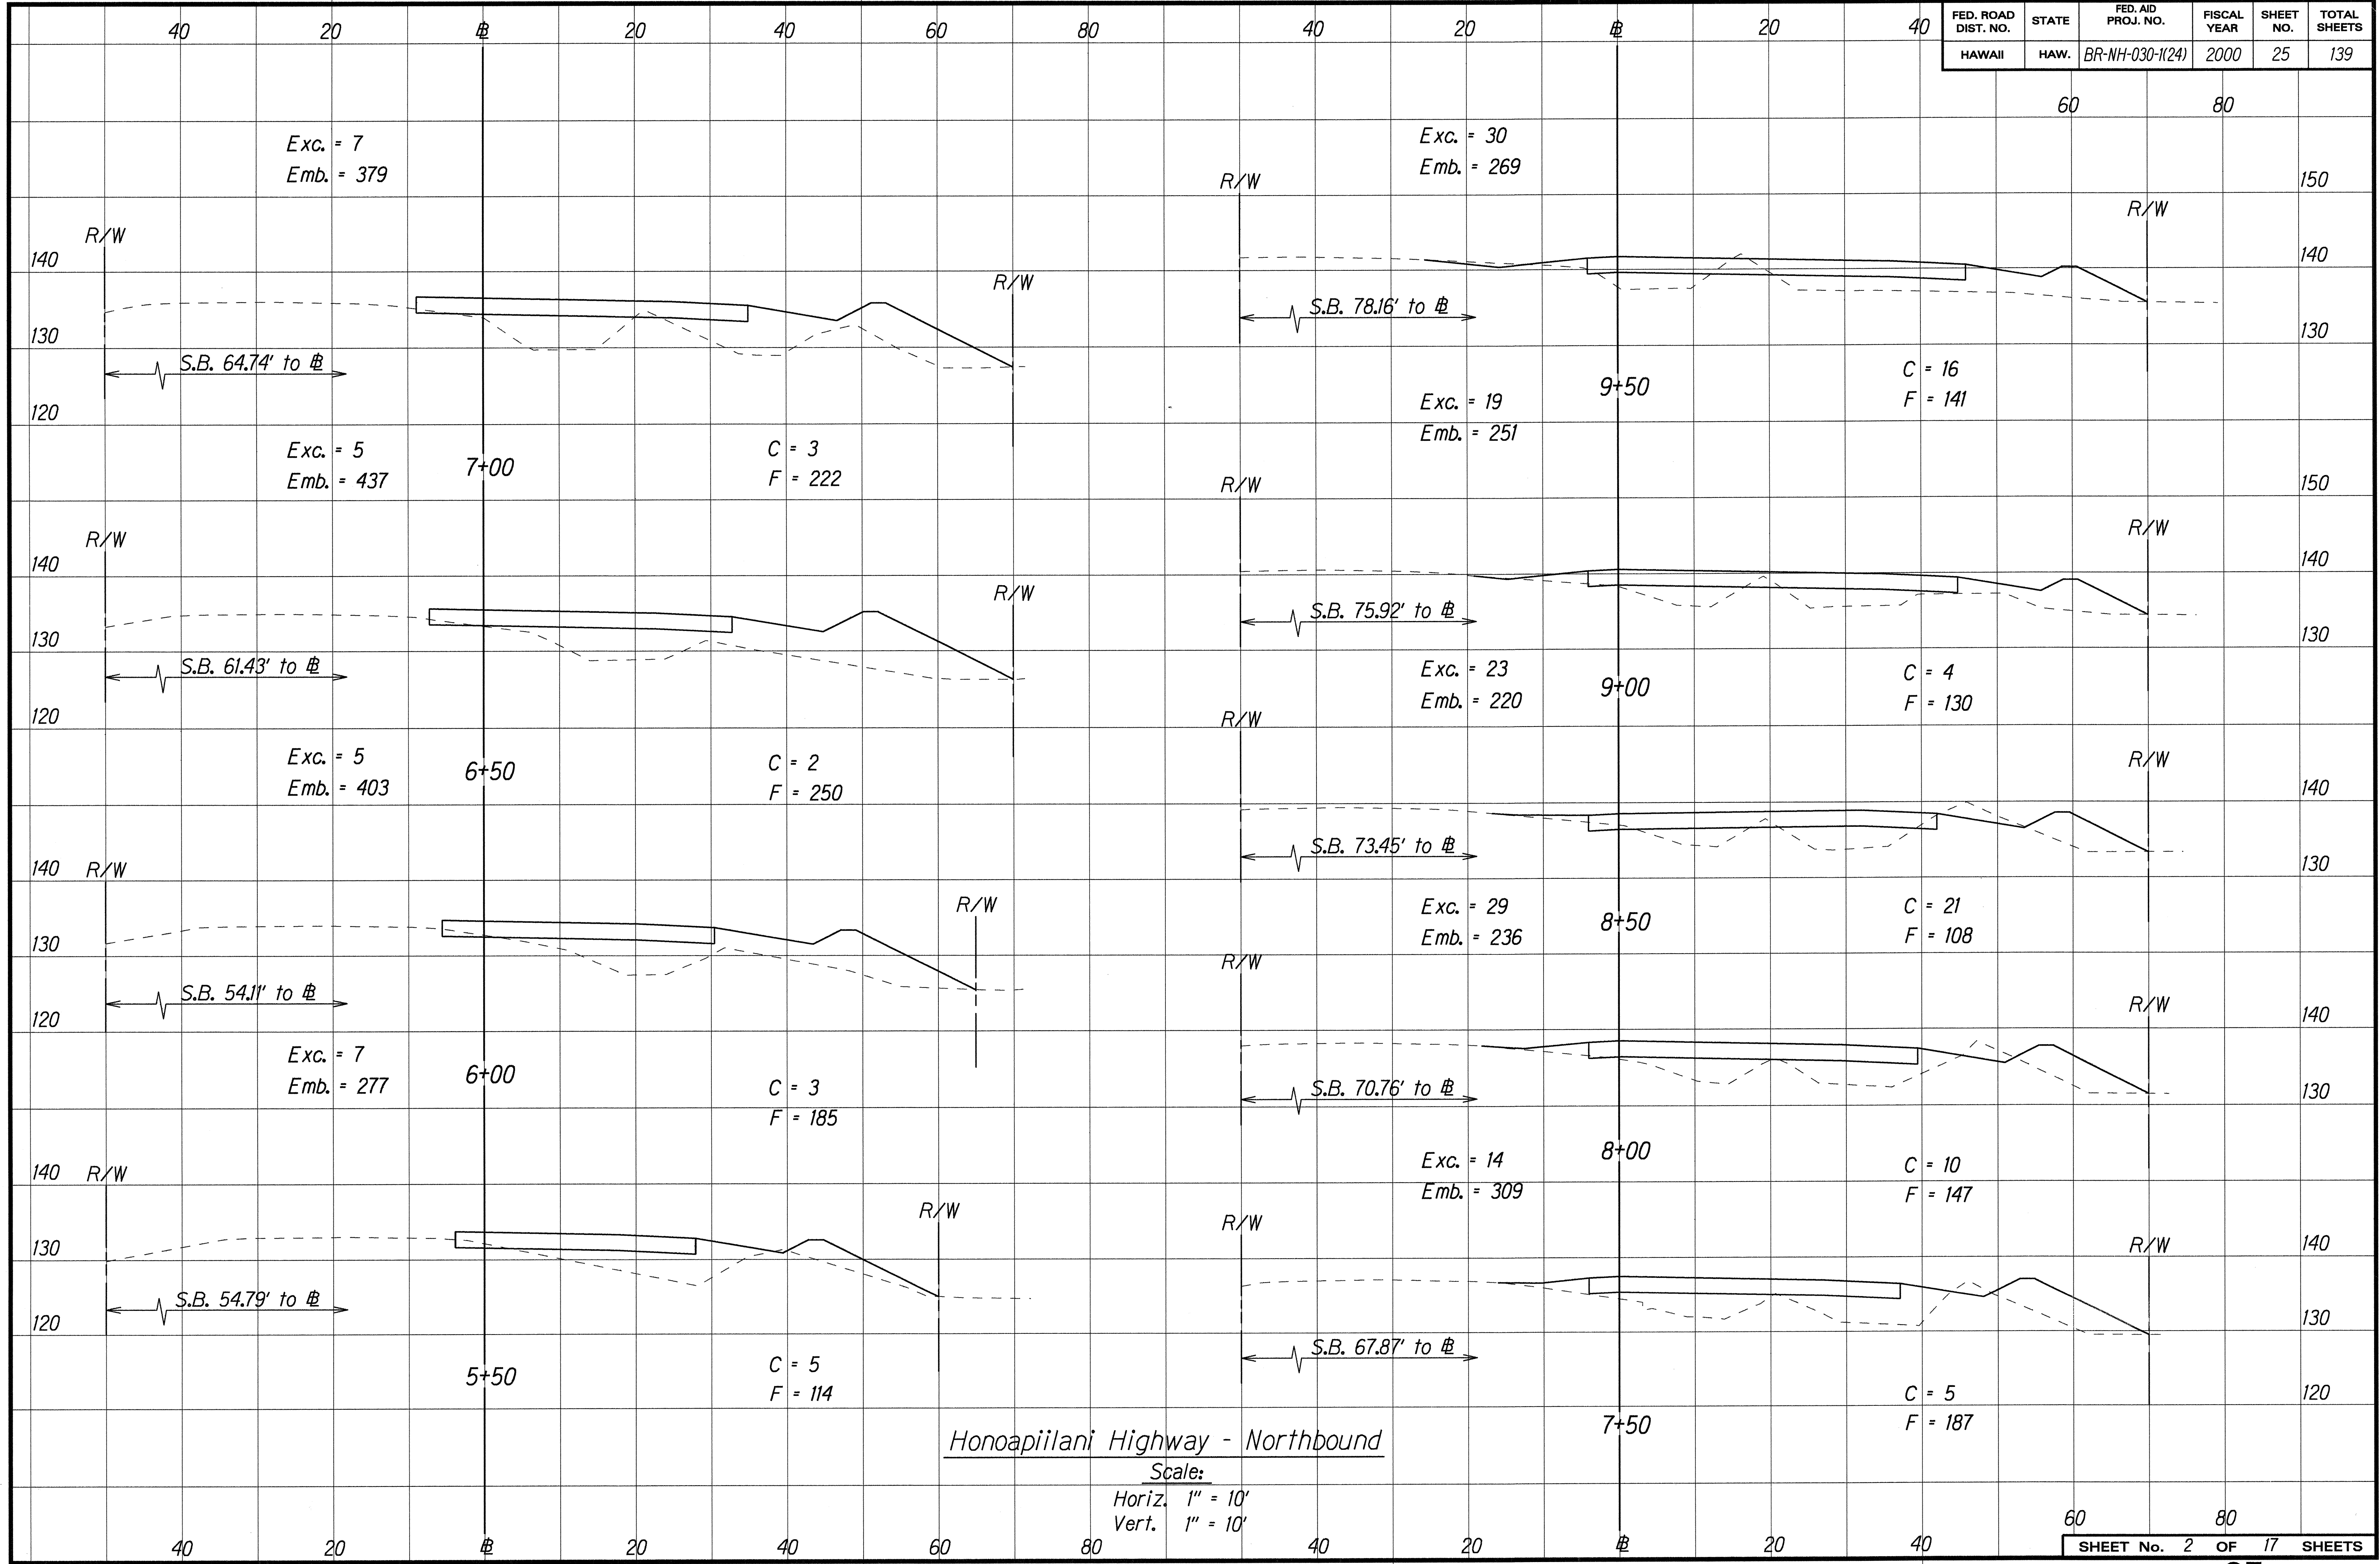


SURVEY PLOTTED BY: DATE
 DRAWN BY: 11-14-97
 DESIGNED BY: R. Hironaka/K. Matsunaga
 CHECKED BY: dd24
 S. Hironaka

FED. ROAD DIST. NO.	STATE	FED. AID PROJ. NO.	FISCAL YEAR	SHEET NO.	TOTAL SHEETS
HAWAII	HAW.	BR-NH-030-1(24)	2000	26	139

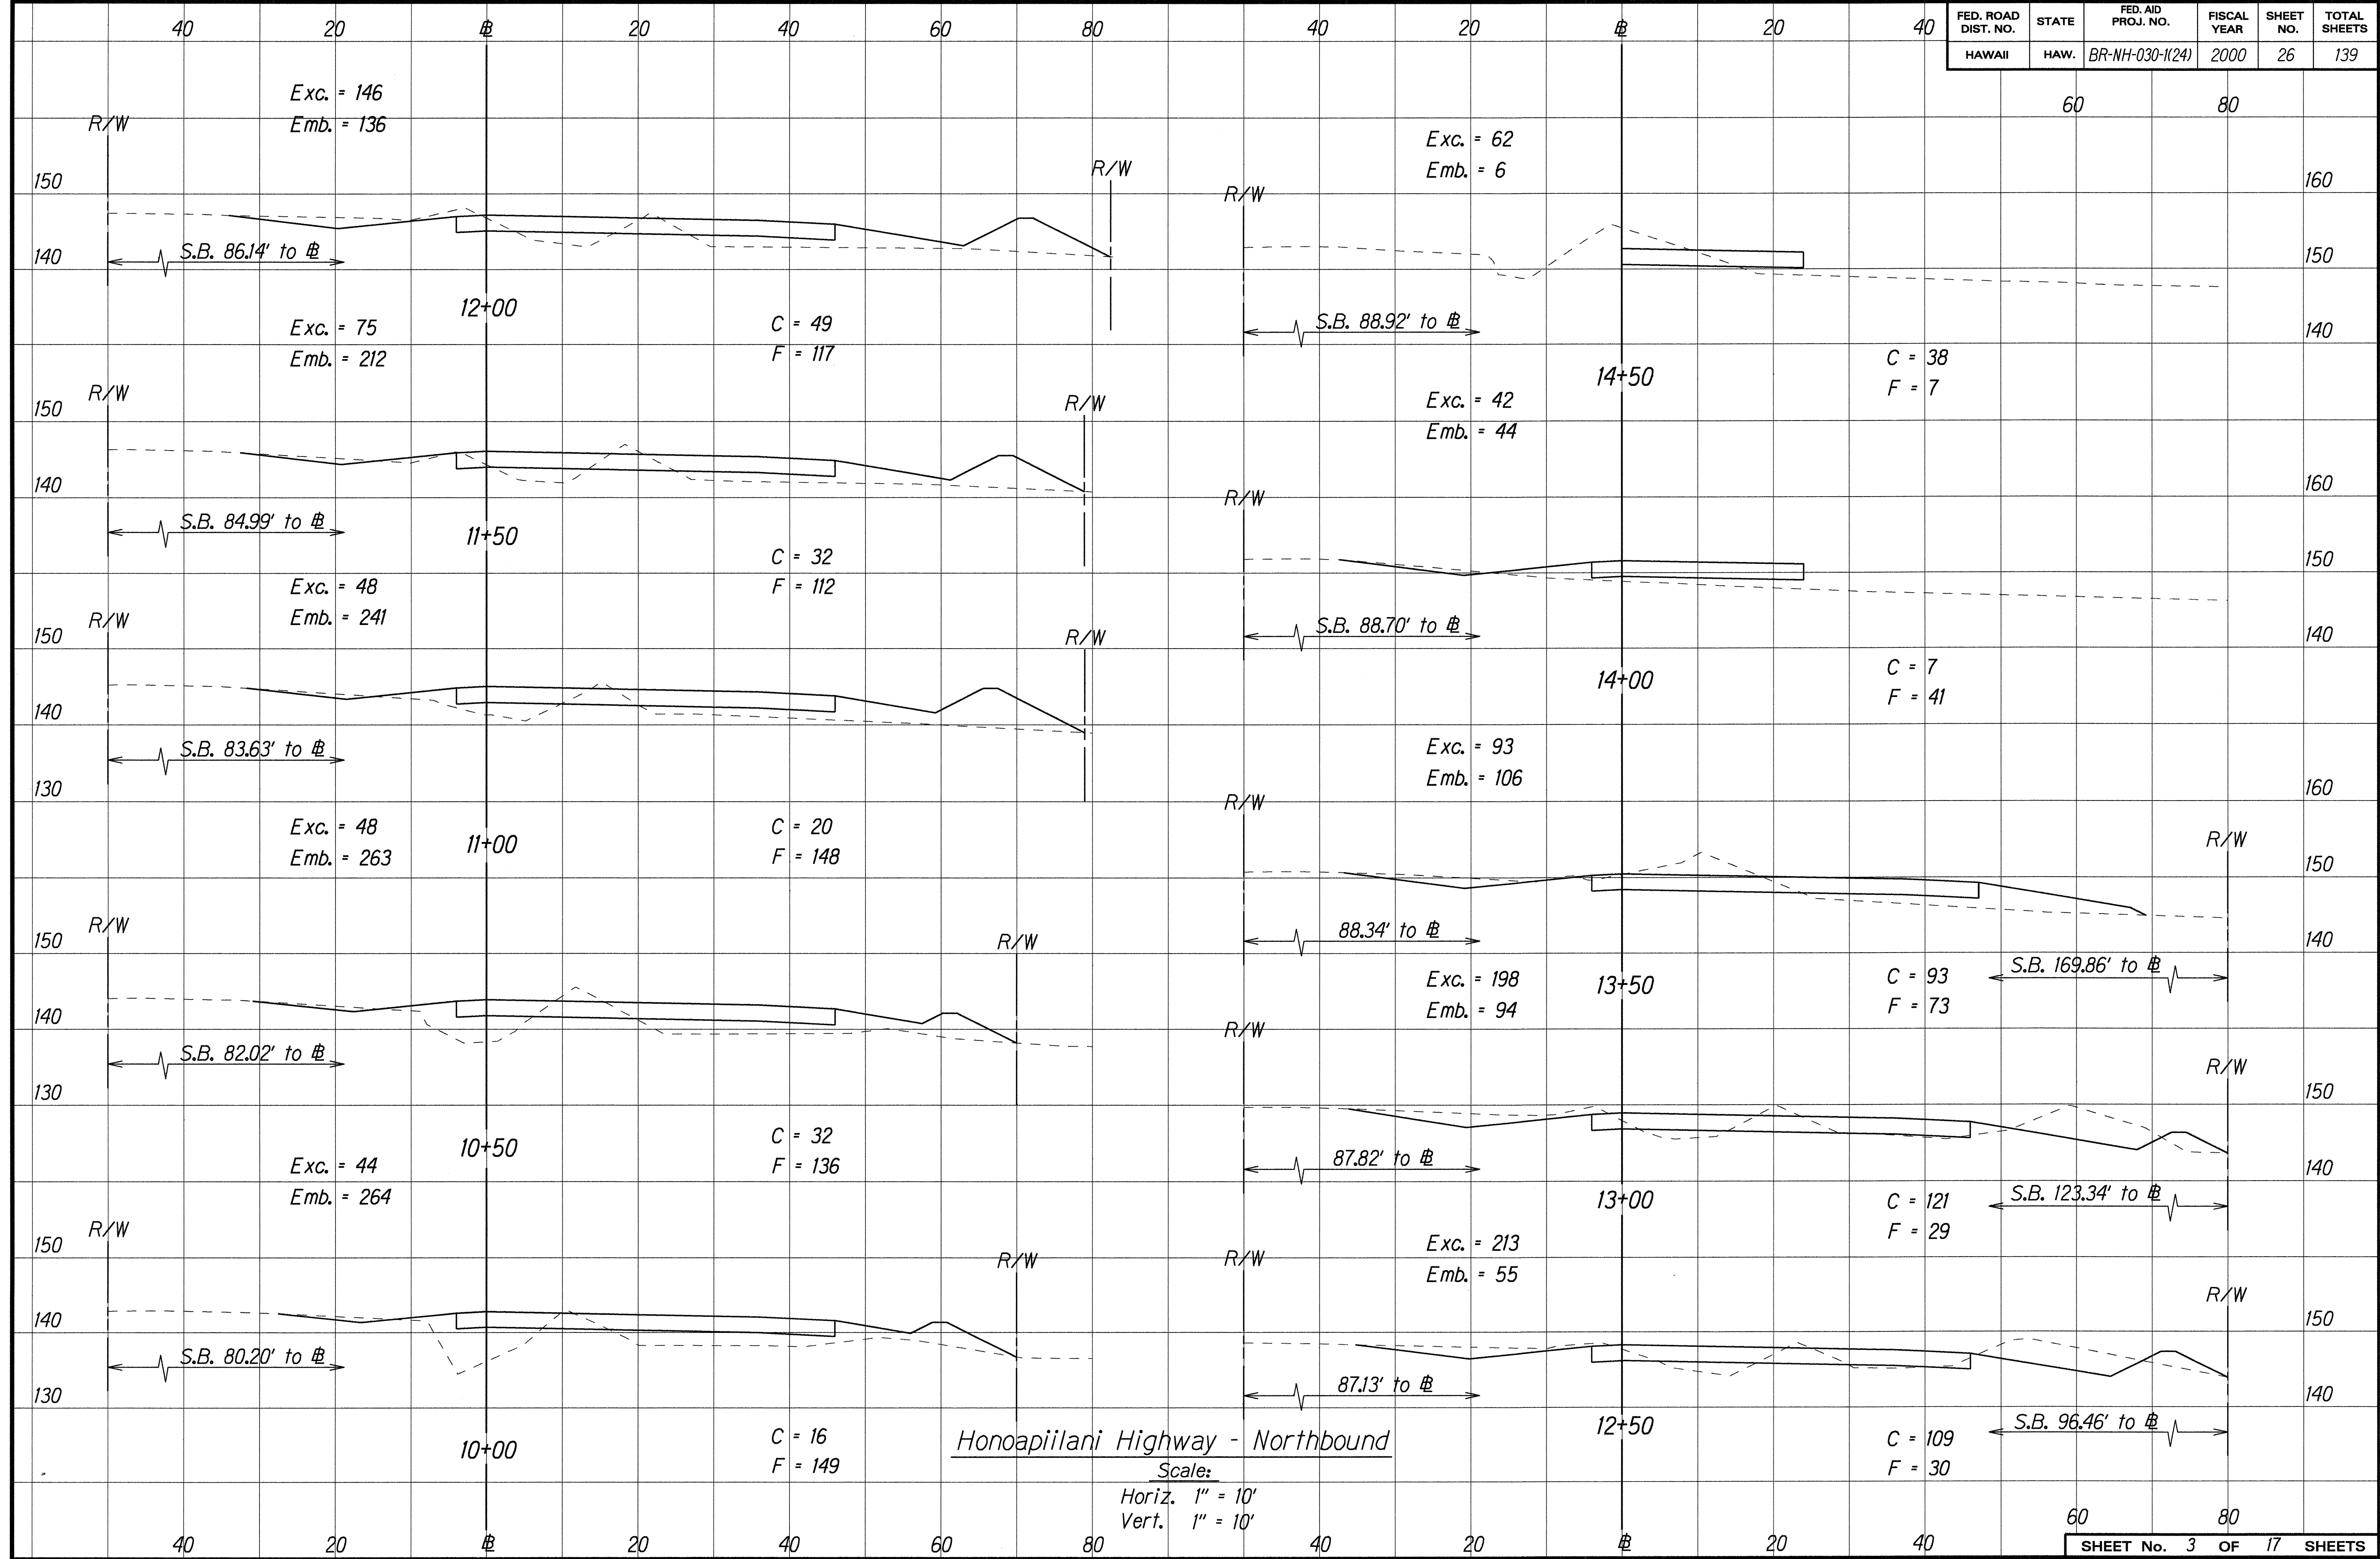

SURVEY PLOTTED BY: DATE: 11-14-97
 DRAWN BY: K. Tanaka
 CHECKED BY: REVIEWED BY: R. Hiroaka/K. Tanaka
 NOTE BOOK: cd241
 ORIGINAL PLAN: cd241
 CHECKED BY: N. Honda/s3

FED. ROAD DIST. NO.	STATE	FED. AID PROJ. NO.	FISCAL YEAR	SHEET NO.	TOTAL SHEETS
HAWAII	HAW.	BR-NH-030-1(24)	2000	27	139

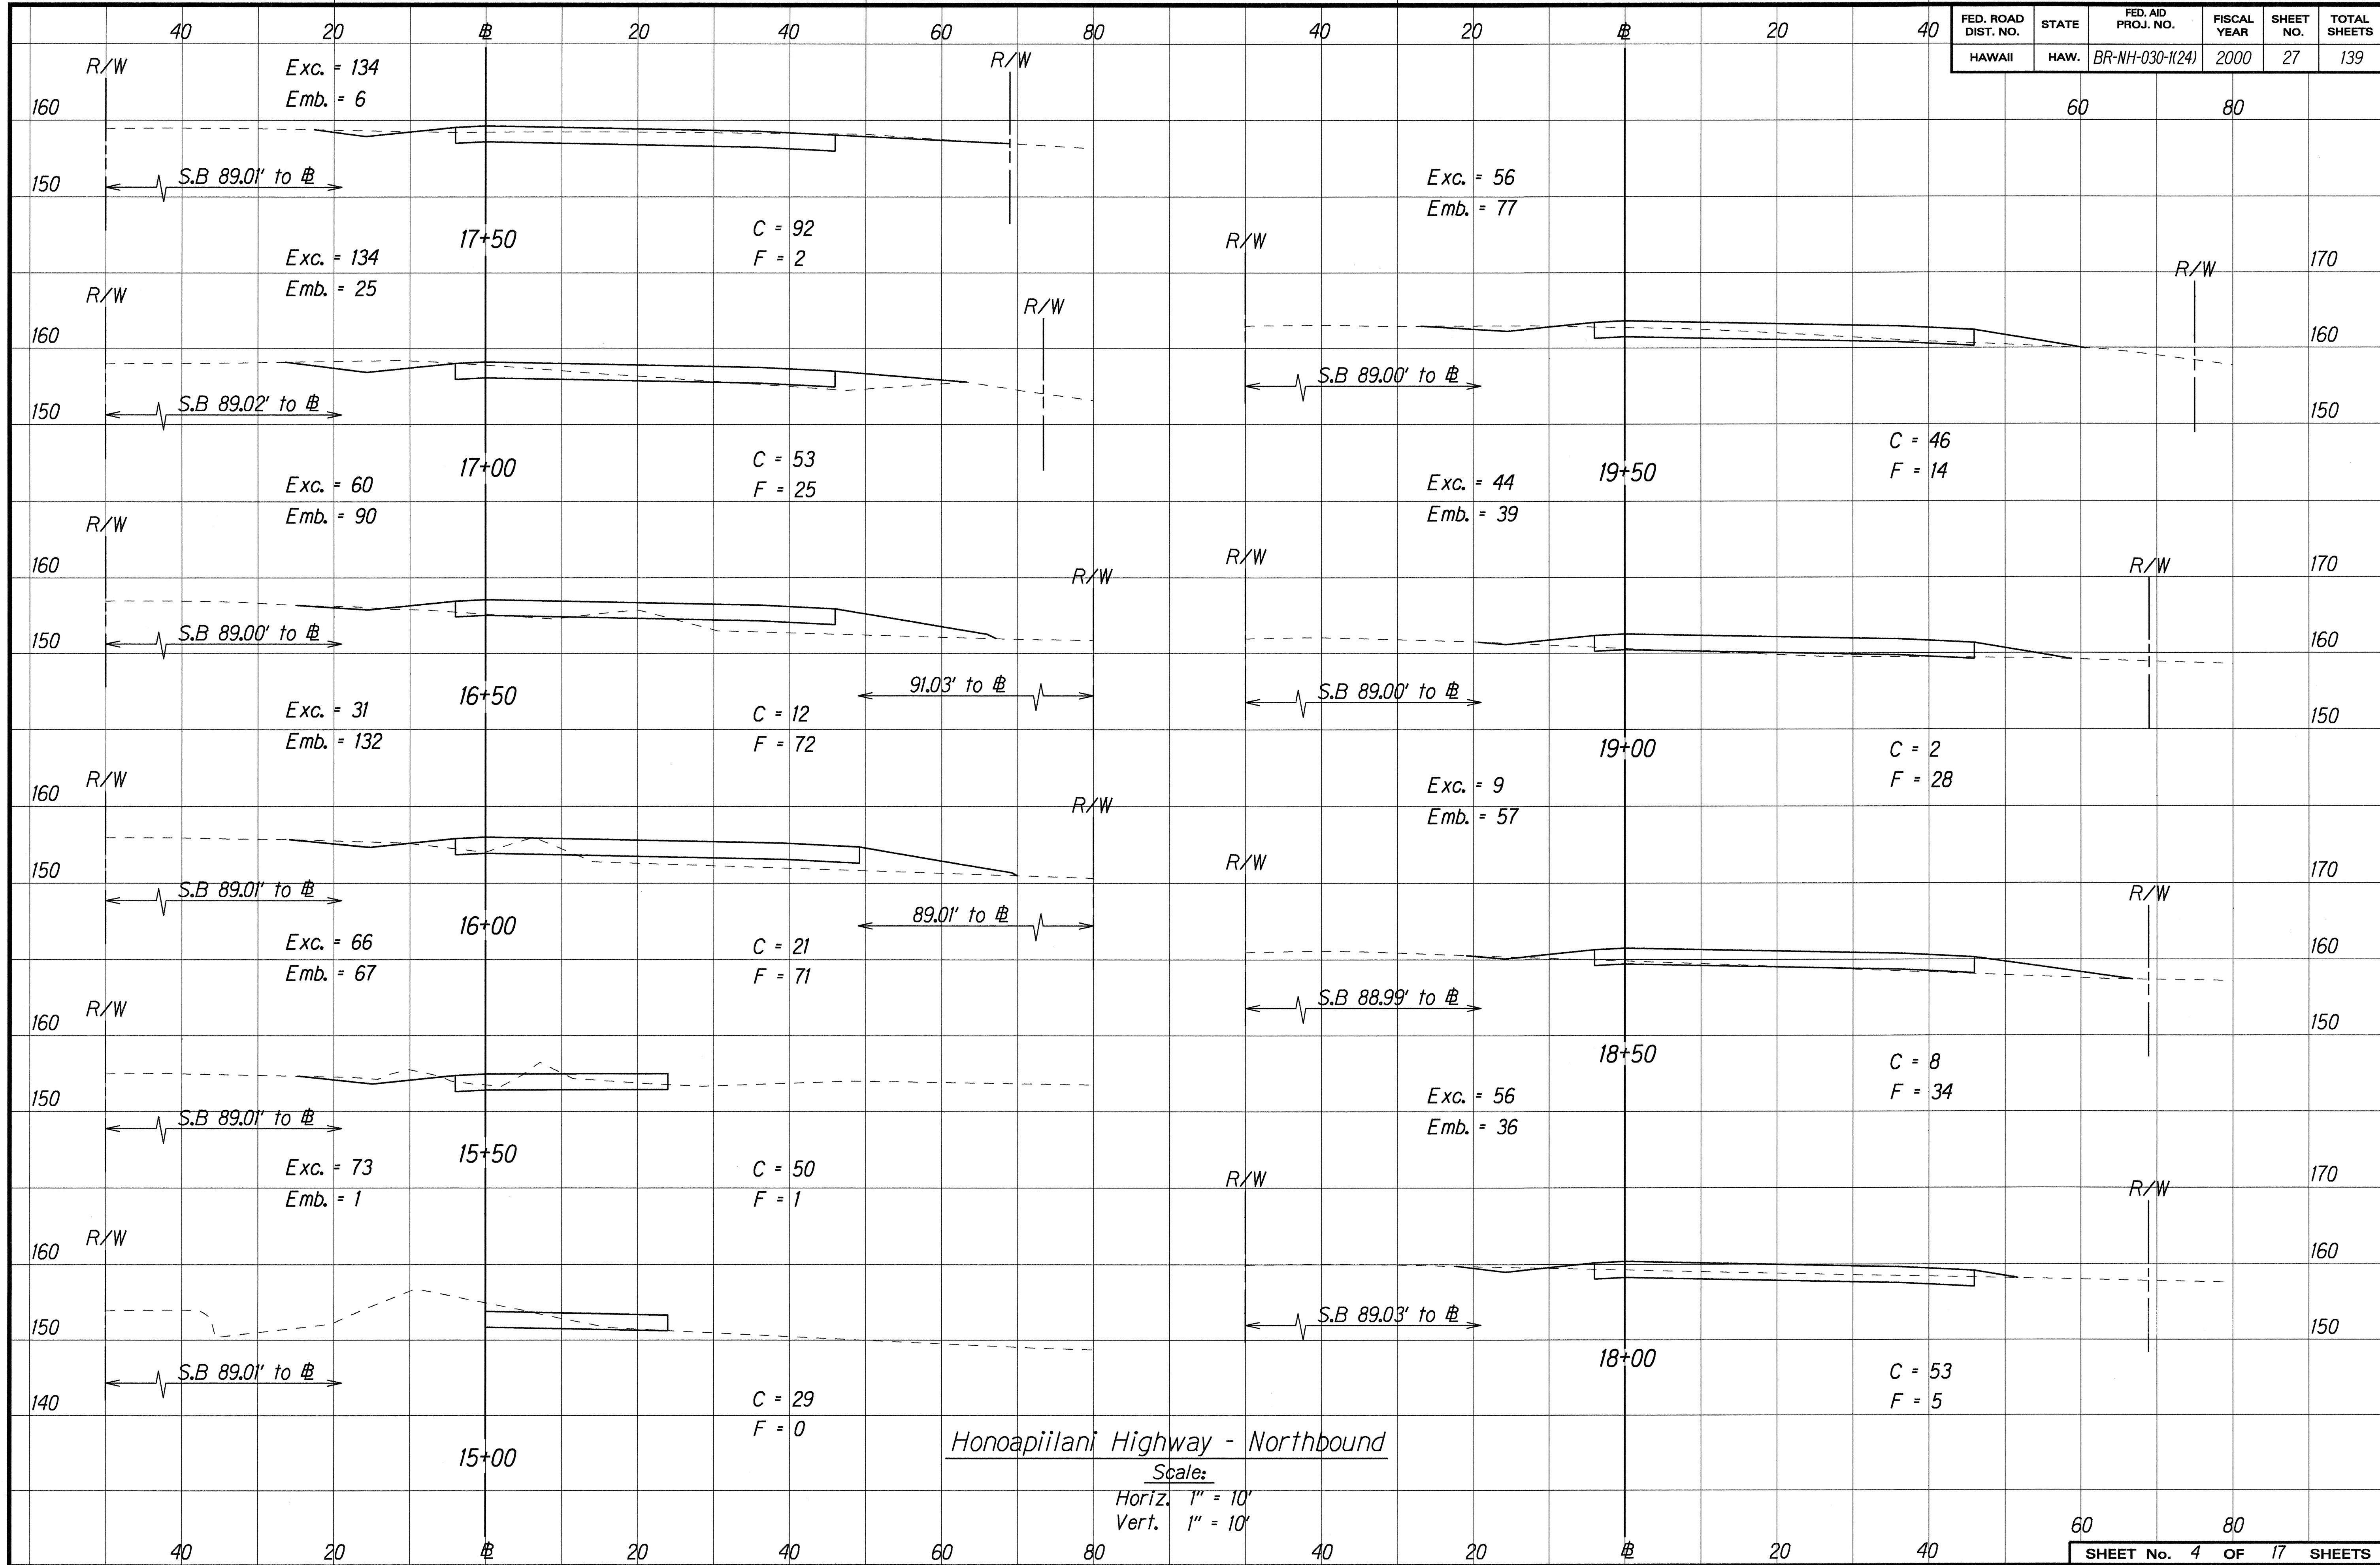


Honoapiilani Highway - Northbound

Scale:

Horiz. 1" = 10'
Vert. 1" = 10'


ORIGINAL PLAN
DATE 12/3/92
DRAWN BY K. Imai
CHECKED BY B. Hirose/K. Imai
NOTED BY B. Hirose/K. Imai
QUANTITIES BY B. Hirose/K. Imai
CHECKED BY B. Hirose/K. Imai

FED. ROAD DIST. NO.	STATE	FED. AID PROJ. NO.	FISCAL YEAR	SHEET NO.	TOTAL SHEETS
HAWAII	HAW.	BR-NH-030-1(24)	2000	28	139

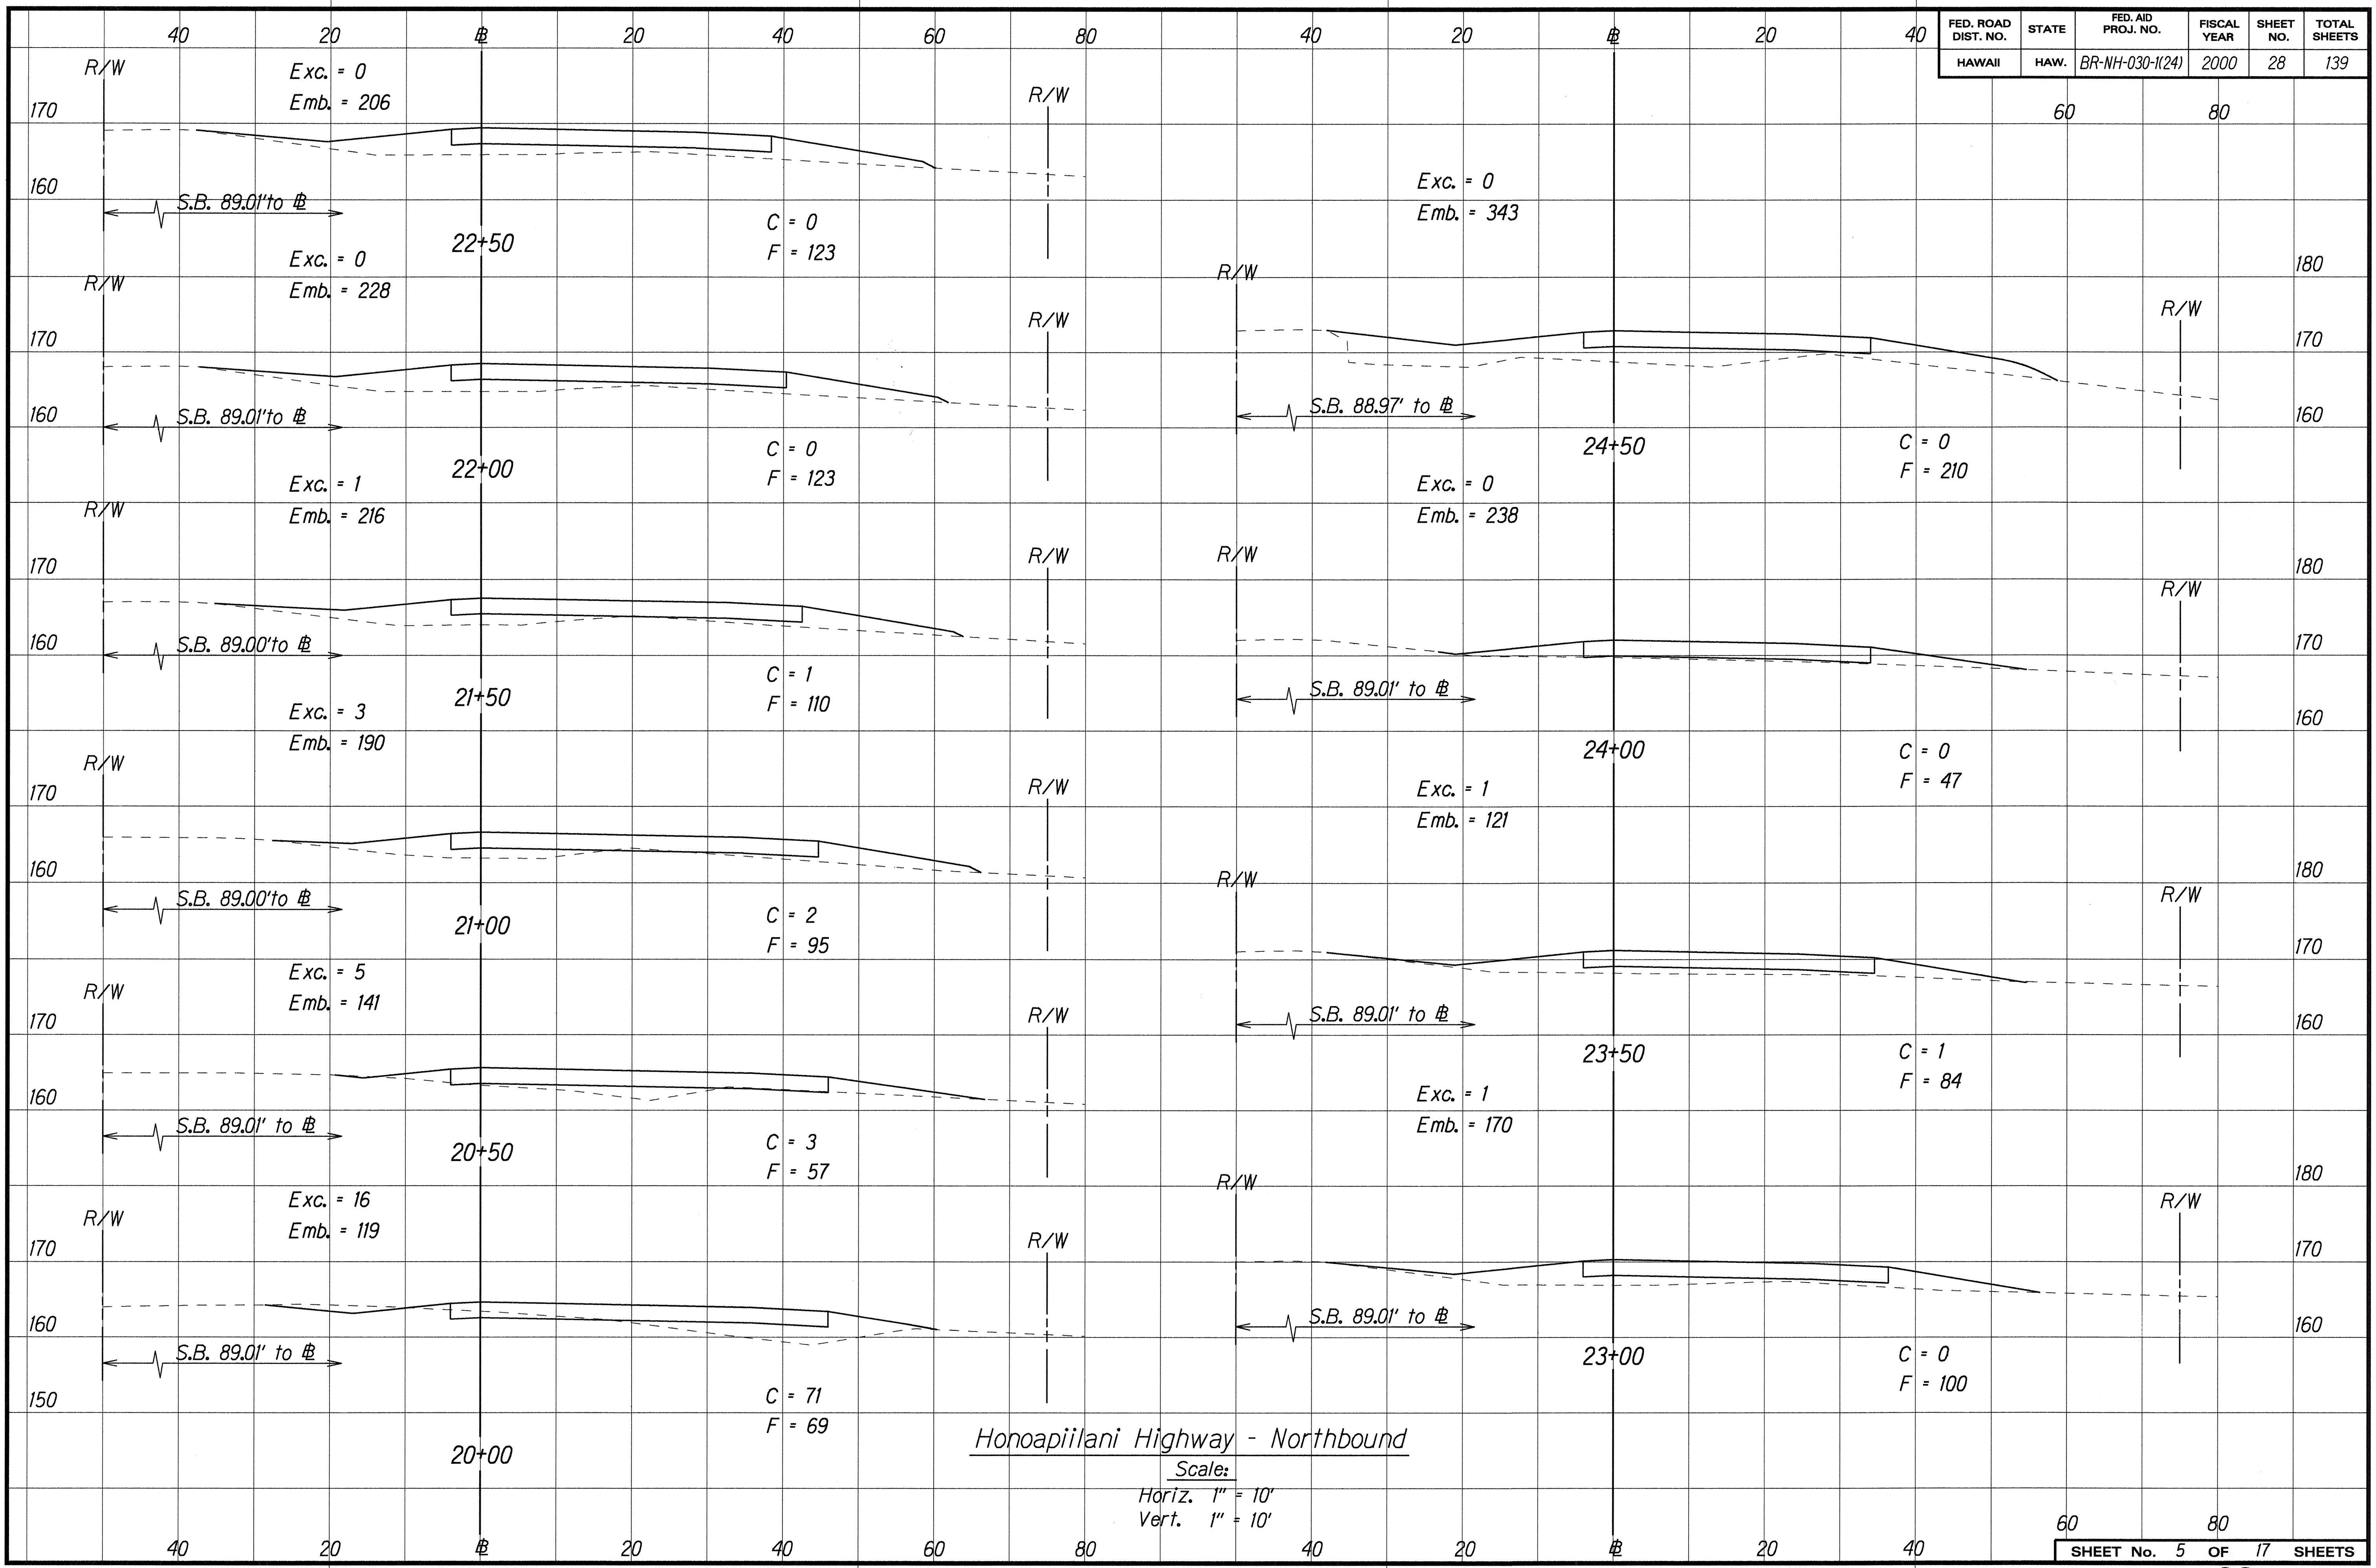


SURVEY PLOTTED BY: DATE: 10/22/93
 DRAWN BY: K. Tanaka
 CHECKED BY: B. Hirooka/K. Tanaka
 NOTE: 60241
 QUANTITIES BY: N. Hironaka

FED. ROAD DIST. NO.	STATE	FED. AID PROJ. NO.	FISCAL YEAR	SHEET NO.	TOTAL SHEETS
HAWAII	HAW.	BR-NH-030-1(24)	2000	29	139

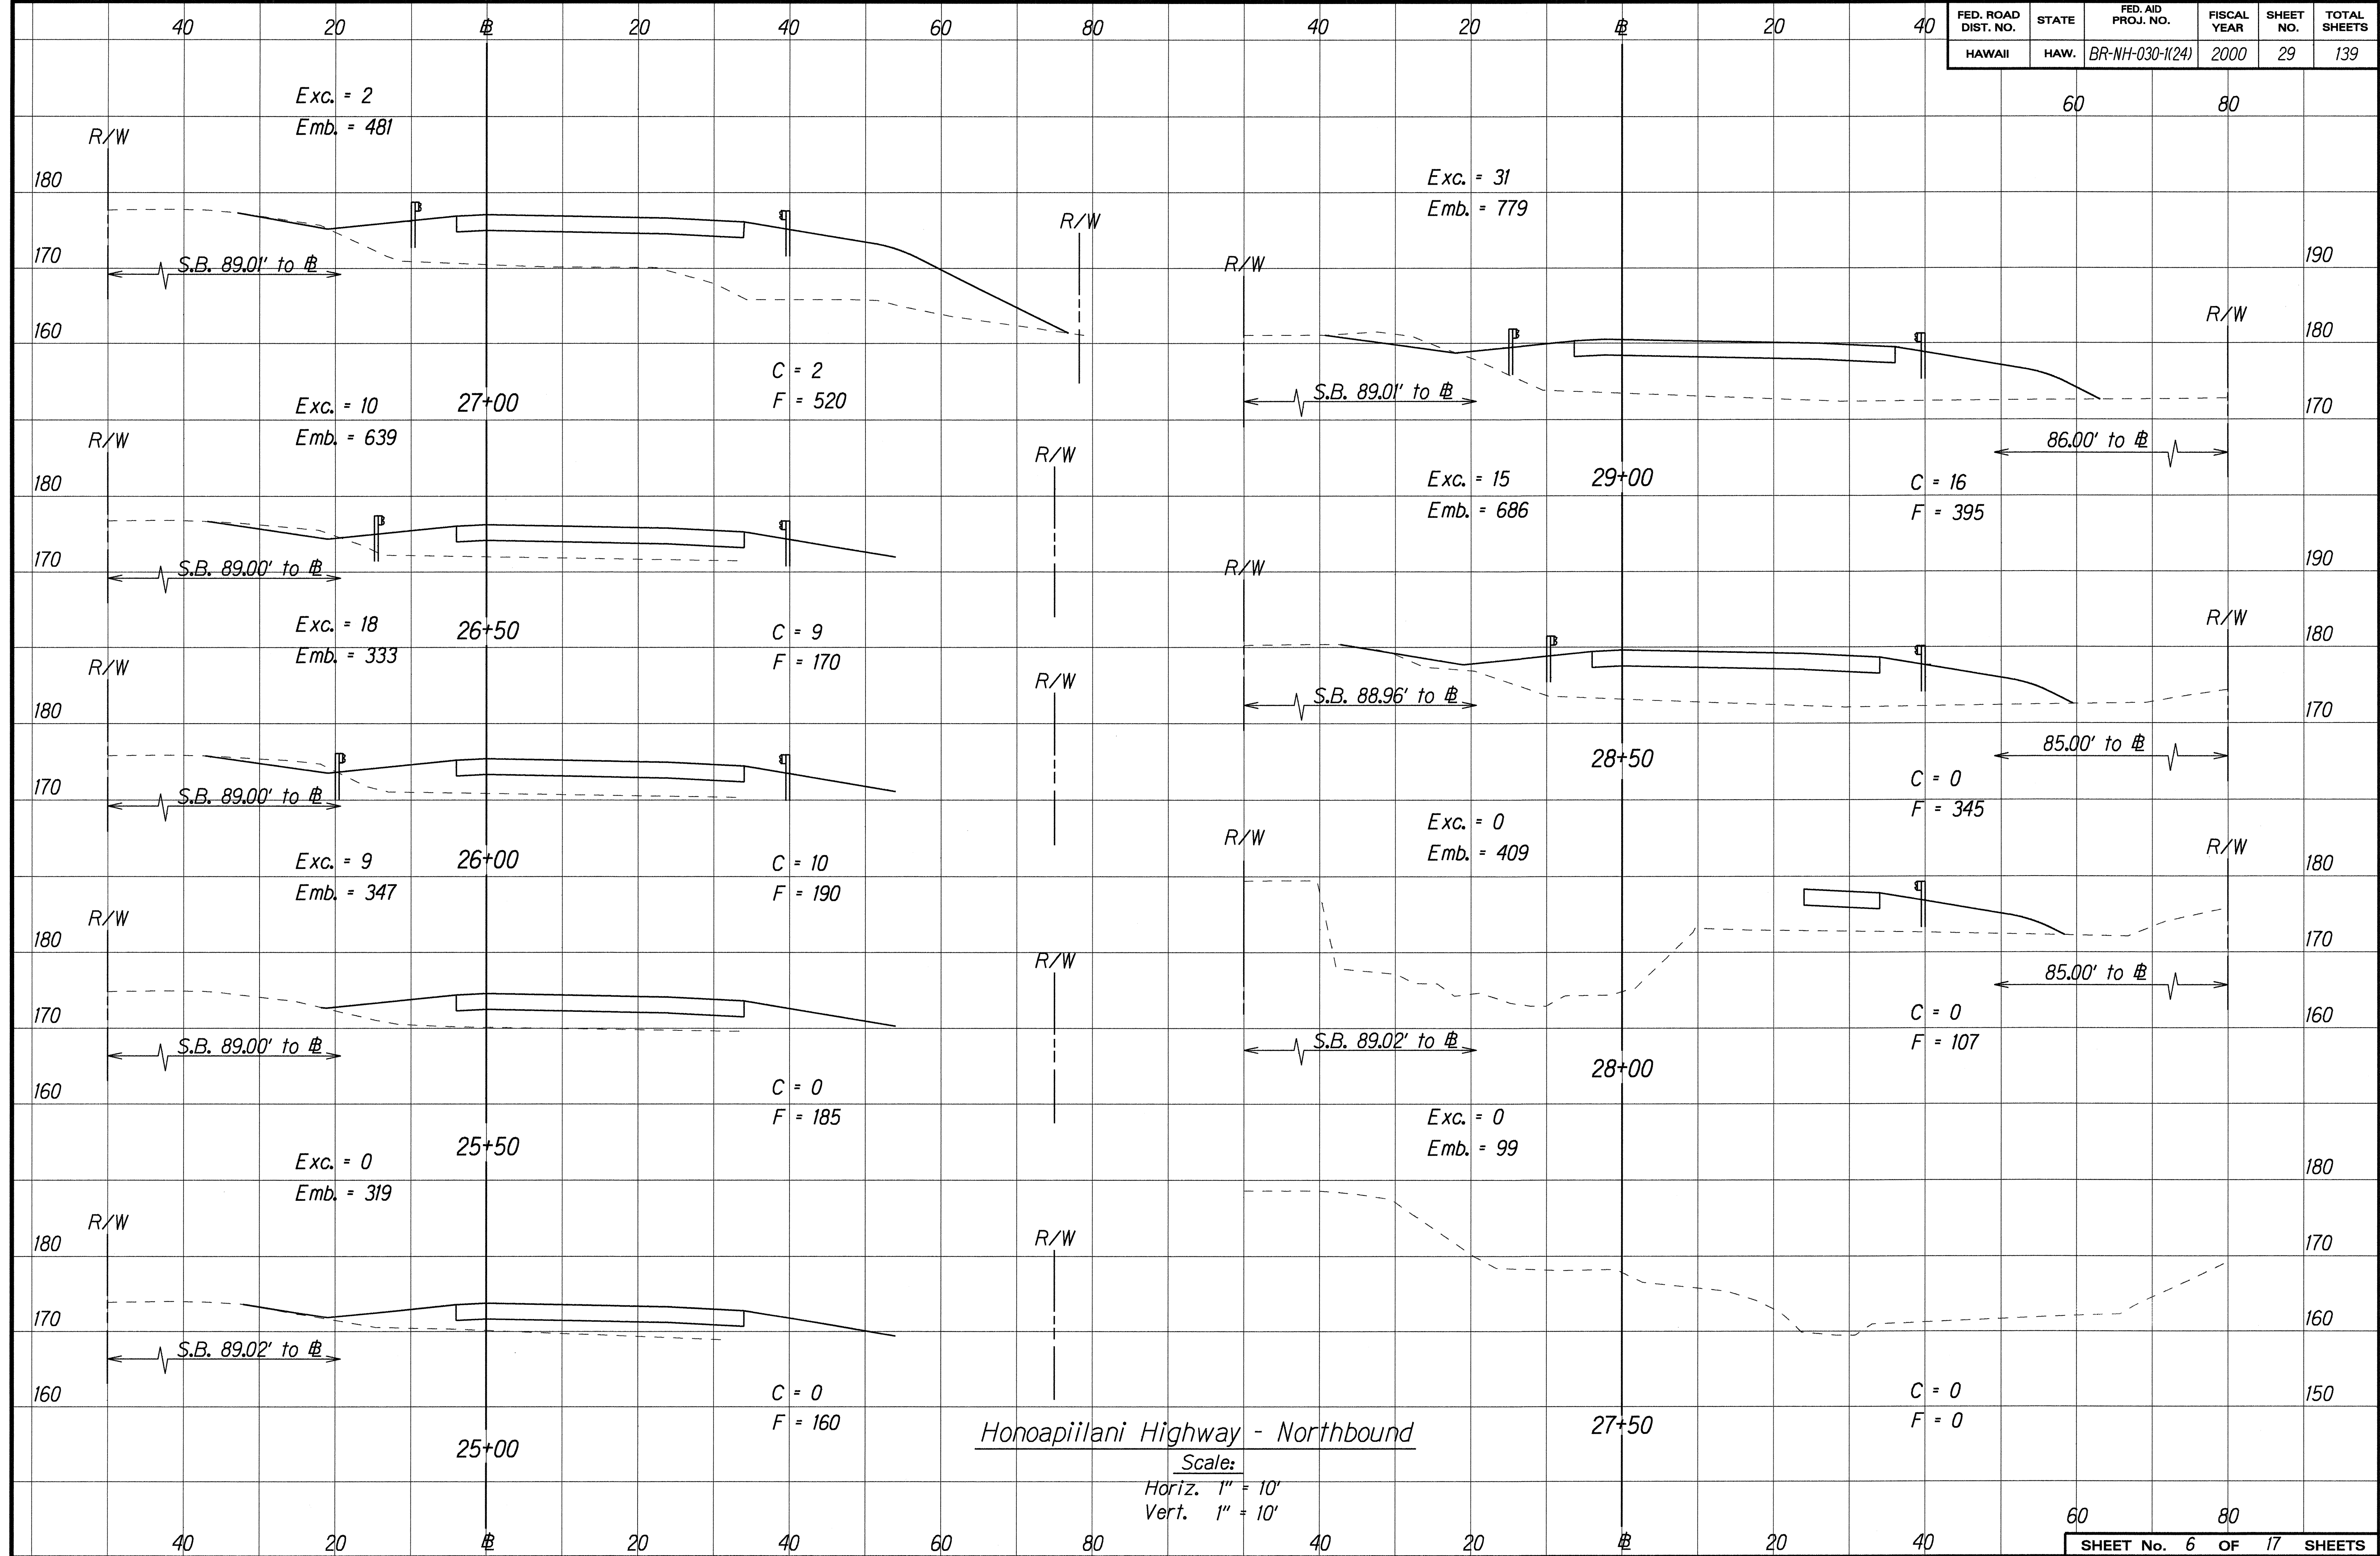


SURVEY PLOTTED BY: _____ DATE: 12/10/24
 DRAWN BY: K. Tanaka
 CHECKED BY: N. Honda
 ORIGINAL PLAN: _____
 NOTE BOOK: 00241
 QUANTITIES BY: _____
 CHECKED BY: _____

FED. ROAD DIST. NO.	STATE	FED. AID PROJ. NO.	FISCAL YEAR	SHEET NO.	TOTAL SHEETS
HAWAII	HAW.	BR-NH-030-1(24)	2000	31	139

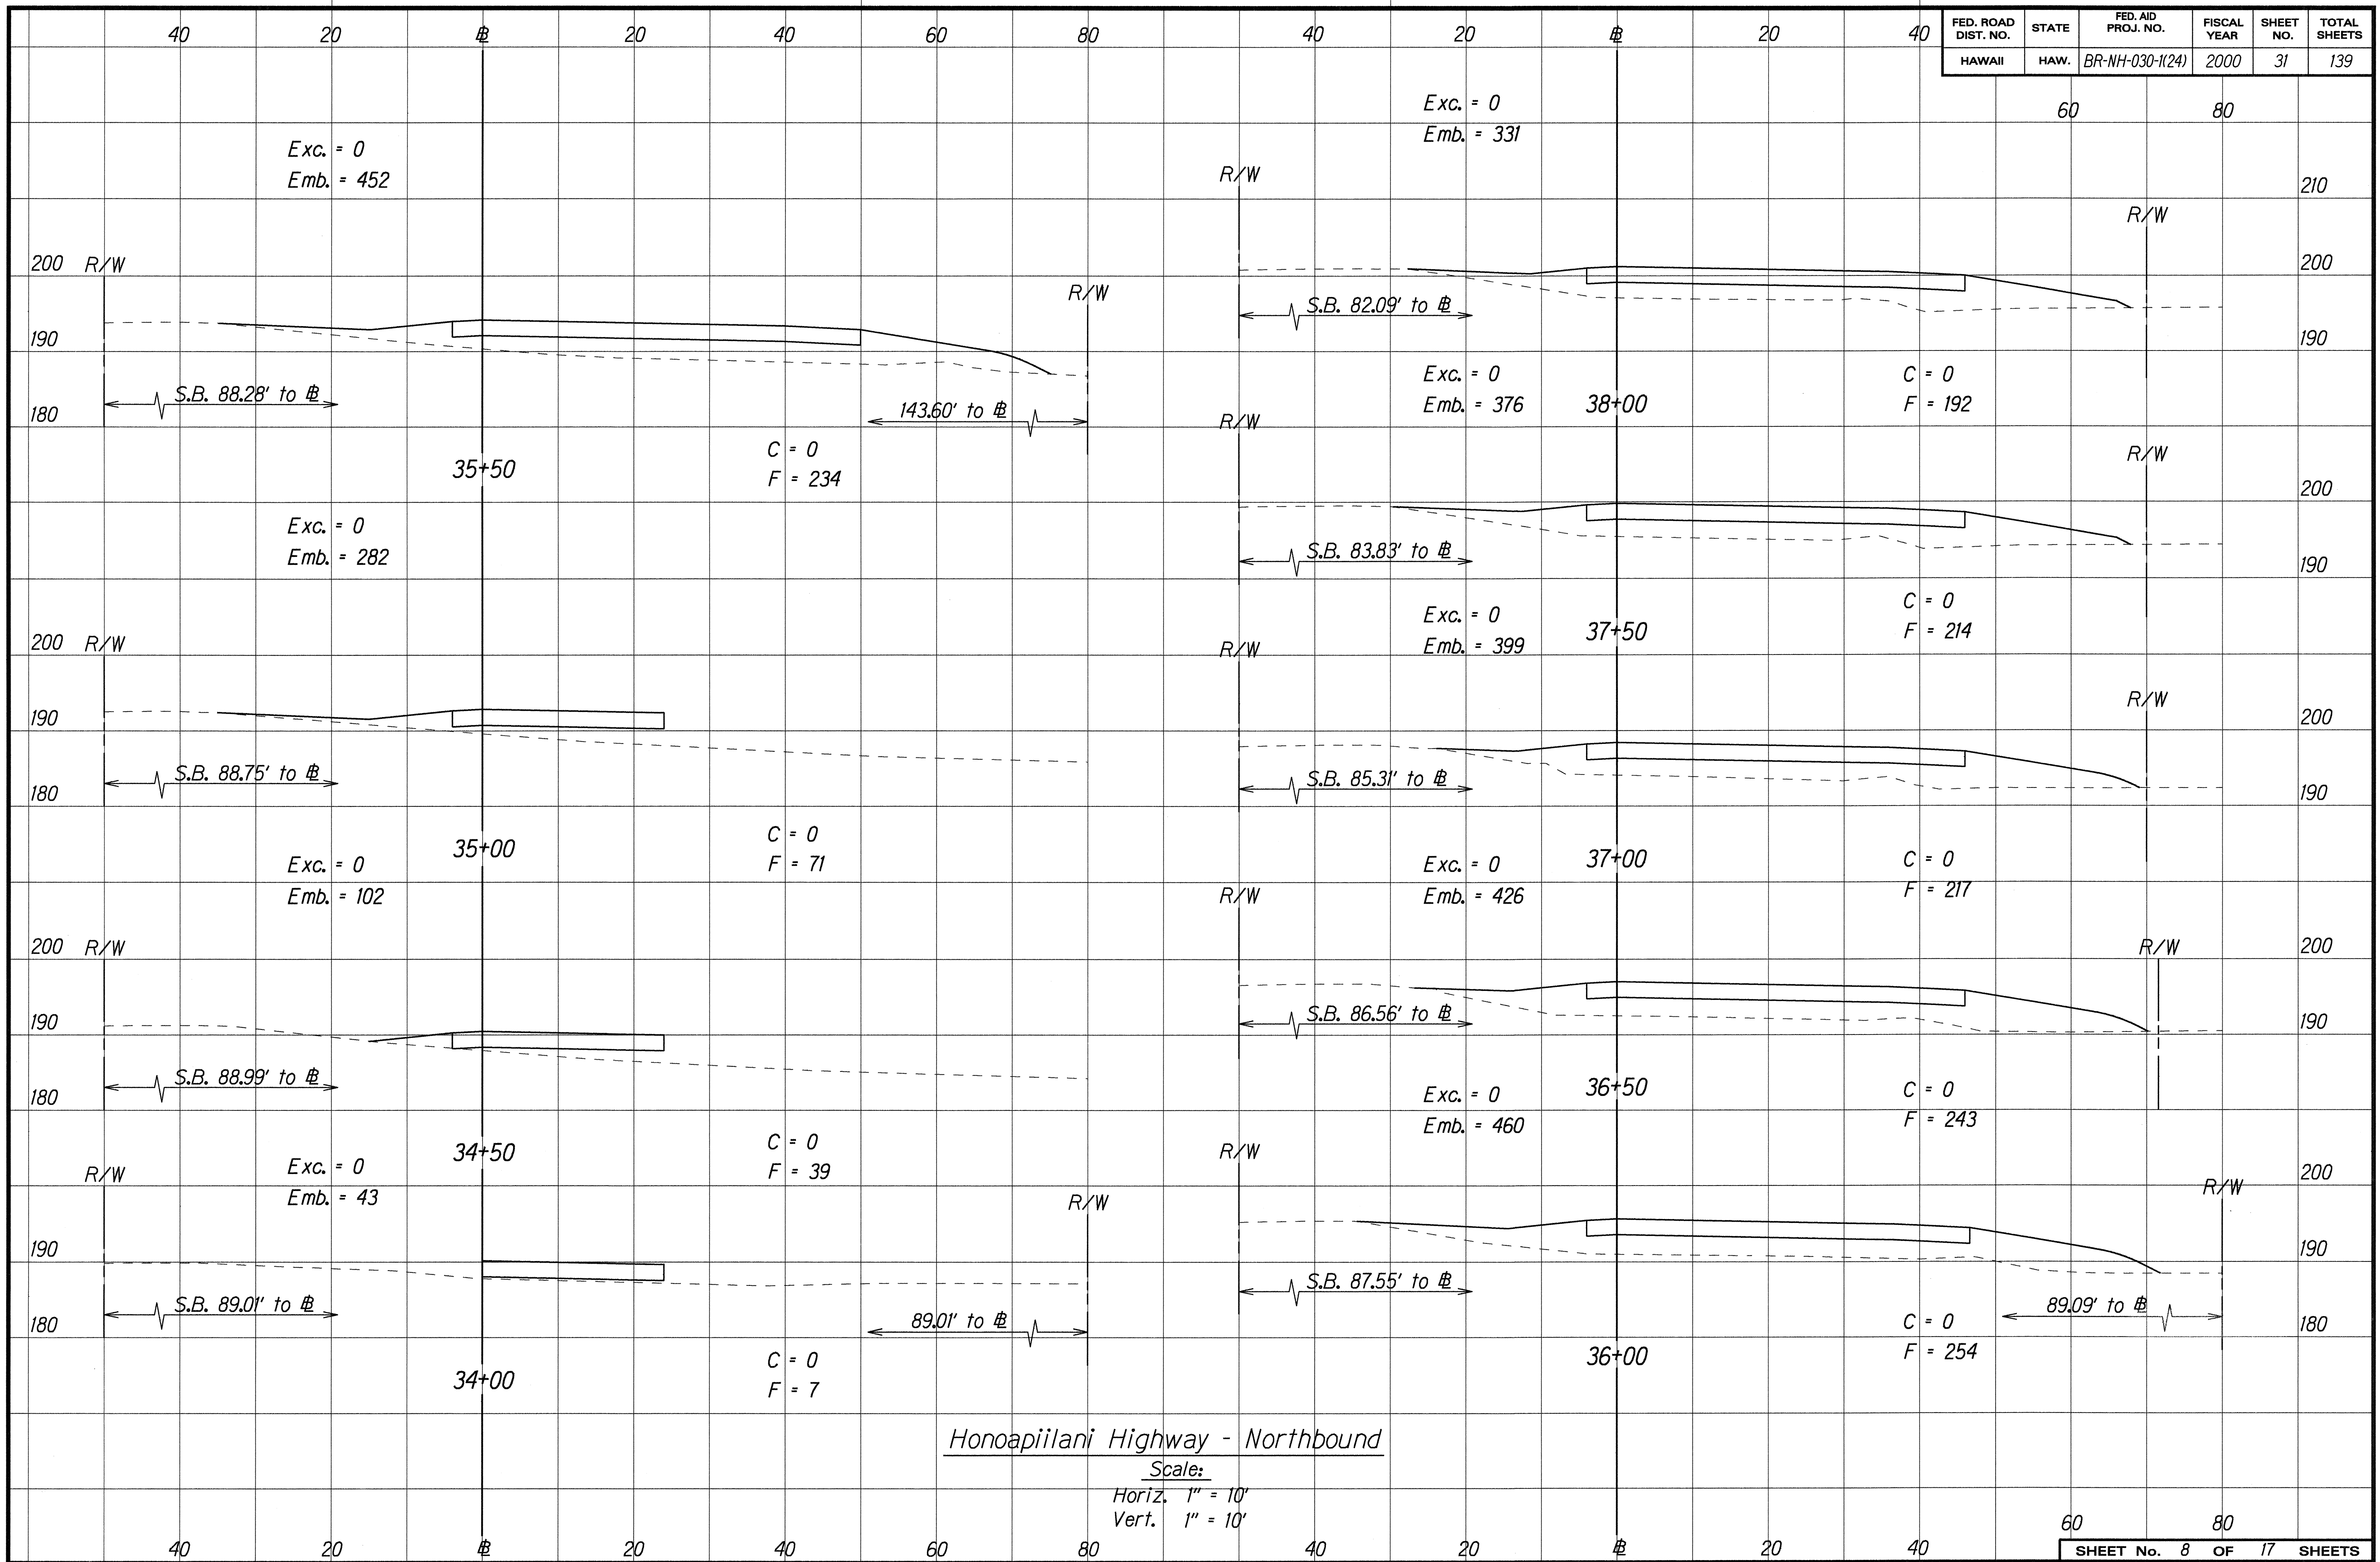


ORIGINAL
PLAN
DATE 11/14/97
DRAWN BY K. Tamahida
CHECKED BY R. Hironaka/K. Matsubuchi
NOTES BOOK 00241
QUANTITIES BY 00241
CHECKED BY N. Hironaka

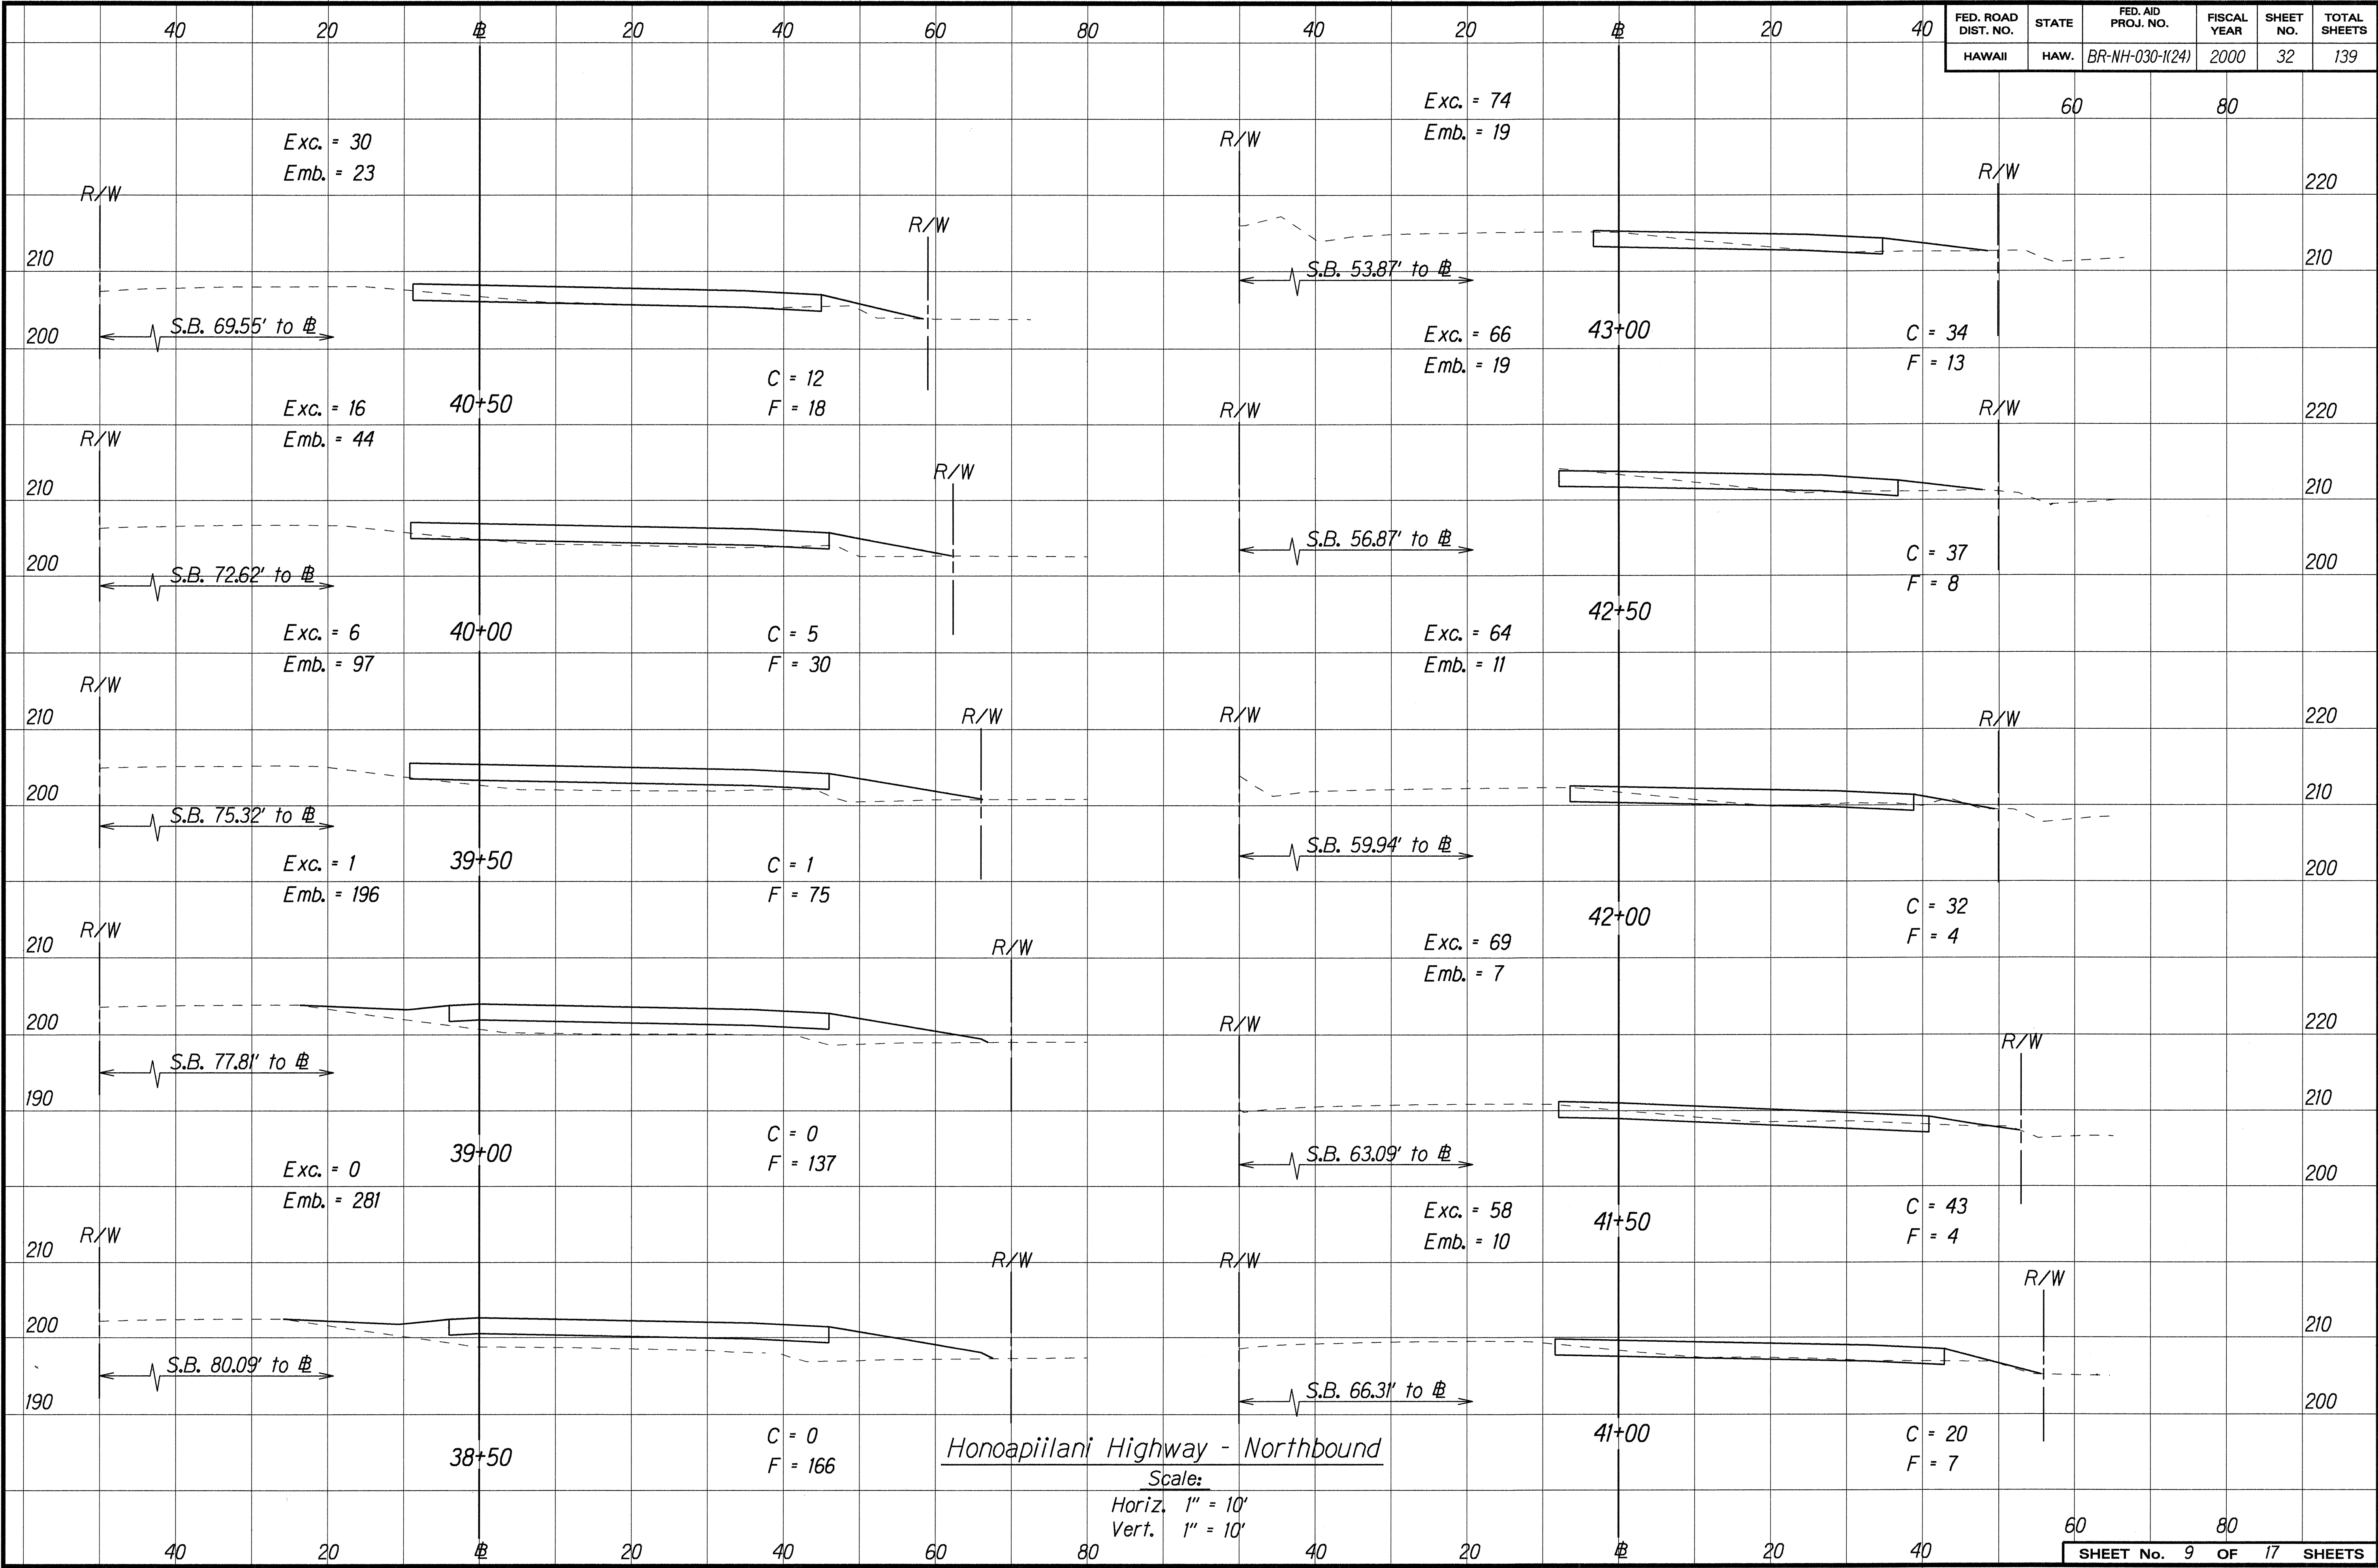

SURVEY PLANNED BY: DATE: 11/14/97
DRAWN BY: K. Tanaka
CHECKED BY: R. Hirooka/K. Tanaka
NOTED BY: 04/24/01
N. Honda/KS9

FED. ROAD DIST. NO.	STATE	FED. AID PROJ. NO.	FISCAL YEAR	SHEET NO.	TOTAL SHEETS
HAWAII	HAW.	BR-NH-030-K(24)	2000	33	139


LEGEND FOR AS-BUILT POSTINGS	
	Squiggly line for as-built deletion
	Double line for as-built deletion
Roadway	Text for as-built posting

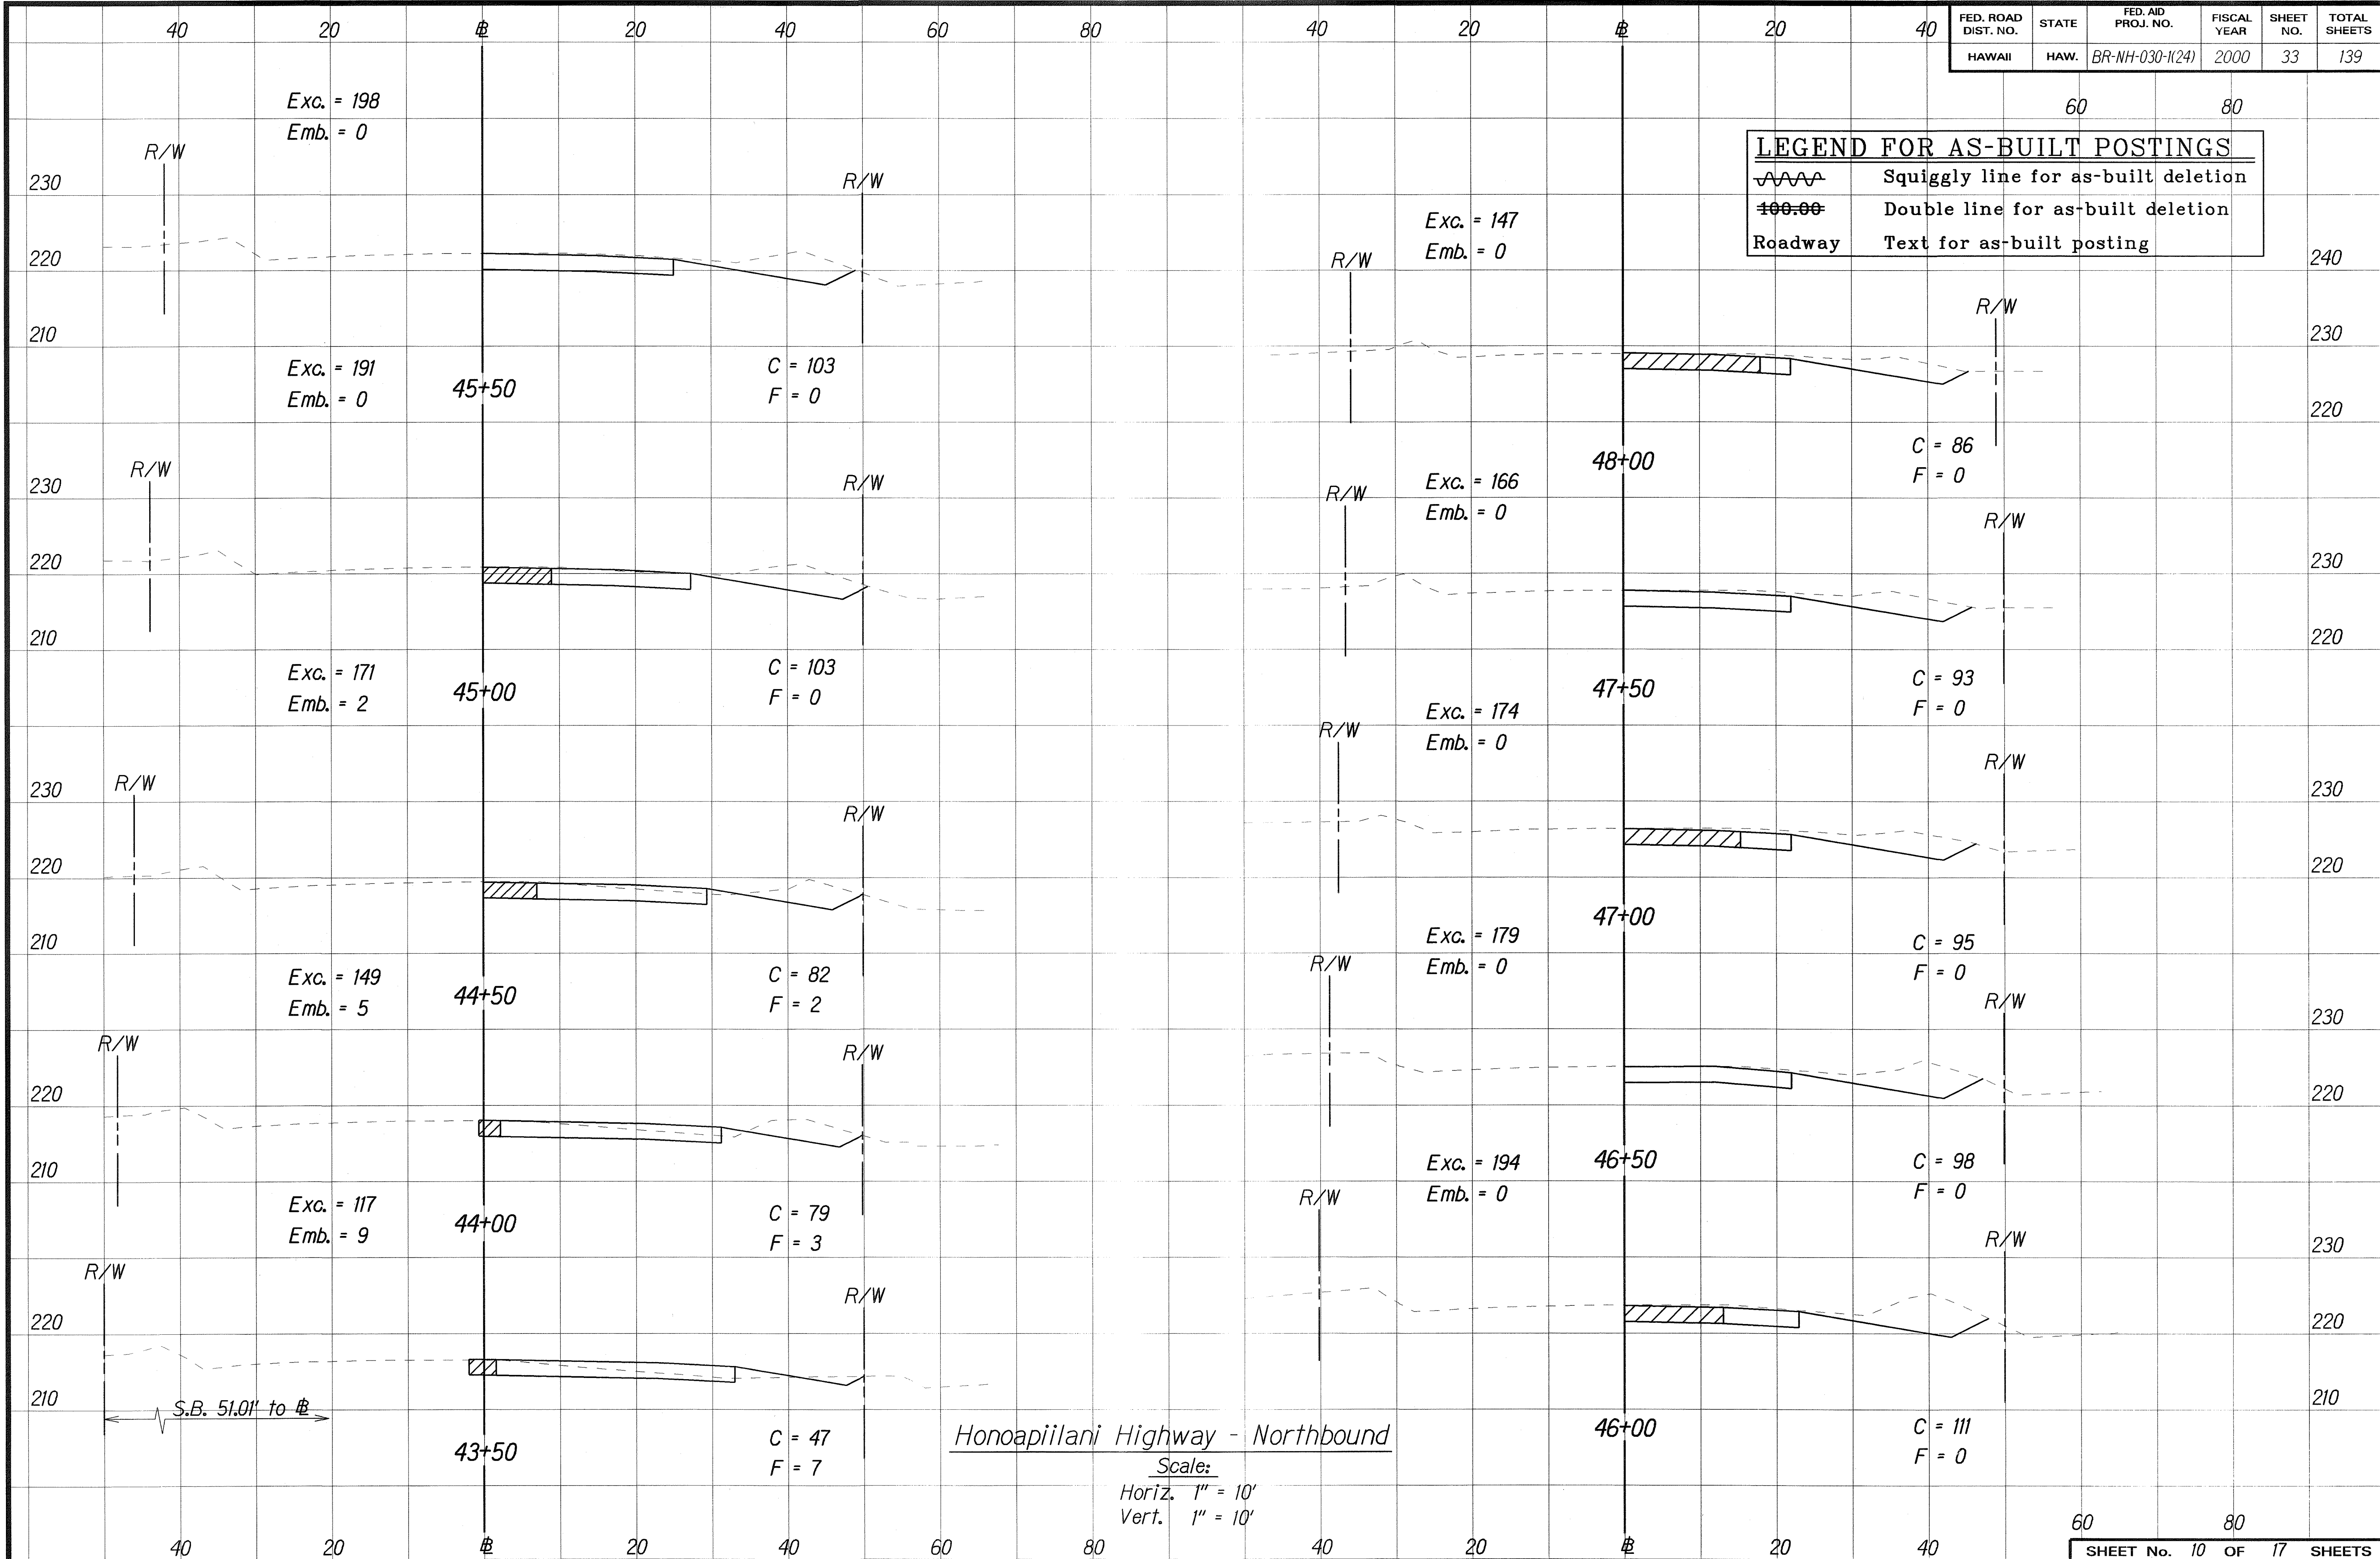

ORIGINAL PLAN
 SURVEY PLOTTED BY
 DRAWN BY
 TRACED BY
 NOTE BOOK
 QUANTITIES BY
 CHECKED BY


"AS-BUILT"

40	60		
----	----	--	--

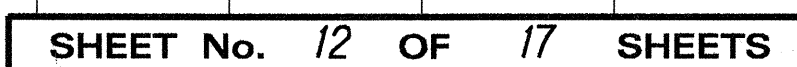

ORIGINAL PLAN	SURVEY PLOTTED BY	DATE
	DRAWN BY <i>K. Candhiata / J.M.</i>	<i>12-25-98</i>
NOTE BOOK	TRACED BY	
<i>dd24</i>	DESIGNED BY <i>R. Hironaka / K. Tatsuyuchi</i>	
<i>phonaxls2</i>	QUANTITIES BY	
	CHECKED BY	


FED. ROAD DIST. NO.	STATE	FED. AID PROJ. NO.	FISCAL YEAR	SHEET NO.	TOTAL SHEETS
HAWAII	HAW.	BR-NH-030-11(24)	2000	36	139

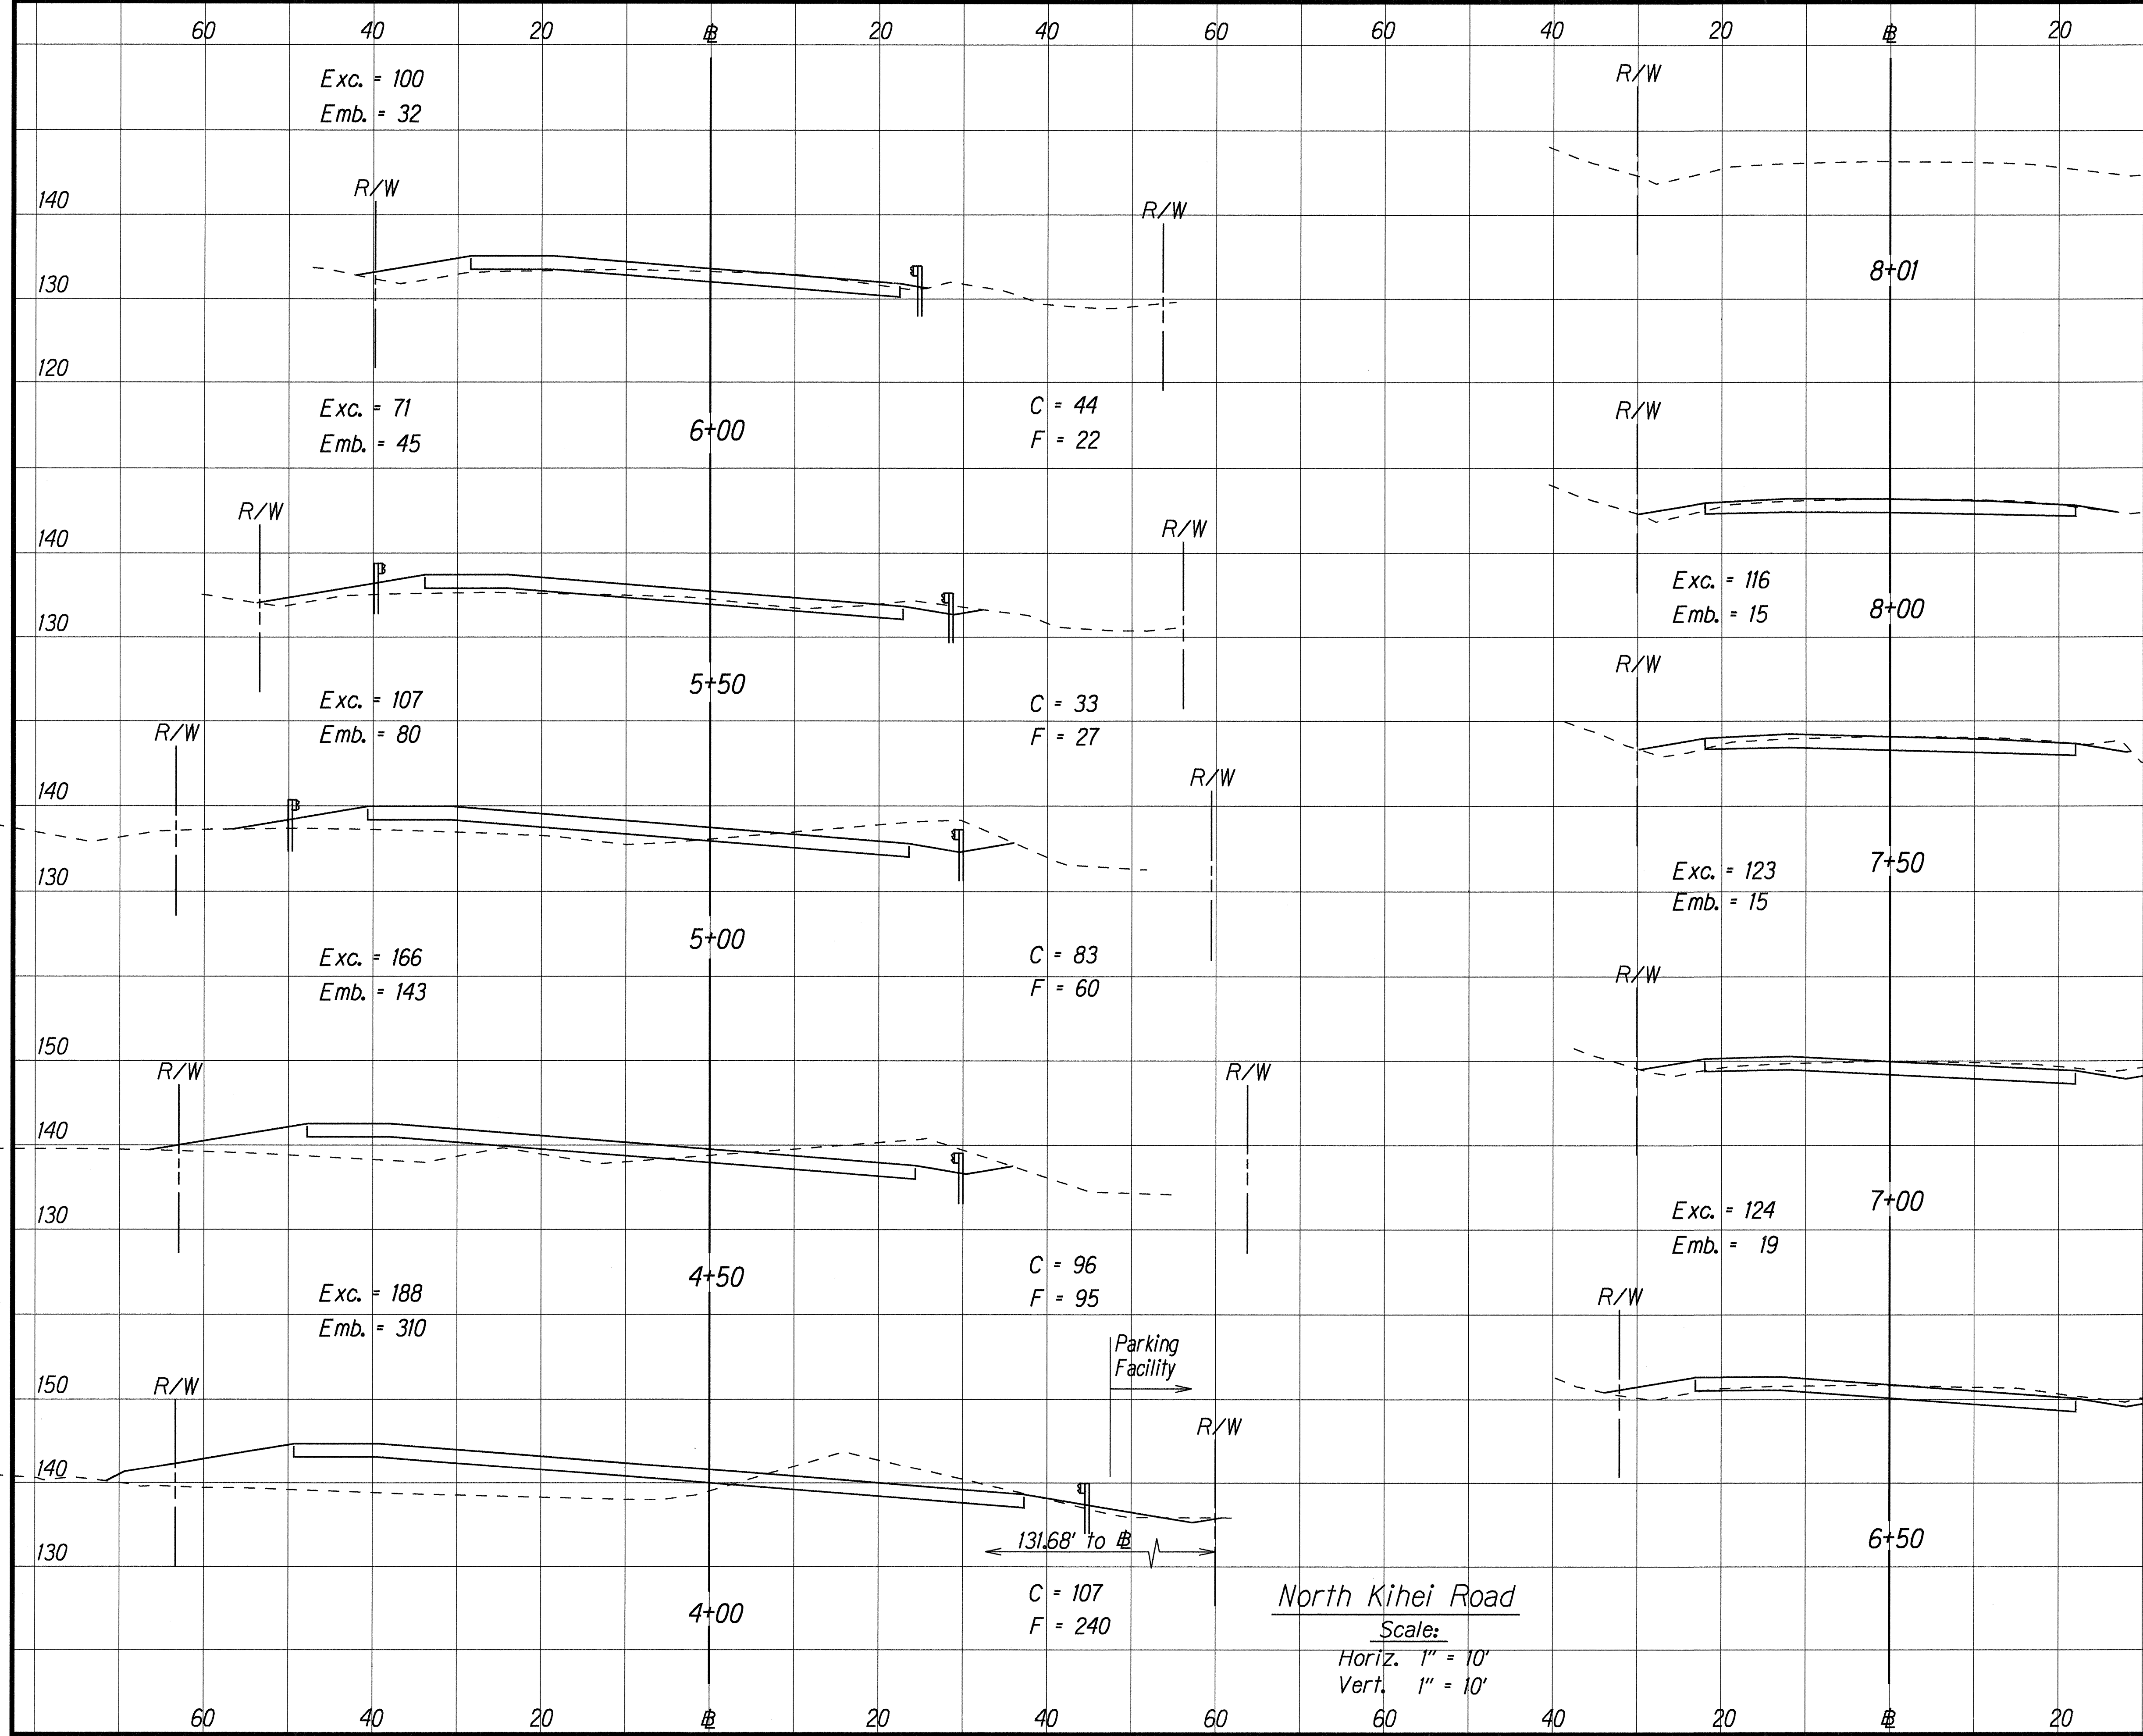

SURVEY PLOTTED BY: DATE: 12-9-2000
 DRAWN BY: K. Tomihata / J.M.
 CHECKED BY: R. Hirooka / K. Tsubouchi
 QUANTITIES BY: 00241
 CHECKED BY: N. Honda / S.13


North Kihei Road
 Scale:
 Horiz. 1" = 10'
 Vert. 1" = 10'

FED. ROAD DIST. NO.	STATE	FED. AID PROJ. NO.	FISCAL YEAR	SHEET NO.	TOTAL SHEETS
HAWAII	HAW.	BR-NH-030-1(24)	2000	37	139

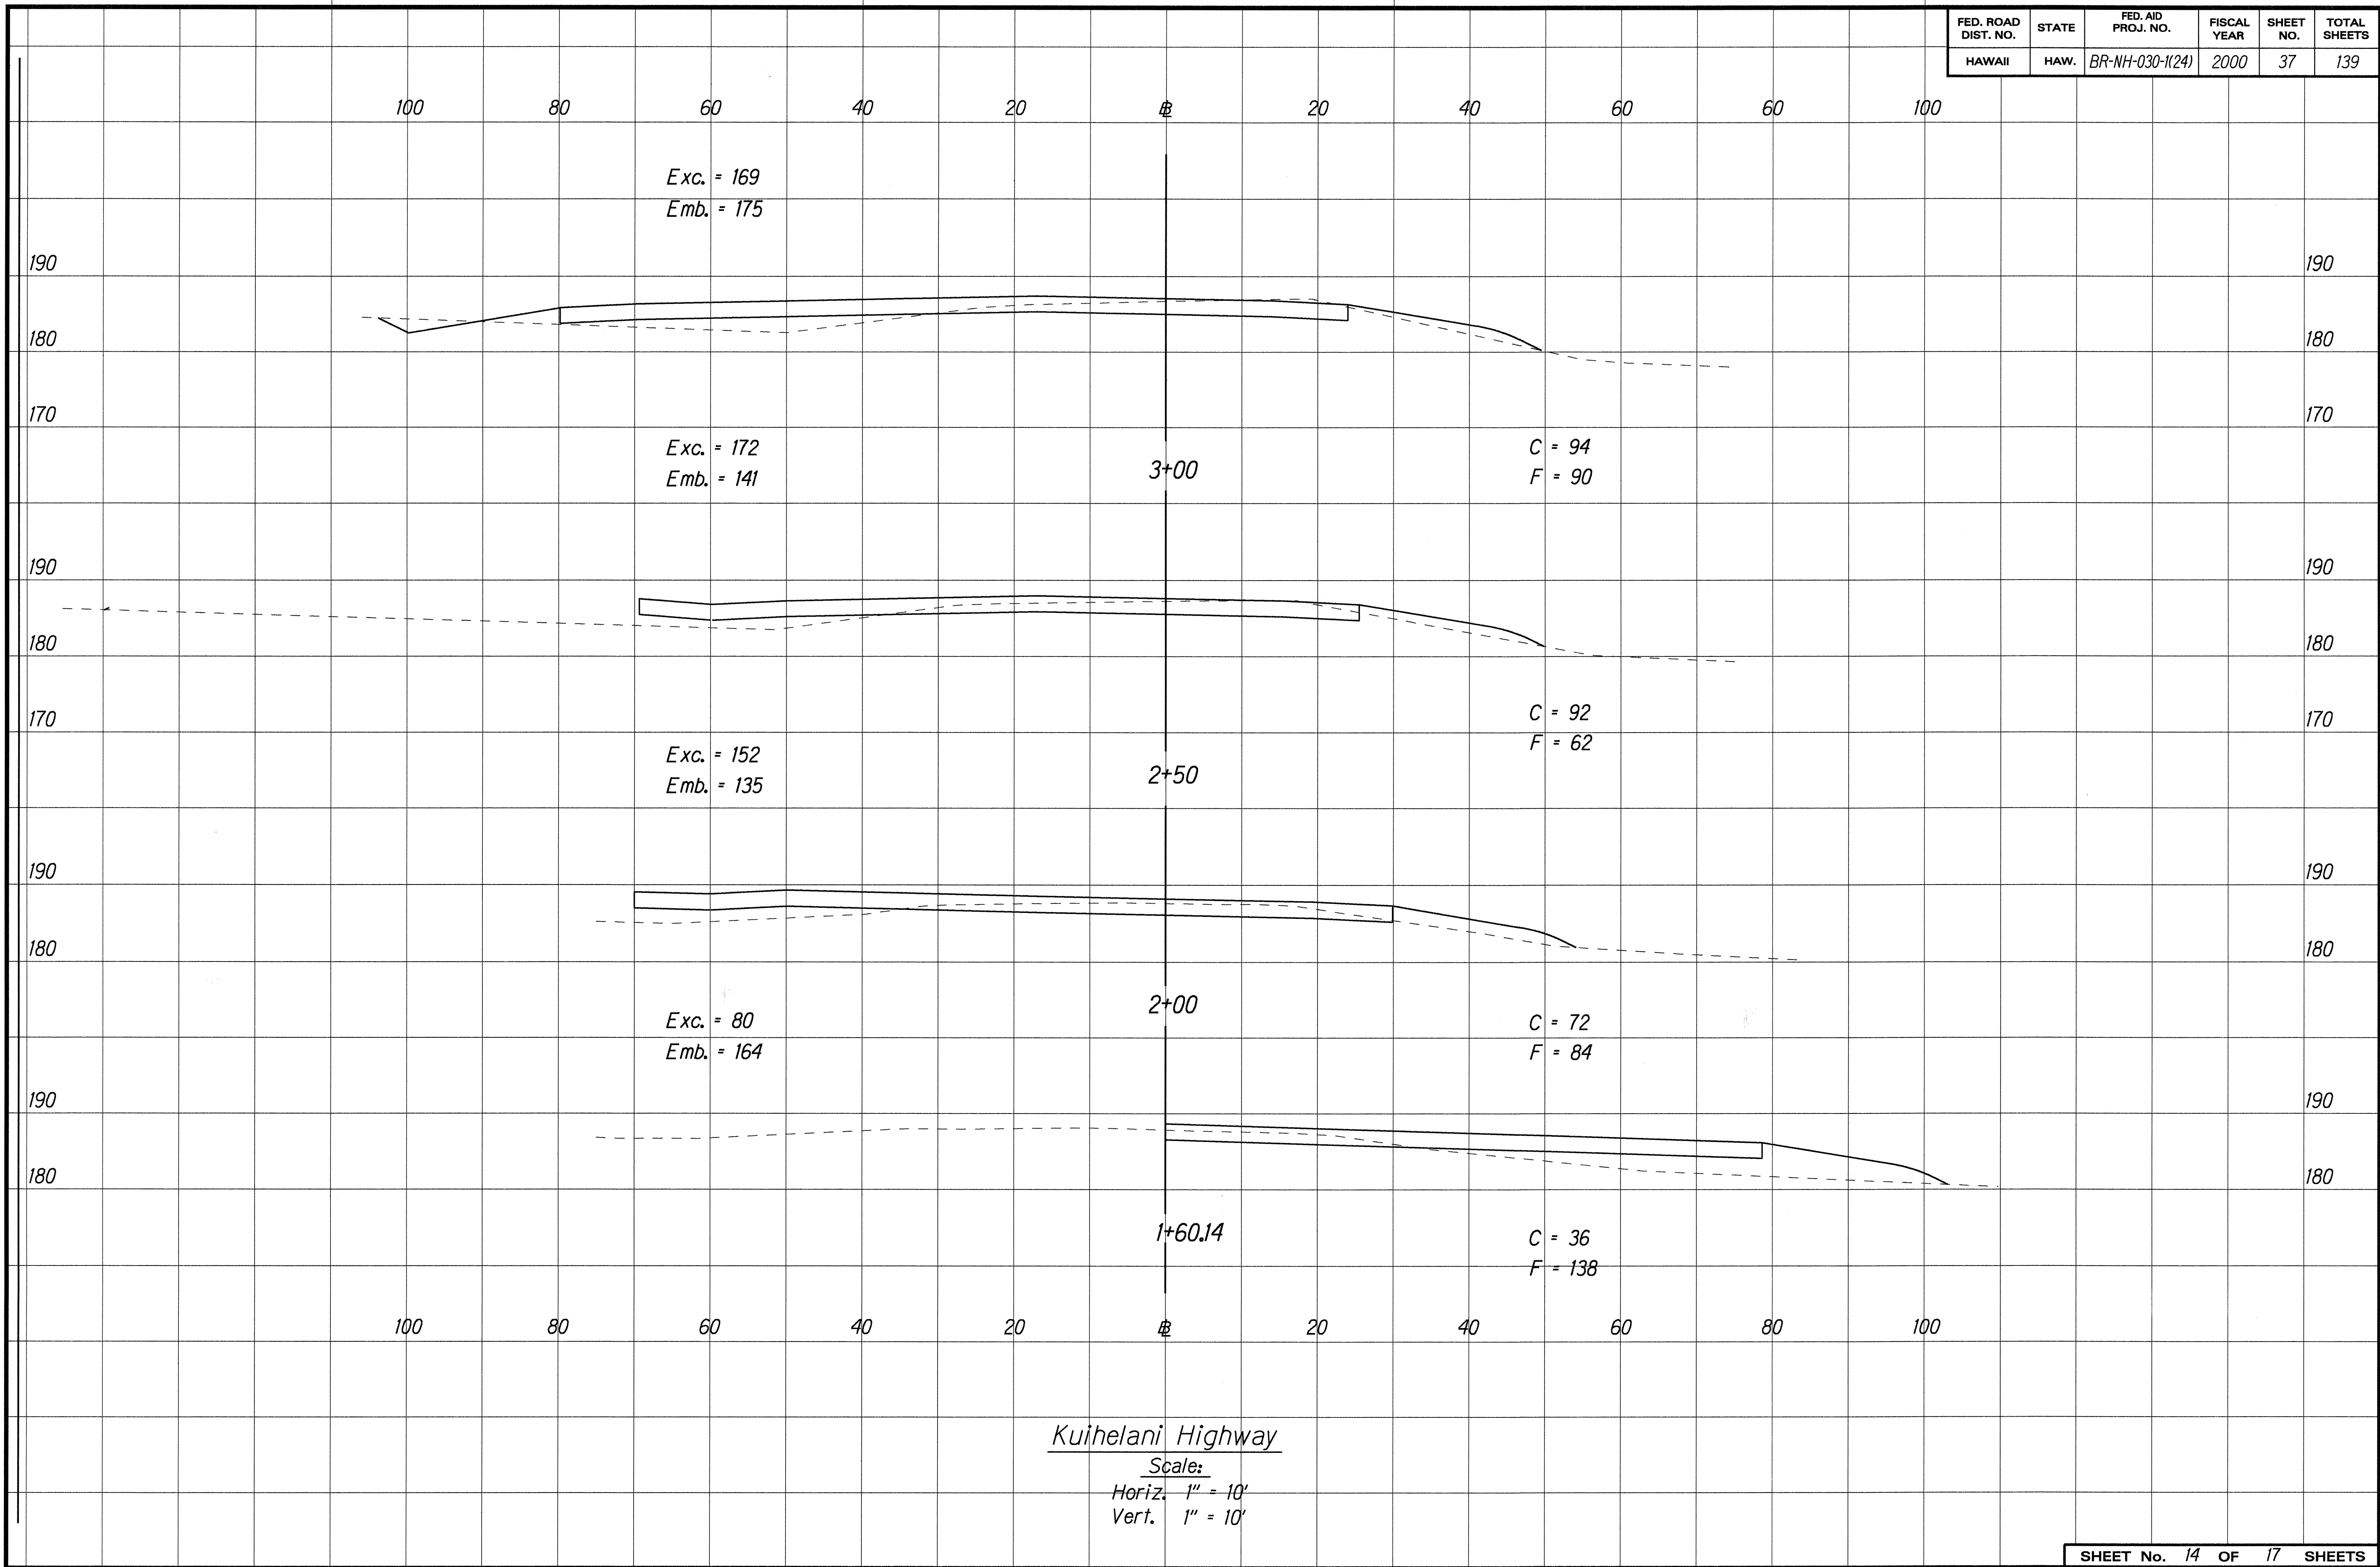

ORIGINAL PLAN	SURVEY PLOTTED BY	DATE
NOTE BOOK	DRAWN BY K. Itochida	1/13/97
dd24	REVIEWED BY R. Hirose/K. Itochida	
N. Honda/s4	CHECKED BY	

FED. ROAD DIST. NO.	STATE	FED. AID PROJ. NO.	FISCAL YEAR	SHEET NO.	TOTAL SHEETS
HAWAII	HAW.	BR-NH-030-1(24)	2000	38	139

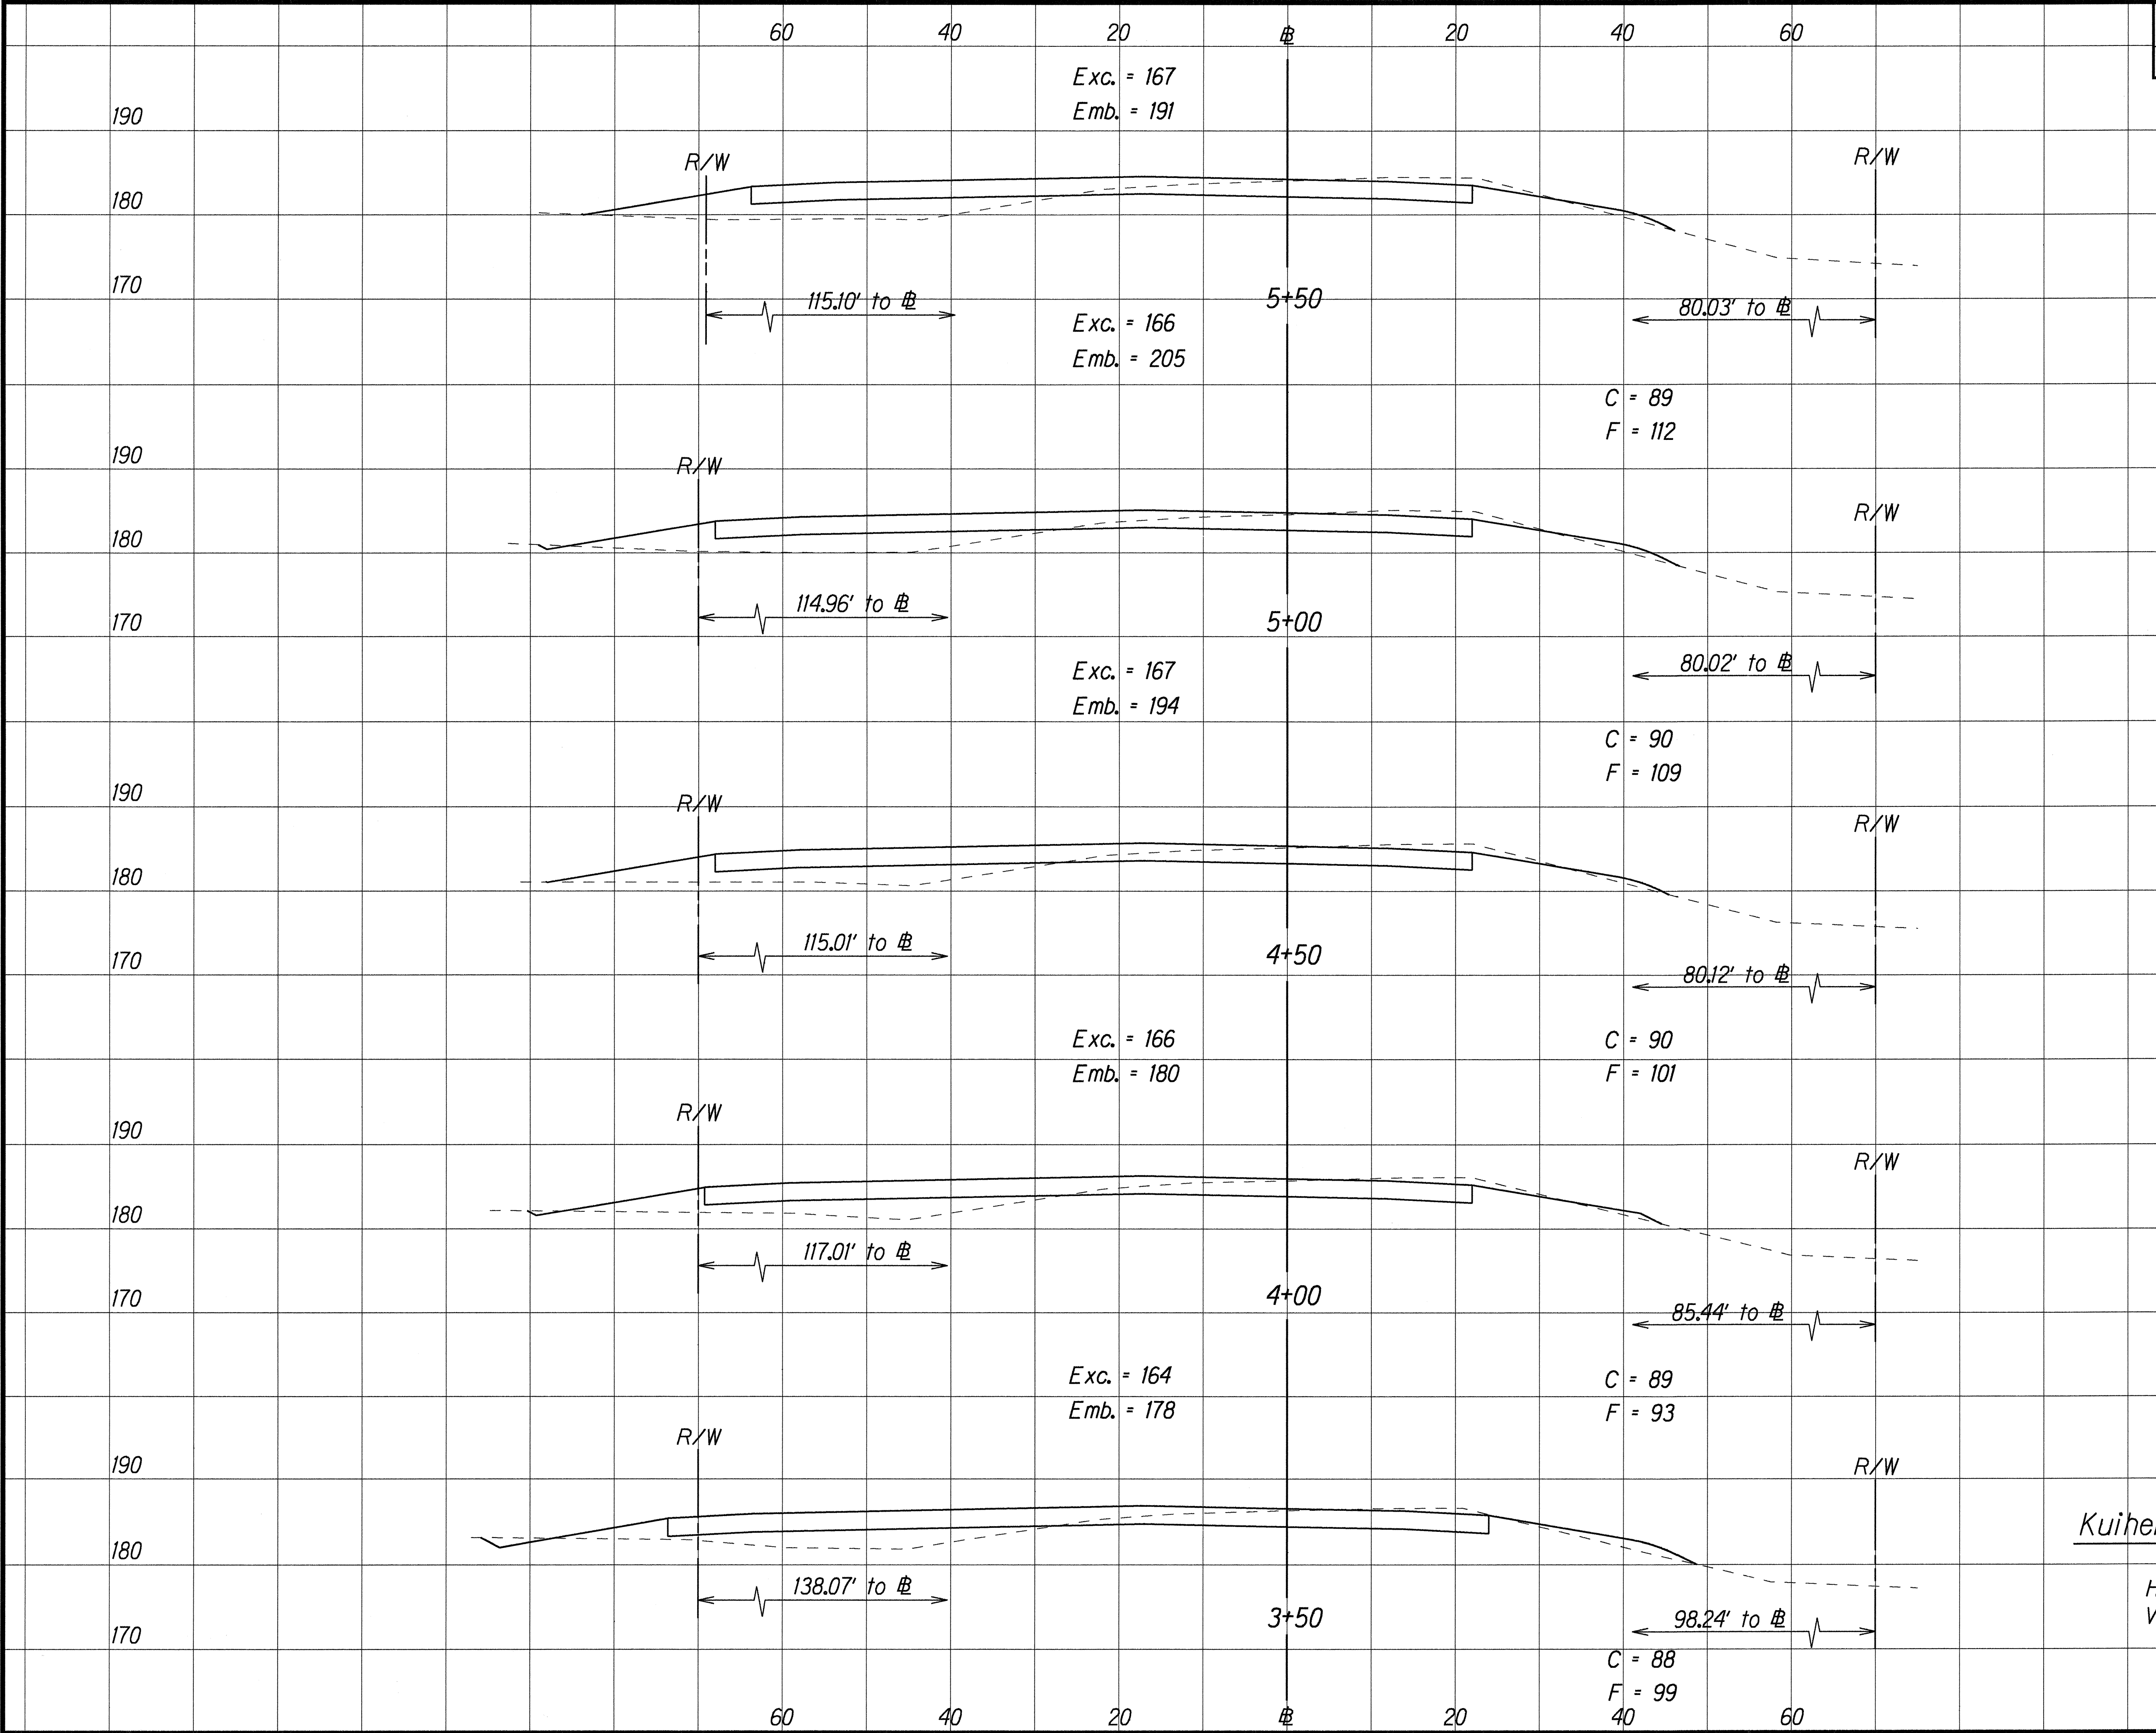


Kuihelani Highway

Scale:
 Horiz. 1" = 10'
 Vert. 1" = 10'

ORIGINAL PLAN
 SURVEY PLOTTED BY
 DRAWN BY
 CHECKED BY
 DATE
 1/13/97
 NOTE BOOK
 66241
 QUANTITIES BY
 CHECKED BY
 N. Hironaka/K. I. Hironaka


FED. ROAD DIST. NO.	STATE	FED. AID PROJ. NO.	FISCAL YEAR	SHEET NO.	TOTAL SHEETS
HAWAII	HAW.	BR-NH-030-1(24)	2000	39	139

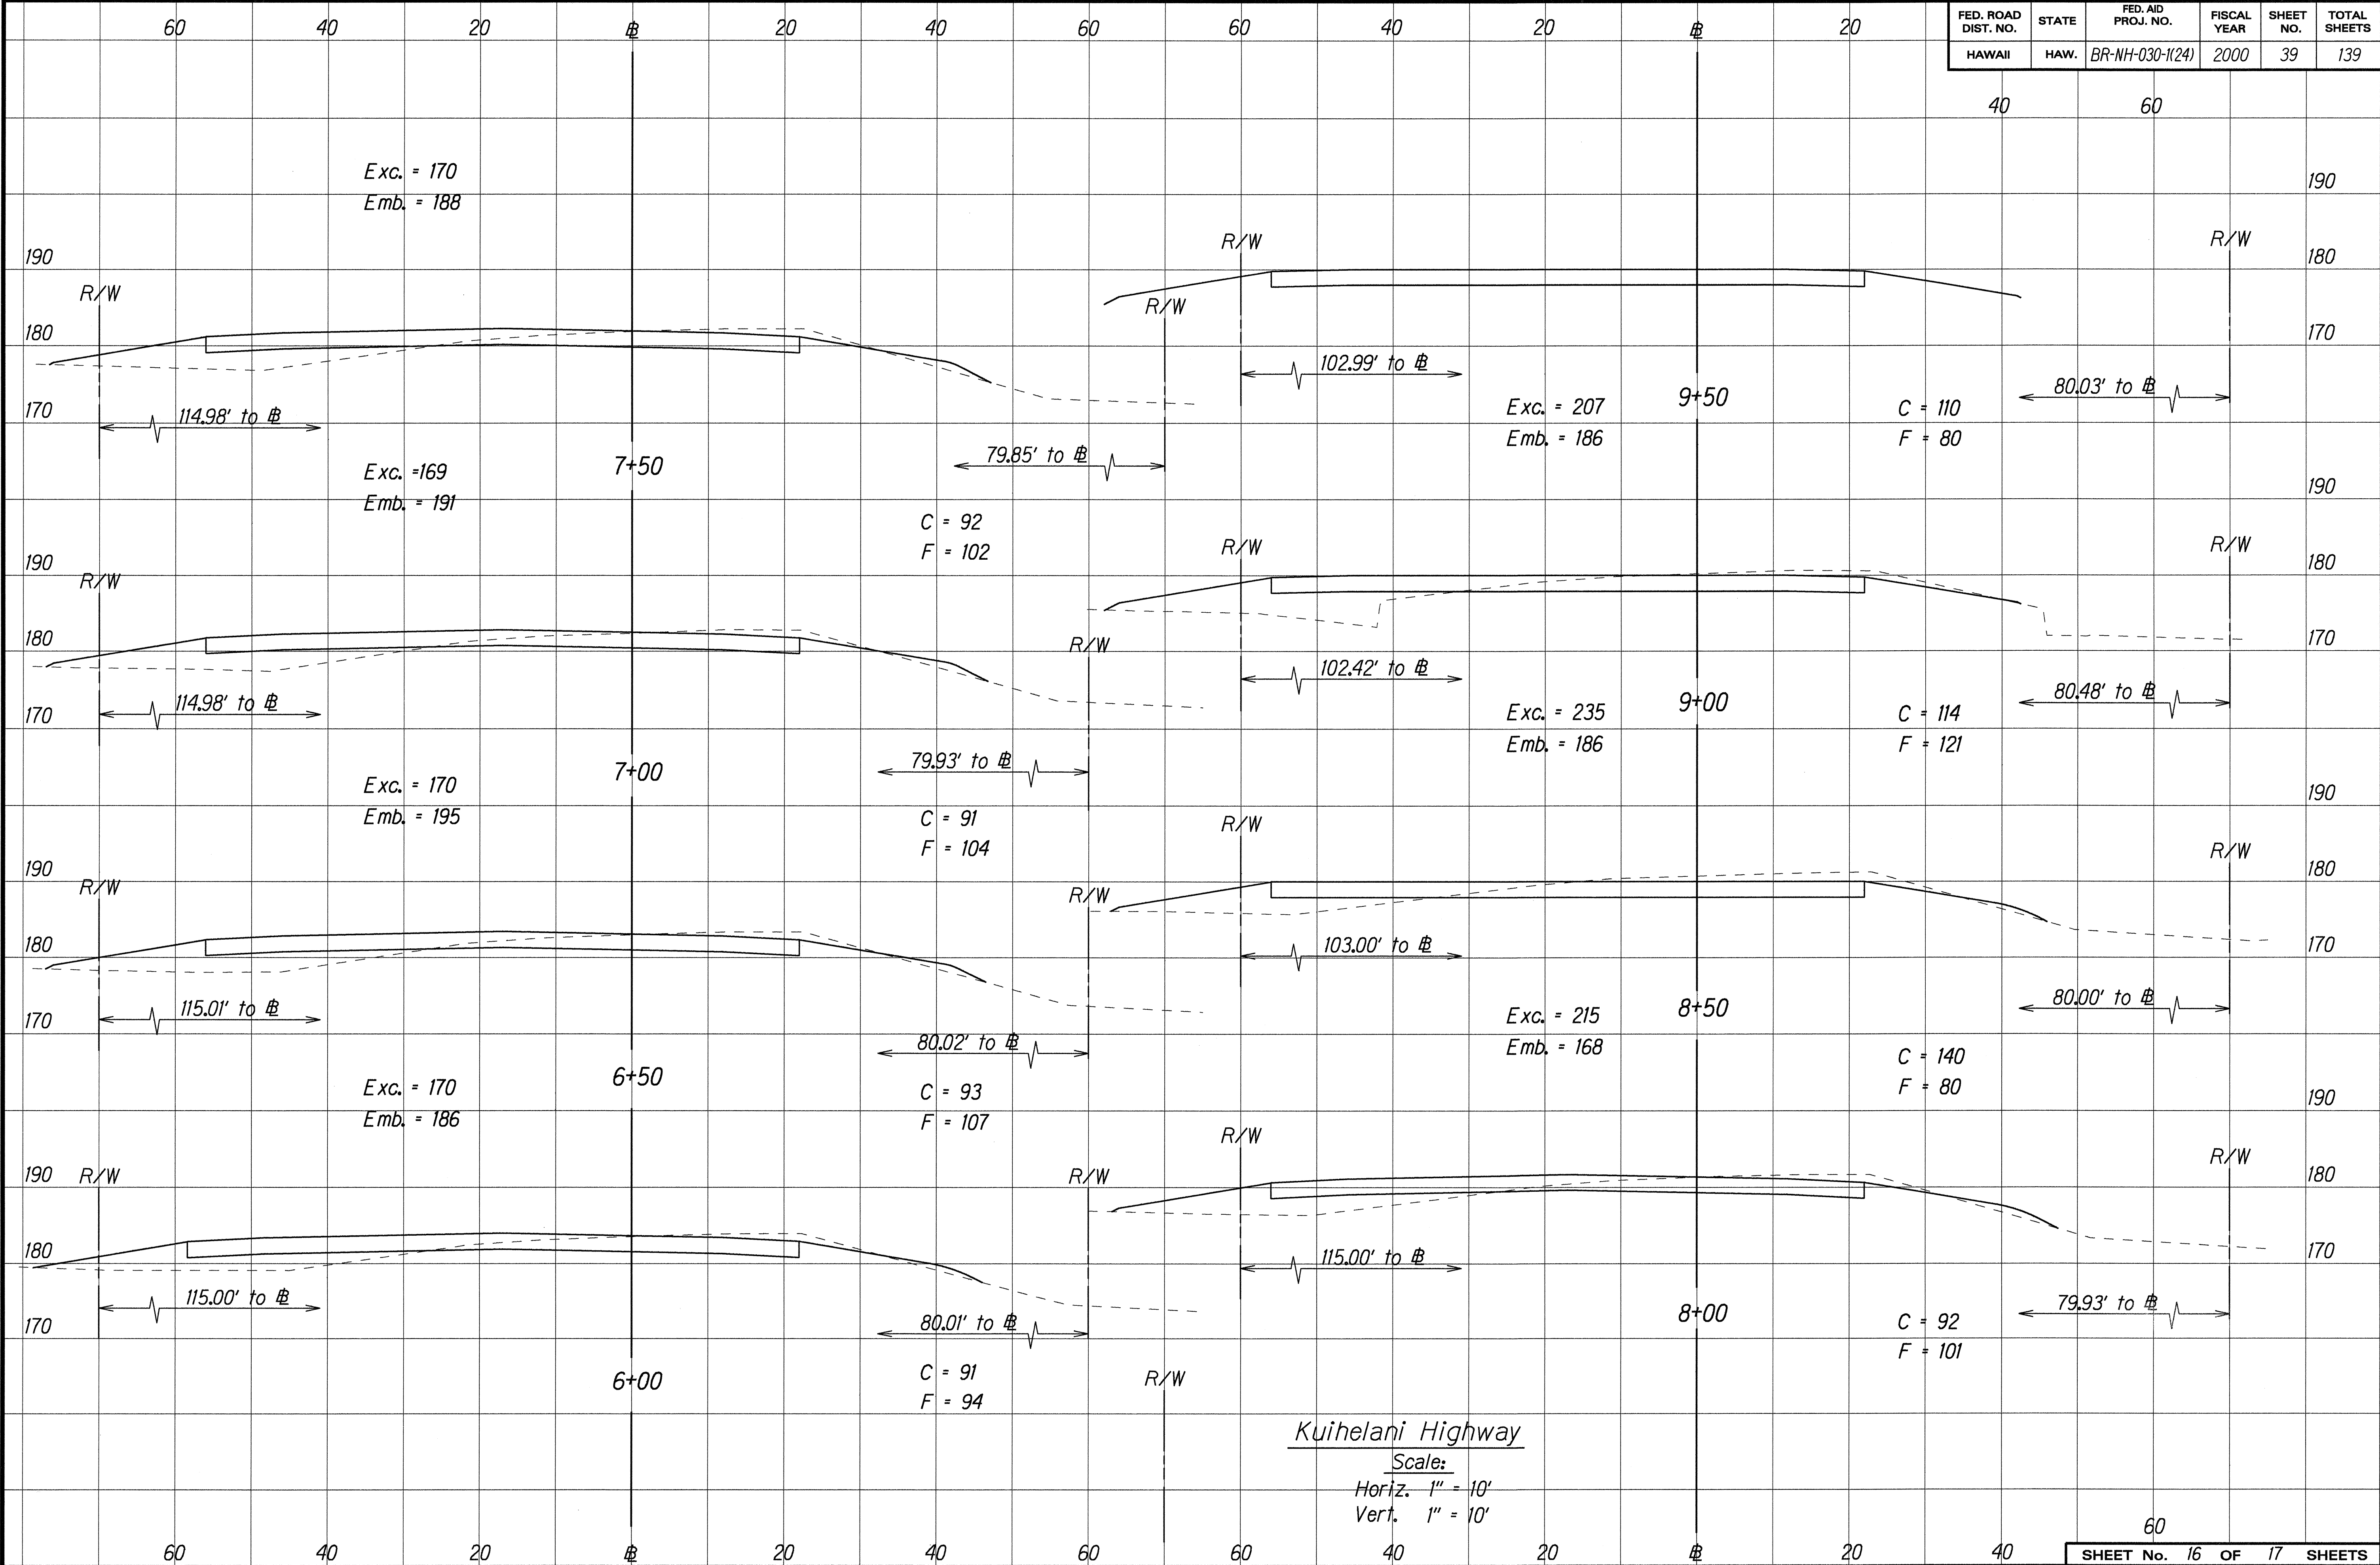

Kuihelani Highway
 Scale:
 Horiz. 1" = 10'
 Vert. 1" = 10'

ORIGINAL PLAN
 SURVEY PLOTTED BY
 DATE 11/24/99
 DRAWN BY K. Tan-Hirata
 CHECKED BY B. Hironaka/K. Hironaka
 NOTE BOOK 00241
 CHECKED BY N. Hironaka

ORIGINAL
PLAN
DRAWN BY: J. Matsunami
DATE: 12-28-92
NOTE BOOK
DESIGNED BY: K. Takaguchi
QUANTITIES BY: cdk
CHECKED BY: N. Hironaka

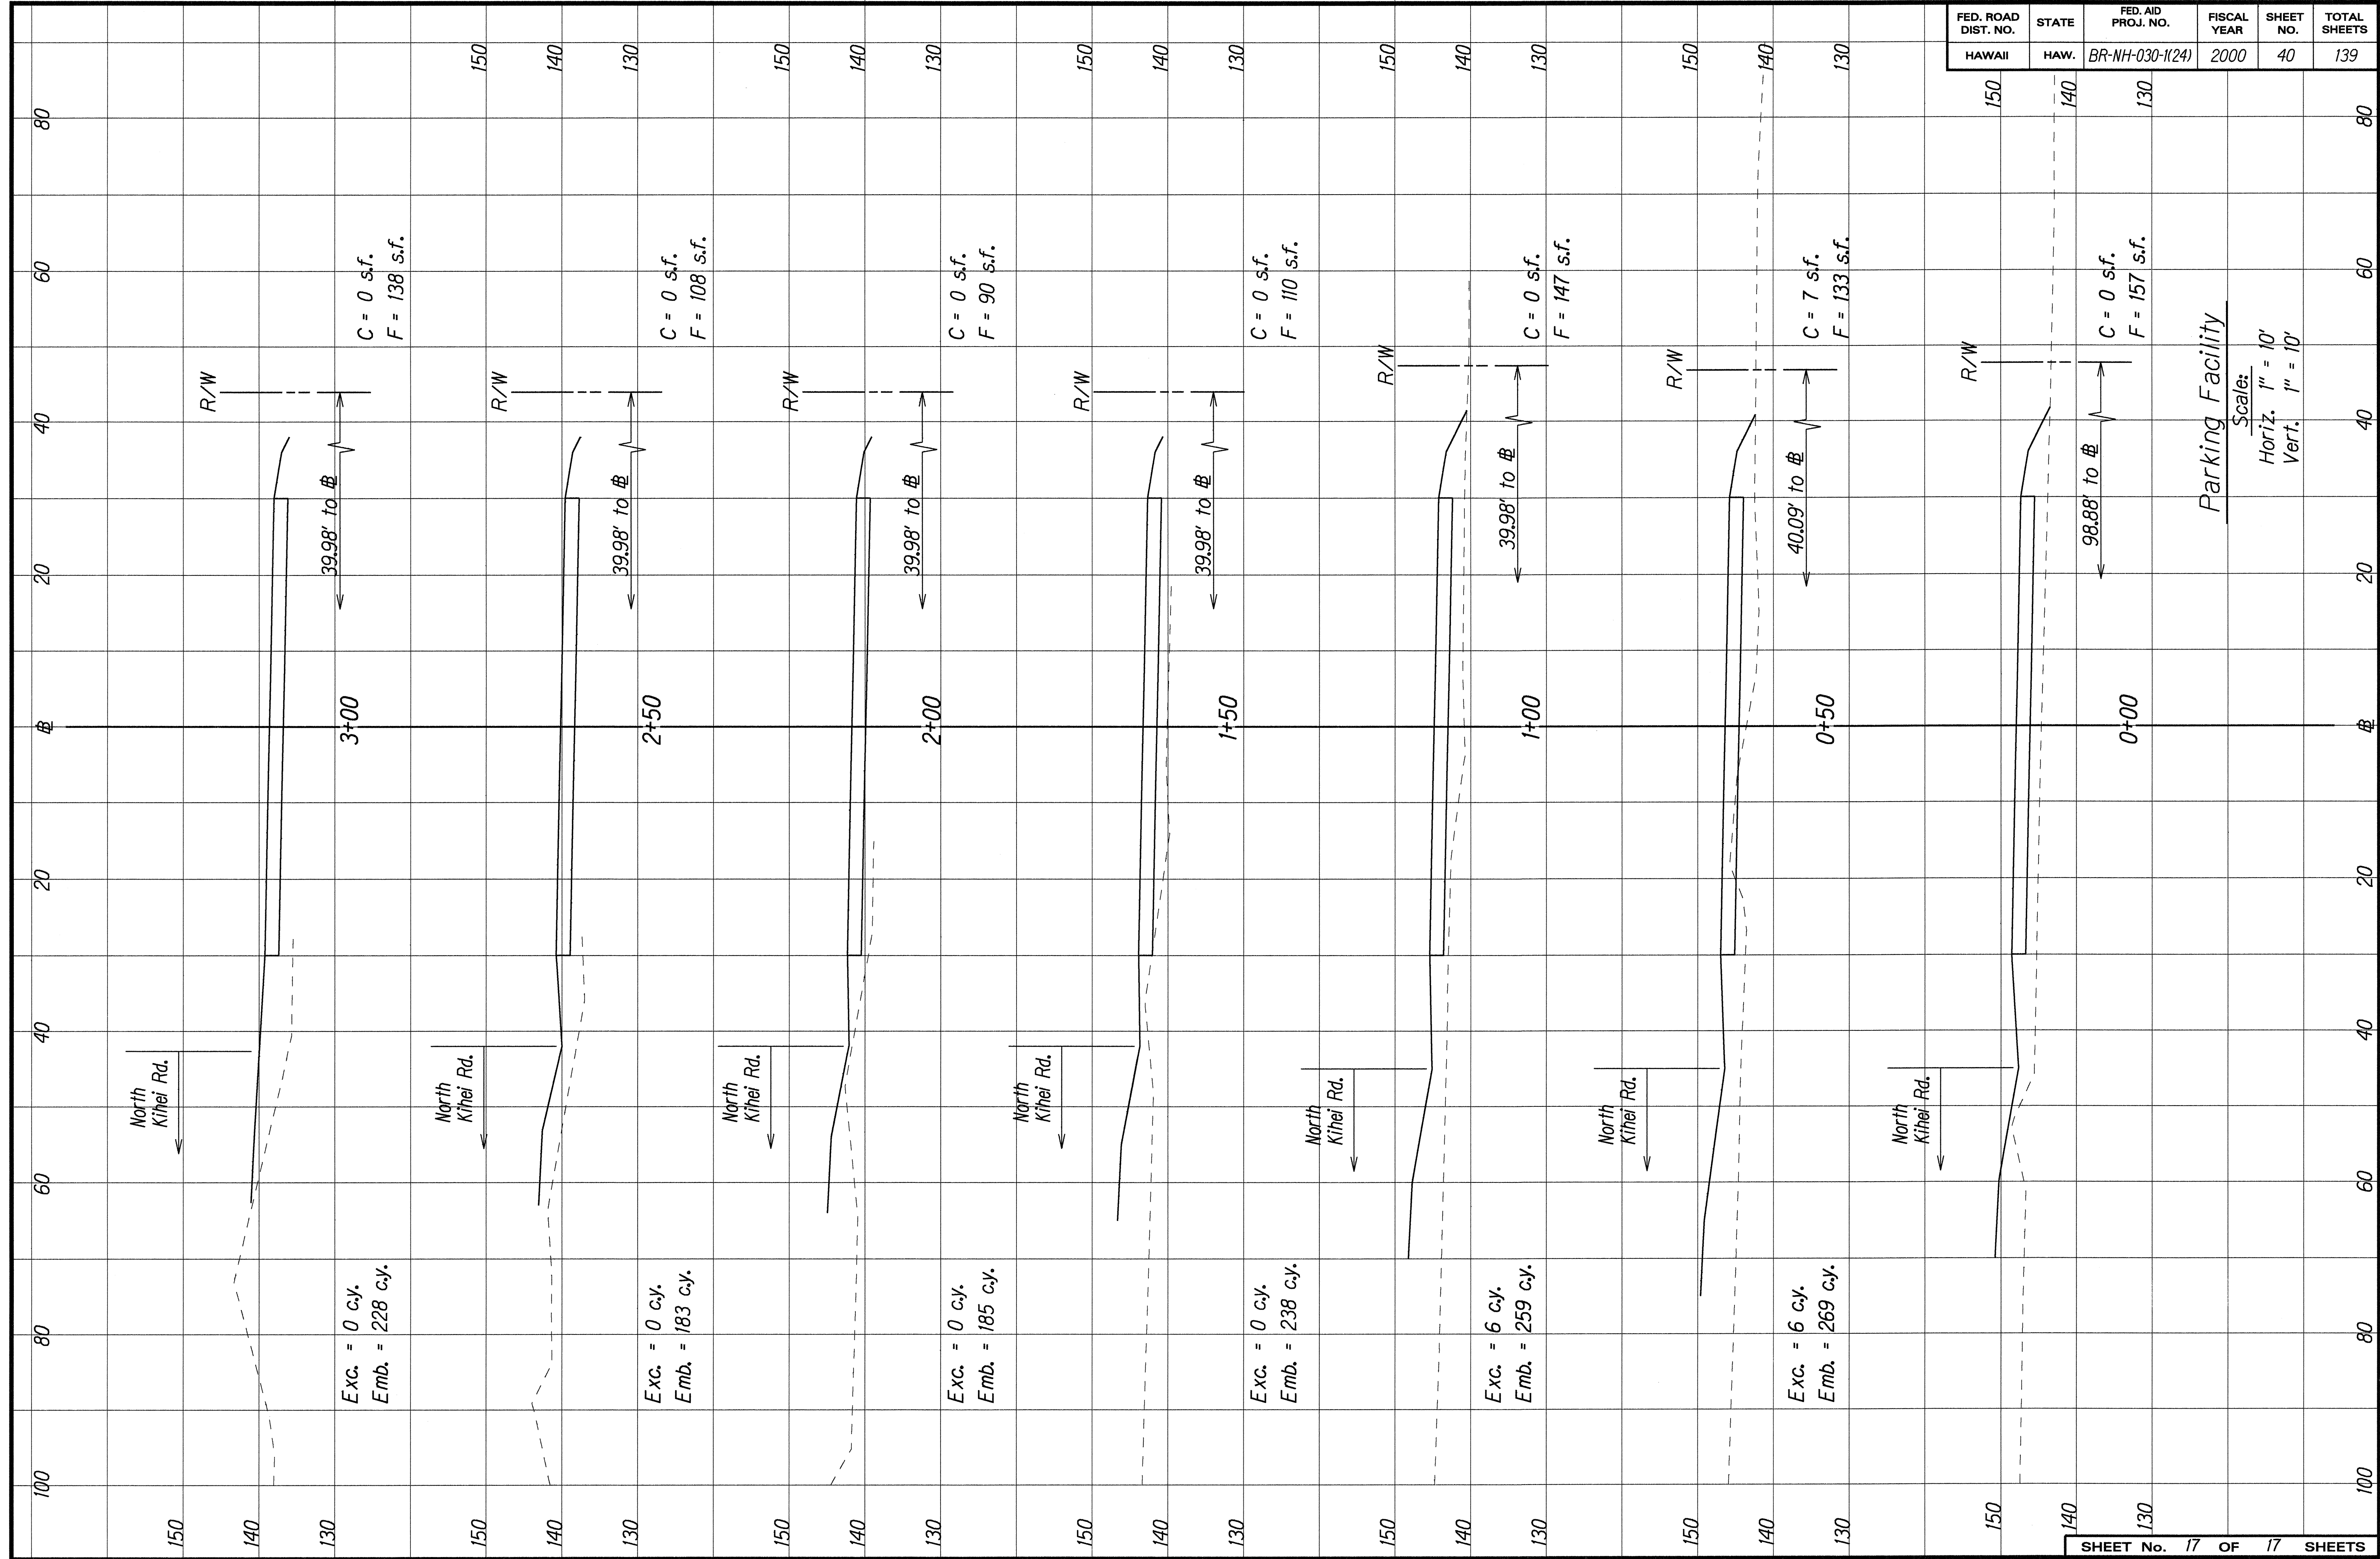

FED. ROAD DIST. NO.	STATE	FED. AID PROJ. NO.	FISCAL YEAR	SHEET NO.	TOTAL SHEETS
HAWAII	HAW.	BR-NH-030-1(24)	2000	40	139