


FED. ROAD DIST. NO.	STATE	FED. AID PROJ. NO.	FISCAL YEAR	SHEET NO.	TOTAL SHEETS
HAWAII	HAW.	BR-NH-030-1(24)	2000	13	139

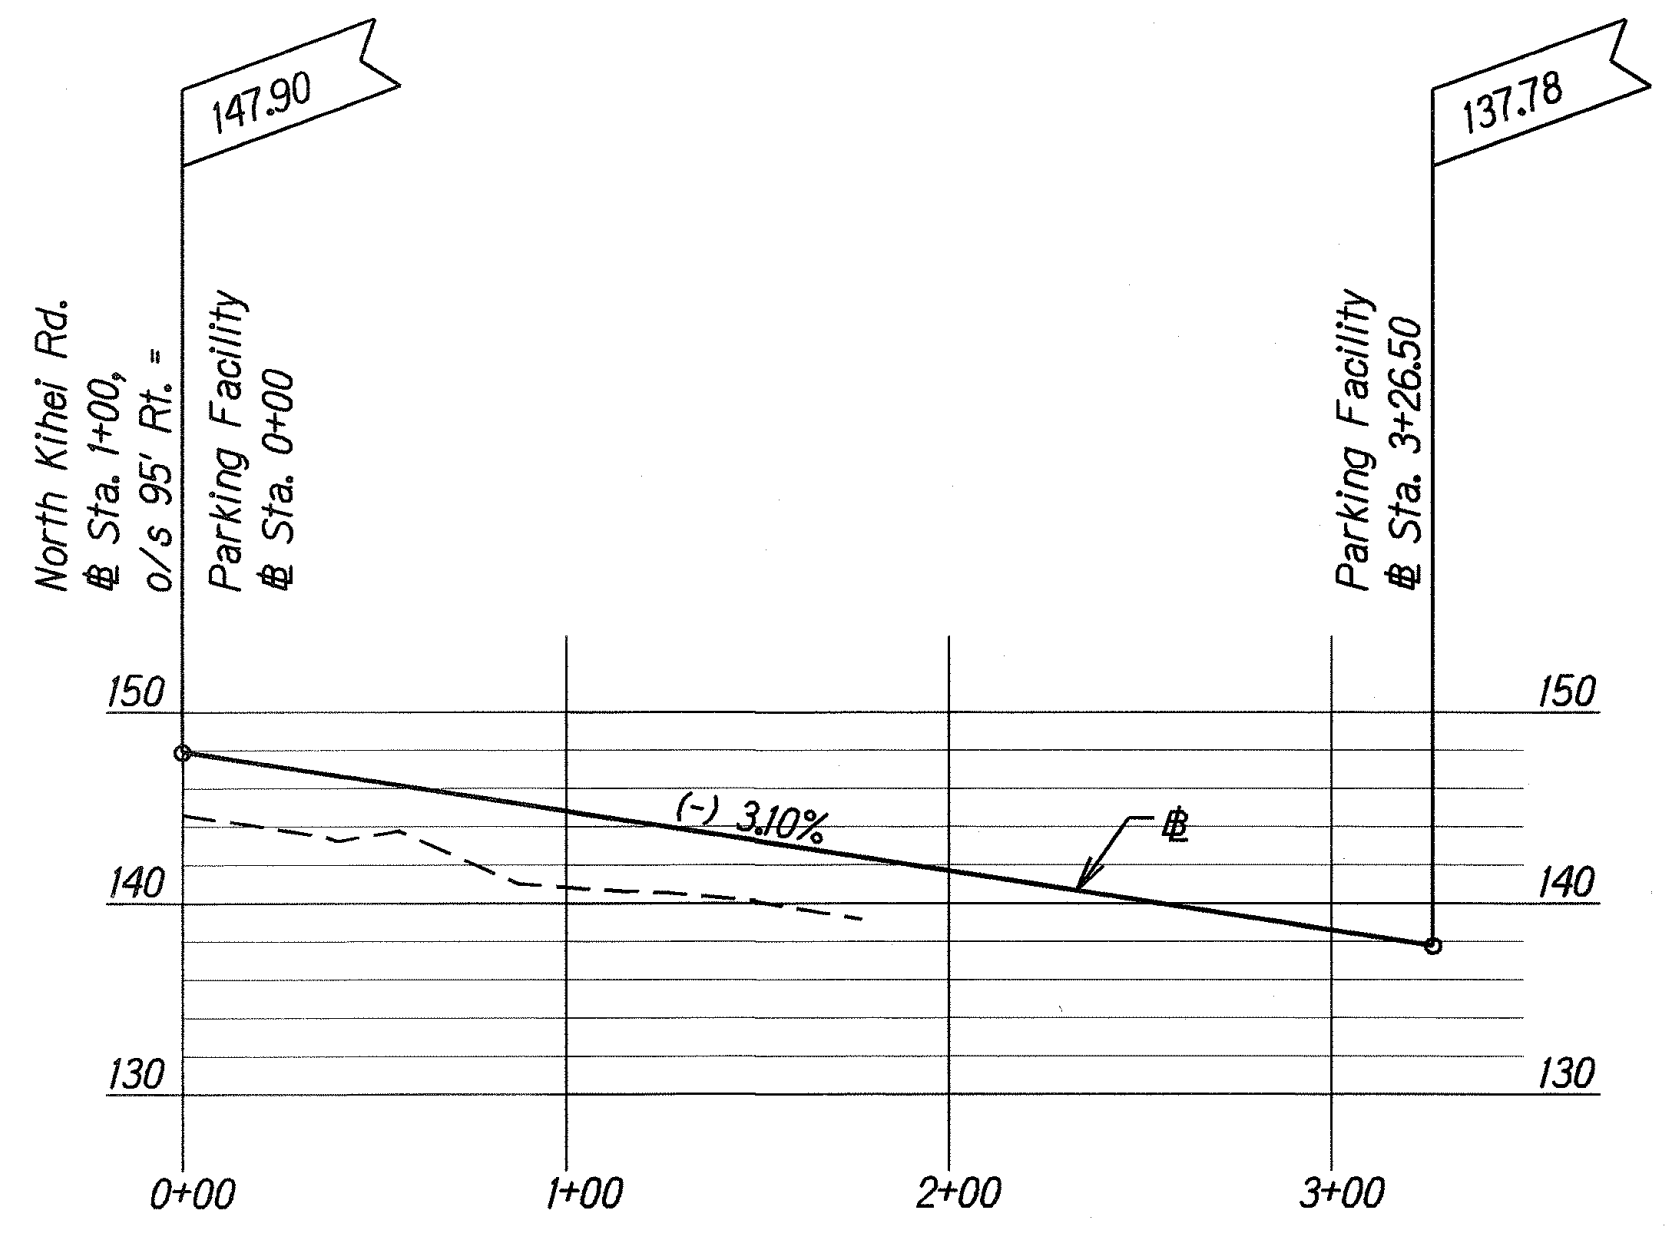


PARKING FACILITY PROFILE
 Scale: Horz.= 1"=50'
 Vert.= 1"=10'

Parking Facility @ 0+00=
 N. Kihei Rd. @ Sta. 1+00 o/s 95.0', Rt.
 Parking Facility
 Sta. 0+00.00

Edge of Pavement
 FLEAT-350 Guardrail
 End Treatment
 For Detail, See
 Plan Sheet No. 44
 4 Ft. Fence w/Toprail,
 For Detail see Plan Sht. No. 7.
 Median Lt. E.P. P.C. Sta. 3+21.70 R=497.33'
 P.C. Sta. 3+34.00 R=478.70'
 Median Rt. E.P. P.C. Sta 3+46.70 R=460.07'

CURVE DATA			
CURVE	NB-2	NB-3	SB-1
Δ	4°05'41.8"	3°12'30"	6°29'45"
R	11,459.16'	34,431.50'	34,377.50'
T	409.67'	964.26'	1,950.84'
C	818.82'	1,927.77'	3,895.42'
Lc	818.99'	1,928.02'	3,897.50'

CURVE	KI-1	KI-2	KI-3
Δ	42°58'41"	42°58'41"	42°58'41"
R	497.33'	478.70'	460.07'
T	195.79'	188.46'	181.12'
C	364.37'	350.72'	337.07'
Lc	373.05'	359.08'	345.10'

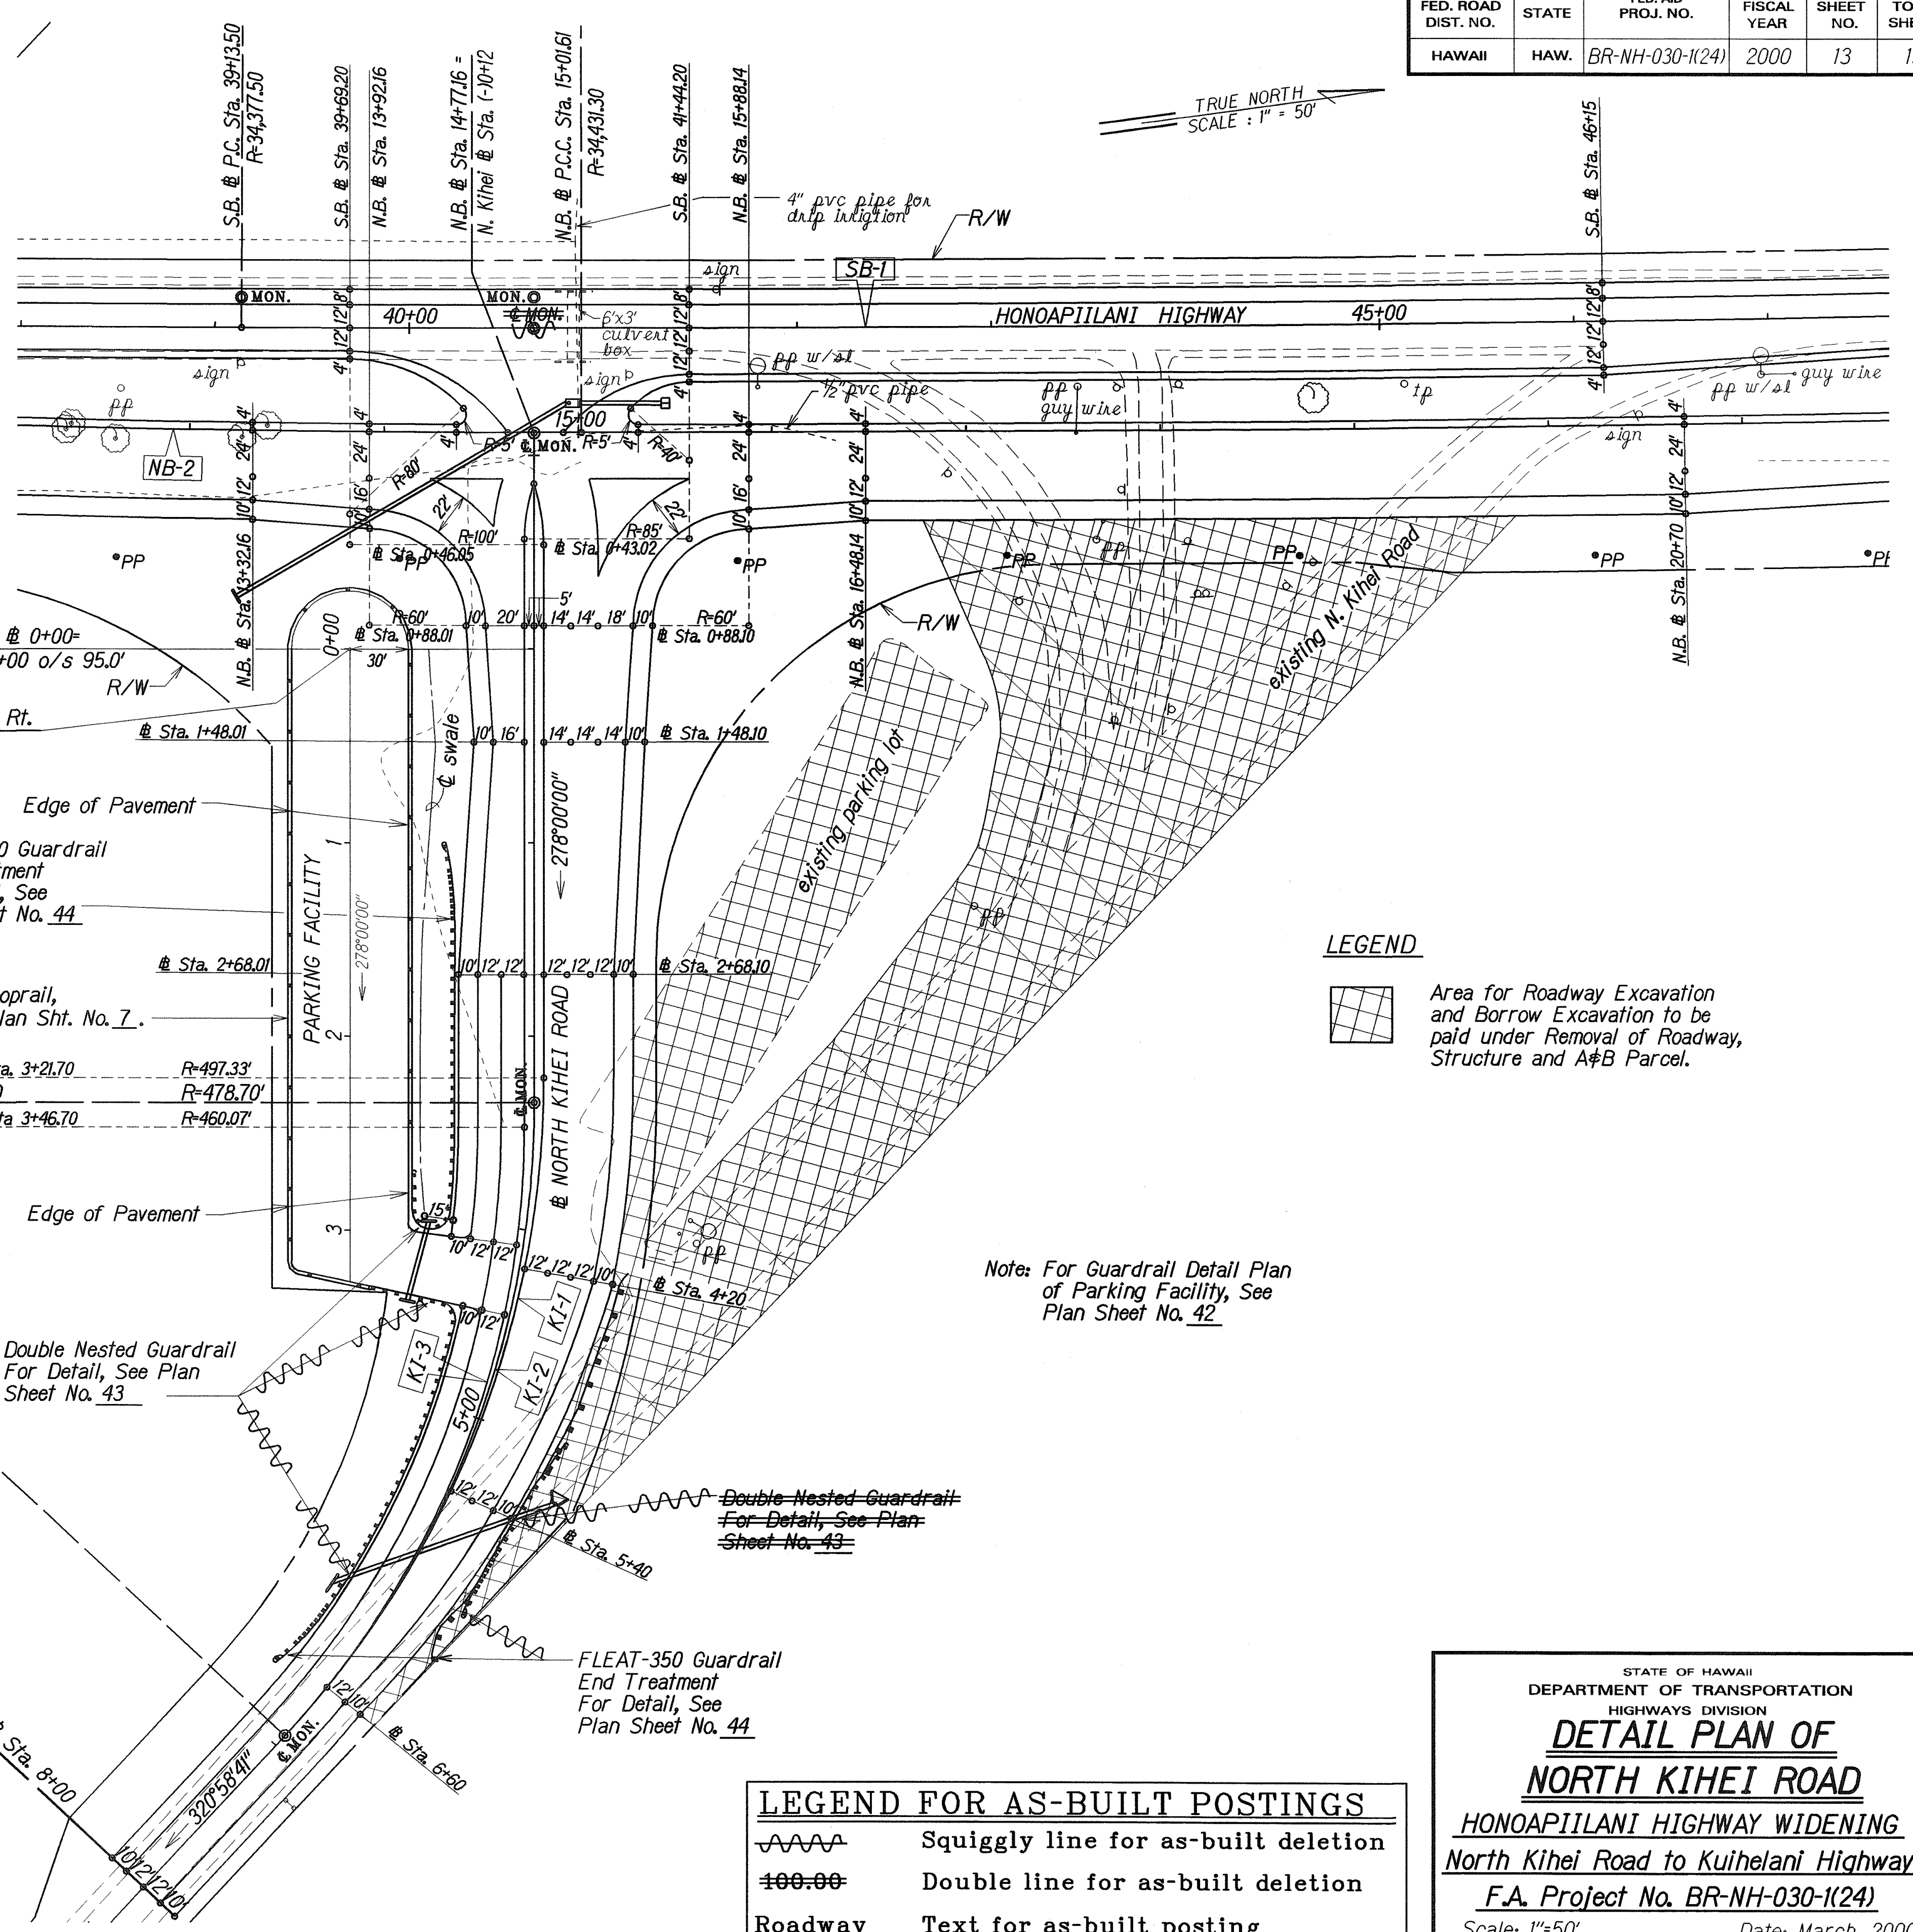

LEGEND
 Area for Roadway Excavation and Borrow Excavation to be paid under Removal of Roadway, Structure and A&B Parcel.

Note: For Guardrail Detail Plan of Parking Facility, See Plan Sheet No. 42

Double Nested Guardrail
 For Detail, See Plan Sheet No. 43

FLEAT-350 Guardrail
 End Treatment
 For Detail, See Plan Sheet No. 44

LEGEND FOR AS-BUILT POSTINGS	
	Squiggly line for as-built deletion
	Double line for as-built deletion
Roadway	Text for as-built posting

STATE OF HAWAII
DEPARTMENT OF TRANSPORTATION
HIGHWAYS DIVISION

DETAIL PLAN OF NORTH KIHAI ROAD

HONOAPIILANI HIGHWAY WIDENING
 North Kihei Road to Kihelani Highway
 F.A. Project No. BR-NH-030-1(24)
 Scale: 1"=50' Date: March, 2000

SHEET No. 1 OF 1 SHEETS


DESIGNED BY	DATE
DRAWN BY	12/12/99
CHECKED BY	
IN CHARGE	
NOTE BOOK	
QUANTITIES BY	
CHECKED BY	

"AS-BUILT"

FED. ROAD DIST. NO.	STATE	FED. AID PROJ. NO.	FISCAL YEAR	SHEET NO.	TOTAL SHEETS
HAWAII	HAW.	BR-NH-030-1(24)	2000	14	139

CURVE DATA				
CURVE	NB-3	NB-4	SB-1	KU-1
Δ	3°12'30"	4°50'	6°29'45"	33°00'
R	34,431.50	7,639.44	34,377.50	2,291.83
T	964.26	322.41	1,950.84	678.87
C	1,927.77	644.25	3,895.42	1,301.83
Lc	1,928.02	644.44	3,897.50	1,320.00

LEGEND FOR
AS-BUILT POSTINGS

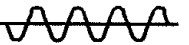
Squiggly line for as-built deletion


Double line for as-built deletion

Roadway
Text for as-built posting

STATE OF HAWAII
DEPARTMENT OF TRANSPORTATION
HIGHWAYS DIVISION

DETAIL PLAN OF
KUIHELANI HIGHWAY
HONOAPIILANI HIGHWAY WIDENING
North Kihei Road to Kuihelani Highway
F.A. Project No. BR-NH-030-1(24)
Scale: 1"=50'
Date: Feb., 2000

SHEET No. 1 OF 1 SHEETS

ORIGINAL PLAN	SURVEY PLOTTED BY	DATE
NOTE BOOK	DRAWN BY	10-12-99
QUANTITIES BY	DESIGNED BY	
CHECKED BY	NOTED BY	

"AS-BUILT"