

General Notes - Traffic Signal System:

1. Locations of Existing Underground Structures and Utilities such as Pipe Lines, Conduits, Cables, Etc., shown on Plans are Approximate only. It is not the intent of these Plans to show the exact Location of all Under-Ground Utilities and Structures. It is the Responsibility of the Contractor to verify the Locations of all Existing Utilities with the Respective Owners. Existing Utilities Damaged by the Contractor shall be Repaired by the Contractor at His Own Cost.
2. All Traffic Signal Work shall Conform to the Requirements of the "Manual on Uniform Traffic Control Devices for Streets and Highways", Federal Highway Administration, Latest Edition, and Amendments.
3. The Locations of the Traffic Signal Standards, Traffic Signal Standards with Mast-Arm, Pedestrian Push Buttons, Traffic Controller, Pullboxes, Conduits, Barriers & Loop Detectors shall be Staked Out in the Field by Contractor & Approval of the Locations Obtained from the Engineer Prior to Construction & Installation. Locations shown on the Plans shall be Adjusted as Necessary to Prevent Conflicts with Existing or New Facilities.
4. All New Conduits Under Roadway shall be PVC Schedule 80. Contractor shall have the Option of Using PVC Schedule 40 for New Conduits not Under Roadway, Unless Otherwise Noted.
5. In Addition to the Conduits Indicated in the "Conduit and Cable Schedule". Install One 3-Inch Conduit in the Footings of all Signal Controllers. Conduit shall be Stubbed-Out 12 Inches from Footing and shall be Capped.
6. A Solid #8 Bare Copper Wire shall be Installed in the Entire Traffic Signal Conduit System for Use as a System Ground.
7. Lead-in Wires in Pullbox near Loops shall be Tagged with Loop Number(s).
8. Locations of Pavement striping and Markings (Lane Lines, Stop Lines, Cross-Walk, Etc.) Shown on the Plans shall be verified with the Engineer prior to the Installation of the Traffic Signal System.
9. All Traffic Signal Controller Equipment shall be Completely Wired in the Cabinet and shall Control the Traffic Signals as called for in the Plans.
10. Signal Indications During Clearance Interval:
- a. If a Signal is G or <G- and will Remain G or <G- During the Next Phase, it shall be G or <G- During the Clearance Interval.
- b. If a Signal is G or <G- and will Become R or Extinguished During the Next Phase, it shall be Y or <Y- During the Clearance Interval.
- c. If the Signal is R and will Remain R or Becomes G During the Next Phase, it shall Remain R During the Clearance Interval.
11. Salvage and Deliver Existing Traffic Signal Equipment (Signal Heads, Pedestrian Pushbuttons, Controller, Enclosures Etc) to DOT's Base Yard as Directed by the Engineer. The Work shall be Considered Incidental to the Various Contract Items.
12. Existing Traffic Signal System shall be Maintained and Kept Operational Until the New Traffic Signal System is in Operation.

General Electrical Notes


1. Electrical Work shall be New Unless Otherwise Noted.
2. "Wiring" Indicates Insulated Wires in Conduit.
3. Contractor shall Tone to Determine Exact Location of Existing Utilities & Adjust His Work Accordingly.
4. The Locations of the Various Existing Utilities Shown on the Contract Drawings were Determined on the Basis of Best Available Information. Therefore, No Assurance is Provided that the Actual Locations will be Precisely as Shown on the Contract Drawings. The Contractor shall verify the Locations and Depths of the Facilities and Exercise Proper Care in Excavating the Area. The Contractor shall be Held Responsible for any Damages to the Facilities.
5. In Performing All Work, the Contractor shall Exercise Due Care and Caution Necessary to Avoid any Damage to and Impairment in the use of any Existing Utility Line. Any Damage Inflicted on Existing Utility Lines Resulting from the Contractor's Operations shall be Immediately Repaired or Restored as Directed by the State at the Contractor's Expense.
6. All Electric/Signal Ducts shall have a Vertical Clearance of 1'-0" when Crossing Water/Sewer Lines.
7. All Dimensions are Nominal. Verify Exact Dimensions & Equipment Requirements with the Successful Supplier.
8. The Contractor shall be Liable for any Damage to Maui Electric Co. Facilities and shall Immediately Report such Damages to Maui Electric Co.'s Trouble Dispatcher at 871-7777.
9. All Maui Electric Co. Overhead Facilities shown on these Plans or whose Approximate Locations within the Project Boundaries have been made known by any Reasonable Means at any time to the Contractor shall be Protected at all Times by the Contractor during Construction. Costs for the Damages to Maui Electric Co. Facilities will be Borne by the Contractor. This Repair Work shall be done by Maui Electric Co. or by the Contractor under Maui Electric Co.'s Supervision.
10. Any Work Required to Remove/Relocate Maui Electric Co. Facilities shall be done by Maui Electric Co. The Contractor shall be Responsible for Coordination.
11. The Project Site Contains Various Maui Electric Co. Lines Operated at 69KV, 23KV, 12.47KV and Various other Secondary Voltages. These Lines must Remain Active. Therefore, the Contractor shall Utilize such Methods, Equipment, Etc., Necessary to Protect His Personnel, the Public, State Personnel, Property, Equipment, Etc.
12. Due to Ongoing Construction & Maintenance, Conditions Indicated in these Drawings may have Changed. Therefore, the Contractor shall verify all Existing Conditions prior to Work.

Demolition Notes


1. Work shall be done in Phases. Verify with Engineer for Phasing Sequence. Provide all Wiring and Connections, per NEC, State, Utility Requirements, to Ensure Continuity of Service to Traffic Signal Equipment and Sreet Light Equipment to Remain in use at No Additional Cost to the State.
2. The Contractor shall verify all Existing Circuit Wiring prior to any Demolition Work.
3. Remove all Abandoned Wires.
4. Where Contract Documents Indicate Wiring is to be Removed:
- A. Remove Existing Cables In Conduit. Remove Sensor Loop Cables that will Interfere with New Work, otherwise Abandon Loop Cables Concealed below Finished Grade.
- B. Remove Conduits that will Interfere with Work. Abandon Conduits that are Concealed below Finished Grade.
- C. Break and Remove Pullboxes/Handholes. Fill Holes with Base Course and Repair to Match Adjacent Surfaces.
5. Remove All Traffic Standard, Traffic Signal and Street Light Standard Concrete Bases by Breaking Bases to 24 Inches below Finish Grade. Fill Holes with Base Course and Repair to Match Adjacent Surfaces.
6. For Circuit(s) where Existing Electrical Equipment shall be Removed, The Contractor Shall Provide all Necessary Raceways, Wires, Boxes, Etc., per NEC Requirements, to Ensure Circuit Continuity to and Proper Operation of the Remaining Component(s).
7. Demolition and Removal Work shall be Considered Incidental to the Various Contract Items.

FED. ROAD DIST. NO.	STATE	FED. AID PROJ. NO.	FISCAL YEAR	SHEET NO.	TOTAL SHEETS
HAWAII	HAW.	BR-NH-030-1(24)	2000	106	139

ORIGINAL PLAN	SURVEY PLOTTED BY	DATE
NOTE BOOK	DRAWN BY	
	DESIGNED BY	
	CHECKED BY	

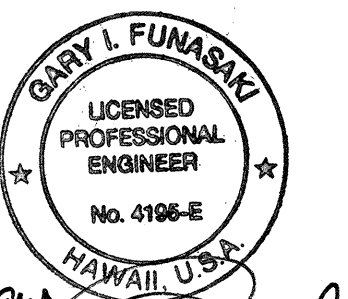 24 MAR 2000 This Work was Prepared by Me or Under My Supervision	STATE OF HAWAII DEPARTMENT OF TRANSPORTATION HIGHWAYS DIVISION ELECTRICAL NOTES HONOAPIILANI HIGHWAY WIDENING North Kihei Road to Kuihelani Highway F.A. Project No. BR-NH-030-1(24) Scale: None Date: Apr. 2000 SHEET No. E2 OF 22 SHEETS
--	---

FED. ROAD DIST. NO.	STATE	FED. AID PROJ. NO.	FISCAL YEAR	SHEET NO.	TOTAL SHEETS
HAWAII	HAW.	BR-NH-030-K(24)	2000	107	139

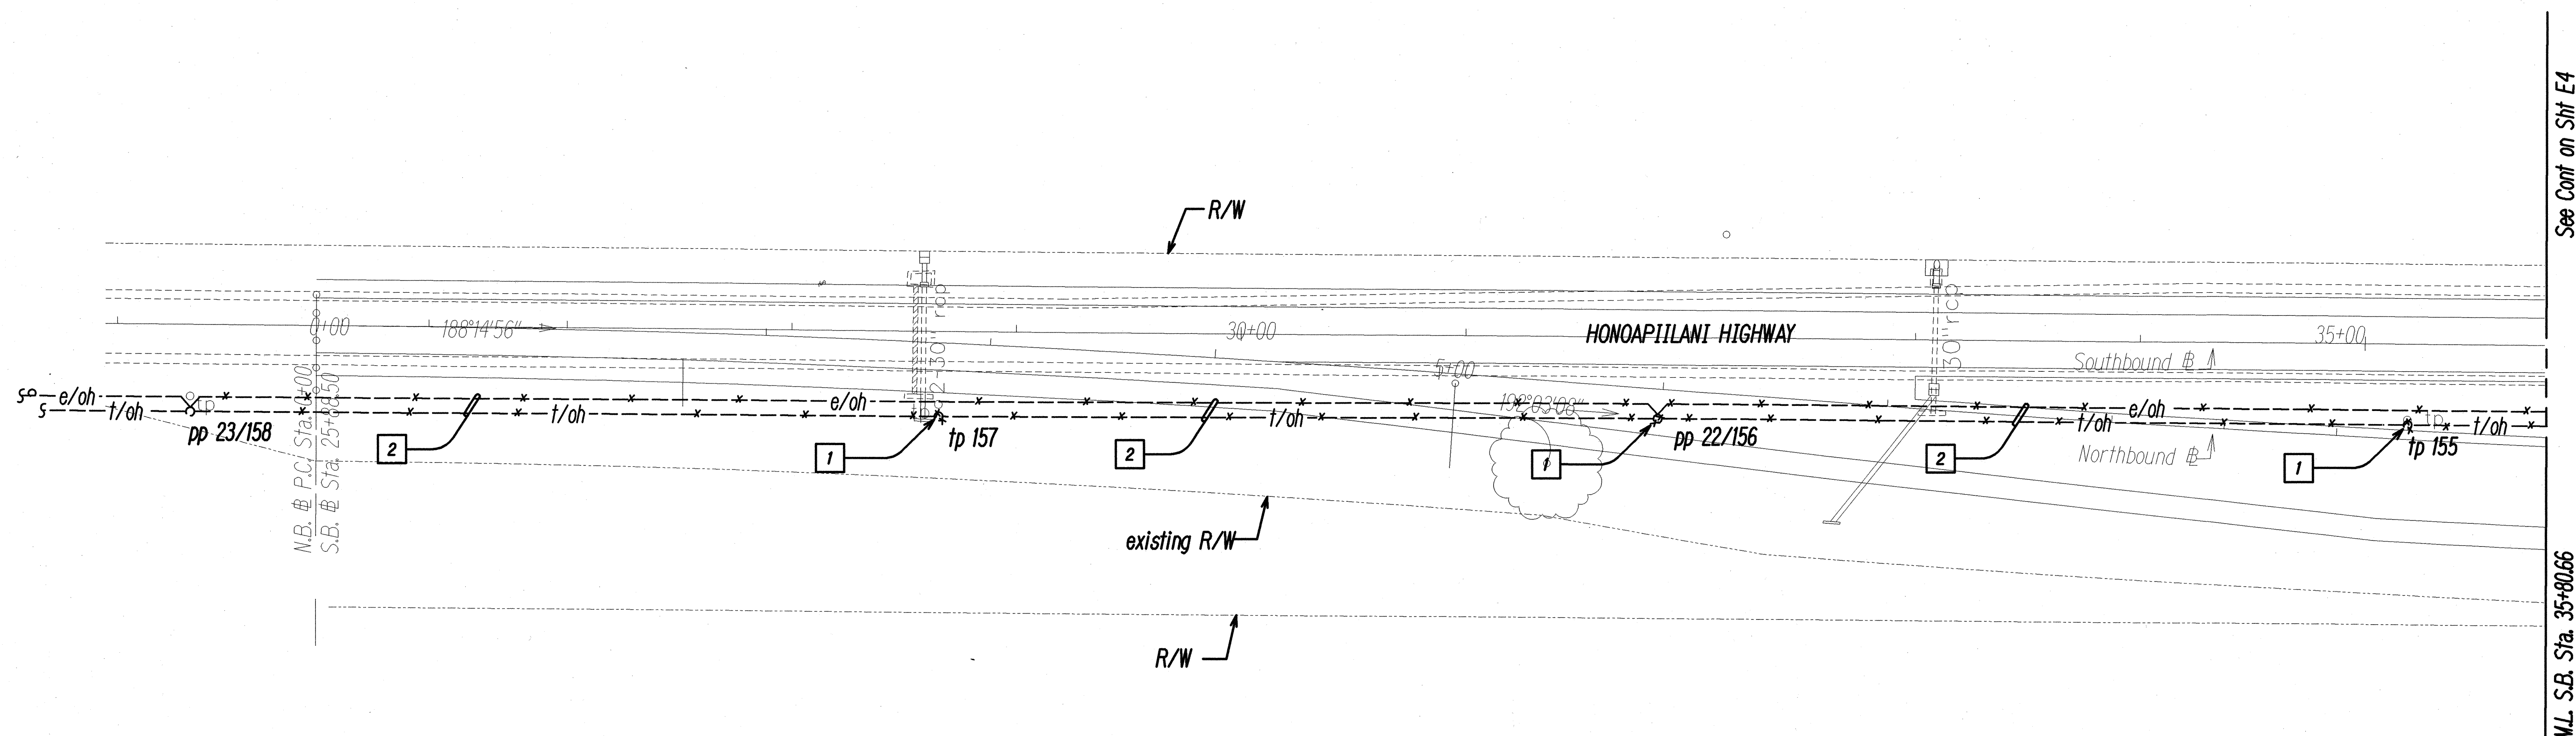


Existing electrical equipment in-use during construction

- Existing traffic signal equipment and existing street lights are in-use and must remain in operation during the construction until the proposed permanent facilities are completed and in service. Any cost for temporary relocations arising during construction shall be borne by the Contractor.
- Work by the Contractor in areas with energized electrical equipment or conductors shall be performed with extreme caution to prevent accidents and to avoid disturbing or damaging this equipment or conductors or any temporary supports or protective guards that are constructed. The Contractor shall have the sole responsibility for maintaining safe and efficient working conditions and procedures in these areas.
- The Contractor shall be responsible for the protection of existing surface and subsurface utilities and poles within and abutting the project site. Any utilities that the contractor encounters during the progress of the work, such as telephone ducts, electric ducts, traffic signal ducts or cables, water lines, sewer lines, electrical lines, gas lines, cable tv, and drainage pipes, whether or not shown on the plans, shall not be disturbed or damaged unless otherwise instructed in the plans or specifications. The Contractor shall notify the engineer and the affected agencies or utility company immediately of any damaged or disturbed utility. Any existing or new facilities including equipment or conductors, damaged by the Contractor shall be replaced at the Contractor's expense.


Notes:

- Existing utility pole to be removed/relocated by respective utility company.
- Existing utility overhead lines to be removed/relocated by respective utility company.

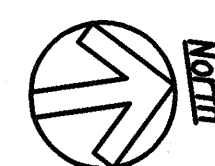

ELECTRICAL DEMOLITION PLAN - I

Scale: 1"=40'-0"

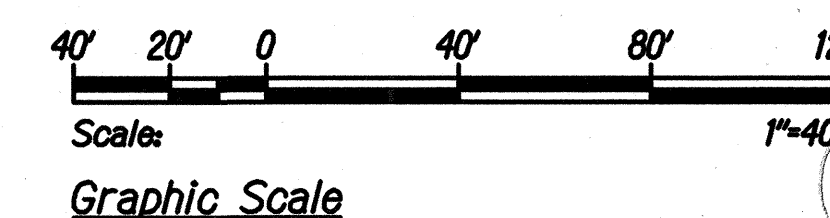

24 MAY 2000
This Work was Prepared by Me
or Under My Supervision

STATE OF HAWAII
DEPARTMENT OF TRANSPORTATION
HIGHWAYS DIVISION

ELECTRICAL DEMOLITION PLAN-I

HONOAPIILANI HIGHWAY WIDENING
North Kihei Road to Kihelani Highway
F.A. Project No. BR-NH-030-K(24)


Scale: 1"=40' Date: Apr. 2000

SHEET No. E3 OF 22 SHEETS

ORIGINAL PLAN	SURVEY PLOTTED BY	DATE
NOTE BOOK	DRAWN BY	
	CHECKED BY	
	QUANTITIES BY	
	NO.	


15 MAY 100 10:03:56 IE 24 MAY 2000 10:03:56 1004000001.dgn

FED. ROAD DIST. NO.	STATE	FED. AID PROJ. NO.	FISCAL YEAR	SHEET NO.	TOTAL SHEETS
HAWAII	HAW.	BR-NH-030-11(24)	2000	108	139

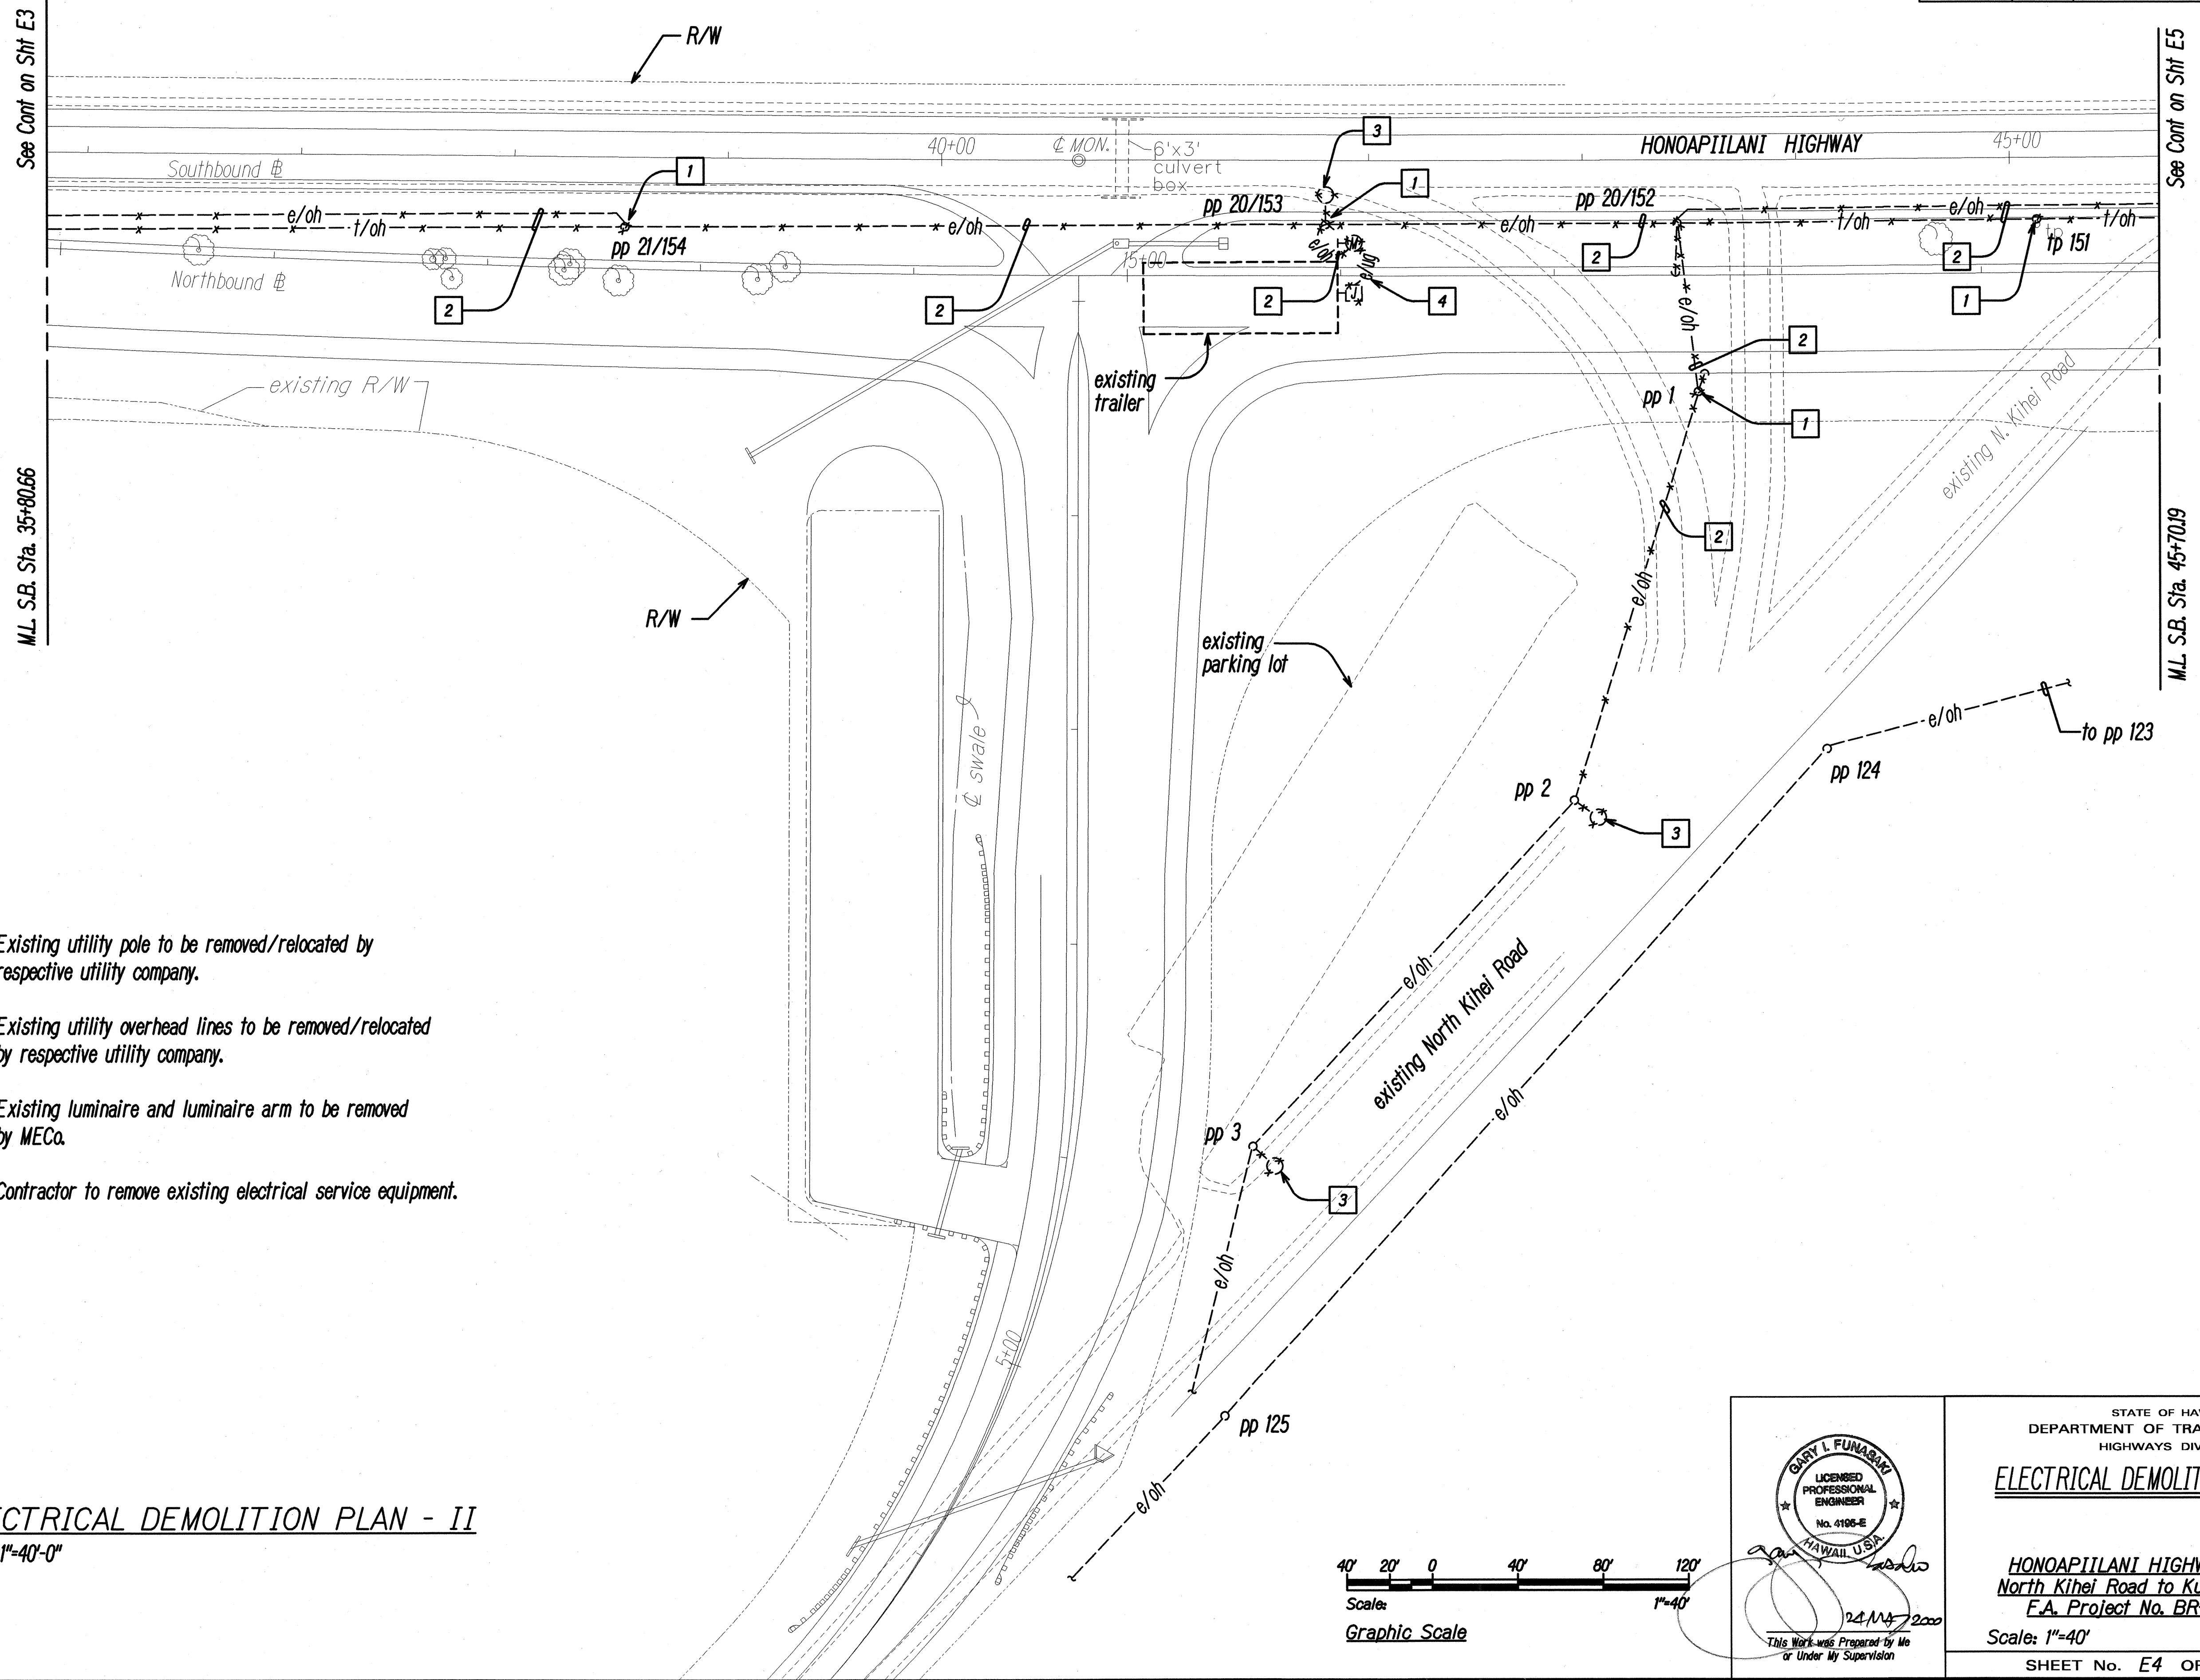



Notes:

- 1 Existing utility pole to be removed/relocated by respective utility company.
- 2 Existing utility overhead lines to be removed/relocated by respective utility company.
- 3 Existing luminaire and luminaire arm to be removed by MECo.
- 4 Contractor to remove existing electrical service equipment.

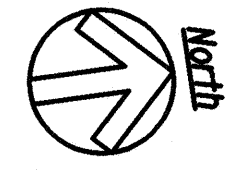

ELECTRICAL DEMOLITION PLAN - II
Scale: 1"=40'-0"

DESIGNED BY	DATE
DRAWN BY	
CHECKED BY	
NOTED BY	
ORIGINAL PLAN	

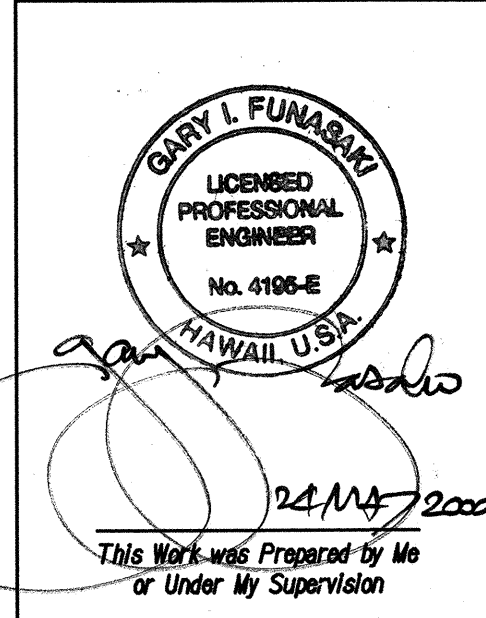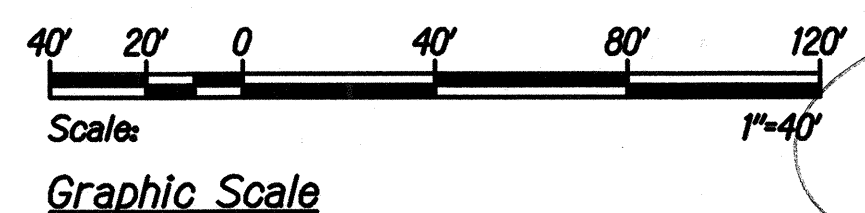

STATE OF HAWAII
DEPARTMENT OF TRANSPORTATION
HIGHWAYS DIVISION

ELECTRICAL DEMOLITION PLAN - II

HONOAPIILANI HIGHWAY WIDENING
North Kihei Road to Kihelani Highway
F.A. Project No. BR-NH-030-11(24)


Scale: 1"=40' Date: Apr. 2000

SHEET No. E4 OF 22 SHEETS

FED. ROAD DIST. NO.	STATE	FED. AID PROJ. NO.	FISCAL YEAR	SHEET NO.	TOTAL SHEETS
HAWAII	HAW.	BR-NH-030-1(24)	2000	109	139

See Cont on Shift E4

ML S.B. Sta. 45+70.19

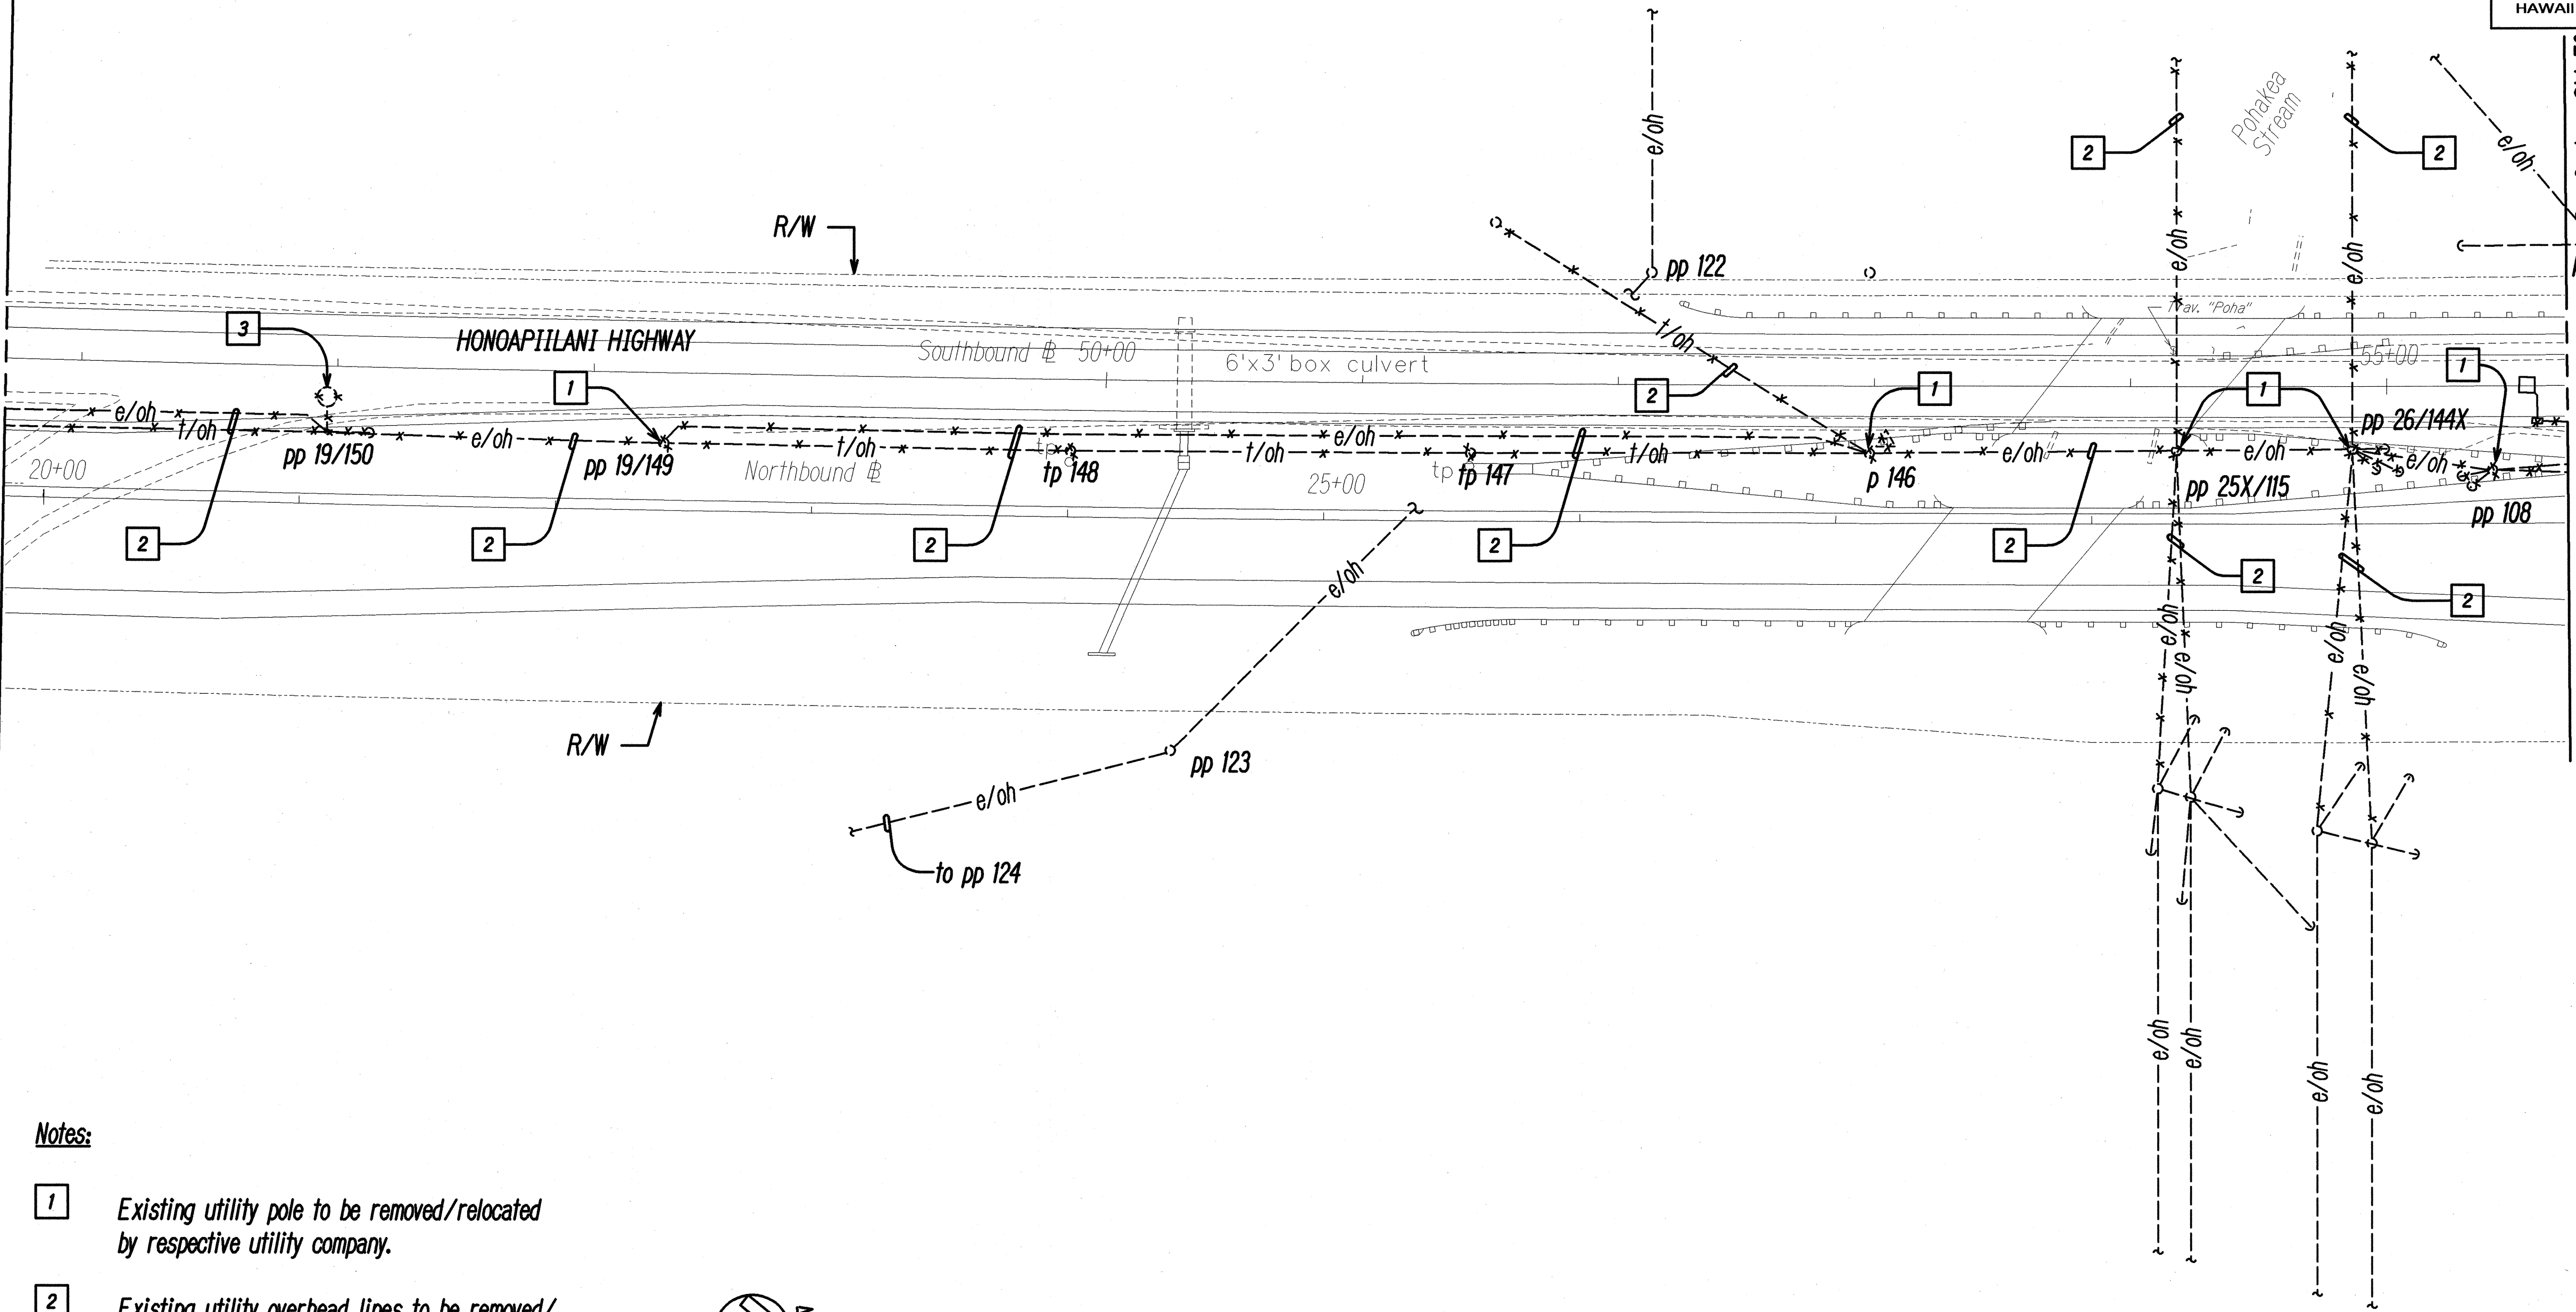


See Cont on Shift E6

ML S.B. Sta. 55+70.00

Notes:


- 1 Existing utility pole to be removed/relocated by respective utility company.
- 2 Existing utility overhead lines to be removed/relocated by respective utility company.
- 3 Existing luminaire and luminaire arm to be remove by MECo.

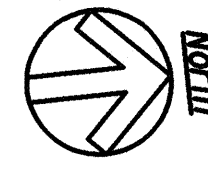

ELECTRICAL DEMOLITION PLAN - III
Scale: 1"=40'-0"

ORIGINAL PLAN	SURVEY PLOTTED BY	DATE
NOTE BOOK	DRAWN BY	
	DESIGNED BY	
	CHECKED BY	

15 MAY 100 10:07:16 TE 24-headarc01.ctb\\sigs\\l\\d\\delmop3.dgn

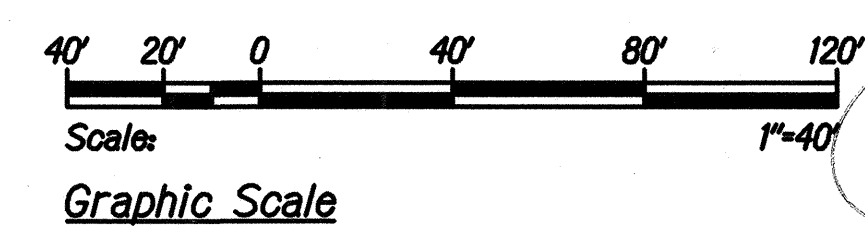

GARY I. FUNASAKI
 LICENSED PROFESSIONAL ENGINEER
 No. 9186-E
 HAWAII, U.S.A.

[Signature]
 This Work was Prepared by Me or Under My Supervision

STATE OF HAWAII
DEPARTMENT OF TRANSPORTATION
HIGHWAYS DIVISION

ELECTRICAL DEMOLITION PLAN - III

HONOAPIILANI HIGHWAY WIDENING
 North Kihei Road to Kulhelani Highway
 F.A. Project No. BR-NH-030-1(24)


Scale: 1"=40' Date: Apr. 2000
 SHEET No. E5 OF 22 SHEETS

See Cont on Sht E5

ML S.B. Sta. 55+70.00

See Cont on Sht E7

ML S.B. Sta. 65+60.69

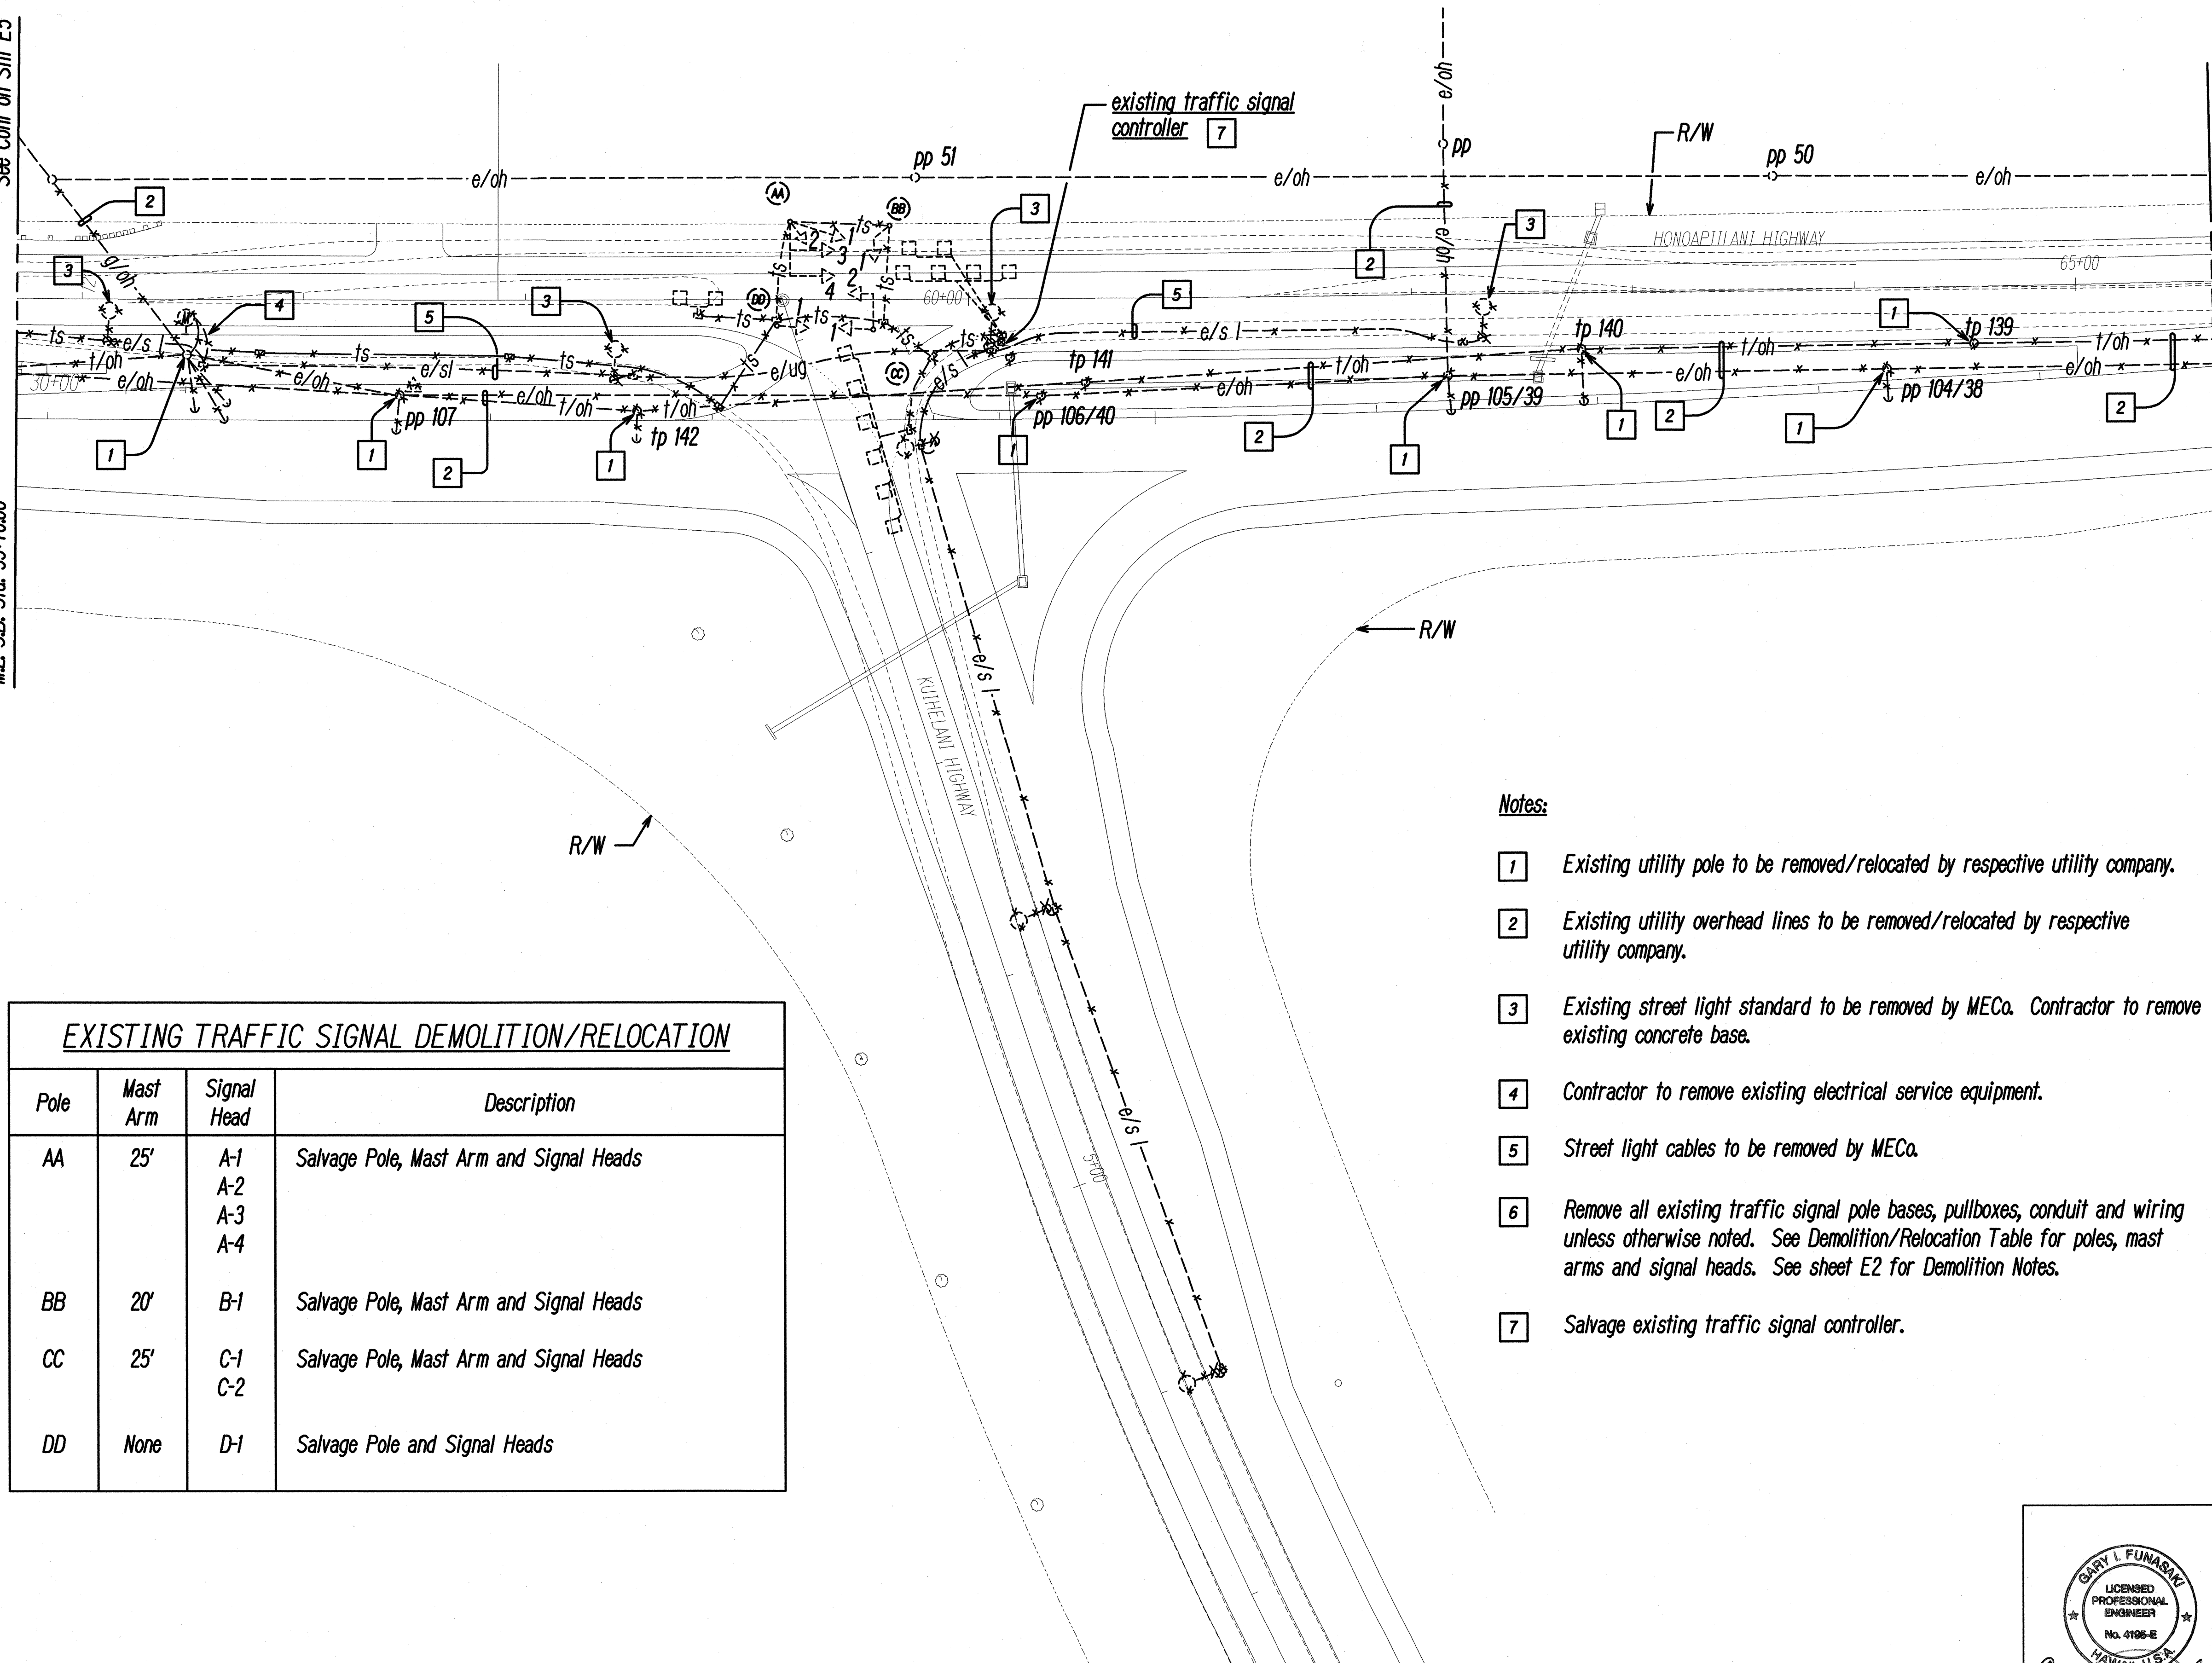


Notes:

- 1 Existing utility pole to be removed/relocated by respective utility company.
- 2 Existing utility overhead lines to be removed/relocated by respective utility company.
- 3 Existing street light standard to be removed by MECo. Contractor to remove existing concrete base.
- 4 Contractor to remove existing electrical service equipment.
- 5 Street light cables to be removed by MECo.
- 6 Remove all existing traffic signal pole bases, pullboxes, conduit and wiring unless otherwise noted. See Demolition/Relocation Table for poles, mast arms and signal heads. See sheet E2 for Demolition Notes.
- 7 Salvage existing traffic signal controller.


ORIGINAL PLAN	SURVEY PLOTTED BY	DATE
NOTE BOOK	DRAWN BY	
	DESIGNED BY	
	CHECKED BY	

23 MAY 100 11:54:53 AM Z:\work\projects\hawaii\100dmap004.dgn

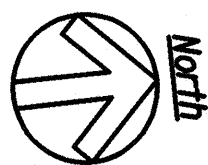

ELECTRICAL DEMOLITION PLAN - IV 6

Scale: 1"=40'-0"

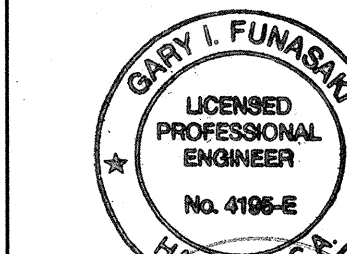

This Work was Prepared by Me
and Under My Supervision

STATE OF HAWAII
DEPARTMENT OF TRANSPORTATION
HIGHWAYS DIVISION



ELECTRICAL DEMOLITION PLAN - IV

HONOAPIILANI HIGHWAY WIDENING
North Kihei Road to Kuihelani Highway
E.A. Project No. BR-NH-030-1(24)

Scale: 1"=40' Date: Apr. 2000

SHEET No. E6 OF 22 SHEETS



FED. ROAD DIST. NO.	STATE	FED. AID PROJ. NO.	FISCAL YEAR	SHEET NO.	TOTAL SHEETS
HAWAII	HAW.	BR-NH-030-1(24)	2000	112	139

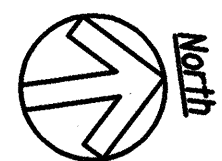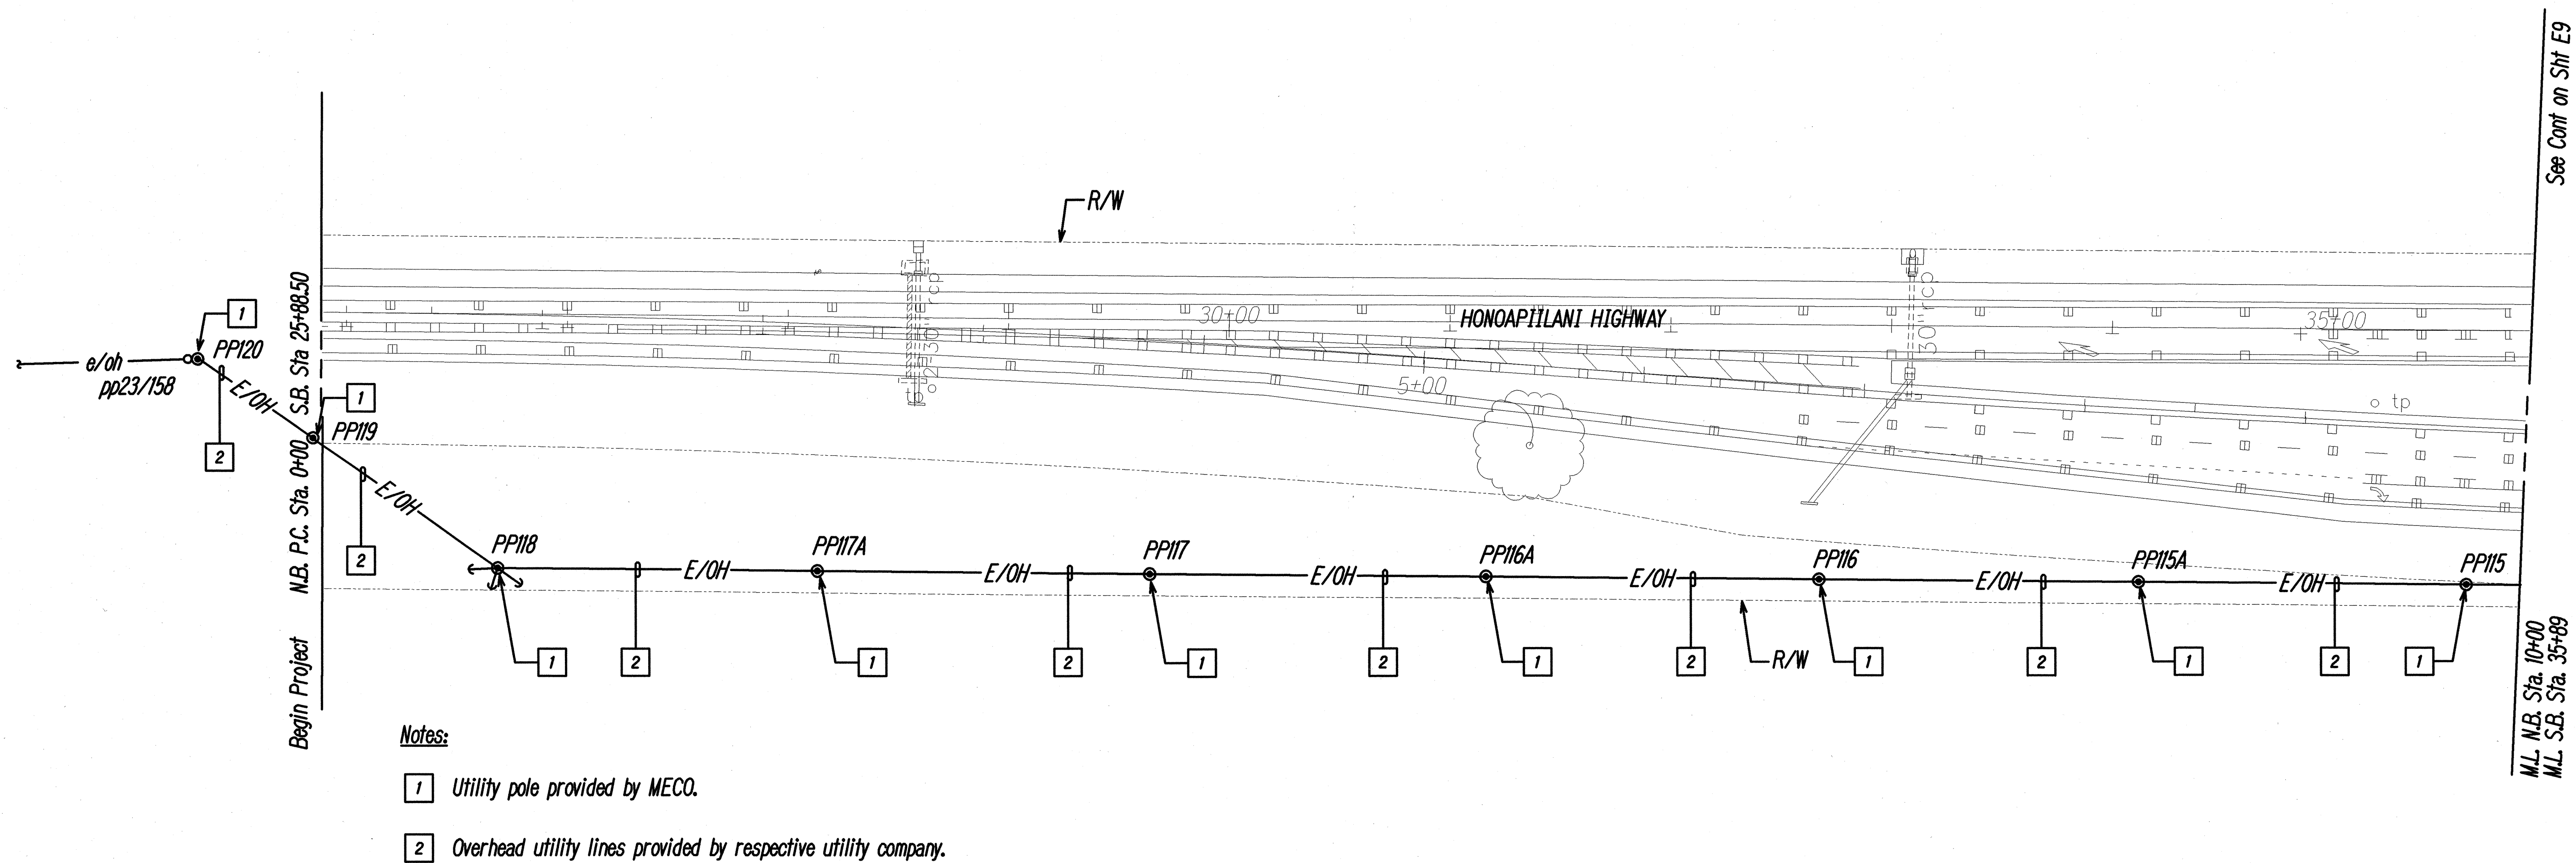

ELECTRICAL PLAN - I

Scale: 1"=40'-0"

ORIGINAL PLAN	DATE
DESIGNED BY	
DRAWN BY	
CHECKED BY	
NOTED BY	

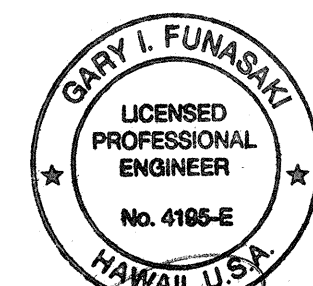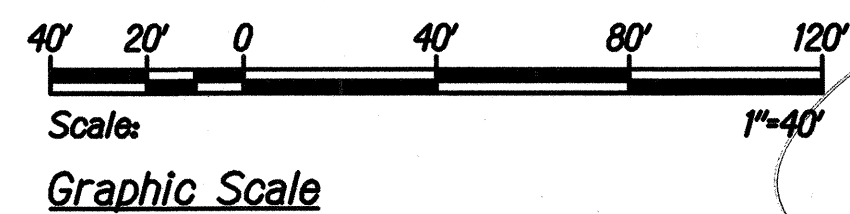

This Work was Prepared by Me or Under My Supervision

STATE OF HAWAII
DEPARTMENT OF TRANSPORTATION
HIGHWAYS DIVISION

ELECTRICAL PLAN - I

HONOAPIʻILANI HIGHWAY WIDENING
North Kihel Road to Kuihelani Highway
F.A. Project No. BR-NH-030-1(24)

Scale: 1"=40' Date: Apr. 2000

SHEET No. E8 OF 22 SHEETS

FED. ROAD DIST. NO.	STATE	FED. AID PROJ. NO.	FISCAL YEAR	SHEET NO.	TOTAL SHEETS
HAWAII	HAW.	BR-NH-030-1(24)	2000	113	139


1	36+93
2	H01
3	8'
4	8'
5	TB
6	30'

1	38+41
2	H03
3	8'
4	8'
5	TB
6	30'

1	39+90
2	H05
3	8'
4	8'
5	TB
6	30'

1	41+39
2	H09
3	CL
4	12'
5	TB
6	30'

1	43+87
2	H010
3	CL
4	12'
5	TB
6	30'

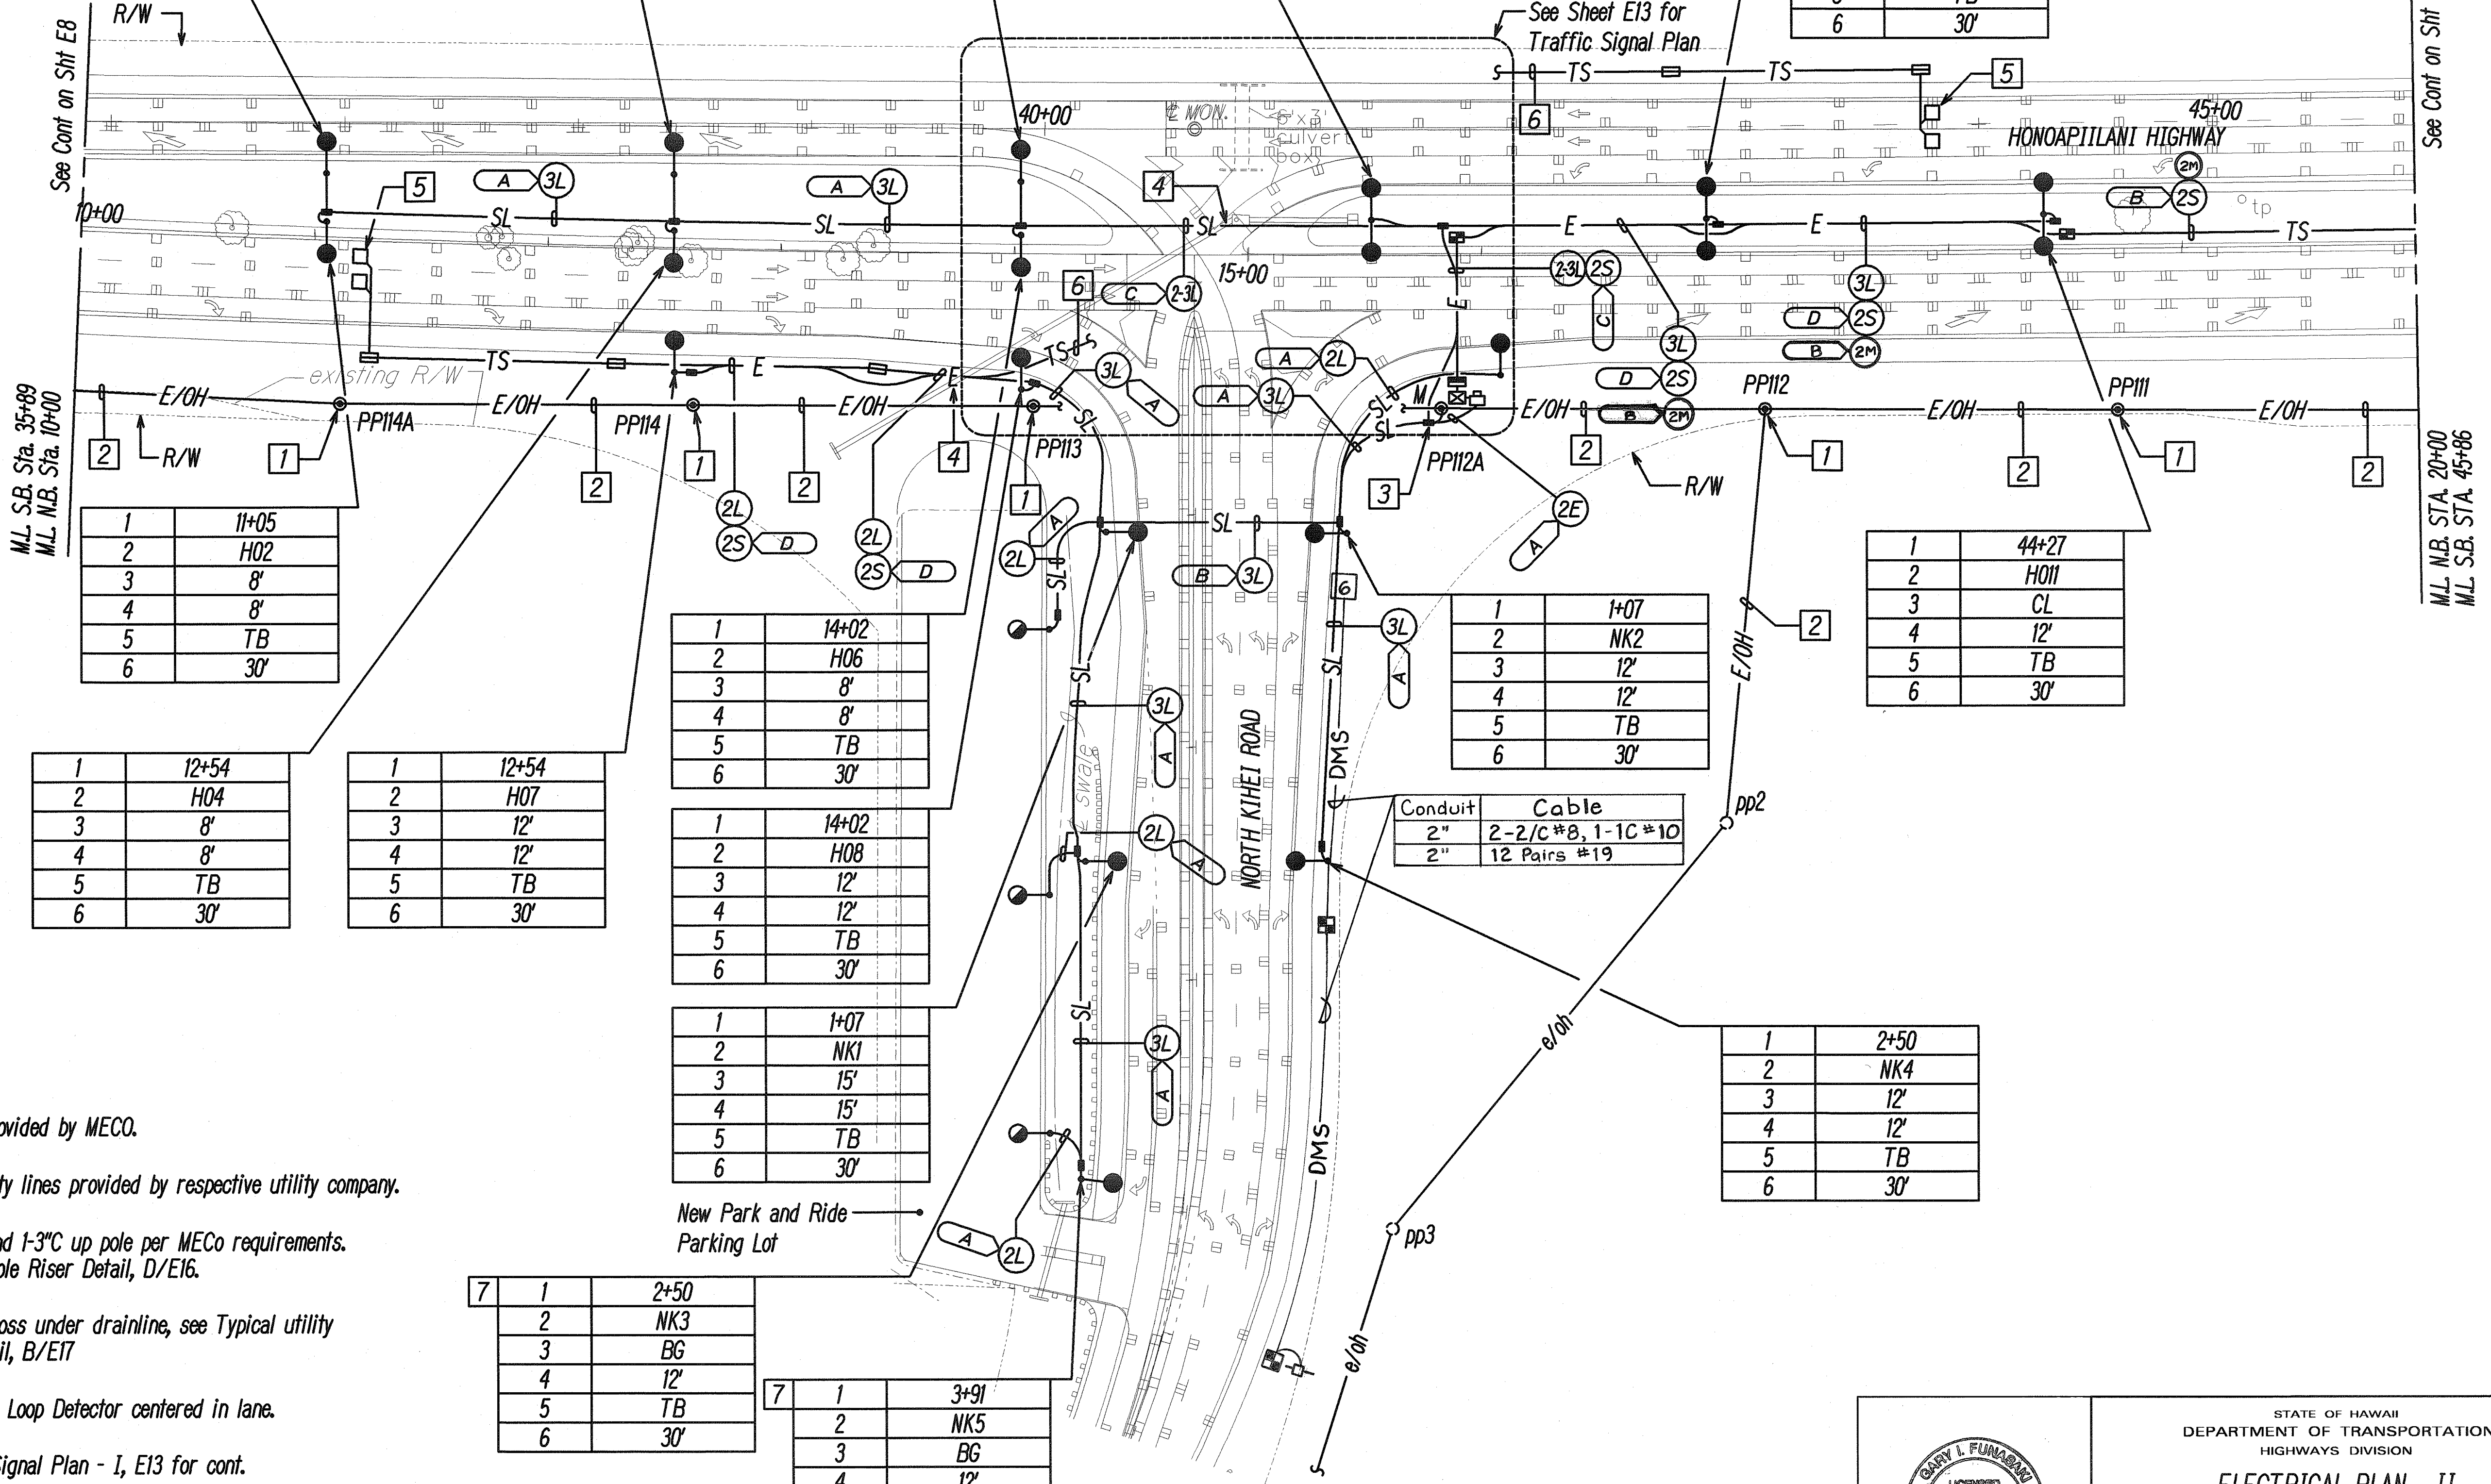


Notes:

- 1 Utility pole provided by MECO.
- 2 Overhead utility lines provided by respective utility company.
- 3 Riser 1-2" and 1-3" up pole per MECO requirements. see Typical Pole Riser Detail, D/E16.
- 4 Ductline to cross under drainline, see Typical utility Crossing Detail, B/E17.
- 5 2 ea. 1-6' X 6' Loop Detector centered in lane.
- 6 See Traffic Signal Plan - I, E13 for cont.
- 7 Provide 2'-0" minimum clearance between Guardrail Post and Street Light Standard.


1	2+50
2	NK3
3	BG
4	12'
5	TB
6	30'

1	3+91
2	NK5
3	BG
4	12'
5	TB
6	30'

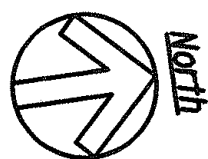

ELECTRICAL PLAN - II

Scale: 1"=40'-0"

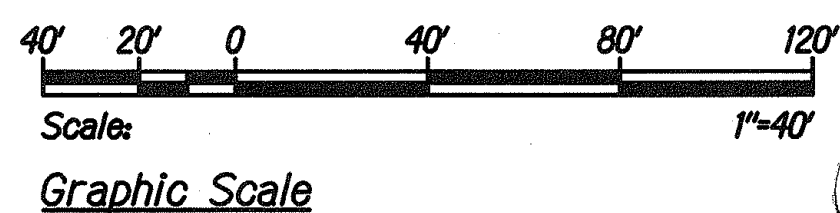

This Work was Prepared by Me or Under My Supervision

STATE OF HAWAII
DEPARTMENT OF TRANSPORTATION
HIGHWAYS DIVISION

ELECTRICAL PLAN - II


HONOAPIʻILANI HIGHWAY WIDENING
North Kihel Road to Kuihelani Highway
F.A. Project No. BR-NH-030-1(24)

Scale: 1"=40' Date: Apr. 2000

SHEET No. E9 OF 22 SHEETS


"AS-BUILT"

FED. ROAD DIST. NO.	STATE	FED. AID PROJ. NO.	FISCAL YEAR	SHEET NO.	TOTAL SHEETS
HAWAII	HAW.	BR-NH-030-1(24)	2000	114	139

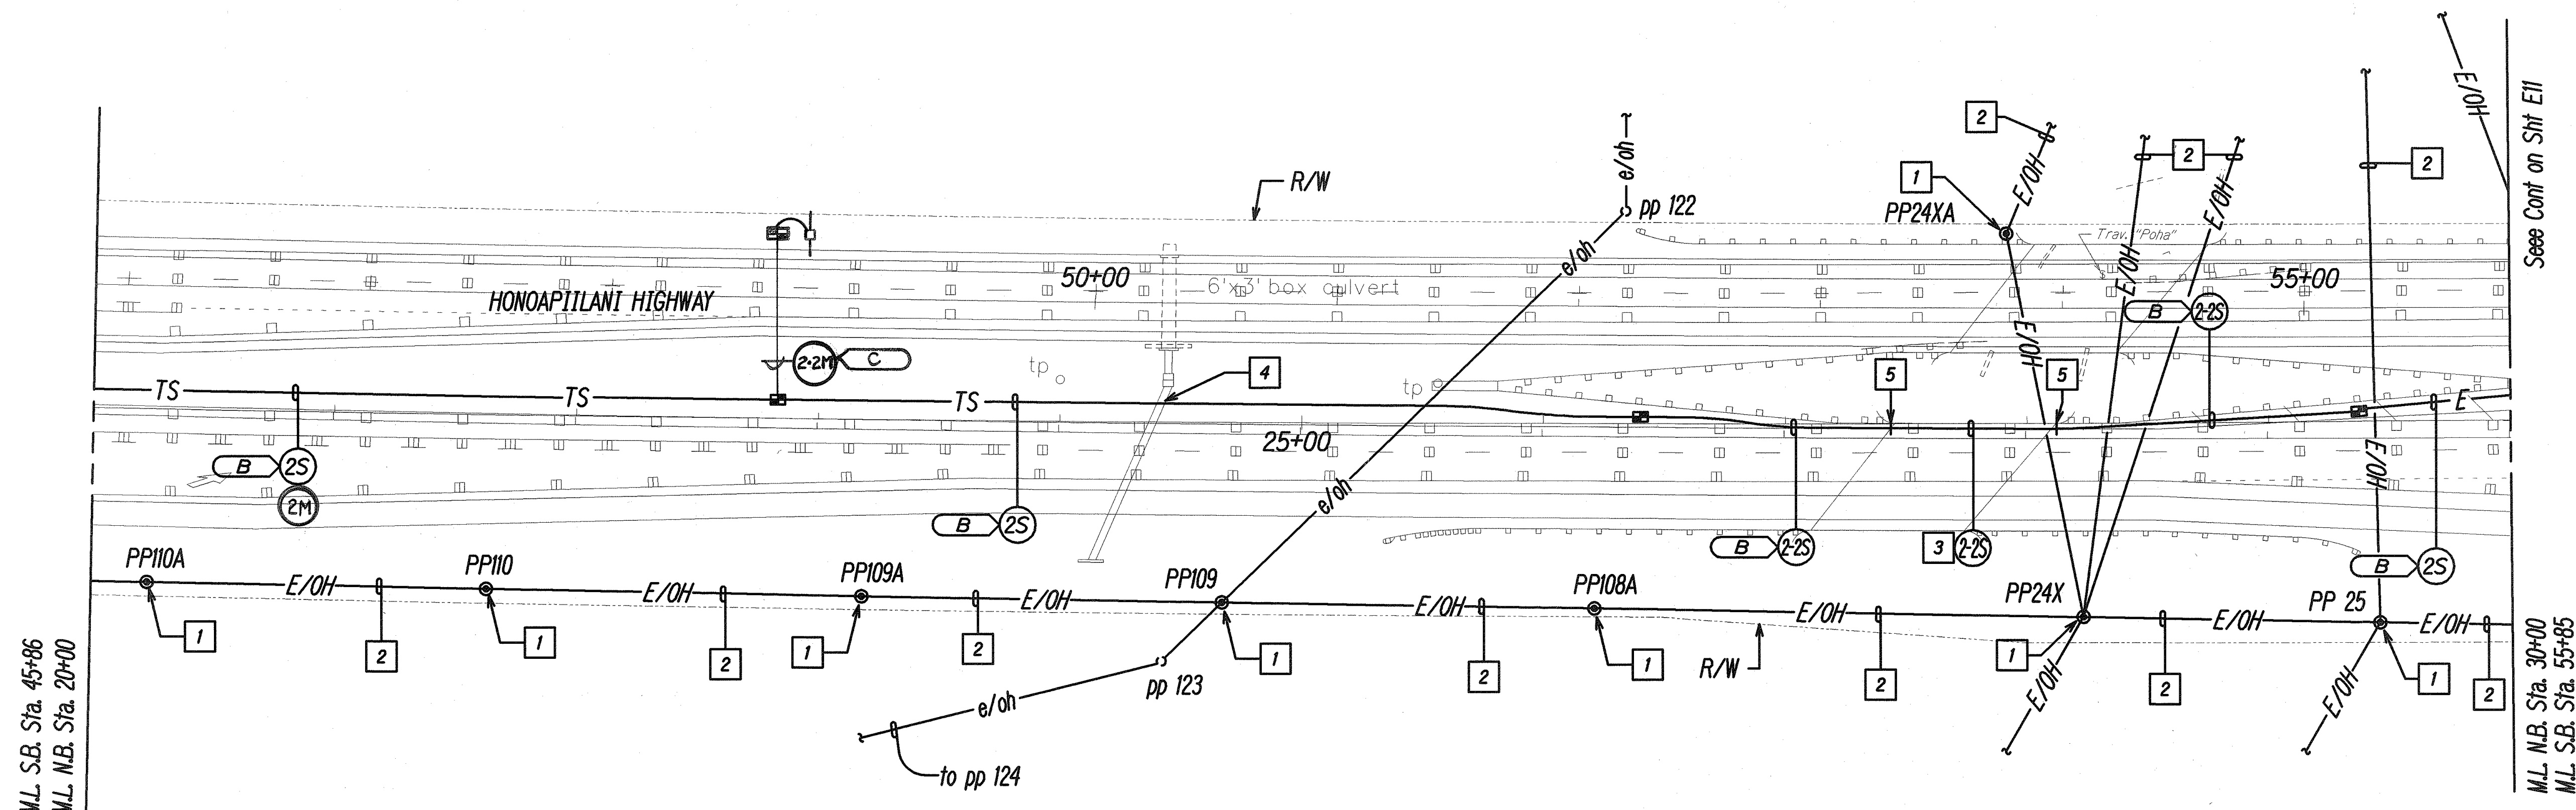


ELECTRICAL PLAN - III
Scale: 1"=40'-0"


- Notes:**
- 1 Utility pole provided by MECO.
 - 2 Overhead utility lines provided by respective utility company.
 - 3 Ductline routed in bridge concrete rail, see B/E17.
 - 4 Ductline to cross under drainline, see Typical Utility Crossing Detail, A/E17.
 - 5 Provide conduit expansion couplings at bridge transition, see Typical Expansion Fitting Detail, A/E10.

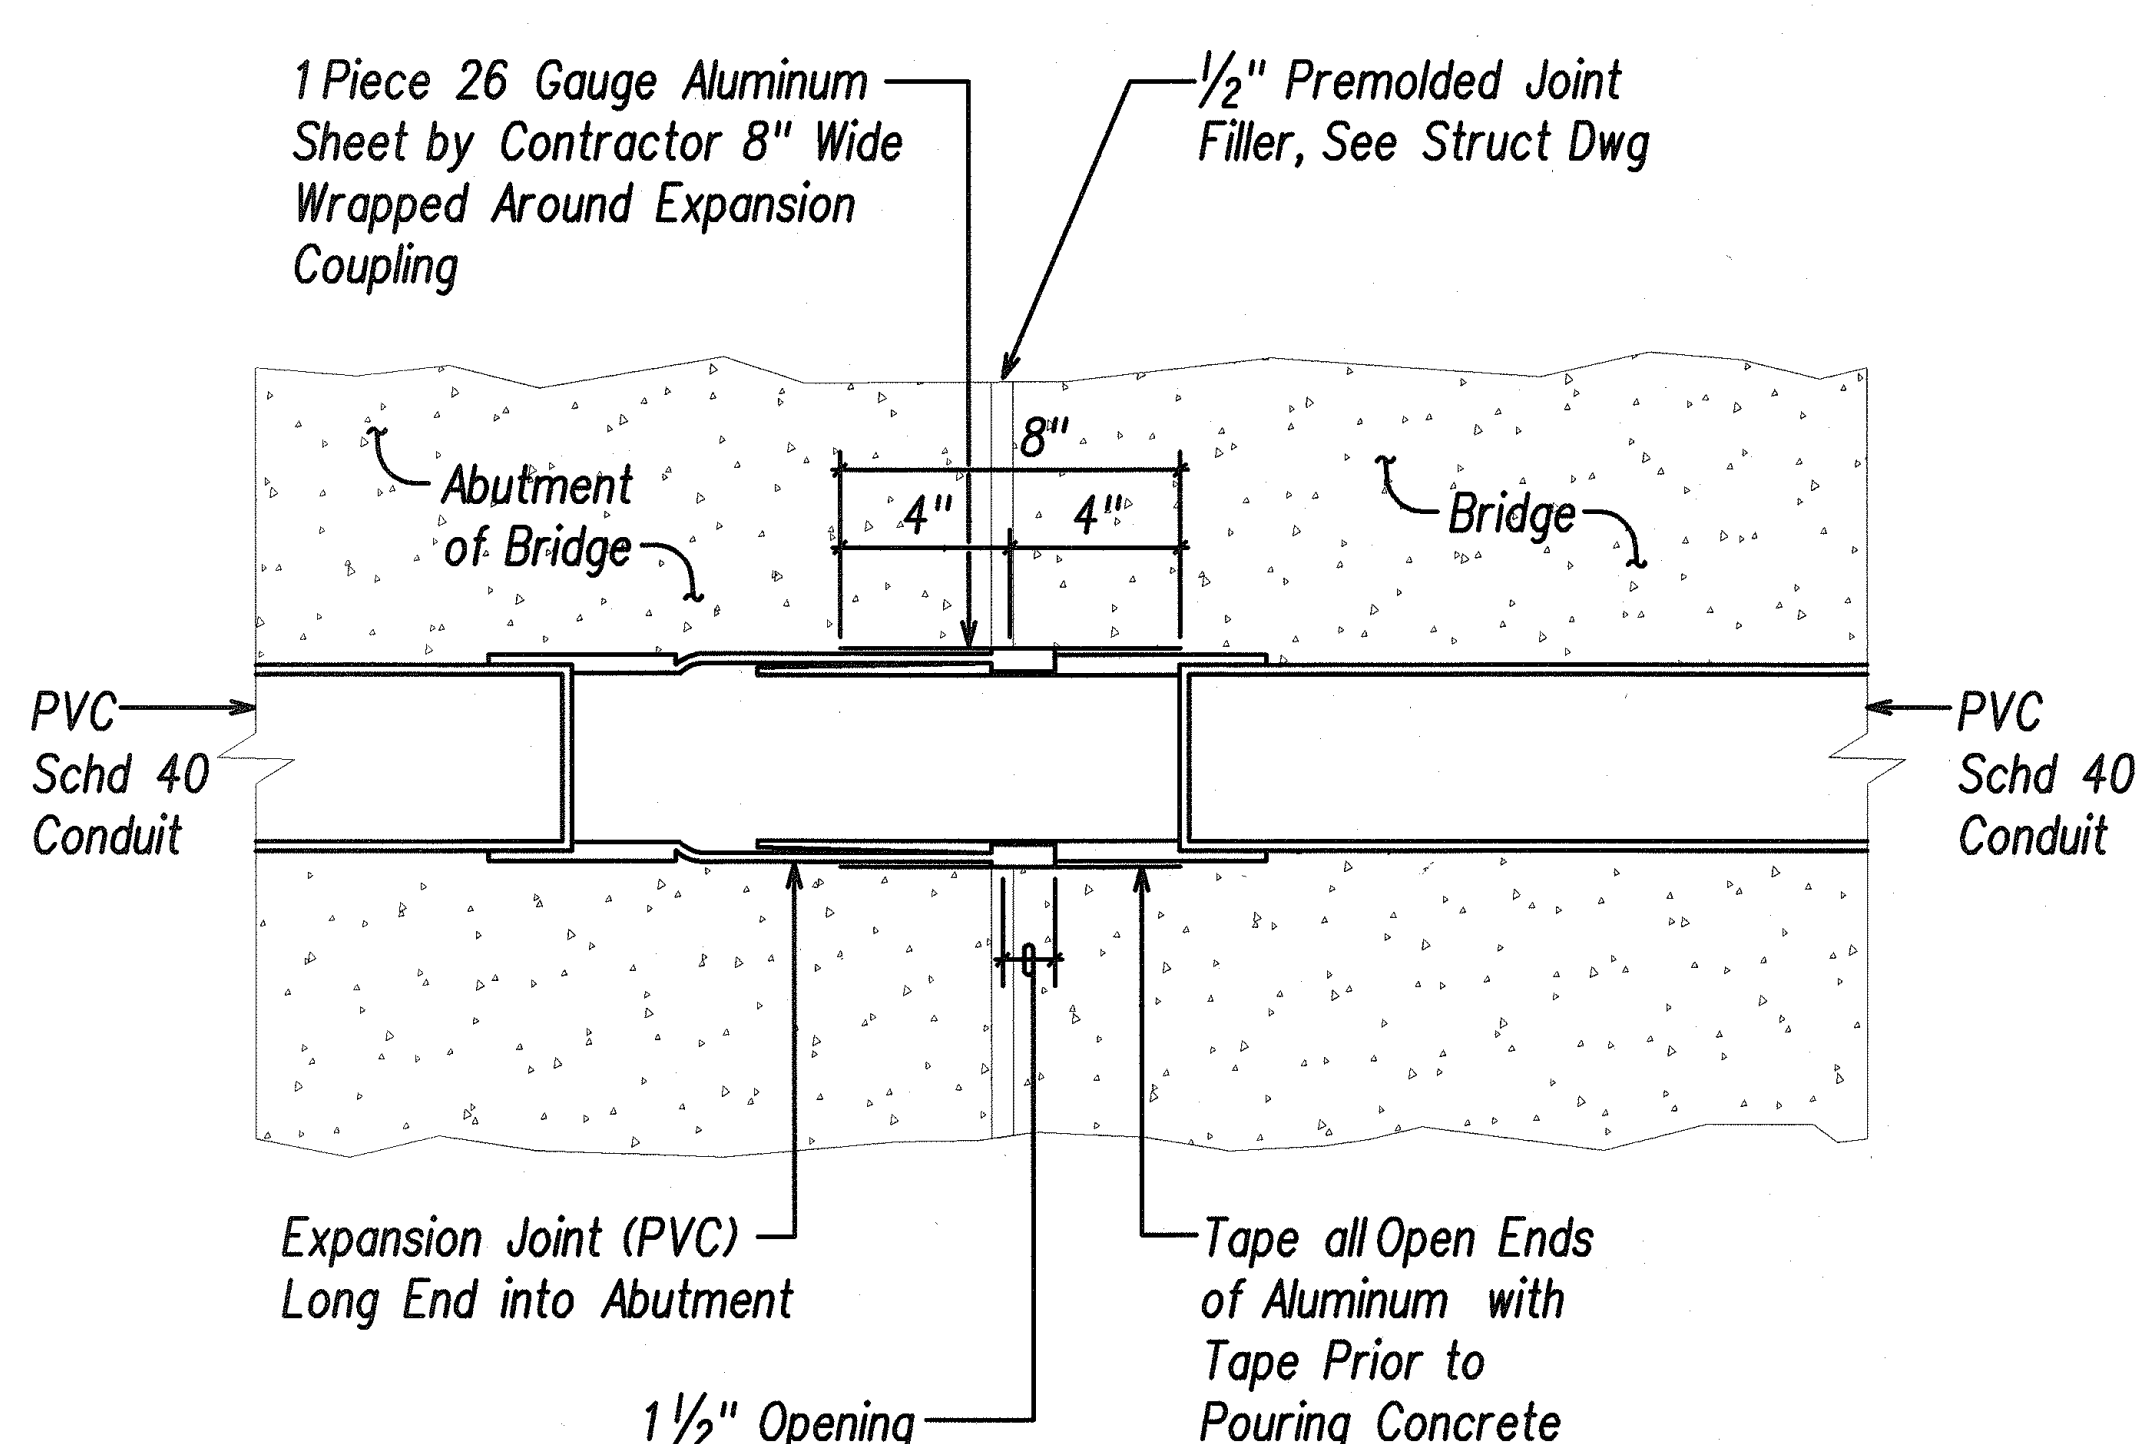


A TYPICAL EXPANSION FITTING DETAIL
E10 Not to Scale

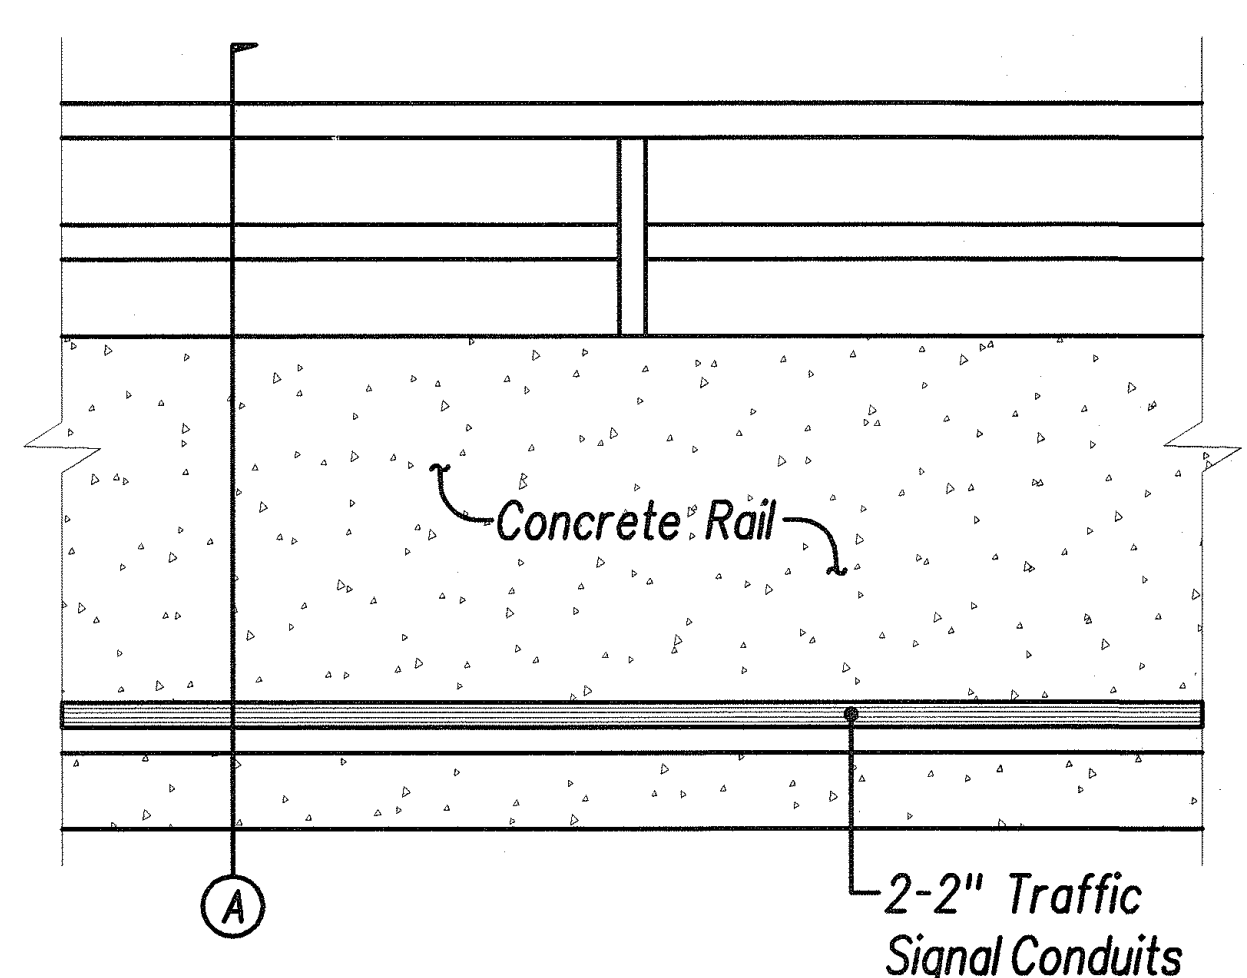

B CONCRETE RAIL DUCT ROUTING DETAIL
E10 Not to Scale

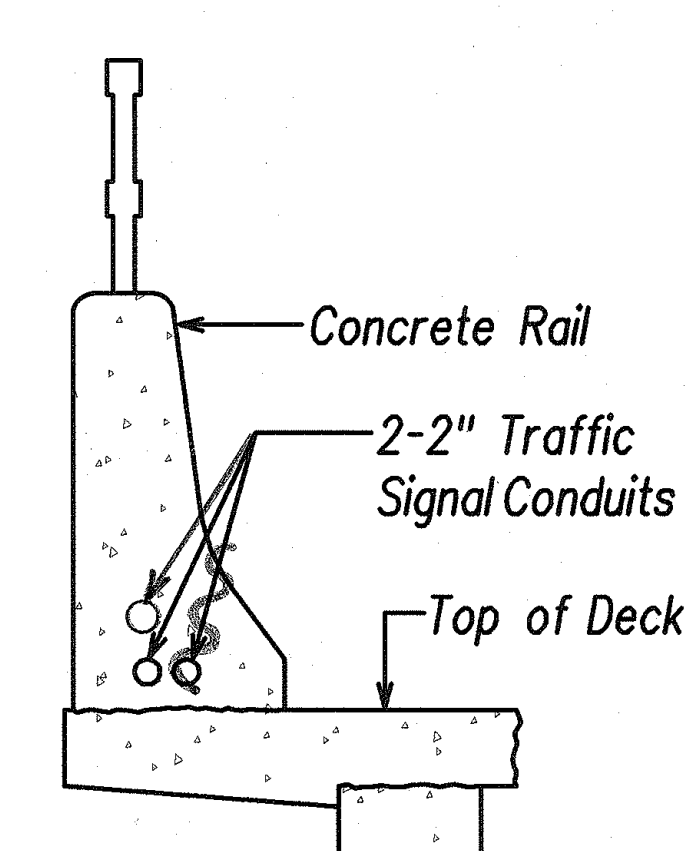

SECTION A

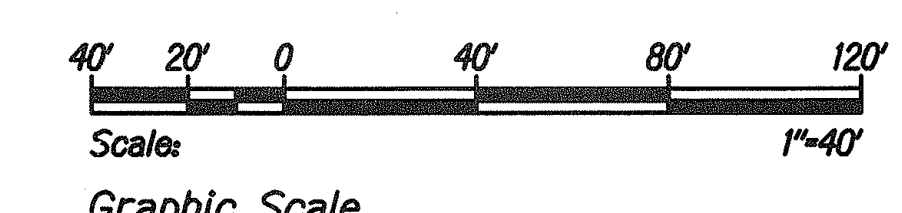

GARY I. FUNASAK
LICENSED PROFESSIONAL ENGINEER
No. 4105-E
HAWAII, U.S.A.
Date: Apr. 2000
This Work was Prepared by Me or Under My Supervision

STATE OF HAWAII
DEPARTMENT OF TRANSPORTATION
HIGHWAYS DIVISION
ELECTRICAL PLAN - III
HONOAPIILANI HIGHWAY WIDENING
North Kihel Road to Kihelani Highway
F.A. Project No. BR-NH-030-1(24)
Scale: 1"=40' Date: Apr. 2000
SHEET No. E10 OF 22 SHEETS

"AS-BUILT"

FED. ROAD DIST. NO.	STATE	FED. AID PROJ. NO.	FISCAL YEAR	SHEET NO.	TOTAL SHEETS
HAWAII	HAW.	BR-NH-030-1(24)	2000	115	139

1	32+84
2	HO14
3	CL
4	12'
5	TB
6	30'

1	58+38
2	HO15
3	CL
4	12'
5	TB
6	30'

1	60+28
2	HO18
3	8'
4	8'
5	TB
6	30'

1	61+73
2	HO20
3	8'
4	8'
5	TB
6	30'

1	30+04
2	HO12
3	8'
4	8'
5	TB
6	30'

1	60+28
2	HO19
3	8'
4	8'
5	TB
6	30'

1	30+04
2	HO13
3	15'
4	12'
5	TB
6	30'

1	31+42
2	HO16
3	12'
4	12'
5	TB
6	30'

1	32+84
2	HO17
3	12'
4	12'
5	TB
6	30'

1	2+44
2	KU1
3	12'
4	12'
5	TB
6	30'

1	4+00
2	KU3
3	12'
4	12'
5	TB
6	30'

1	2+70
2	KU2
3	12'
4	12'
5	TB
6	30'


1	61+73
2	HO21
3	8'
4	8'
5	TB
6	30'

1	63+24
2	HO22
3	CL
4	12'
5	TB
6	30'



1	4+00
2	KU4
3	12'
4	12'
5	TB
6	30'

Notes:

- 1 Utility pole provided by MECO.
- 2 Overhead utility lines provided by respective utility company.
- 3 Riser 1-2"C and 1-3"C Up pole per MECO requirements. See Typical Pole Riser Detail, C/E16
- 4 Ductline to cross under drainline, see Typical Utility crossing Detail, A/E17
- 5 2 ea. 1-6' X 6' Loop Detector Centered in Lane.
- 6 See Traffic Signal Plan - II, Sheet E14 for cont.

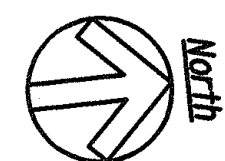

ELECTRICAL PLAN - IV
Scale: 1"=40'-0"

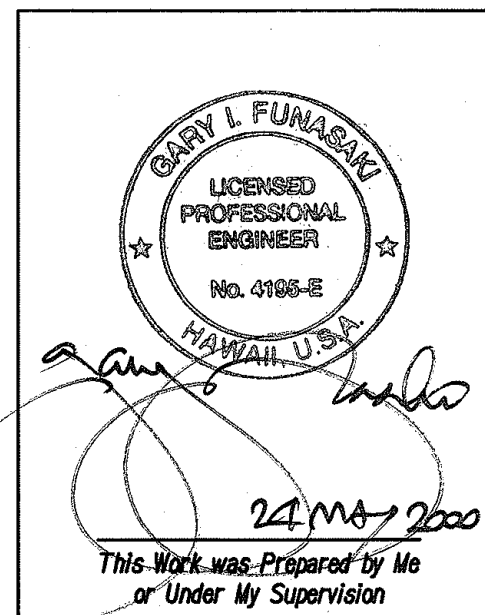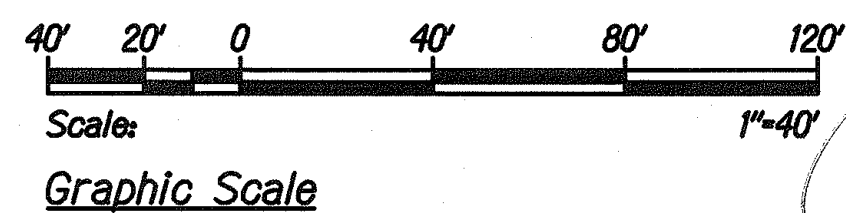

STATE OF HAWAII
DEPARTMENT OF TRANSPORTATION
HIGHWAYS DIVISION

ELECTRICAL PLAN - IV

HONOAPIILANI HIGHWAY WIDENING
North Kihel Road to Kihelani Highway
F.A. Project No. BR-NH-030-1(24)

Scale: 1"=40' Date: Apr. 2000
SHEET No. E11 OF 22 SHEETS

"AS-BUILT"

List of Materials			
Pole Letter	Standard Type	Mounting Type	Signal Faces & Opticom Receivers
A	II - 36	Mast Arm - One Way Mast Arm - One Way Mast Arm - One Way Mast Arm - Hor.	R-Y-G ↑ R-Y-G ↑ R-Y-G ← Opticom
B	I - 10	Slipfitter - Two Way	R-Y-G ↑, R-Y-G ←
C	I - 10	Slipfitter - Two Way Tp - Evp.	R-Y-G ←, R-Y-G ← Opticom
D	II - 20	Mast Arm - One Way Mast Arm - One Way Bracket Arm - One Way Bracket Arm - Vertical Mast Arm - Hor.	R-Y-G ↑ R-Y-G ↑ R-Y-G Opticom Opticom
E	I - 10	Slipfitter - Two Way	R-Y-G, R-Y-G ←

Conduit	Cable
2"	1-26C*14
2"	Spare

Conduit	Cable
2"	3-4/C*14
2"	1-3/C*20
2"	Spare

Conduit	Cable
2"	2-4/C*14

Conduit	Cable
2"	1-26C*14
2"	2-2C*14
2"	Spare


Conduit	Cable
2"	1-2C*14

Conduit	Cable
2"	1-2C*14

Note:


- See Electrical Plan - II, Sheet E9 for Cont.
- Ductline to cross under Drainline, see Typical utility crossing Detail, B/E17
- Stub-out and Cap Conduit 12" Min from Footing.

FED. ROAD DIST. NO.	STATE	FED. AID PROJ. NO.	FISCAL YEAR	SHEET NO.	TOTAL SHEETS
HAWAII	HAW.	BR-NH-030-1(24)	2000	117	139

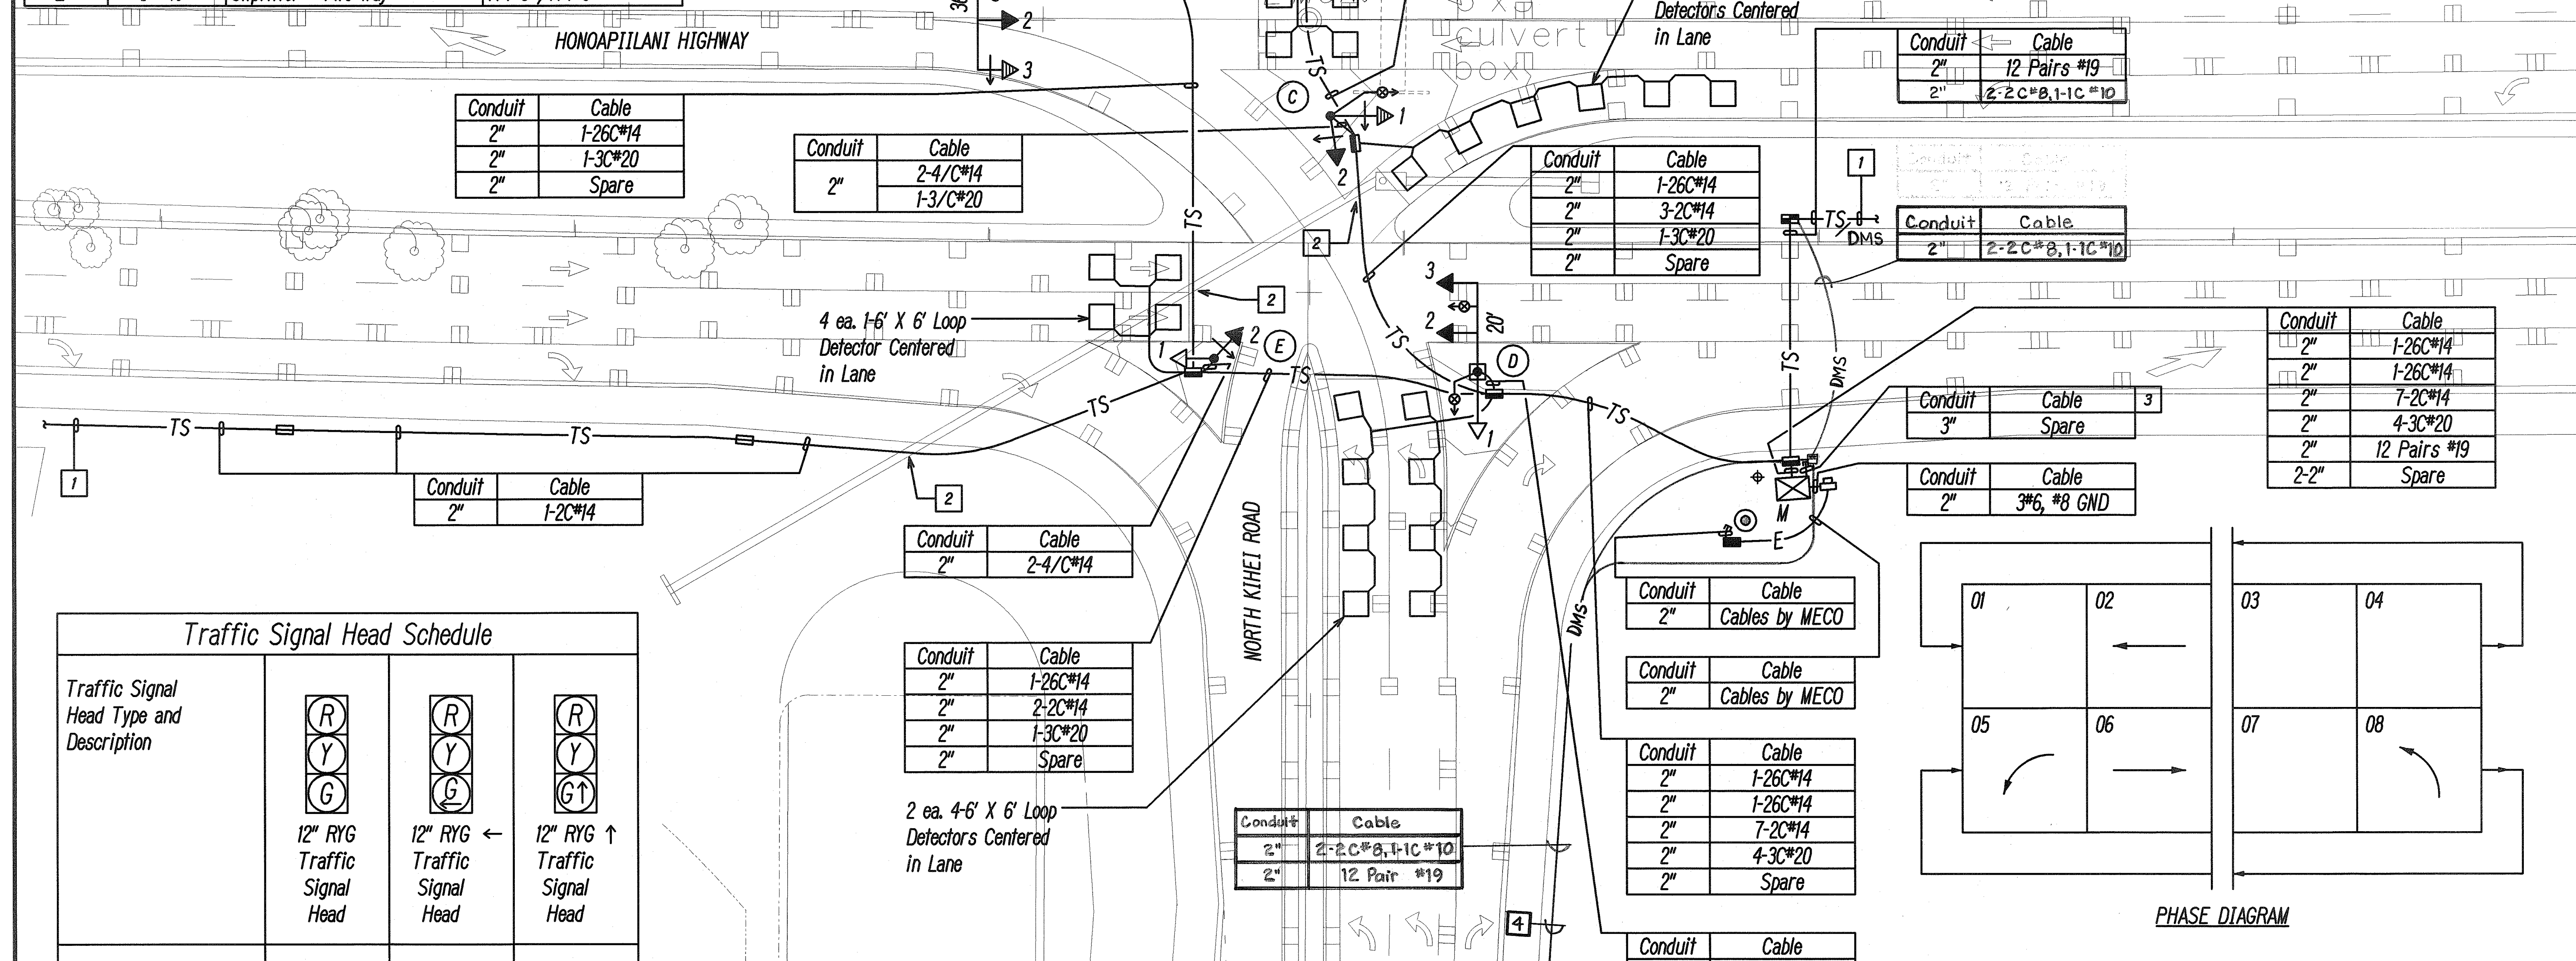


Traffic Signal Head Schedule			
Traffic Signal Head Type and Description			
	12" RYG Traffic Signal Head	12" RYG Traffic Signal Head	12" RYG Traffic Signal Head
Pole Letter	D-1	A-3 *	A-1 A-2
Signal Head Number	E-1	B-2 C-1 * C-2 E-2	B-1 D-2 D-3

* Programmable Visibility Head

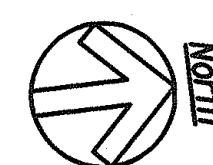

TRAFFIC SIGNAL PLAN - I
Scale: 1"=20'

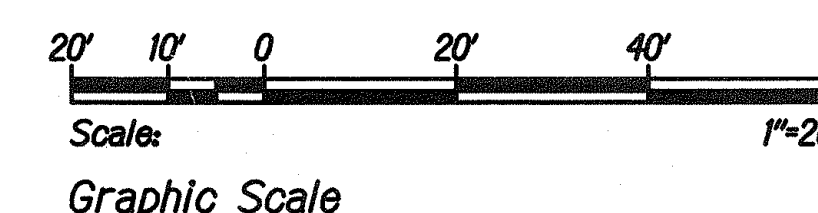

24 MAY 2000
This Work was Prepared by Me or Under My Supervision

STATE OF HAWAII
DEPARTMENT OF TRANSPORTATION
HIGHWAYS DIVISION

TRAFFIC SIGNAL PLAN - I

HONOAPIʻILANI HIGHWAY WIDENING
North Kihei Road to Kūihelani Highway
F.A. Project No. BR-NH-030-1(24)

Scale: 1"=20' Date: Apr. 2000

SHEET No. E13 OF 22 SHEETS

"AS-BUILT"

List of Materials			
Pole Letter	Standard Type	Mounting Type	Signal Faces & Opticom Receivers
A	I - 10	Slipfitter - One Way	R-Y-G ← Opticom
B	I - 10	Slipfitter - Two Way	RYG ↑, R-Y-G ←
C	I - 10	Slipfitter - One Way	R-Y-G ←
D	II - 33	Bracket Arm - Two Way	R-Y-G, R-Y-G
		Mast Arm - One Way	R-Y-G ←
		Mast Arm - One Way	R-Y-G
		Mast Arm - Hor.	Opticom
E	*II - 40	Bracket Arm - One Way	R-Y-G ←
F	II - 35	TP - EVP	Opticom
		Bracket Arm - One Way	R-Y-G ←
		Mast Arm - One Way	R-Y-G ↑
		Mast Arm - One Way	R-Y-G ↑
		Mast Arm - One Way	R-Y-G ←
		Mast Arm - Hor.	Opticom

* Provide Type II Standard for Future 40' Mast Arm

Conduit	Cable
2"	1-4/C*14
	1-3/C*20

Conduit	Cable
2"	1-26C*14
2"	Spare

Conduit	Cable
2"	12 Pairs #19


Conduit	Cable
2"	1-26C*14
2"	1-3C*20
2-2"	Spare

Conduit	Cable
2"	2-4/C*14

Notes:

- See Electrical Plan - II, Sheet E11 for Cont.
- Ductline to cross under Drainline. see Typical utility crossing Detail, B/E17
- Stub-out and Cap Conduit 12" Min from Footing.

FED. ROAD DIST. NO.	STATE	FED. AID PROJ. NO.	FISCAL YEAR	SHEET NO.	TOTAL SHEETS
HAWAII	HAW.	BR-NH-030-K(24)	2000	118	139

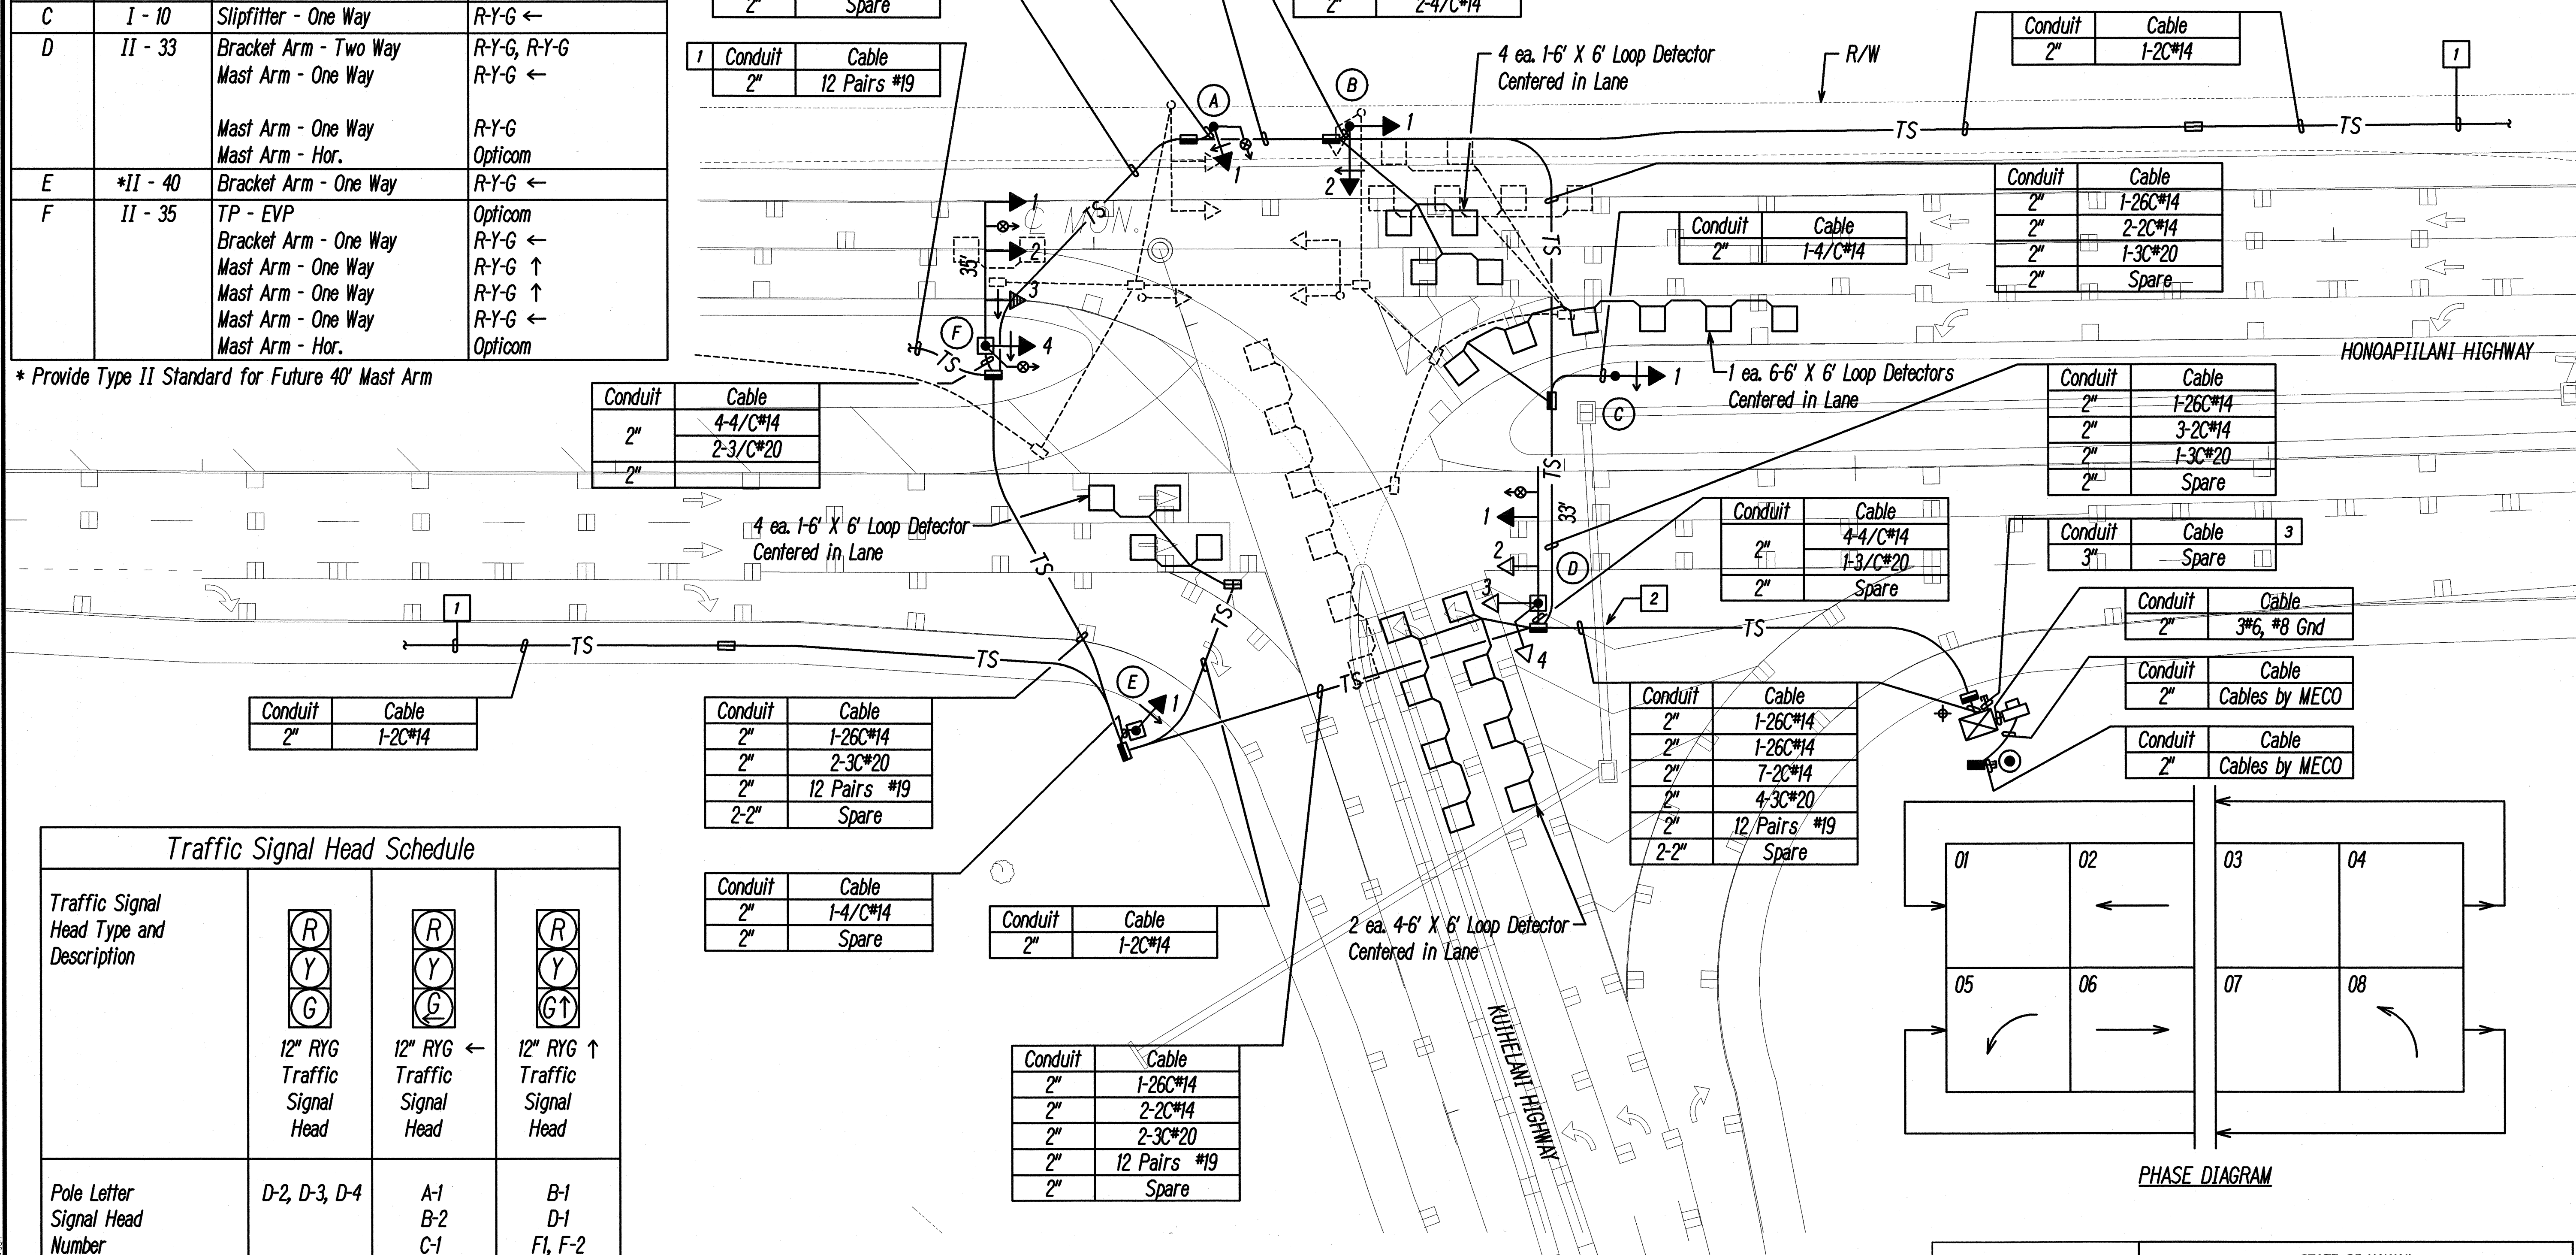



Traffic Signal Head Schedule

Traffic Signal Head Type and Description			
	12" RYG Traffic Signal Head	12" RYG ← Traffic Signal Head	12" RYG ↑ Traffic Signal Head
Pole Letter Signal Head Number	D-2, D-3, D-4	A-1 B-2 C-1 E-1 F-3 * F-4	B-1 D-1 F-1, F-2

* Programmable Visibility Head

TRAFFIC SIGNAL PLAN - II

Scale: 1"=20'

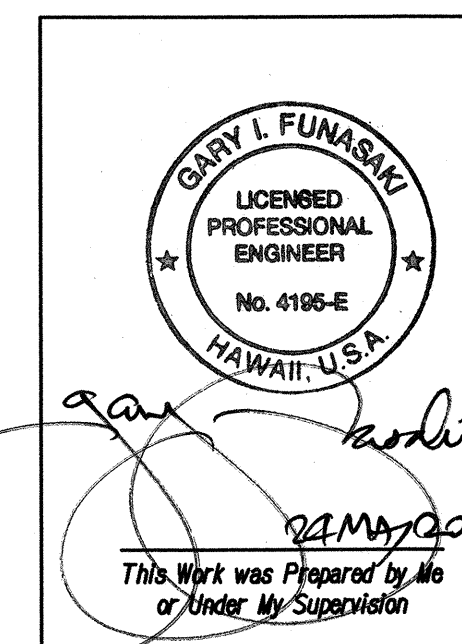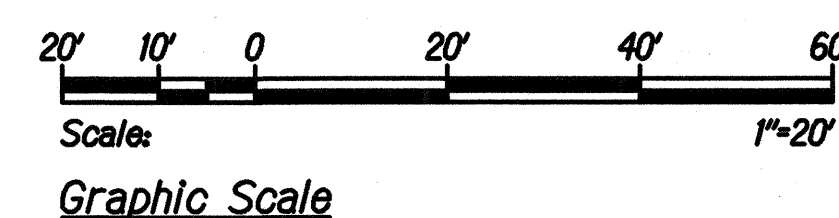

STATE OF HAWAII
DEPARTMENT OF TRANSPORTATION
HIGHWAYS DIVISION


TRAFFIC SIGNAL PLAN - II

HONOAPIILANI HIGHWAY WIDENING
North Kihelani Road to Kihelani Highway
F.A. Project No. BR-NH-030-K(24)

Scale: 1"=20' Date: Apr. 2000



SHEET No. E14 OF 22 SHEETS

FED. ROAD DIST. NO.	STATE	FED. AID PROJ. NO.	FISCAL YEAR	SHEET NO.	TOTAL SHEETS
HAWAII	HAW.	BR-NH-030-K(24)	2000	119	139

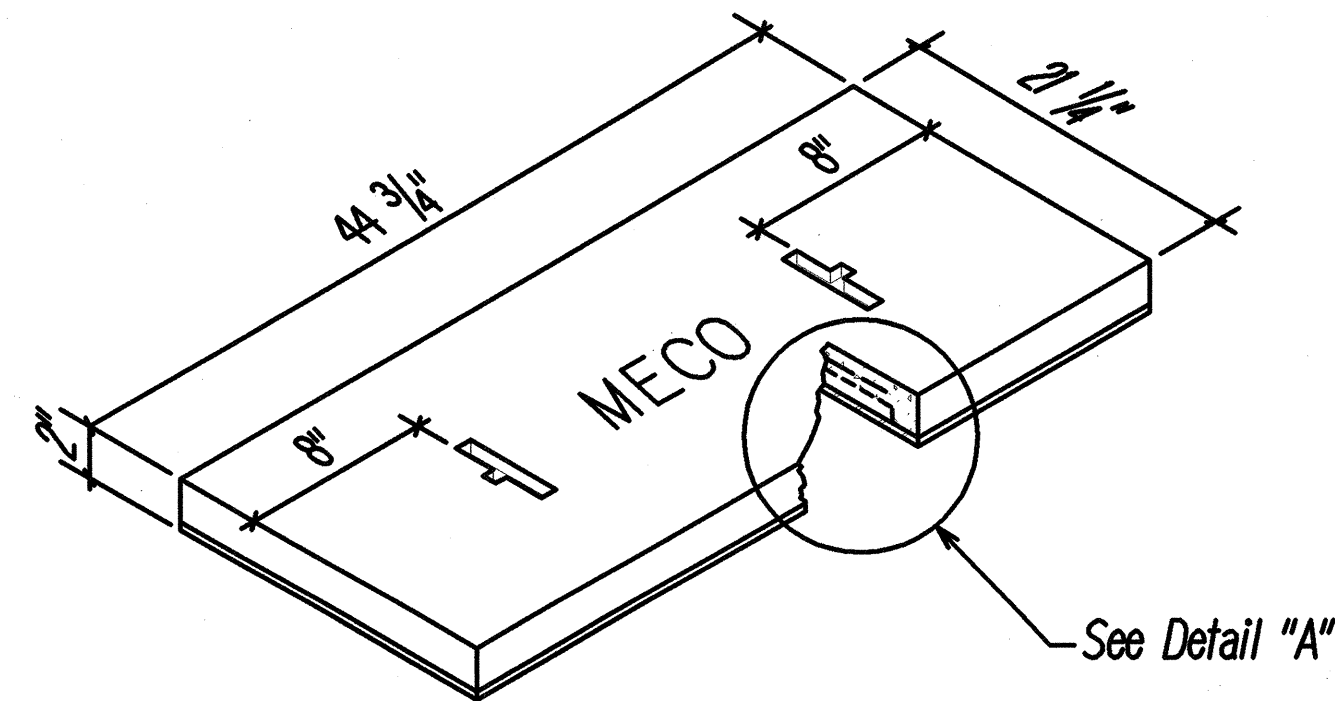


The Maui Electric Co., Inc. (MECO) Handholes shall be constructed by the Contractor as shown in these drawings & in accordance with the following standard drawings:



Type	Description
2' X 4' HECO Pullbox	2' X 4' Precast concrete pullbox with precast concrete cover, provided in accordance with HECO Standard Drawing No. 30-2005.

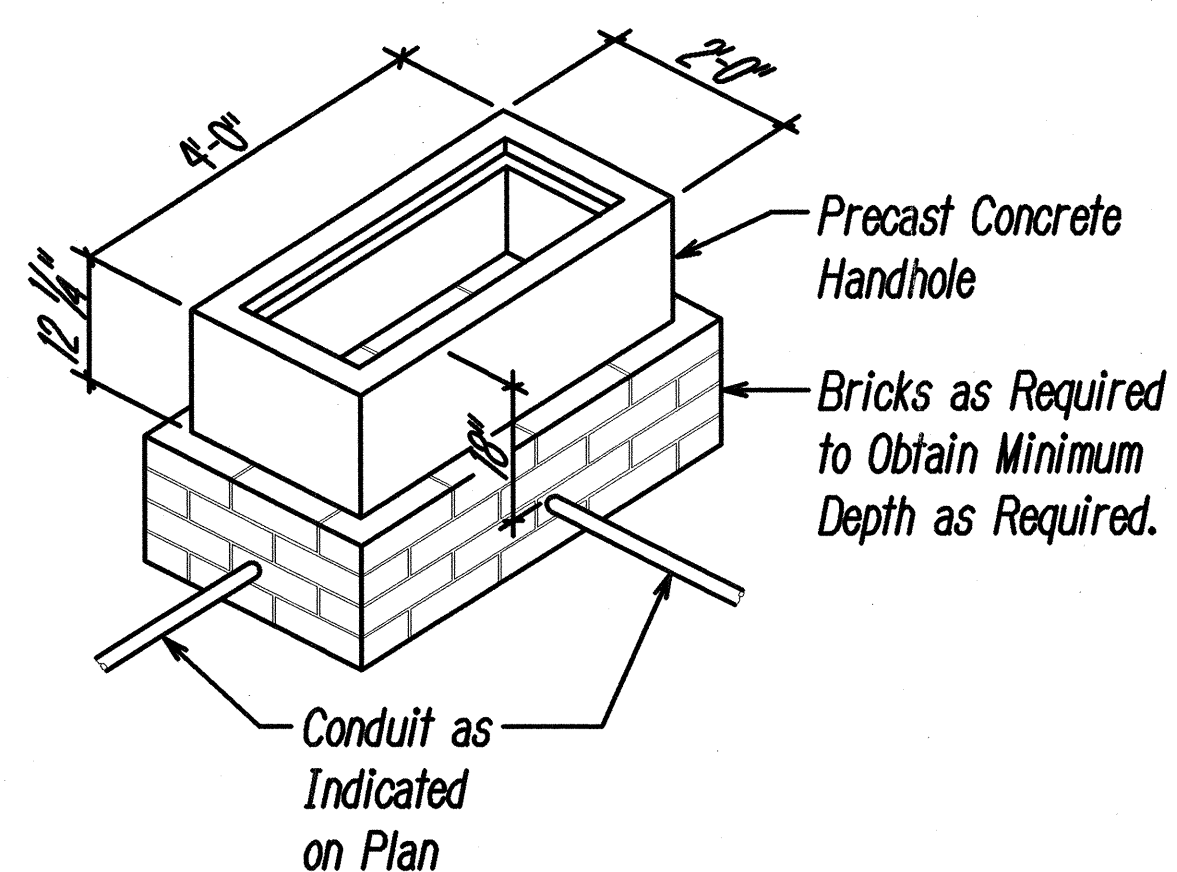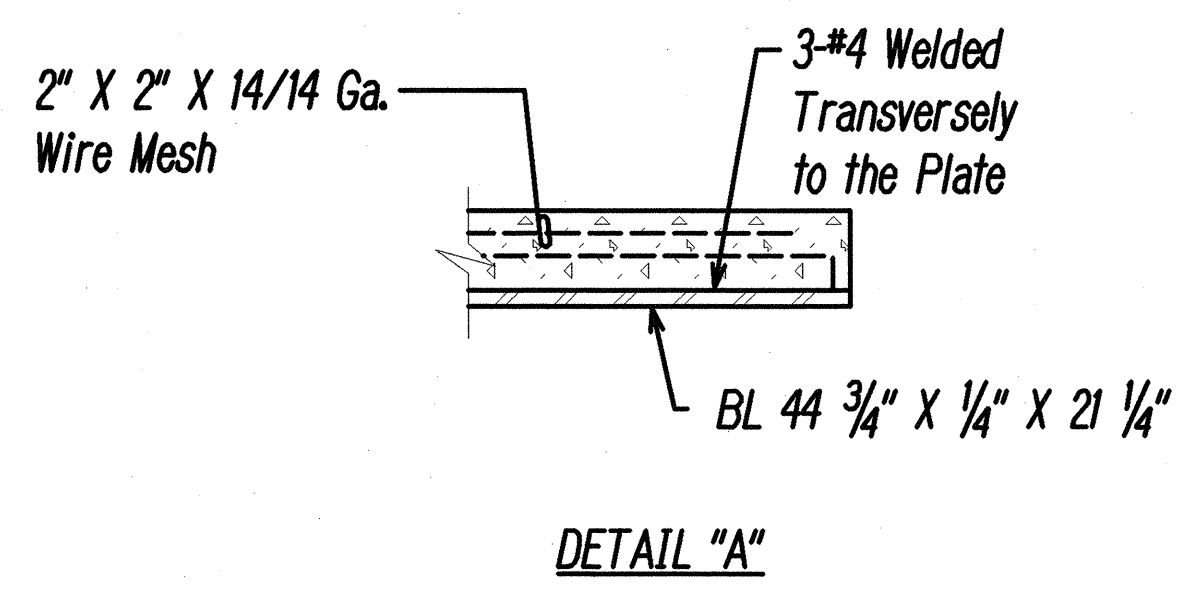


A 2' X 4' MECO HANDHOLE DETAIL
E15 Not to Scale

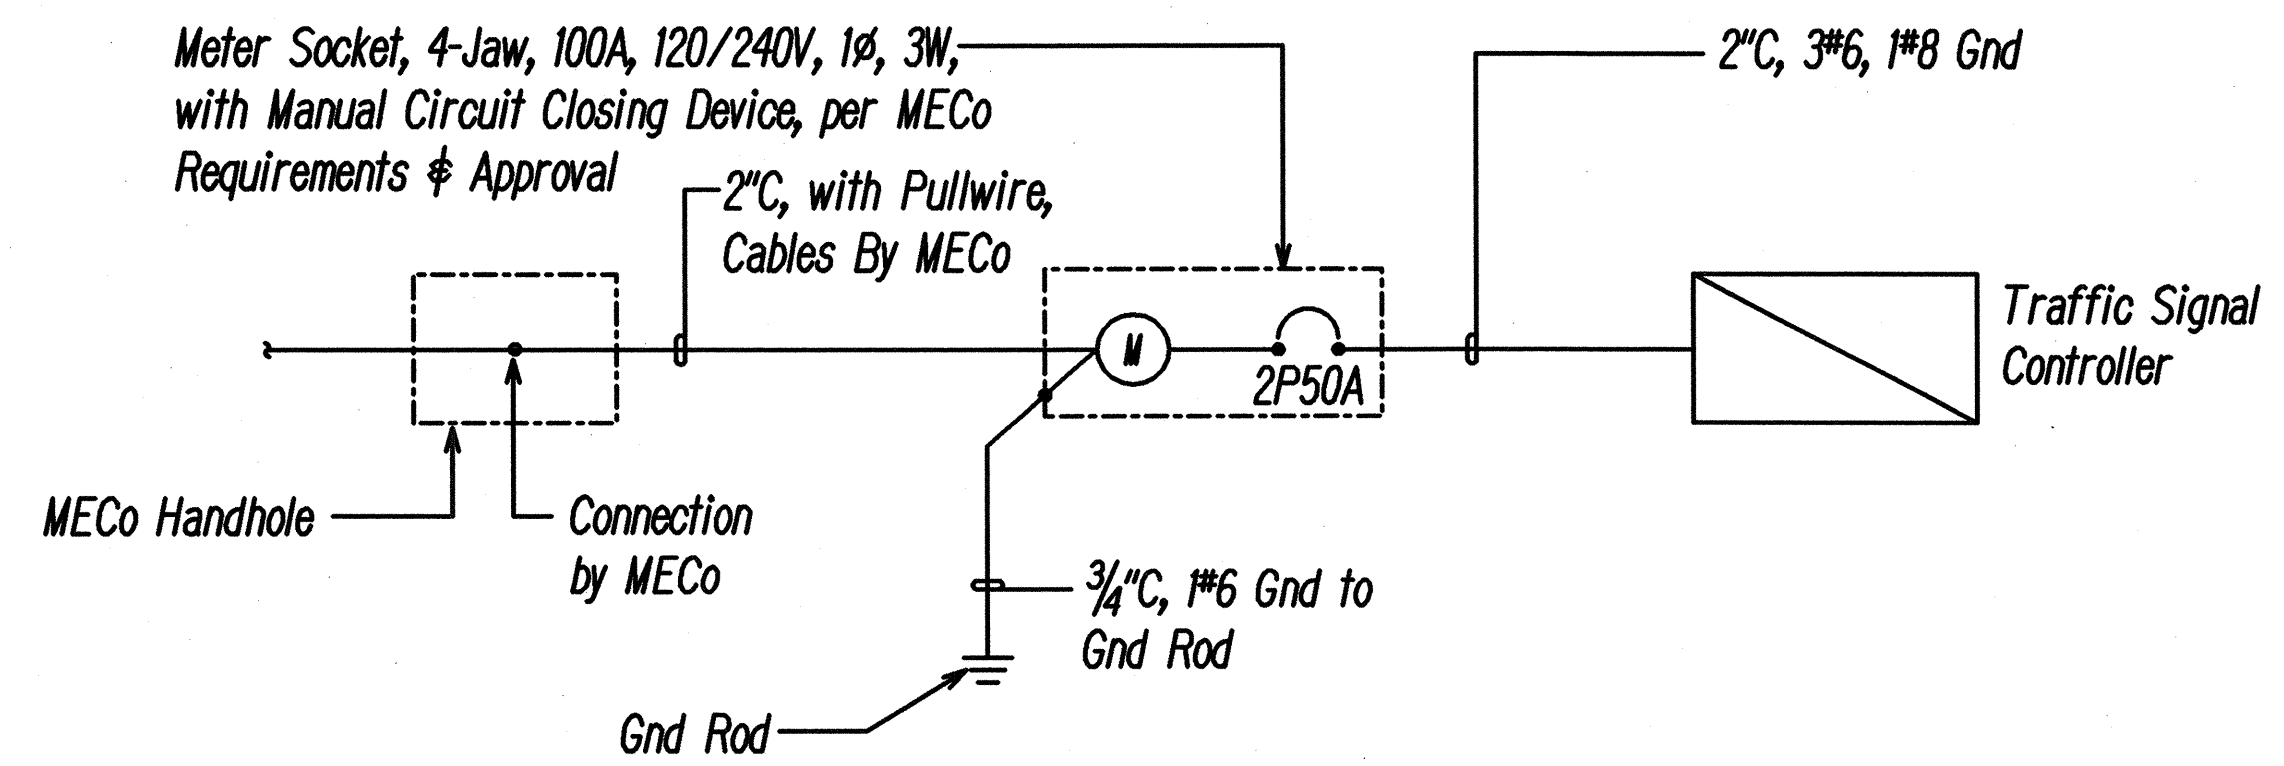

B TYPICAL ONE-LINE DIAGRAM
E15

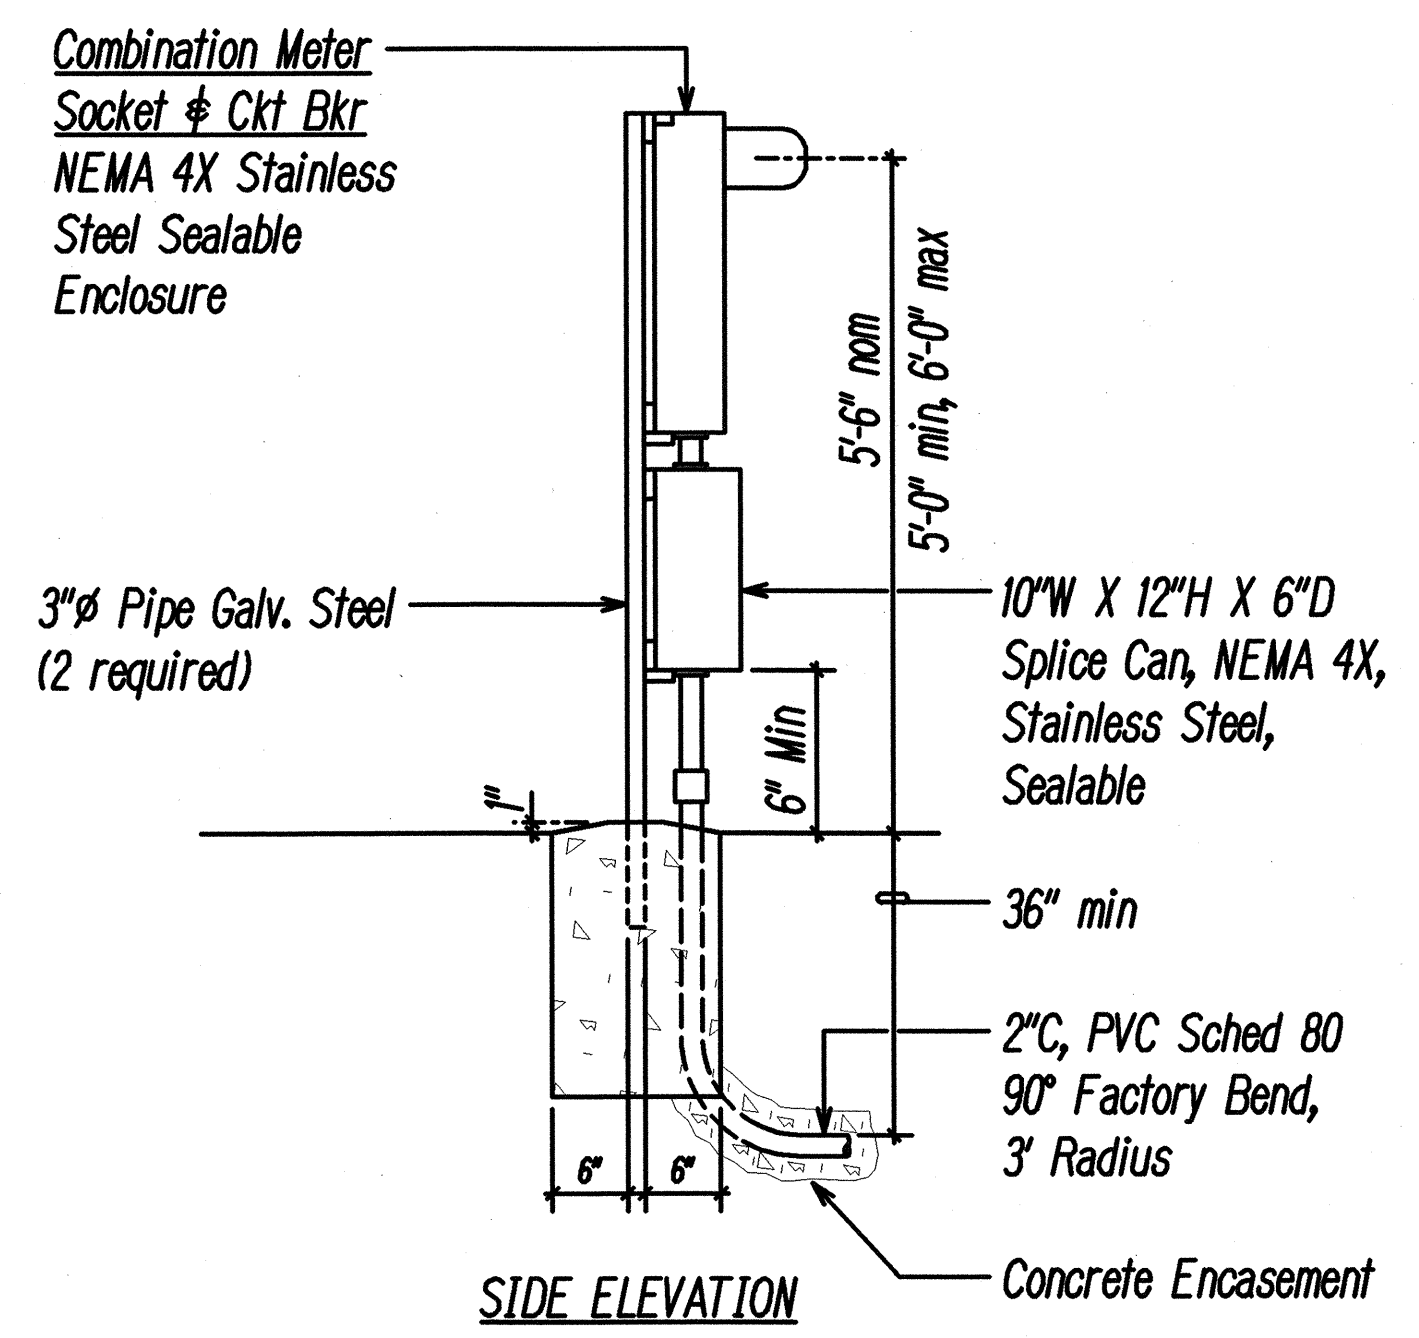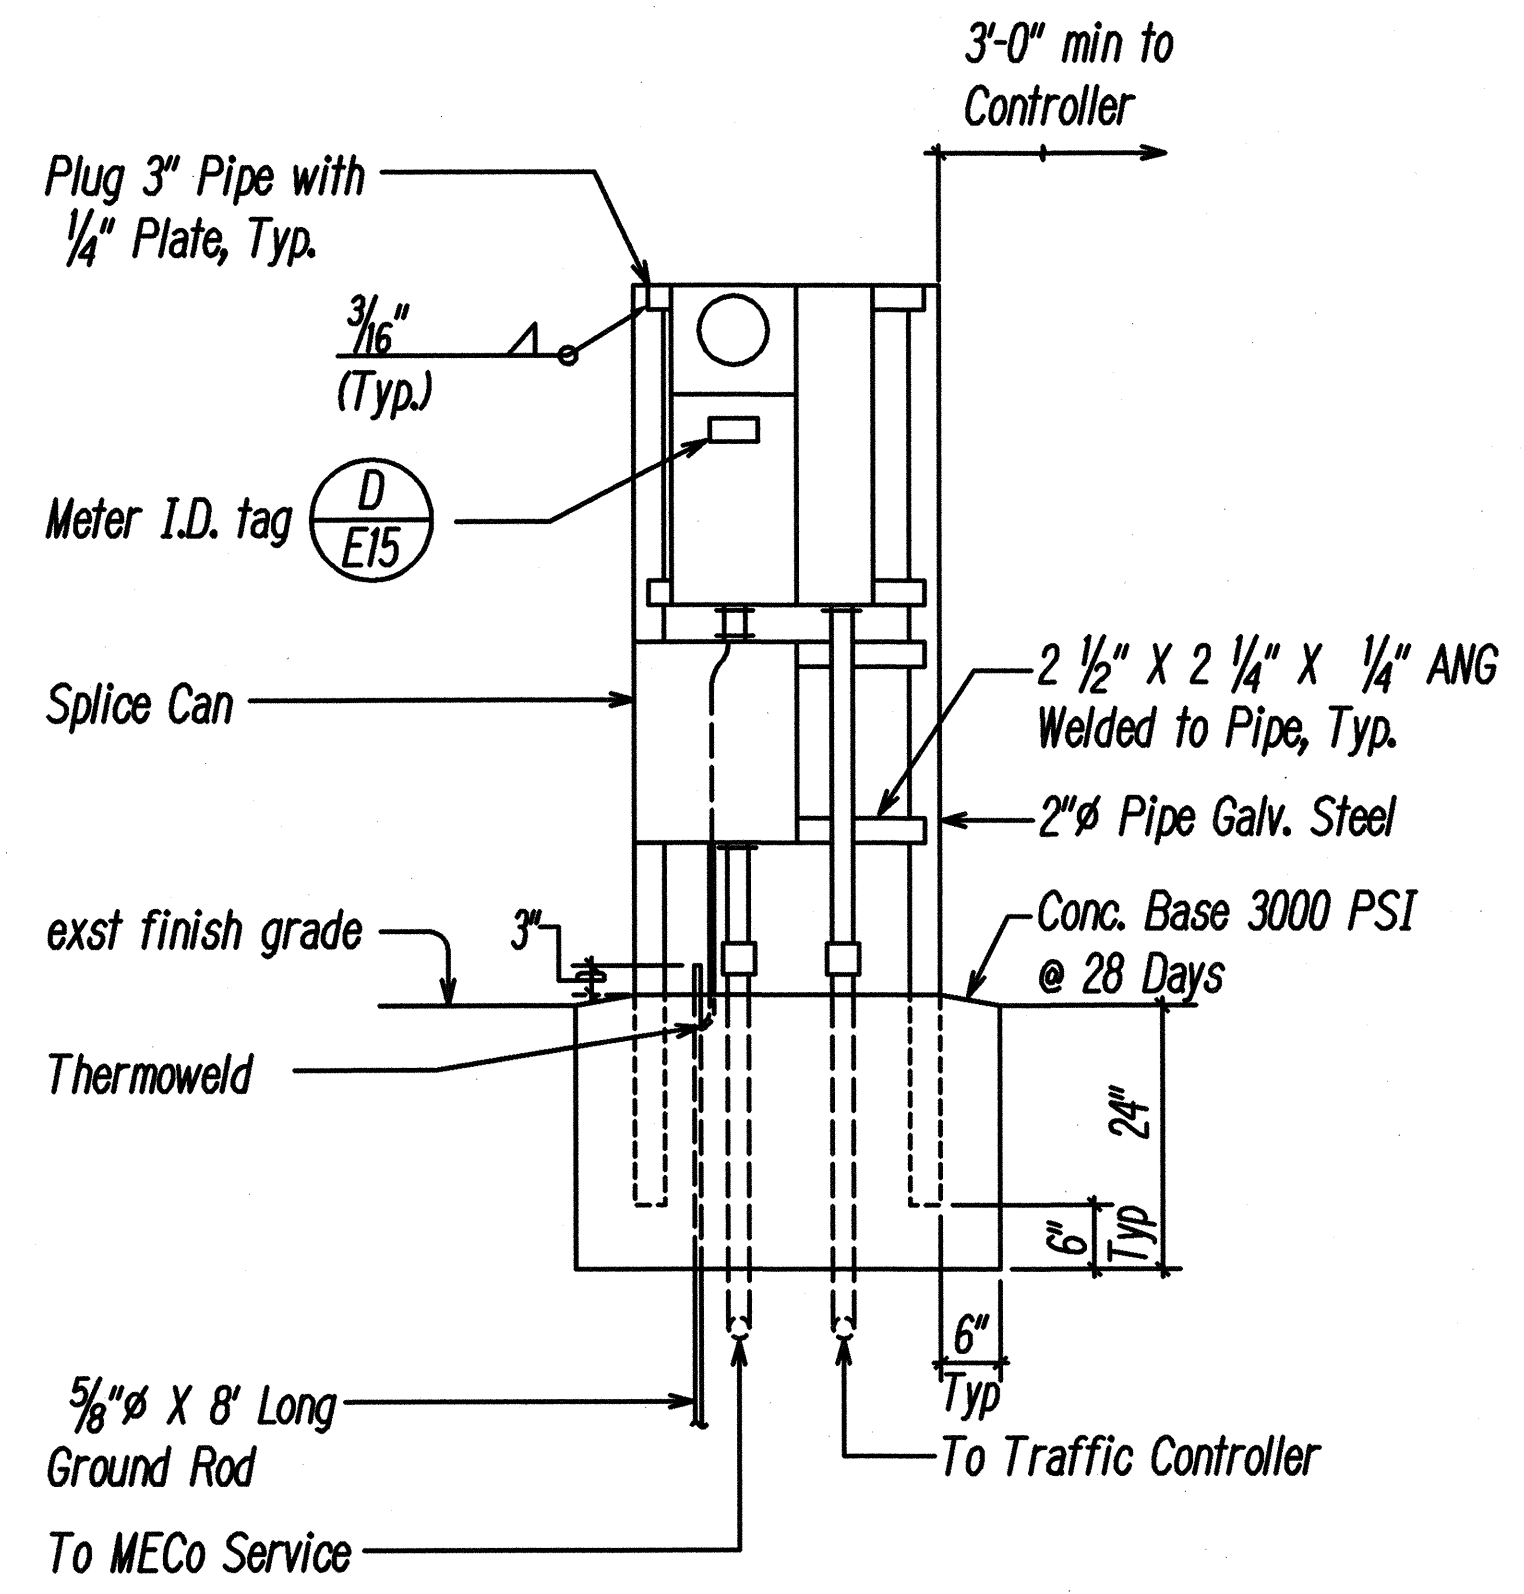

C ELECTRICAL SERVICE ELEVATION
E15 Not to Scale

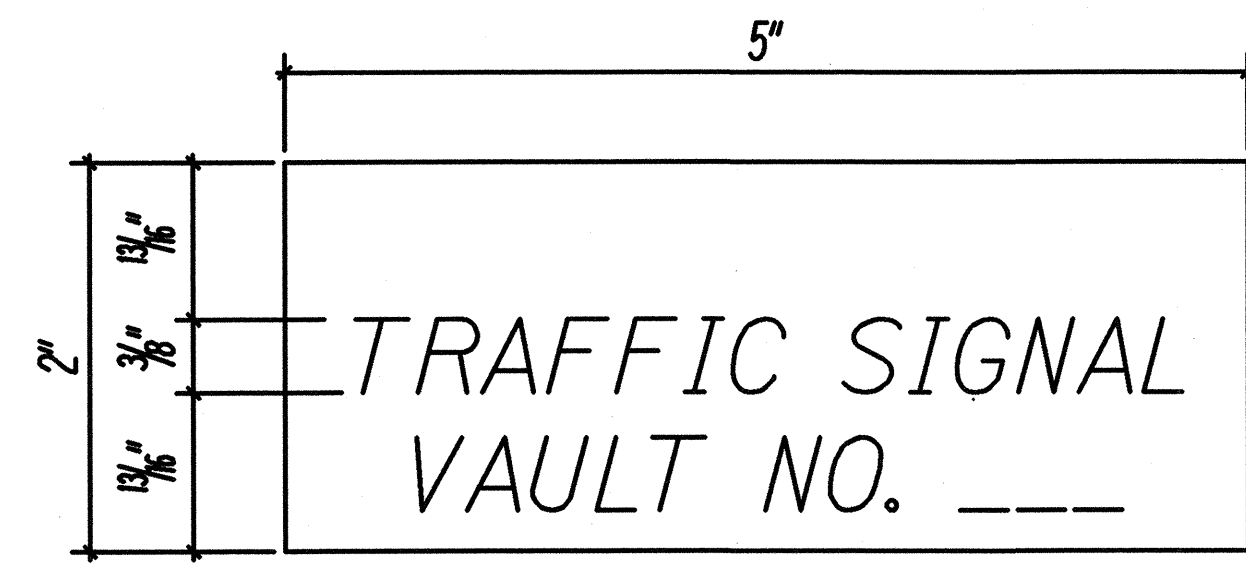

D METER I.D. TAG DETAIL
E15 Not to Scale

- Notes:
- Use 3 Ply Laminated Flexible Plastic, Black-White-Black. Thickness: Black Cap & Base Sheet - 0.010", White Middle Sheet - 0.052".
 - Letters and Numbers shall be Engraved 3/8" High, 1/16" Stroke, White in Color.
 - Attach to Meter Socket using Scotch 3M Brand very High Bond (VHB) Double Coated Acrylic Foam Tape or Equivalent.
 - Letters and Numbers shall be Engraved through "Black Cap Sheet" to Expose "White" Letters.

ORIGINAL PLAN	DATE
DESIGNED BY	
CHECKED BY	
NOTED BY	
DATE	

STATE OF HAWAII
DEPARTMENT OF TRANSPORTATION
HIGHWAYS DIVISION

ONE-LINE DIAGRAM
ELECTRICAL SERVICE ELEVATION, DETAILS

HONOAPIILANI HIGHWAY WIDENING
North Kihei Road to Kihelani Highway
F.A. Project No. BR-NH-030-K(24)


Scale: None Date: Apr. 2000

SHEET No. E15 OF 22 SHEETS


This Work was Prepared by Me or Under My Supervision

24 May 2000

FED. ROAD DIST. NO.	STATE	FED. AID PROJ. NO.	FISCAL YEAR	SHEET NO.	TOTAL SHEETS
HAWAII	HAW.	BR-NH-030-II(24)	2000	122	139

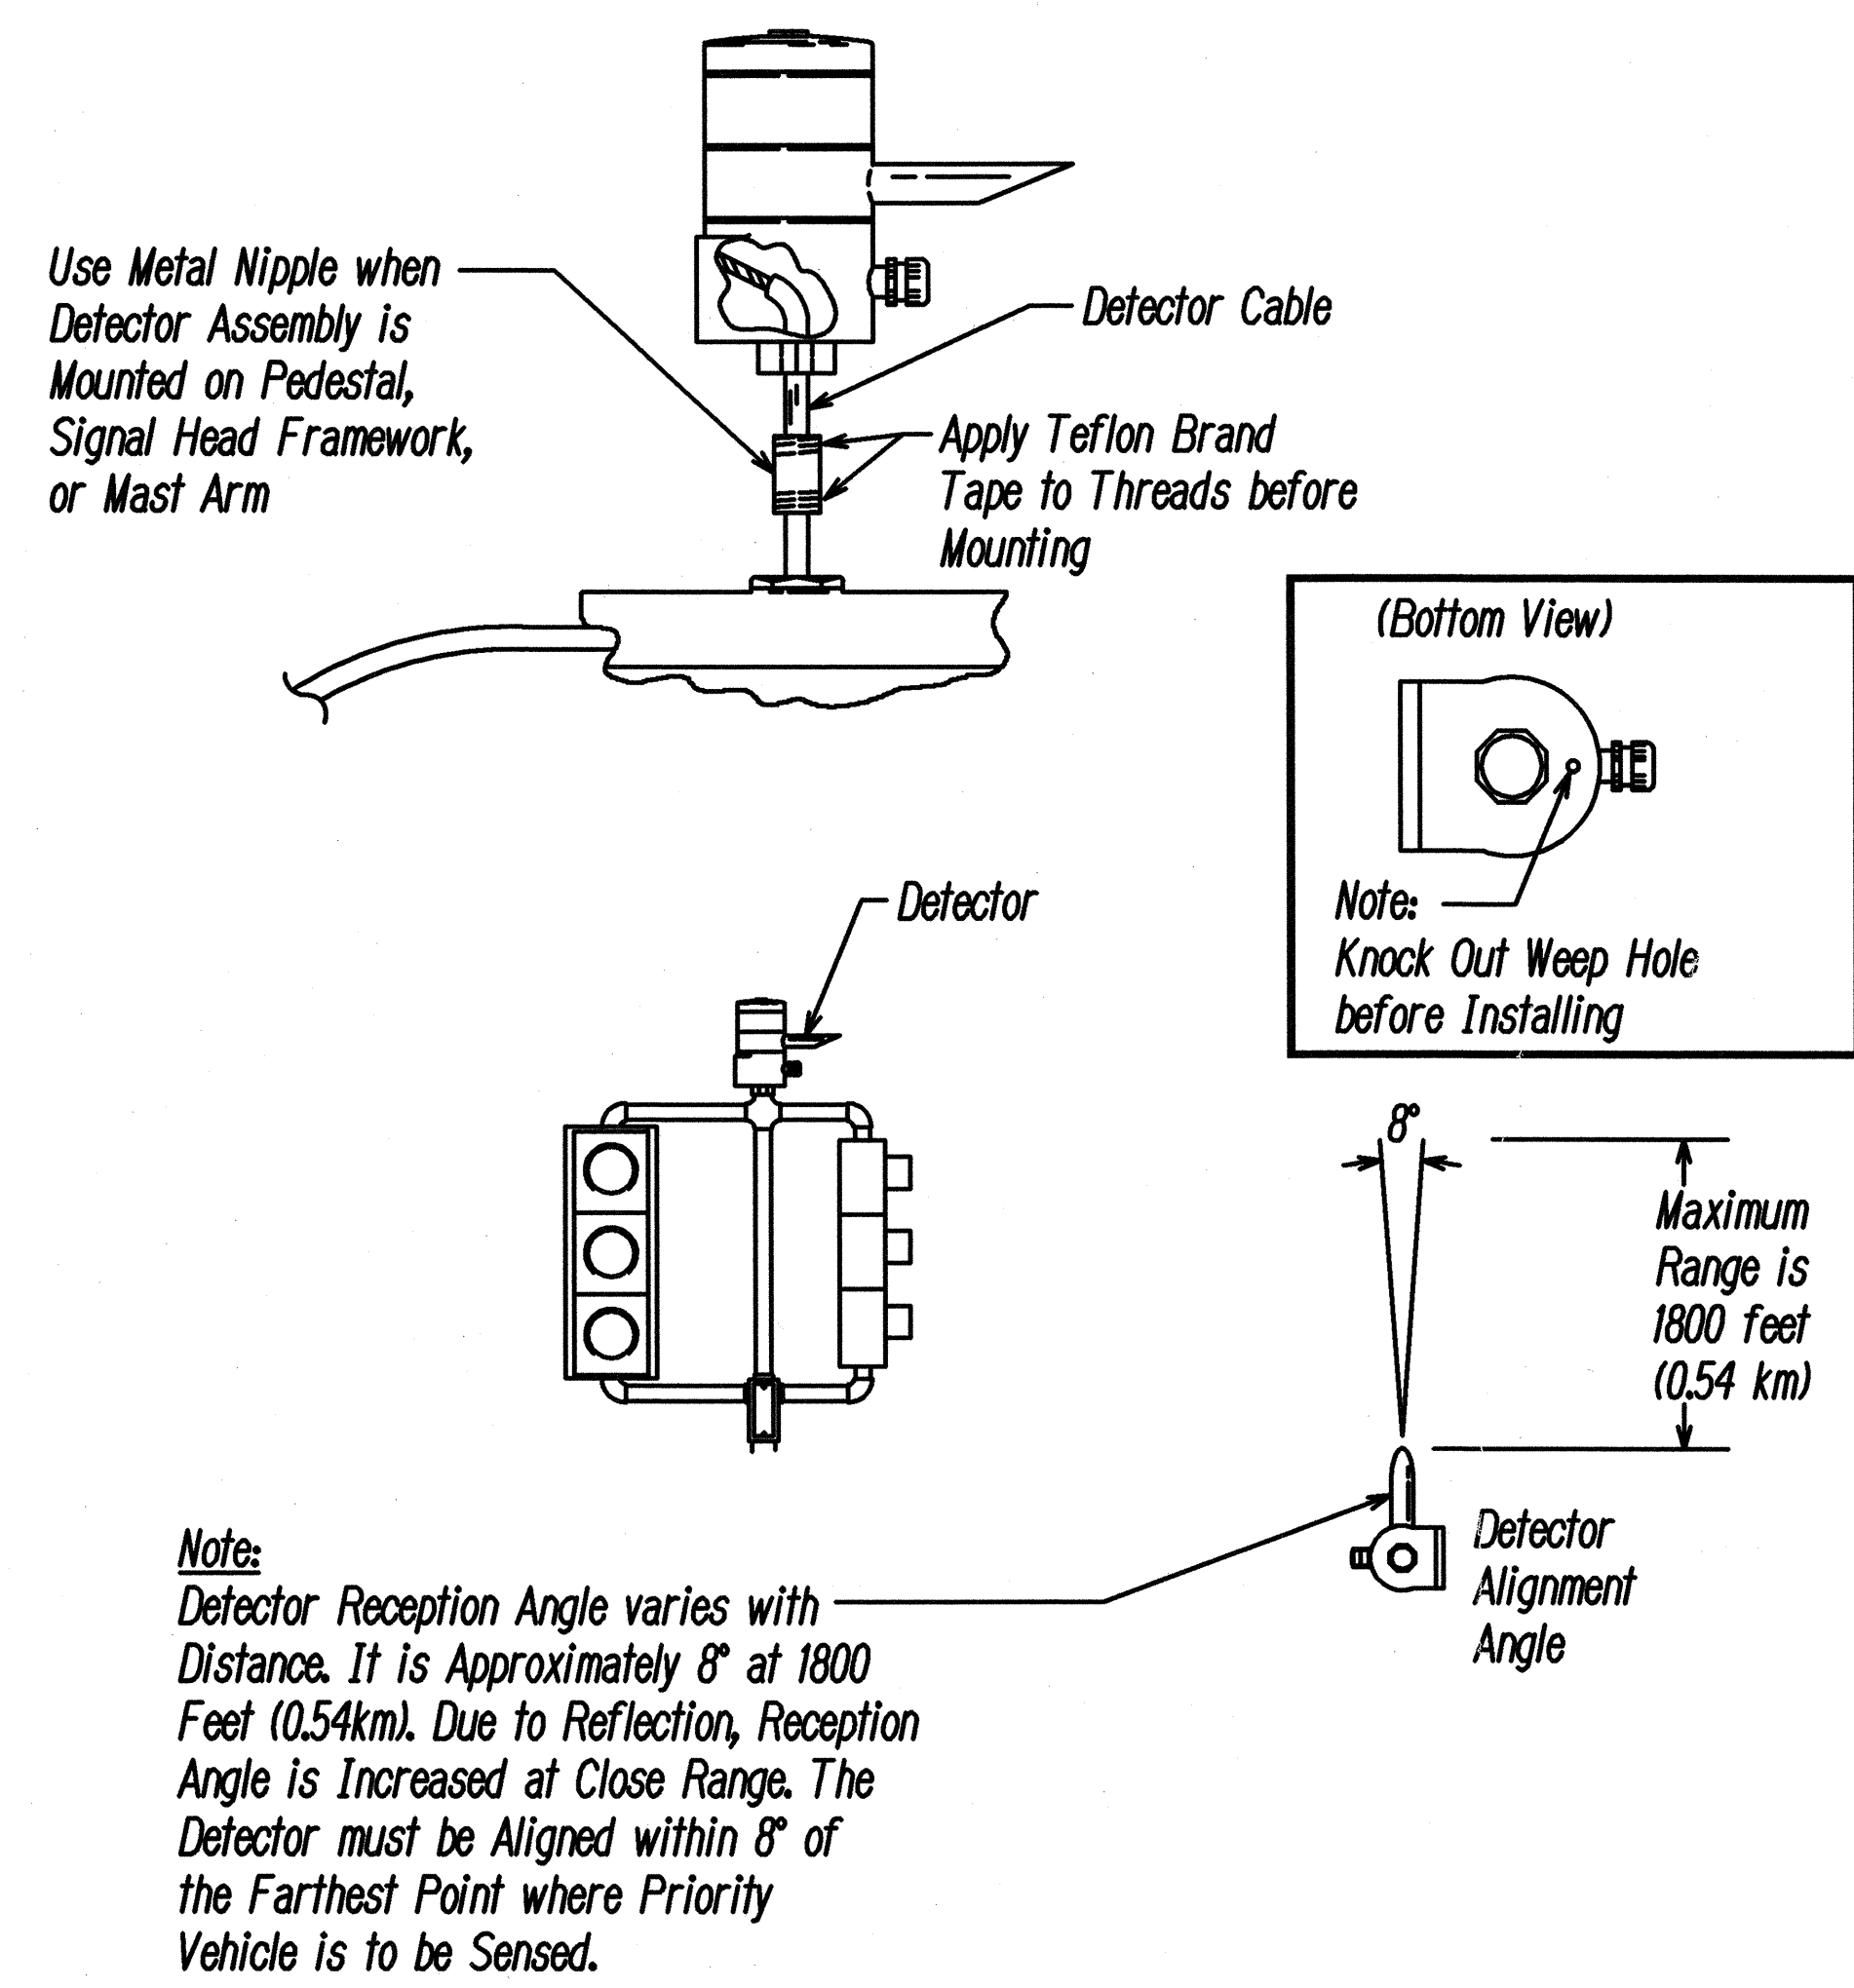


TYPICAL PEDESTAL/TYPE T.S.S. MOUNTING OF EVP DETECTOR

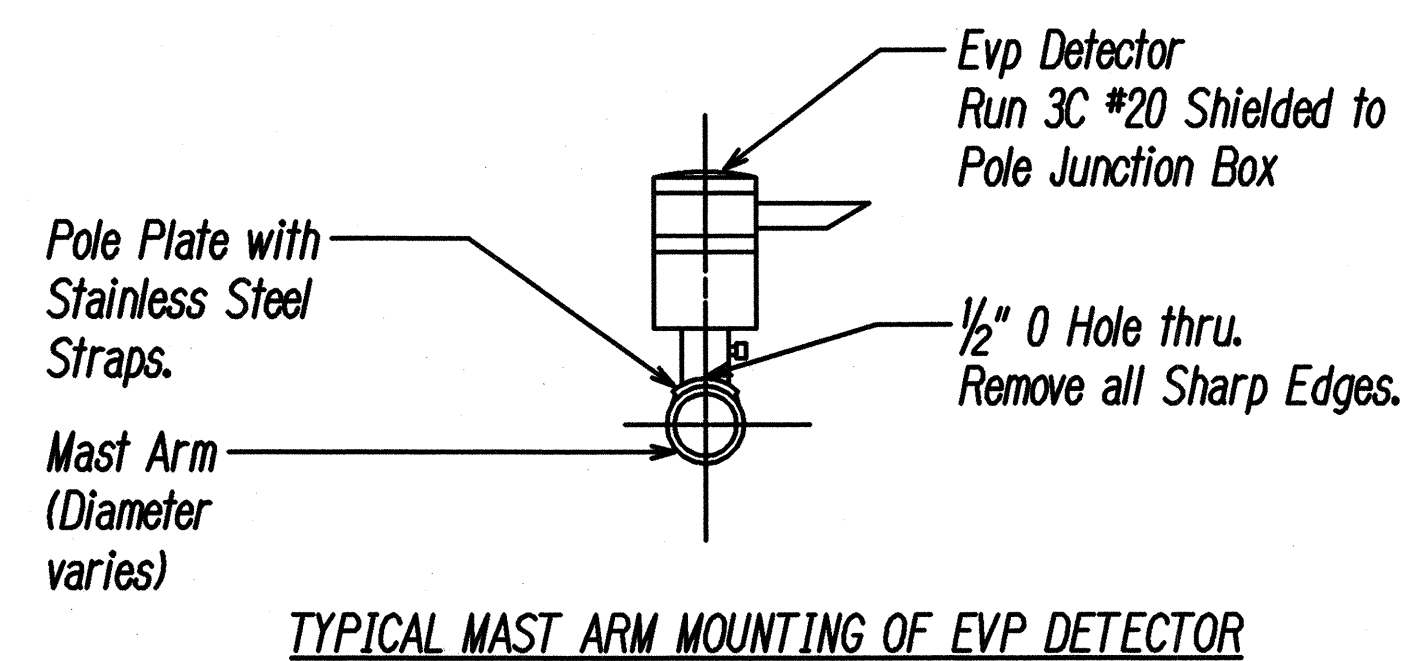

TYPICAL MAST ARM MOUNTING OF EVP DETECTOR

A EVP DETECTOR MOUNTING
E18 Not to Scale

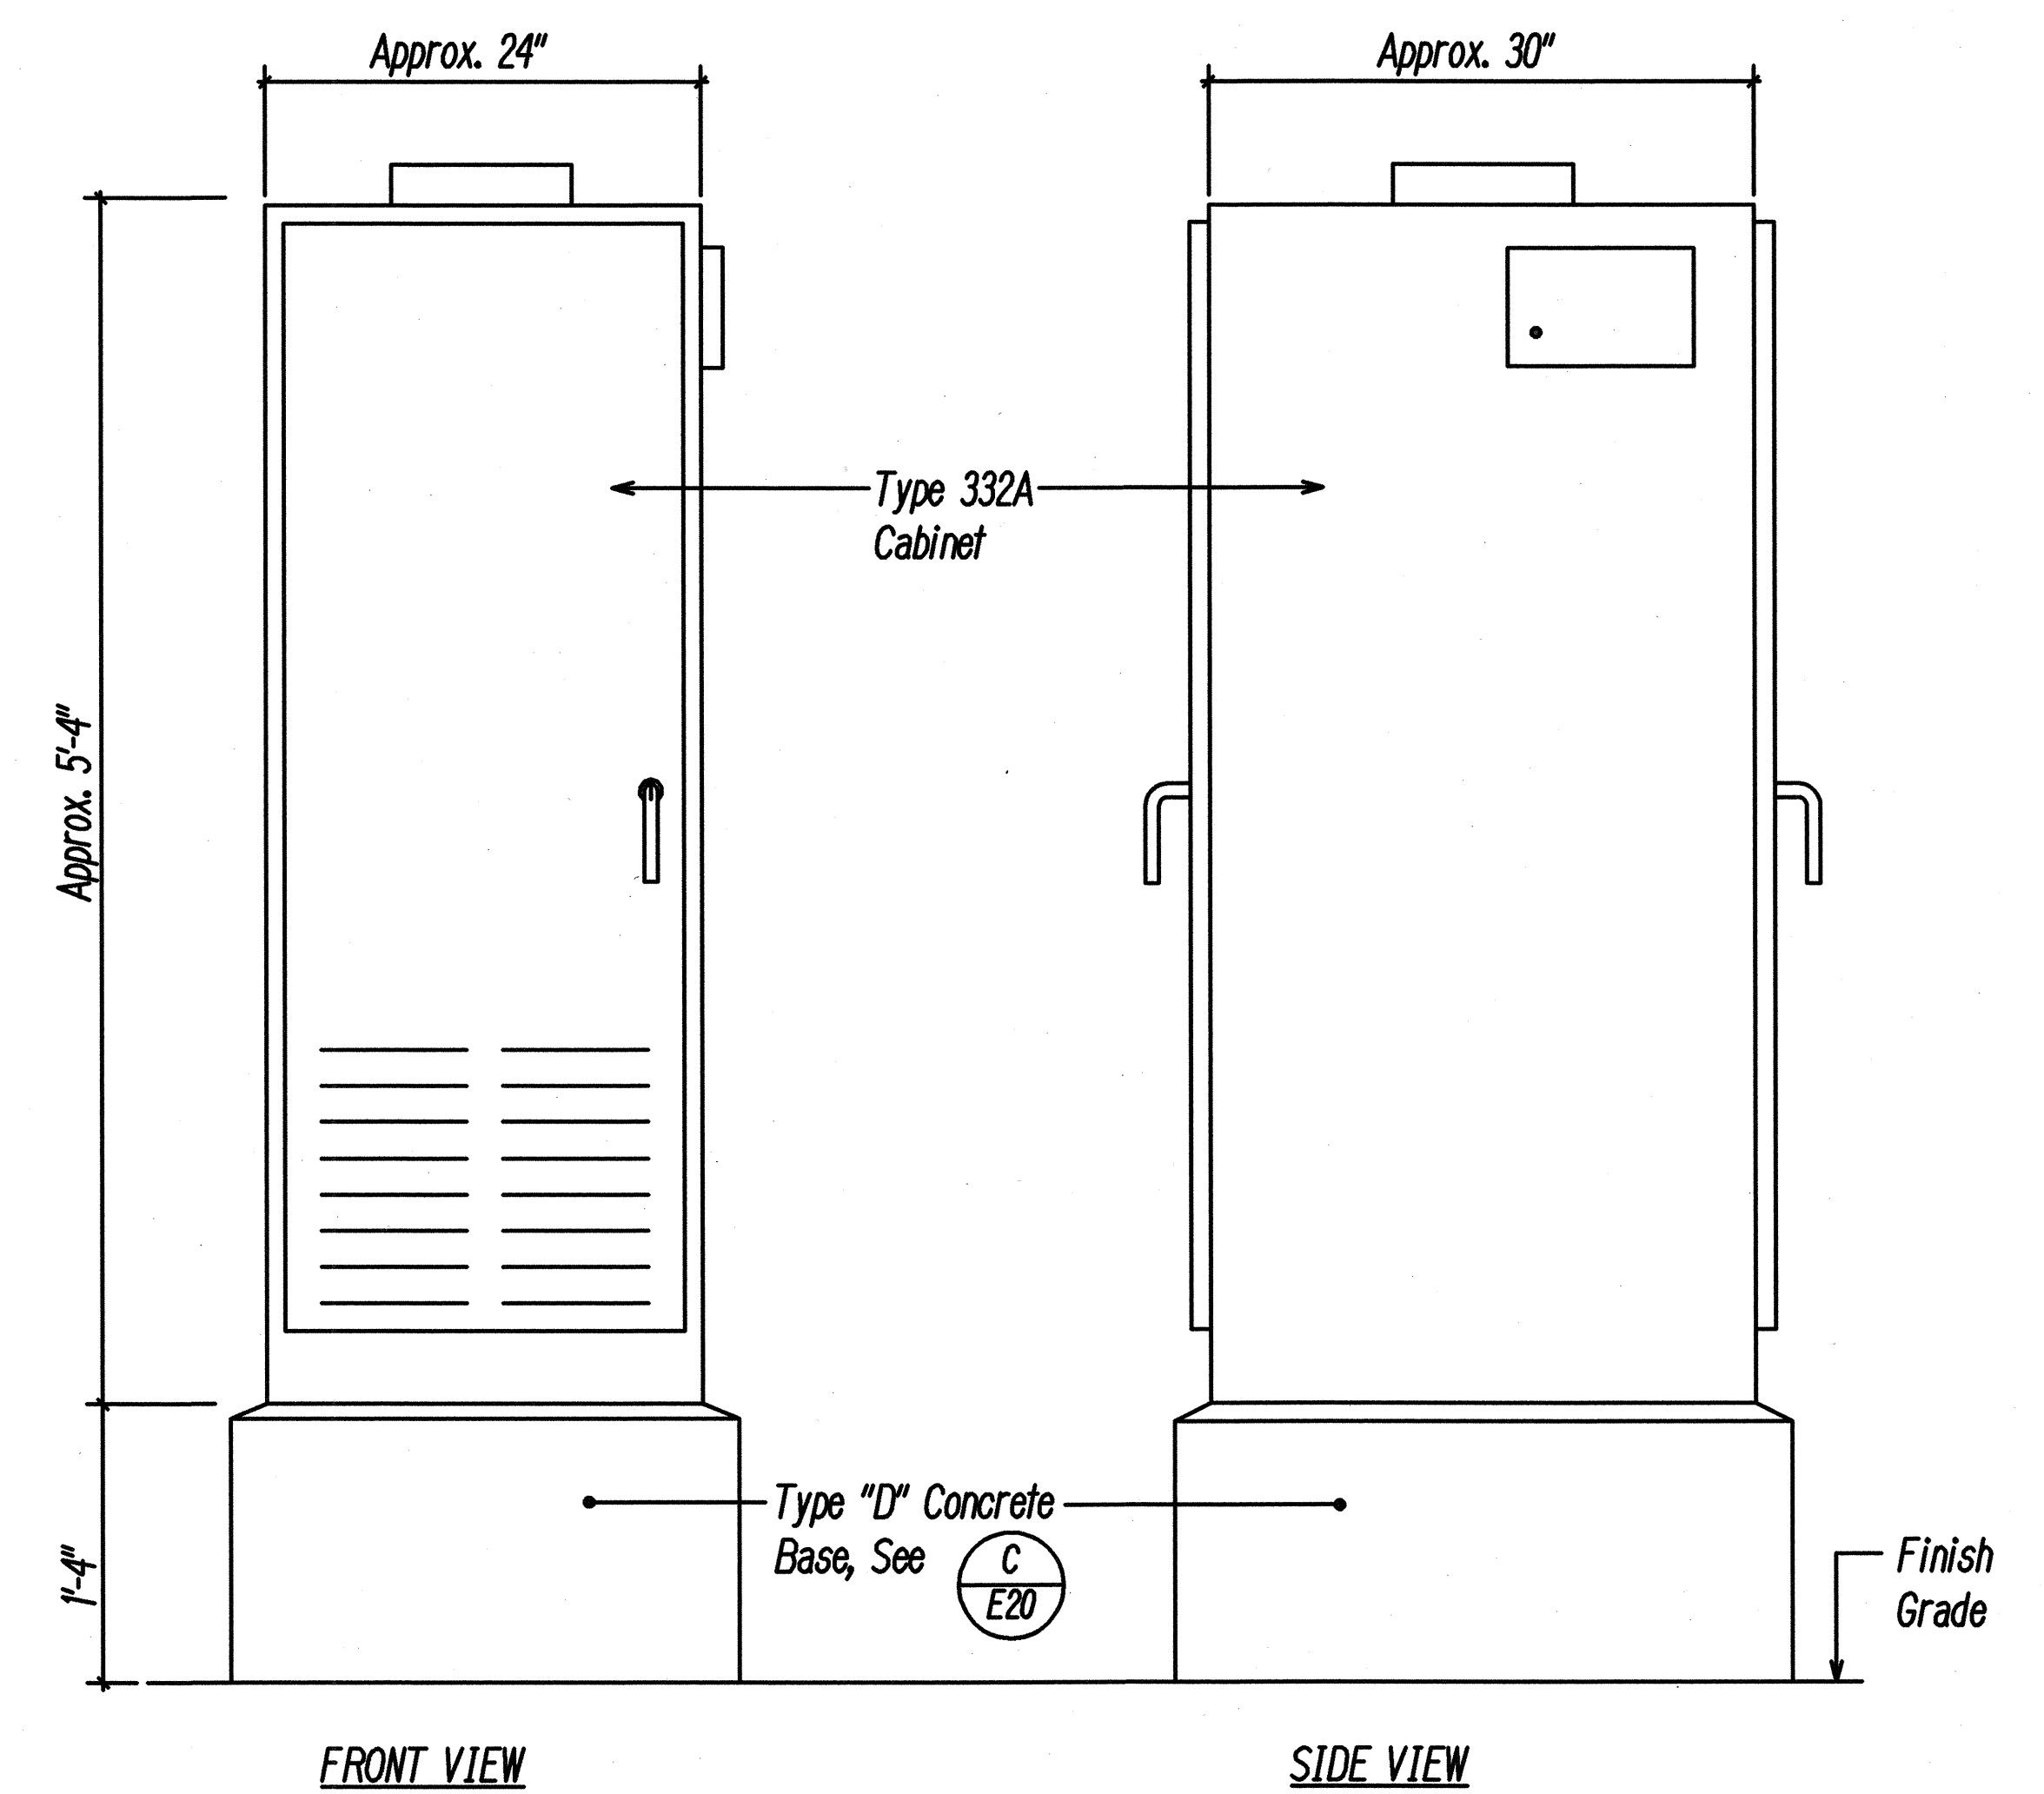

B TYPE 332A TRAFFIC SIGNAL CONTROLLER CABINET DETAIL
E18 Not to Scale

SURVEY PLOTTED BY	DATE
DRAWN BY	
CHECKED BY	
NOTED BY	
QUANTITIES BY	
CHECKED BY	
ORIGINAL PLAN	
NOTE BOOK	
N°	

24 MAY 2000
This Work was Prepared by Me
or Under My Supervision

STATE OF HAWAII
DEPARTMENT OF TRANSPORTATION
HIGHWAYS DIVISION


**TRAFFIC SIGNAL EQUIPMENT ELEVATION,
EVP DETECTOR MOUNTING DETAIL**

HONOAPIILANI HIGHWAY WIDENING
North Kihei Road to Kuihelani Highway
F.A. Project No. BR-NH-030-II(24)


Scale: None Date: Apr. 2000

SHEET No. E18 OF 22 SHEETS


FED. ROAD DIST. NO.	STATE	FED. AID PROJ. NO.	FISCAL YEAR	SHEET NO.	TOTAL SHEETS
HAWAII	HAW.	BR-NH-030-1(24)	2000	123	139

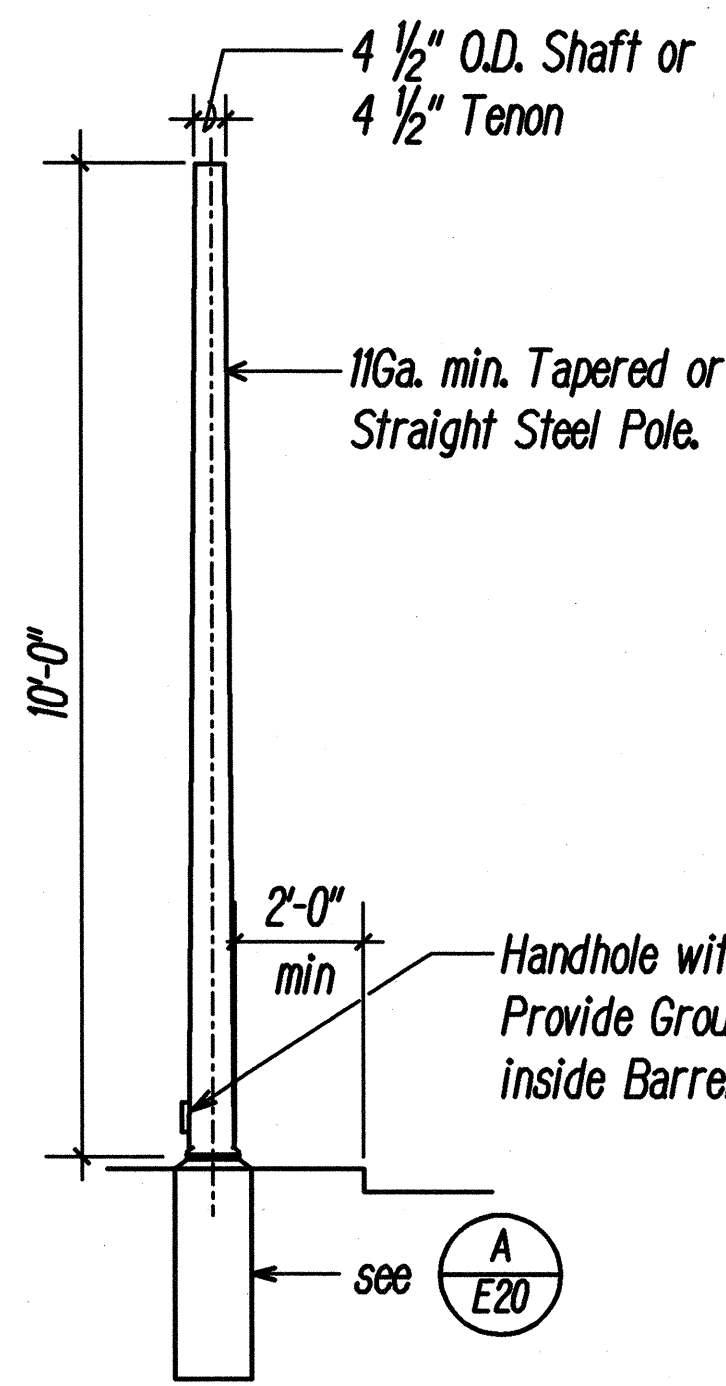


TYPE I TRAFFIC SIGNAL STANDARD
Not to Scale

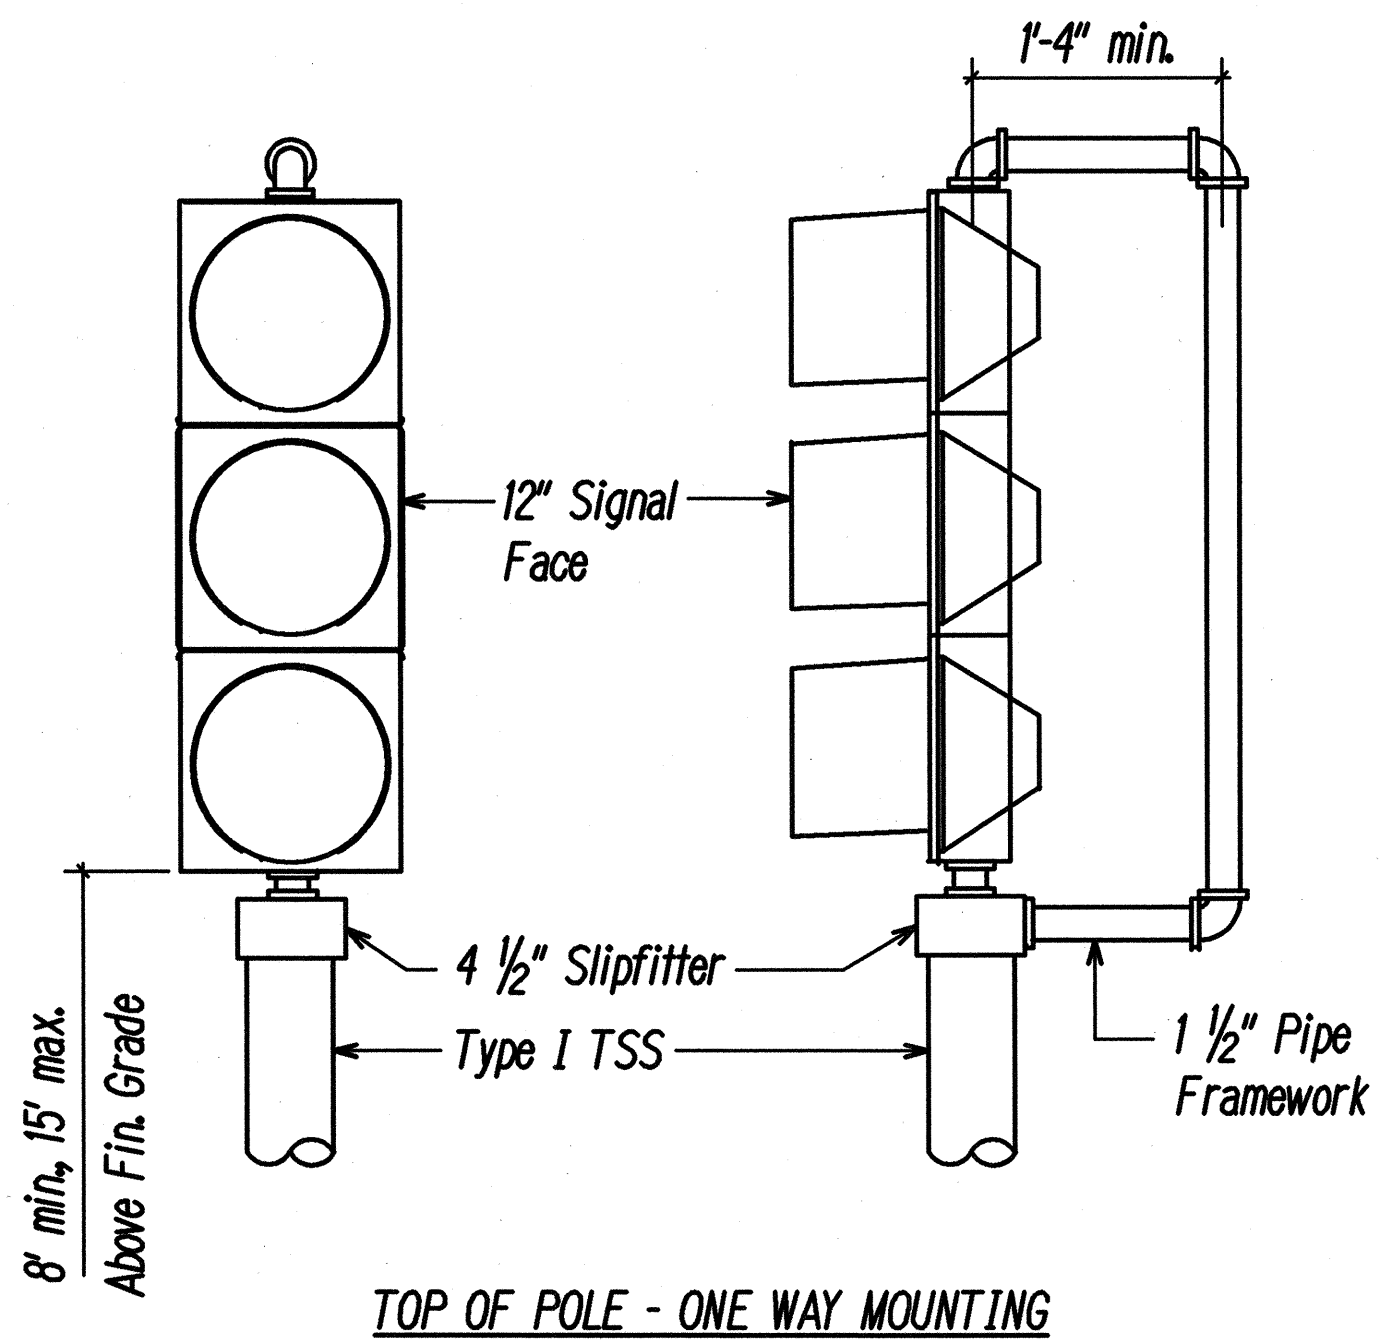

TOP OF POLE - ONE WAY MOUNTING

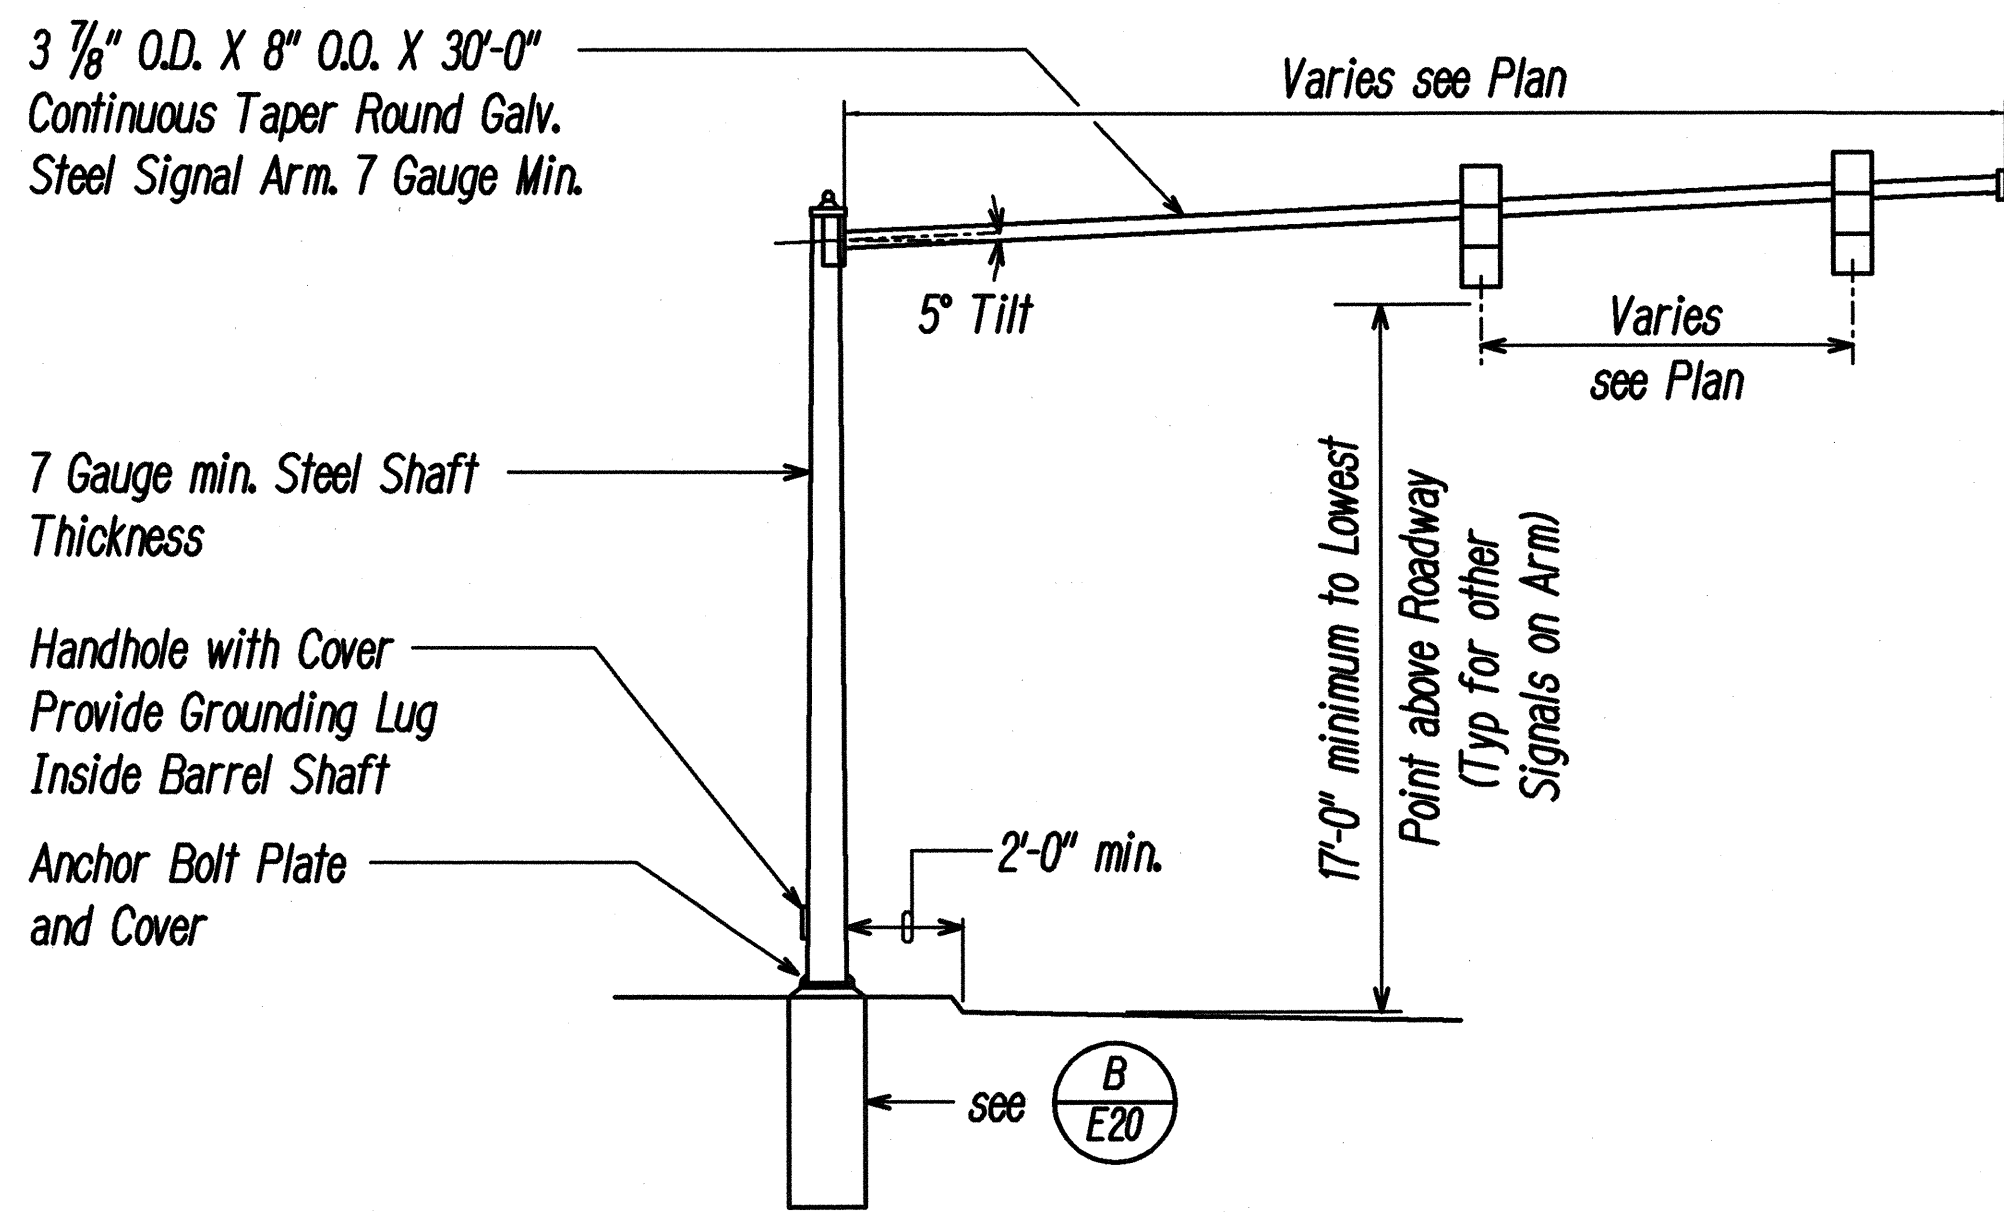

TYPE II TRAFFIC SIGNAL STANDARD
Not to Scale

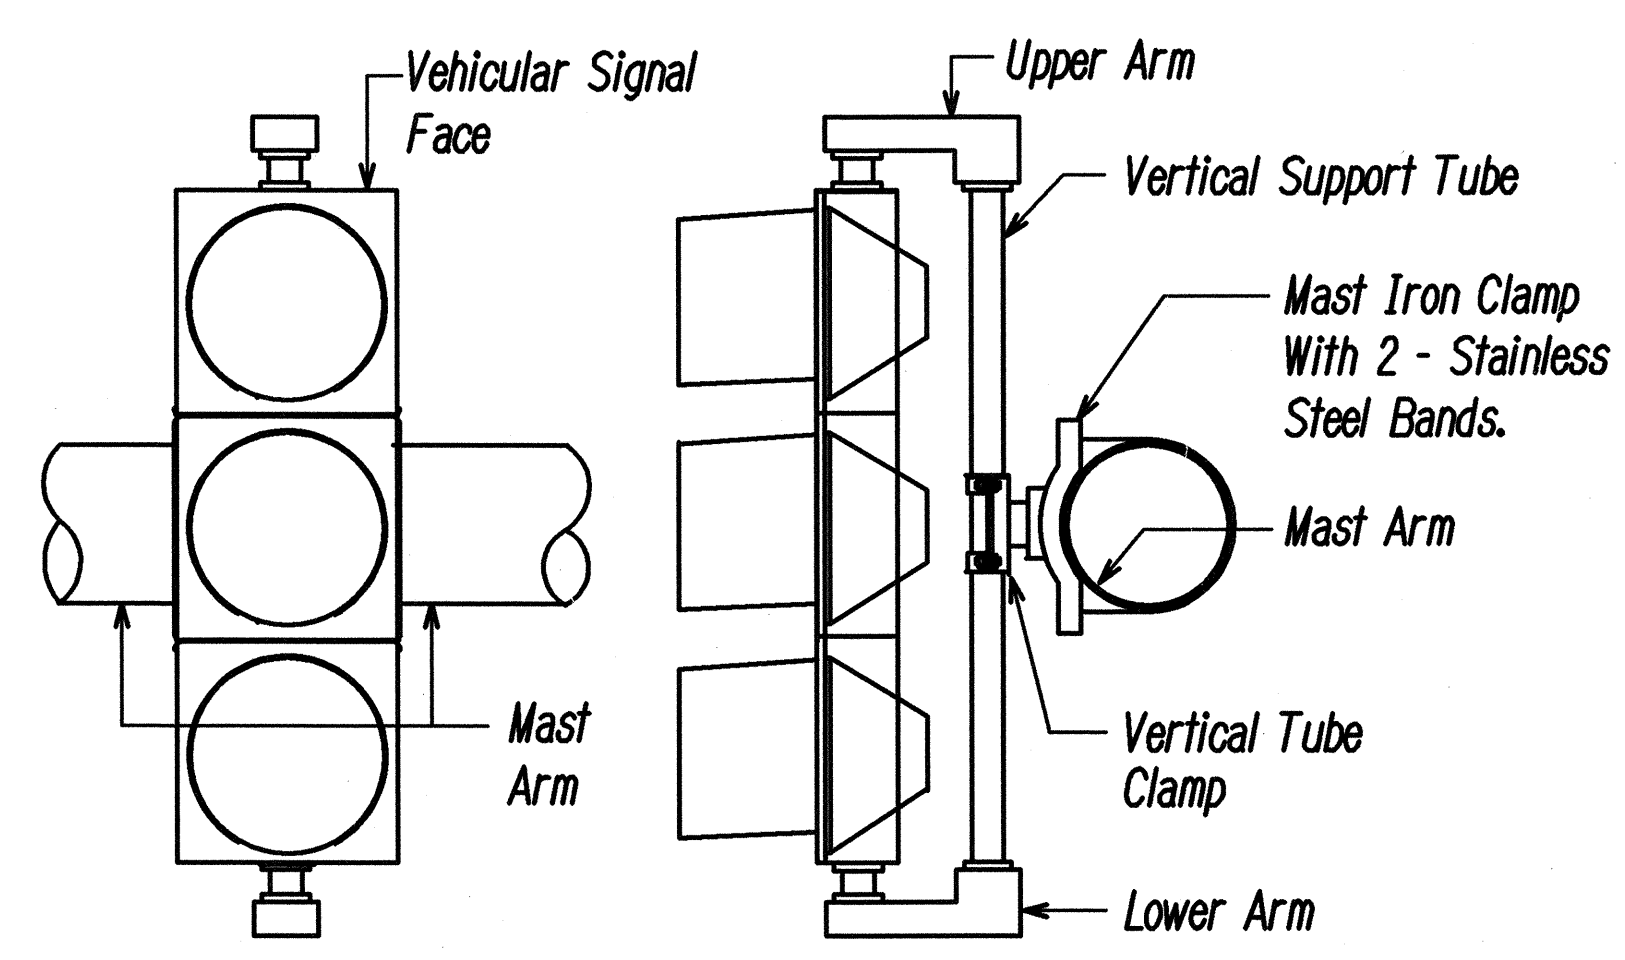


ADJUSTABLE MAST ARM ONE WAY MOUNTING AT INTERMEDIATE POINT

- Notes:
1. Stainless Steel Bands shall be 1/2 inch wide x .050 inch thick, minimum. Tensile strength shall be 100,000 PSI minimum.
 2. Upper Arm, Lower Arm and Vertical Support Tube shall be of 356 Cast Aluminum.
 3. All wiring shall be concealed.
 4. Vertical Tube Clamp shall be of Malleable Iron, Grade 32510.
 5. All Aluminum Parts shall have an Alodine 1200 Finish.


VEHICULAR SIGNAL MOUNTING DETAILS
Not to Scale

Notes for Type II:

1. Standard shall be designed in accordance with "Standard Specifications for Structural Supports for Highway Signs, Luminaires and Traffic Signals".
2. Mounting for signals at intermediate points of mast arm shall be of the adjustable type.
3. See Standard Plan TE-38 for additional requirements.
4. Submit shop drawings for approval.

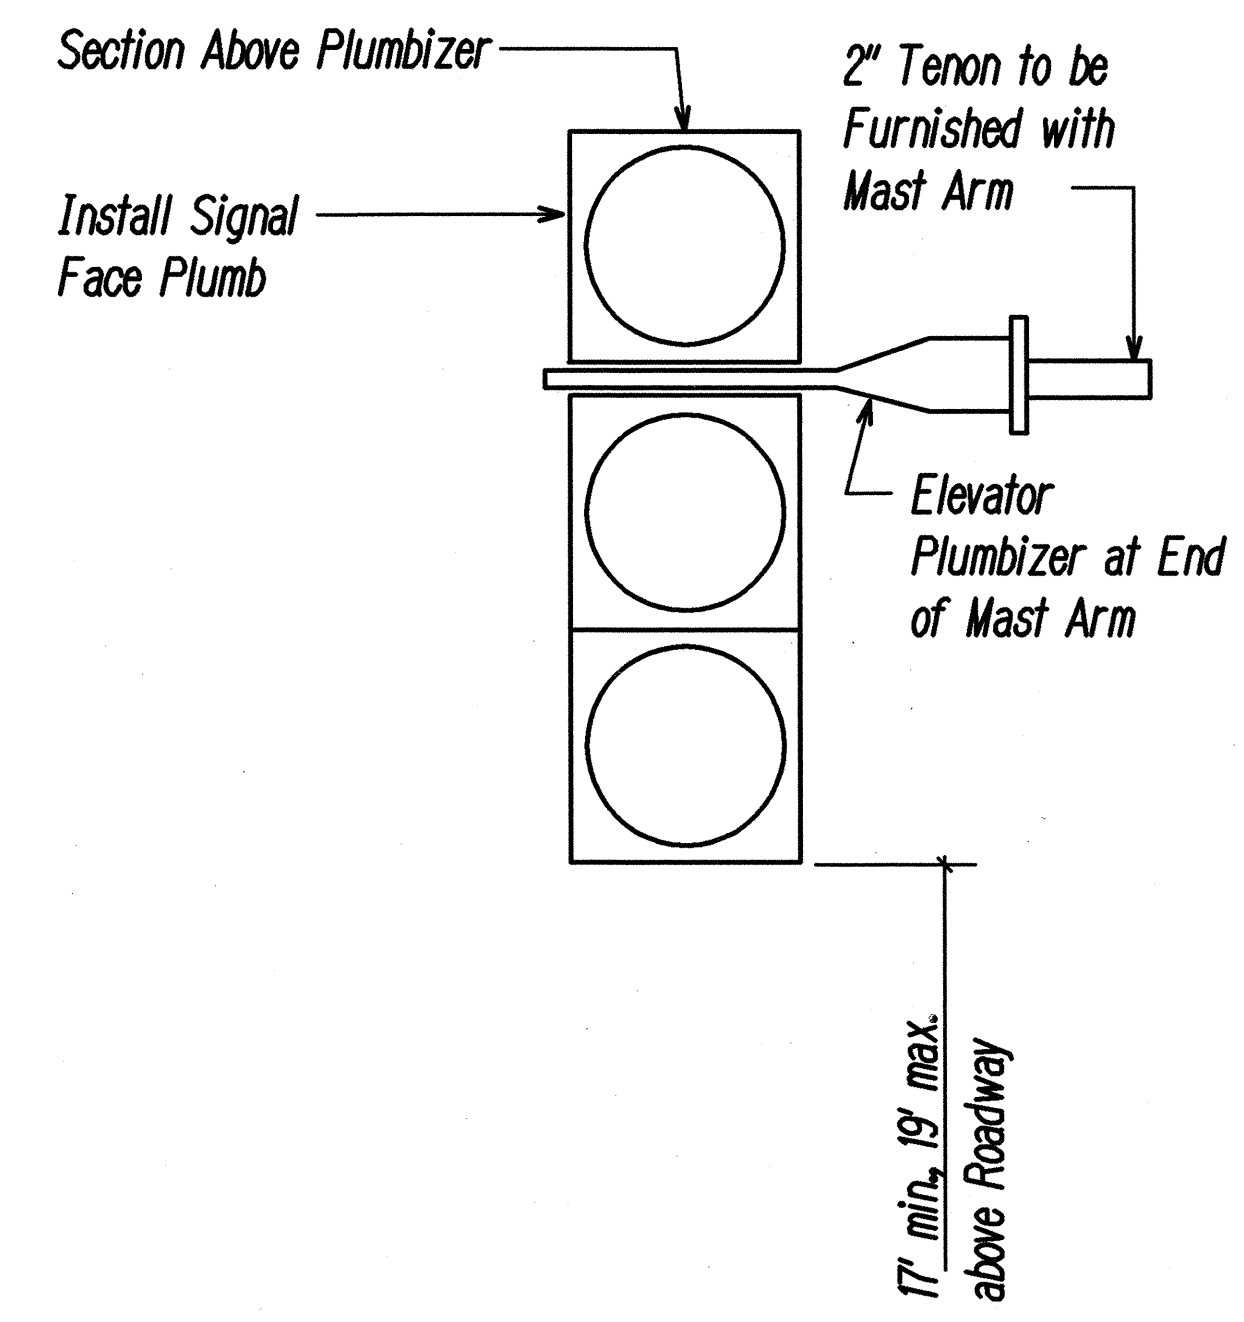

MAST ARM - ONE WAY MOUNTING AT ENDS

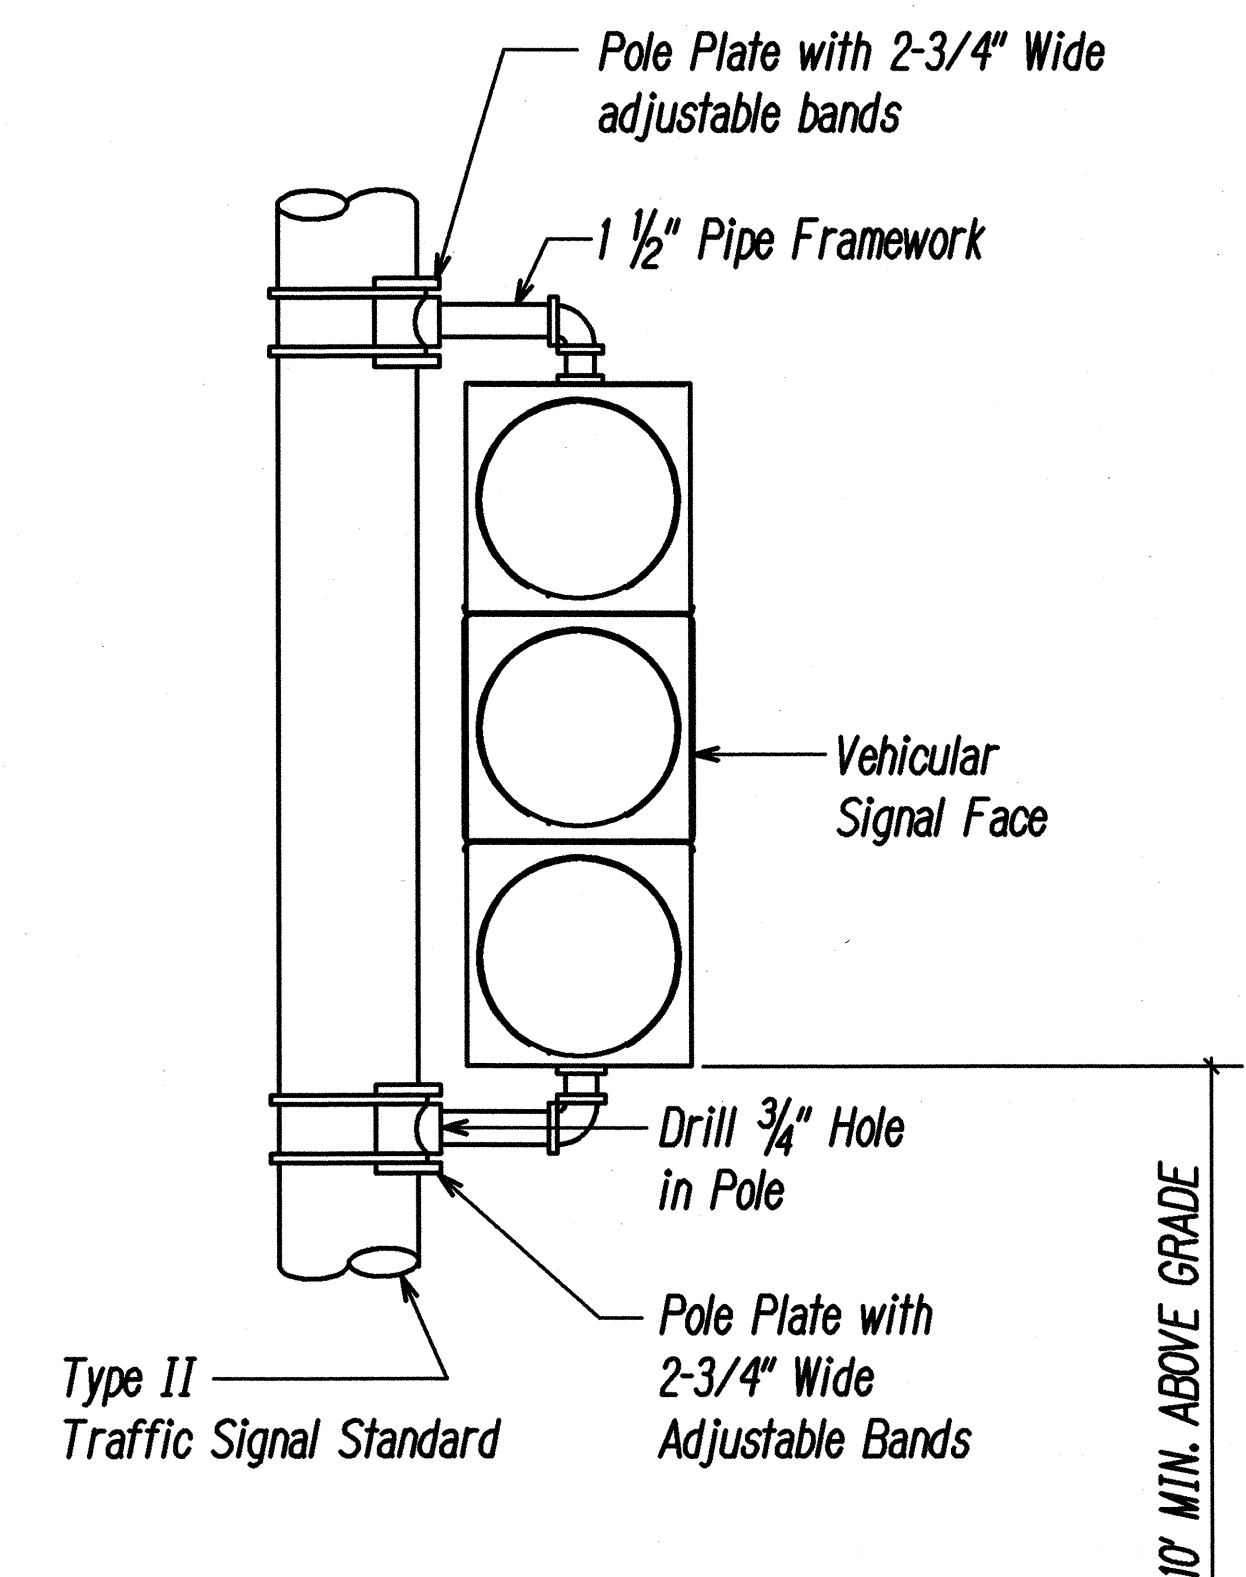

BRACKET ARM - ONE WAY

ORIGINAL PLAN	SURVEY PLOTTED BY	DATE
DESIGNED BY	DRAWN BY	
CHECKED BY	NOTED BY	

Gary I. Funabashi
 LICENSED PROFESSIONAL ENGINEER
 No. 4195-E
 HAWAII, U.S.A.

STATE OF HAWAII
 DEPARTMENT OF TRANSPORTATION
 HIGHWAYS DIVISION


TRAFFIC SIGNAL STANDARD & VEHICULAR SIGNAL MOUNTING DETAILS

HONOAPIILANI HIGHWAY WIDENING
North Kihel Road to Kihelani Highway
F.A. Project No. BR-NH-030-1(24)

Scale: None Date: Apr. 2000



SHEET No. E19 OF 22 SHEETS

FED. ROAD DIST. NO.	STATE	FED. AID PROJ. NO.	FISCAL YEAR	SHEET NO.	TOTAL SHEETS
HAWAII	HAW.	BR-NH-030-1(24)	2000	124	139

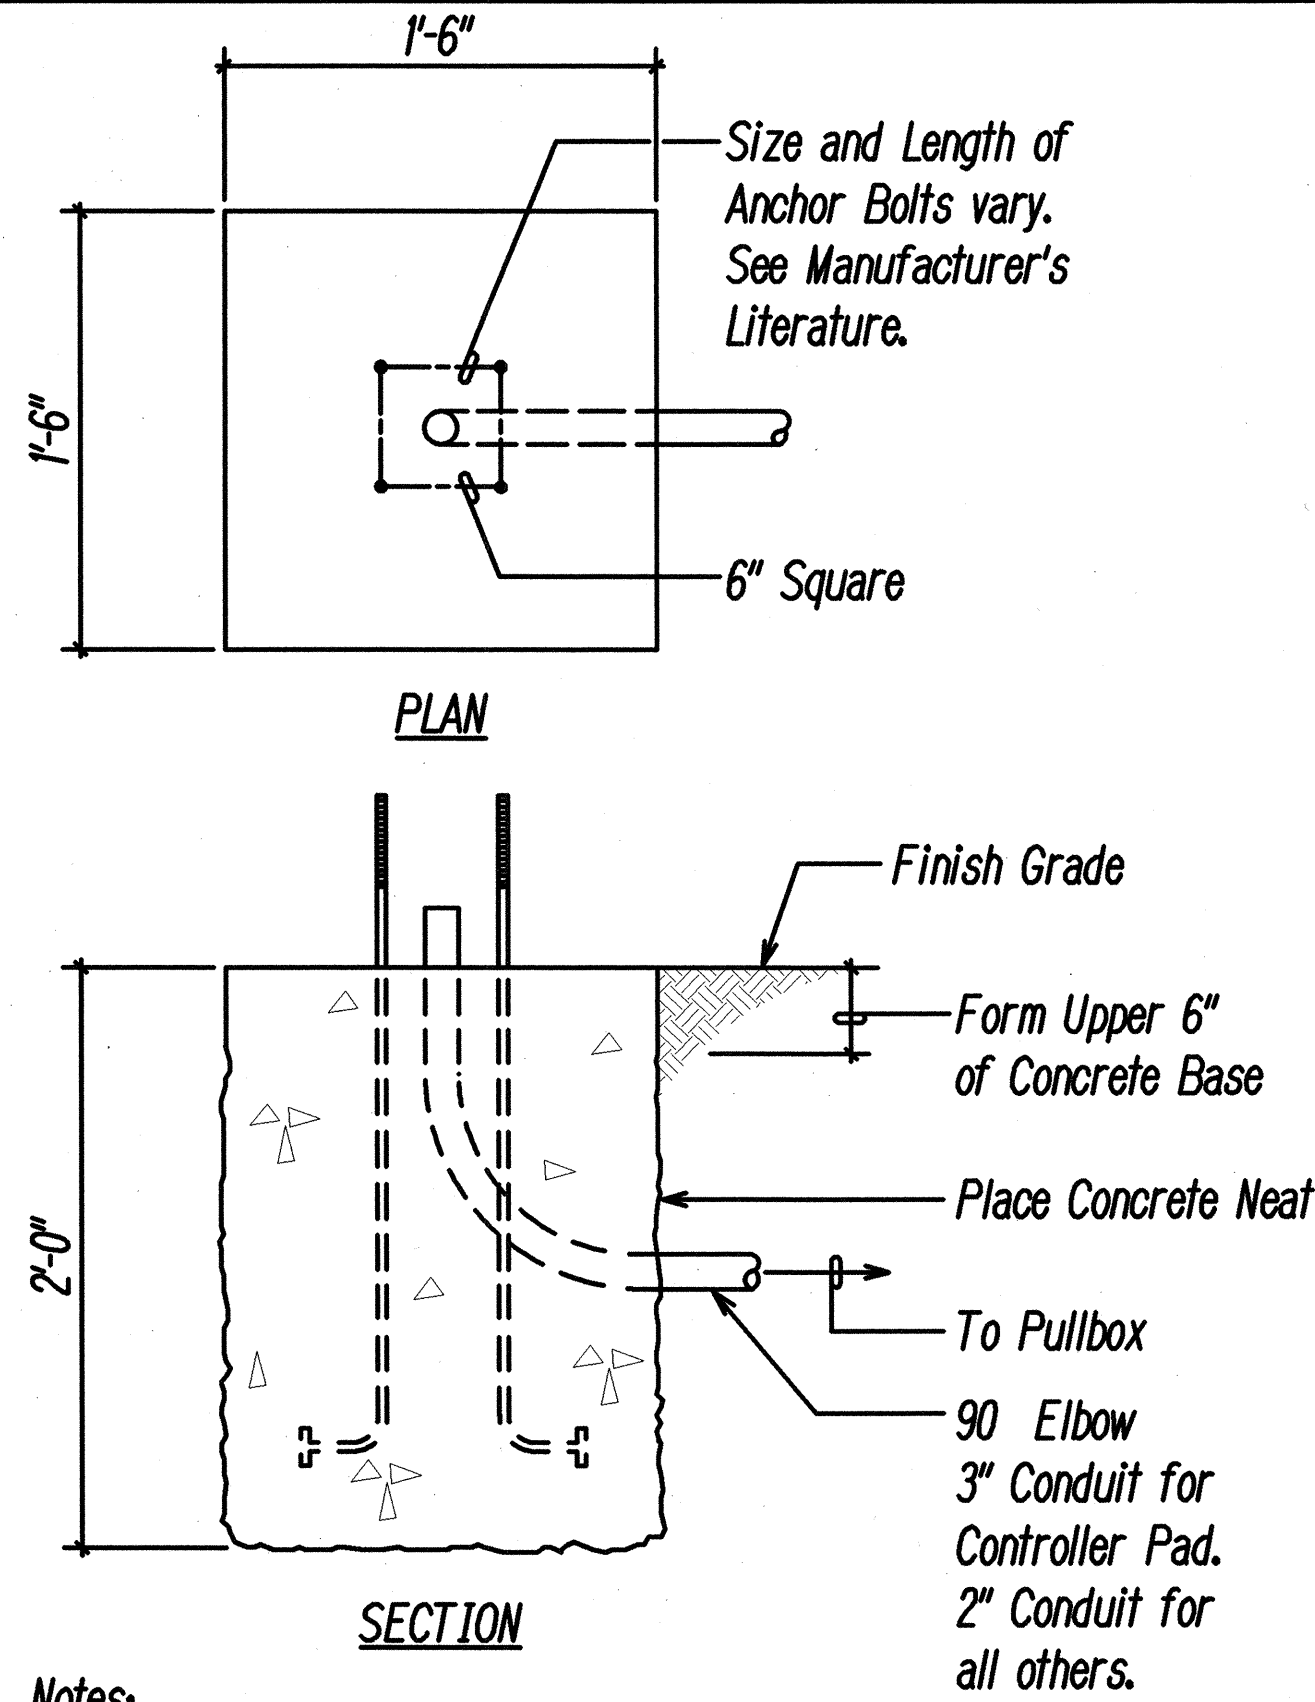

- Notes:
1. Concrete Shall be Class "B".
 2. Type "A" Concrete Base shall be used for Type I-10 Standards.
 3. Conduit Bend is Incidental to Concrete Base Construction.

A TYPE "A" CONCRETE BASE
E20 Not to Scale

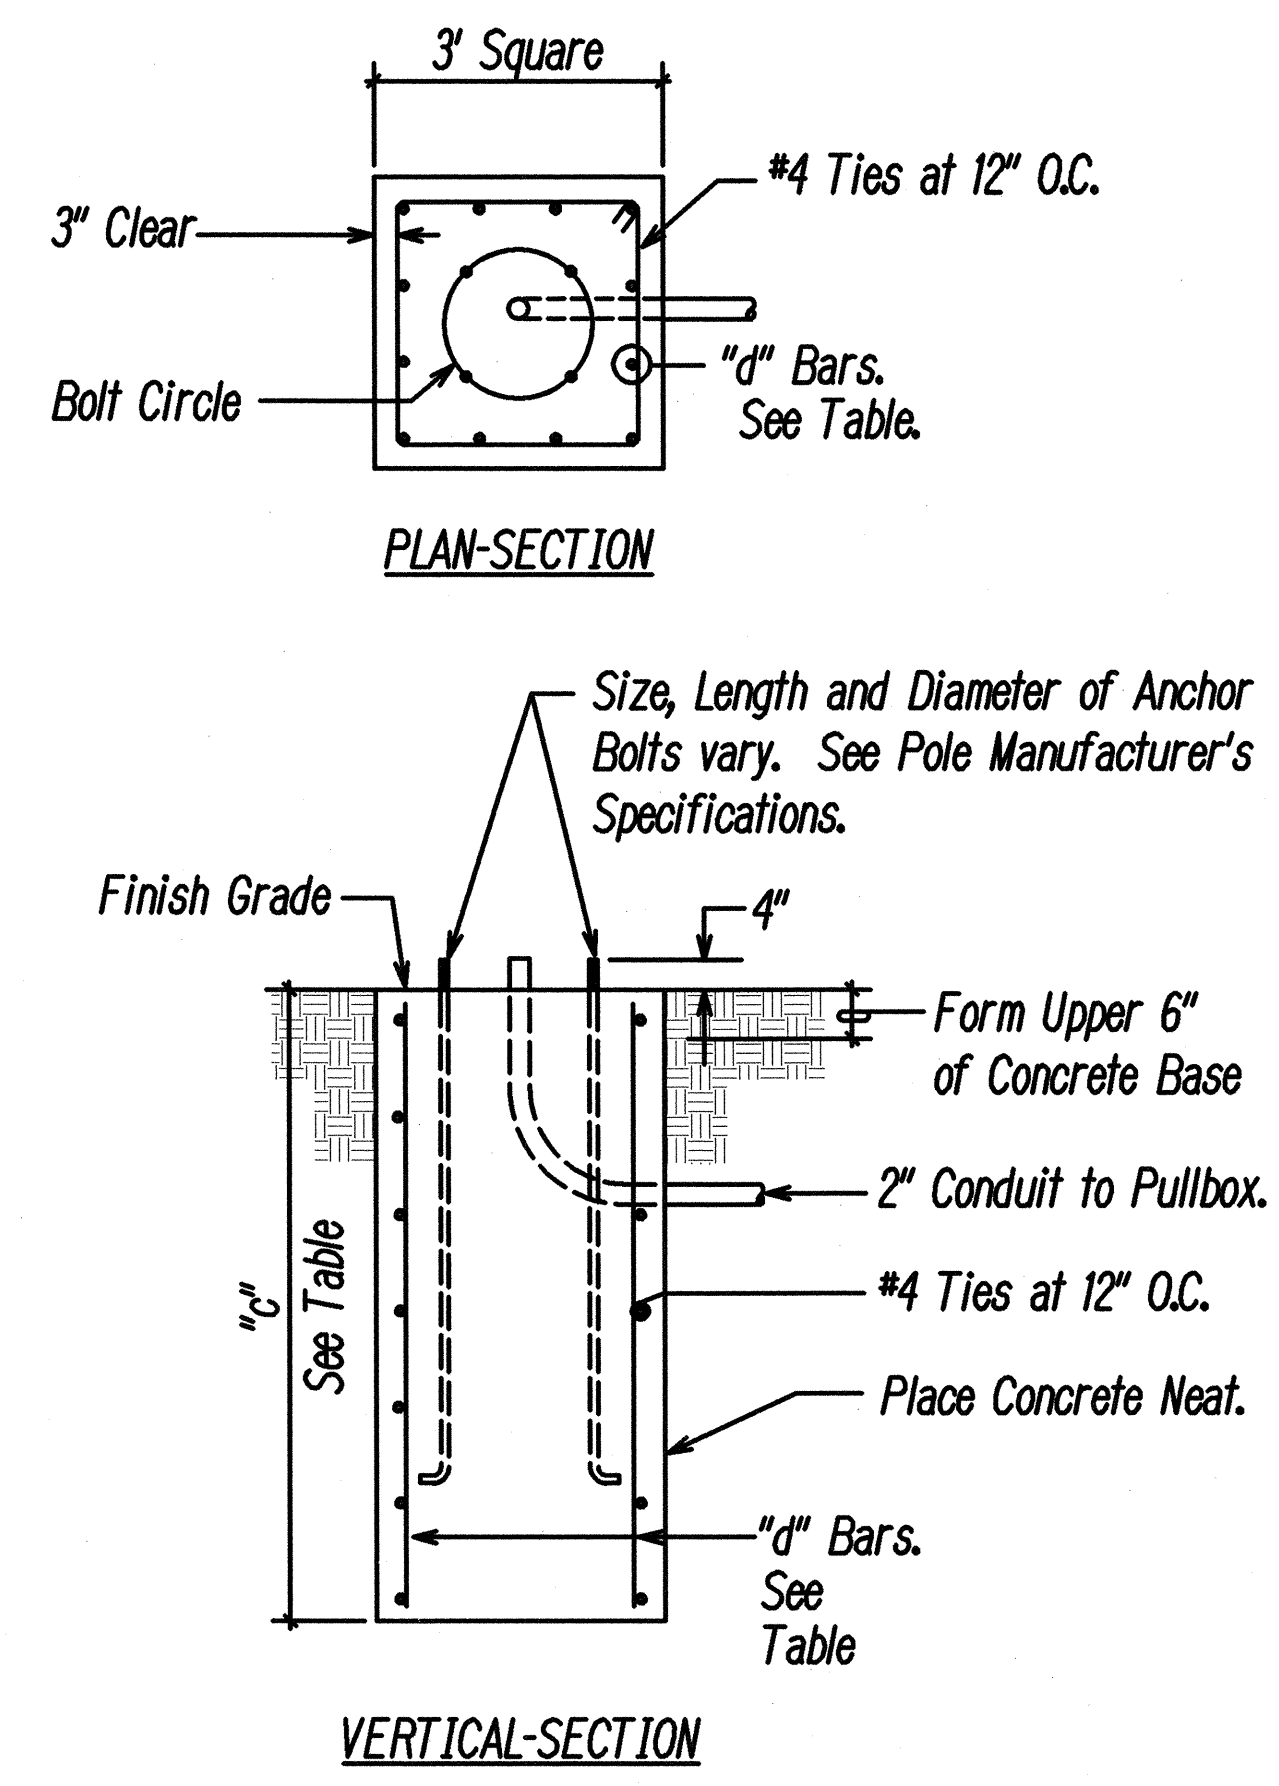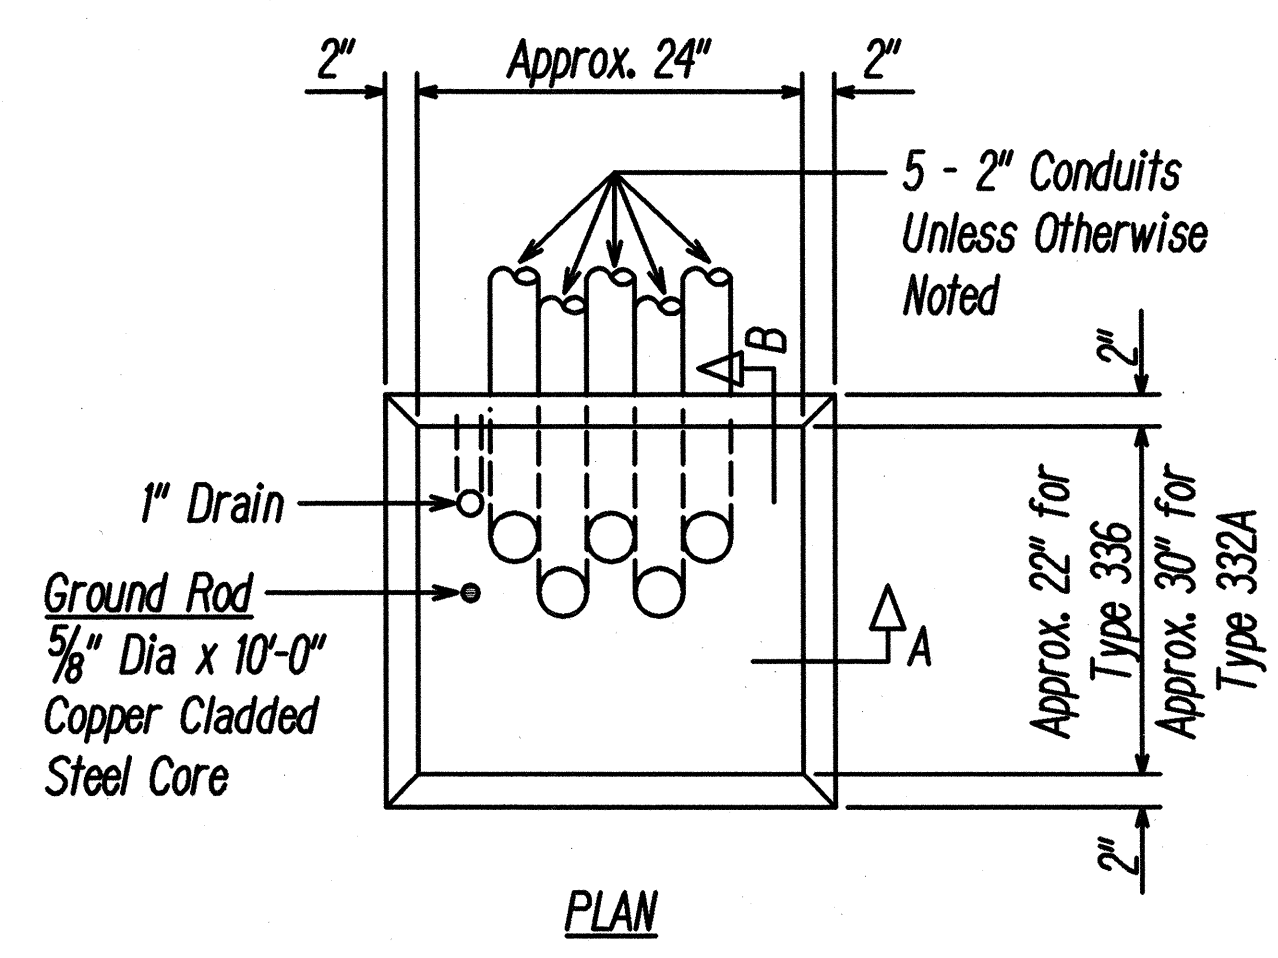


TYPE "C" CONCRETE BASE		
Type of Standard	"c"	"d" Bars
II - 18	5'-0"	12 - #6
II - 20	5'-6"	12 - #6
II - 25	6'-0"	12 - #6
II - 30	6'-6"	12 - #8
II - 35	7'-0"	12 - #8
II - 40	8'-0"	12 - #8
III - 18	5'-6"	12 - #6
III - 20	6'-0"	12 - #6
III - 25	6'-6"	12 - #8
III - 30	6'-6"	12 - #8
III - 35	7'-0"	12 - #8
III - 40	8'-0"	12 - #8

Type ———
Typical Standard Designation: II - 25
Mast Arm Length ———

- Notes:
1. Concrete shall be Class "B".
 2. Type "C" Concrete Base shall be used for Types II and III Traffic Signal Standards.
 3. Design Lateral Pressure: 1,500 PSF.
 4. Conduit bend is Incidental to Concrete Base.

B TYPE "C" CONCRETE BASE
E20 Not to Scale

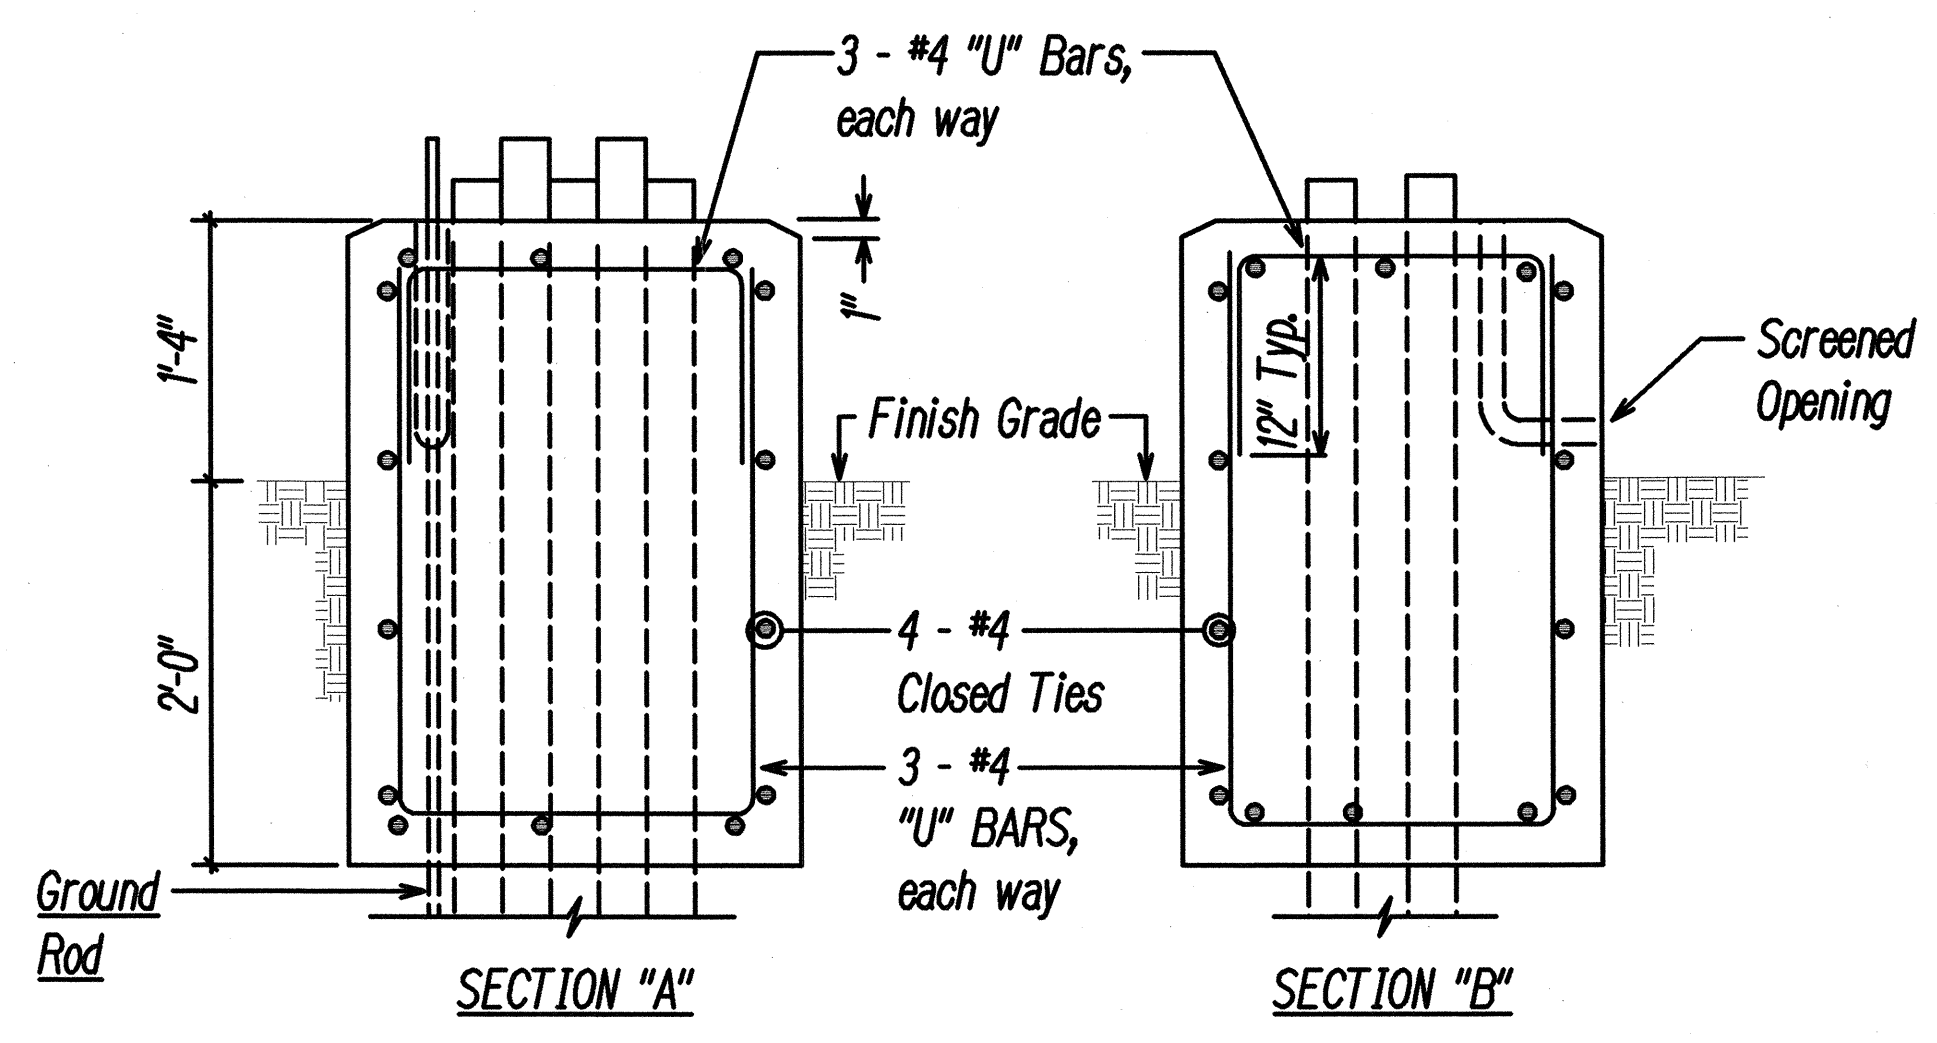


- Notes:
1. Concrete shall be Class "B".
 2. Dimensions shall be Altered to Suit Controller Cabinet Actually Furnished.
 3. Conduit Bends and Drain are Incidental to Concrete Base.
 4. Refer to Cabinet Manufacturer's Specifications for Details of Anchor Bolts and Base Setting.
 5. All Exposed Surfaces of Concrete Base shall be given a Class 2, Rubbed Finish.

C TYPE "D" CONCRETE BASE
E20 Not to Scale

Notes: See Standard Plan TE-39 for Additional Requirements

SURVEY PLOTTED BY	DATE
DRAWN BY	
DESIGNED BY	
QUANTITIES BY	
CHECKED BY	

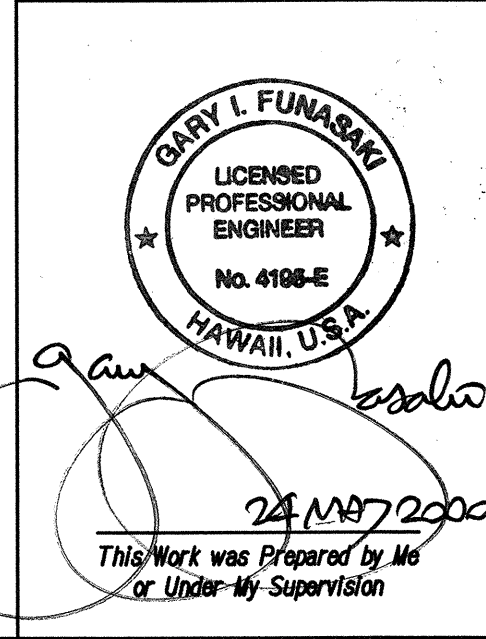

STATE OF HAWAII
DEPARTMENT OF TRANSPORTATION
HIGHWAYS DIVISION

TRAFFIC SIGNAL BASE DETAILS

HONOAPIILANI HIGHWAY WIDENING
North Kihei Road to Kuihelani Highway
F.A. Project No. BR-NH-030-1(24)


Scale: None Date: Apr. 2000

SHEET No. E20 OF 22 SHEETS

FED. ROAD DIST. NO.	STATE	FED. AID PROJ. NO.	FISCAL YEAR	SHEET NO.	TOTAL SHEETS
HAWAII	HAW.	BR-NH-030-1(24)	2000	126	139

GENERAL NOTES

- Provide a minimum of one 16 dia. x 2.5m Copperweld Ground Rod in each pullbox. When directed by the Traffic Signal Inspector/Engineer, install additional Ground Rods. Cost of Ground Rods shall be incidental to the pullboxes.
- All pre-cast concrete pullboxes shall be manufactured in two pieces.
- The pullbox with cover shall be capable of supporting an MS 18 Loading.
- The maximum weight of the pullbox cover shall not exceed 27 kilograms.
- The openings for the conduits on all pullboxes shall be pre-cast concrete knockouts.
- After installing the conduits in the openings of the pullboxes, the Contractor shall fill the excess opening in the pre-cast knockouts with concrete mortar.
- Prior to installing the pullboxes, the Contractor shall level the bottom of the trench and achieve a minimum of 95% relative compaction of the bottom of the trench.
- All concrete shall be Class A (25MPa, min.)
- Rebars shall be Grade 300 and all lapped splices shall be 360mm minimum.
- The #57 or #67 size aggregate shall conform to latest version of AASHTO M43 (ASTM D 448).
- Type "C" Pullbox shall be installed in a location protected from vehicular traffic (i.e. raised sidewalk, behind A.C. curbs, traffic signal standard or pipe guards).

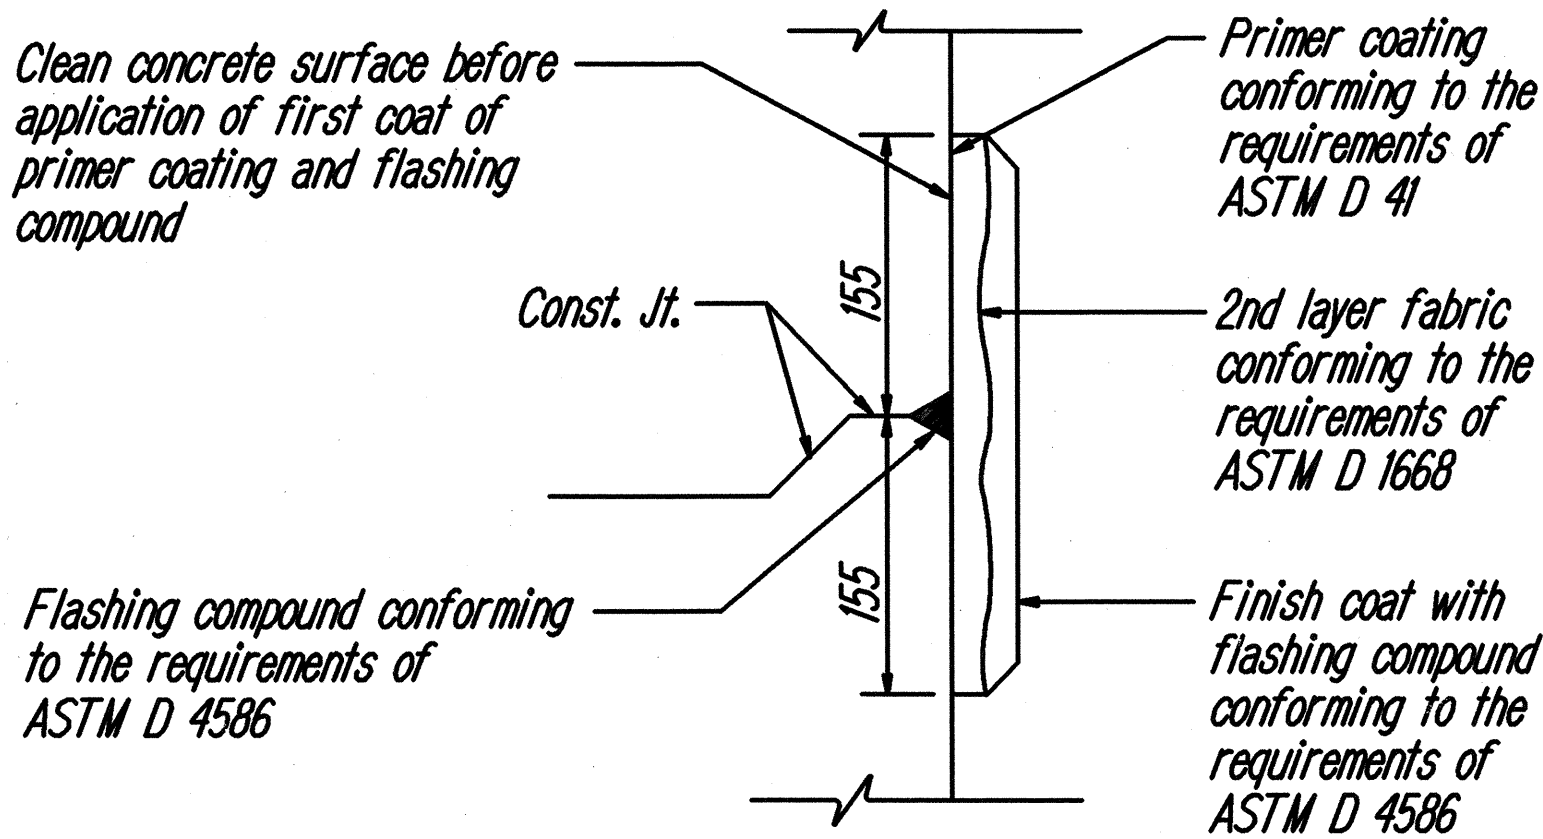

D
E22
TYPICAL FLASHING COMPOUND WATERPROOFING DETAILS
N.T.S.



All Dimensions are in Millimeters unless otherwise shown

STATE OF HAWAII
DEPARTMENT OF TRANSPORTATION
HIGHWAYS DIVISION



PULLBOX & COVER DETAILS

HONOAPIILANI HIGHWAY WIDENING
North Kihei Road to Kuihelani Highway
F.A. Project No. BR-NH-030-1(24)


Scale: As Noted Date: Apr. 2000
SHEET No. E22 OF 22 SHEETS

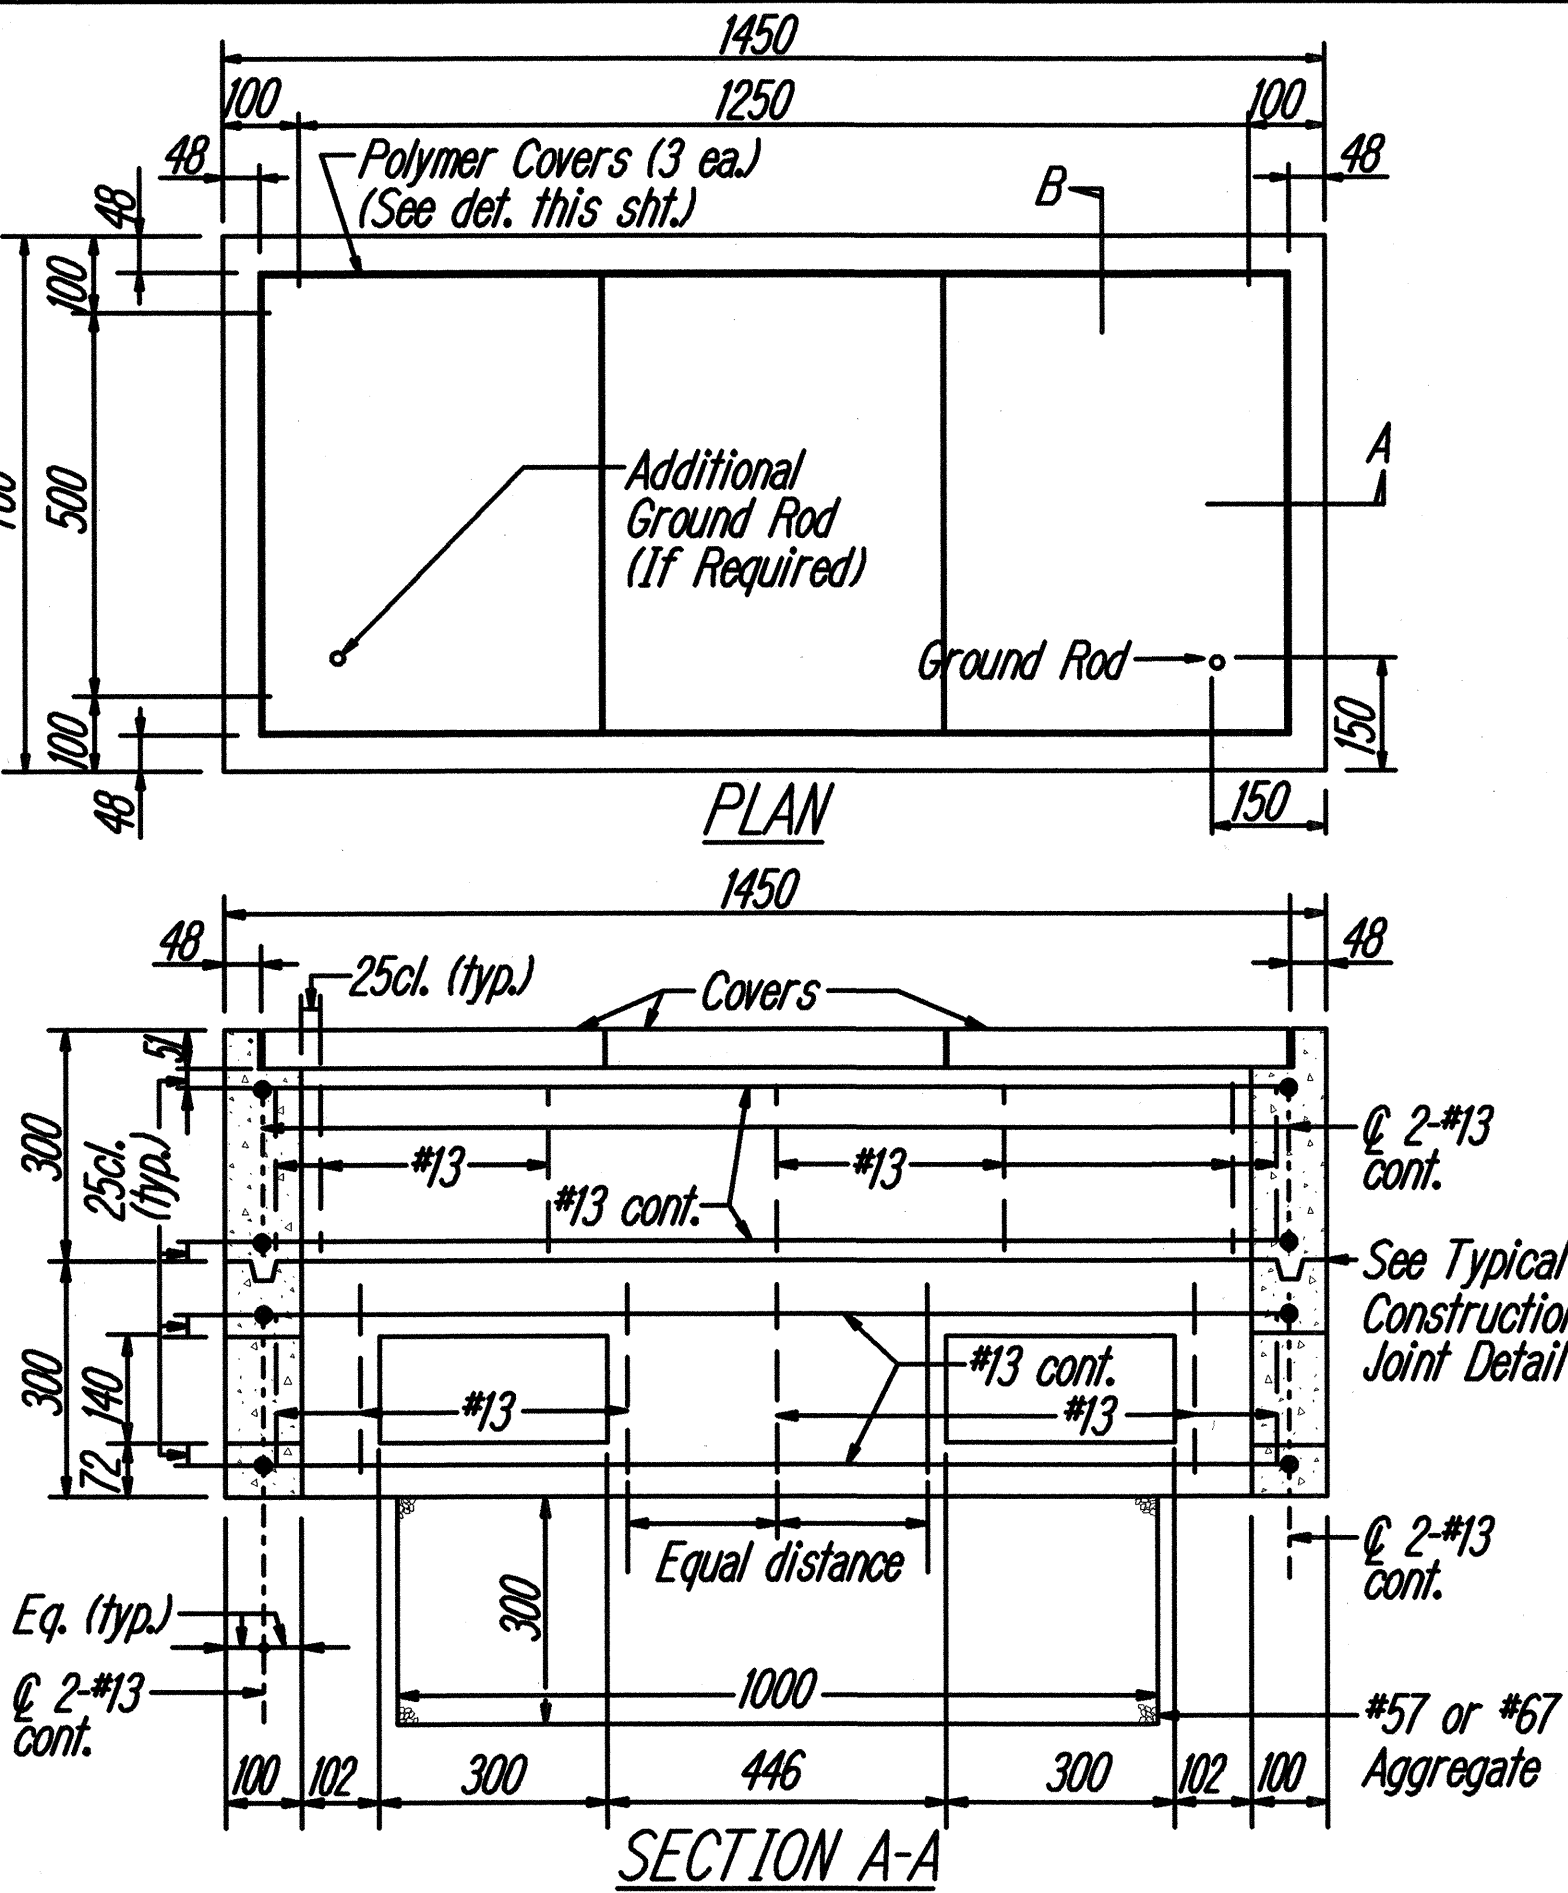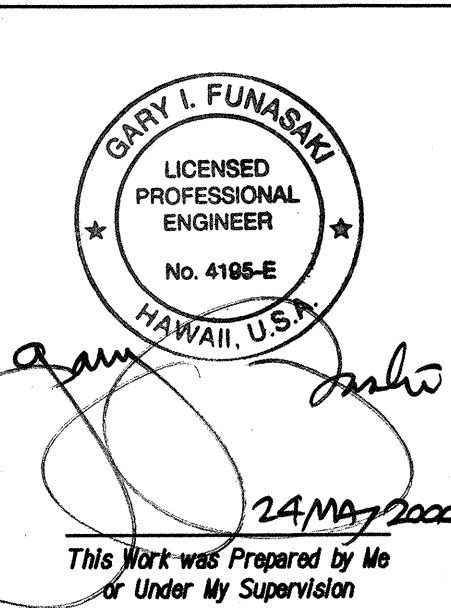


C
E22
TYPE "C" PULLBOX (Old Type "D")
N.T.S.

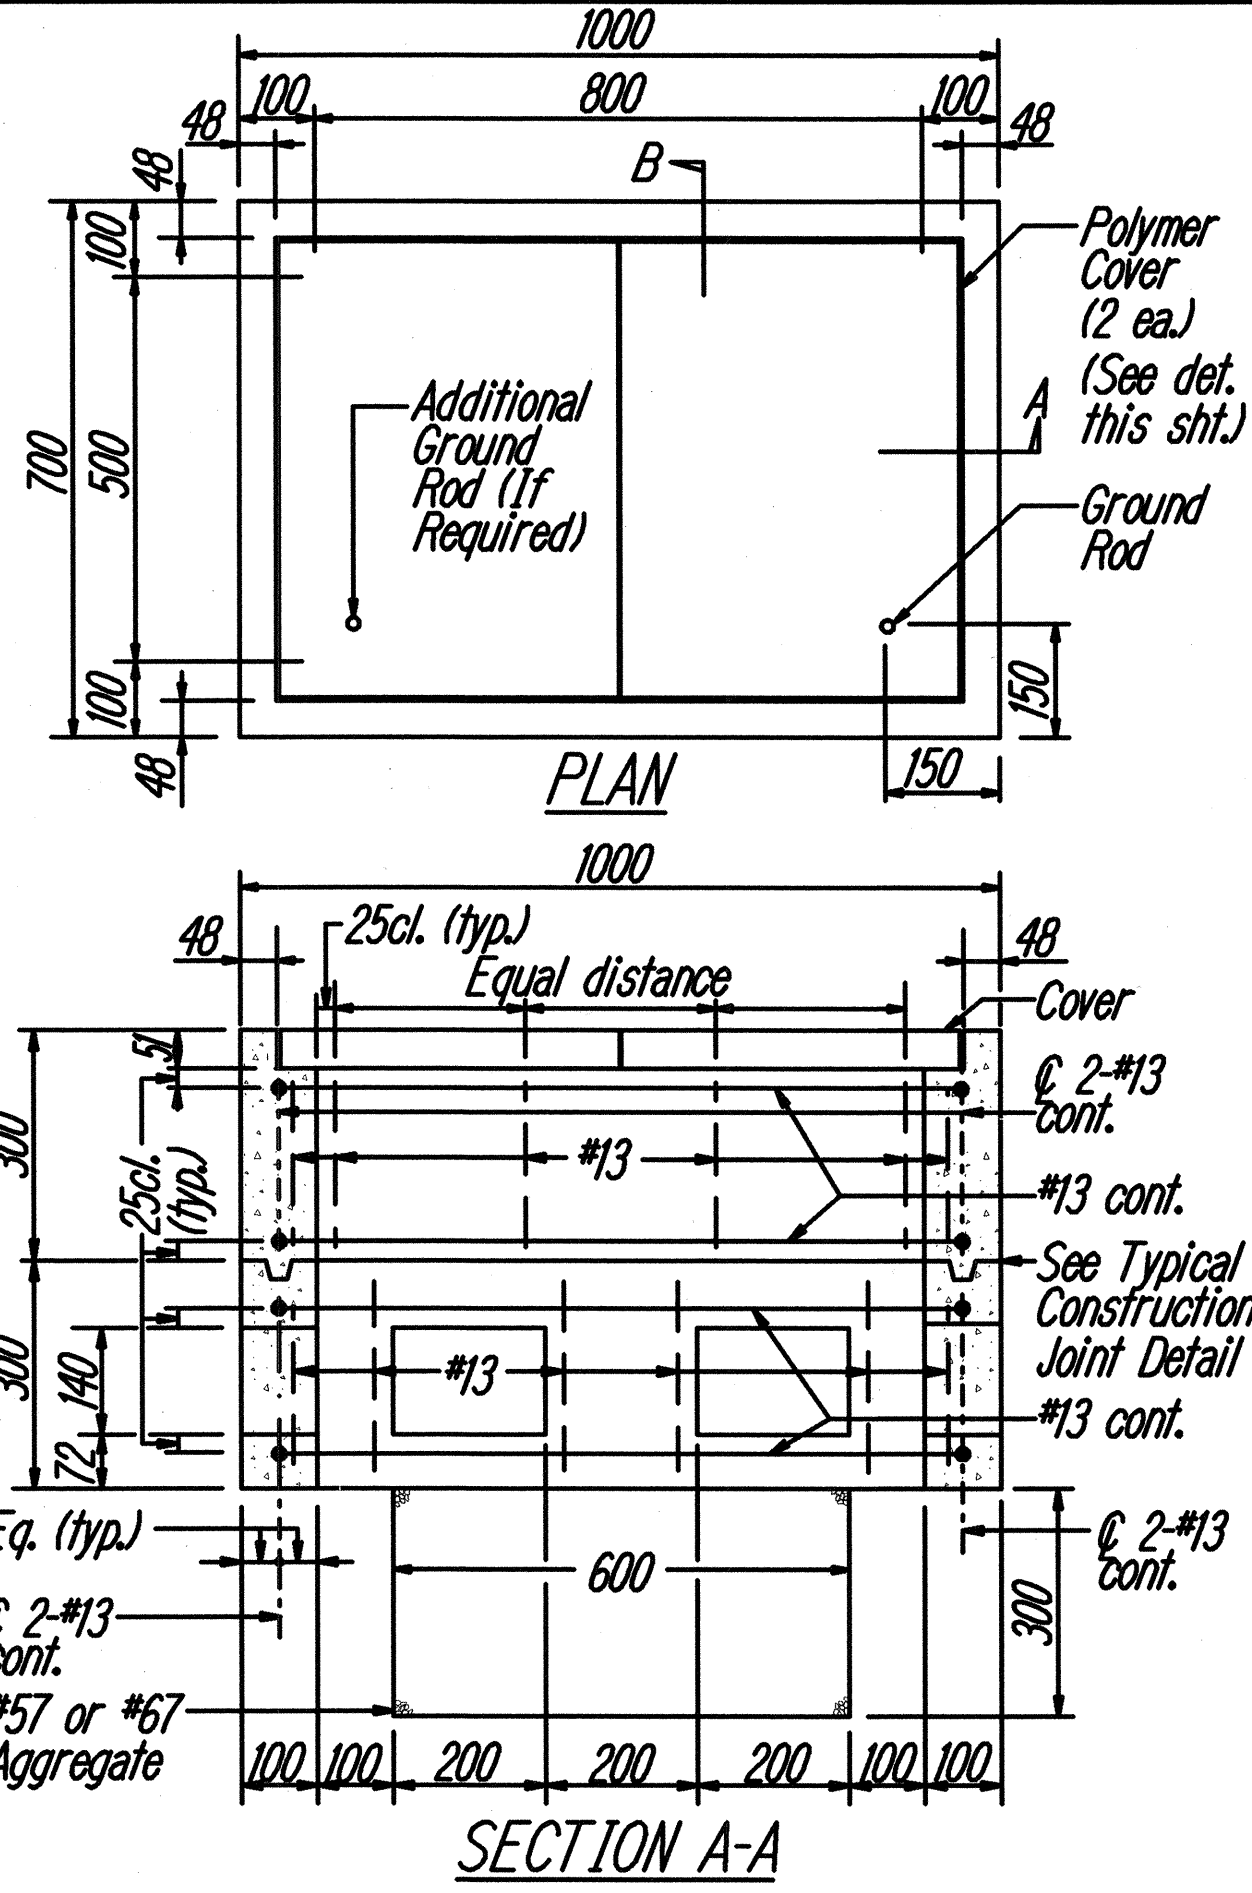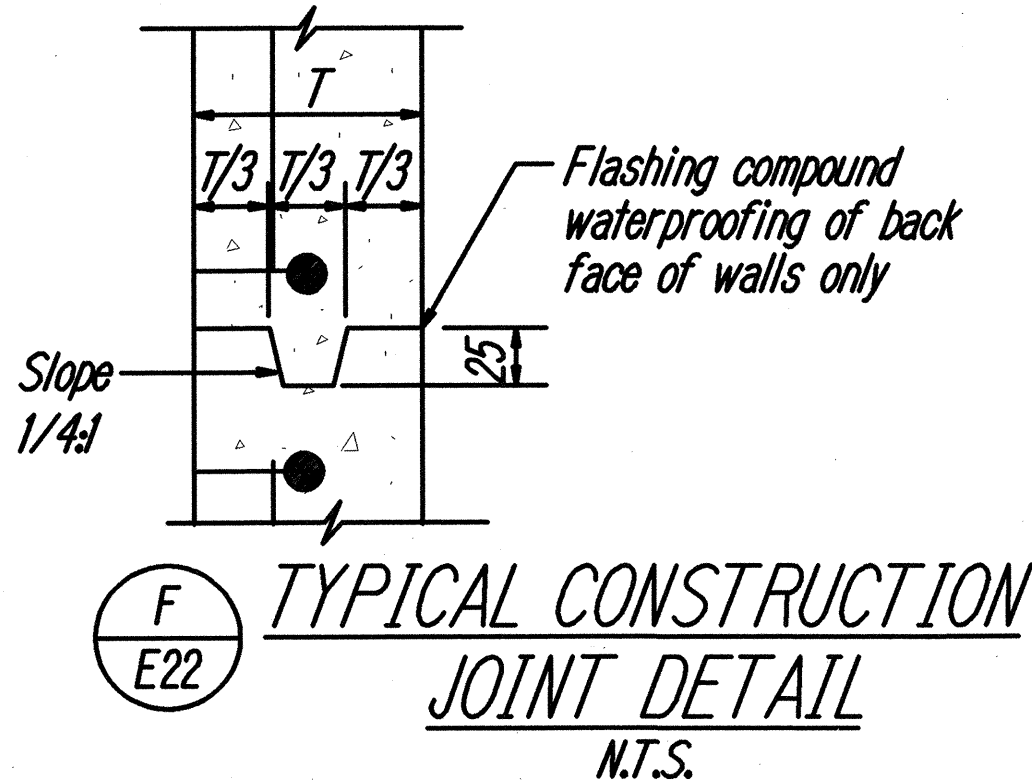


B
E22
TYPE "B" PULLBOX (Old Type "C")
N.T.S.

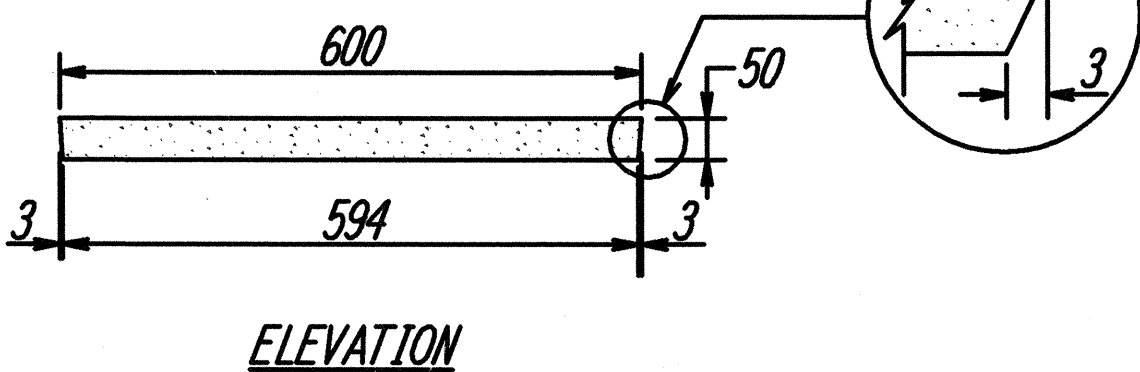

E
E22
POLYMER CONCRETE COVER
N.T.S.

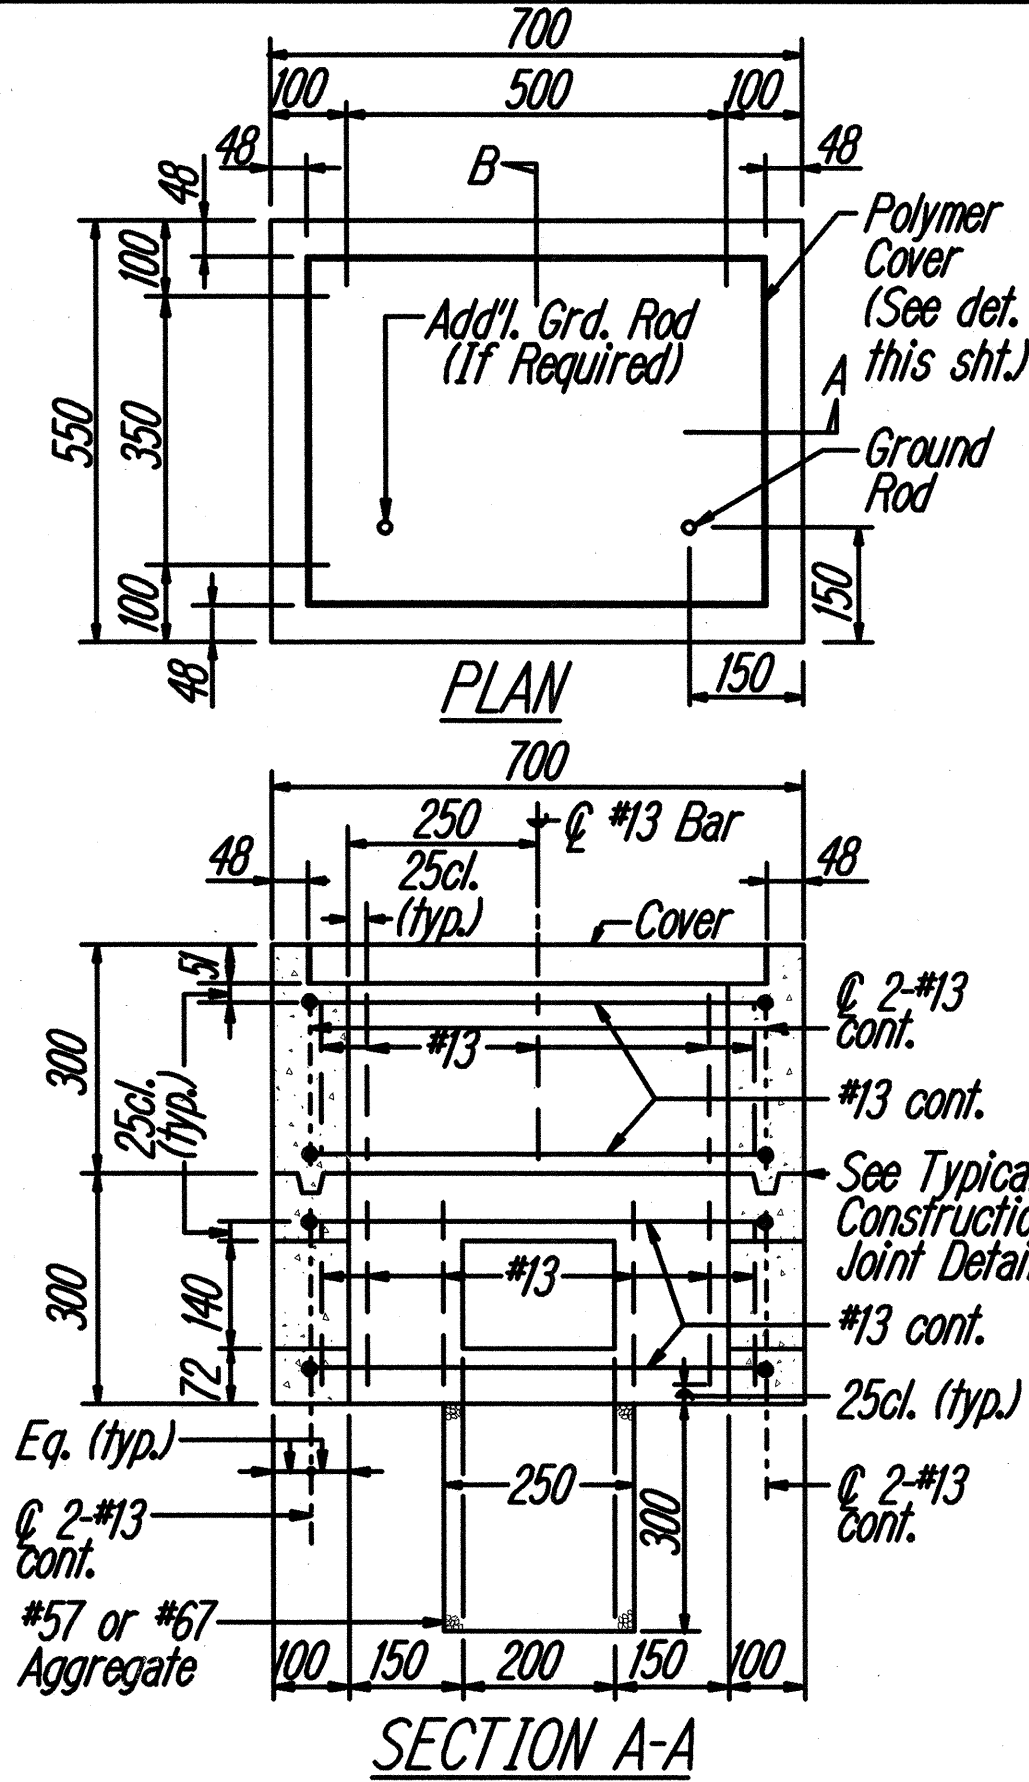

A
E22
TYPE "A" PULLBOX (Old Type "B")
N.T.S.

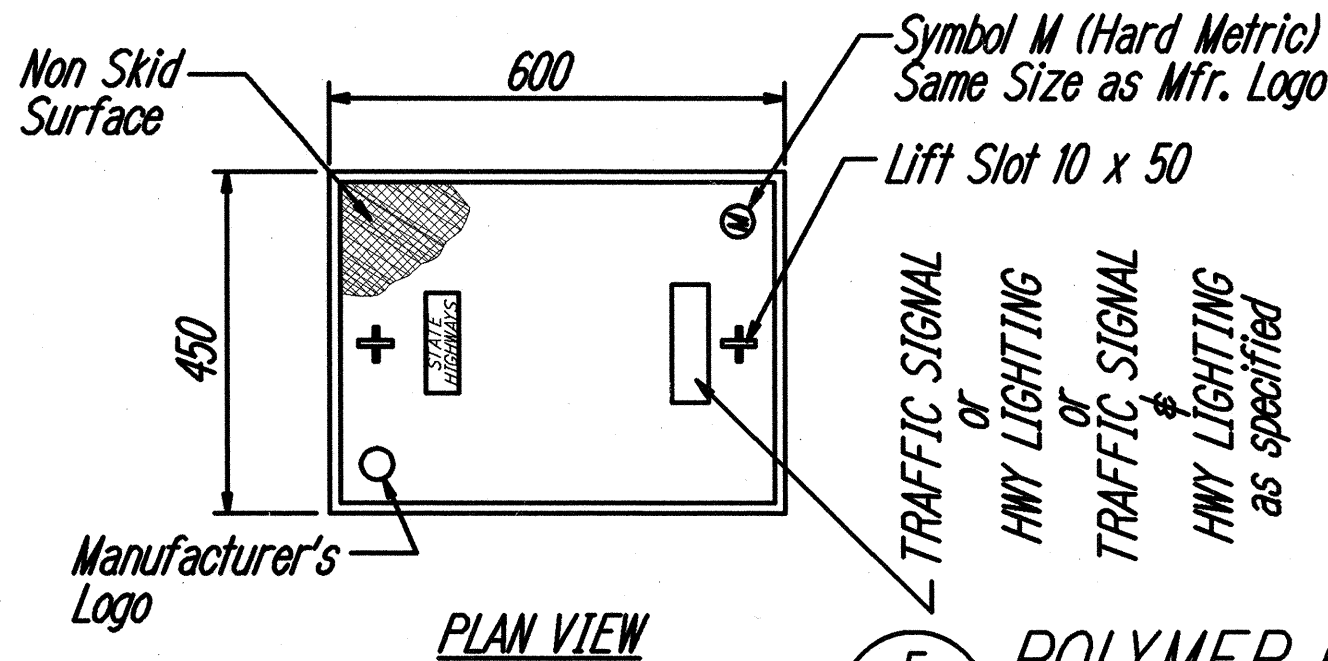

SURVEY PLOTTED BY	DATE
DRAWN BY	
CHECKED BY	
NOTE BOOK	
NO.	

16 MAY 100 11:57:32 TE Z:\wood\projects\96\170\del-111.dgn