
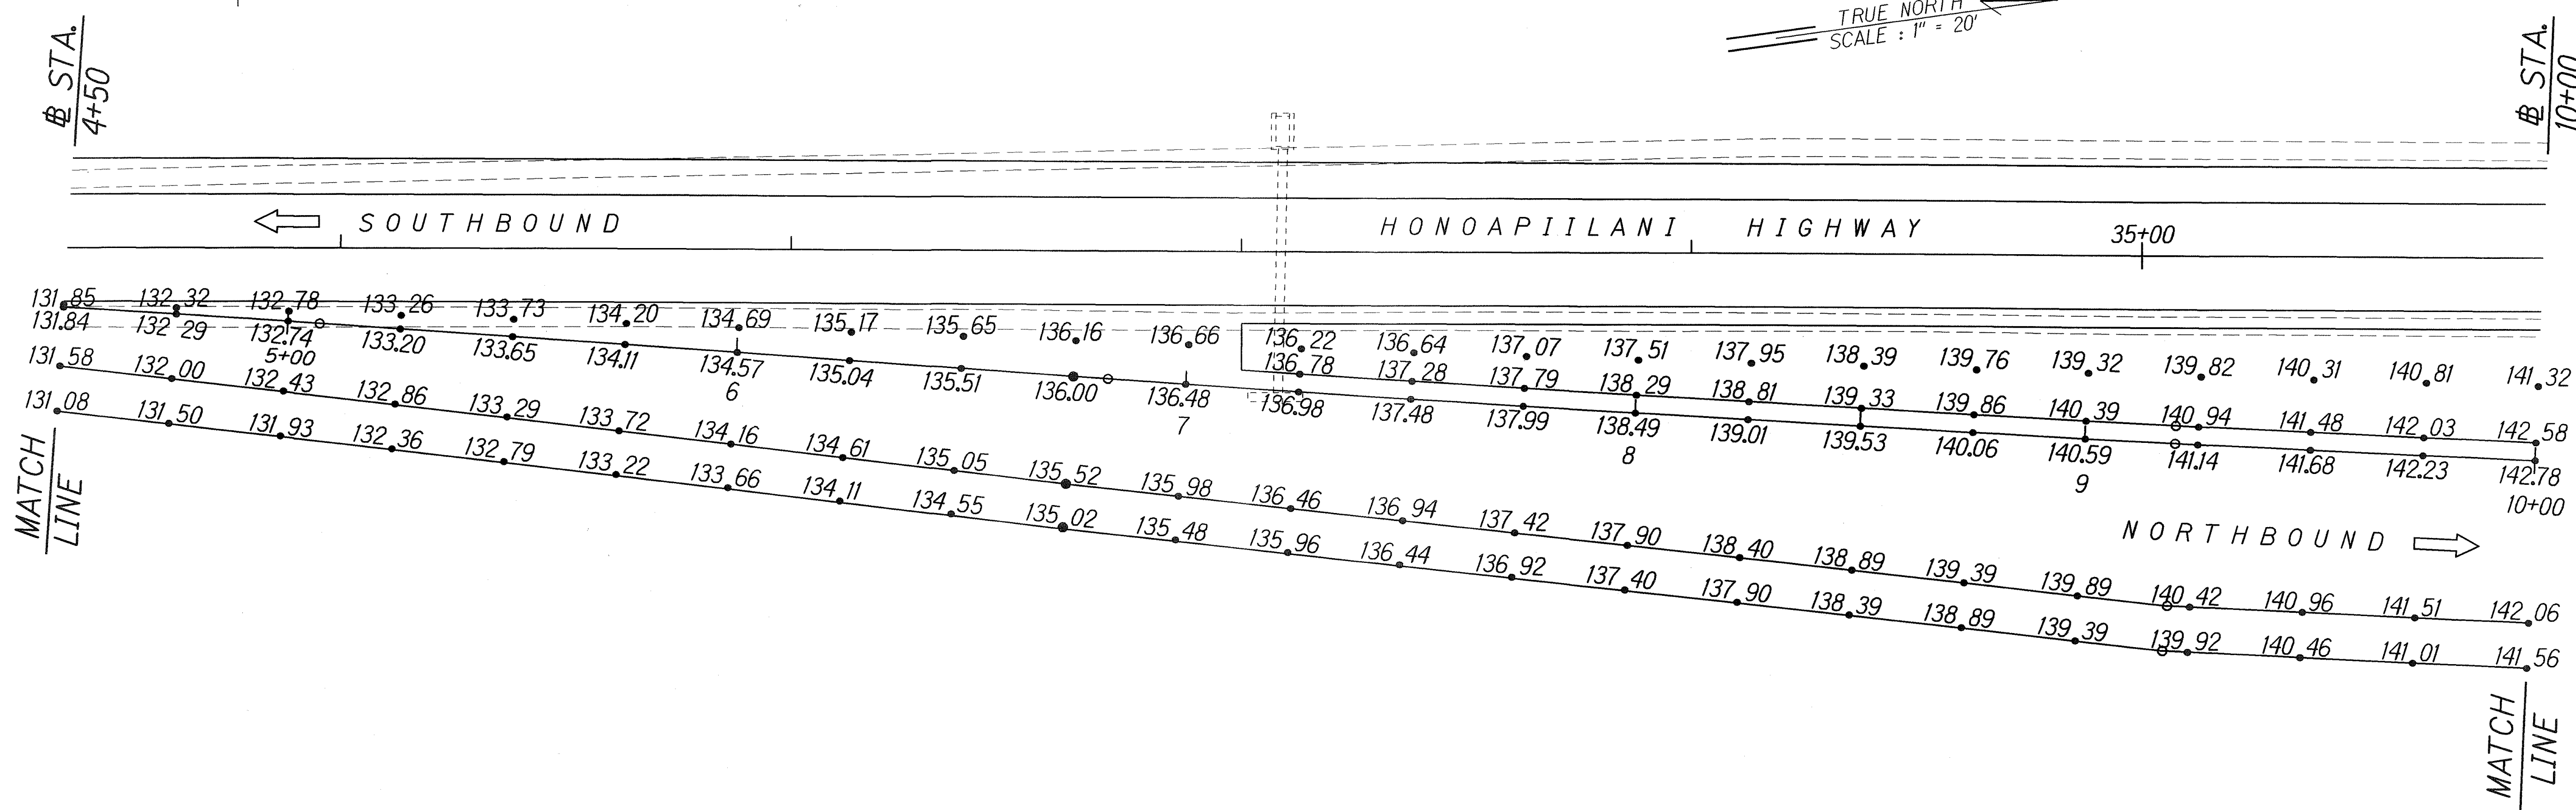


FED. ROAD DIST. NO.	STATE	FED. AID PROJ. NO.	FISCAL YEAR	SHEET NO.	TOTAL SHEETS
HAWAII	HAW.	BR-NH-030-1(24)	2000	17	139

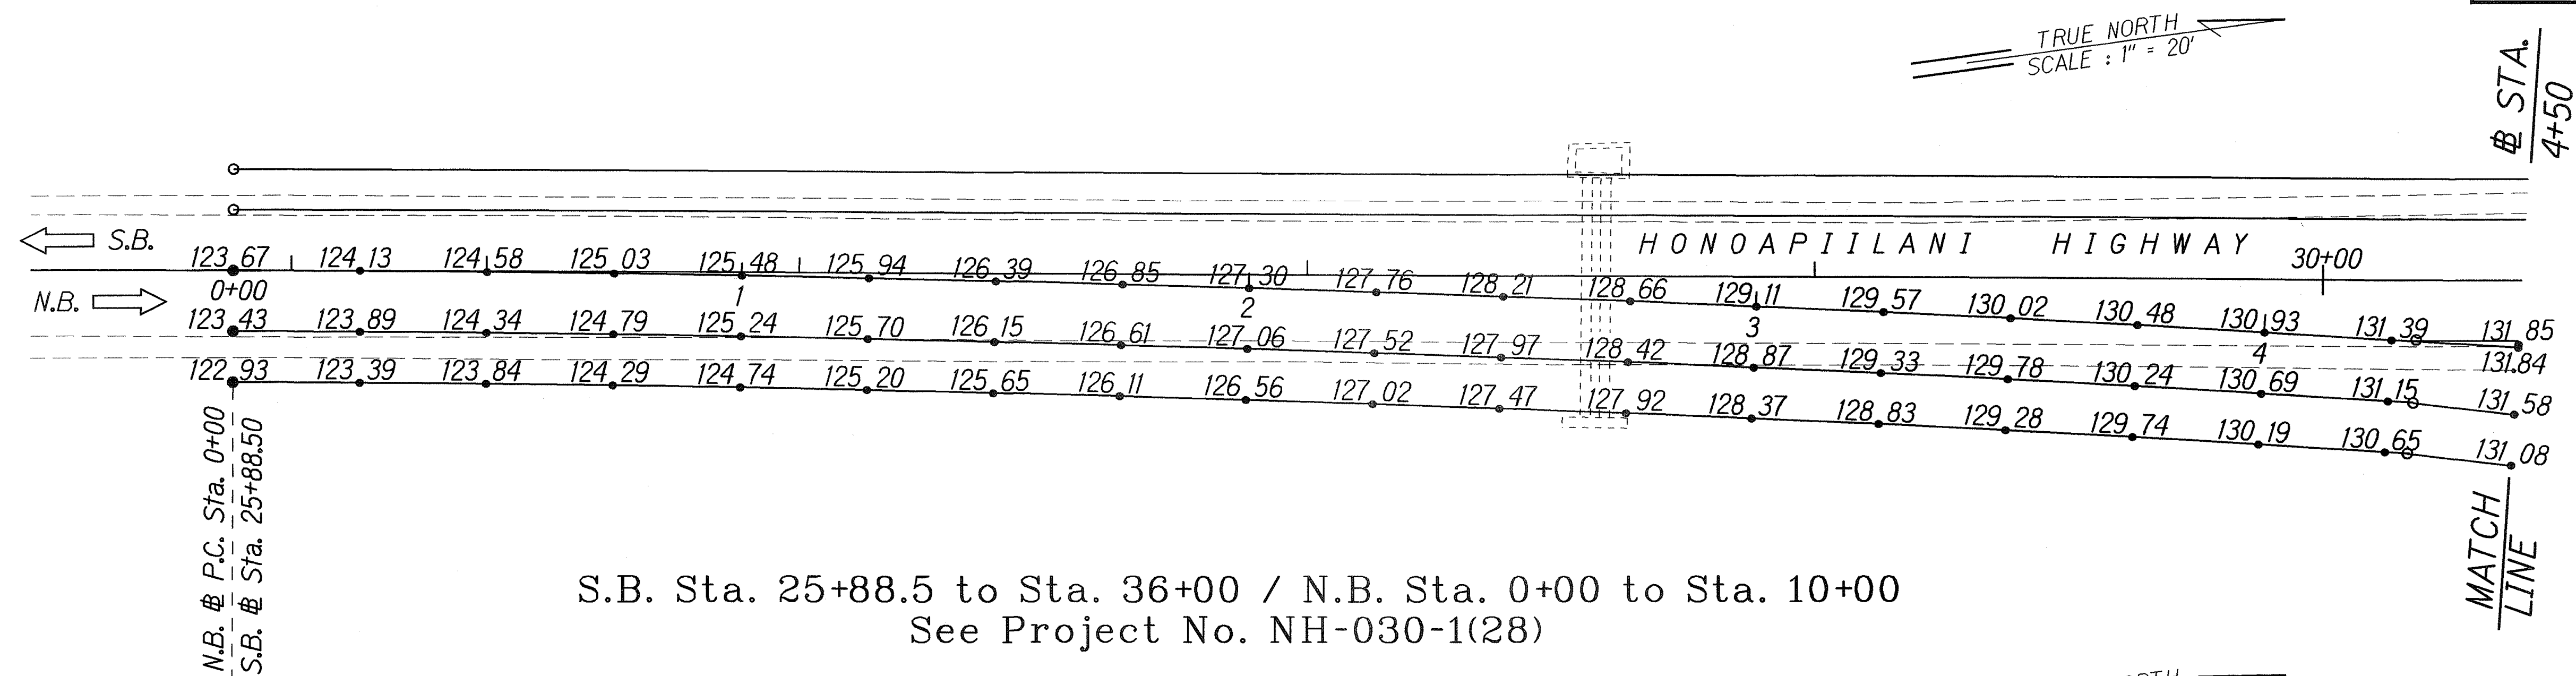

ORIGINAL PLAN	SURVEY PLOTTED BY	DATE
NOTE BOOK	DRAWN BY	2.5.06
QUANTITIES BY	DESIGNED BY	
CHECKED BY		

LEGEND FOR AS-BUILT POSTINGS	
	Squiggly line for as-built deletion
	Double line for as-built deletion
Roadway	Text for as-built posting

STATE OF HAWAII
DEPARTMENT OF TRANSPORTATION
HIGHWAYS DIVISION


GRADING PLAN

HONOAPIILANI HIGHWAY WIDENING
North Kihei Road to Kuihelani Highway
F.A. Project No. BR-NH-030-1(24)

Scale: 1"=20' Date: Feb., 2000

SHEET No. 1 OF 7 SHEETS

FED. ROAD DIST. NO.	STATE	FED. AID PROJ. NO.	FISCAL YEAR	SHEET NO.	TOTAL SHEETS
HAWAII	HAW.	BR-NH-030-1(24)	2000	18	139

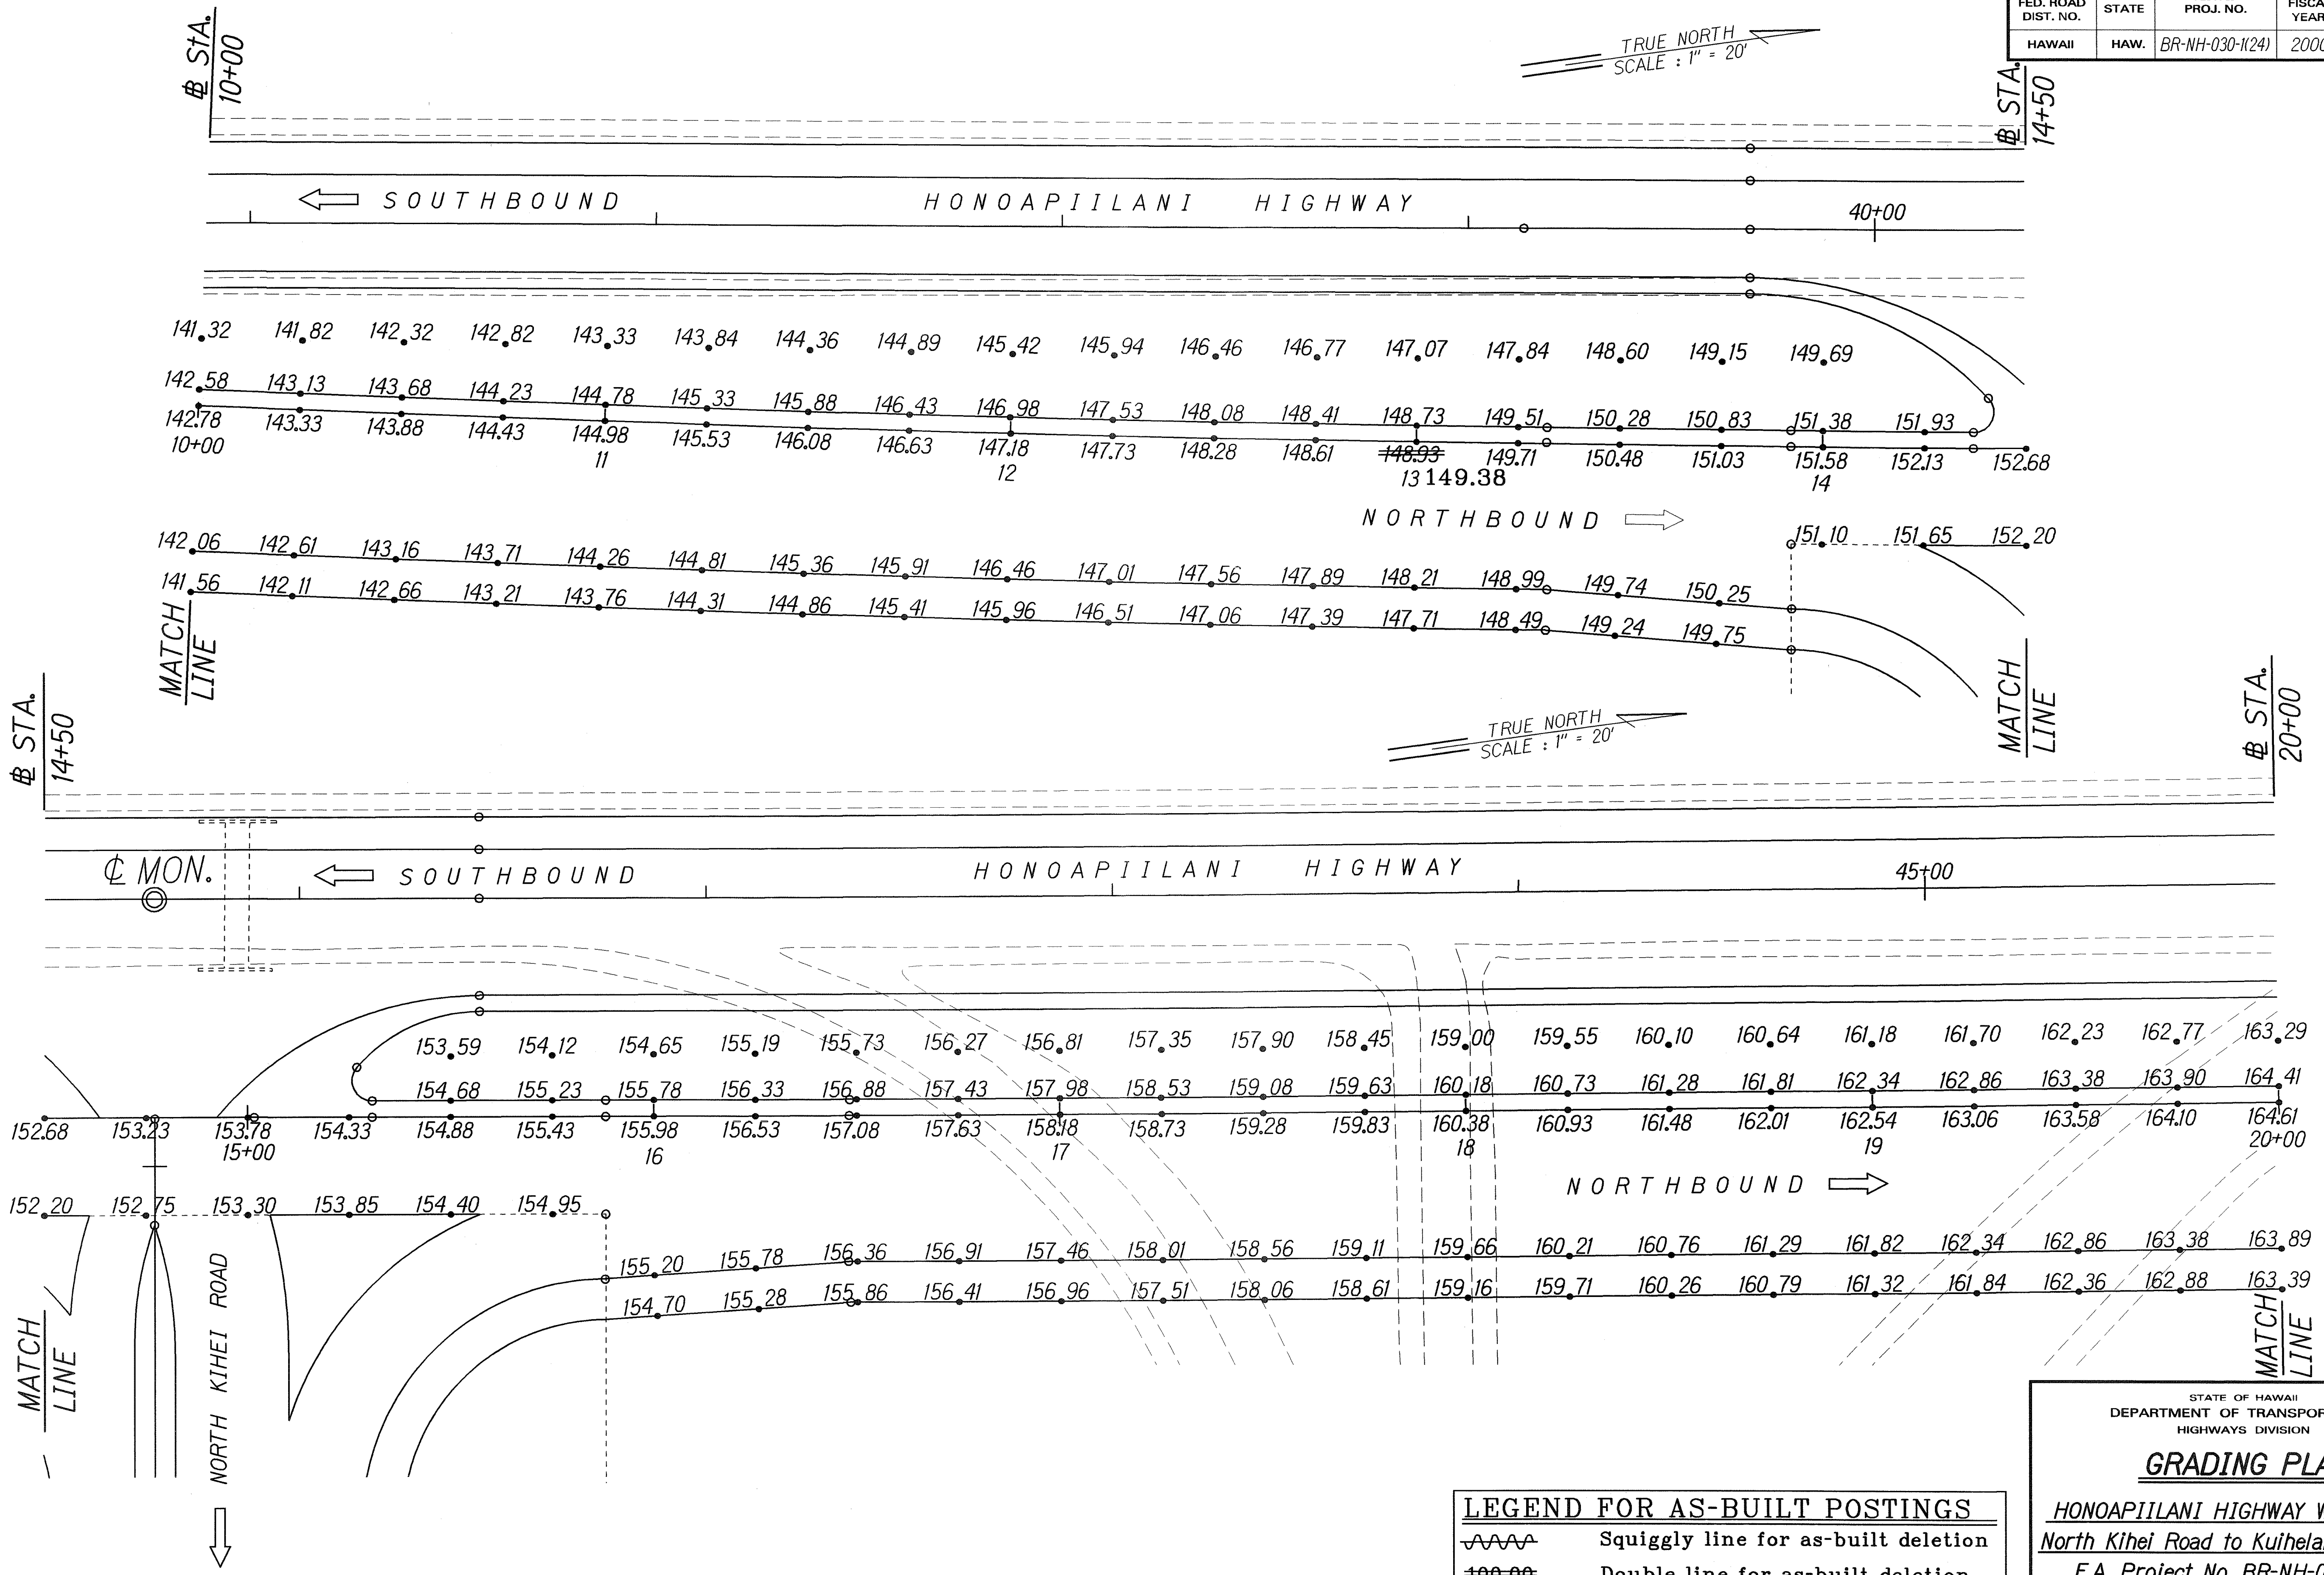

ORIGINAL PLAN	SURVEY PLOTTED BY	DATE
NOTE BOOK	DRAWN BY	2-5-98
ad/taeas/ul	TRACED BY	
NOV09/2-98	CHECKED BY	

LEGEND FOR AS-BUILT POSTINGS	
	Squiggly line for as-built deletion
	Double line for as-built deletion
Roadway	Text for as-built posting

STATE OF HAWAII
DEPARTMENT OF TRANSPORTATION
HIGHWAYS DIVISION

GRADING PLAN


HONOAPIILANI HIGHWAY WIDENING
North Kihei Road to Kuihelani Highway
F.A. Project No. BR-NH-030-1(24)

Scale: 1"=20' Date: Feb., 2000

SHEET No. 2 OF 7 SHEETS

"AS-BUILT"

FED. ROAD DIST. NO.	STATE	FED. AID PROJ. NO.	FISCAL YEAR	SHEET NO.	TOTAL SHEETS
HAWAII	HAW.	BR-NH-030-1(24)	2000	19	139

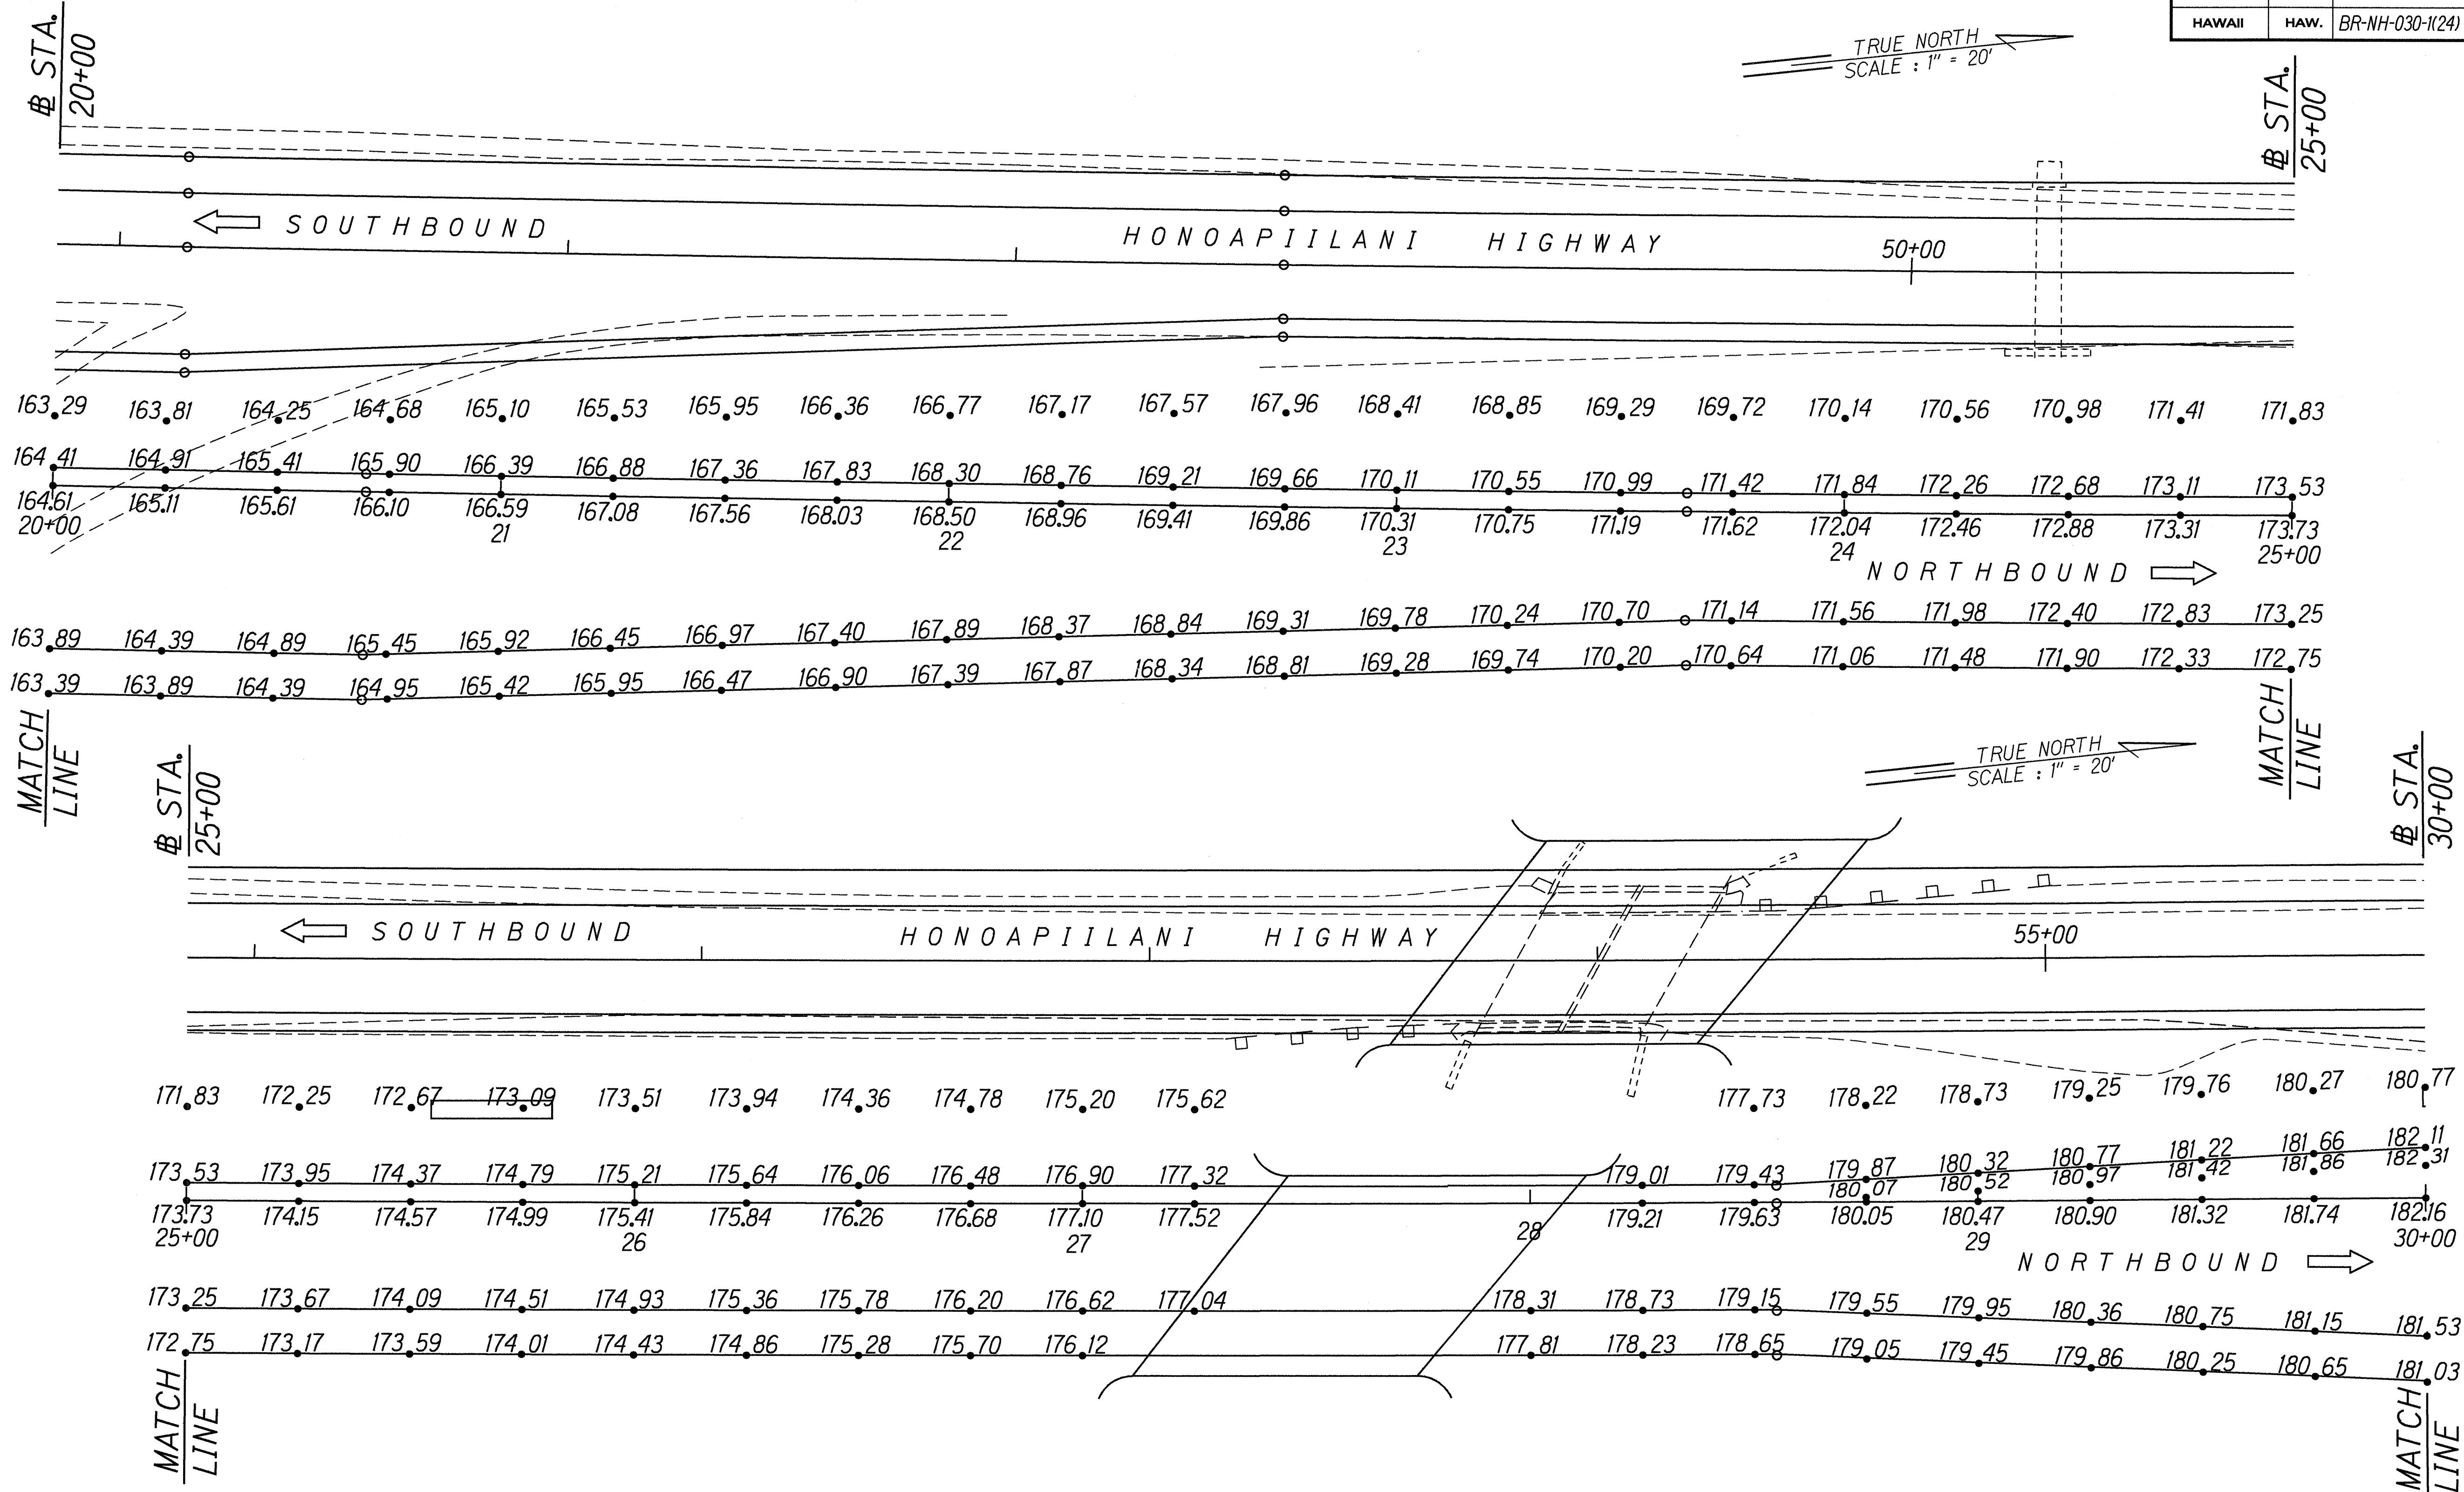

ORIGINAL PLAN	DATE	7-4-97
SURVEY PLOTTED BY		
DRAWN BY		
NOTED BY		
CHECKED BY		

STATE OF HAWAII
DEPARTMENT OF TRANSPORTATION
HIGHWAYS DIVISION


GRADING PLAN

HONOAPIILANI HIGHWAY WIDENING
North Kihei Road to Kuihelani Highway
F.A. Project No. BR-NH-030-1(24)

Scale: 1"=20' Date: Feb., 2000

SHEET No. 3 OF 7 SHEETS

FED. ROAD DIST. NO.	STATE	FED. AID PROJ. NO.	FISCAL YEAR	SHEET NO.	TOTAL SHEETS
HAWAII	HAW.	BR-NH-030-1(24)	2000	20	139

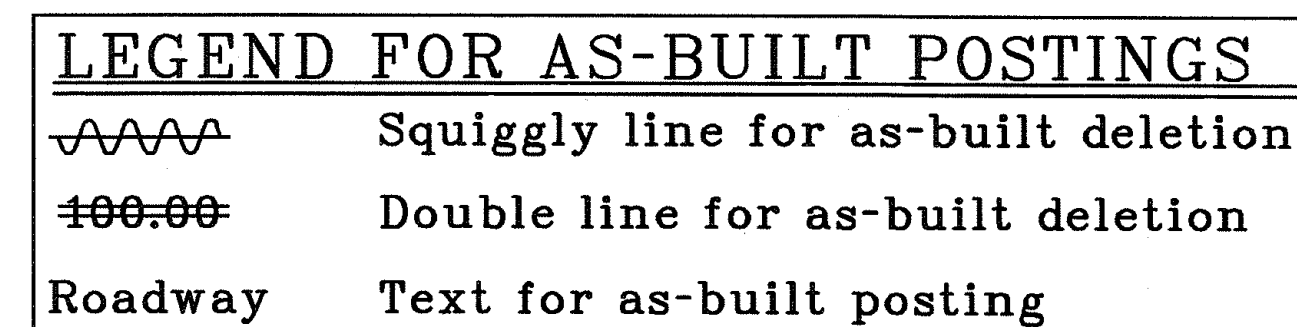

STATE OF HAWAII
DEPARTMENT OF TRANSPORTATION
HIGHWAYS DIVISION

GRADING PLAN

HONOAPIILANI HIGHWAY WIDENING
North Kihei Road to Kuihelani Highway
F.A. Project No. BR-NH-030-1(24)

Scale: 1"=20' Date: Feb., 2000

SHEET No. 4 OF 7 SHEETS

S.B. Sta. 57+87.70 Lt. to S.B. Sta. 67+51.65 Lt. See
As Built Plans for Honoapiilani Hwy Improvements
For Pohakulepo Recycling Partnership

TRUE NORTH
SCALE : 1" = 20'

40+00

45+00

SOUTHBOUND

HONOAPIILANI HIGHWAY

70+00

207.00 207.70 208.40 209.09 209.79 210.48 211.18 211.86 212.55 213.23 213.92 214.60 215.29 215.97 216.66 217.35 218.03 218.72 219.42 220.12 220.82

206.82 207.52 208.22 208.92 209.62 210.32 211.02 211.72 212.42 213.12 213.82 214.52 215.22 215.92 216.62 217.32 218.02 218.72 219.42 219.75 220.47


40+00 41 42 43 44 45+00

206.10 206.80 207.52 208.24 208.96 209.68 210.40 211.12 211.84 212.56 213.28 214.01 214.75 215.44 216.16 216.88 217.60 218.31 219.03 219.75 219.97

205.60 206.30 207.02 207.74 208.46 209.18 209.90 210.62 211.34 212.06 212.58 213.51 214.25 214.94 215.66 216.38 217.10 217.81 218.53 219.25 219.97


MATCH LINE

MATCH LINE

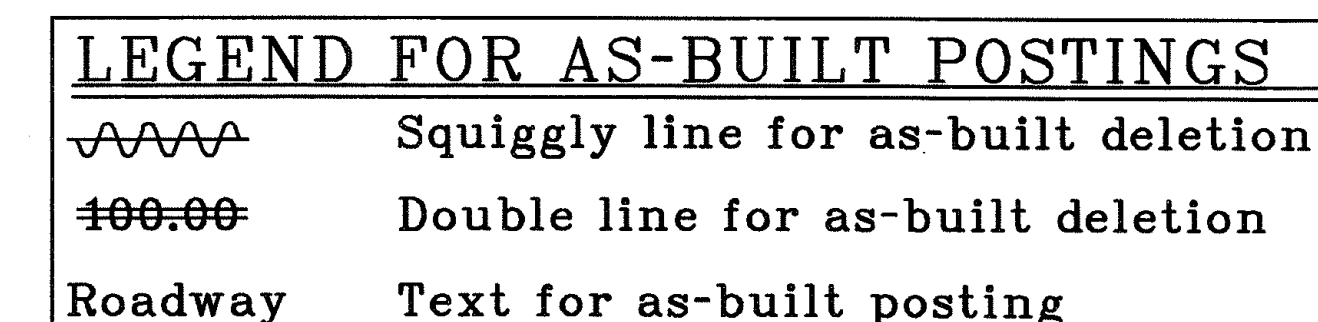

"AS-BUILT"

FED. ROAD DIST. NO.	STATE	FED. AID PROJ. NO.	FISCAL YEAR	SHEET NO.	TOTAL SHEETS
HAWAII	HAW.	BR-NH-030-K(24)	2000	22	139

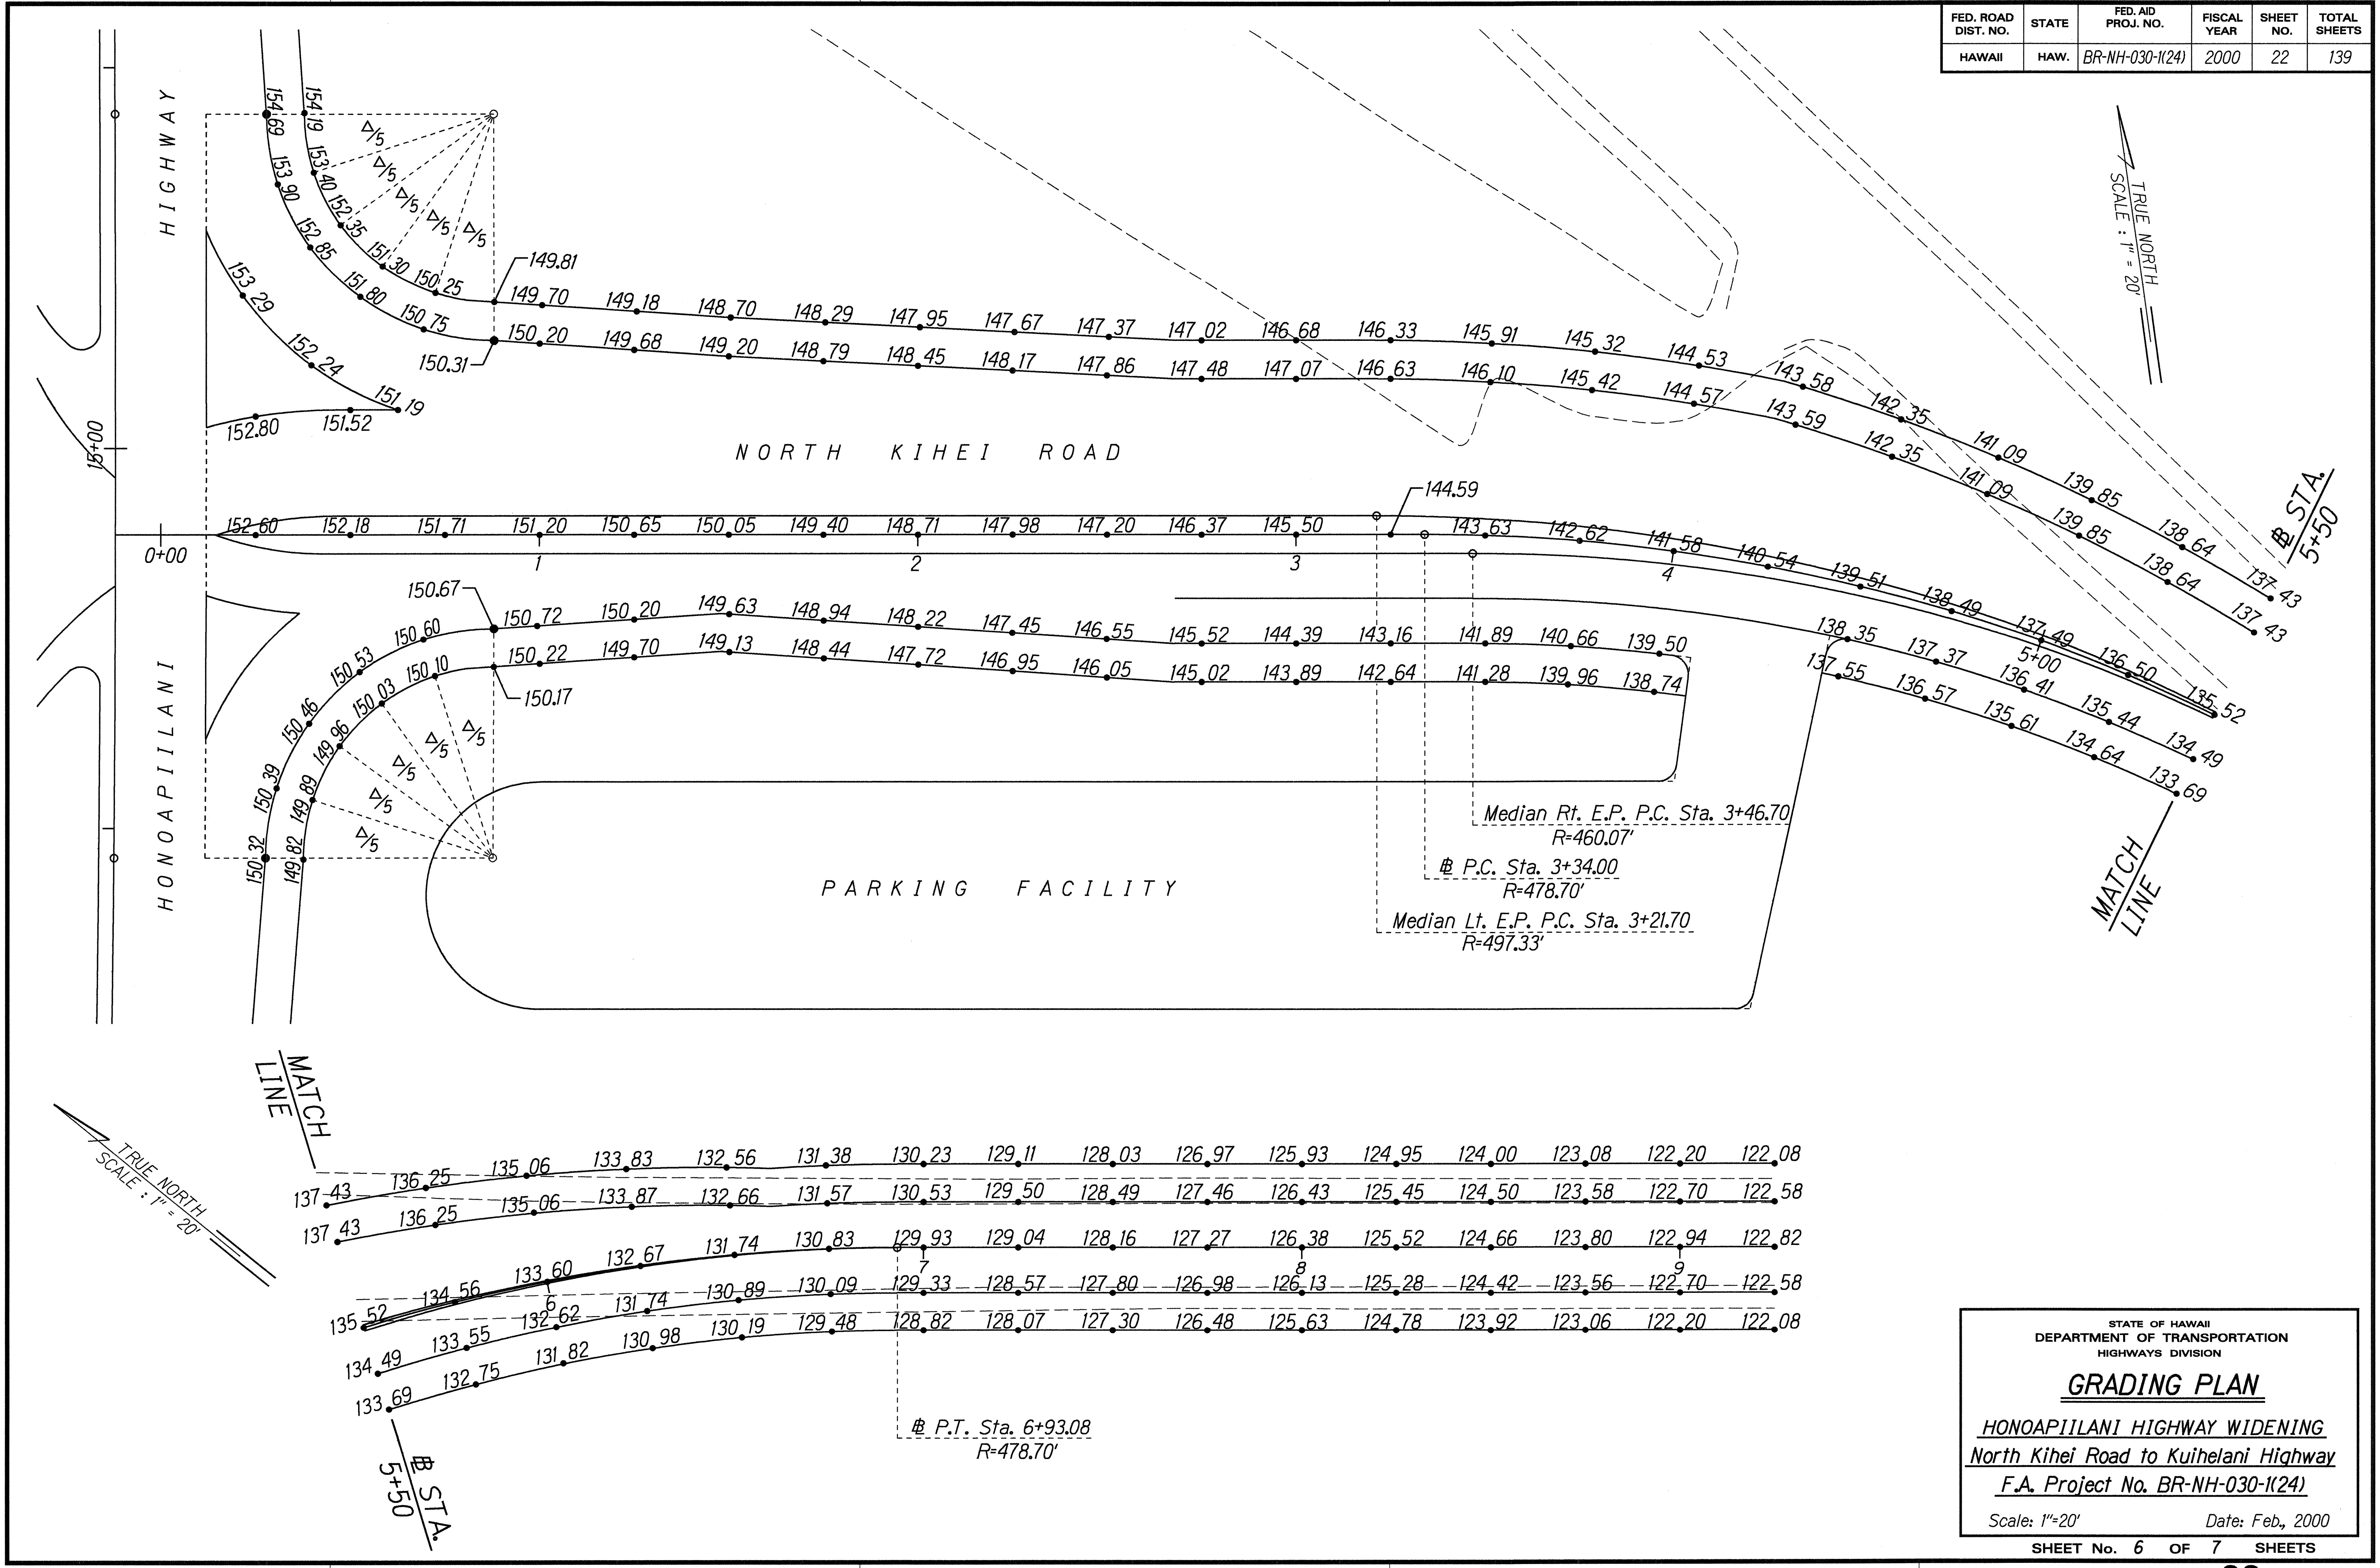

ORIGINAL PLAN	DATE
DRAWN BY: J. Matsunaga	12-26-99
DESIGNED BY: K. J. Salsburgh	
CHECKED BY: N. Bhongir6	

STATE OF HAWAII
DEPARTMENT OF TRANSPORTATION
HIGHWAYS DIVISION


GRADING PLAN

HONOAPIILANI HIGHWAY WIDENING
North Kihei Road to Kuihelani Highway
F.A. Project No. BR-NH-030-K(24)

Scale: 1"=20' Date: Feb., 2000

SHEET No. 6 OF 7 SHEETS

FED. ROAD DIST. NO.	STATE	FED. AID PROJ. NO.	FISCAL YEAR	SHEET NO.	TOTAL SHEETS
HAWAII	HAW.	BR-NH-030-1(24)	2000	23	139

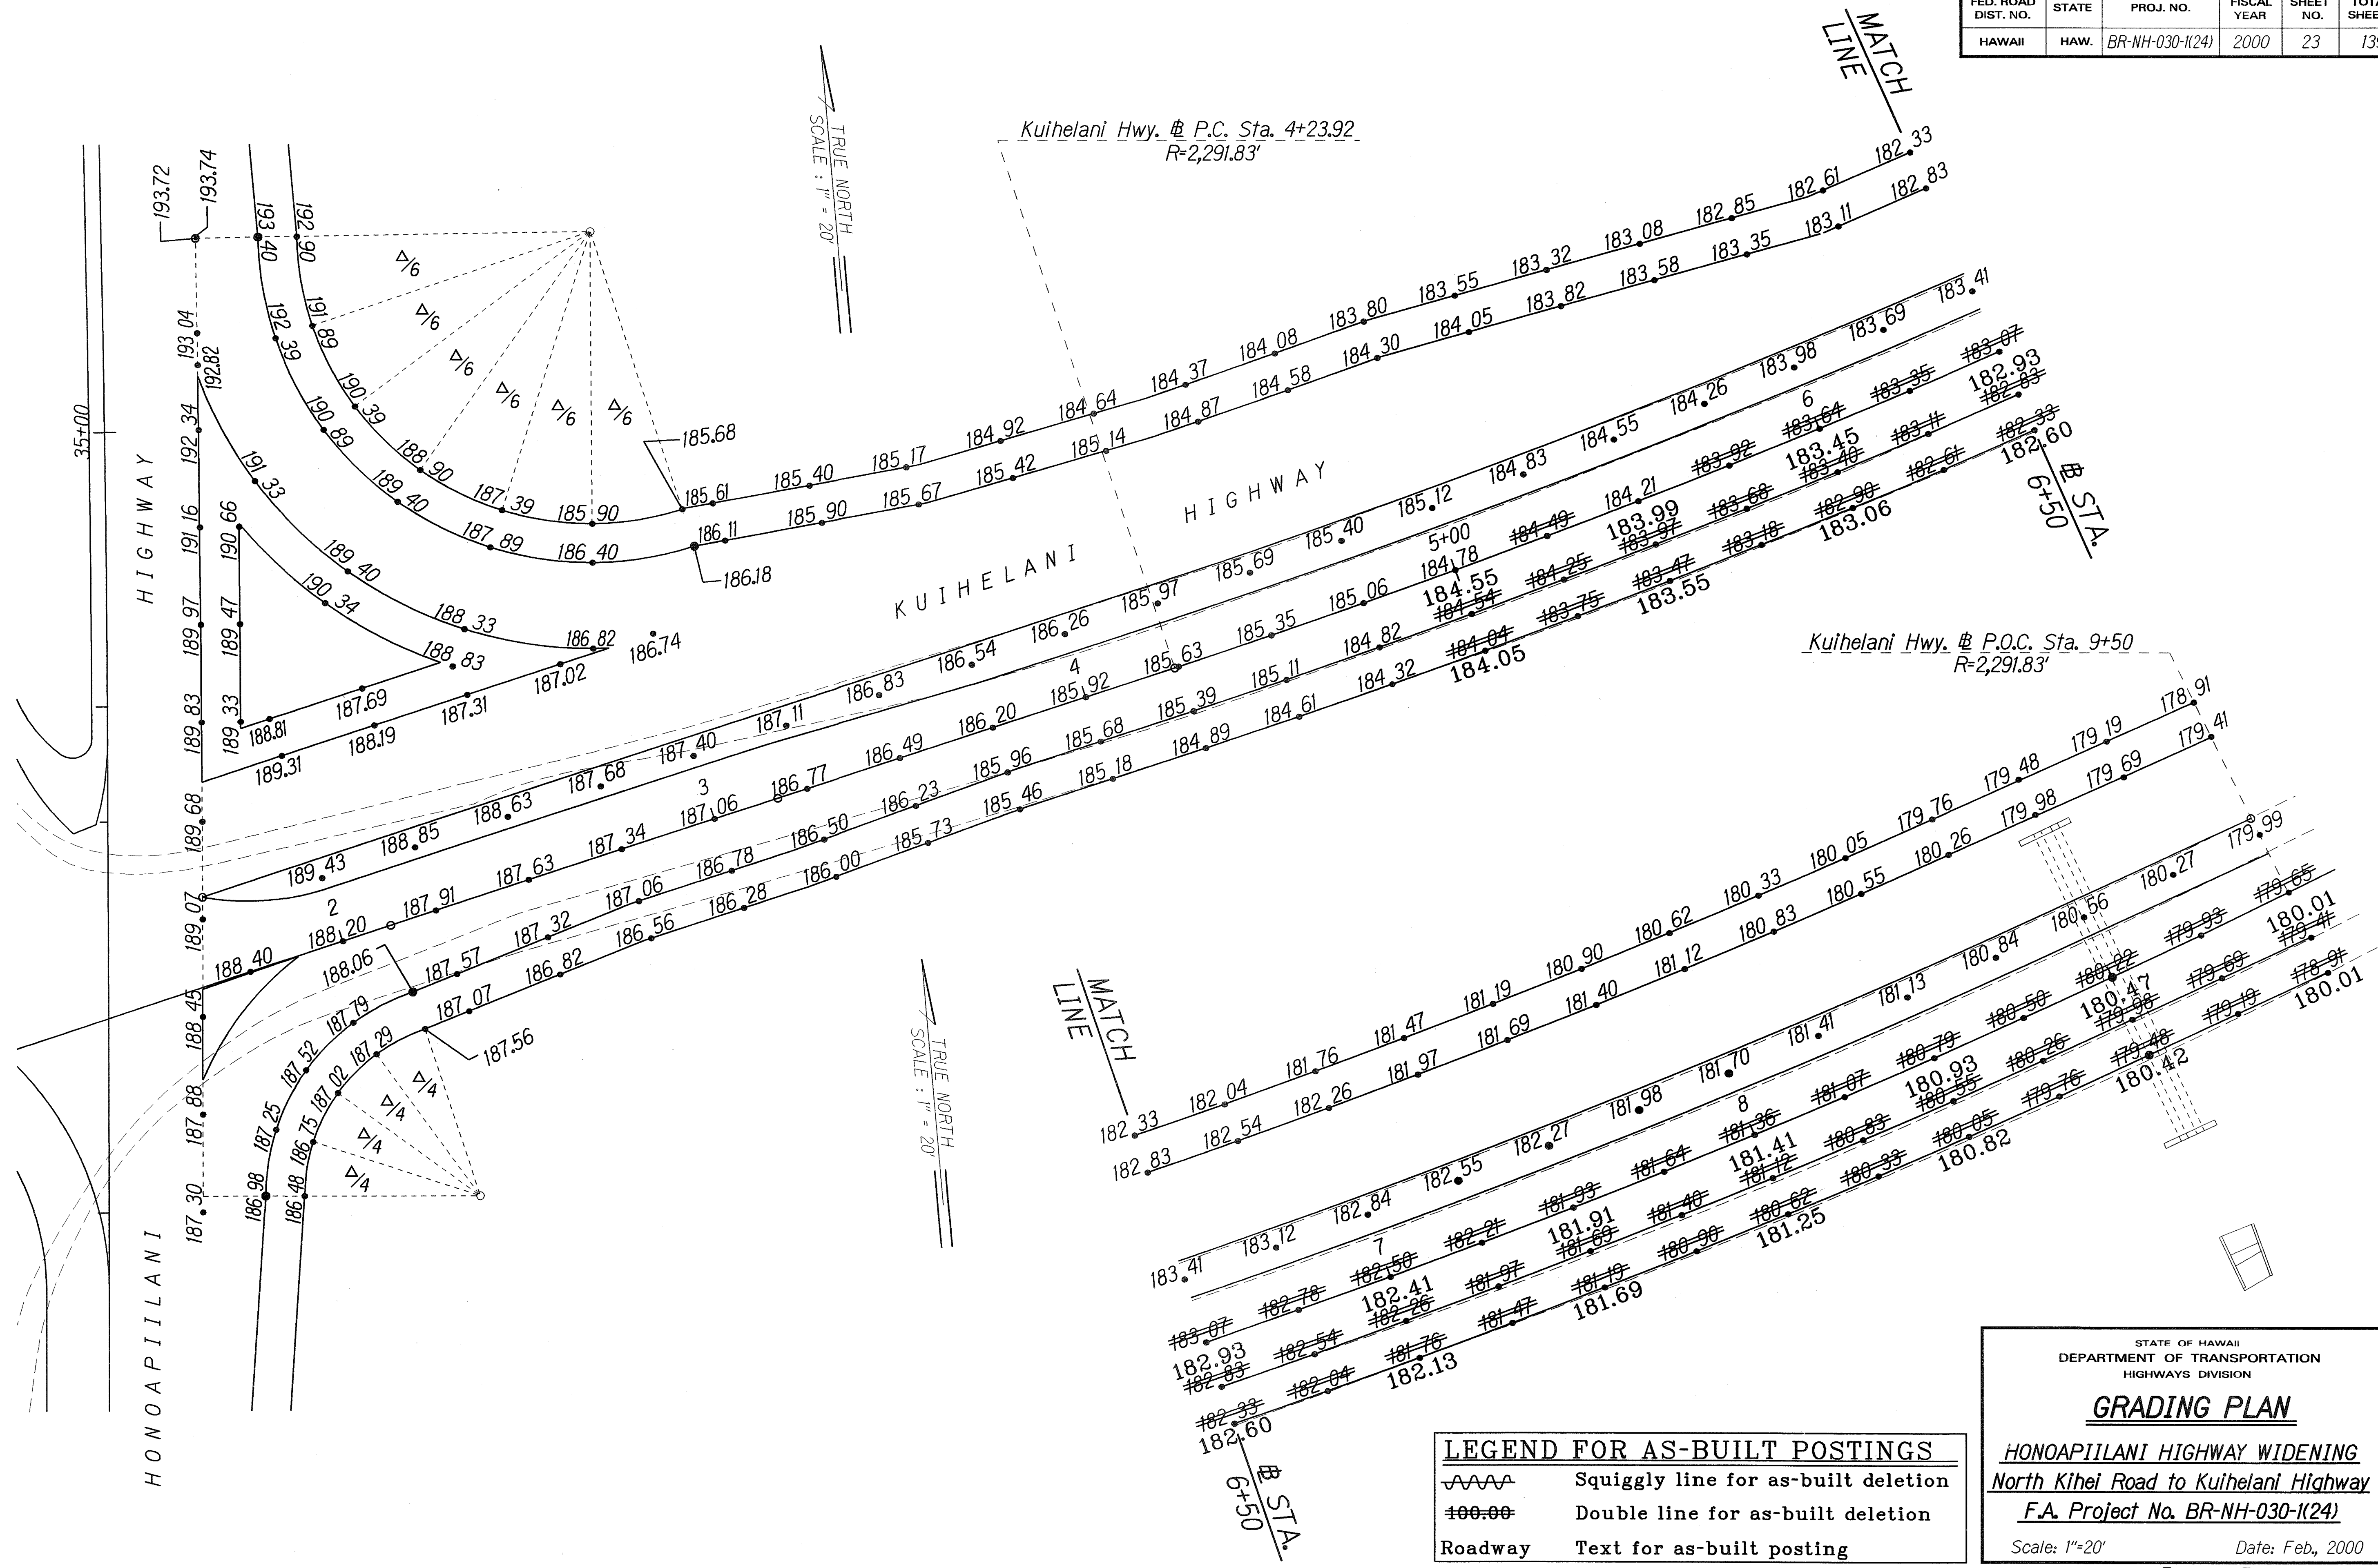

ORIGINAL PLAN	SURVEY PLOTTED BY	DATE
PLAN	DRAWN BY	10-12-99
NOTE BOOK	DESIGNED BY	
QUANTITIES BY	CHECKED BY	
NOTED BY		

LEGEND FOR AS-BUILT POSTINGS	
	Squiggly line for as-built deletion
	Double line for as-built deletion
Roadway	Text for as-built posting

STATE OF HAWAII
DEPARTMENT OF TRANSPORTATION
HIGHWAYS DIVISION

GRADING PLAN

HONOAPIILANI HIGHWAY WIDENING
North Kihel Road to Kihelani Highway
F.A. Project No. BR-NH-030-1(24)

Scale: 1"=20' Date: Feb., 2000

SHEET No. 7 OF 7 SHEETS