


FED. ROAD DIST. NO.	STATE	FED. AID PROJ. NO.	FISCAL YEAR	SHEET NO.	TOTAL SHEETS
HAWAII	HAW.	BR-NH-030-1(24)	2000	42	139

TRUE NORTH
SCALE: 1" = 10'

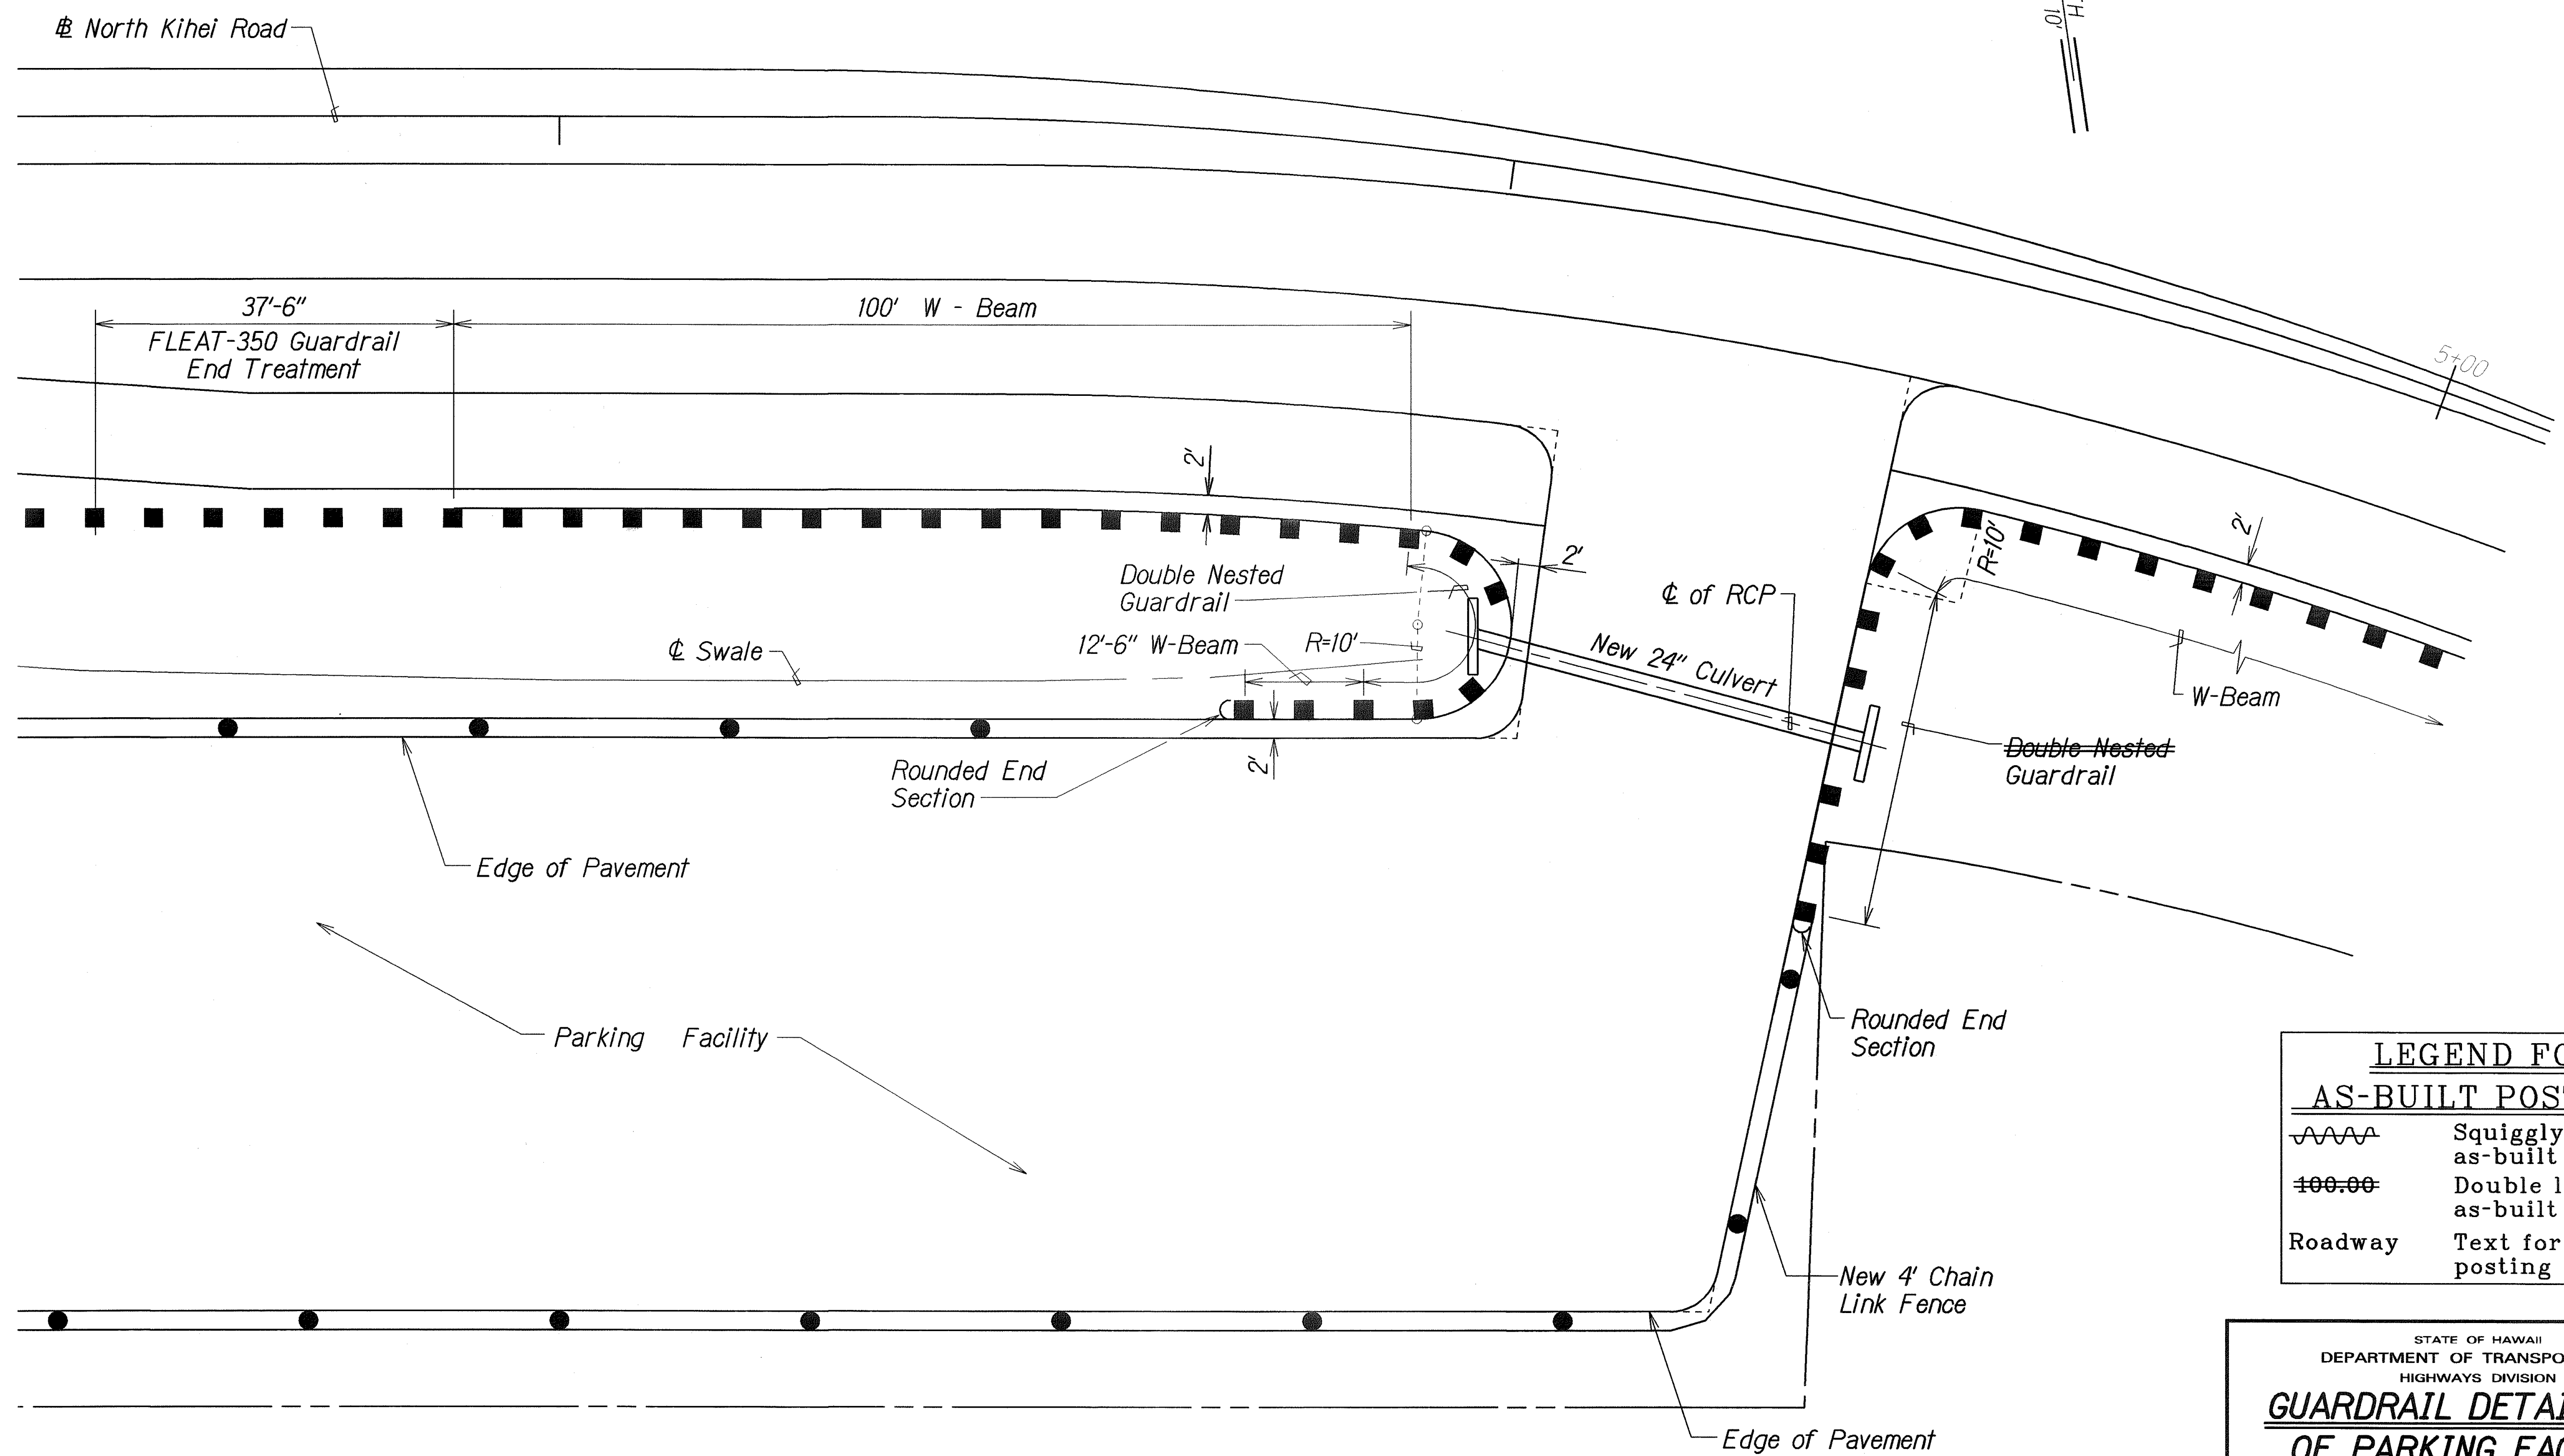

LEGEND FOR AS-BUILT POSTINGS	
	Squiggly line for as-built deletion
	Double line for as-built deletion
Roadway	Text for as-built posting

STATE OF HAWAII
DEPARTMENT OF TRANSPORTATION
HIGHWAYS DIVISION

**GUARDRAIL DETAIL PLAN
OF PARKING FACILITY**

HONOAPIILANI HIGHWAY WIDENING
North Kihei Road to Kuihelani Highway
F.A. Project No. BR-NH-030-1(24)
Scale: 1"=10' Date: March, 1998

SHEET No. 1 OF 1 SHEETS

ORIGINAL PLAN	DATE
SURVEY PLOTTED BY	12/6/98
DRAWN BY	
DESIGNED BY	
QUANTITIES BY	
CHECKED BY	

"AS-BUILT"