
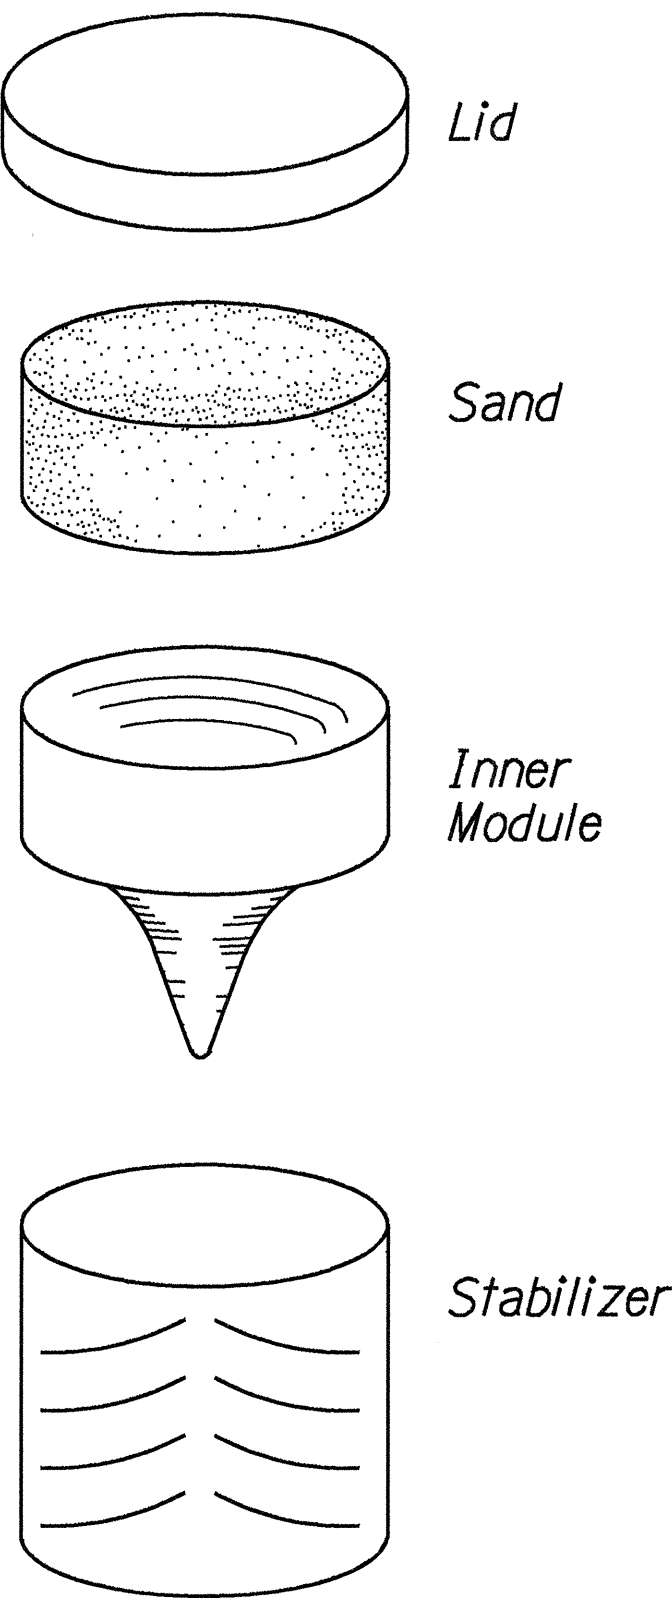


FED. ROAD DIST. NO.	STATE	FED. AID PROJ. NO.	FISCAL YEAR	SHEET NO.	TOTAL SHEETS
HAWAII	HAW.	BR-NH-030-1(24)	2000	48	139

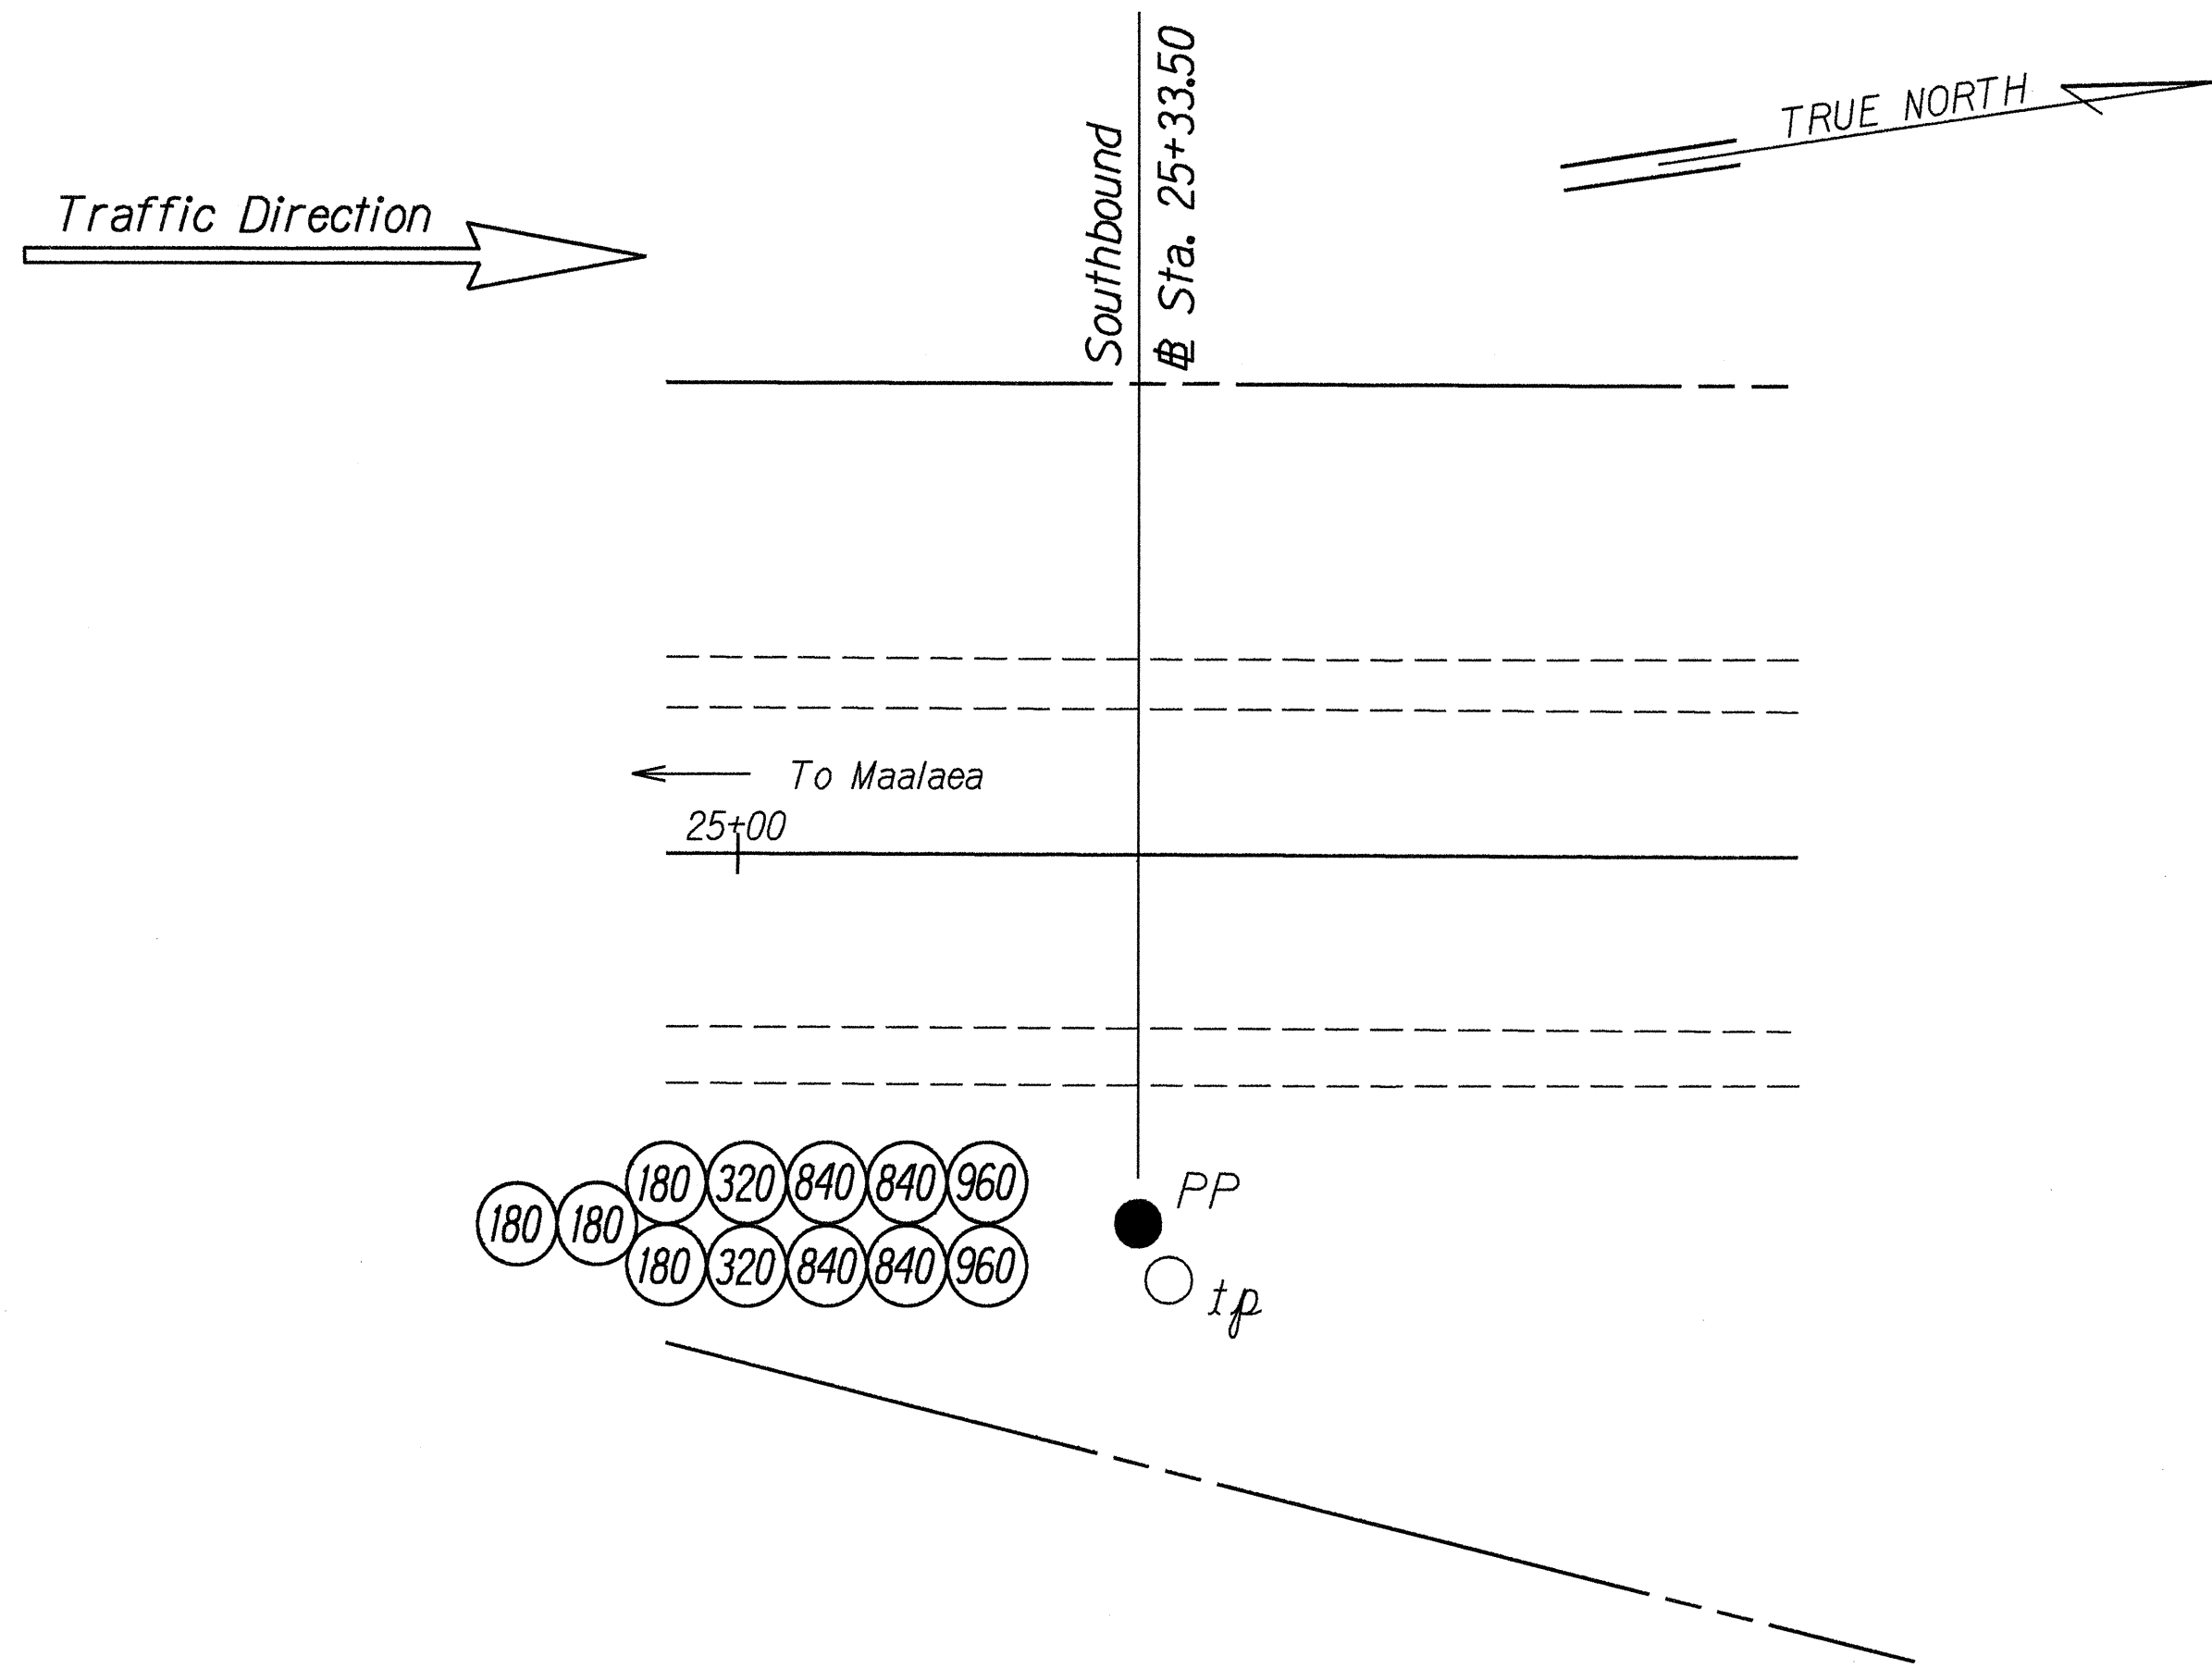

- Notes:
1. Standard size of stabilizer: 36" diameter top, 32" diameter base with 35 3/4" height.
 2. Standard weights of modules are 400, 700, 1400 and 2100 pounds.
 3. Design vehicle weight is 4400 pounds (2000 kg)
 4. Design initial impact speed is 56 m.p.h. (90 km/h)
 5. Payment for relocations of temporary Inertial Barriers for the diferent construction phases shall be incidental to Contract Item Nos. 649.1002,649.1004, 649.1006, and 649.1008, Inertial Barriers Modules 400 lb, 700 lb, 1400 lb, and 2100 lb respectively.

CONTAINER DETAIL
Not to Scale

TEMPORARY CRASH ATTENUATOR FOR
MECO POWER POLES
Not to Scale

ORIGINAL PLAN	SURVEY PLOTTED BY	DATE
NOTE BOOK	DRAWN BY G. Alibucala	14-25-00
10/22/01	TRACED BY H. Ito	
N. Ito	QUANTIFIED BY	
	CHECKED BY	

STATE OF HAWAII
DEPARTMENT OF TRANSPORTATION
HIGHWAYS DIVISION

INERTIAL BARRIER DETAILS

HONOAPIILANI HIGHWAY WIDENING
North Kihei Road to Kuihelani Highway
F.A. Project No. BR-NH-030-1(24)

Date: March, 2000

SHEET No. 1 OF 1 SHEETS