
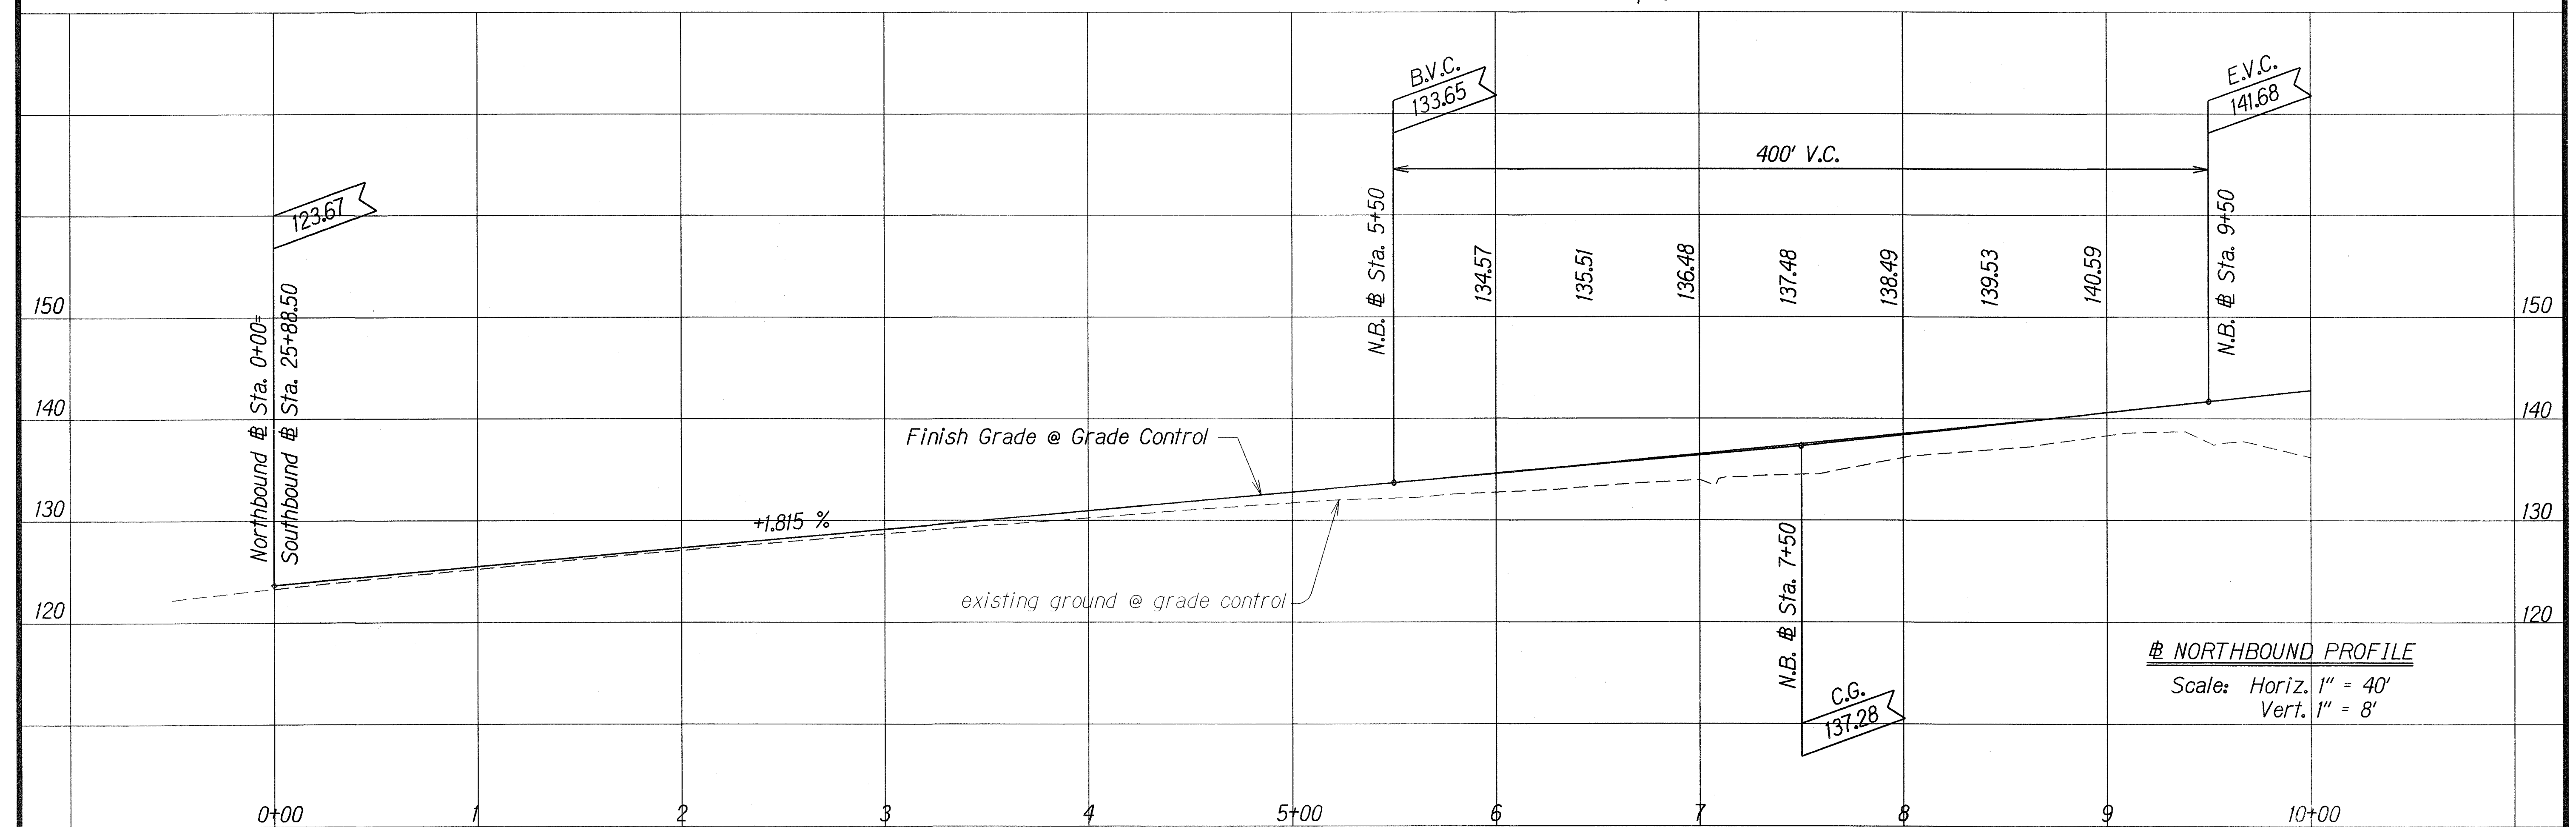


FED. ROAD DIST. NO.	STATE	FED. AID PROJ. NO.	FISCAL YEAR	SHEET NO.	TOTAL SHEETS
HAWAII	HAW.	BR-NH-030-1124)	2000	8	139

CURVE DATA		
CURVE	NB-1	NB-2
Δ	3°48'11.8"	4°05'41.8"
R	7,639.44	11,459.16
T	253.64	409.67
C	507.01	818.82
L_c	507.10	818.99



LEGEND FOR AS-BUILT POSTINGS	
	Squiggly line for as-built deletion
	Double line for as-built deletion
Roadway	Text for as-built posting

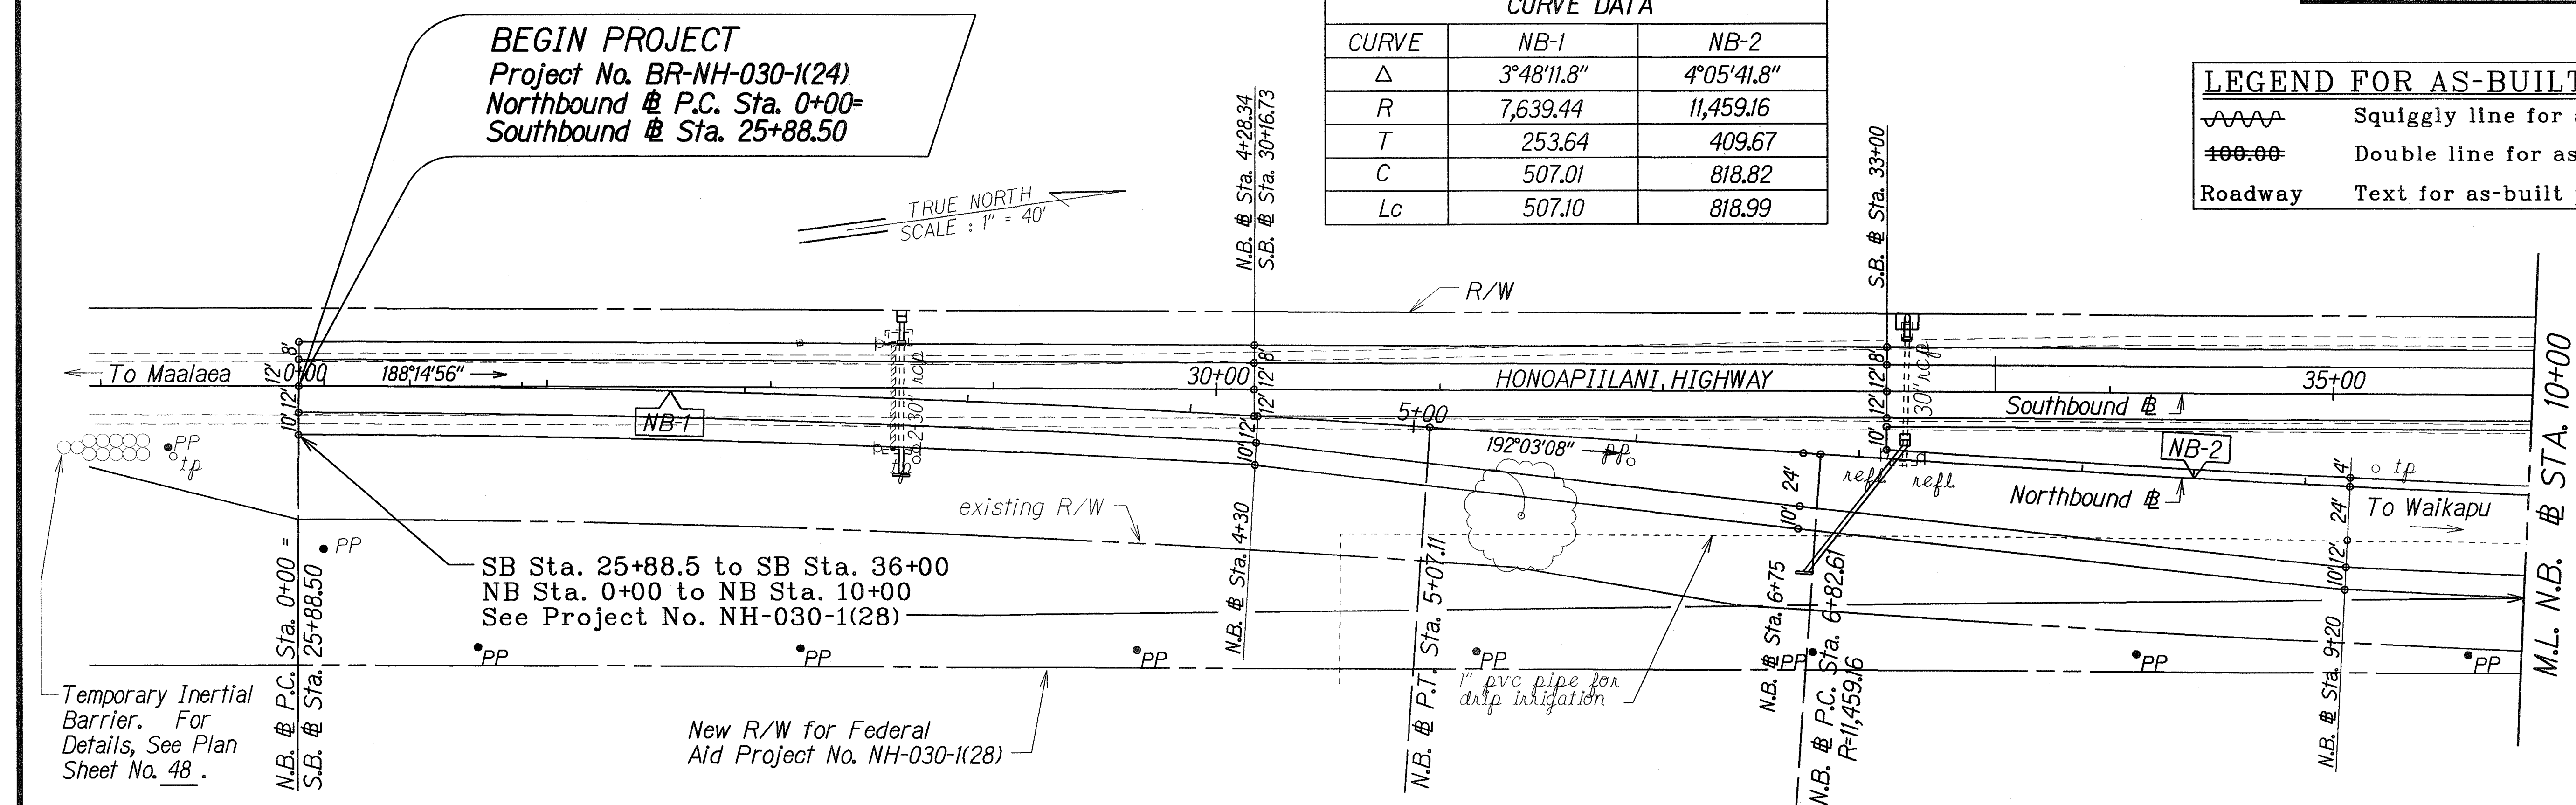

"AS-BUILT"


CURVE DATA			
CURVE	NB-2	NB-3	SB-1
Δ	4°05'41.8"	3°12'30"	6°29'45"
R	11,459.16	34,431.30	34,377.50
T	409.67	964.26	1,950.84
C	818.82	1,927.77	3,895.42
Lc	818.99	1,928.02	3,897.50

FED. ROAD DIST. NO.	STATE	FED. AID PROJ. NO.	FISCAL YEAR	SHEET NO.	TOTAL SHEETS
HAWAII	HAW.	BR-NH-030-1(24)	2000	9	139

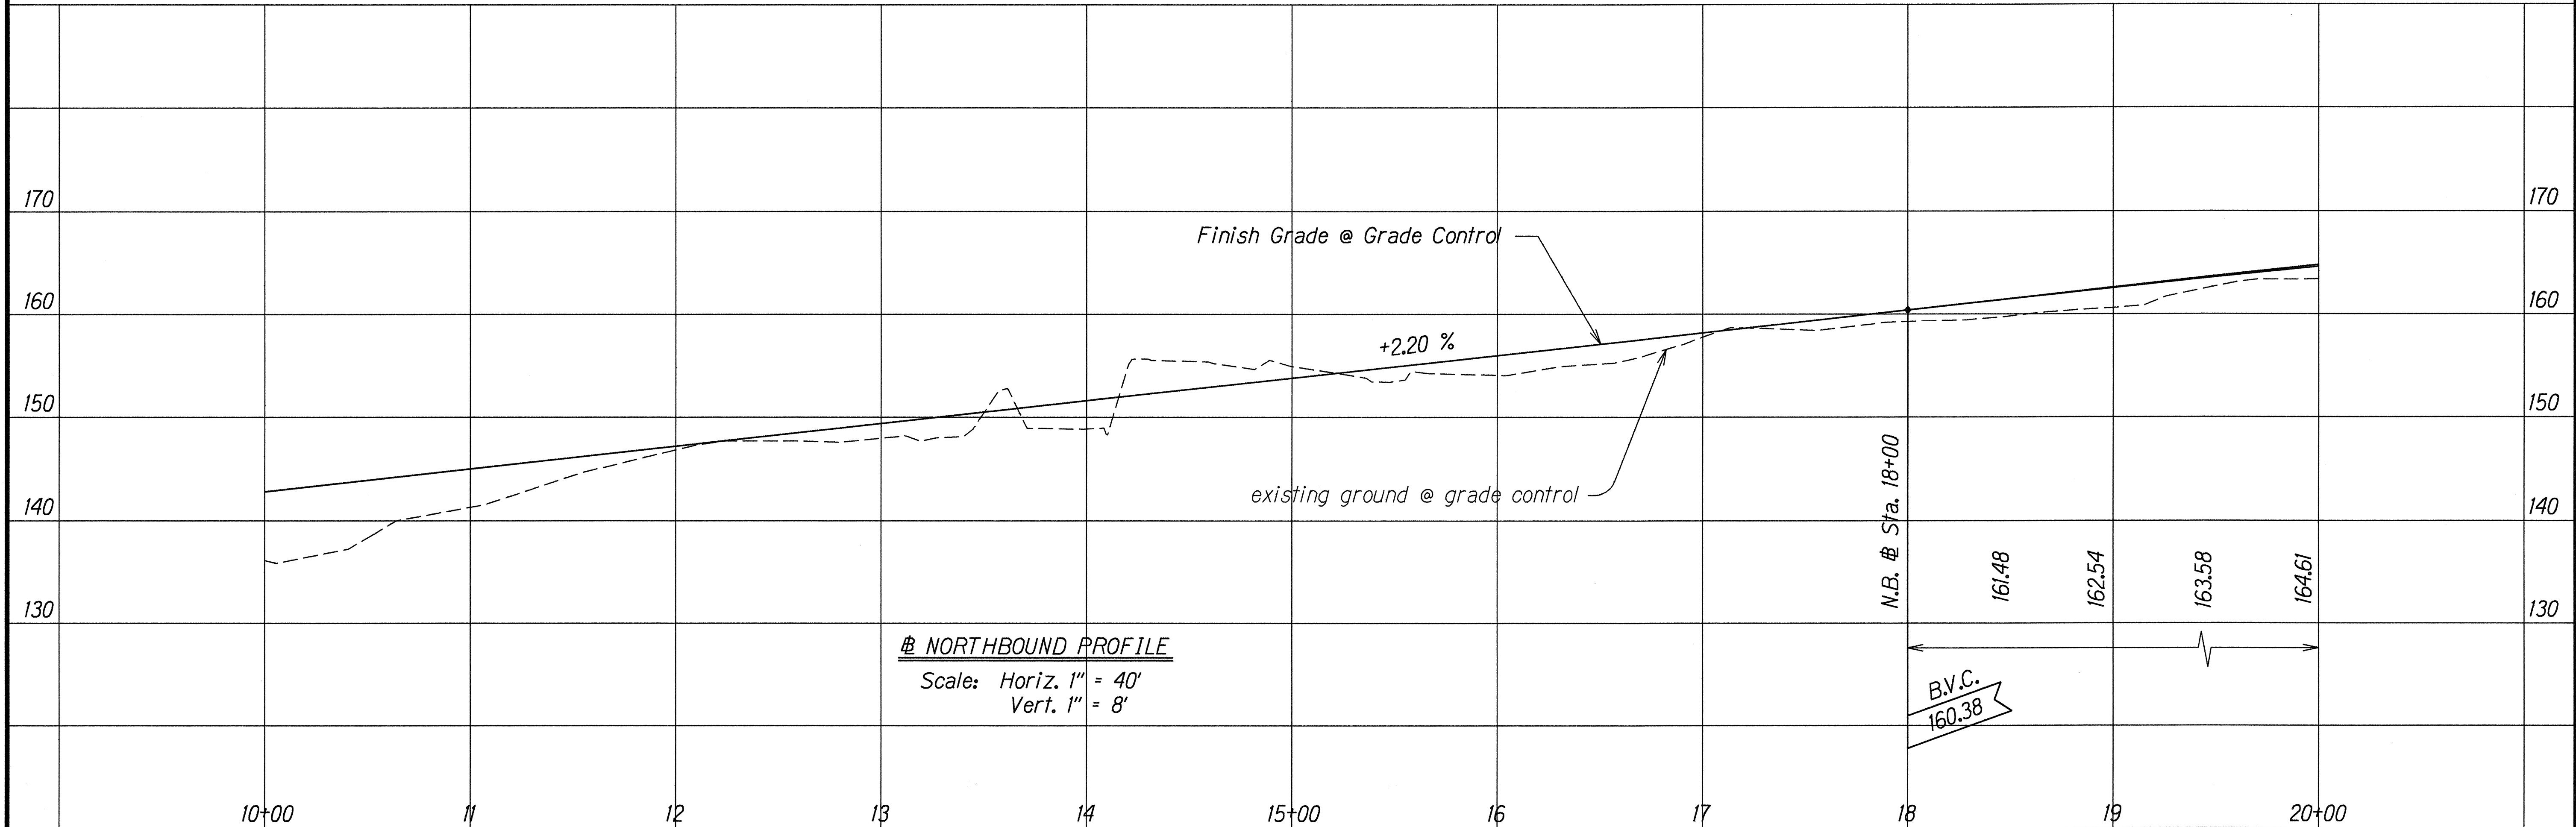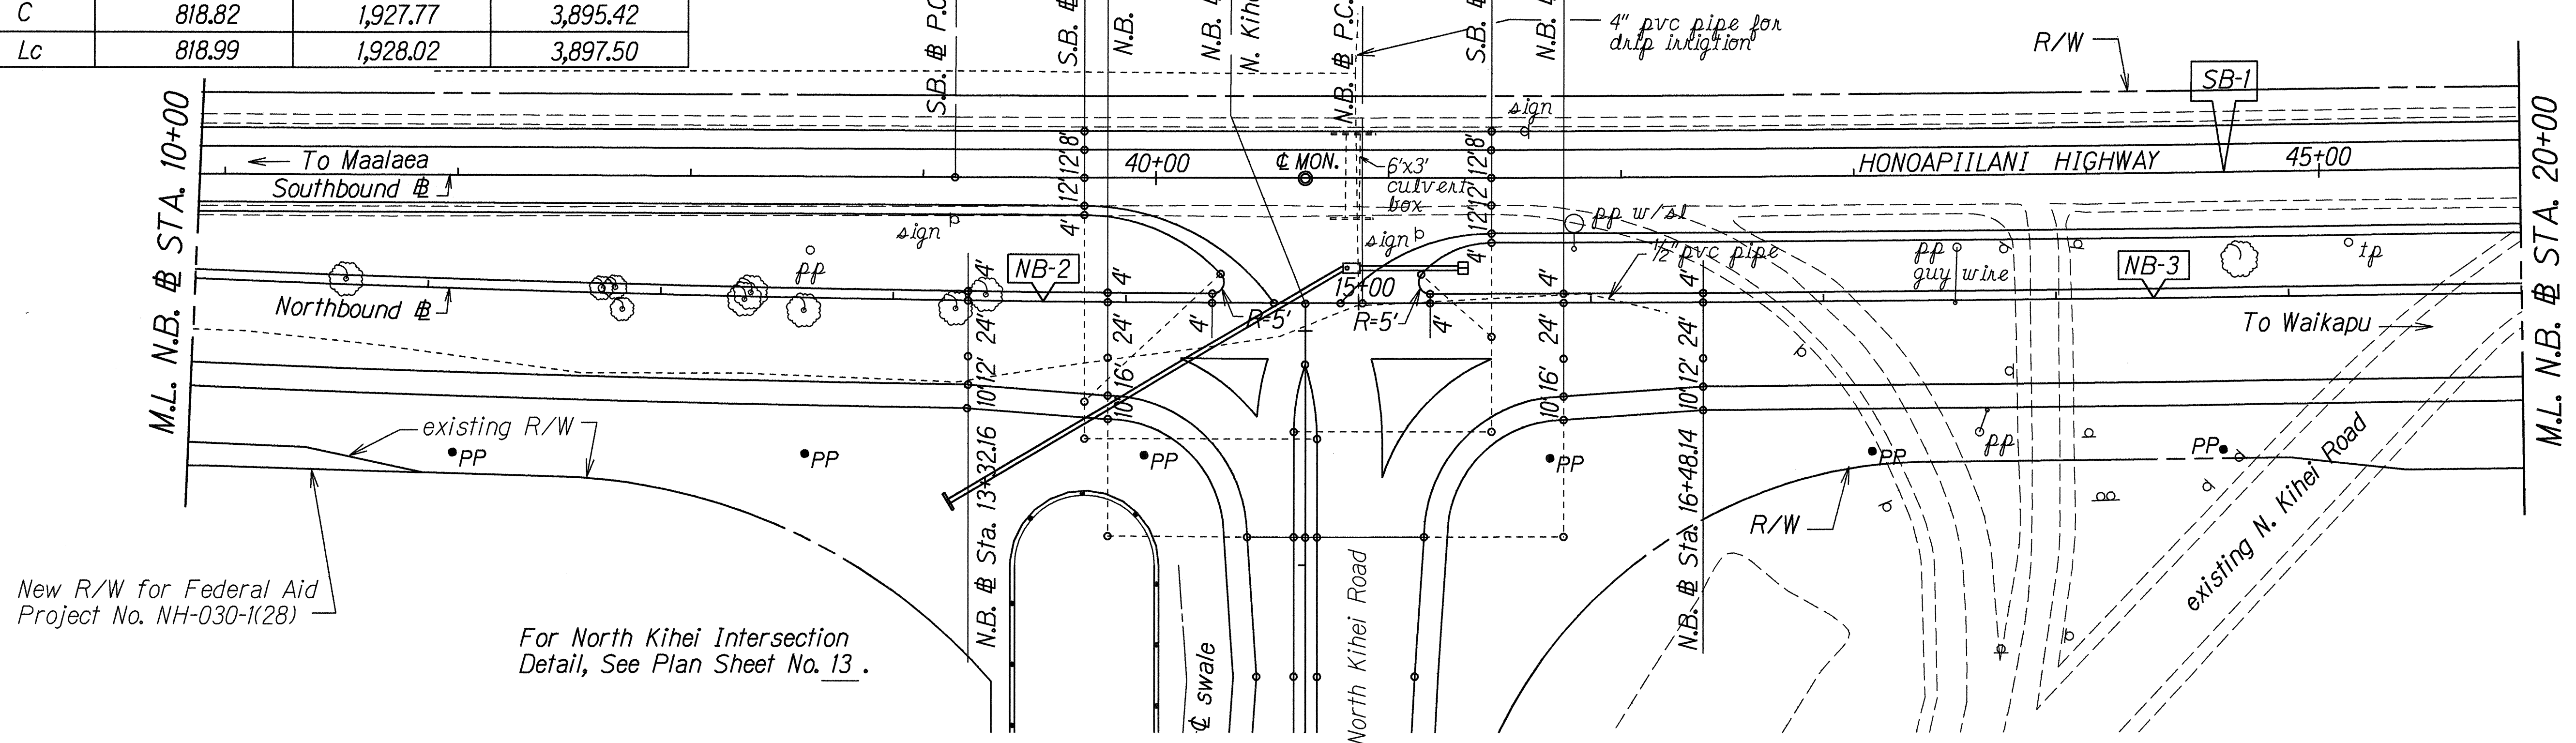


ORIGINAL PLAN	DATE
DRAWN BY K. Imai	10-8-96
CHECKED BY B. Hirose/K. Imai	
NOTED BY	
QUANTITIES BY	
CHECKED BY	

FED. ROAD DIST. NO.	STATE	FED. AID PROJ. NO.	FISCAL YEAR	SHEET NO.	TOTAL SHEETS
HAWAII	HAW.	BR-NH-030-K(24)	2000	10	139

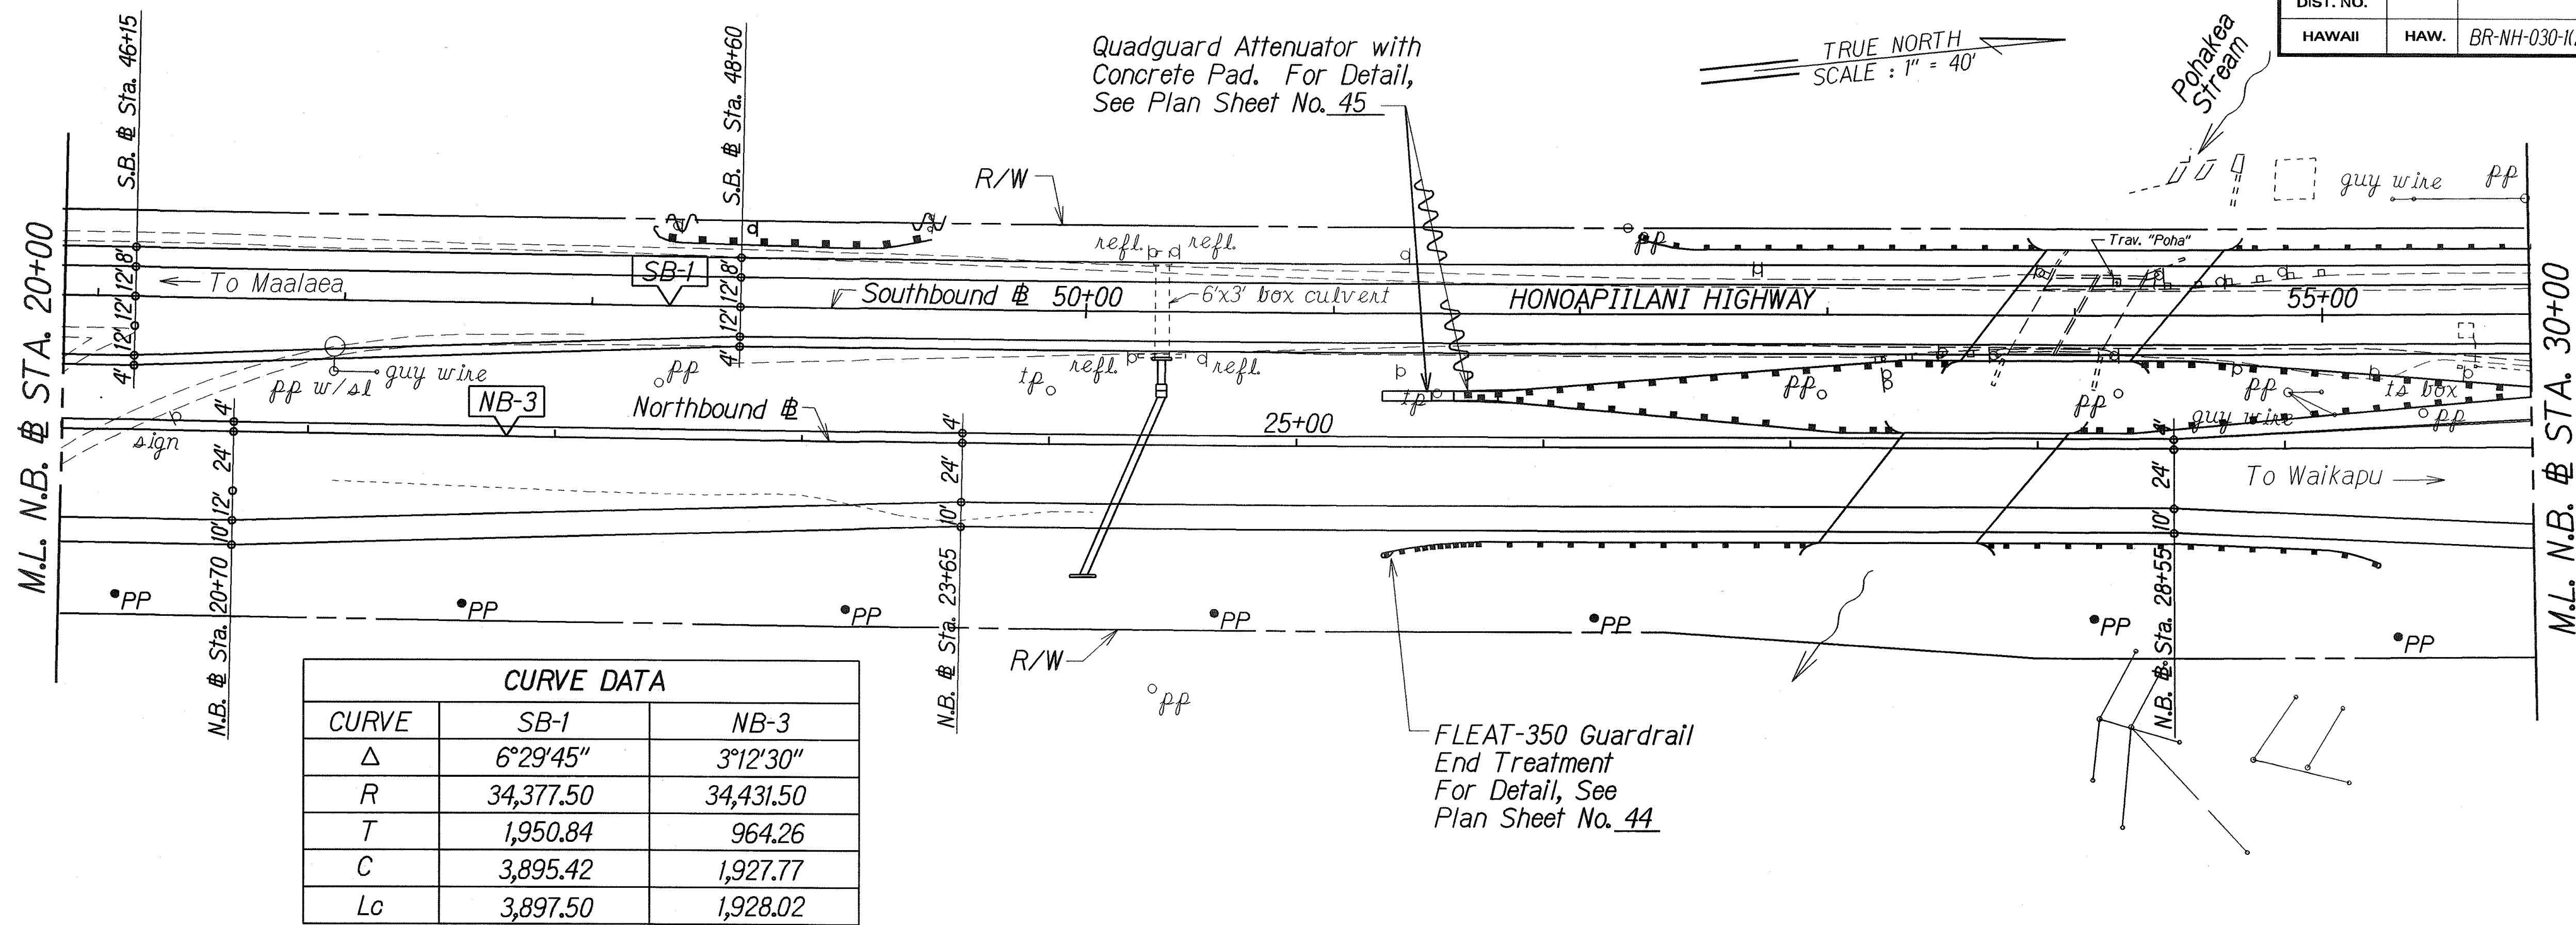

CURVE DATA		
CURVE	SB-1	NB-3
Δ	6°29'45"	3°12'30"
R	34,377.50	34,431.50
T	1,950.84	964.26
C	3,895.42	1,927.77
Lc	3,897.50	1,928.02

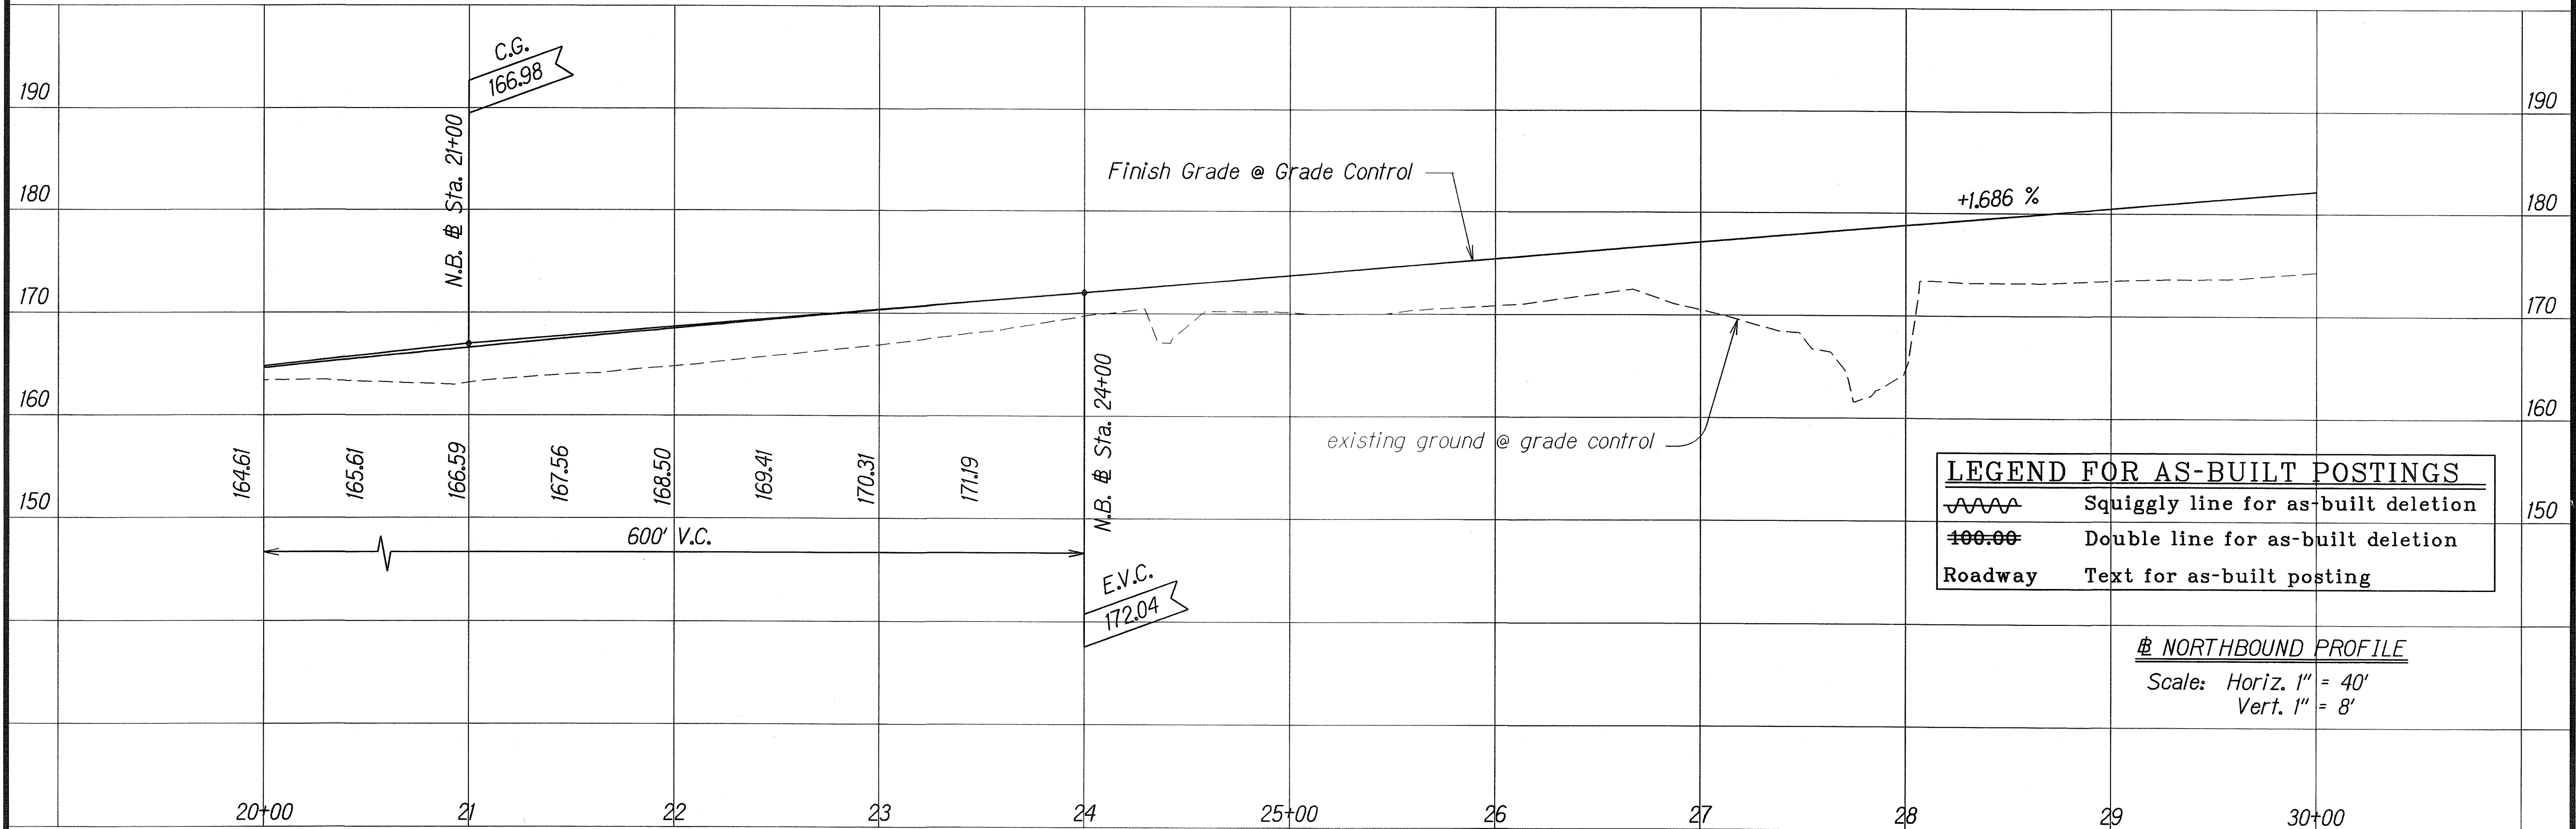

LEGEND FOR AS-BUILT POSTINGS	
	Squiggly line for as-built deletion
	Double line for as-built deletion
Roadway	Text for as-built posting

NORTHBOUND PROFILE
 Scale: Horiz. 1" = 40'
 Vert. 1" = 8'

ORIGINAL SURVEY PLOTTED BY	DATE
DESIGNED BY	
TRACED BY	
NOTE BOOK	
QUANTITIES BY	
CHECKED BY	

