

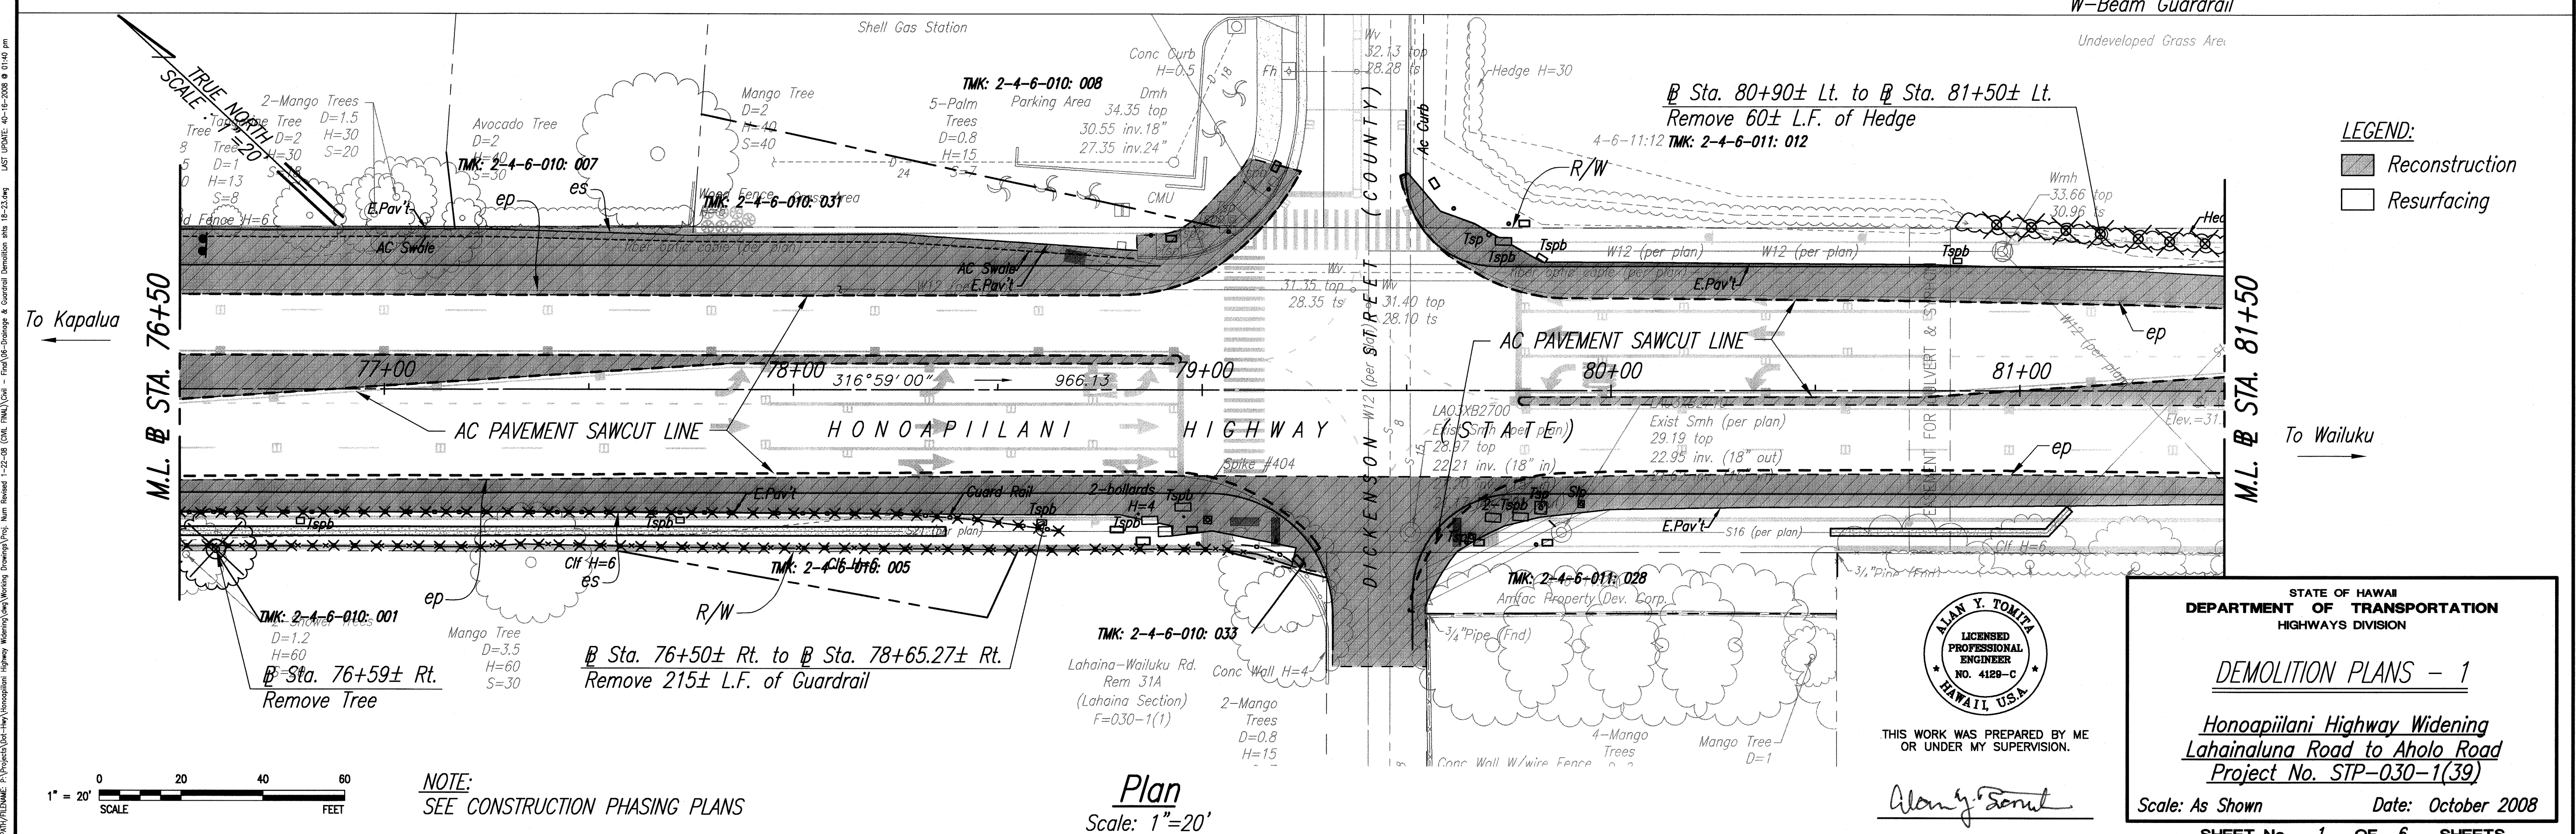
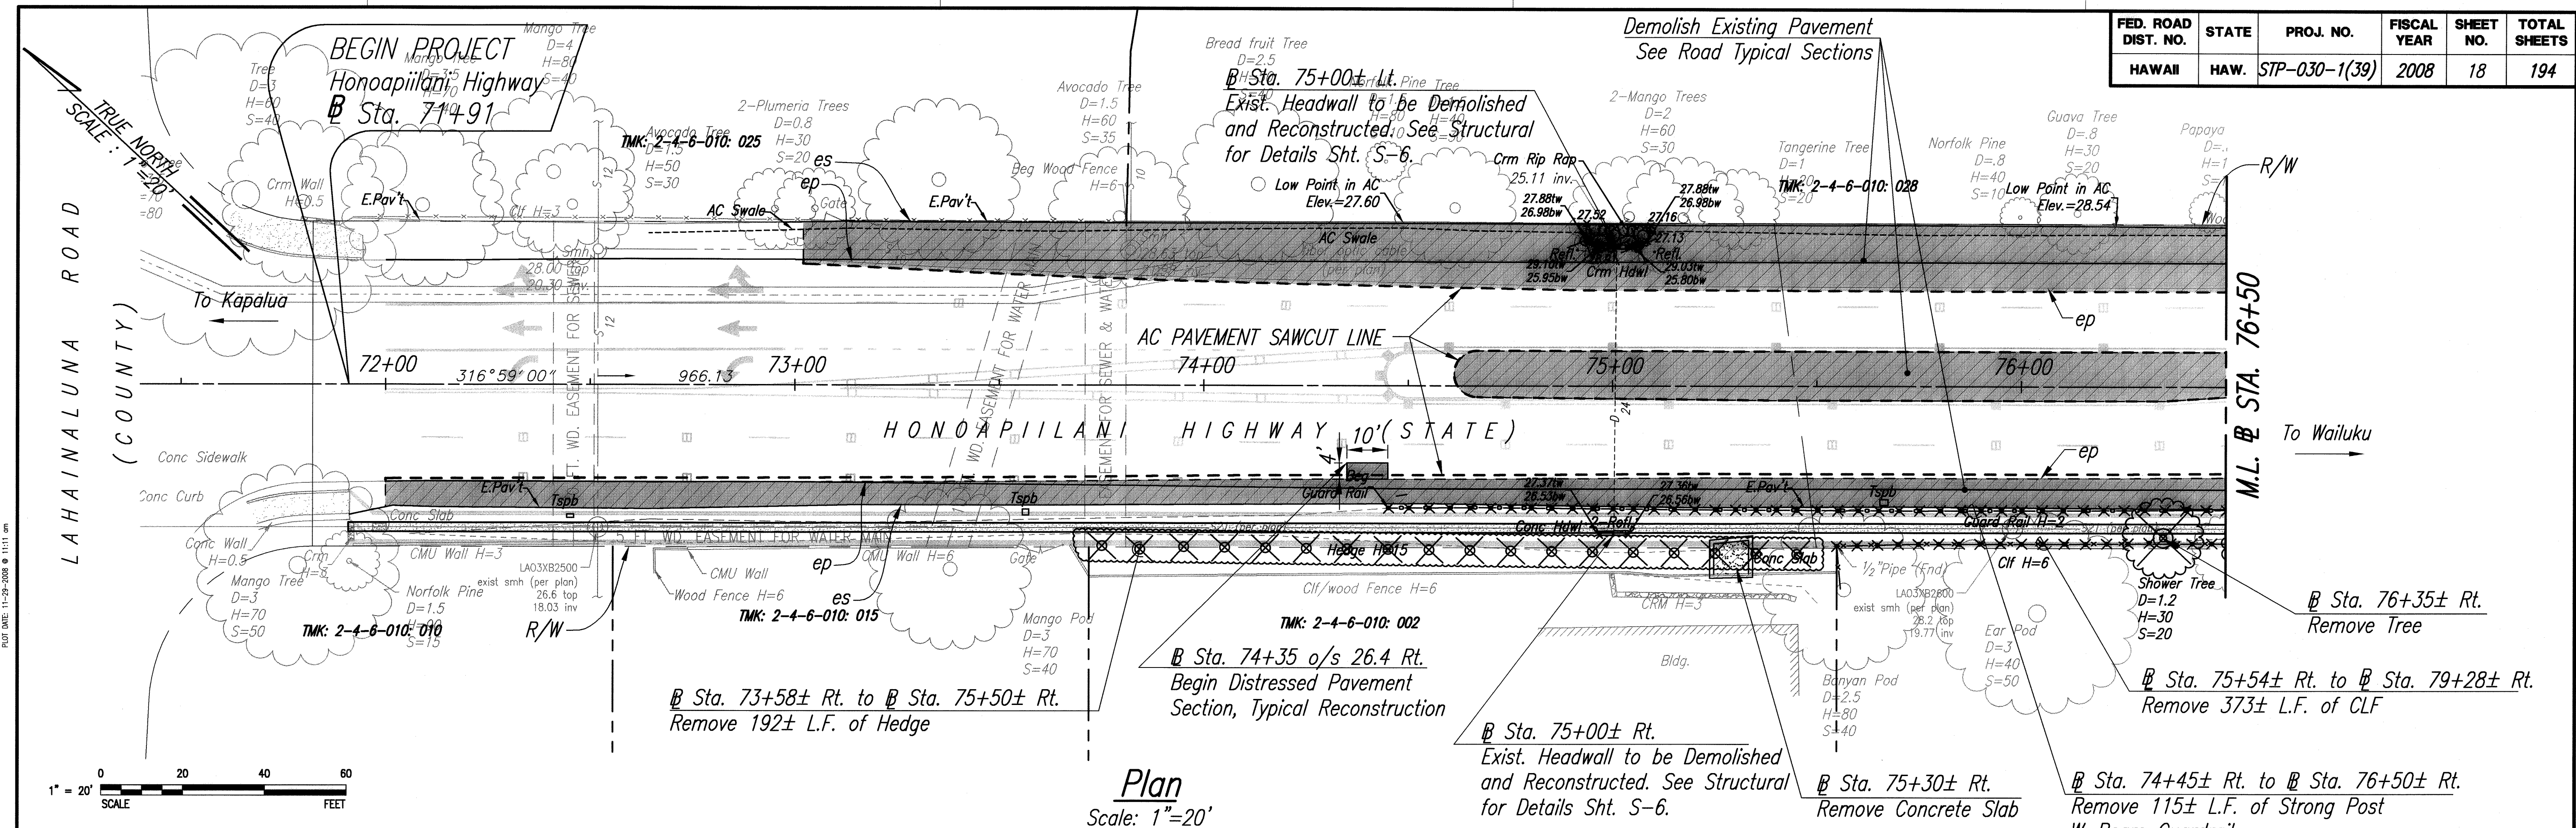



FED. ROAD DIST. NO.	STATE	PROJ. NO.	FISCAL YEAR	SHEET NO.	TOTAL SHEETS
HAWAII	HAW.	STP-030-1(39)	2008	18	194

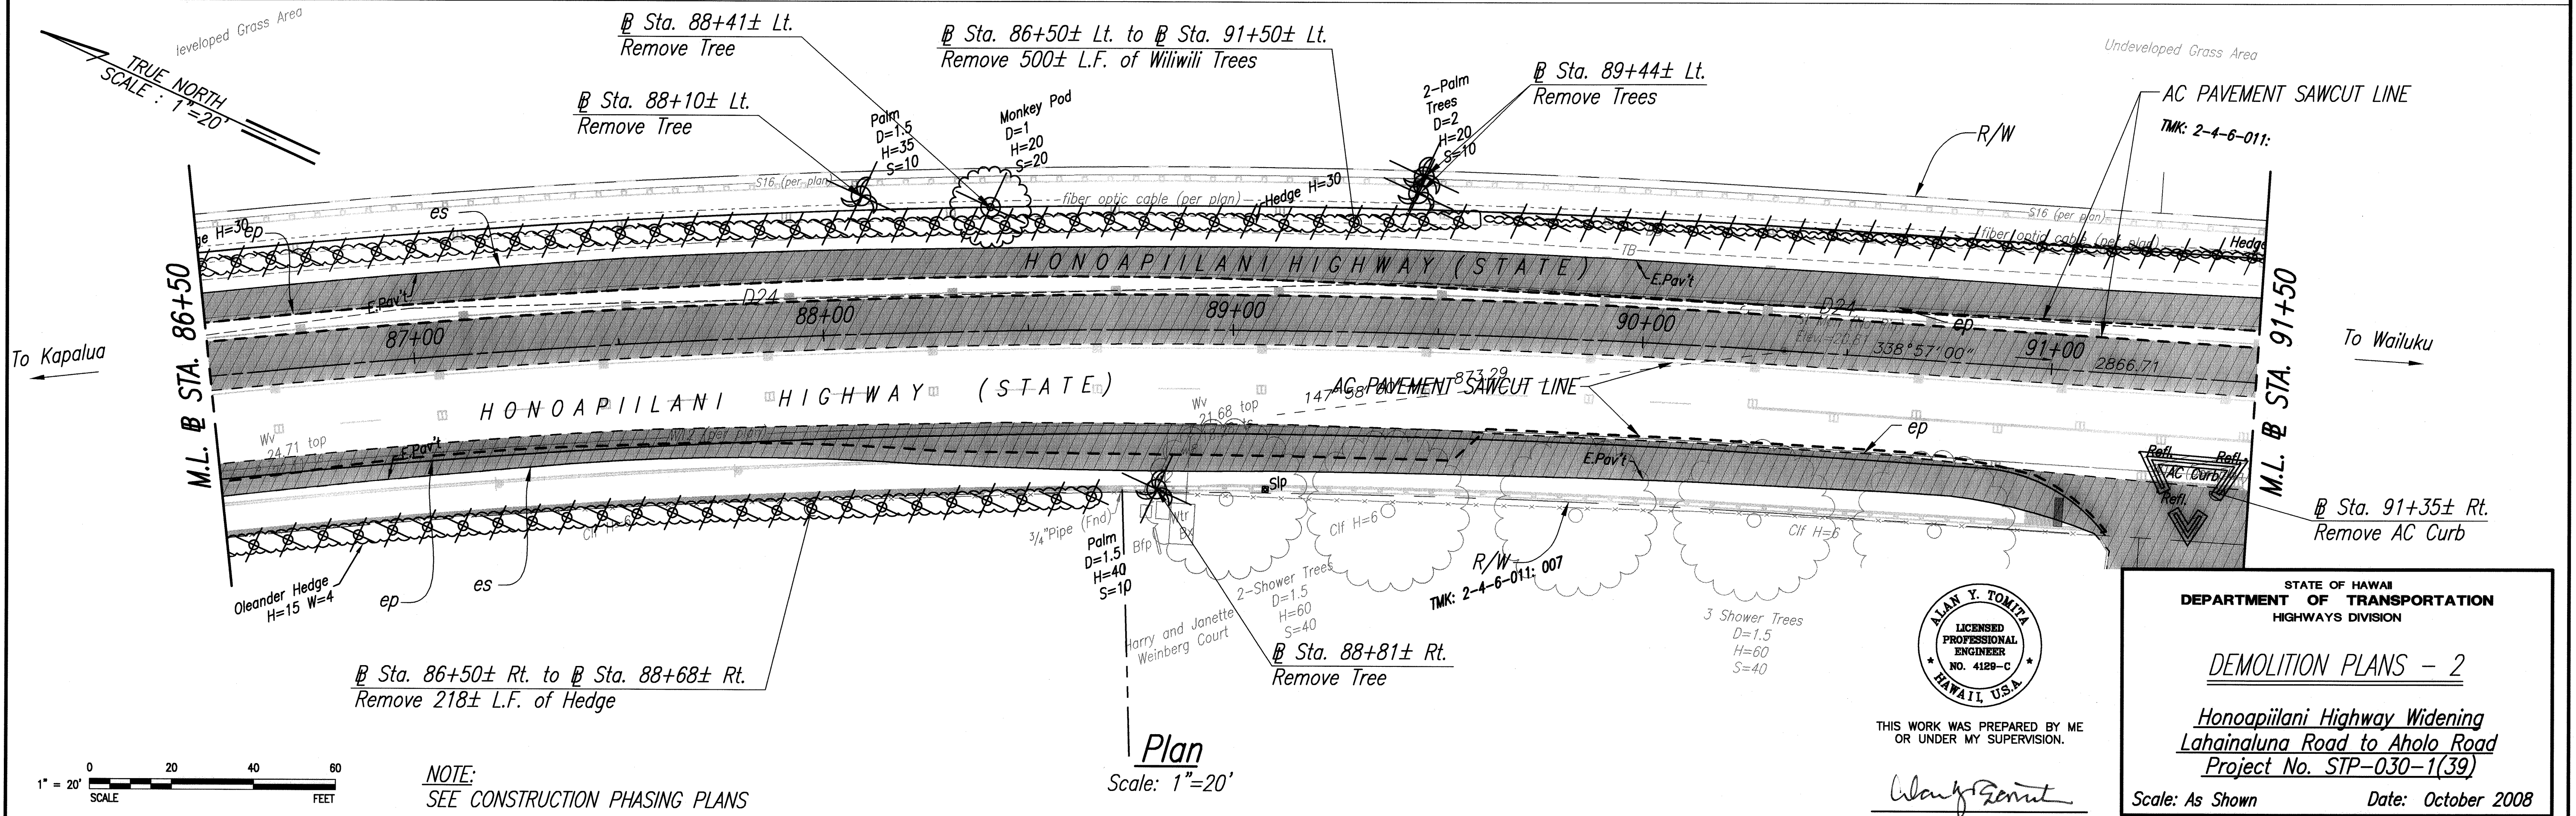

FED. ROAD DIST. NO.	STATE	PROJ. NO.	FISCAL YEAR	SHEET NO.	TOTAL SHEETS
HAWAII	HAW.	STP-030-1(39)	2008	19	194

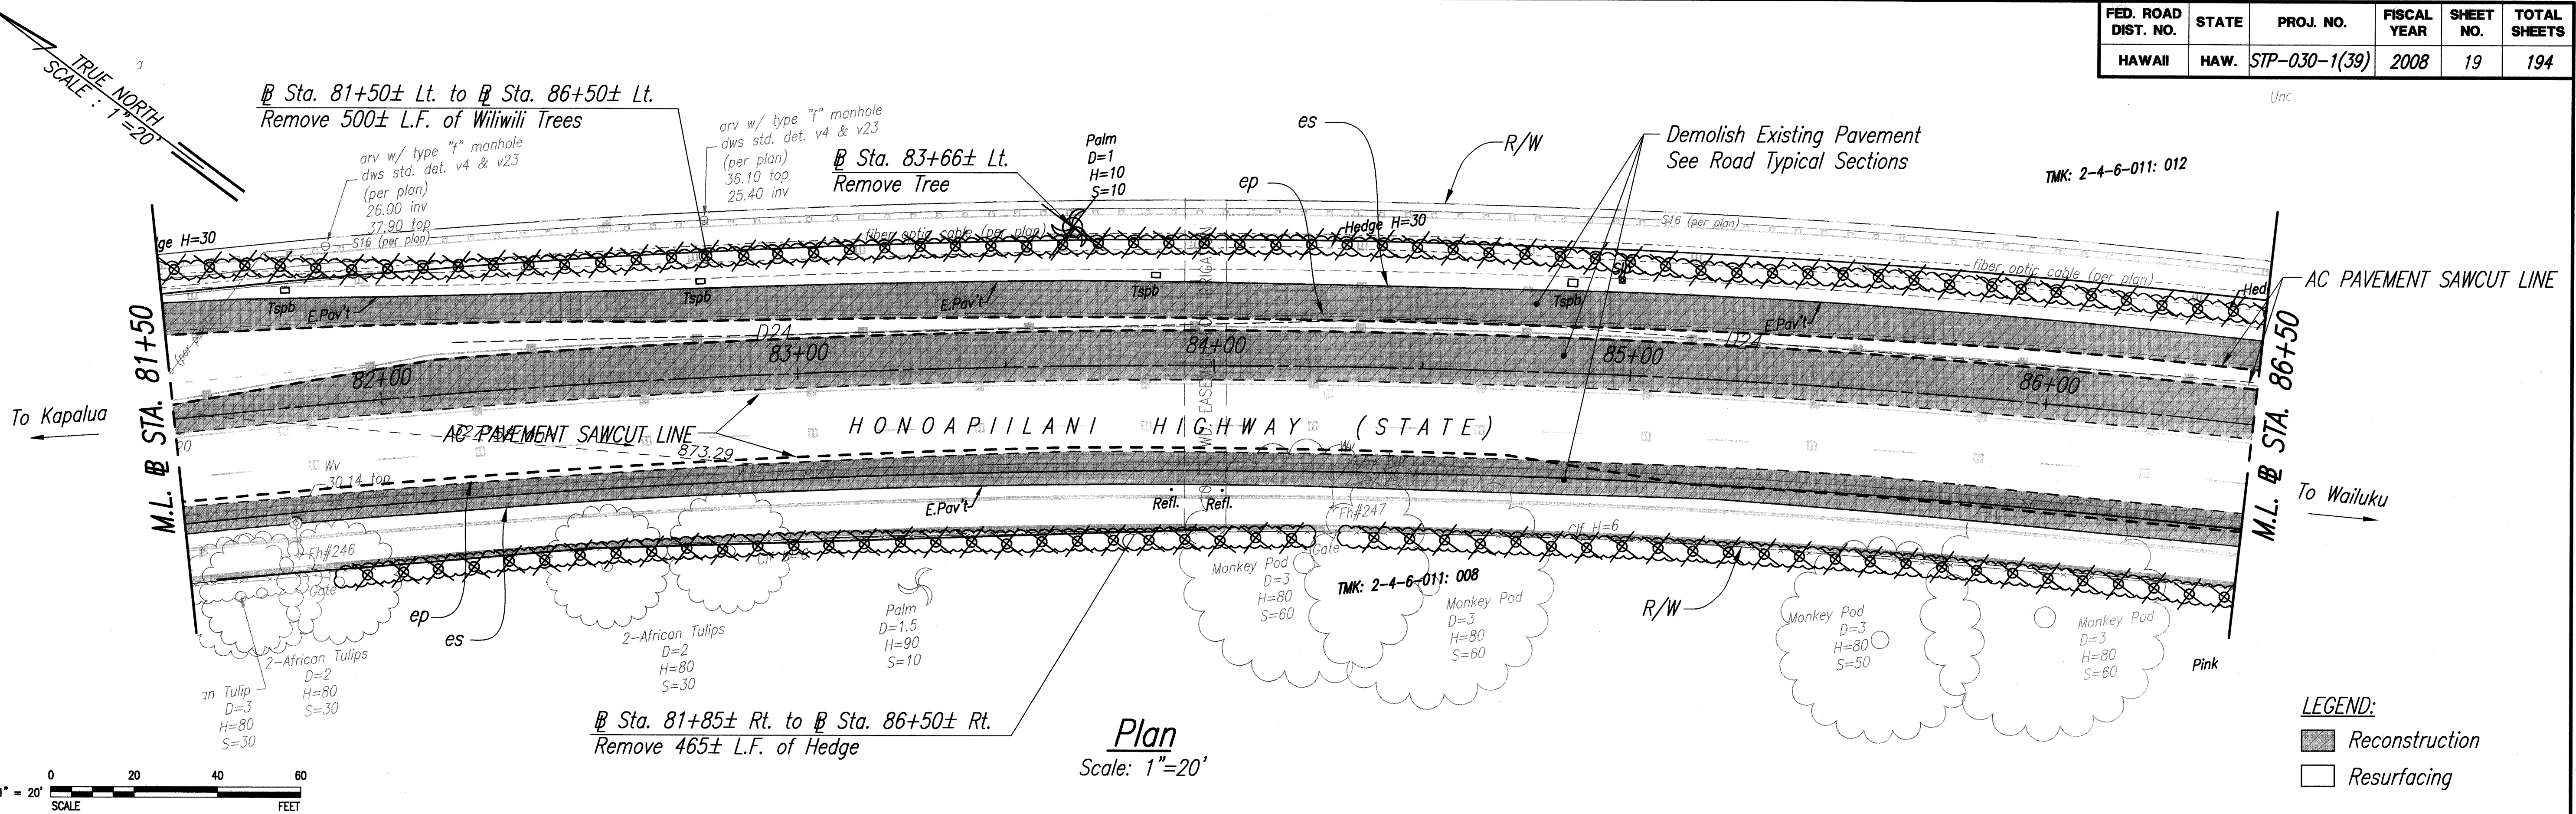

ORIGINAL PLAN	DATE
DRAWN BY	
TRACED BY	
DESIGNED BY	
QUANTITIES BY	
CHECKED BY	
NO.	

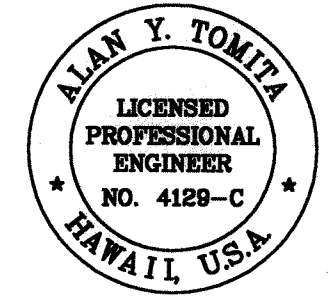

THIS WORK WAS PREPARED BY ME OR UNDER MY SUPERVISION.

Wang Gant

STATE OF HAWAII
DEPARTMENT OF TRANSPORTATION
HIGHWAYS DIVISION



DEMOLITION PLANS - 2

*Honoapiilani Highway Widening
Lahainaluna Road to Aholo Road
Project No. STP-030-1(39)*

Scale: As Shown Date: October 2008

SHEET No. 2 OF 6 SHEETS

FED. ROAD DIST. NO.	STATE	PROJ. NO.	FISCAL YEAR	SHEET NO.	TOTAL SHEETS
HAWAII	HAW.	STP-030-1(39)	2008	20	194

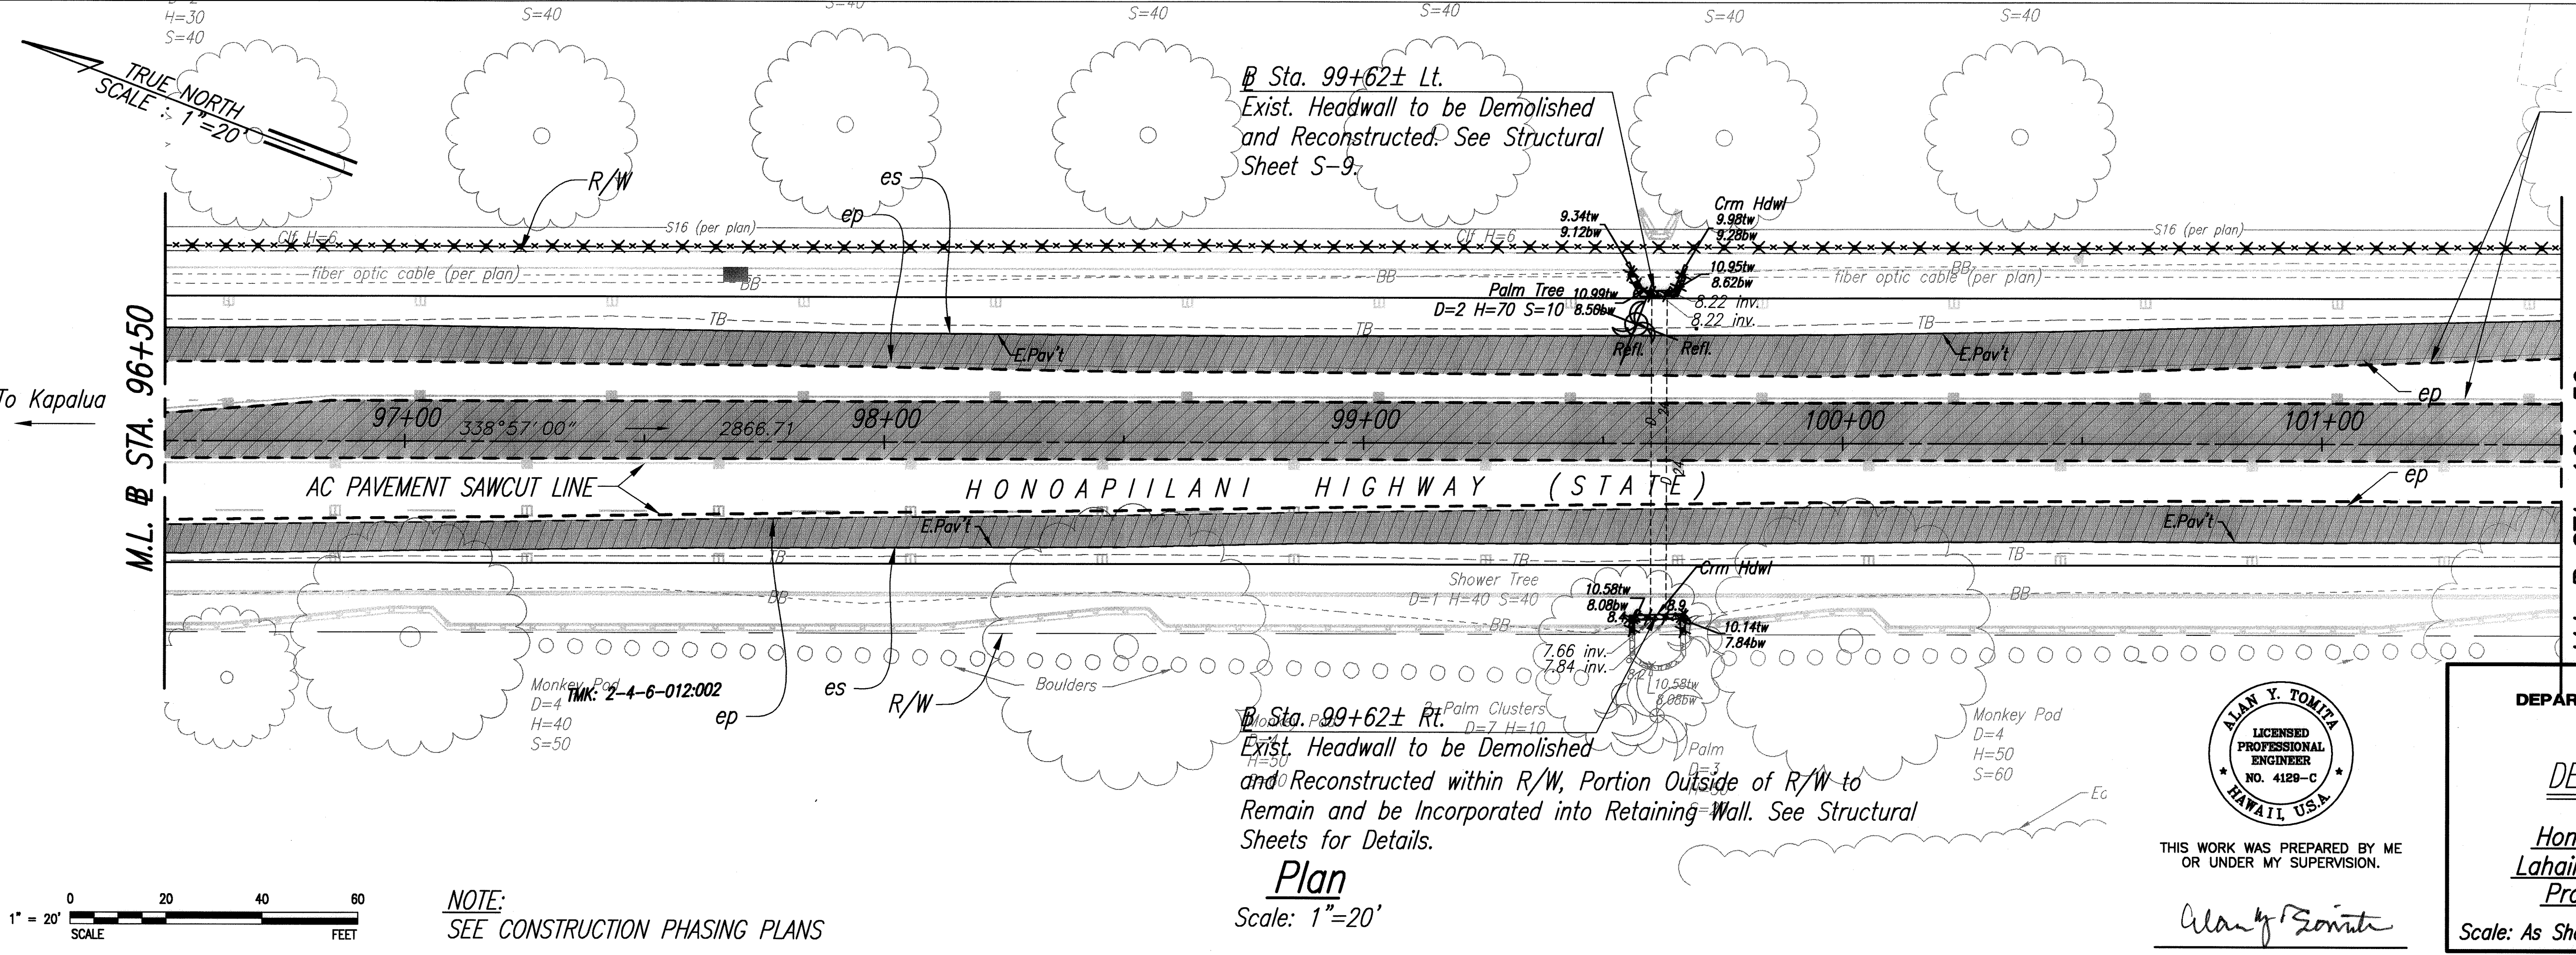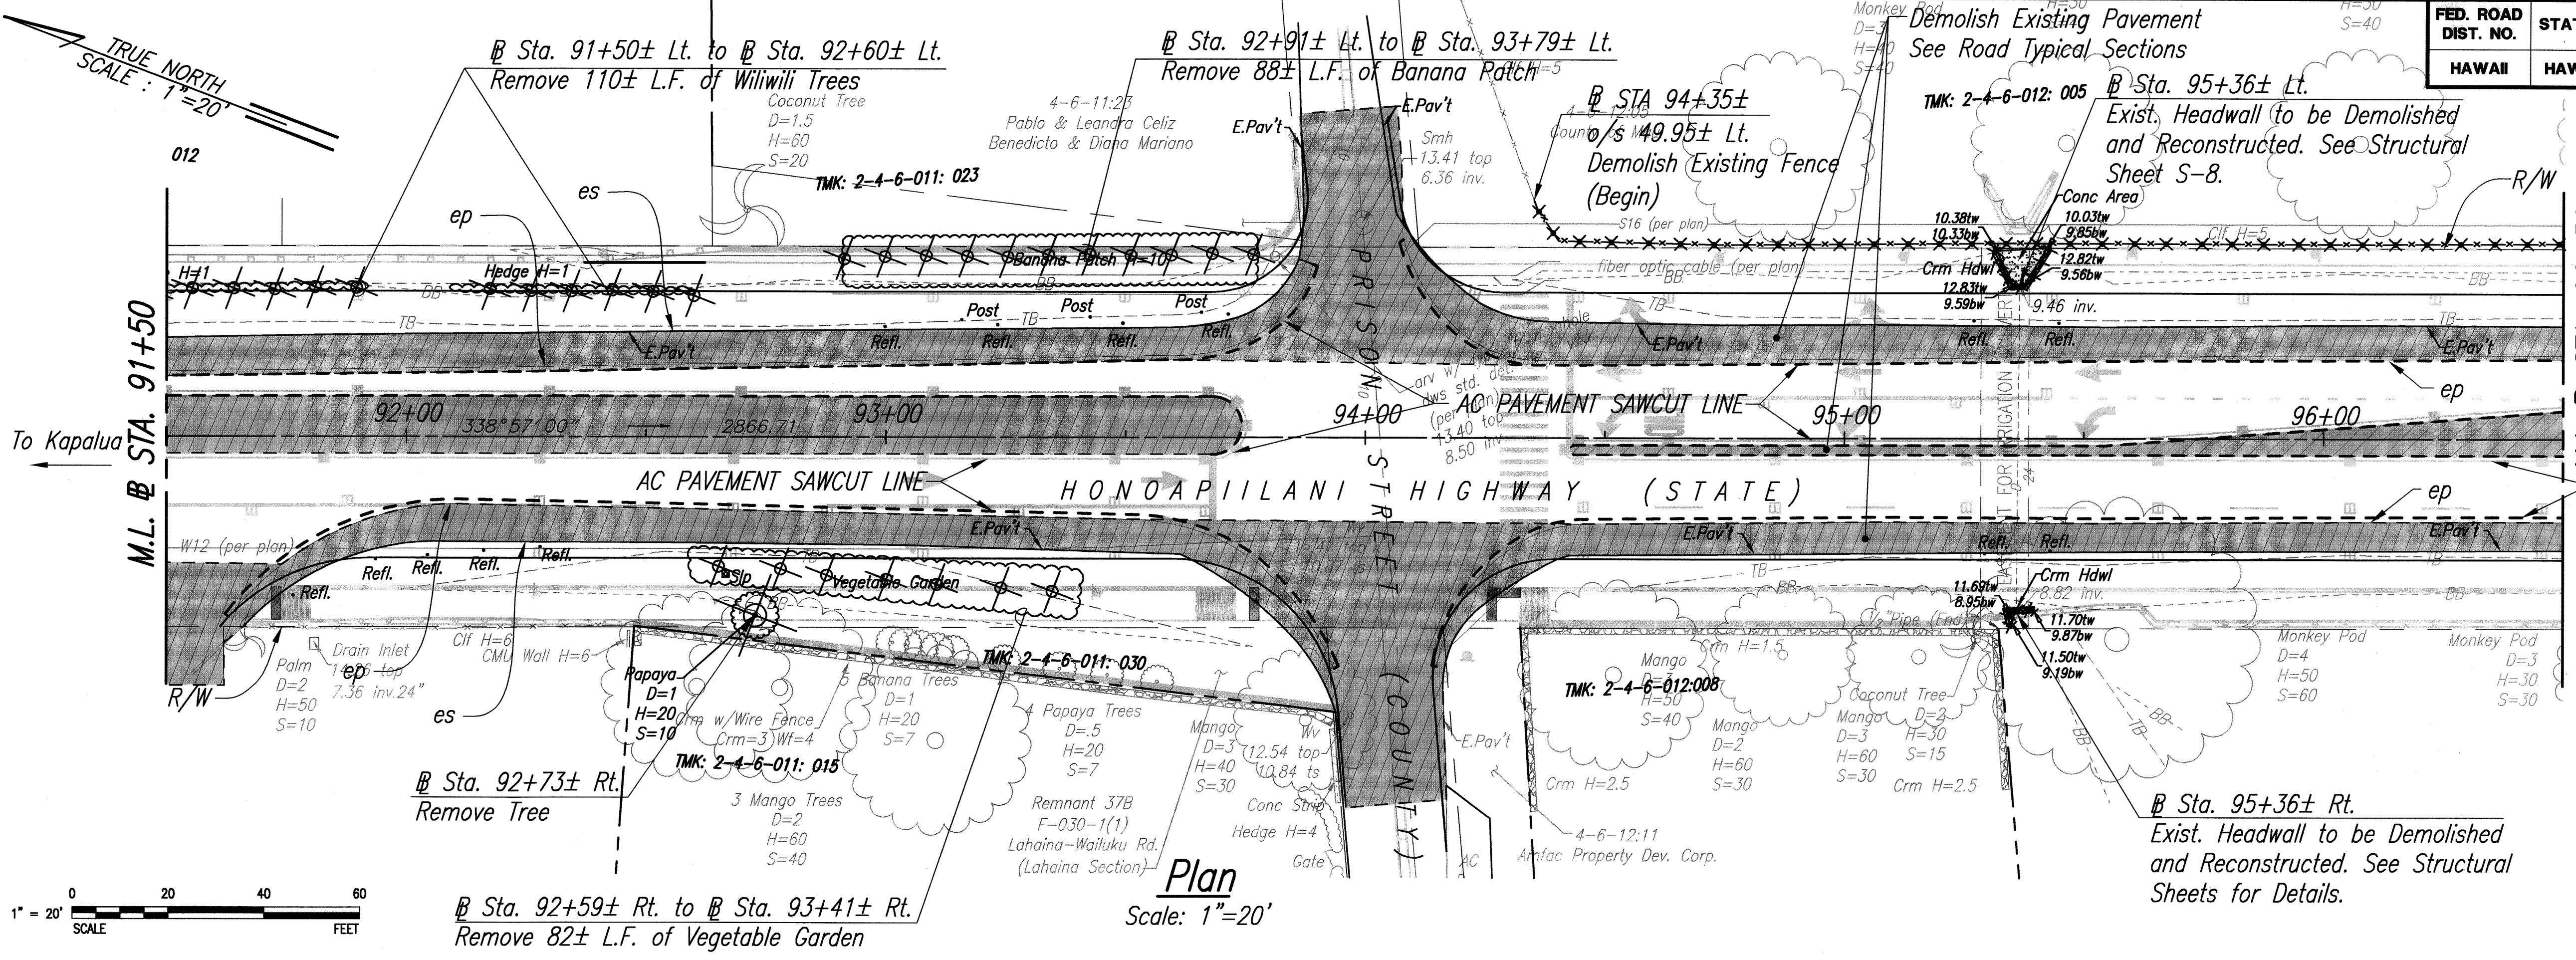

NOTE:
SEE CONSTRUCTION PHASING PLANS

ALAN Y. TOMITA
LICENSED PROFESSIONAL ENGINEER
NO. 4128-C
HAWAII, U.S.A.
THIS WORK WAS PREPARED BY ME
OR UNDER MY SUPERVISION.
Alan Y. Tomita

STATE OF HAWAII
DEPARTMENT OF TRANSPORTATION
HIGHWAYS DIVISION



DEMOLITION PLANS - 3

Honoapiilani Highway Widening
Lahainaluna Road to Aholo Road
Project No. STP-030-1(39)

Scale: As Shown Date: October 2008

SHEET No. 3 OF 6 SHEETS


FED. ROAD DIST. NO.	STATE	PROJ. NO.	FISCAL YEAR	SHEET NO.	TOTAL SHEETS
HAWAII	HAW.	STP-030-1(39)	2008	21	194

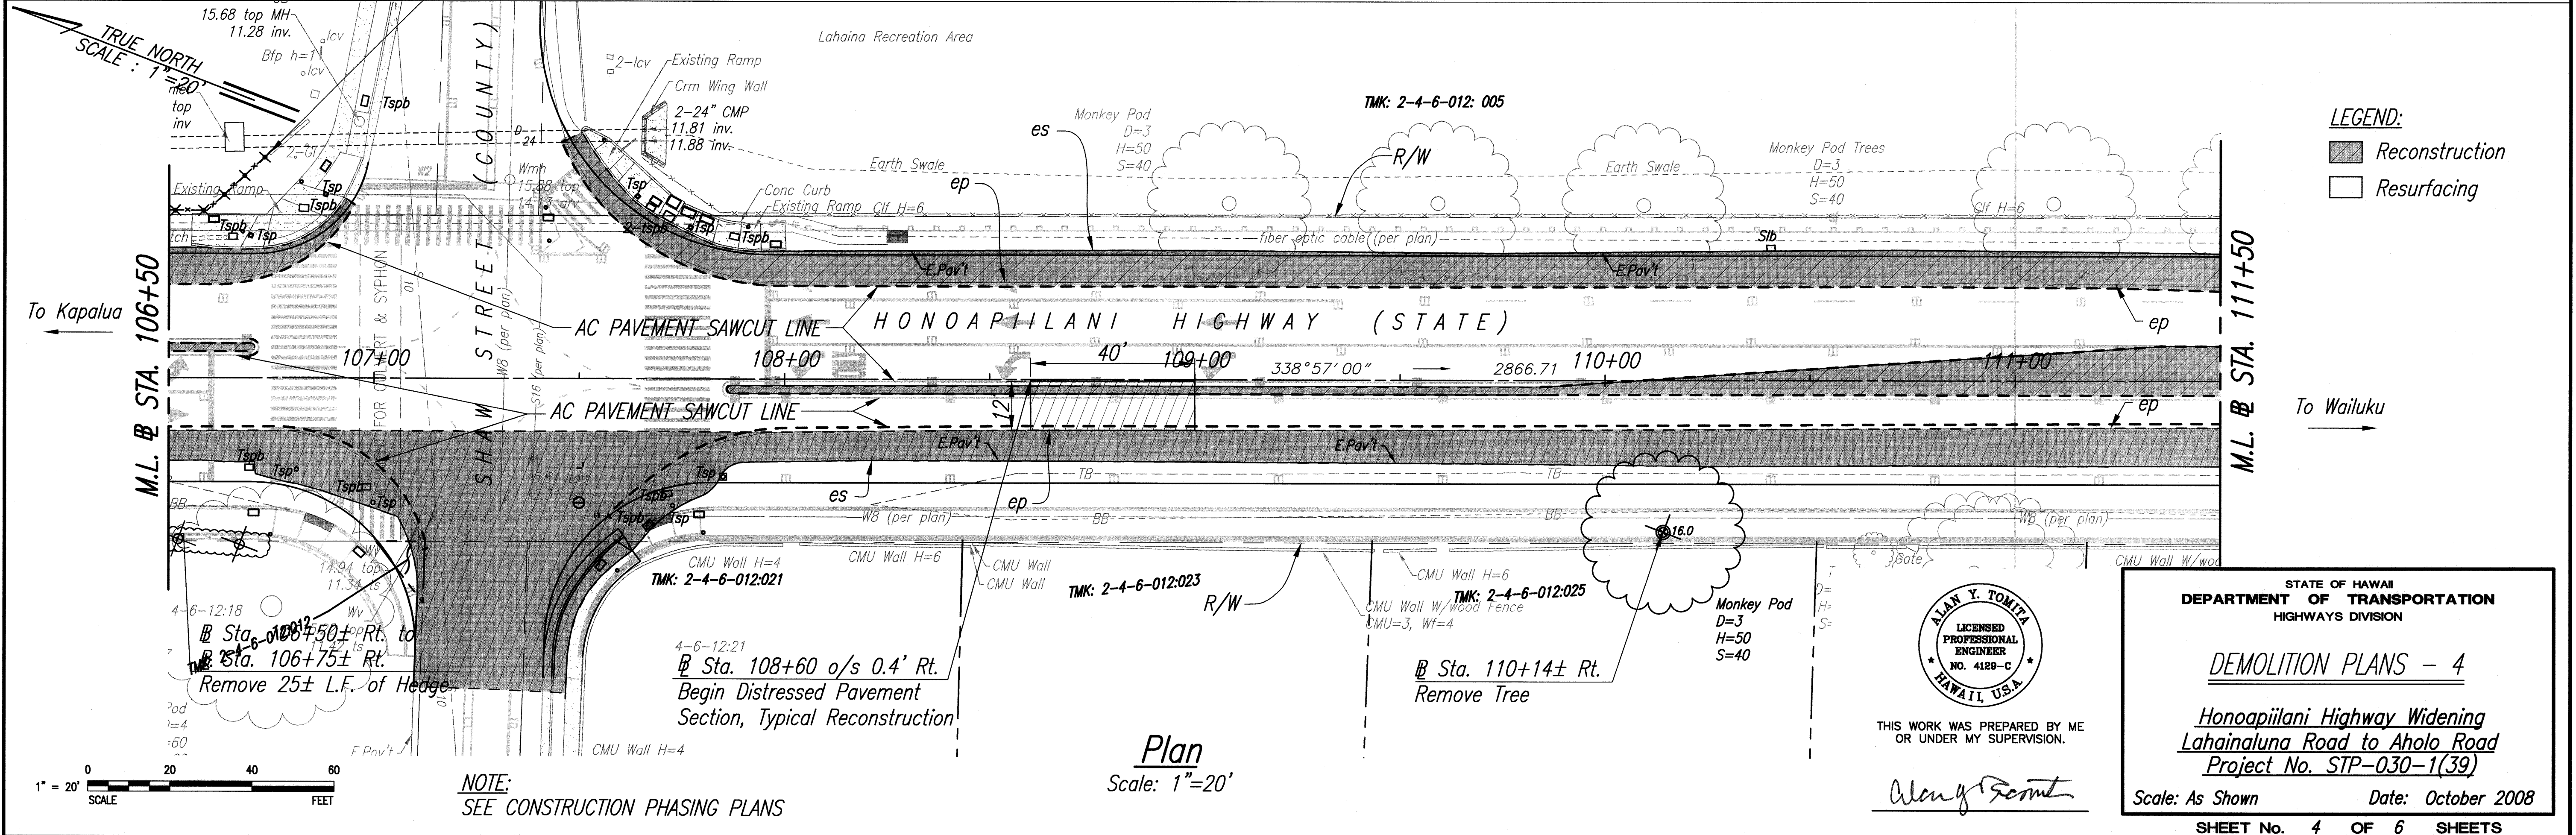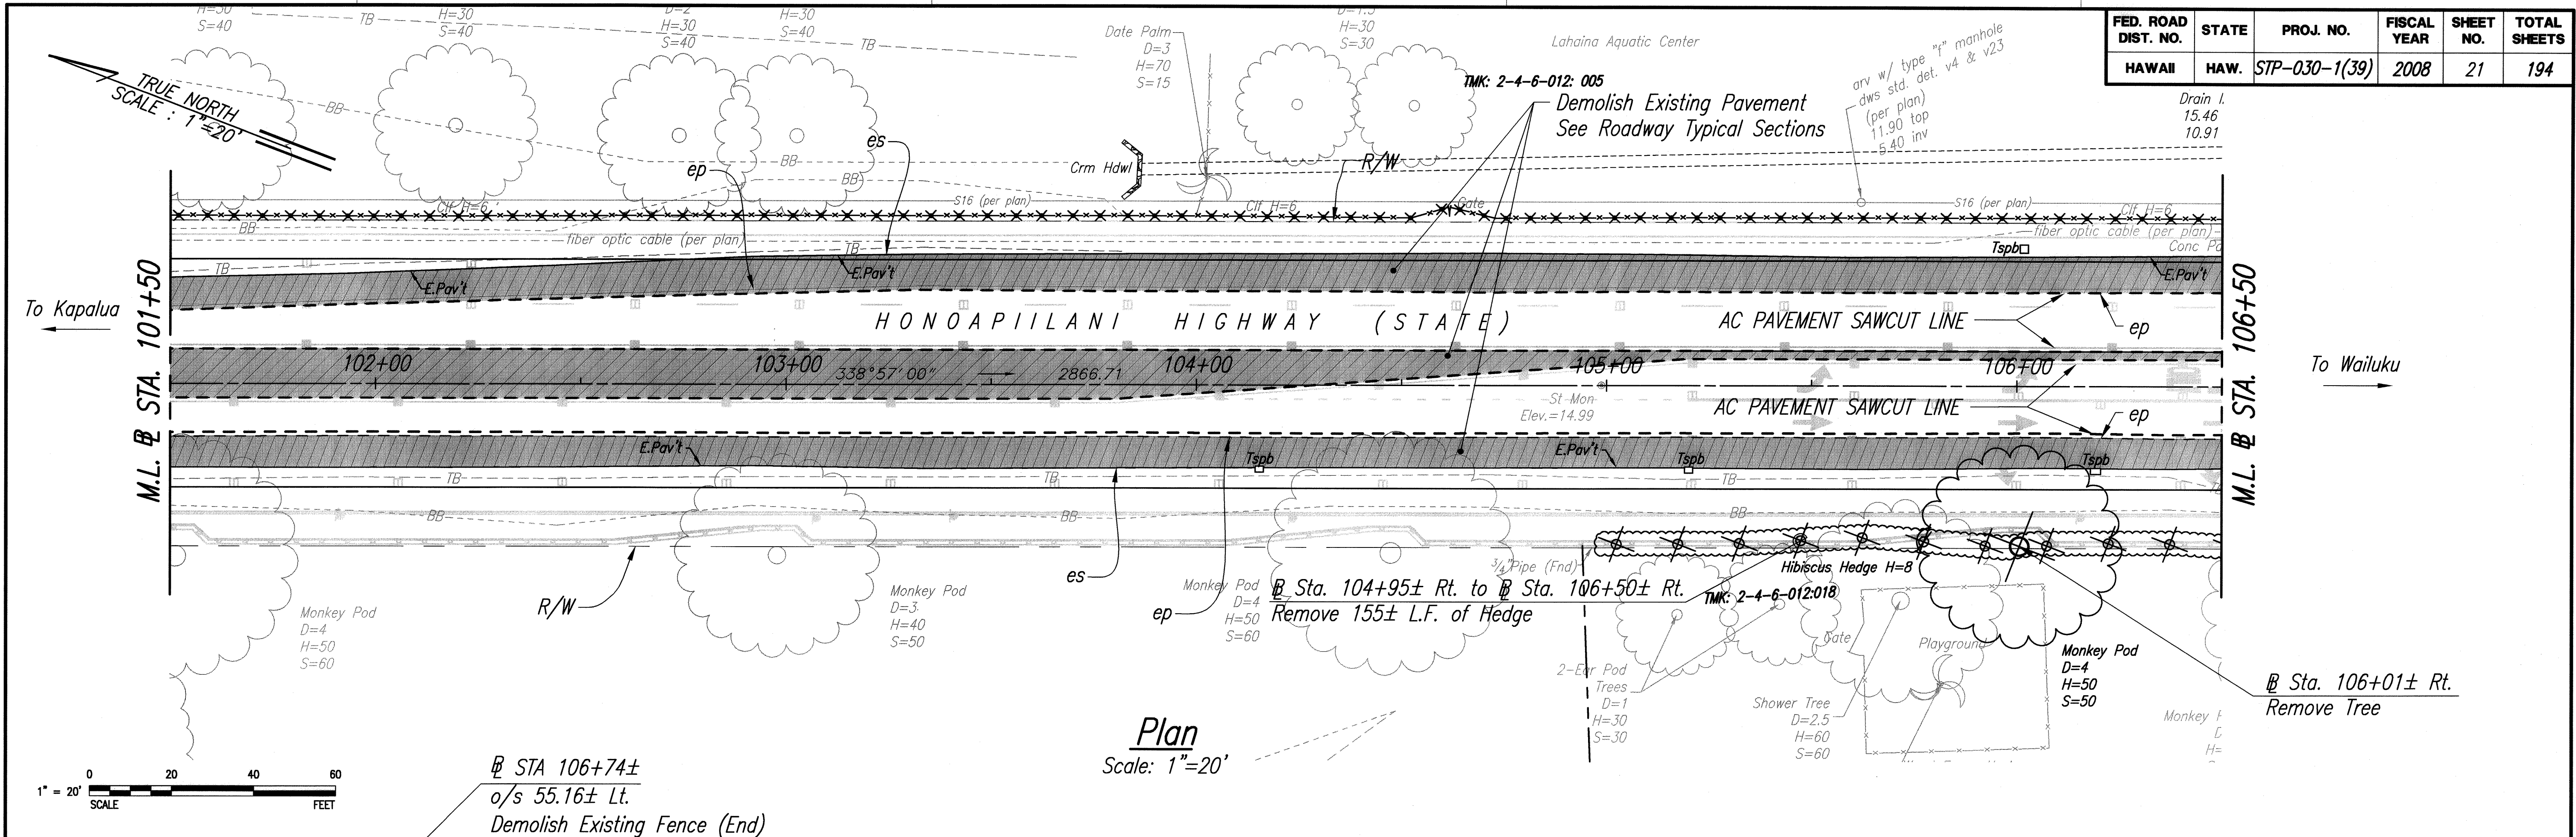

LEGEND:

Reconstruction

Resurfacing

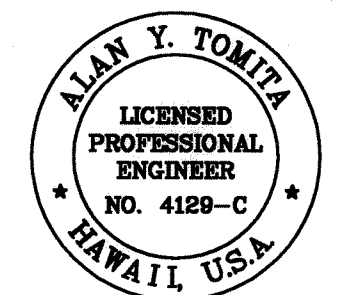

THIS WORK WAS PREPARED BY ME OR UNDER MY SUPERVISION.

Along Road

STATE OF HAWAII
DEPARTMENT OF TRANSPORTATION
HIGHWAYS DIVISION

DEMOLITION PLANS - 4

Honoapiilani Highway Widening
Lahainaluna Road to Aholo Road
Project No. STP-030-1(39)



Scale: As Shown Date: October 2008

SHEET No. 4 OF 6 SHEETS

ORIGINAL PLAN	DATE
DESIGNED BY	
TRACED BY	
DESIGNED BY	
QUANTITIES BY	
CHECKED BY	
NO.	

PLT DATE: 11-29-2008 @ 11:11 am
LAST UPDATE: 10-15-2008 @ 01:49 pm
PROJECT: Honoapiilani Highway Widening, Lahainaluna Road to Aholo Road, Project No. STP-030-1(39)

FED. ROAD DIST. NO.	STATE	PROJ. NO.	FISCAL YEAR	SHEET NO.	TOTAL SHEETS
HAWAII	HAW.	STP-030-1(39)	2008	22	194

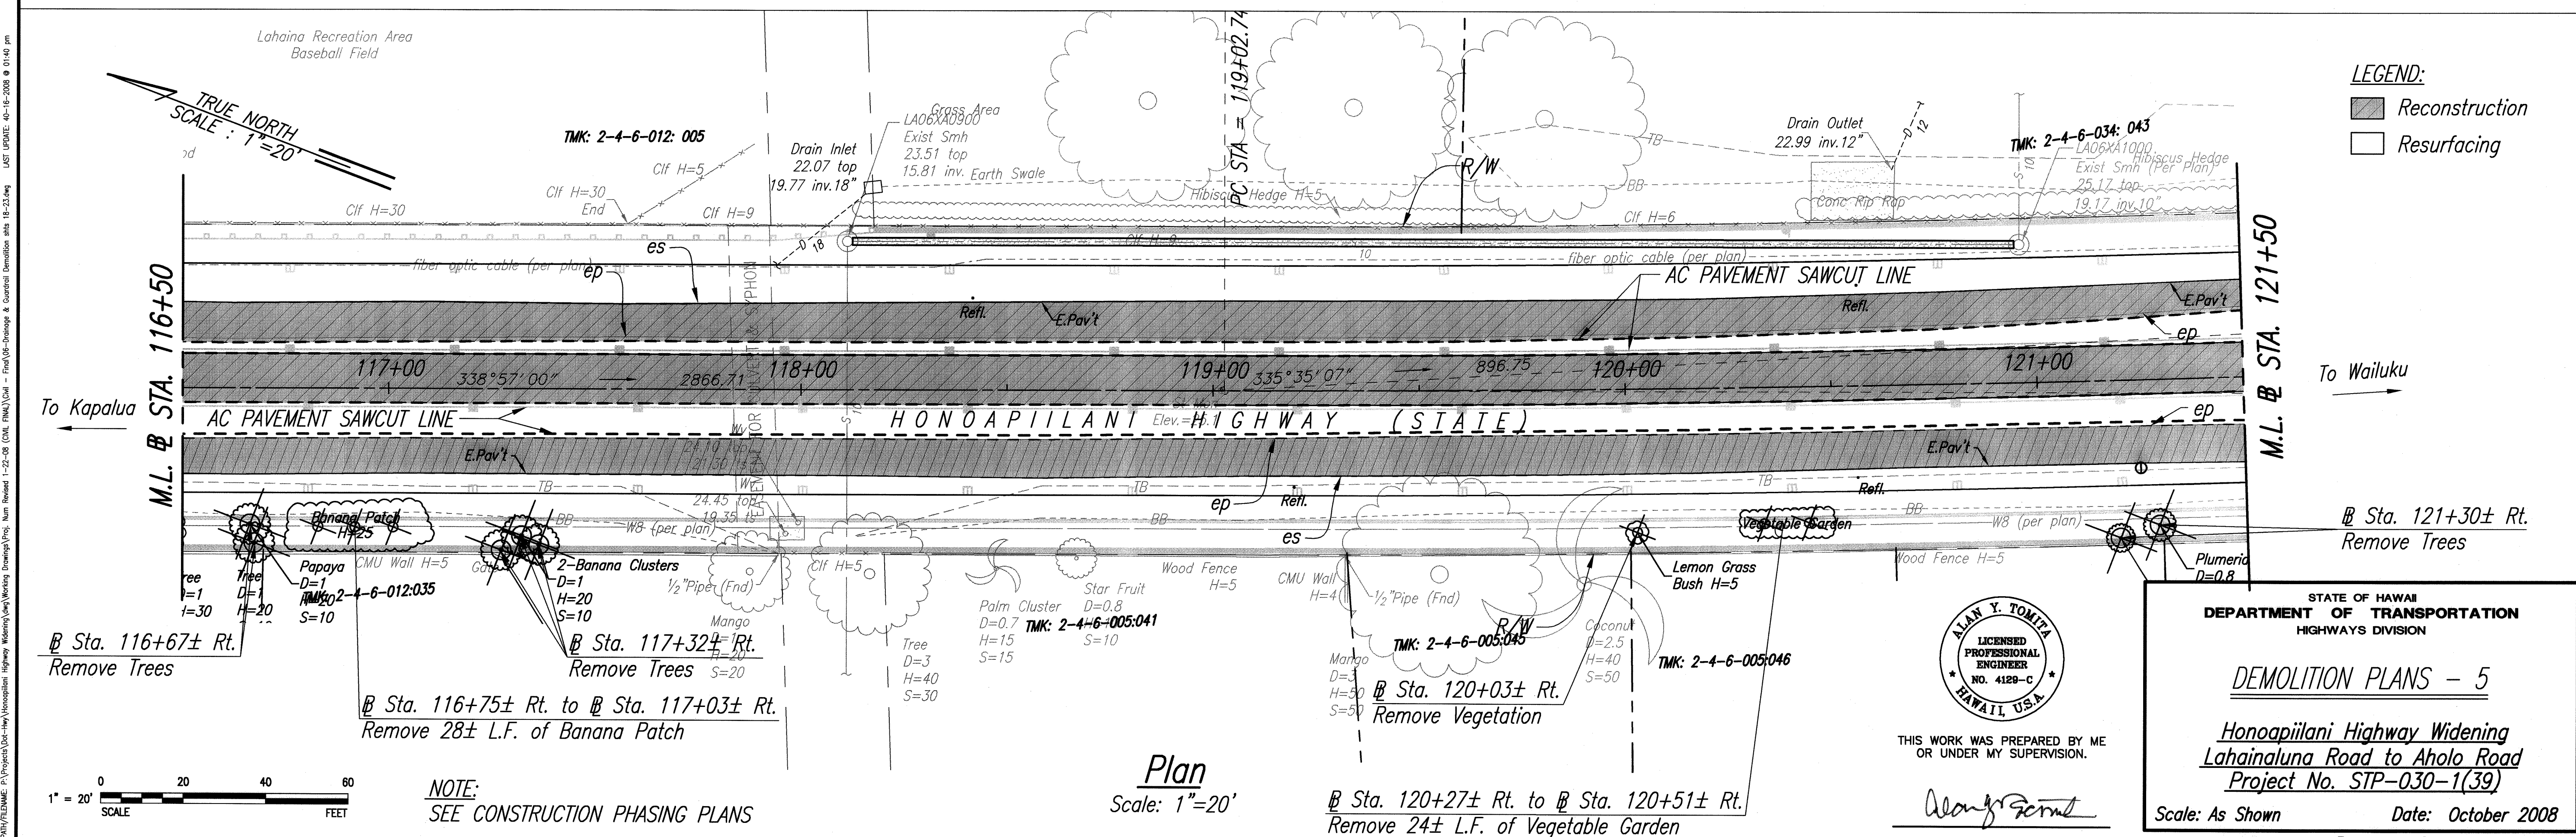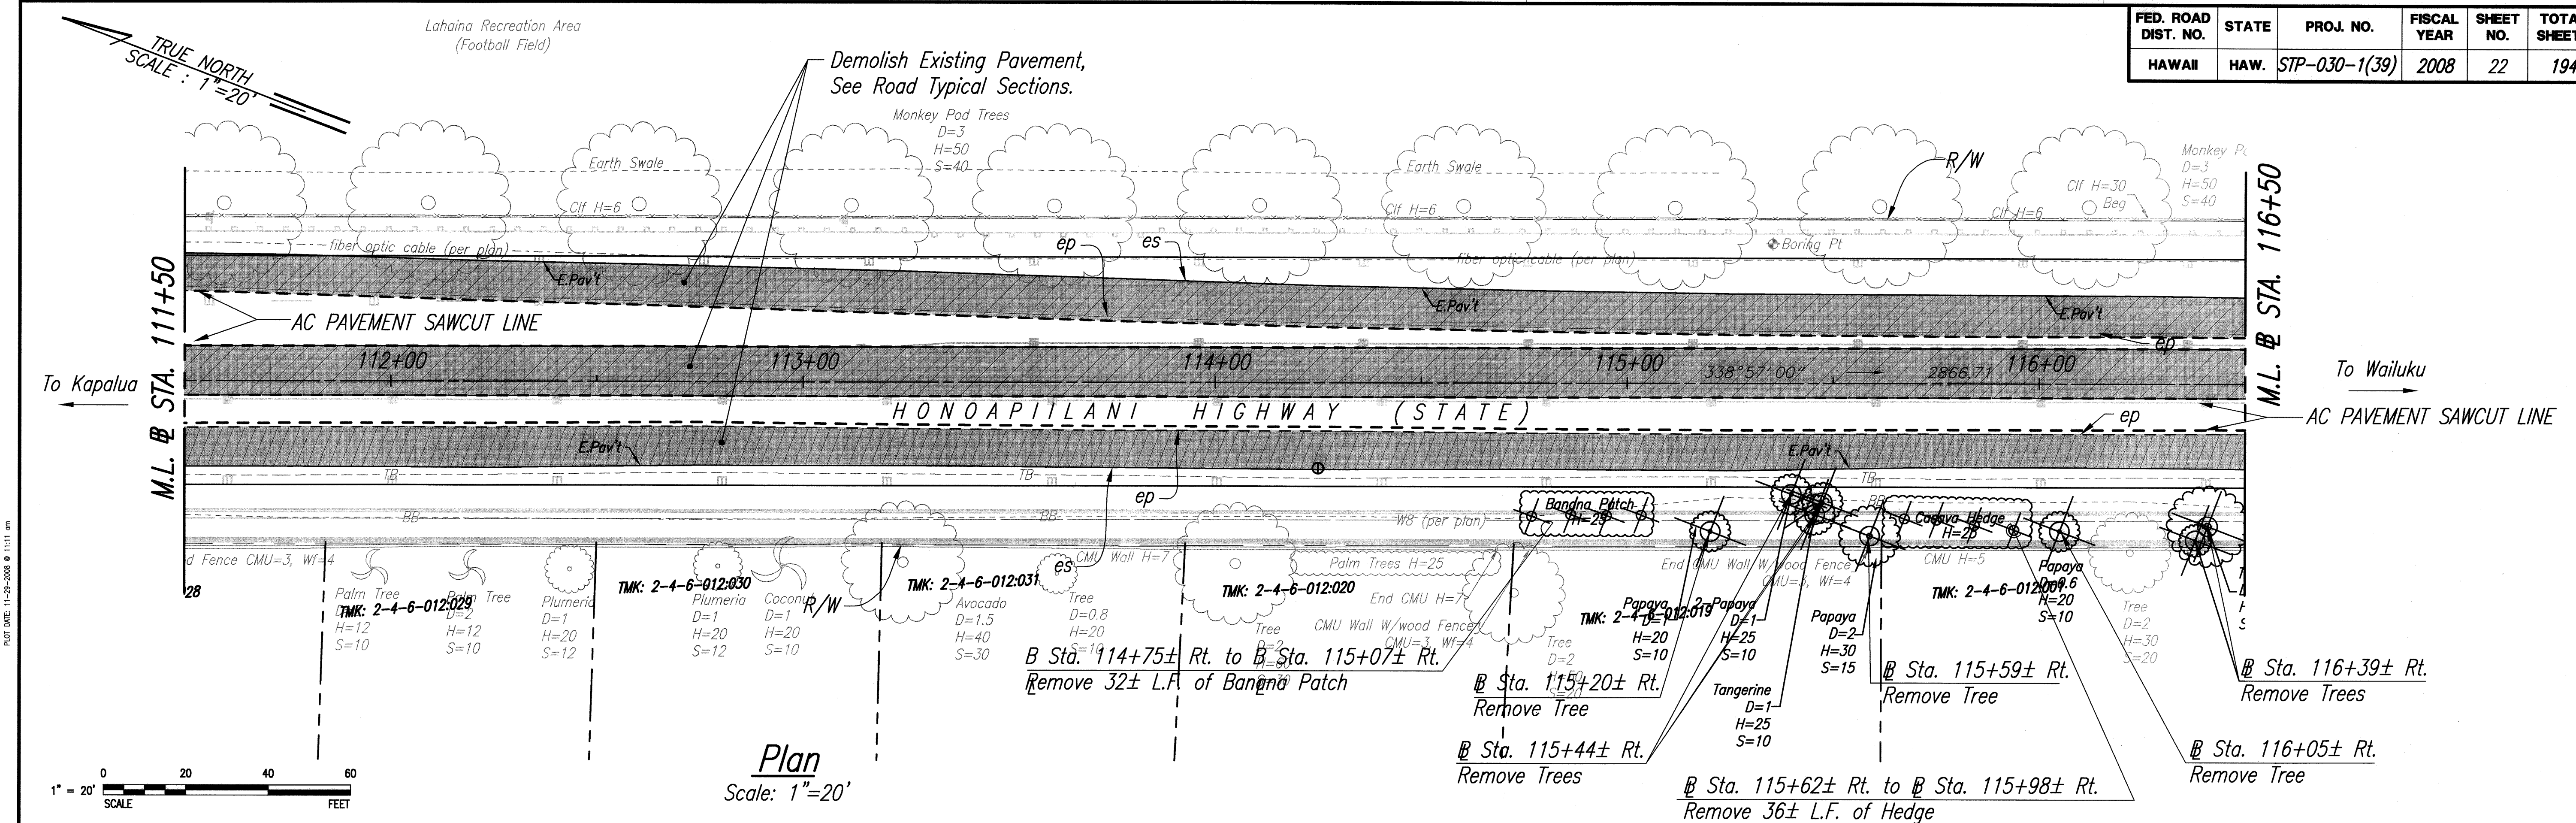

FED. ROAD DIST. NO.	STATE	PROJ. NO.	FISCAL YEAR	SHEET NO.	TOTAL SHEETS
HAWAII	HAW.	STP-030-1(39)	2008	23	194

