

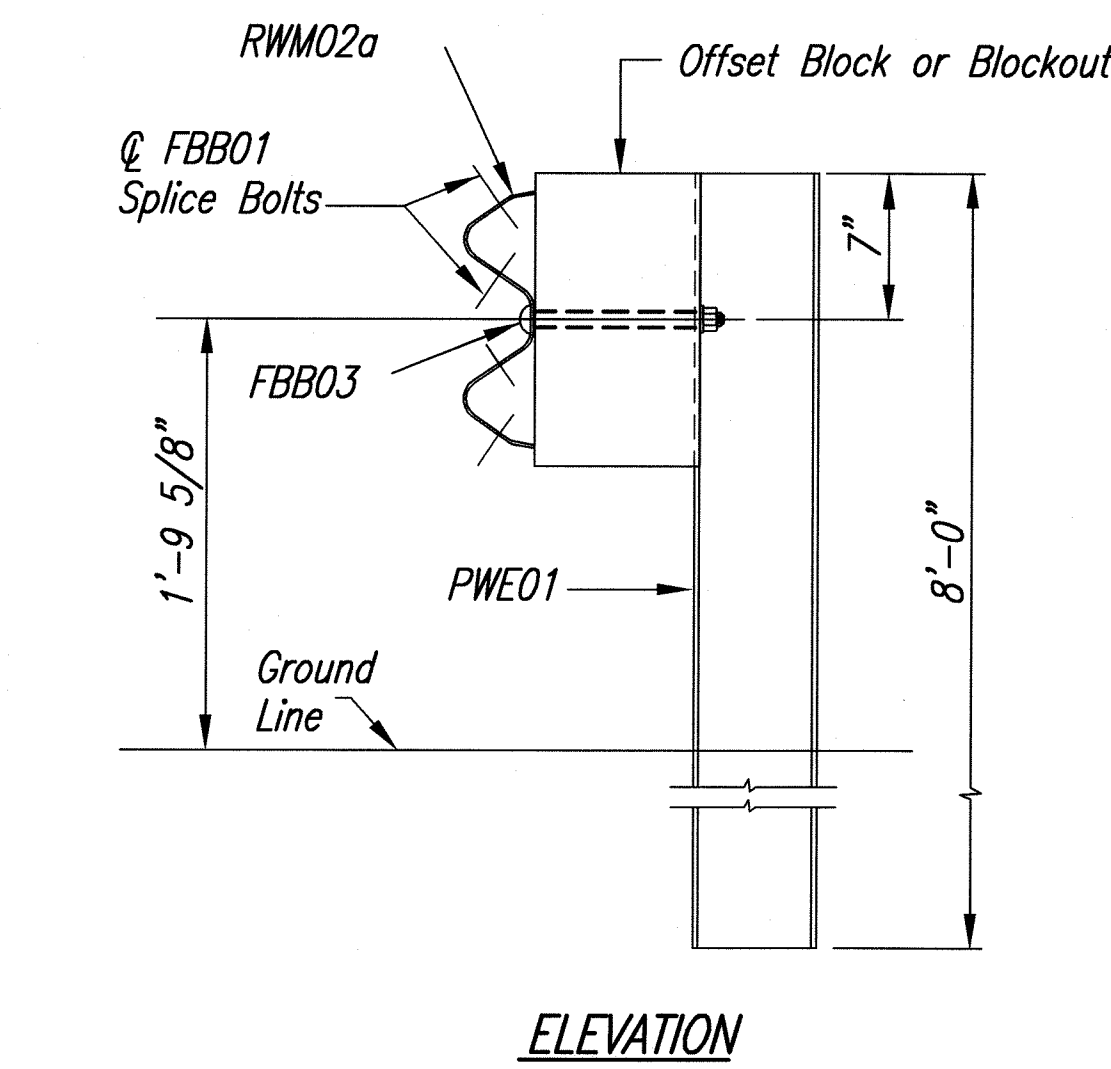




FED. ROAD DIST. NO.	STATE	PROJ. NO.	FISCAL YEAR	SHEET NO.	TOTAL SHEETS
HAWAII	HAW.	STP-030-1(39)	2008	74	194

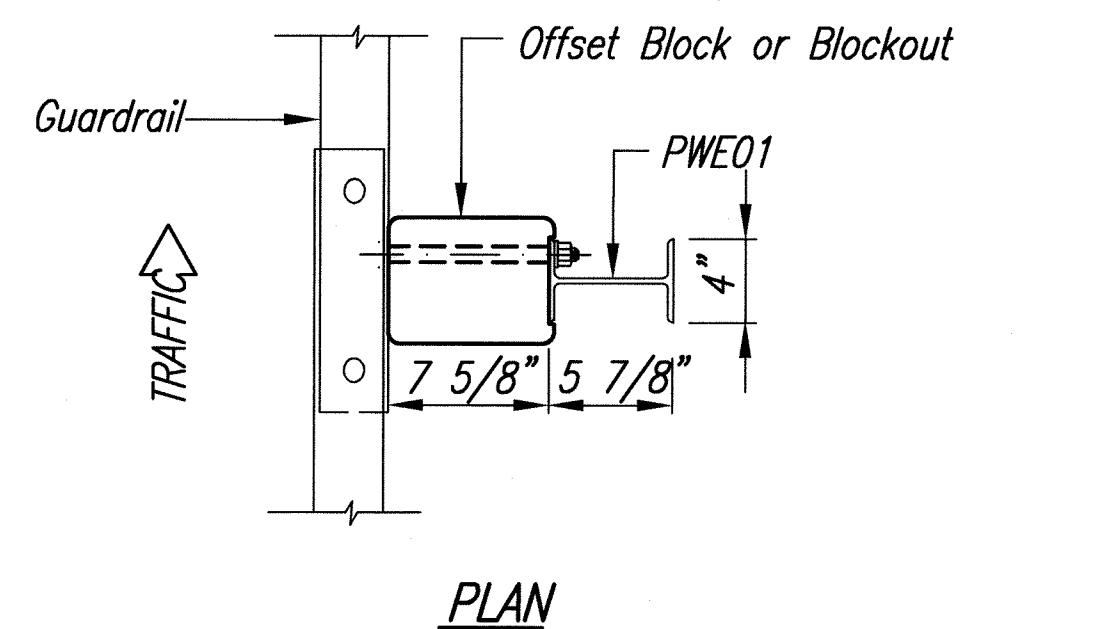


STRONG POST W-BEAM GUARDRAIL (SGR04a)
N.T.S.

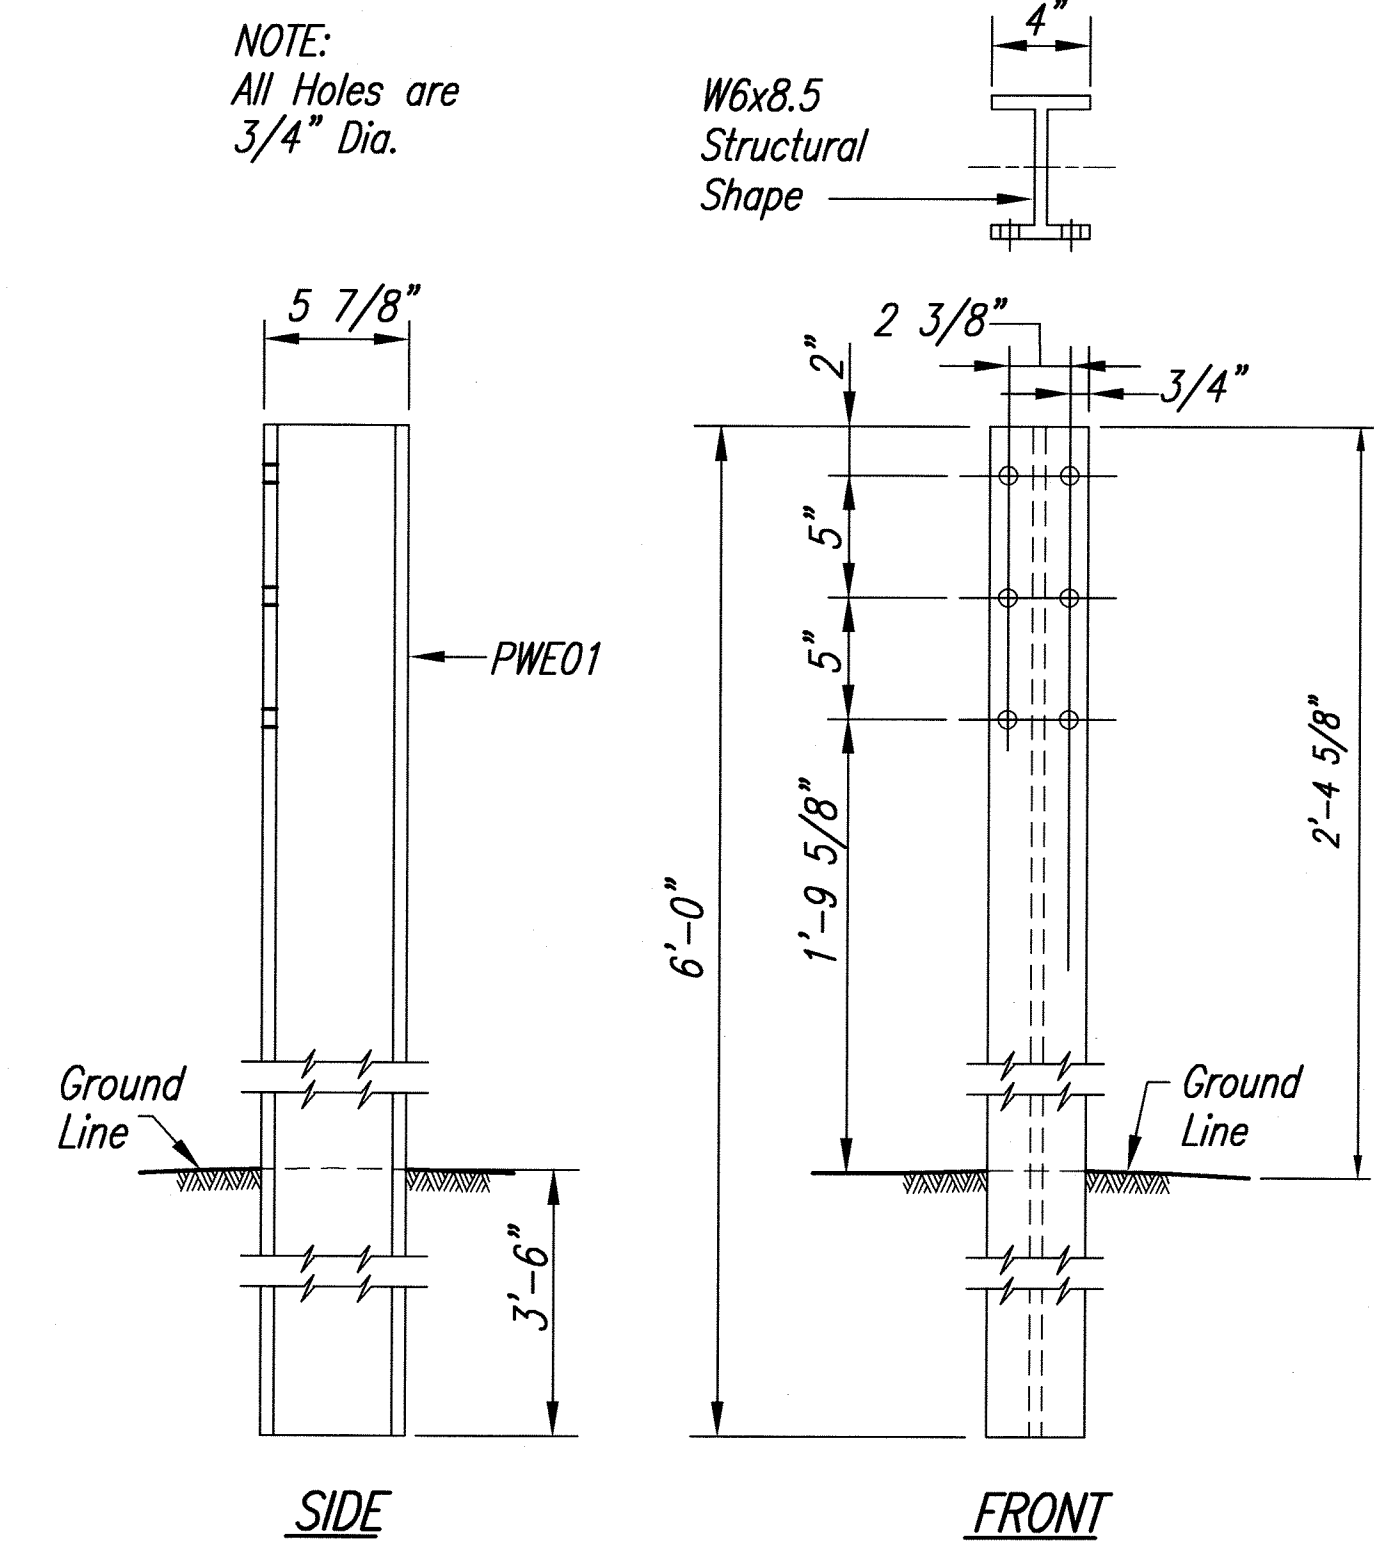


STRONG POST W-BEAM (PWE01)
N.T.S.

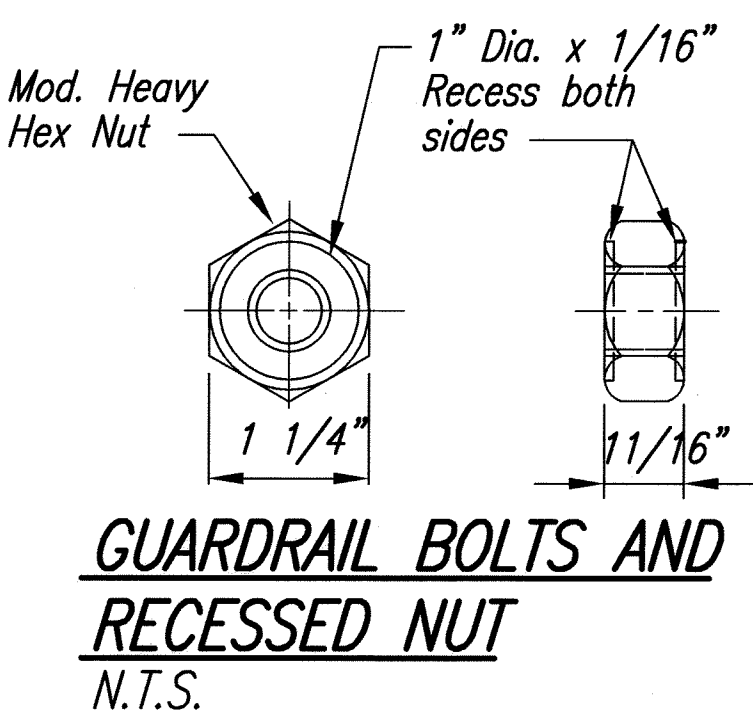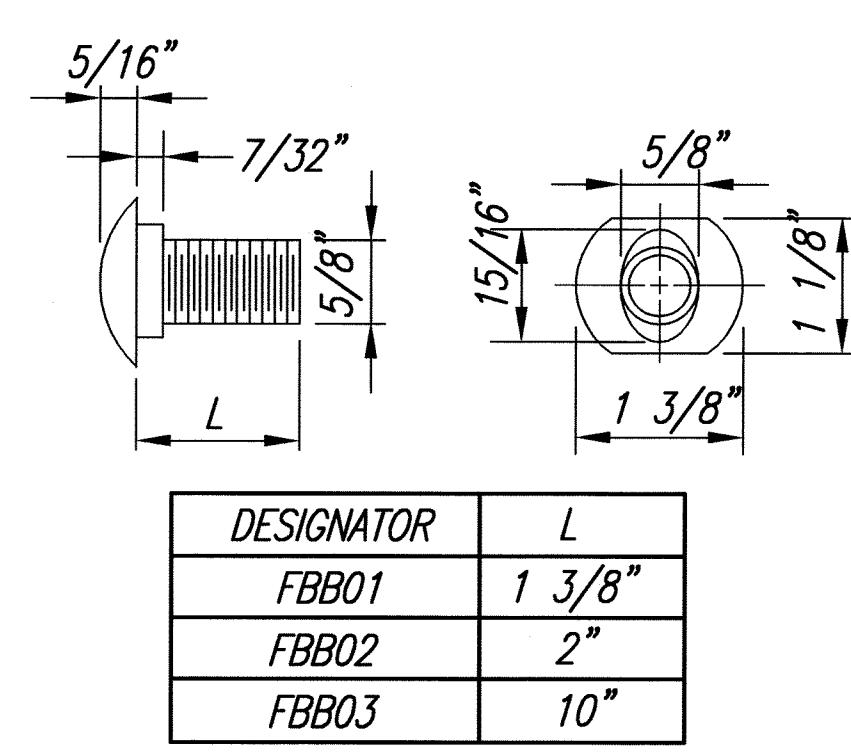


GUARDRAIL BOLTS AND RECESSED NUT
N.T.S.

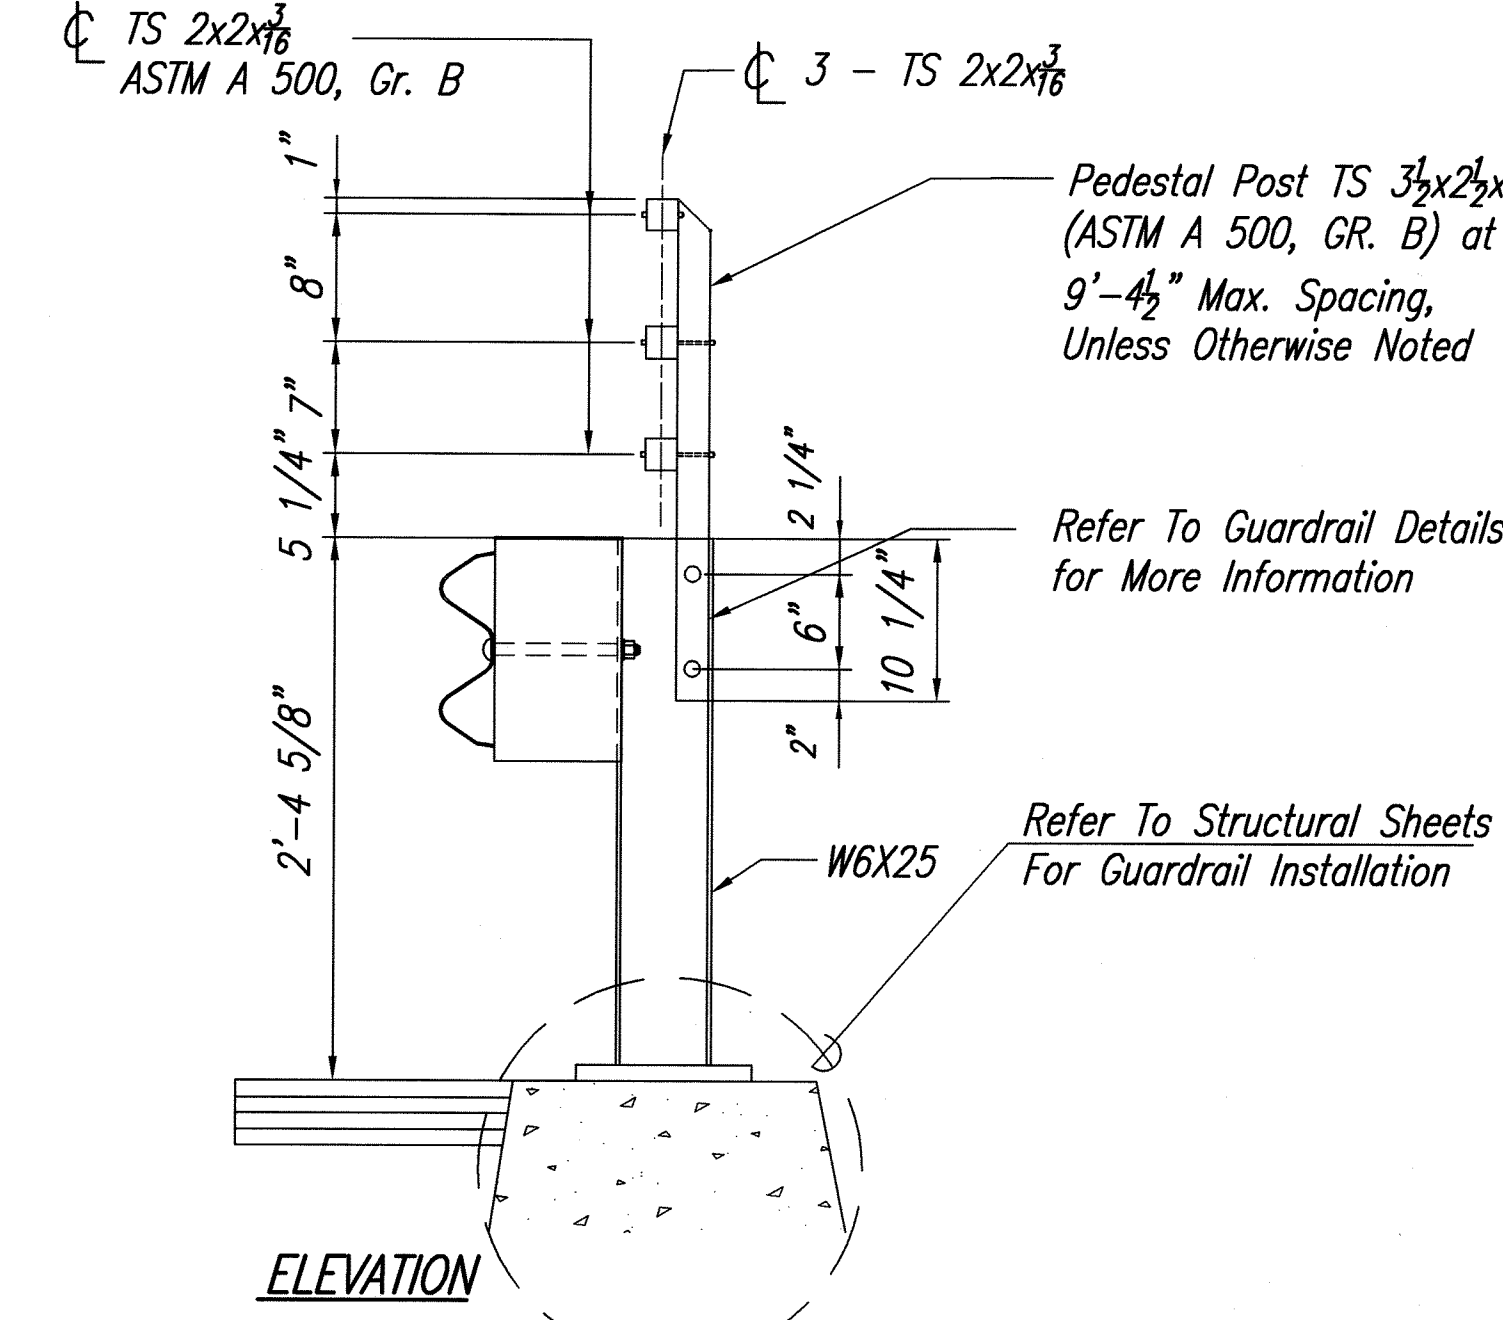


W-BEAM GUARDRAIL WITH PEDESTAL POST (ON RETAINING WALL)
N.T.S.

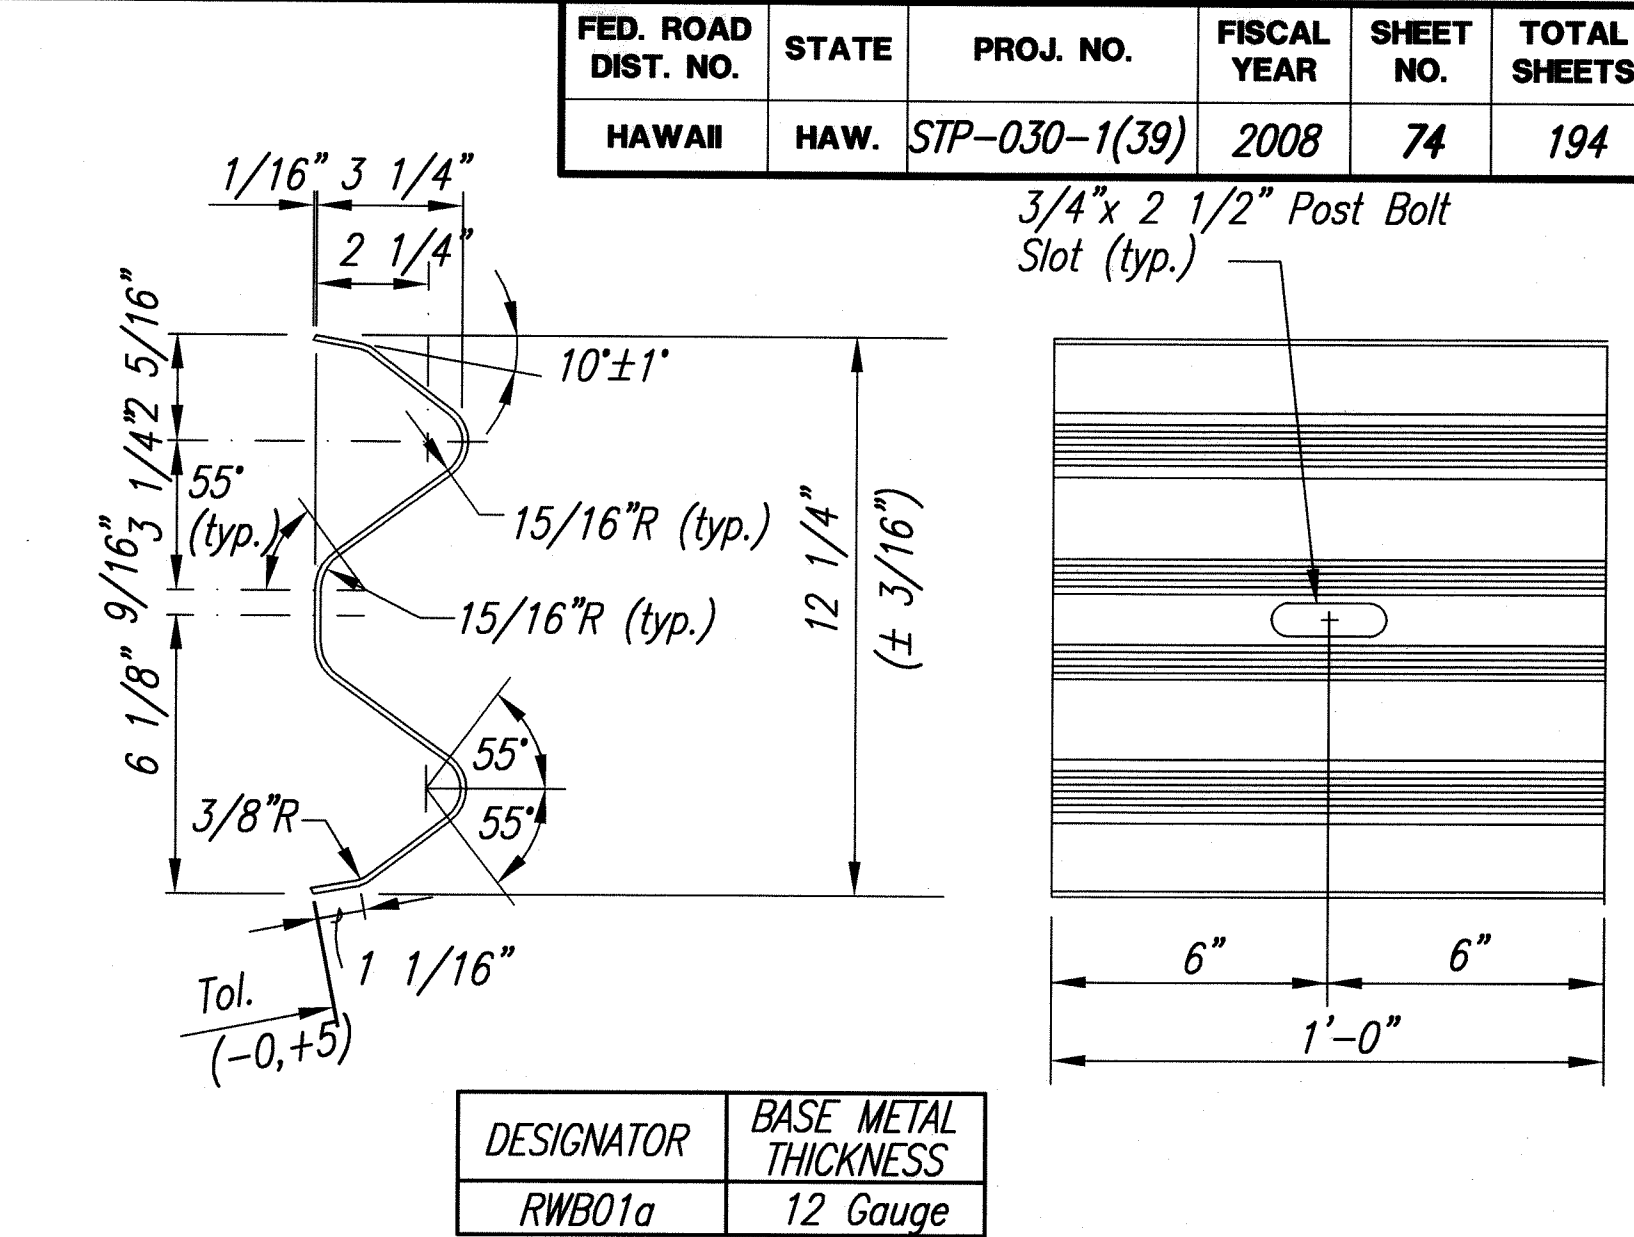

W-BEAM BACK-UP-PLATE (RWB01a)
N.T.S.

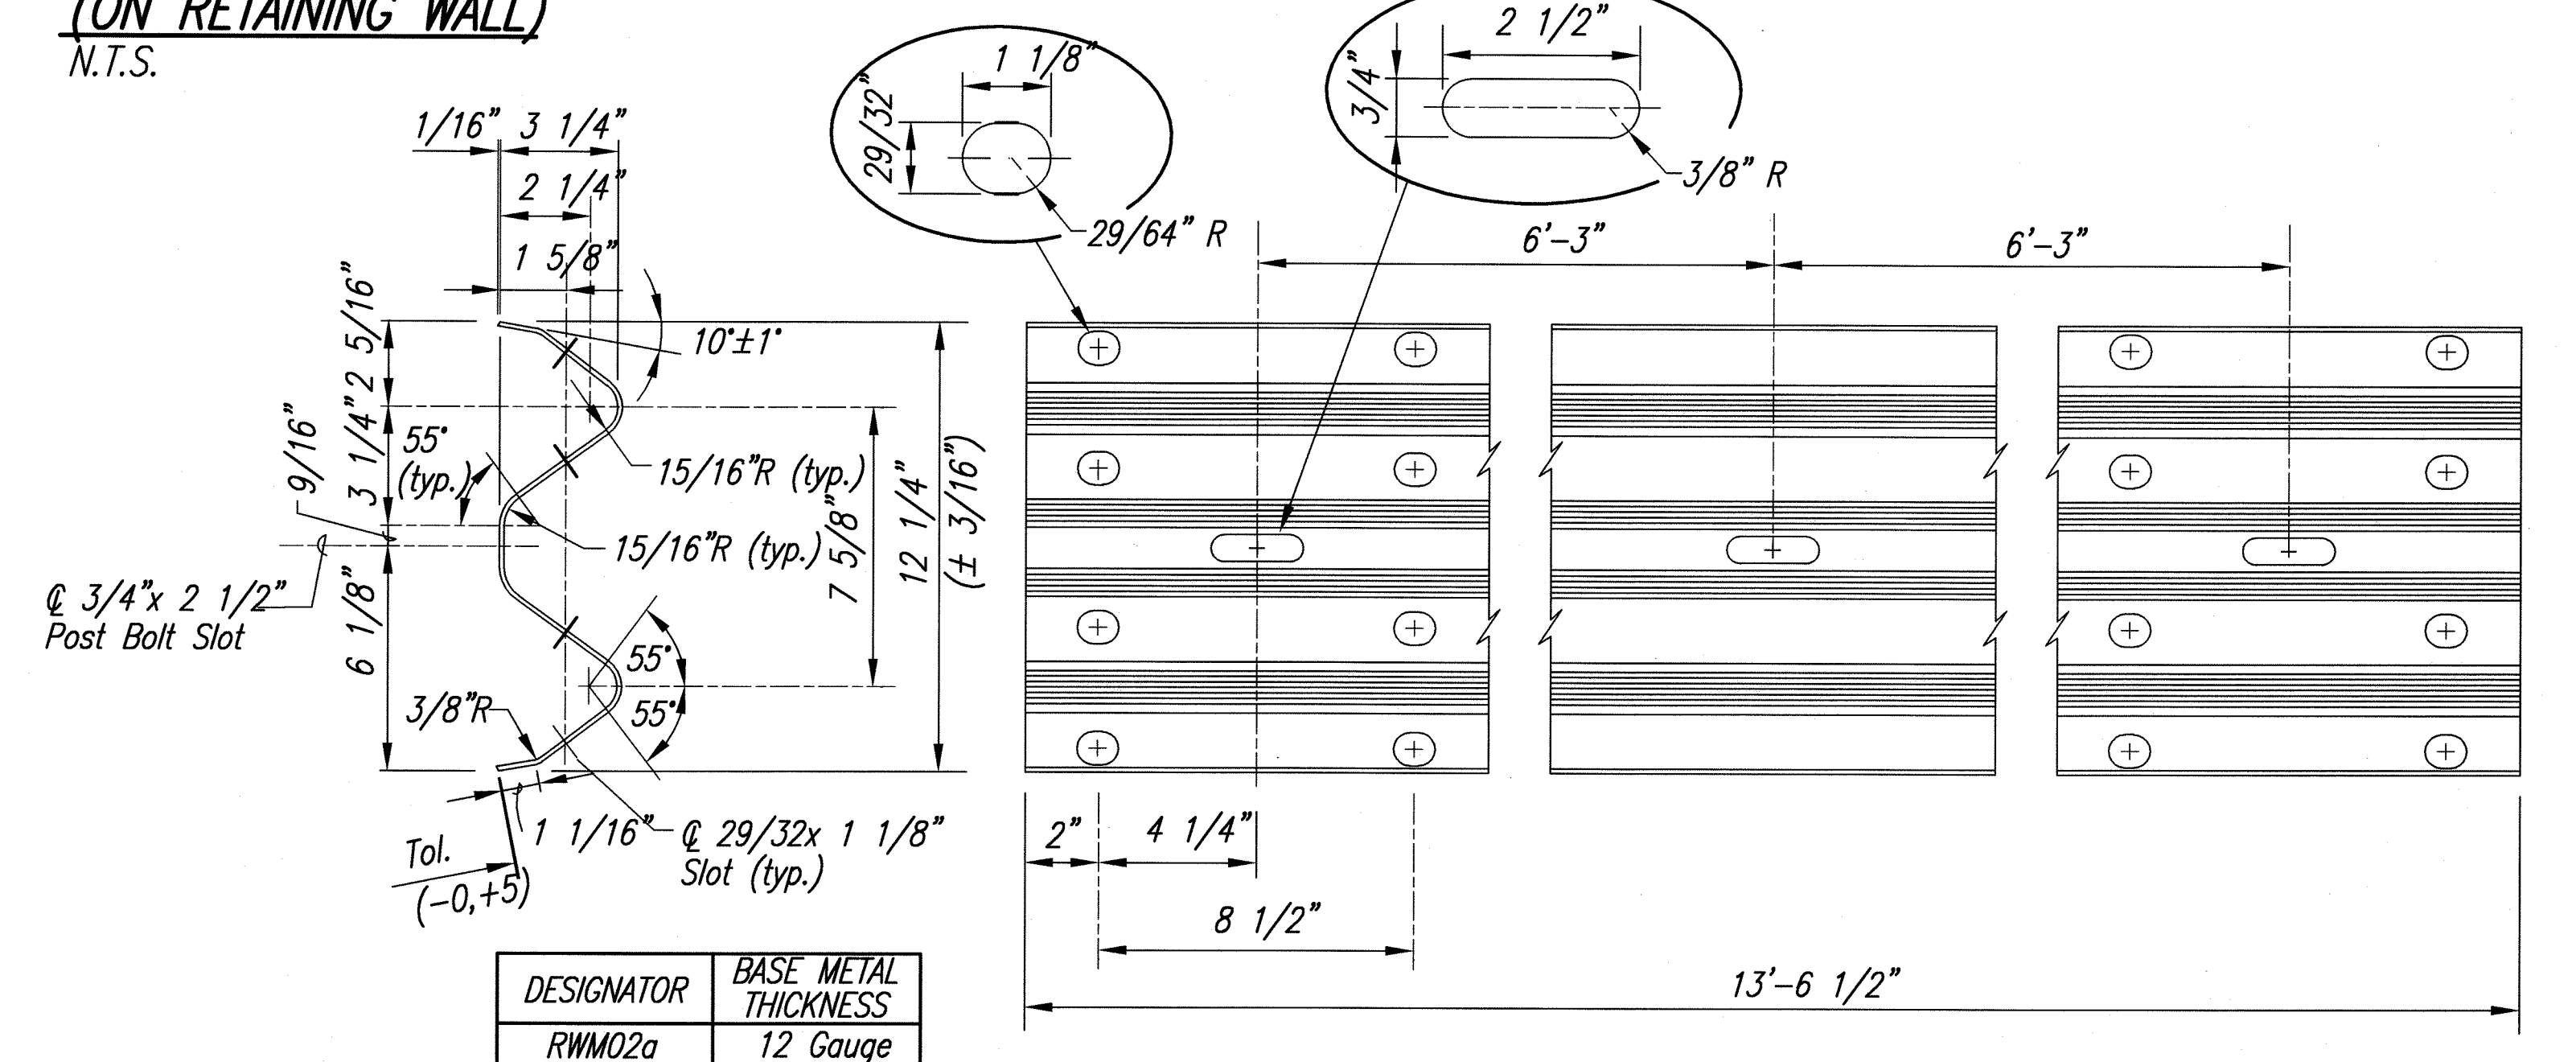

2 SPACE W-BEAM GUARDRAIL (RWM02a)
N.T.S.

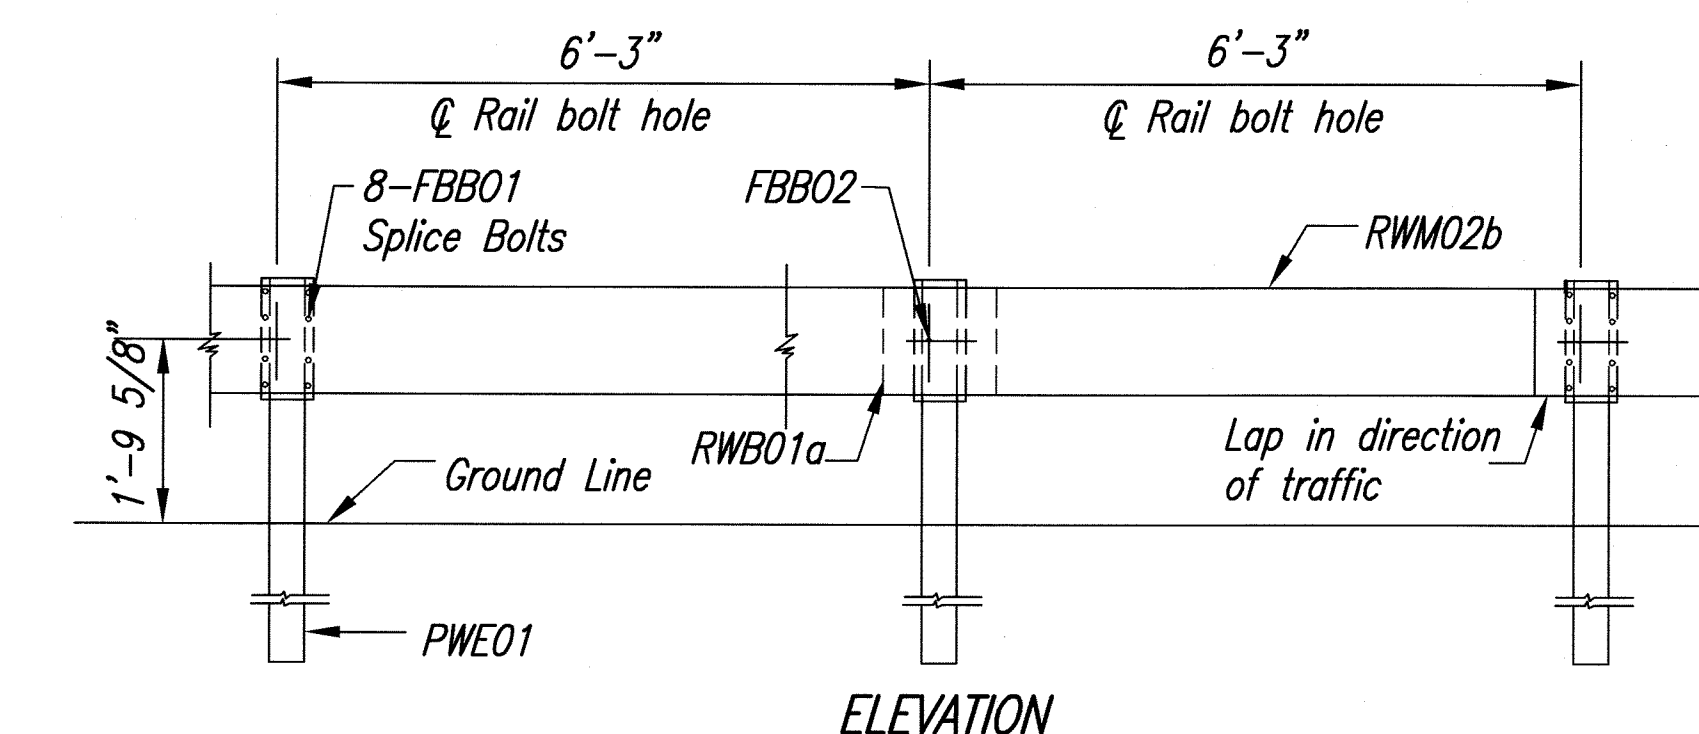

STRONG POST W-BEAM GUARDRAIL WITH RECYCLED OFFSET BLOCK OR PLASTIC BLOCKOUT
N.T.S.

ALAN Y. TOMITA
LICENSED PROFESSIONAL ENGINEER
NO. 4128-C
HAWAII, USA

THIS WORK WAS PREPARED BY ME OR UNDER MY SUPERVISION.

Alan Y. Tomita

STATE OF HAWAII
DEPARTMENT OF TRANSPORTATION
HIGHWAYS DIVISION

GUARDRAIL DETAILS

*Honoapiilani Highway Widening
Lahaina Road to Aholo Road
Project No. STP-030-1(39)*

Scale: As Shown Date: October 2008

SHEET No. 2 OF 6 SHEETS

FED. ROAD DIST. NO.	STATE	PROJ. NO.	FISCAL YEAR	SHEET NO.	TOTAL SHEETS
HAWAII	HAW.	STP-030-1(39)	2008	75	194


GENERAL NOTES

- Breakaway posts are required with the FLEAT Terminal.
- All bolts, nuts, cable assemblies, cable anchors and bearing plates shall be galvanized.
- The soil tubes shall not protrude more than 4" above ground (measured along a 5' cord). Site grading may be necessary to meet this requirement.
- The soil tubes may be driven with an approved driving head. Soil tubes should not be driven with the post in the tube. If the tubes are placed in drilled holes, the backfill material must be satisfactorily compacted to prevent settlement.
- When rock is encountered during excavation, a 12" Dia. post hole, 20" deep may be used if approved by the Engineer. Granular material will be placed in the bottom of the hole approx. 2 1/2" deep to provide drainage. The soil tubes will be field cut to length, placed in the hole and backfilled with adequately compacted material excavated from the hole.
- The breakaway cable assembly must be taut. A locking device, (vice grips or channel lock pliers) should be used to prevent the cable from twisting when tightening nuts.
- (R) or (L) indicates right or left Impact Head Reflector Marker (IHRM). Providing and installing of IHRM shall be considered incidental to end treatment.
- The stripes for IHRM shall slope downward at an angle of 45° towards the side of the end treatment that traffic is to pass.


ITEM NO.	QTY	BILL OF MATERIALS
F3000	1	IMPACT HEAD
F1303	1	W-BEAM GUARDRAIL END SECTION, 12 GA.
F1304	1	W-BEAM GUARDRAIL CENTER SECTION, 12 GA.
G1203	1	W-BEAM GUARDRAIL, 12 GA.
S730	2	*FOUNDATION SOIL TUBE, 6" x 8" x 72"
E750	1	BEARING PLATE
S760	1	CABLE ANCHOR BOX
E770	1	BCT CABLE ANCHOR ASSEMBLY
E780	1	GROUND STRUT
PB620	2	STEEL BREAKAWAY END POST
PB621	5	STEEL BREAKAWAY LINE POST
	5	RECYCLED PLASTIC BLOCKOUT OR OFFSET BLOCK
	1	IMPACT HEAD REFLECTOR MARKER - IHRM(R) OR (L)
		HARDWARE
B580122	25	5/8" Dia. x 1 1/4" SPLICE BOLT, POST #2
B580754	2	5/8" Dia. x 7 1/2" HEX BOLT
B341004	2	3/4" Dia. x 10" HEX BOLT
B581002	5	5/8" Dia. x 10" H.G.R. BOLT (POST 3 THRU 7)
N050	32	5/8" Dia. H.G.R. NUT (SPLICE 24, SOIL TUBES 2, POST 2 THRU 7, 6)
N030	2	3/4" Dia. HEX NUT
W050	6	H.G.R. WASHER
W030	4	3/4" ID WASHER
N100	2	1" ANCHOR CABLE HEX NUT
W100	2	1" ANCHOR CABLE WASHER
B140404	2	1/4" x 4" HEX BOLT
N014	2	1/4" HEX NUT
W014	4	1/4" WASHER
SB58A	8	CABLE ANCHOR BOX SHOULDER BOLT
N055A	8	1/2" A325 STRUCTURAL NUT
W050A	16	1 1/16" OD x 9/16" ID A325 STR. WASHER

Foundation Tube Options For Posts 1 & 2


- *6'-0" Split Foundation Tubes S730
- *6'-0" Solid Foundation Tubes E731
- *5'-0" Foundation Tubes S735 W/Soil Plates SP600
- *4'-6" Foundation Tubes E735 W/Soil Plates SP600

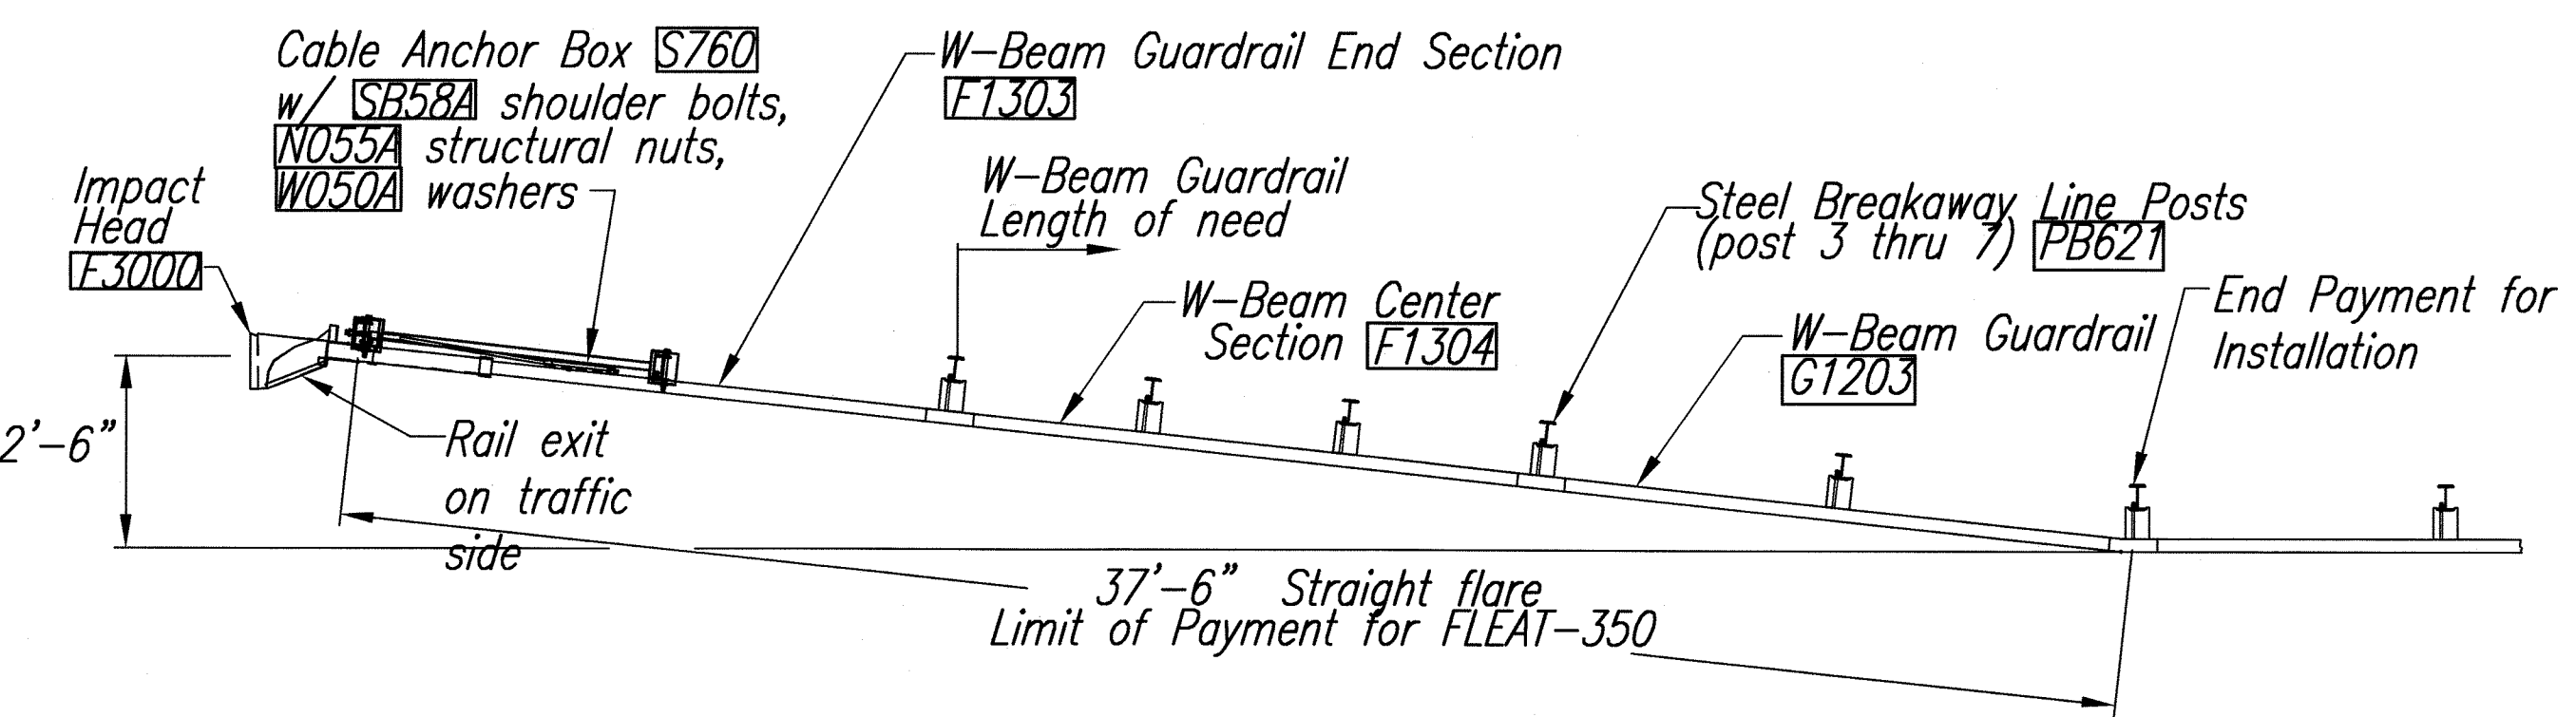


PLAN

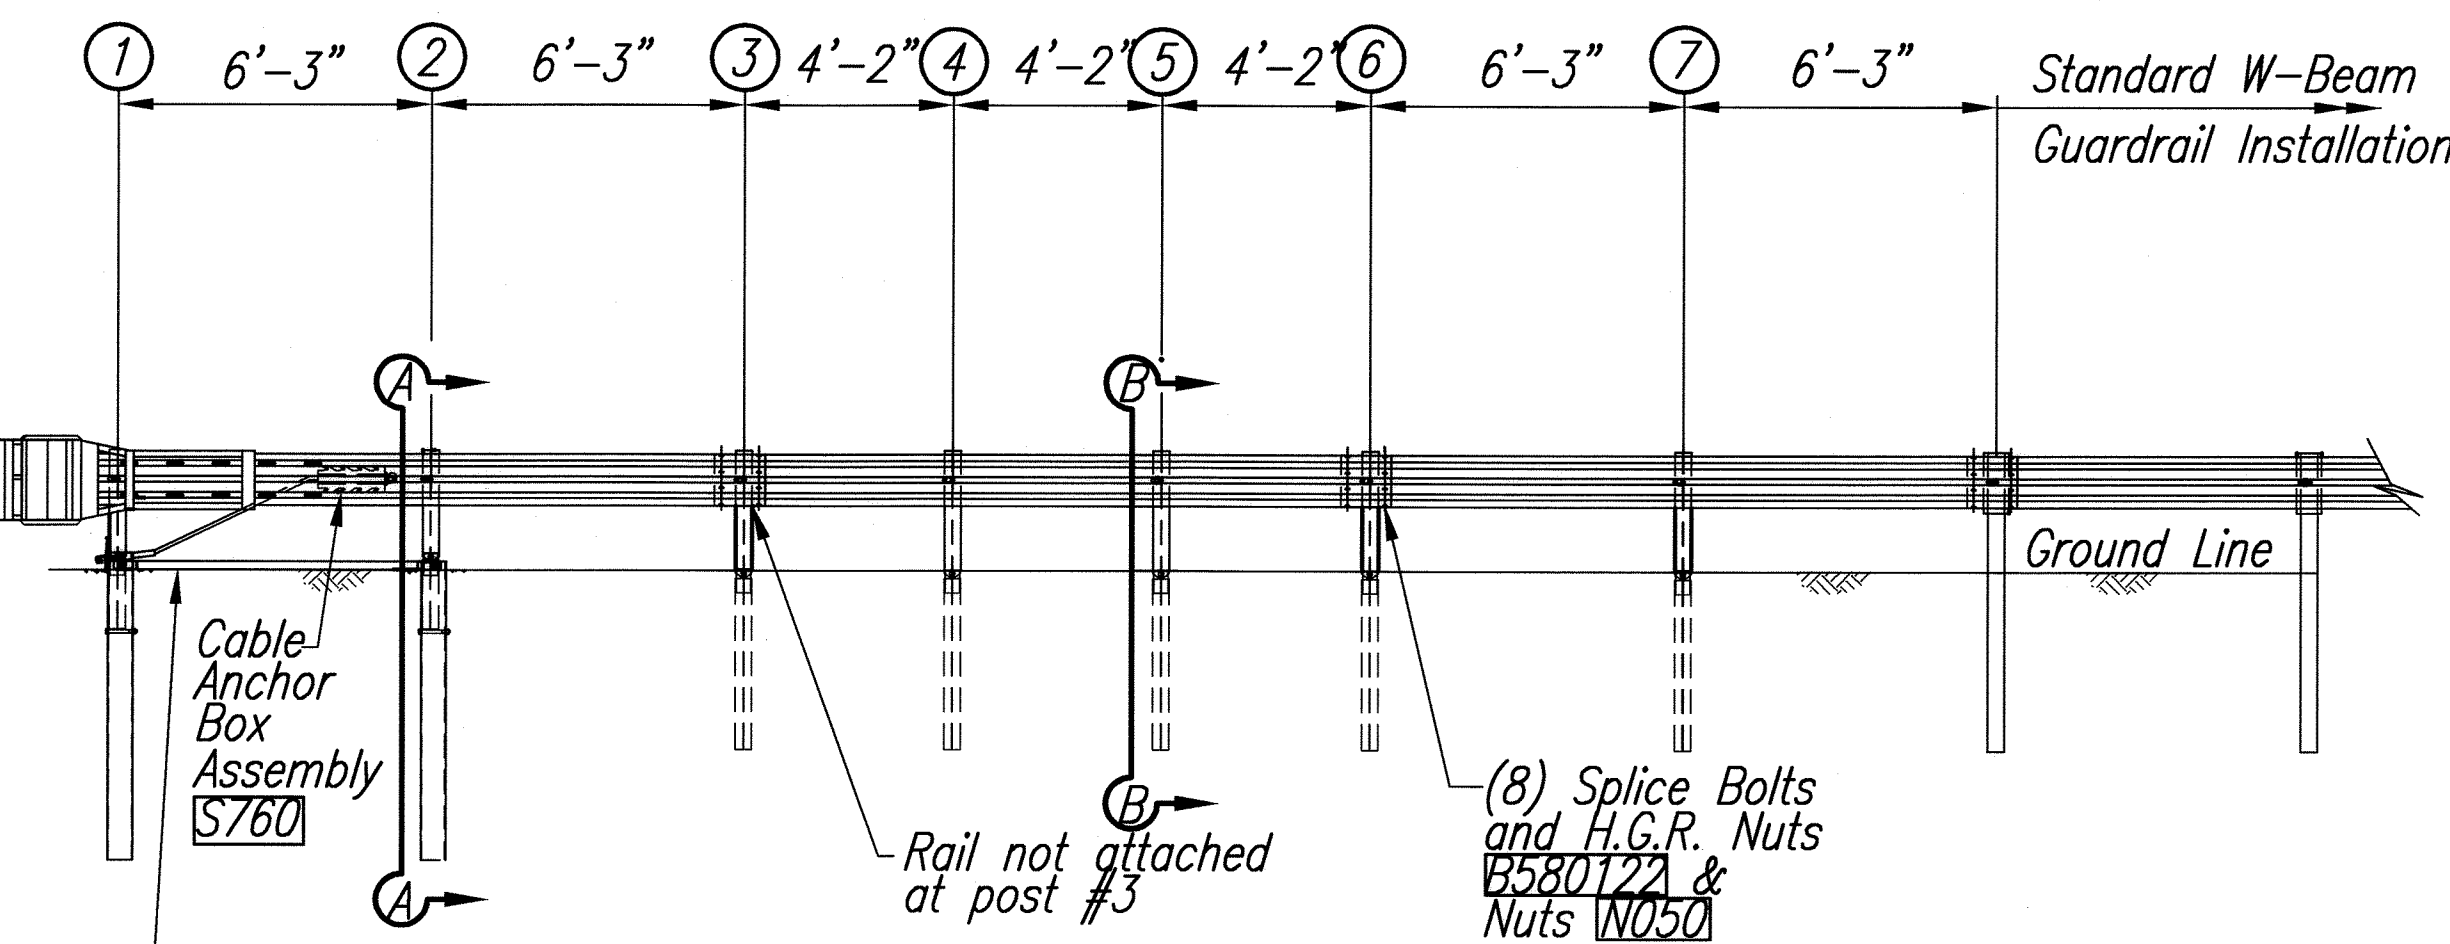


ELEVATION

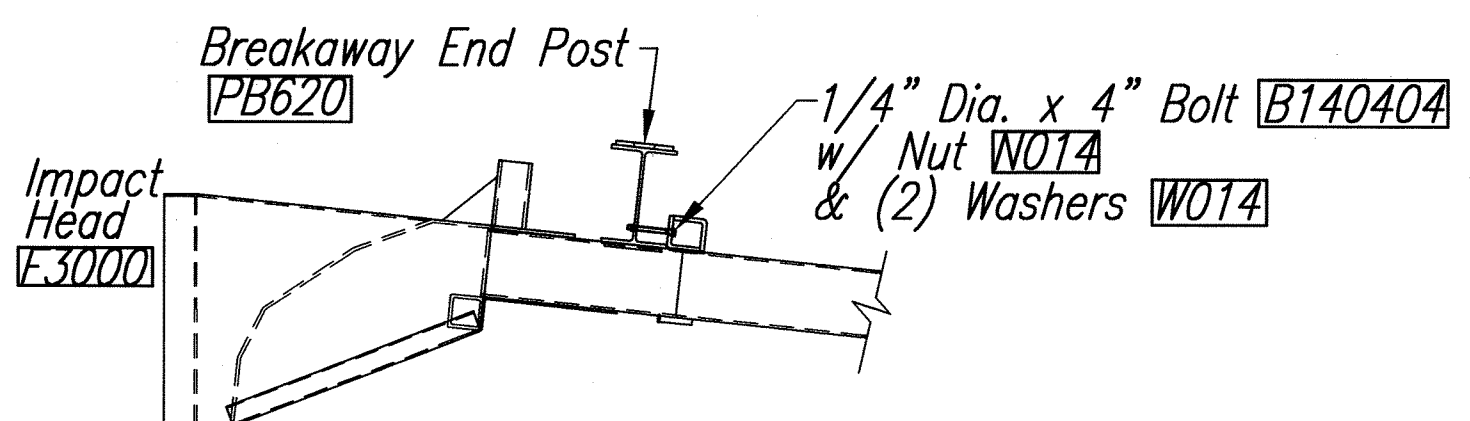


IMPACT HEAD CONNECTING DETAIL

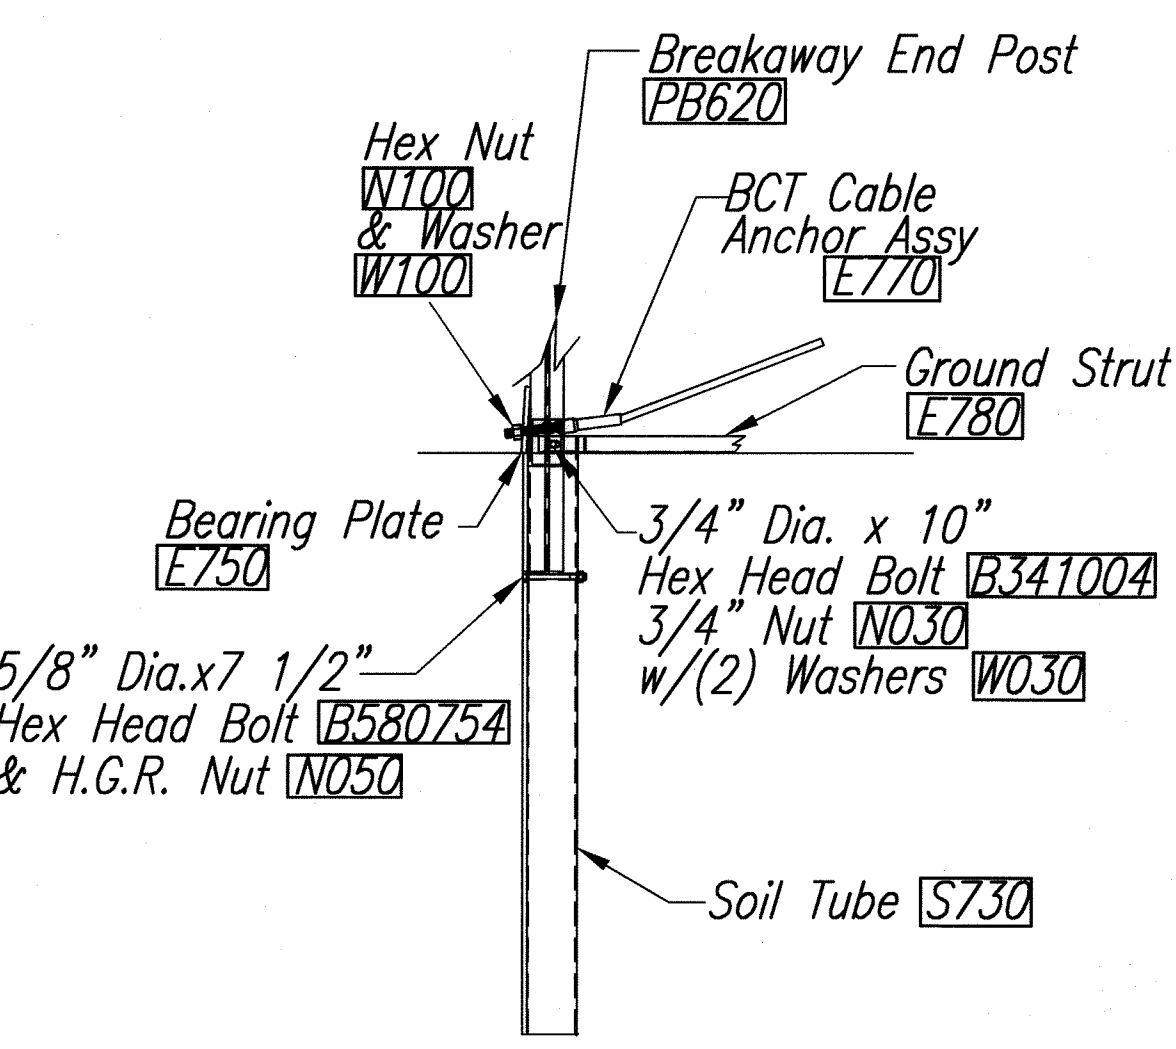


PARTIAL VIEW OF POST 1

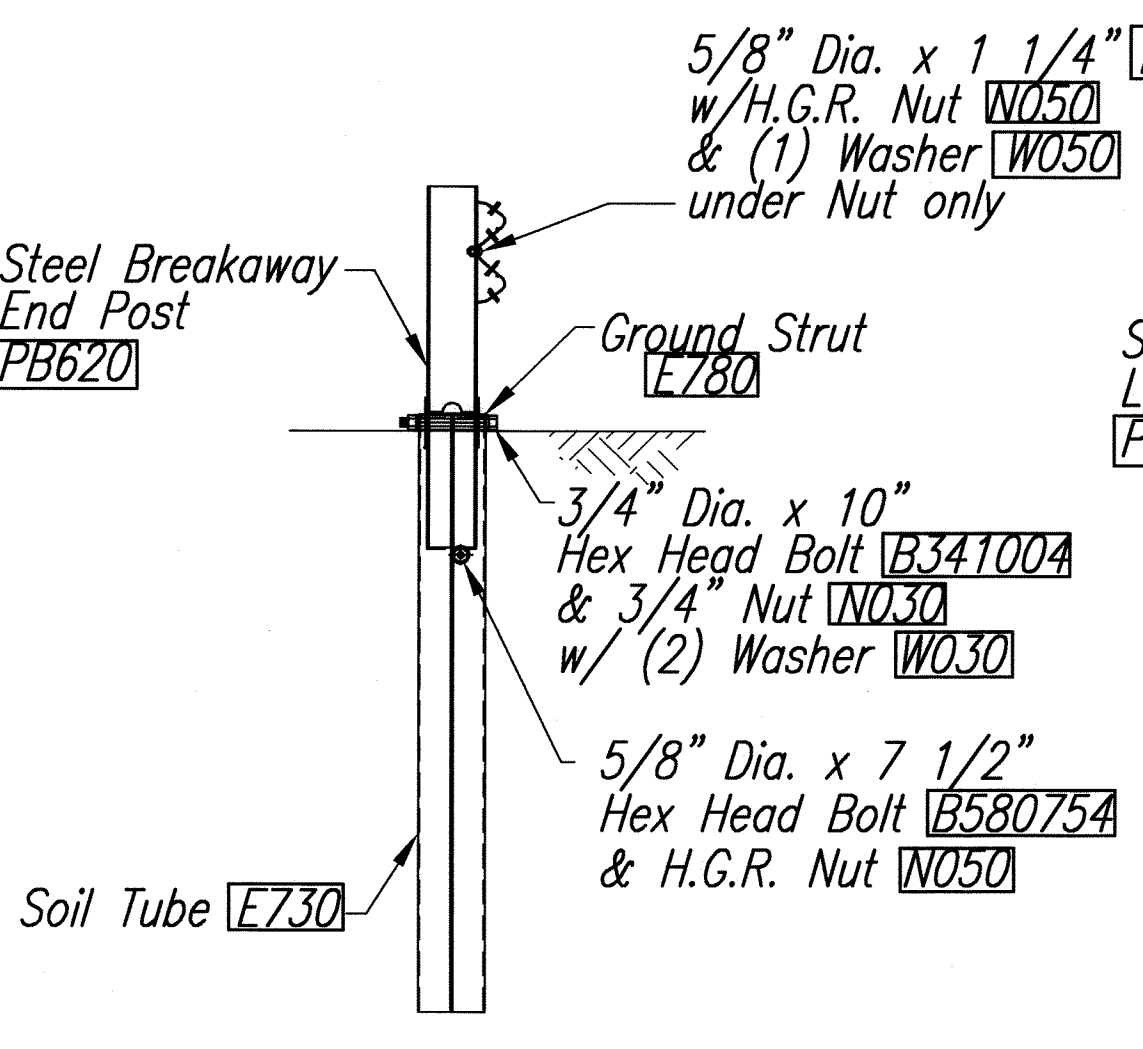


SECTION A-A
(@ Post #2)

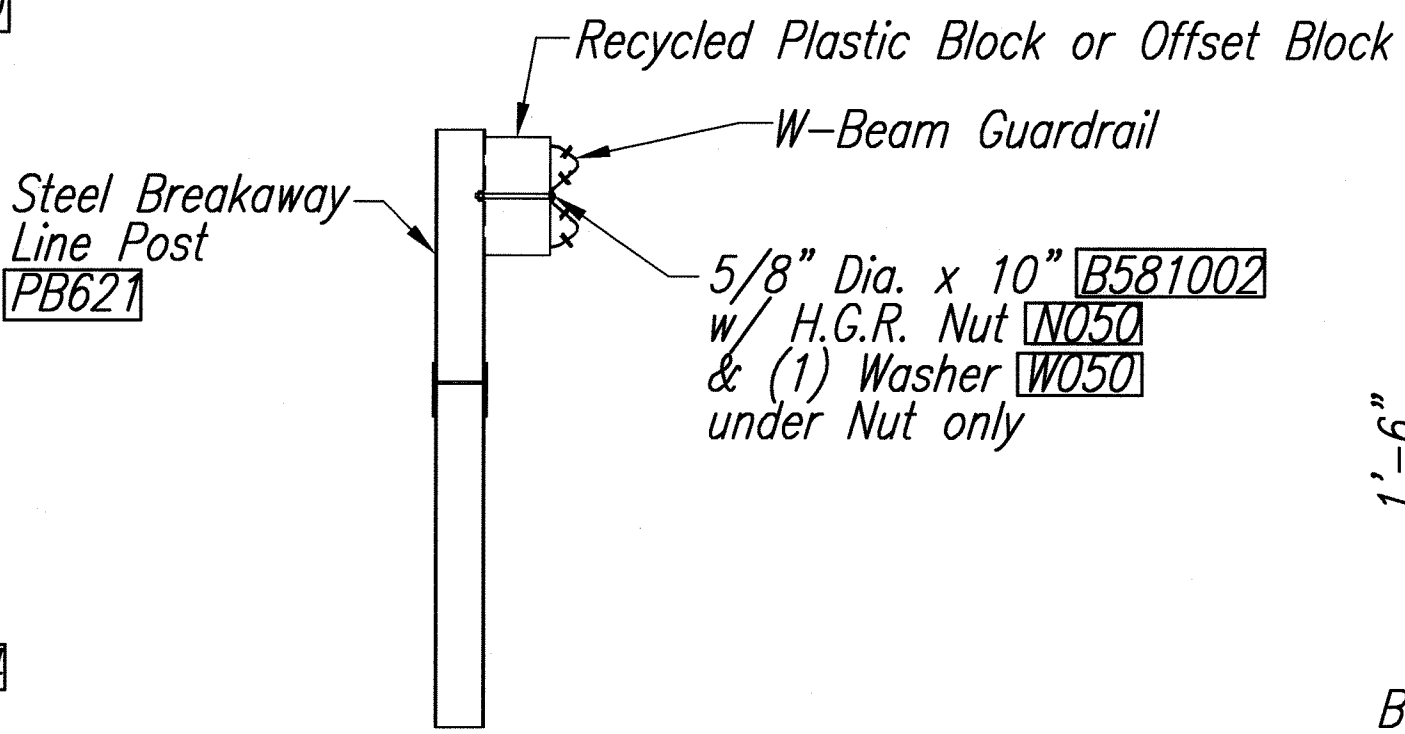

SECTION B-B
(Typical @ Post 3 - 7)
NOTE: RAIL NOT BOLTED @ POST #3

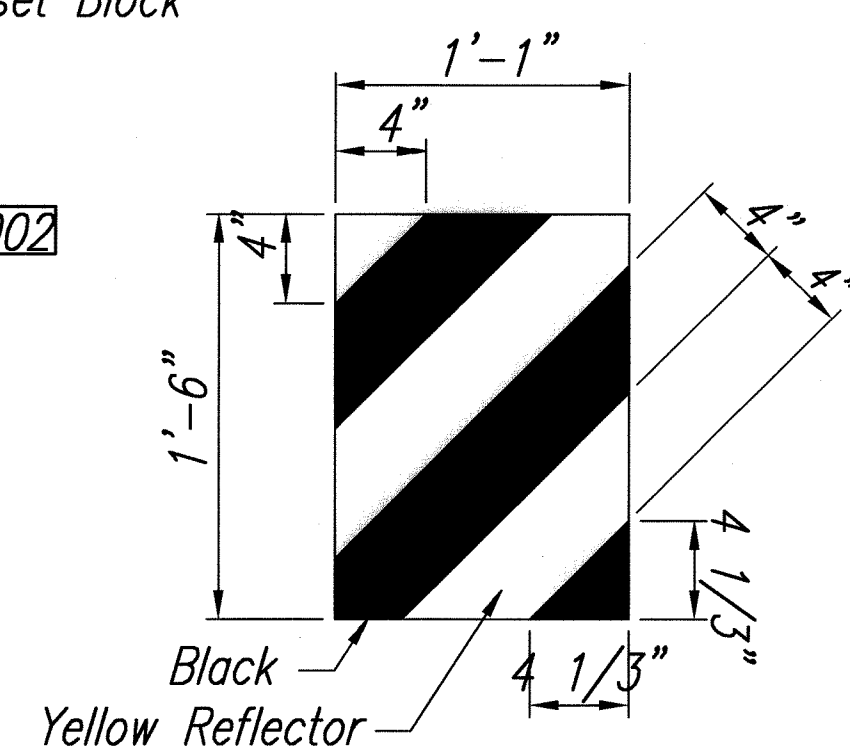

IHRM(R)
IMPACT HEAD REFLECTOR
MARKER INSERT
DETAIL

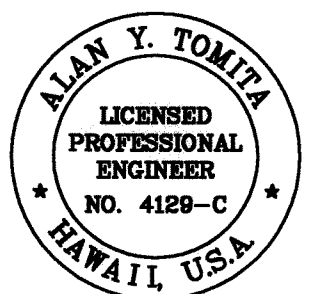

THIS WORK WAS PREPARED BY ME OR UNDER MY SUPERVISION.

Alan Y. Tomita


STATE OF HAWAII
DEPARTMENT OF TRANSPORTATION
HIGHWAYS DIVISION

GUARDRAIL DETAILS

*Honoapiilani Highway Widening
Lahainaluna Road to Aholo Road
Project No. STP-030-1(39)*

Scale: As Shown Date: October 2008

SHEET No. 3 OF 6 SHEETS

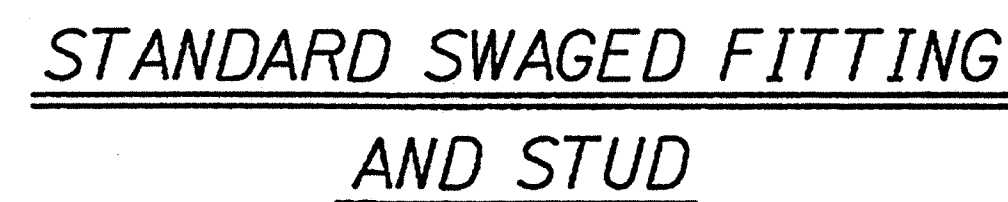194

TYPE "G" FLARE END TERMINAL

During construction, the Contractor shall layout the proposed Type "G" Modified End Terminal and receive approval from the Construction Engineer prior to installation.

1. Concrete, G.R.P., excavation, anchor rod and miscellaneous appurtenances necessary to anchor the guardrail ends shall be incidental to metal guardrail.

THIS WORK WAS PREPARED BY ME
OR UNDER MY SUPERVISION.


SHEET No. 4 OF 6 SHEETS

GENERAL NOTES:









- Breakaway steel posts are required with the Sequential Kinking Terminal.
- All bolts, nuts, cable assemblies, cable anchors and bearing plates shall be galvanized.
- When the Sequential Kinking Terminal is selected as the end treatment for W-beam guardrail installation, the SKT will be flared at a rate of 25d to prevent the impact head from encroaching on the shoulder.
- The soil tube shall not protrude more than 4" above ground (measured along a 5' cord). Site grading may be necessary to meet this requirement.
- The soil tubes may be driven with an approved driving head. They shall not be driven with the post in the tube. If the soil tubes are placed in drilled holes, the backfill material must be satisfactorily compacted to prevent settlement.
- When rock is encountered during excavation, a 12" dia. post hole, 20" deep may be used if approved by the engineer. Granular material will be placed in the bottom of the hole approx. 2 1/2" deep to provide drainage. The soil tubes will be field cut to length, placed in the hole and backfilled with adequately compacted material excavated from the hole.
- The breakaway cable assembly must be taut. A locking device, (vice grips or channel lock pliers) should be used to prevent the cable from twisting when tightening nuts.
- A special site evaluation should be considered prior to using the Sequential Kinking Terminal where there is less than 25' between the outlet side of the Sequential Kinking Terminal and any adjacent driving lane.
- (R) or (L) indicates right or left Impact Head Reflector Marker (IHRM). Providing and installing of IHRM shall be considered incidental to end treatment.
- The stripes for IHRM shall slope downward at an angle of 45° towards the side of the end treatment that traffic is to pass.

ITEM NO.	QTY.	BILL OF MATERIALS		194
S3000	1	IMPACT HEAD		
SI303/ SI305	1	W-BEAM GUARDRAIL END SECTION	12 ga. 12.5' or 25'	
G1203	1/0	W-BEAM GUARDRAIL, 12 GA., 12.5'		
S730	2	*FOUNDATION SOIL TUBE, 6" X 8" X 6'-0"		
E750	1	BEARING PLATE		
S760	1	CABLE ANCHOR BOX		
E770	1	BCT CABLE ANCHOR ASSEMBLY		
E780	1	GROUND STRUT		
PB620	2	BREAKAWAY END POST		
PB621	3	BREAKAWAY LINE POST		
	3	RECYCLED PLASTIC BLOCKOUTS OR OFFSET BLOCKS		
	1	IMPACT HEAD REFLECTOR MARKER - IHRM(R) OR (L)		
		HARDWARE		
B580122	9/17	5/8" Dia. x 1 1/4" SPLICE BOLT, POST 2		
B580754	2	5/8" Dia. x 7 1/2" HEX BOLT		
B341004	2	3/4" Dia. x 10" HEX BOLTS		
B581002	3	5/8" Dia. x 10" H.G.R. BOLT (POSTS 3 THRU 5)		
N050	14/22	5/8" Dia. H.G.R. NUT (SPLICE 8/16, SOIL TUBES 2, POSTS 2 THRU 5,4)		
N030	2	3/4" Dia. HEX NUT		
W050	4	H.G.R. WASHER		
W030	4	3/4" ID WASHER		
N100	2	1" ANCHOR CABLE HEX NUT		
W100	2	1" ANCHOR CABLE WASHER		
B140404	2	1/4" x 4" HEX BOLT		
N014	2	1/4" HEX NUT		
W014	4	1/4" WASHER		
SB58A	8	CABLE ANCHOR BOX SHOULDER BOLT		
N055A	8	1/2" A325 STRUCTURAL NUT		
W050A	16	1 1/16" OD X 9/16" ID A325 STR. WASHER		

Foundation Tube Options For Posts 1 & 2:
 *6'-0" Split Foundation Tube S730
 *6'-0" Solid Foundation Tube E731
 *5'-0" Foundation Tube S735 w/Soil Plate SP600
 *4'-6" Foundation Tube E735 w/Soil Plate SP600

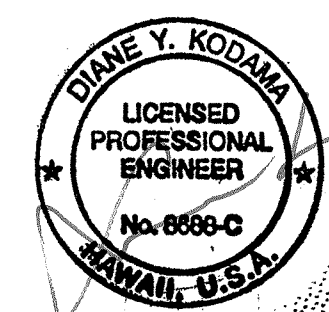


STATE OF HAWAII
 DEPARTMENT OF TRANSPORTATION
 HIGHWAYS DIVISION
SKT-S-TL2-2
SEQUENTIAL KINKING TERMINAL
 Honoapiʻilani Highway Widening
 Lahaina Road to Ahole Road
 Project No. STP-030-1(39)
 Scale: As Shown
 Date: February 2008
 SHEET No. 5 OF 6 SHEETS

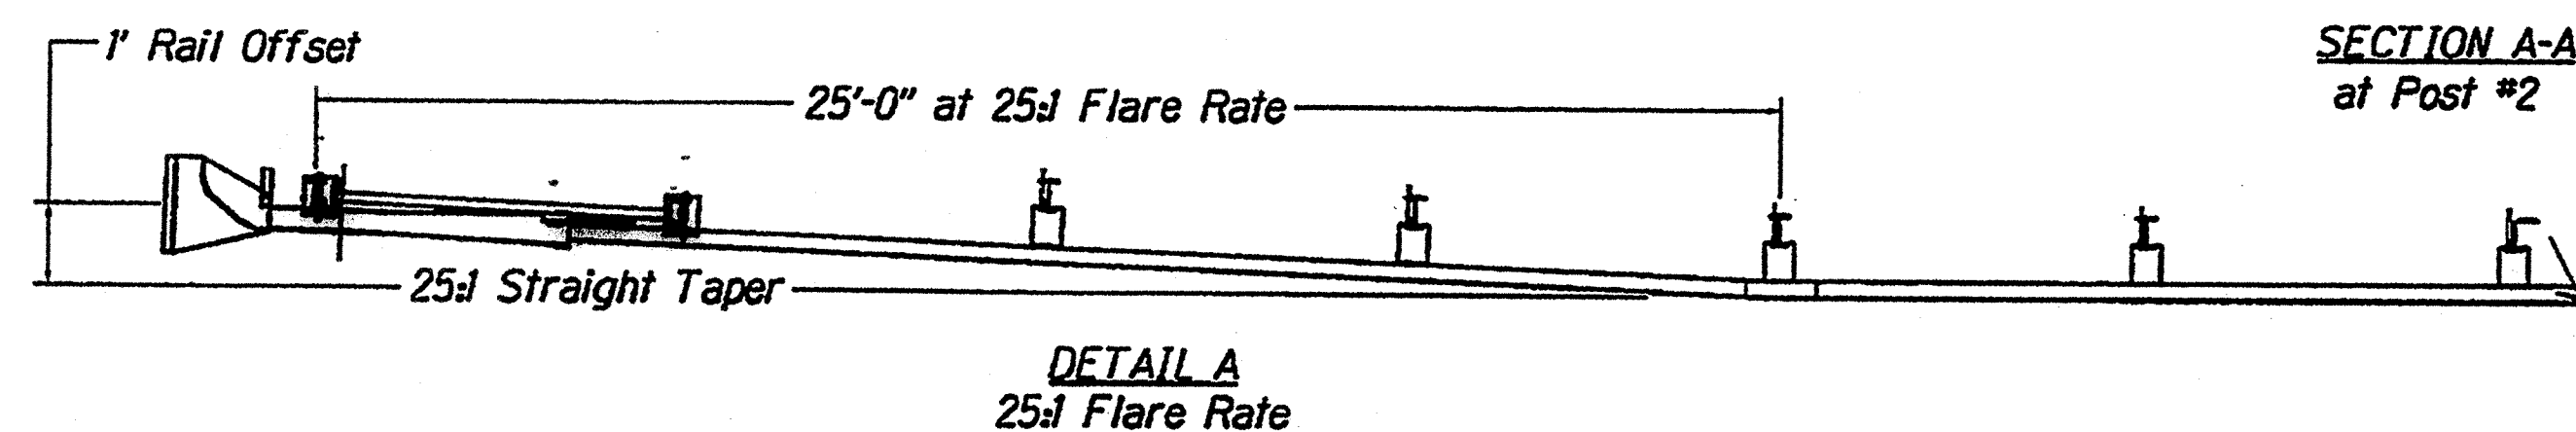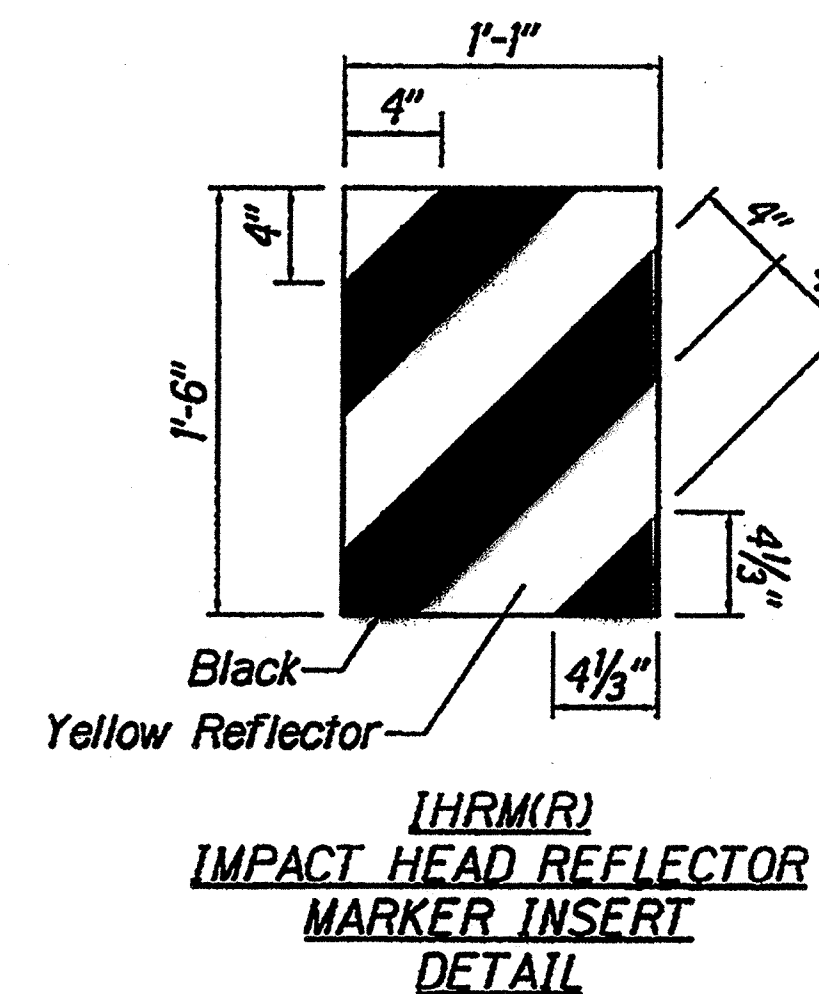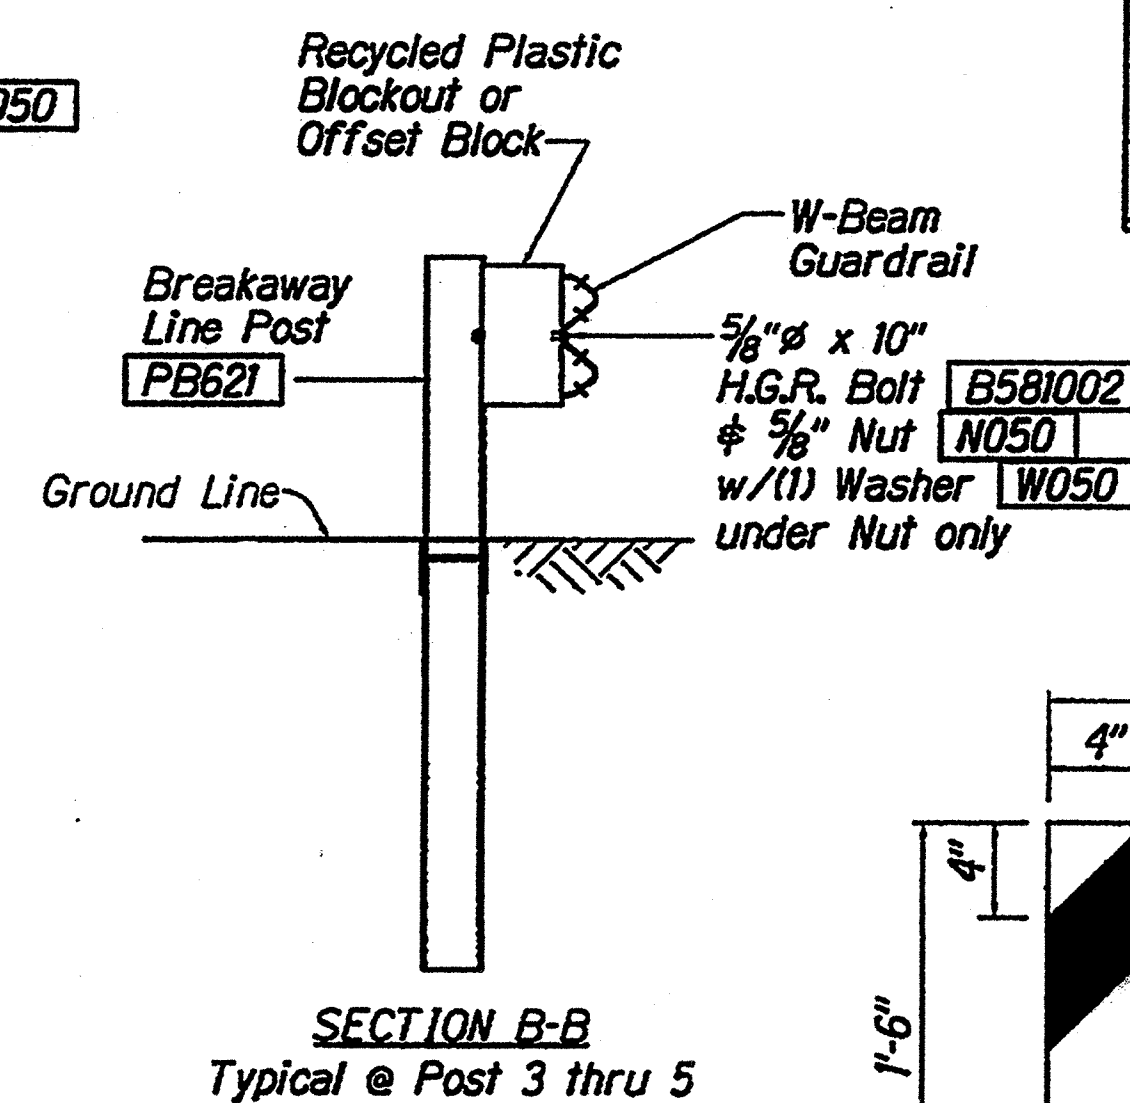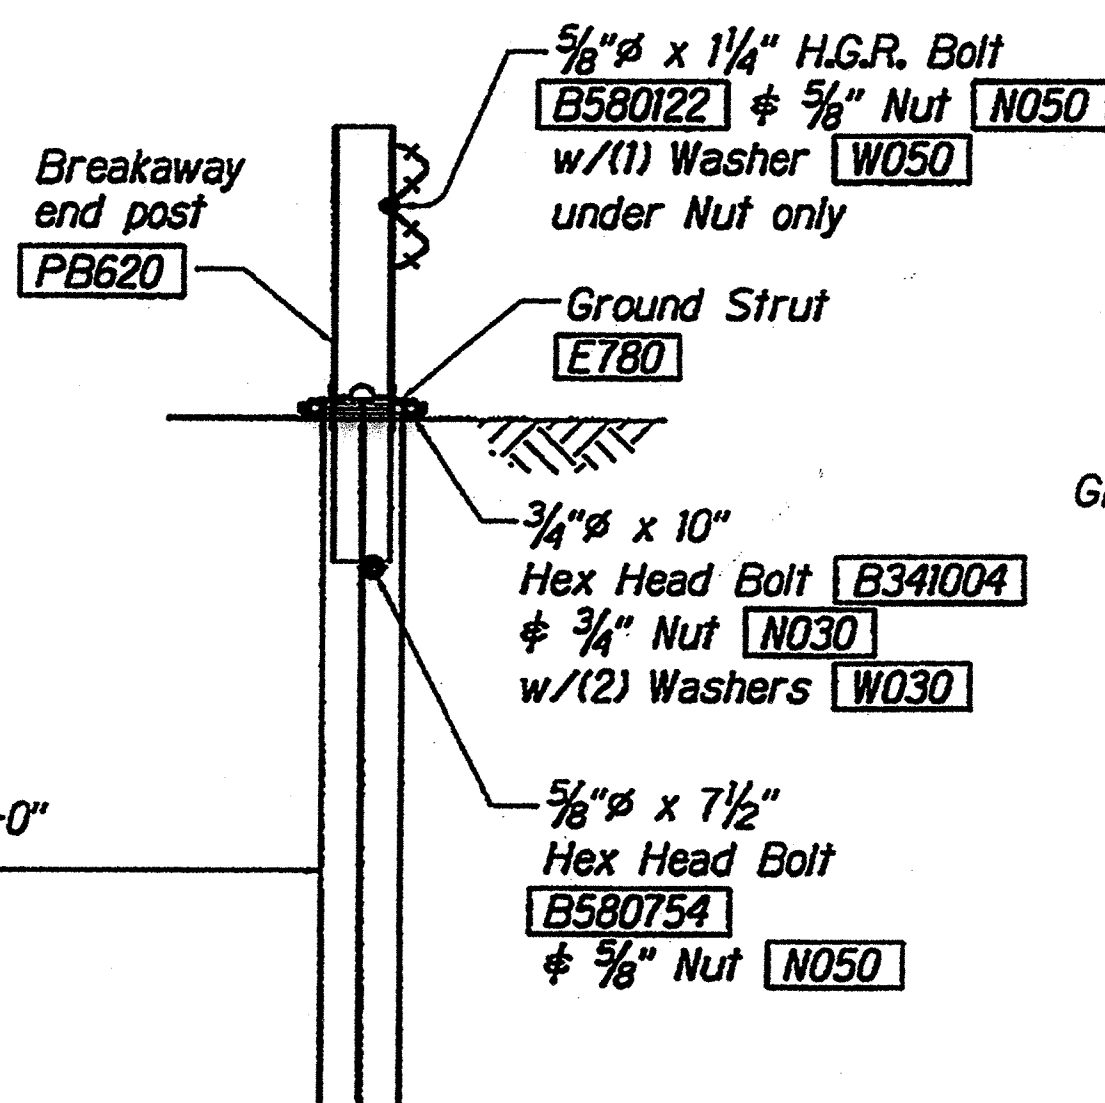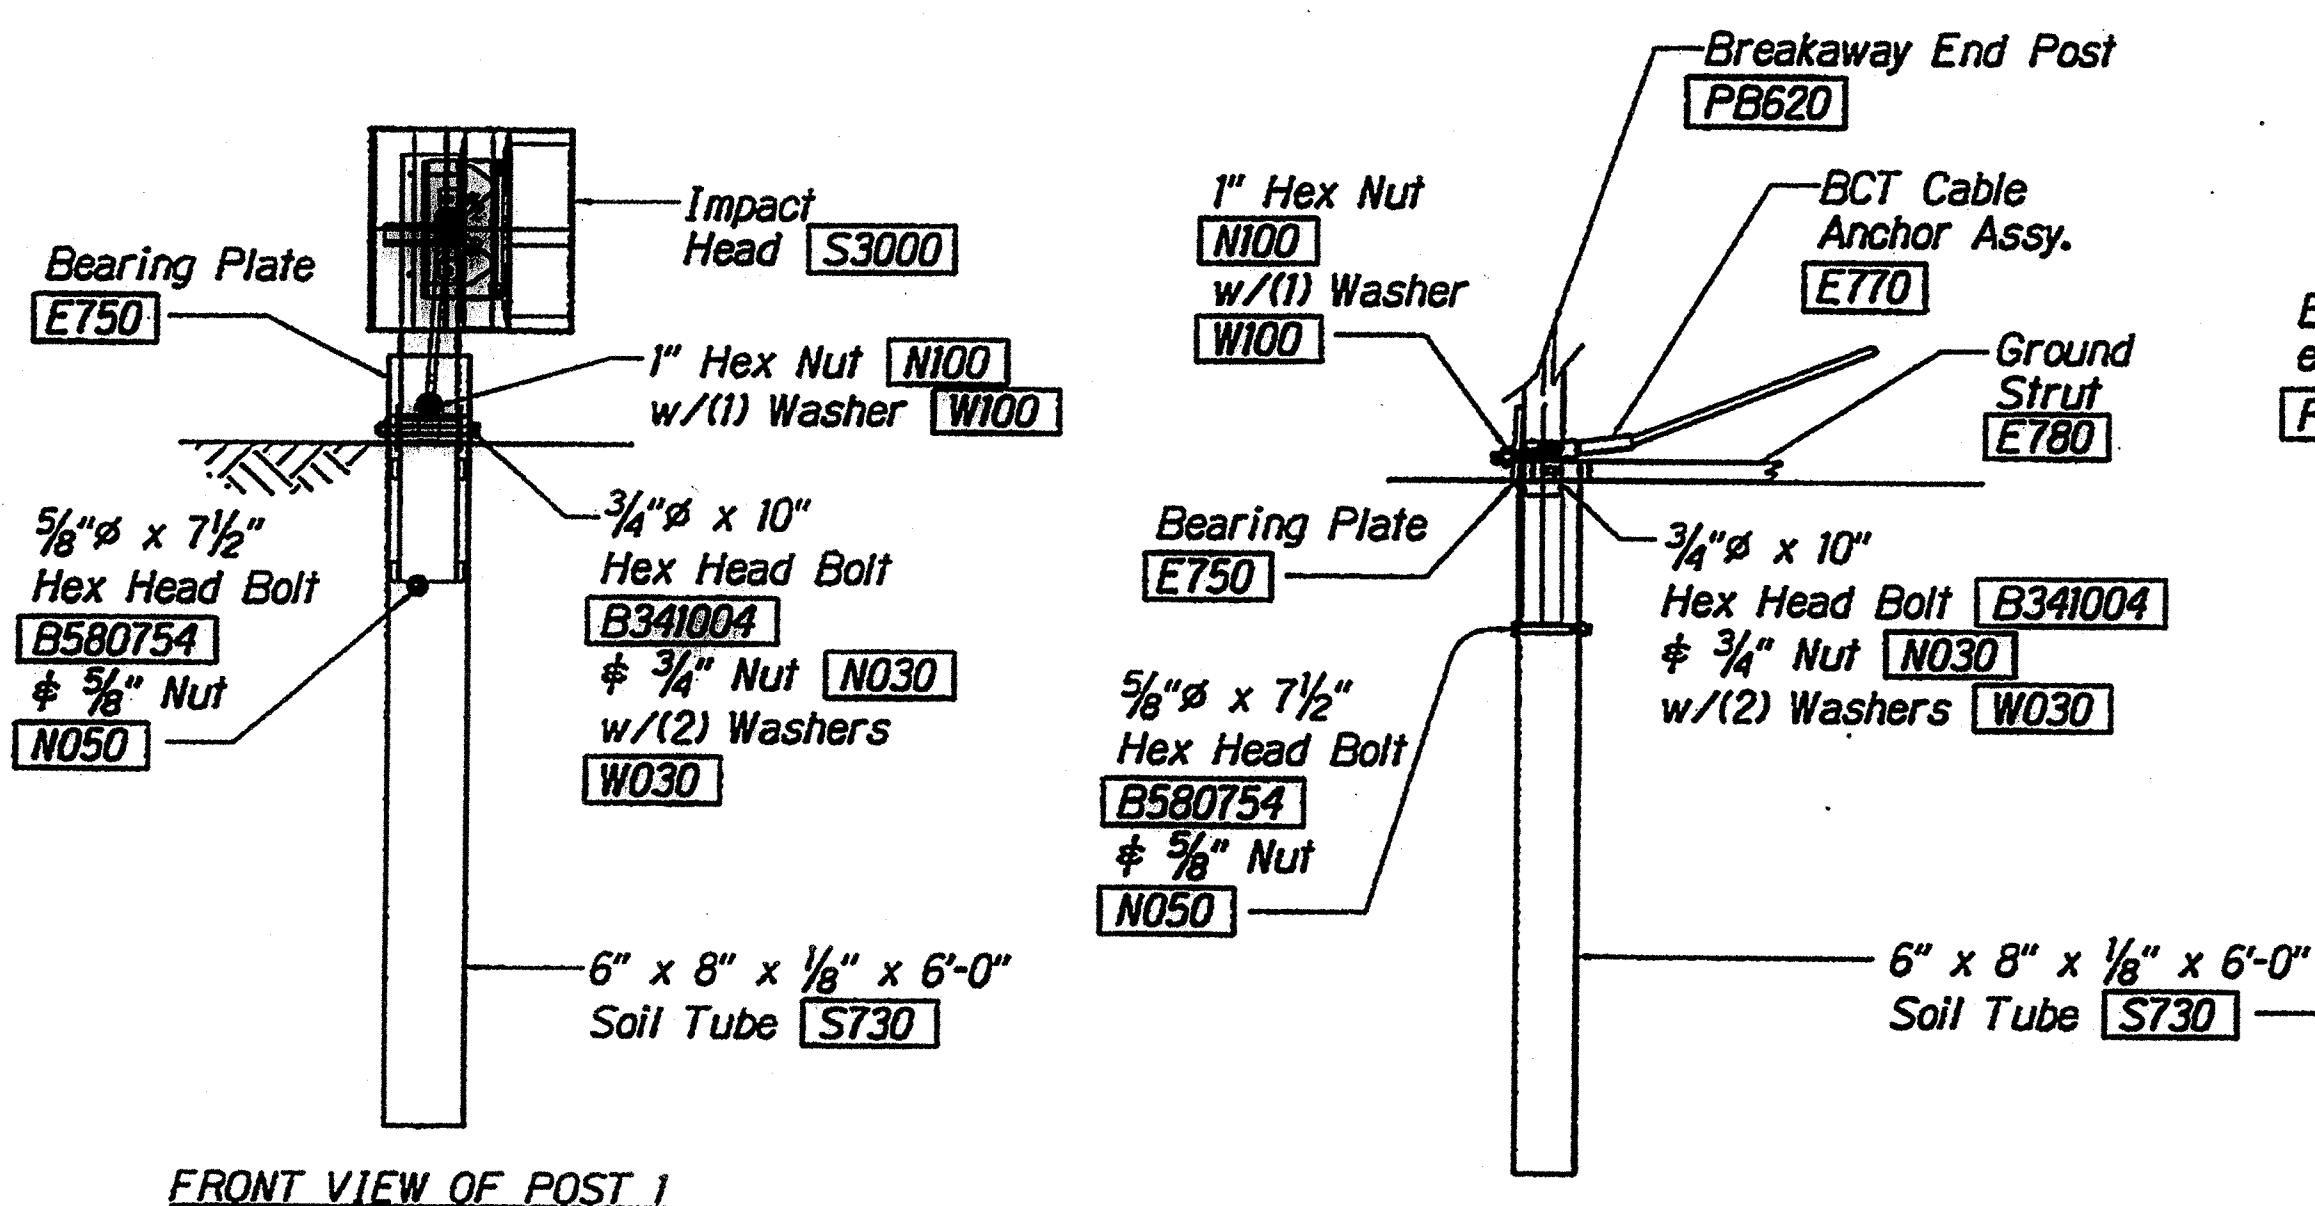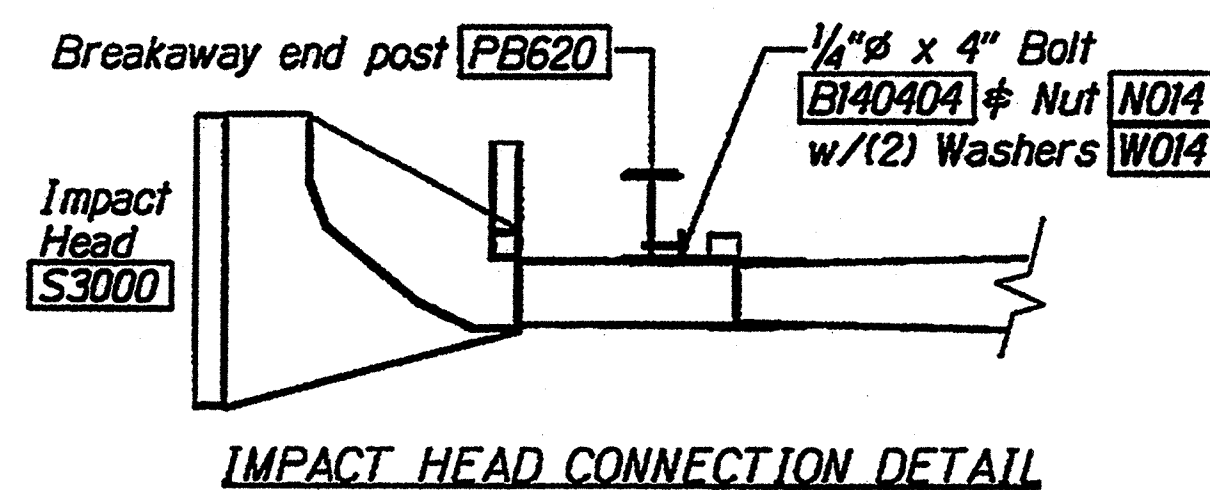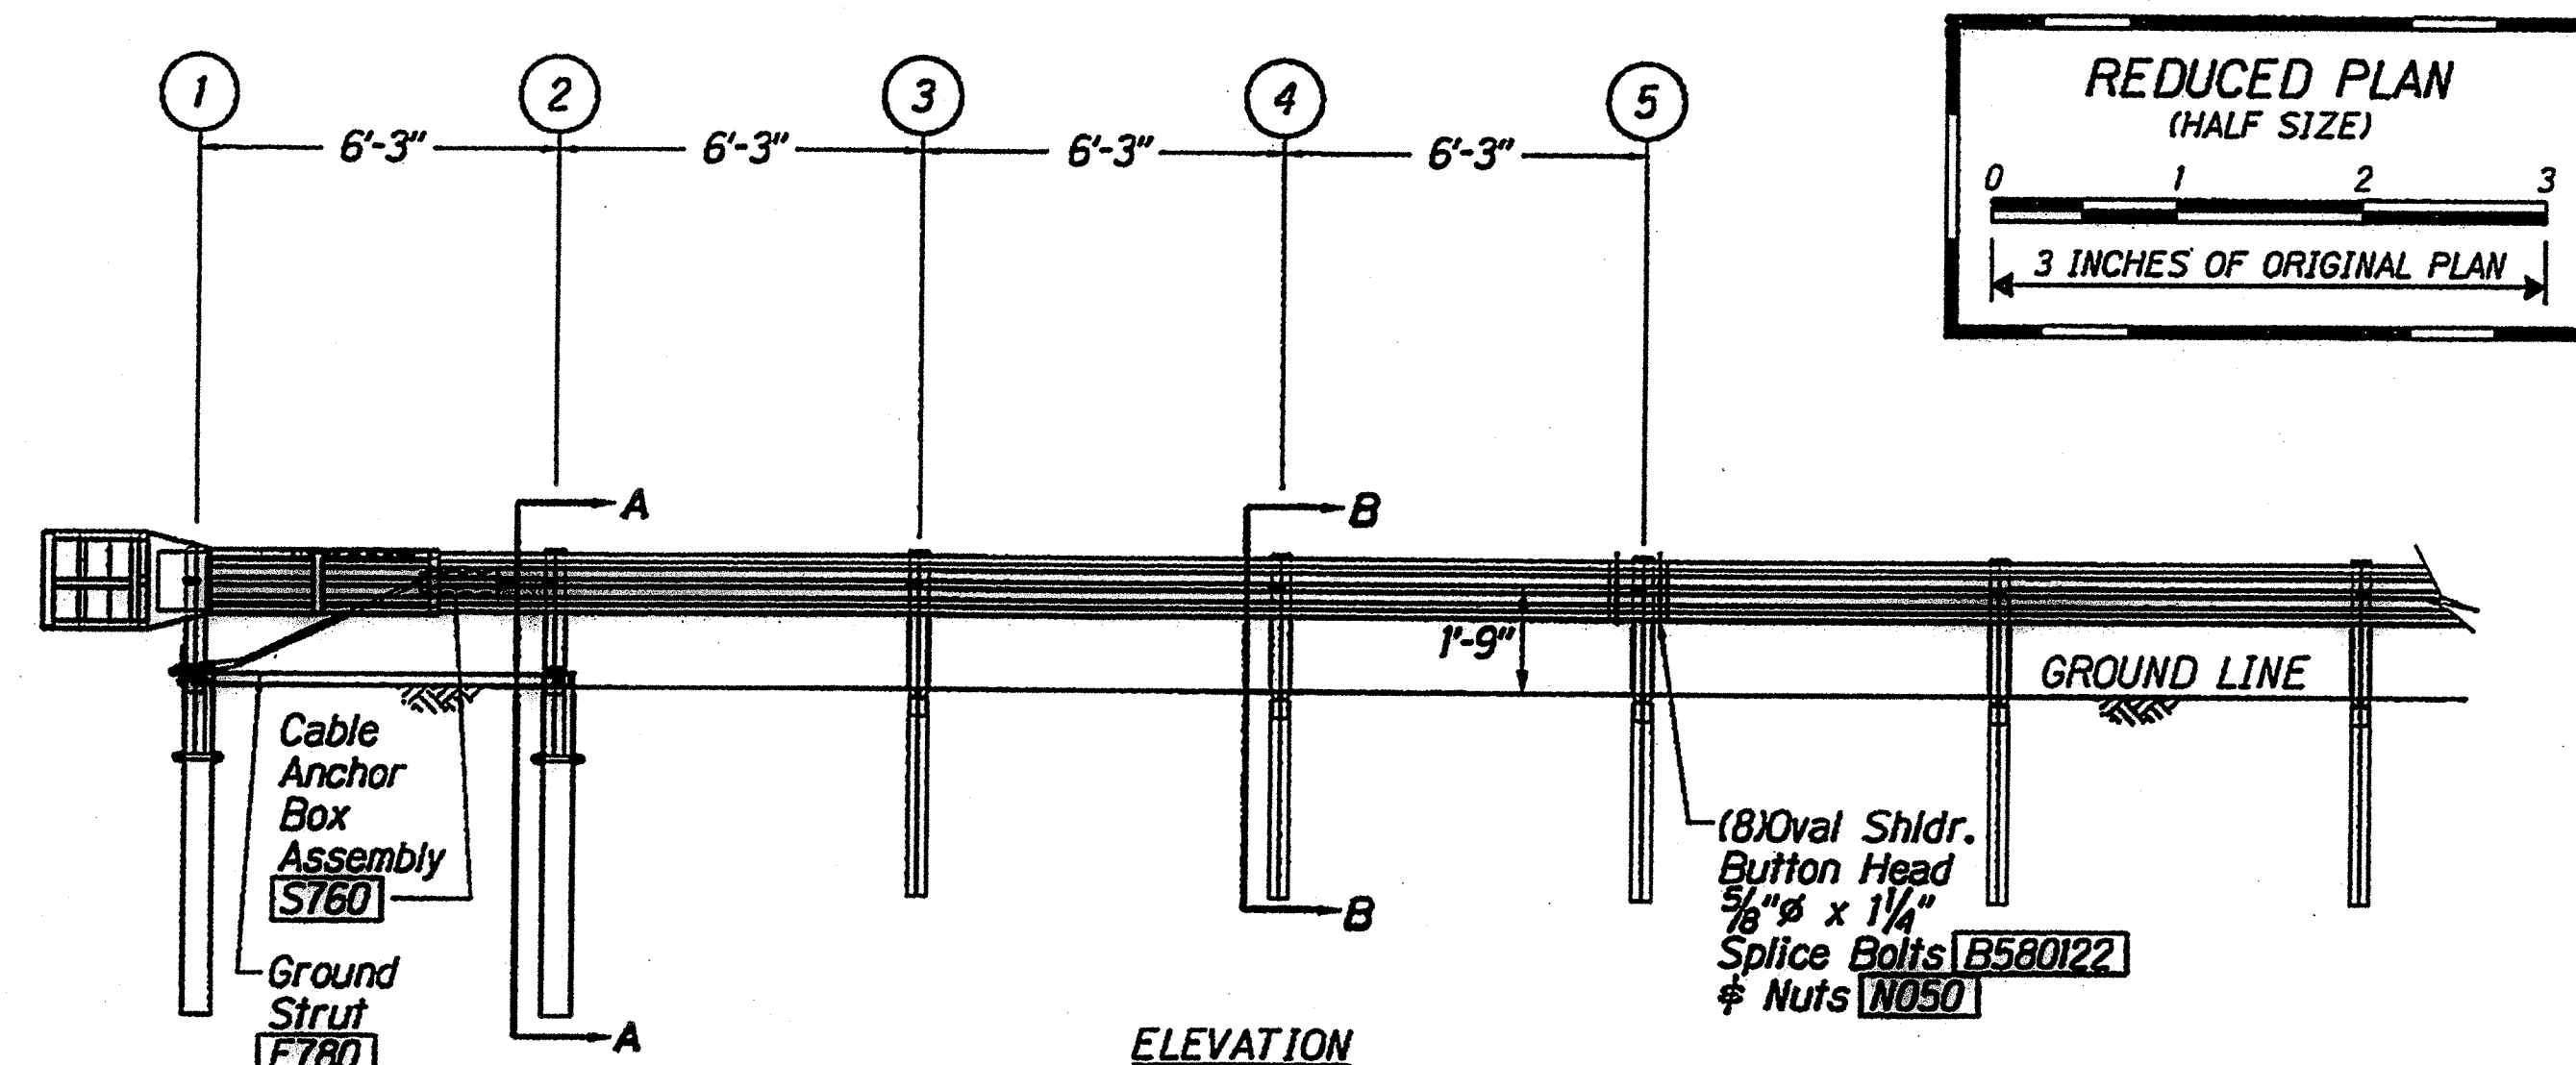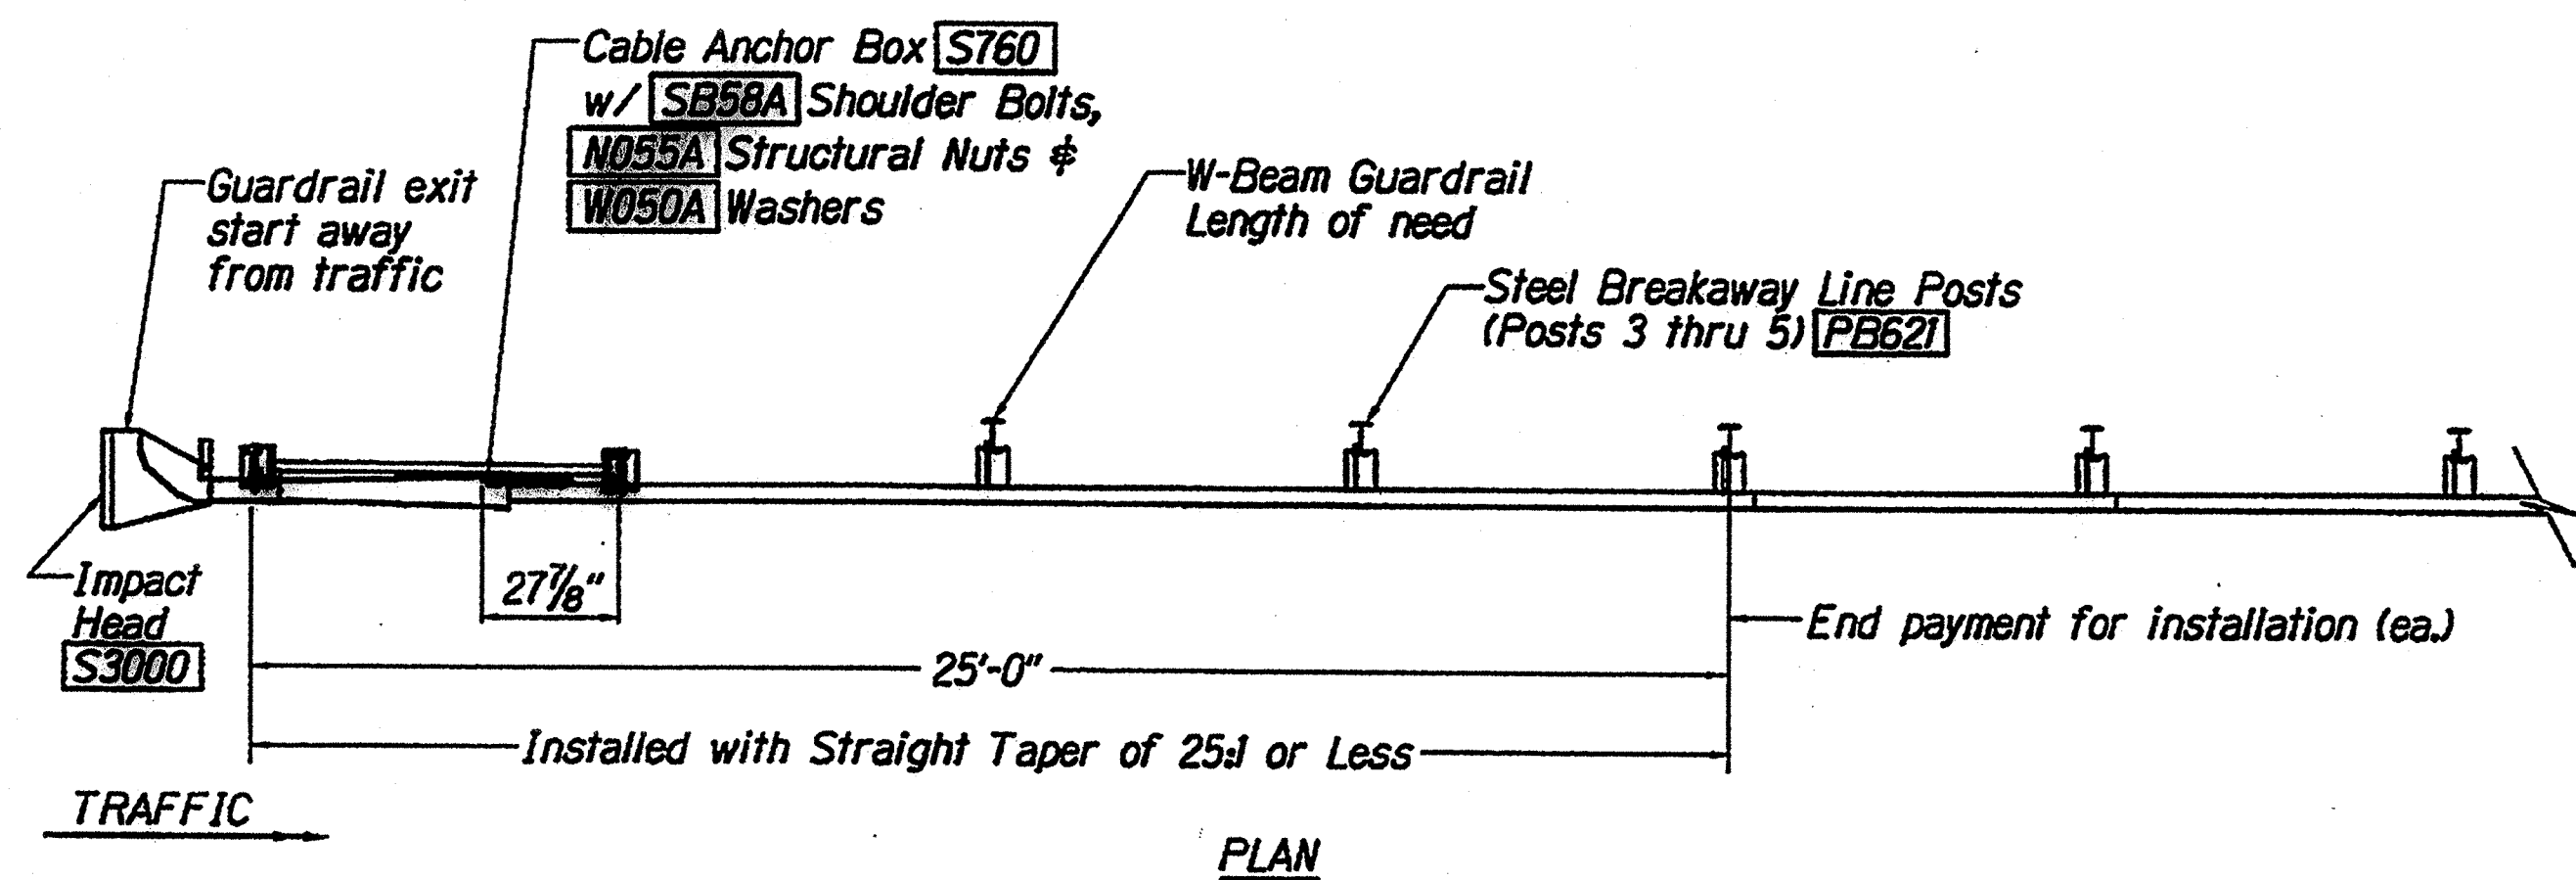




3/28/08
 TEL: 808/541-2100
 FAX: 808/541-2101
 E-MAIL: 808/541-2102
 WWW: 808/541-2103

FED. ROAD DIST. NO.	STATE	PROJ. NO.	FISCAL YEAR	SHEET NO.	TOTAL SHEETS
HAWAII	HAW.	STP-030-1(39)	2008	78	195

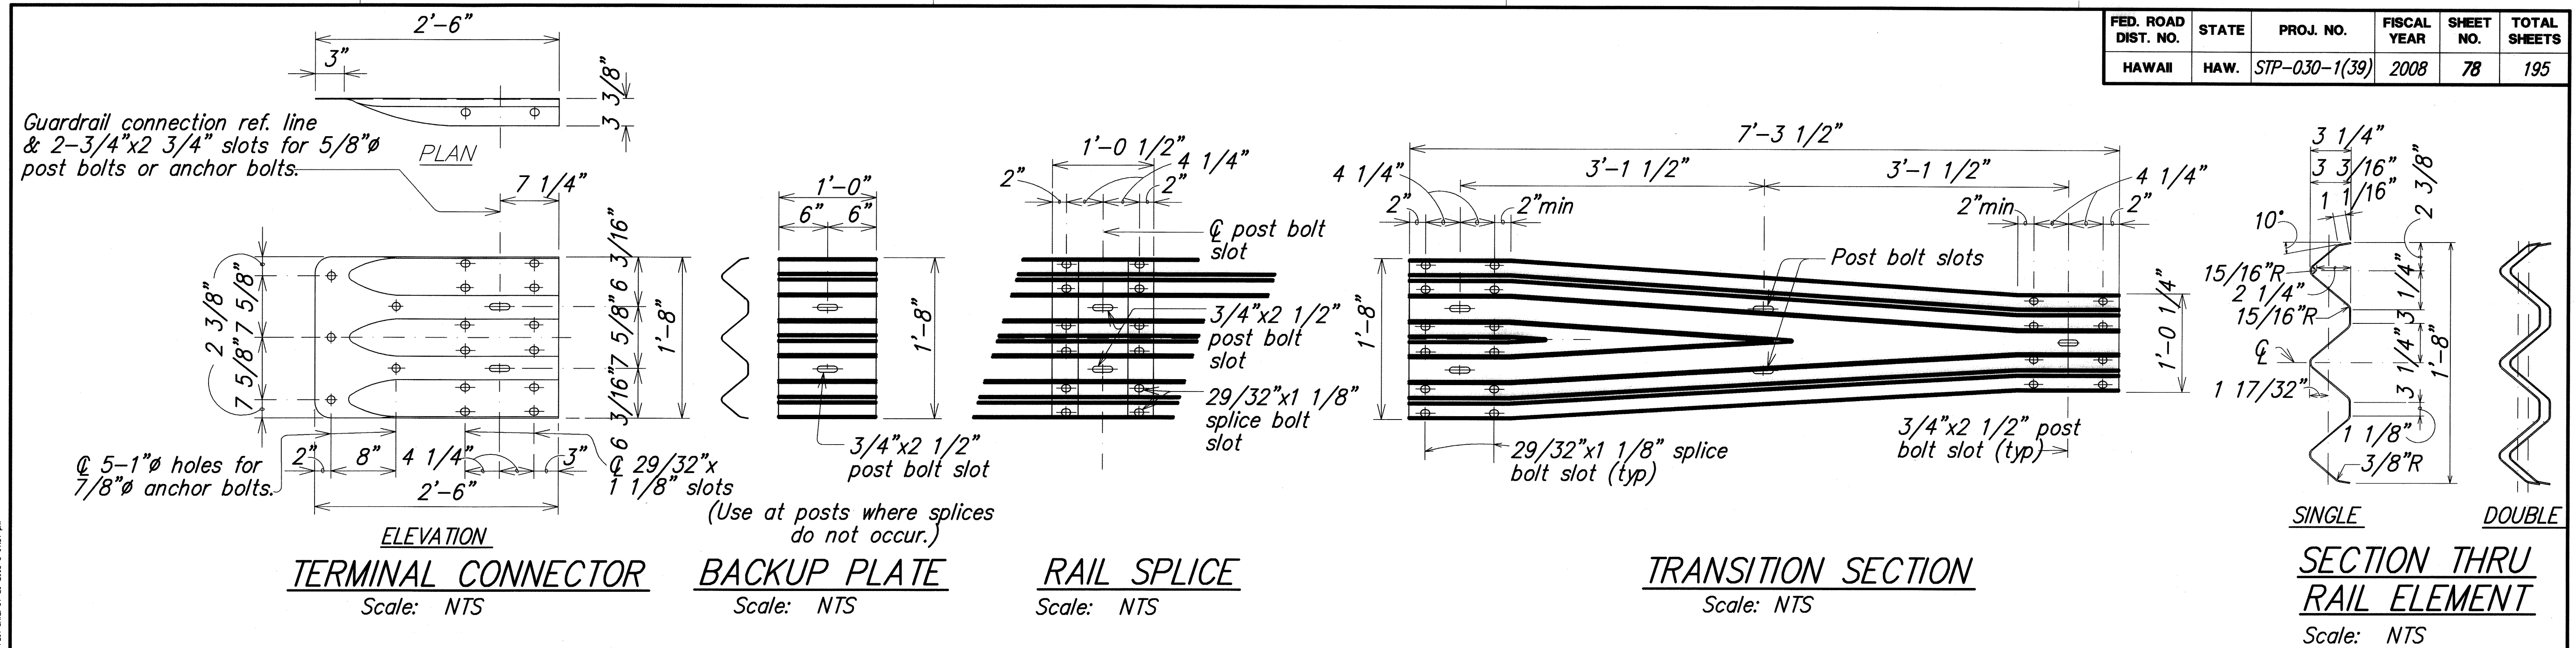


NOTES:

- A. The work necessary to connect guardrail to concrete end post shall include all labor, materials, tools, equipment and incidentals necessary to complete the work and will not be paid for separately.
- B. Lap terminal connector and rail element in direction of traffic to prevent snagging.
- C. All anchor bolts shall be high strength bolts conforming to the requirements of ASTM 325 and Standard Specification, Section 713.04.
- D. Anchor bolt length shall be such that a snug fit of the elements and full thread engagement plus 1/4" (max) is attained.
- E. "Terminal Connector", "Transition Section" and thrie beam shall be fabricated from 10gauge steel conforming to the requirements of AASHTO M 180, Type II, Class B.
- F. "Terminal Connector" and standard spacer, including all anchor bolts, cap PL, nuts and washers, shall be hot-dip galvanized after fabrication.
- G. Cap PL shall be fabricated from ASTM A 36.
- H. First 25'-0" of guardrail adjoining "Terminal Connector" shall be galvanized steel and supports spaced as shown on the detail drawings. This section of rail shall be placed on tangent to end post or parallel to roadway, unless conditions at site renders it impossible to do so. Flare point to be determined in field.
- I. Double (nest 1st panel) thrie beam elements at all end post connections, except on highways with one-way traffic pattern, use single thrie beam elements at end post on trailing end only.
- J. Where double (nested) beam occur, 12" "Back-up Plate" not required.
- K. Heads of through anchor bolts shall be placed on the traffic side of the rail.
- L. All steel shapes, rails and plates shall conform to ASTM A 36 specifications.

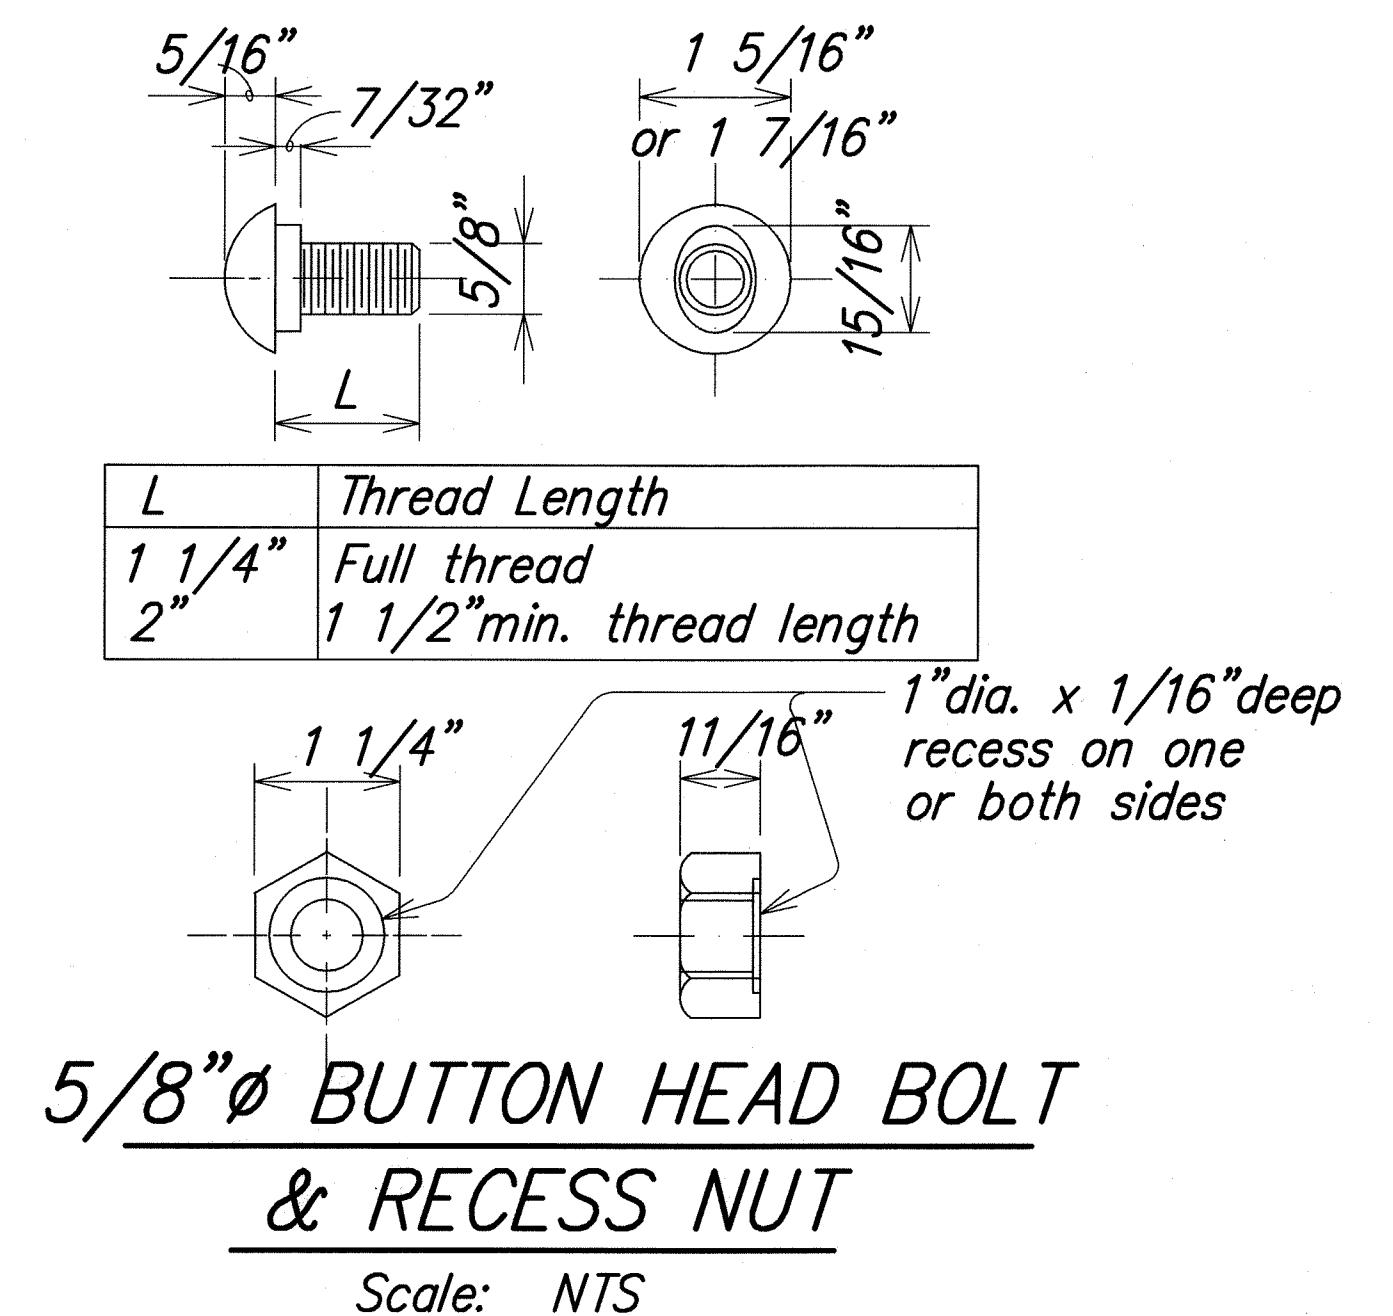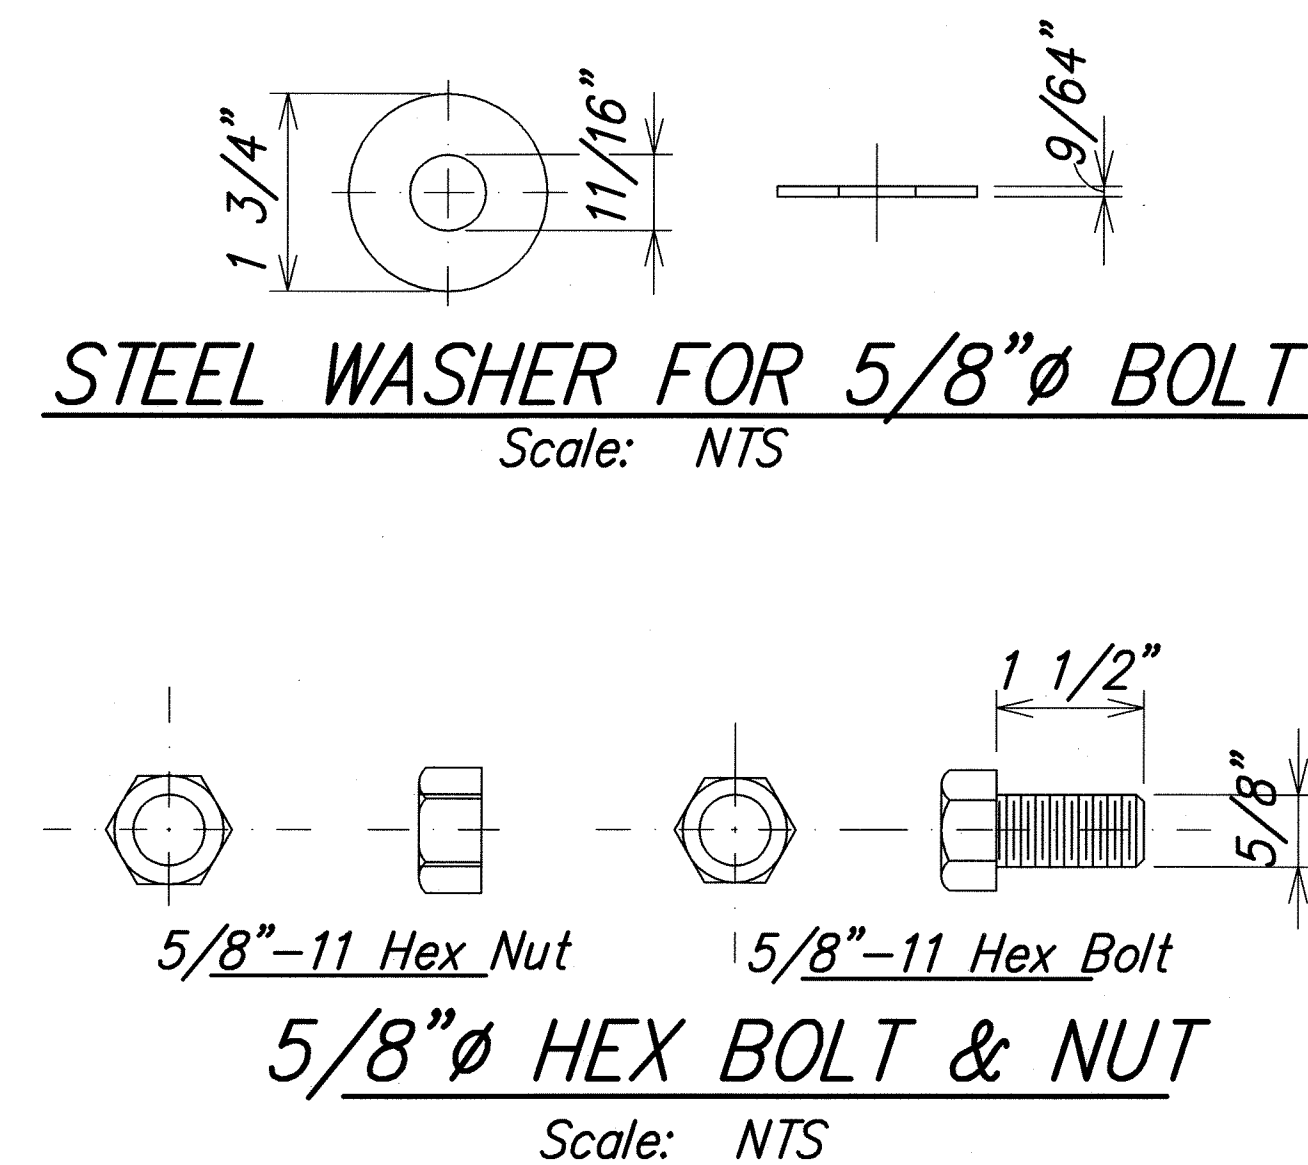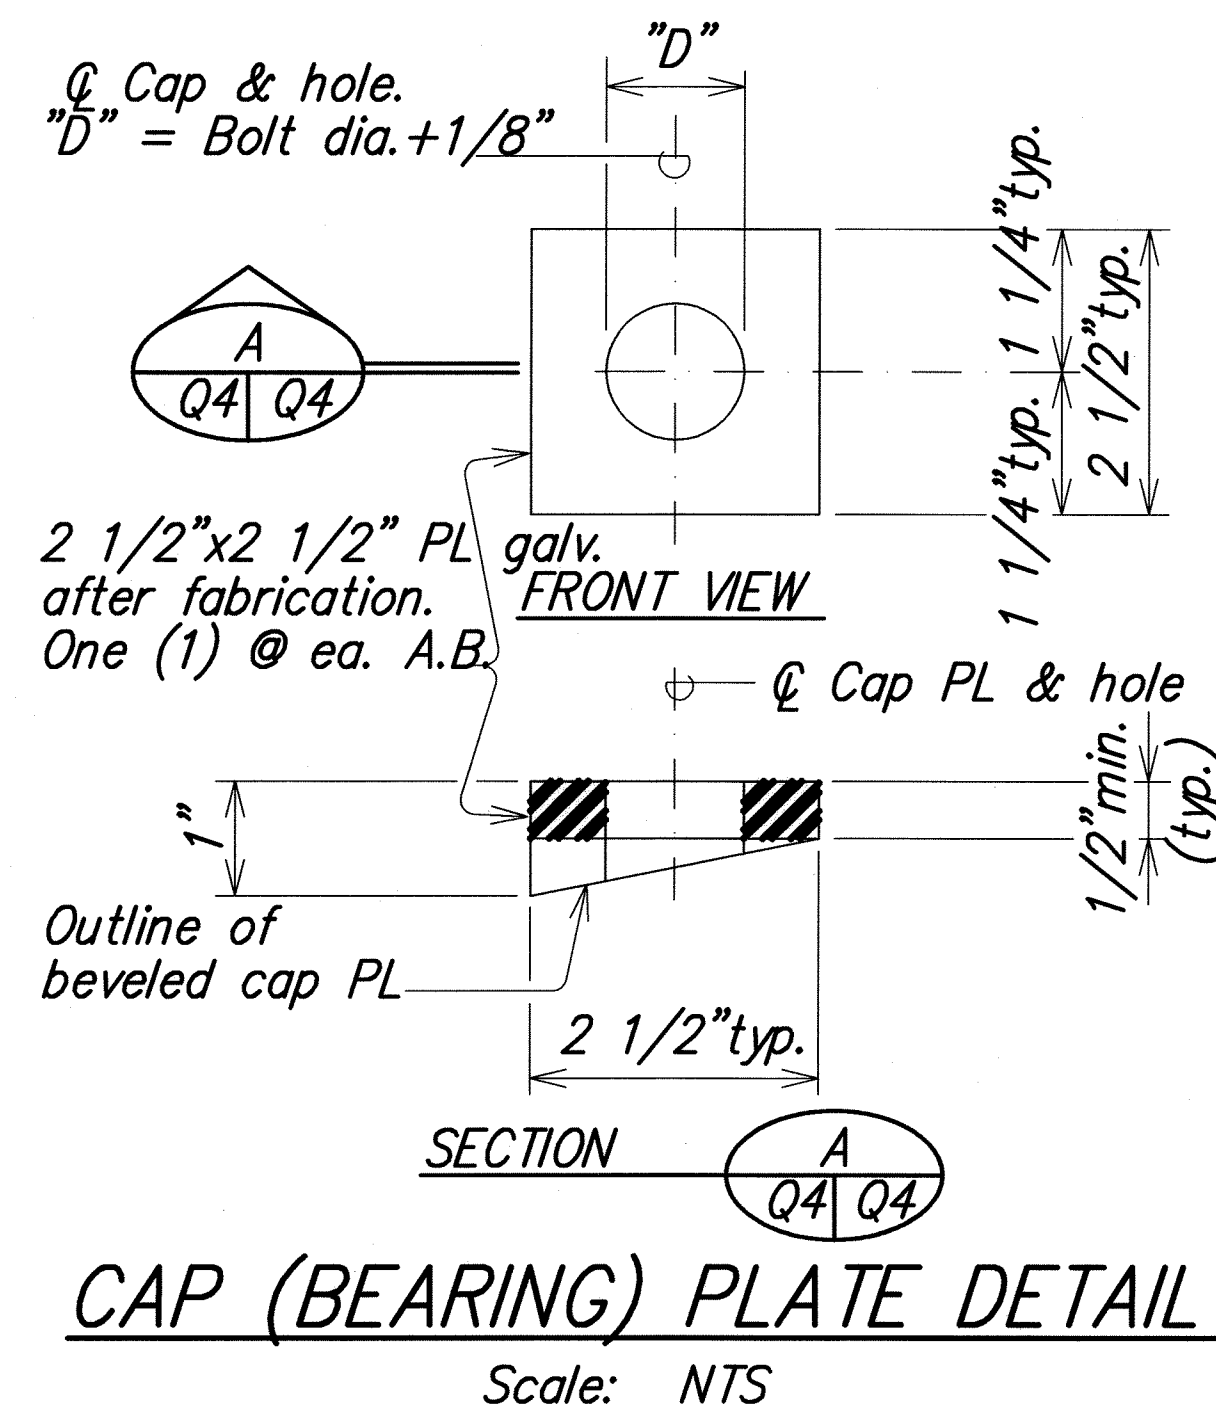

ORIGINAL PLAN	SURVEY PLOTTED BY _____	DATE _____
NOTE BOOK	DRAWN BY _____	" "
	TRACED BY _____	" "
	DESIGNED BY _____	" "
	QUANTITIES BY _____	" "
No. _____	CHECKED BY _____	" "

PATH/FILENAME: P:\Projects\Dot-Hwy\Honouliuli Highway Widening\dwg\Working Drawings\Proj. Num Revised 1-22-08 (CML FINAL)\Cml - Final\13x-GUARDRAIL_DETAIL.SX-Three Beams SHF 78.dwg LAST UPDATE: 08-08-2008 @ 11:08 am



THIS WORK WAS PREPARED BY ME
OR UNDER MY SUPERVISION.

Alan J. Semel

STATE OF HAWAII
DEPARTMENT OF TRANSPORTATION
HIGHWAYS DIVISION

GUARDRAIL DETAILS

Honoapiilani Highway Widening
Lahainaluna Road to Aholo Road
Project No. STP-030-1(39)

Scale: As Shown Date: February 2008

SHEET No. 6 OF 6 SHEETS