


ORIGINAL PLAN	SURVEY PLOTTED BY	DATE
	DRAWN BY	"
	TRACED BY	"
NOTE BOOK	DESIGNED BY	"
	QUANTITIES BY	"
	CHECKED BY	"
No.		

LAST UPDATE: 45-03-2008 @ 11:45 am

g

PATH/FILENAME: F

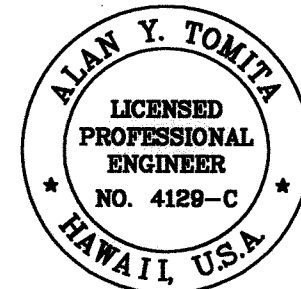


Olonyi Samuel

Scale: _____ Date: October 2008

SHEET No. 1 OF 3 SHEETS

ORIGINAL PLAN	SURVEY PLOTTED BY _____	DATE _____
NOTE BOOK	DRAWN BY _____	_____
	TRACED BY _____	_____
	DESIGNED BY _____	_____
	QUANTITIES BY _____	_____
No. _____	CHECKED BY _____	_____

PATH/FILENAME: P:\Projects\Dot-Hwy\Honoopiari Highway Widening\dwg\Working Drawings\Proj. Num Revised 1-22-08 (CNML FINAL)\Civil - Final\10-RetainingWall&FootingsPlan SHTS 57-59.dwg

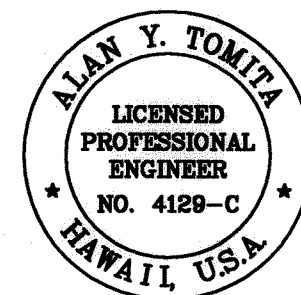


Along Road

SHEET No. 2 OF 3 SHEETS

ORIGINAL PLAN	SURVEY PLOTTED BY _____	DATE _____
NOTE BOOK	DRAWN BY _____	_____
	TRACED BY _____	_____
	DESIGNED BY _____	_____
	QUANTITIES BY _____	_____
No. _____	CHECKED BY _____	_____

\\P:\Projects\Dot-Hwy\Honoopiliani Highway Widening\dwg\Working Drawings\Proj. Num Revised 1-22-08 (CML FINAL)\Civil - Final\10-RetainingWall&FootingPlan SHTS 57-59.dwg

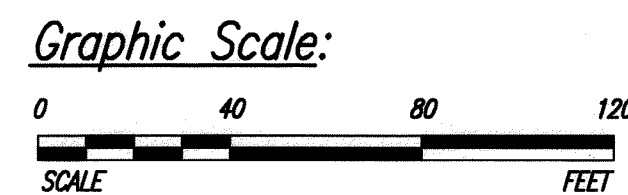

SHEET No. 3 OF 3 SHEETS